


FILE NAME: W:\Projects\ANY\KA\29741\CADD\ASTN\13a368\Consultants\Highway\413a368xsc.dgn  
DATE/TIME: 3/30/2017  
USER: 5323

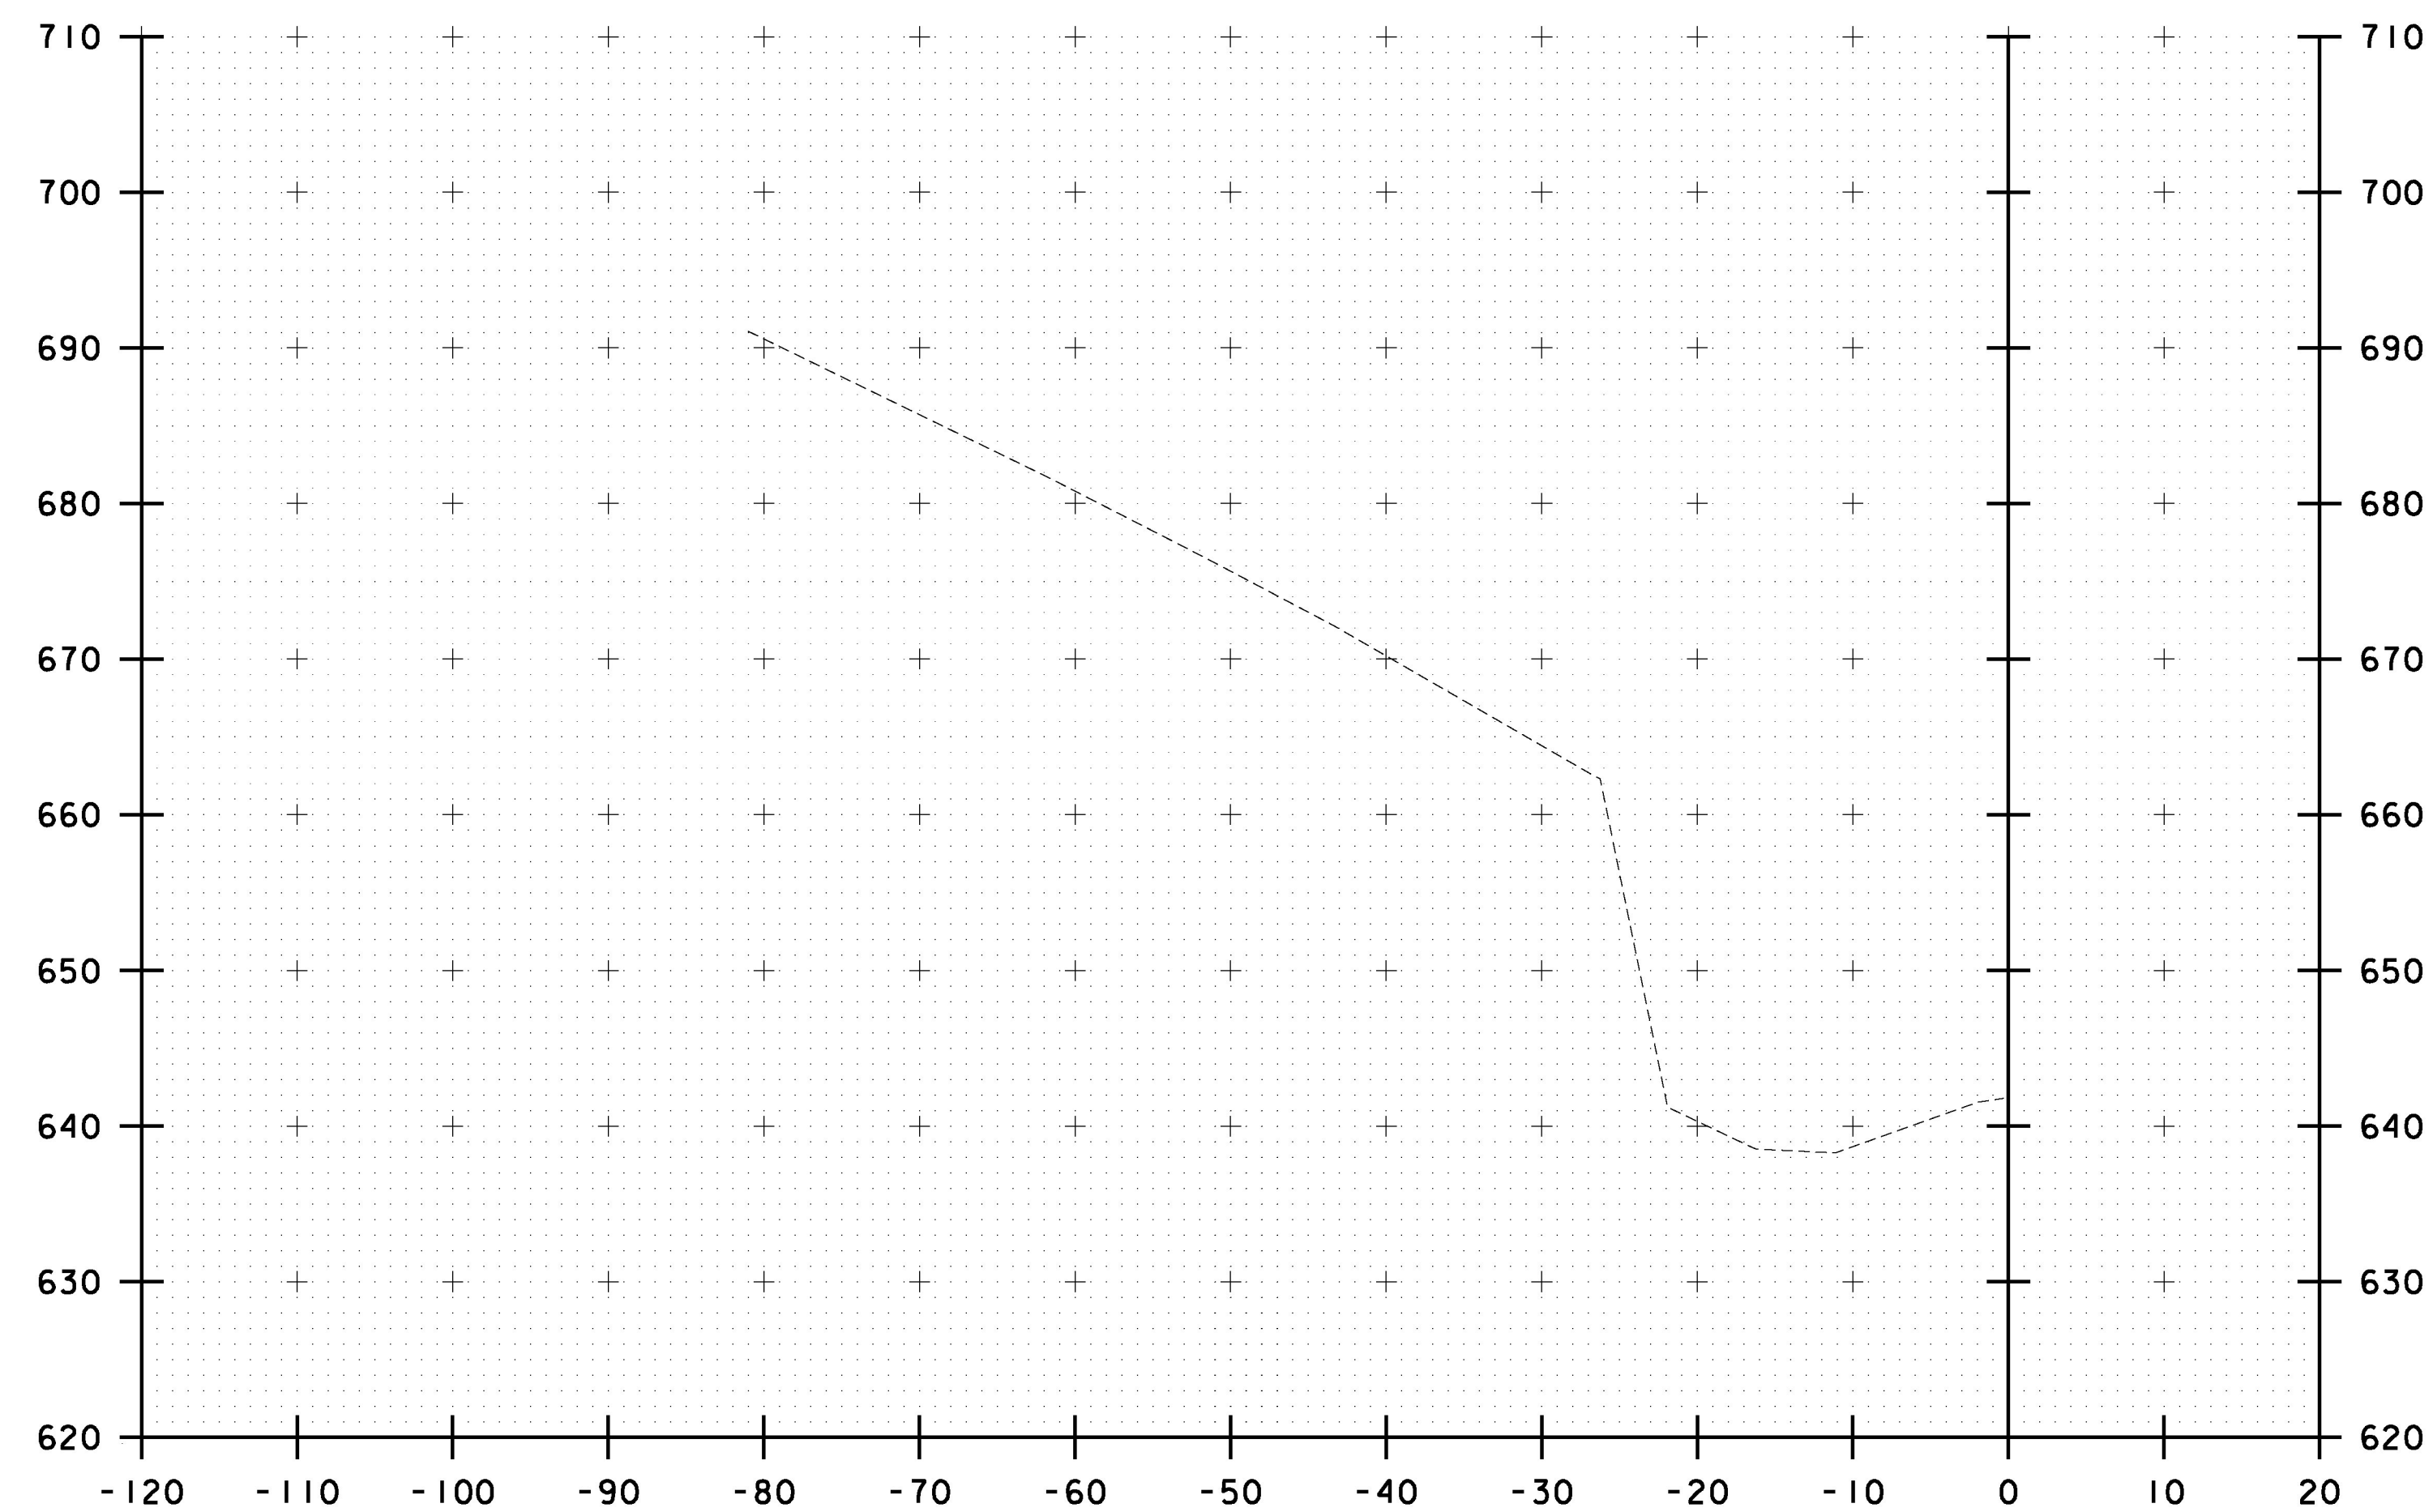

S 6183+44.90  
END PROJECT

STA. S 6183+44.90

10 0 10  
SCALE IN FEET

CHA

|                                |                        |
|--------------------------------|------------------------|
| PROJECT NAME: RYEGATE          |                        |
| PROJECT NUMBER: IM 091-2(80)   |                        |
| FILE NAME: z13a368xsc.dgn      | PLOT DATE: 3/30/2017   |
| PROJECT LEADER: D. GOZALKOWSKI | DRAWN BY: J. HEALD     |
| DESIGNED BY: J. OLSEN          | CHECKED BY: J. SHIELDS |
| CROSS SECTION SHEET 24         | SHEET 59 OF 61         |