


Weldless Rings



Replace with
7/8inch Domestic
galvanized shackle



Weldless Rings meet the
performance requirements of
Federal Specification
RR-C-271D Type VI.

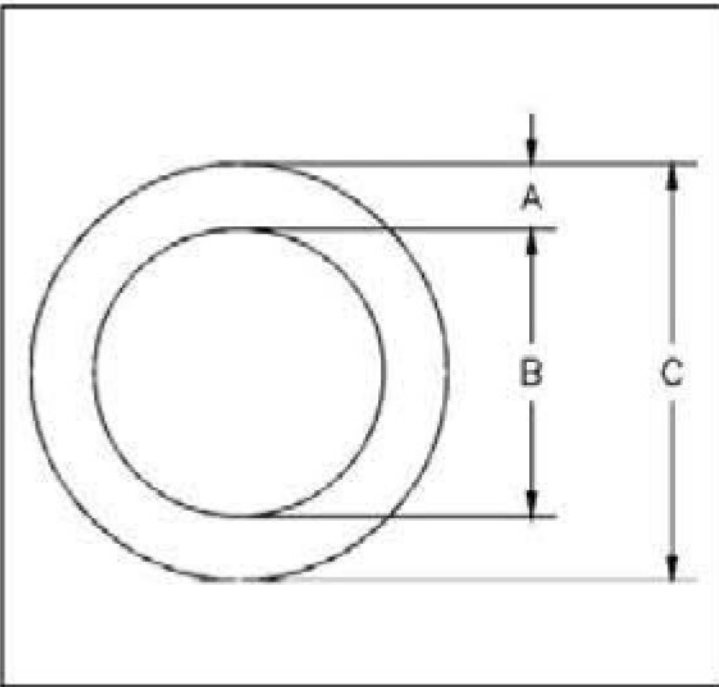

Self colored or Hot Dip galvanized
Forged Carbon Steel- Quenched and Tempered

Size (A) (in.)	Working Load Limit Single Pull (lbs.)*	Weight Each (lbs.)	Dimensions (in.)	
			B	C
7/8 x 4	7200	2.72	4.00	5.75
7/8 x 5-1/2	5600	3.47	5.50	7.25
1 x 4	10800	3.69	4.00	6.00
1-1/8 x 6	10400	6.60	6.00	8.25
1-1/4 x 5	17000	6.82	5.00	7.50
1-3/8 x 6	19000	10.12	6.00	8.75

* Ultimate Load is 6 times the Working Load Limit.

Maccaferri reserves the right to amend product specifications without notice and specifiers are requested to check as to the validity of the specifications they are using.



www.maccaferri-usa.com

HEADQUARTERS:
10303 Governor Lane Boulevard
Williamsport, MD 21795-3116
Tel: 301-223-6910
Fax: 301-223-6134
info@maccaferri-usa.com

AREA OFFICES:

AZ, Phoenix
CA, Sacramento
FL, Coral Gables
MD, Williamsport
MO, St. Louis
NJ, Iselin
NM, Albuquerque
PR, Caguas
TX, Lewisville
WA, Seattle