



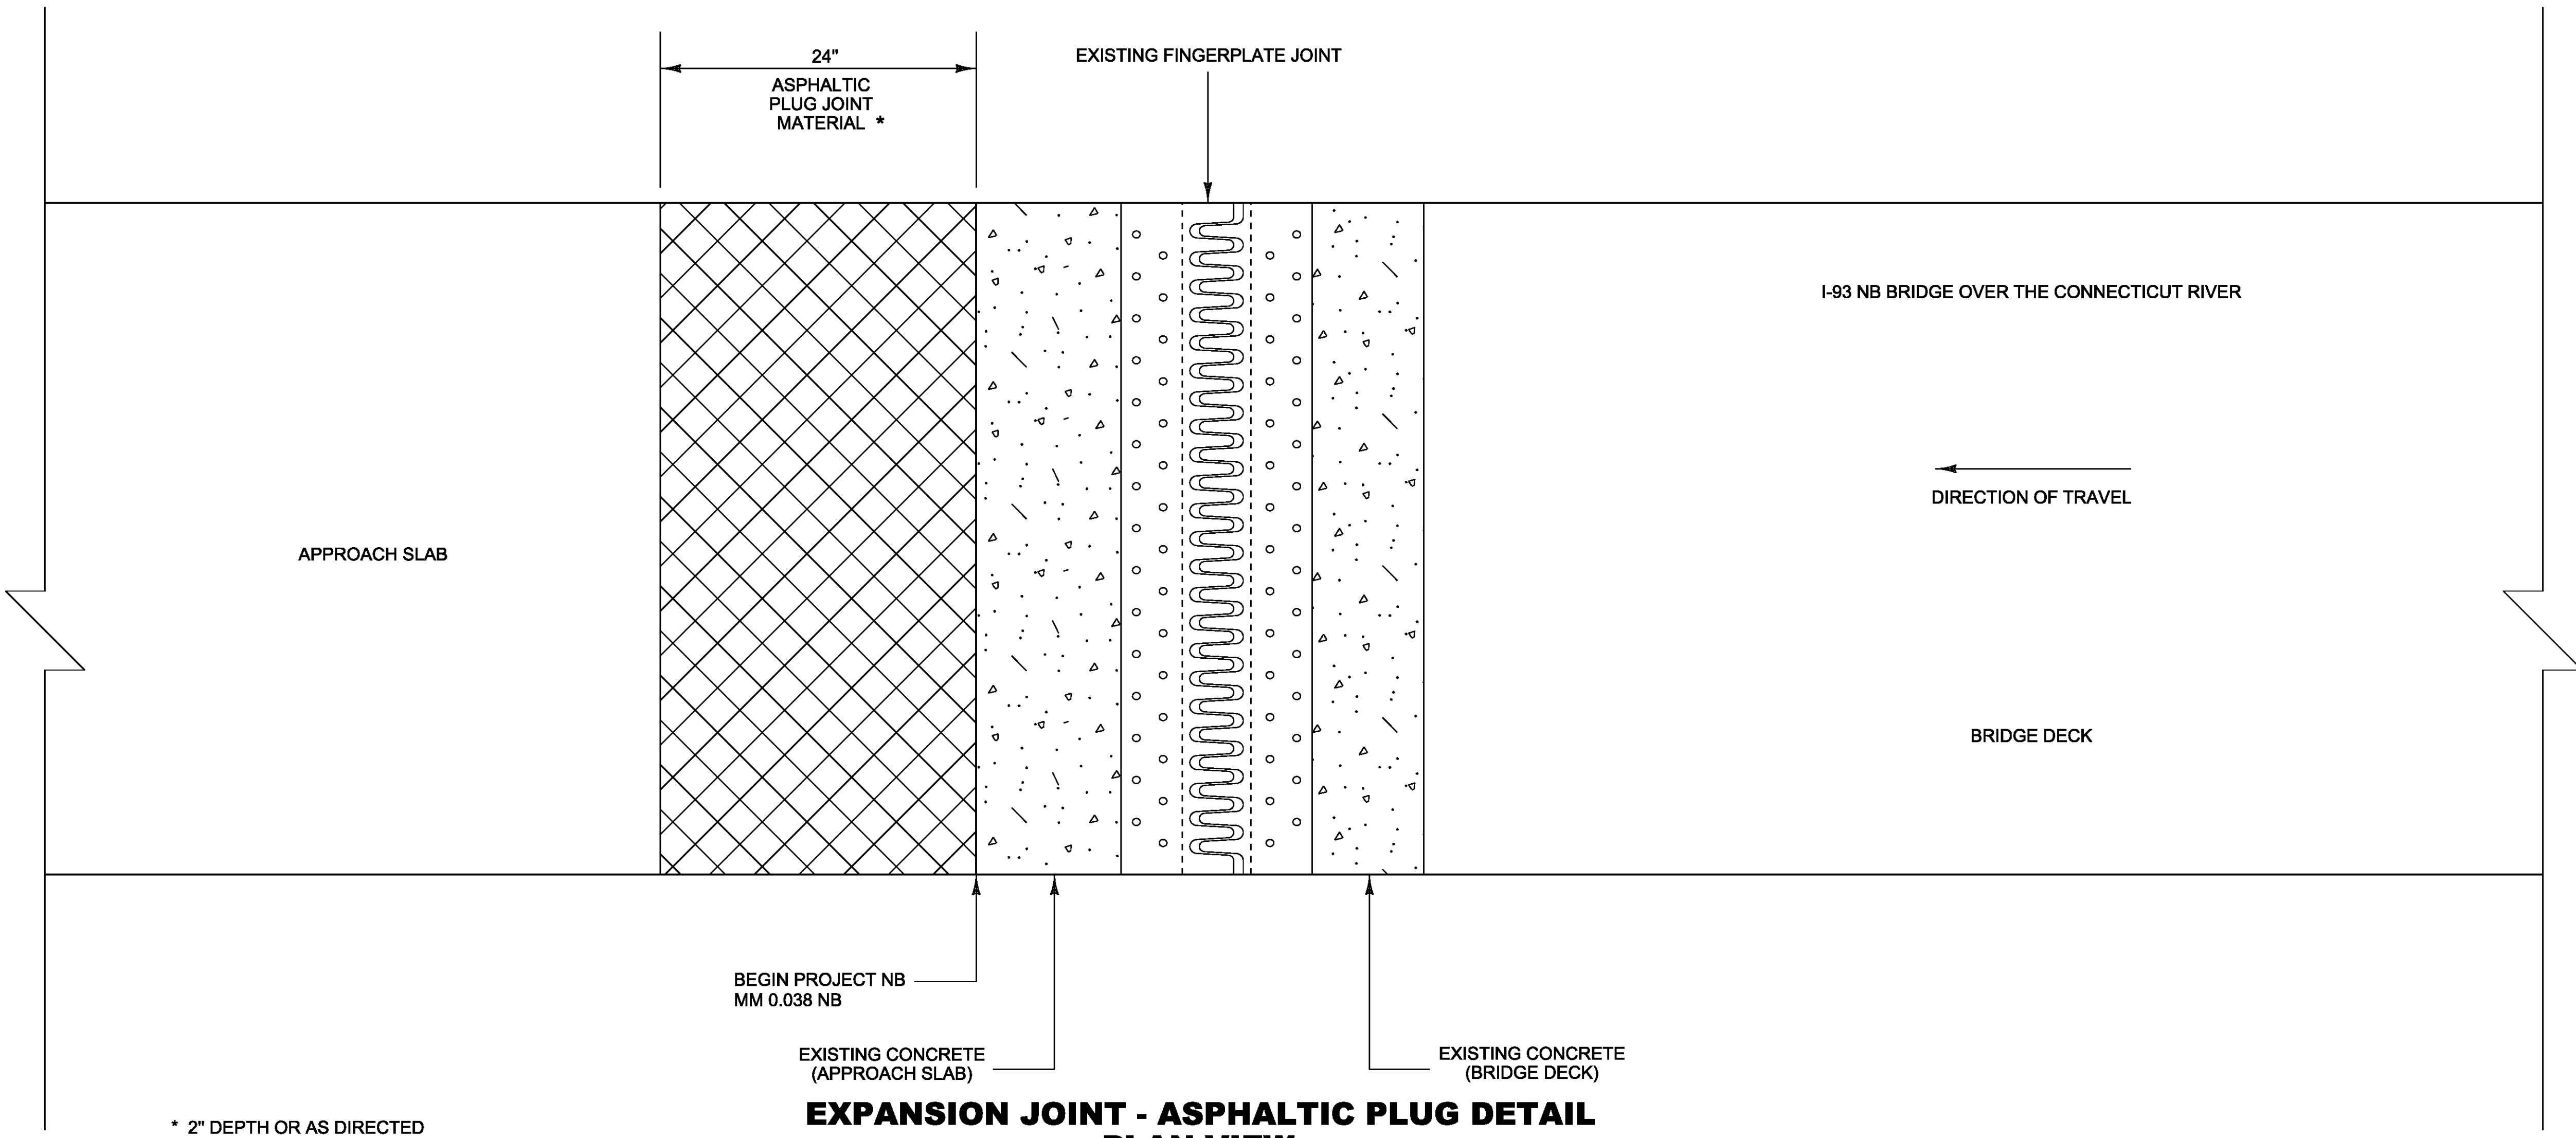

**EXPANSION JOINT - ASPHALTIC PLUG DETAIL
PLAN VIEW
(FINGER PLATE JOINT)**

* 2" DEPTH OR AS DIRECTED
BY THE ENGINEER

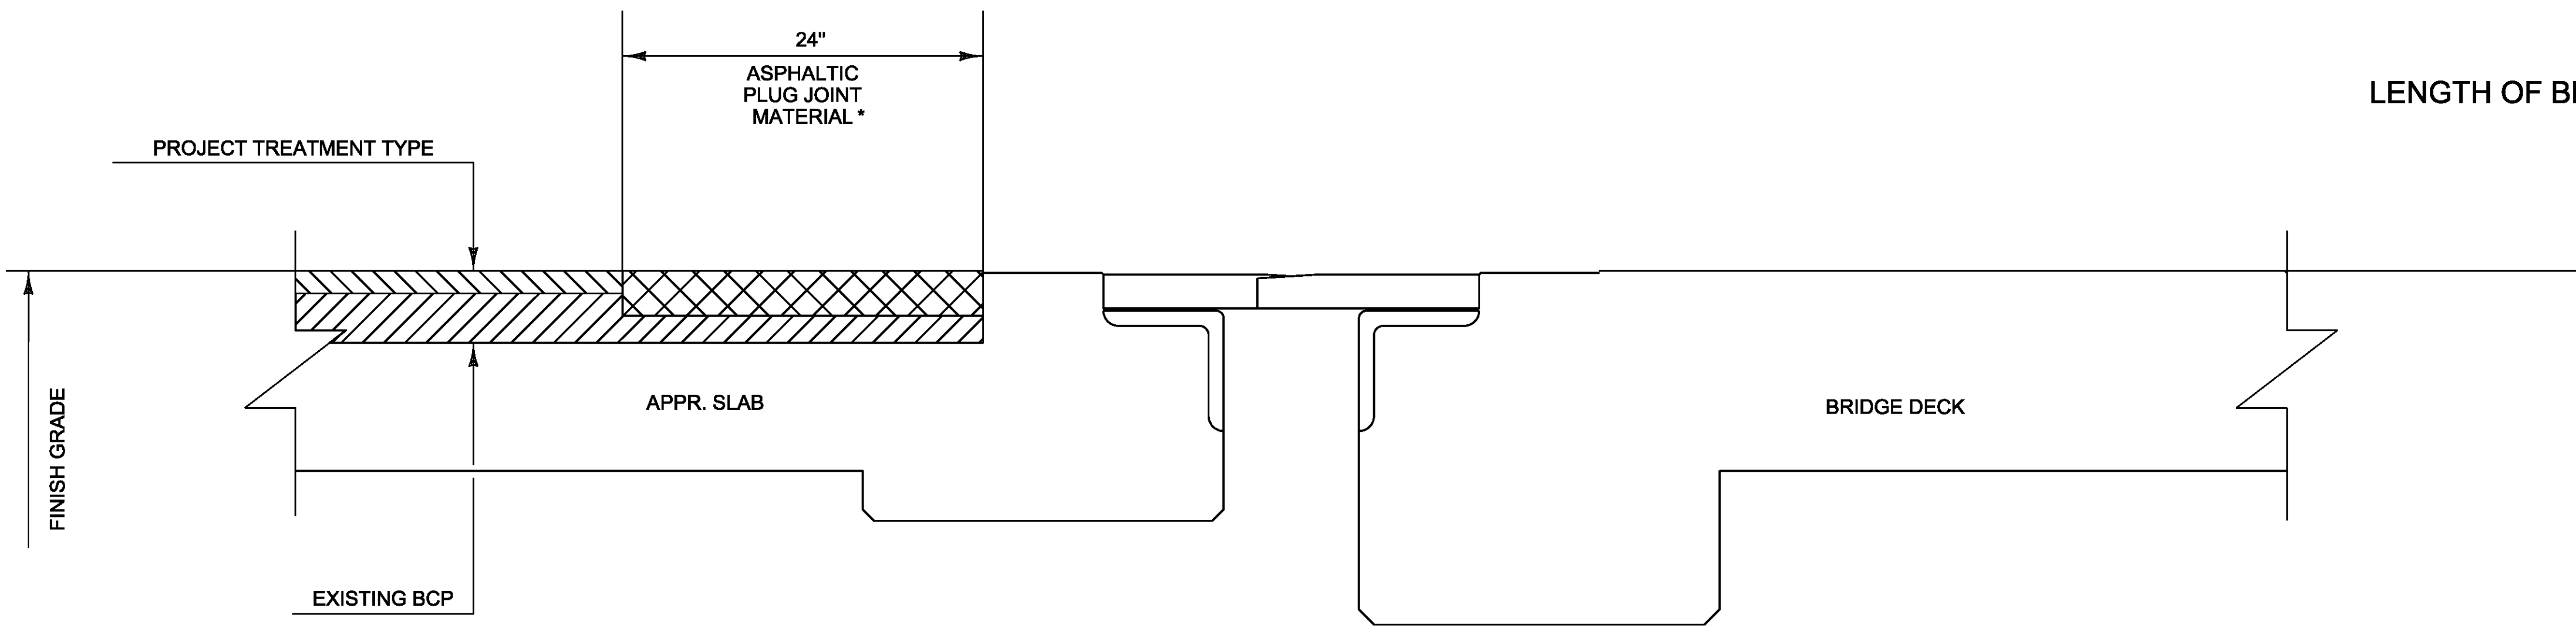

**EXPANSION JOINT - ASPHALTIC PLUG DETAIL
CROSS SECTION VIEW
(FINGER PLATE JOINT)**

NOT TO SCALE

BRIDGE DETAIL SHEET # 2	PROJECT NAME: WATERFORD	
	PROJECT NUMBER: IM SURF(47)	
	FILE NAME: I4aI22\pl4aI22.dgn	PLOT DATE: I2-JAN-2015
	PROJECT LEADER: M. FOWLER	DRAWN BY: K. LOCKE
	DESIGNED BY: K. LOCKE	CHECKED BY: M. FOWLER
	IPARM FILE NAME: pl4aI22_07.I	SHEET 7 OF 22