



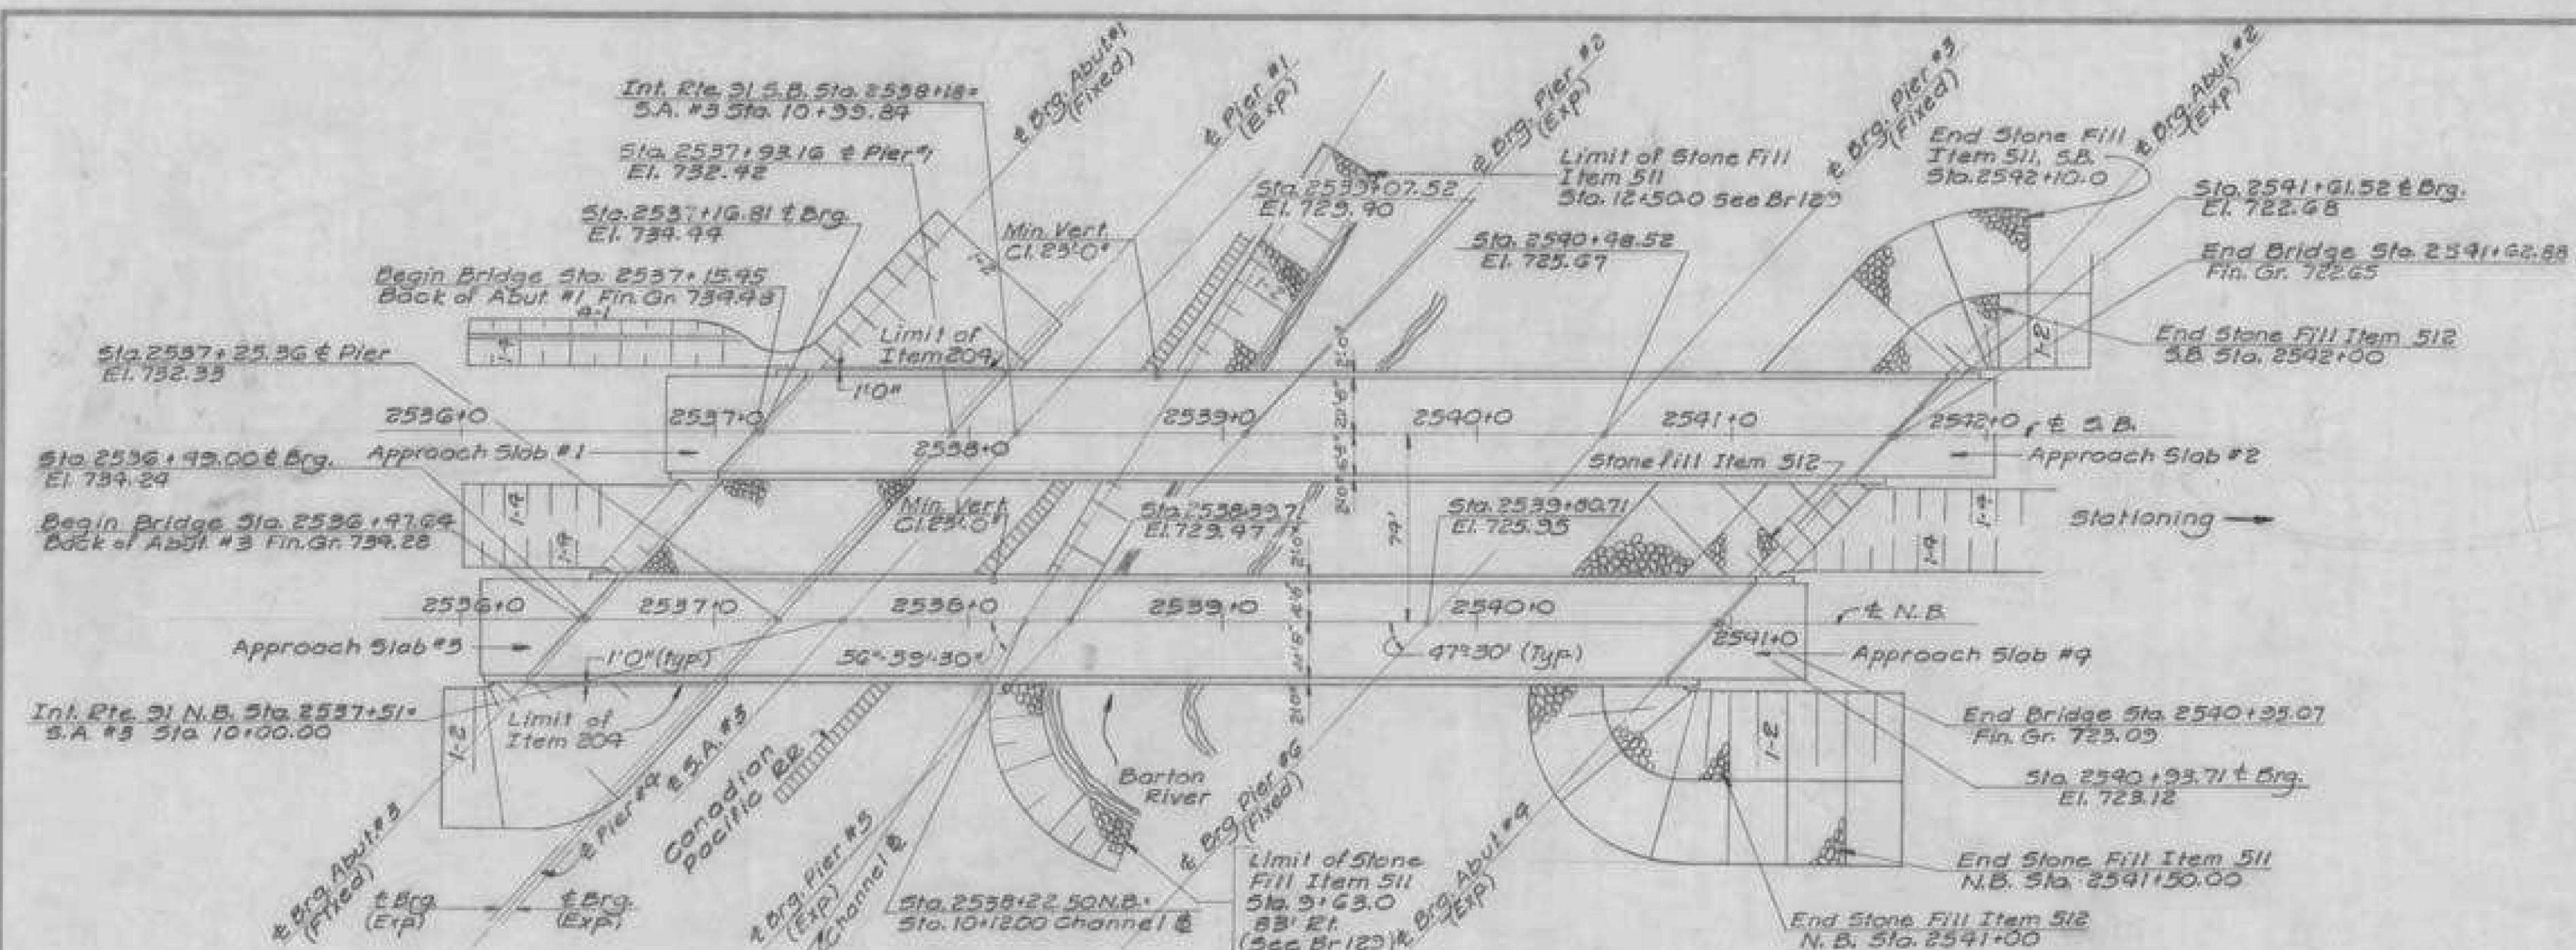

PLAN

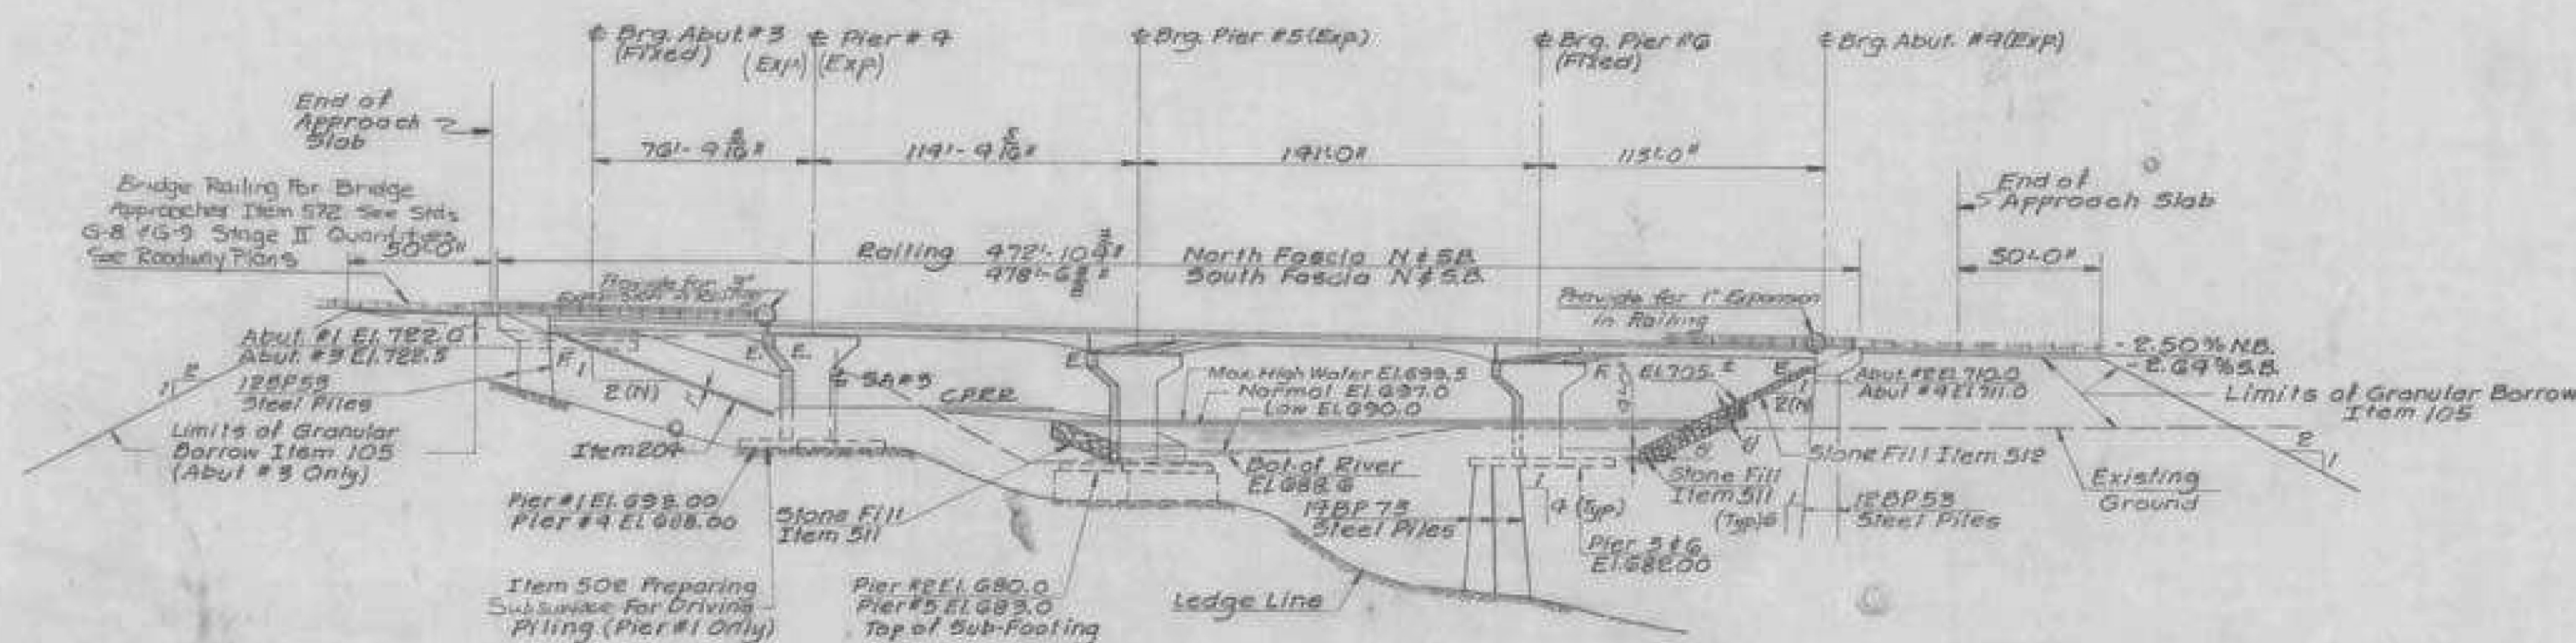

ELEVATION

LIST OF SHEETS

- Br.100 Plan & Elevation
- Br.101-102 Bridge Quantity Sheets
- Br.103 Preliminary Information Sheet
- Br.104-106 Borings Logs
- Br.107 Framing Plan & Girder Details
- Br.108 Girder Elevation & Conn. Details
- Br.109 Deck Section & Splice
- Br.110 Expansion Dam & Scupper Details
- Br.111 Rafter Bearings
- Br.112 Abutment #1
- Br.113 Abutment #2
- Br.114 Abutment #3
- Br.115 Abutment #4
- Br.116 Abutment #2 & #4 Details
- Br.117 Abutment #1 & #3 Approach Slab
- Br.118 Abutment #2 & #4 Approach Slab
- Br.119 Pier #1
- Br.120 Pier #2
- Br.121 Pier #3
- Br.122 Pier #4
- Br.123 Pier #5
- Br.124 Pier #6
- Br.125-128 Reinforcing Schedules
- Br.129 Channel Sections

STANDARD SHEETS REQUIRED

- SCB D1 67 General Notes & Information Jan 24, 48
- SCB D2 67 Detail A&B 10 Jan 24, 48
- SCB D3 67 Drain Trough Details Jan 24, 48
- SCB D4 67 Reinforcing at Abutments Dec 17, 48
- SCB D5 67 Detail A&B May 23, 1949
- SCB D6 67 Intermediate Diaphragm Jan 24, 48
- SCB D7 67 Bearing Devices Jan 24, 48
- SCB D8 67 Detail A Jan 24, 48
- SCB D9 67 Detail B Jan 24, 48
- SB R1 64 Aluminum Railing (12 Sheets) Sheet 1st 2, 2nd 3, 3rd 4, 4th 5, 5th 6, 6th 7, 7th 8, 8th 9, 9th 10, 10th 11, 11th 12, 12th 13, 13th 14, 14th 15, 15th 16, 16th 17, 17th 18, 18th 19, 19th 20, 20th 21, 21st 22, 22nd 23, 23rd 24, 24th 25, 25th 26, 26th 27, 27th 28, 28th 29, 29th 30, 30th 31, 31st 32, 32nd 33, 33rd 34, 34th 35, 35th 36, 36th 37, 37th 38, 38th 39, 39th 40, 40th 41, 41st 42, 42nd 43, 43rd 44, 44th 45, 45th 46, 46th 47, 47th 48, 48th 49, 49th 50, 50th 51, 51st 52, 52nd 53, 53rd 54, 54th 55, 55th 56, 56th 57, 57th 58, 58th 59, 59th 60, 60th 61, 61st 62, 62nd 63, 63rd 64, 64th 65, 65th 66, 66th 67, 67th 68, 68th 69, 69th 70, 70th 71, 71st 72, 72nd 73, 73rd 74, 74th 75, 75th 76, 76th 77, 77th 78, 78th 79, 79th 80, 80th 81, 81st 82, 82nd 83, 83rd 84, 84th 85, 85th 86, 86th 87, 87th 88, 88th 89, 89th 90, 90th 91, 91st 92, 92nd 93, 93rd 94, 94th 95, 95th 96, 96th 97, 97th 98, 98th 99, 99th 100, 100th 101, 101st 102, 102nd 103, 103rd 104, 104th 105, 105th 106, 106th 107, 107th 108, 108th 109, 109th 110, 110th 111, 111st 112, 112nd 113, 113rd 114, 114th 115, 115th 116, 116th 117, 117th 118, 118th 119, 119th 120, 120th 121, 121st 122, 122nd 123, 123rd 124, 124th 125, 125th 126, 126th 127, 127th 128, 128th 129, 129th 130, 130th 131, 131st 132, 132nd 133, 133rd 134, 134th 135, 135th 136, 136th 137, 137th 138, 138th 139, 139th 140, 140th 141, 141st 142, 142nd 143, 143rd 144, 144th 145, 145th 146, 146th 147, 147th 148, 148th 149, 149th 150, 150th 151, 151st 152, 152nd 153, 153rd 154, 154th 155, 155th 156, 156th 157, 157th 158, 158th 159, 159th 160, 160th 161, 161st 162, 162nd 163, 163rd 164, 164th 165, 165th 166, 166th 167, 167th 168, 168th 169, 169th 170, 170th 171, 171st 172, 172nd 173, 173rd 174, 174th 175, 175th 176, 176th 177, 177th 178, 178th 179, 179th 180, 180th 181, 181st 182, 182nd 183, 183rd 184, 184th 185, 185th 186, 186th 187, 187th 188, 188th 189, 189th 190, 190th 191, 191st 192, 192nd 193, 193rd 194, 194th 195, 195th 196, 196th 197, 197th 198, 198th 199, 199th 200, 200th 201, 201st 202, 202nd 203, 203rd 204, 204th 205, 205th 206, 206th 207, 207th 208, 208th 209, 209th 210, 210th 211, 211st 212, 212nd 213, 213rd 214, 214th 215, 215th 216, 216th 217, 217th 218, 218th 219, 219th 220, 220th 221, 221st 222, 222nd 223, 223rd 224, 224th 225, 225th 226, 226th 227, 227th 228, 228th 229, 229th 230, 230th 231, 231st 232, 232nd 233, 233rd 234, 234th 235, 235th 236, 236th 237, 237th 238, 238th 239, 239th 240, 240th 241, 241st 242, 242nd 243, 243rd 244, 244th 245, 245th 246, 246th 247, 247th 248, 248th 249, 249th 250, 250th 251, 251st 252, 252nd 253, 253rd 254, 254th 255, 255th 256, 256th 257, 257th 258, 258th 259, 259th 260, 260th 261, 261st 262, 262nd 263, 263rd 264, 264th 265, 265th 266, 266th 267, 267th 268, 268th 269, 269th 270, 270th 271, 271st 272, 272nd 273, 273rd 274, 274th 275, 275th 276, 276th 277, 277th 278, 278th 279, 279th 280, 280th 281, 281st 282, 282nd 283, 283rd 284, 284th 285, 285th 286, 286th 287, 287th 288, 288th 289, 289th 290, 290th 291, 291st 292, 292nd 293, 293rd 294, 294th 295, 295th 296, 296th 297, 297th 298, 298th 299, 299th 300, 300th 301, 301st 302, 302nd 303, 303rd 304, 304th 305, 305th 306, 306th 307, 307th 308, 308th 309, 309th 310, 310th 311, 311st 312, 312nd 313, 313rd 314, 314th 315, 315th 316, 316th 317, 317th 318, 318th 319, 319th 320, 320th 321, 321st 322, 322nd 323, 323rd 324, 324th 325, 325th 326, 326th 327, 327th 328, 328th 329, 329th 330, 330th 331, 331st 332, 332nd 333, 333rd 334, 334th 335, 335th 336, 336th 337, 337th 338, 338th 339, 339th 340, 340th 341, 341st 342, 342nd 343, 343rd 344, 344th 345, 345th 346, 346th 347, 347th 348, 348th 349, 349th 350, 350th 351, 351st 352, 352nd 353, 353rd 354, 354th 355, 355th 356, 356th 357, 357th 358, 358th 359, 359th 360, 360th 361, 361st 362, 362nd 363, 363rd 364, 364th 365, 365th 366, 366th 367, 367th 368, 368th 369, 369th 370, 370th 371, 371st 372, 372nd 373, 373rd 374, 374th 375, 375th 376, 376th 377, 377th 378, 378th 379, 379th 380, 380th 381, 381st 382, 382nd 383, 383rd 384, 384th 385, 385th 386, 386th 387, 387th 388, 388th 389, 389th 390, 390th 391, 391st 392, 392nd 393, 393rd 394, 394th 395, 395th 396, 396th 397, 397th 398, 398th 399, 399th 400, 400th 401, 401st 402, 402nd 403, 403rd 404, 404th 405, 405th 406, 406th 407, 407th 408, 408th 409, 409th 410, 410th 411, 411st 412, 412nd 413, 413rd 414, 414th 415, 415th 416, 416th 417, 417th 418, 418th 419, 419th 420, 420th 421, 421st 422, 422nd 423, 423rd 424, 424th 425, 425th 426, 426th 427, 427th 428, 428th 429, 429th 430, 430th 431, 431st 432, 432nd 433, 433rd 434, 434th 435, 435th 436, 436th 437, 437th 438, 438th 439, 439th 440, 440th 441, 441st 442, 442nd 443, 443rd 444, 444th 445, 445th 446, 446th 447, 447th 448, 448th 449, 449th 450, 450th 451, 451st 452, 452nd 453, 453rd 454, 454th 455, 455th 456, 456th 457, 457th 458, 458th 459, 459th 460, 460th 461, 461st 462, 462nd 463, 463rd 464, 464th 465, 465th 466, 466th 467, 467th 468, 468th 469, 469th 470, 470th 471, 471st 472, 472nd 473, 473rd 474, 474th 475, 475th 476, 476th 477, 477th 478, 478th 479, 479th 480, 480th 481, 481st 482, 482nd 483, 483rd 484, 484th 485, 485th 486, 486th 487, 487th 488, 488th 489, 489th 490, 490th 491, 491st 492, 492nd 493, 493rd 494, 494th 495, 495th 496, 496th 497, 497th 498, 498th 499, 499th 500, 500th 501, 501st 502, 502nd 503, 503rd 504, 504th 505, 505th 506, 506th 507, 507th 508, 508th 509, 509th 510, 510th 511, 511st 512, 512nd 513, 513rd 514, 514th 515, 515th 516, 516th 517, 517th 518, 518th 519, 519th 520, 520th 521, 521st 522, 522nd 523, 523rd 524, 524th 525, 525th 526, 526th 527, 527th 528, 528th 529, 529th 530, 530th 531, 531st 532, 532nd 533, 533rd 534, 534th 535, 535th 536, 536th 537, 537th 538, 538th 539, 539th 540, 540th 541, 541st 542, 542nd 543, 543rd 544, 544th 545, 545th 546, 546th 547, 547th 548, 548th 549, 549th 550, 550th 551, 551st 552, 552nd 553, 553rd 554, 554th 555, 555th 556, 556th 557, 557th 558, 558th 559, 559th 560, 560th 561, 561st 562, 562nd 563, 563rd 564, 564th 565, 565th 566, 566th 567, 567th 568, 568th 569, 569th 570, 570th 571, 571st 572, 572nd 573, 573rd 574, 574th 575, 575th 576, 576th 577, 577th 578, 578th 579, 579th 580, 580th 581, 581st 582, 582nd 583, 583rd 584, 584th 585, 585th 586, 586th 587, 587th 588, 588th 589, 589th 590, 590th 591, 591st 592, 592nd 593, 593rd 594, 594th 595, 595th 596, 596th 597, 597th 598, 598th 599, 599th 600, 600th 601, 601st 602, 602nd 603, 603rd 604, 604th 605, 605th 606, 606th 607, 607th 608, 608th 609, 609th 610, 610th 611, 611st 612, 612nd 613, 613rd 614, 614th 615, 615th 616, 616th 617, 617th 618, 618th 619, 619th 620, 620th 621, 621st 622, 622nd 623, 623rd 624, 624th 625, 625th 626, 626th 627, 627th 628, 628th 629, 629th 630, 630th 631, 631st 632, 632nd 633, 633rd 634, 634th 635, 635th 636, 636th 637, 637th 638, 638th 639, 639th 640, 640th 641, 641st 642, 642nd 643, 643rd 644, 644th 645, 645th 646, 646th 647, 647th 648, 648th 649, 649th 650, 650th 651, 651st 652, 652nd 653, 653rd 654, 654th 655, 655th 656, 656th 657, 657th 658, 658th 659, 659th 660, 660th 661, 661st 662, 662nd 663, 663rd 664, 664th 665, 665th 666, 666th 667, 667th 668, 668th 669, 669th 670, 670th 671, 671st 672, 672nd 673, 673rd 674, 674th 675, 675th 676, 676th 677, 677th 678, 678th 679, 679th 680, 680th 681, 681st 682, 682nd 683, 683rd 684, 684th 685, 685th 686, 686th 687, 687th 688, 688th 689, 689th 690, 690th 691, 691st 692, 692nd 693, 693rd 694, 694th 695, 695th 696, 696th 697, 697th 698, 698th 699, 699th 700, 700th 701, 701st 702, 702nd 703, 703rd 704, 704th 705, 705th 706, 706th 707, 707th 708, 708th 709, 709th 710, 710th 711, 711st 712, 712nd 713, 713rd 714, 714th 715, 715th 716, 716th 717, 717th 718, 718th 719, 719th 720, 720th 721, 721st 722, 722nd 723, 723rd 724, 724th 725, 725th 726, 726th 727, 727th 728, 728th 729, 729th 730, 730th 731, 731st 732, 732nd 733, 733rd 734, 734th 735, 735th 736, 736th 737, 737th 738, 738th 739, 739th 740, 740th 741, 741st 742, 742nd 743, 743rd 744, 744th 745, 745th 746, 746th 747, 747th 748, 748th 749, 749th 750, 750th 751, 751st 752, 752nd 753, 753rd 754, 754th 755, 755th 756, 756th 757, 757th 758, 758th 759, 759th 760, 760th 761, 761st 762, 762nd 763, 763rd 764, 764th 765, 765th 766, 766th 767, 767th 768, 768th 769, 769th 770, 770th 771, 771st 772, 772nd 773, 773rd 774, 774th 775, 775th 776, 776th 777, 777th 778, 778th 779, 779th 780, 780th 781, 781st 782, 782nd 783, 783rd 784, 784th 785, 785th 786, 786th 787, 787th 788, 788th 789, 789th 790, 790th 791, 791st 792, 792nd 793, 793rd 794, 794th 795, 795th 796, 796th 797, 797th 798, 798th 799, 799th 800, 800th 801, 801st 802, 802nd 803, 803rd 804, 804th 805, 805th 806, 806th 807, 807th 808, 808th 809, 809th 810, 810th 811, 811st 812, 812nd 813, 813rd 814, 814th 815, 815th 816, 816th 817, 817th 818, 818th 819, 819th 820, 820th 821, 821st 822, 822nd 823, 823rd 824, 824th 825, 825th 826, 826th 827, 827th 828, 828th 829, 829th 830, 830th 831, 831st 832, 832nd 833, 833rd 834, 834th 835, 835th 836, 836th 837, 837th 838, 838th 839, 839th 840, 840th 841, 841st 842, 842nd 843, 843rd 844, 844th 845, 845th 846, 846th 847, 847th 848, 848th 849, 849th 850, 850th 851, 851st 852, 852nd 853, 853rd 854, 854th 855, 855th 856, 856th 857, 857th 858, 858th 859, 859th 860, 860th 861, 861st 862, 862nd 863, 863rd 864, 864th 865, 865th 866, 866th 867, 867th 868, 868th 869, 869th 870, 870th 871, 871st 872, 872nd 873, 873rd 874, 874th 875, 875th 876, 876th 877, 877th 878, 878th 879, 879th 880, 880th 881, 881st 882, 882nd 883, 883rd 884, 884th 885, 885th 886, 886th 887, 887th 888, 888th 889, 889th 890, 890th 891, 891st 892, 892nd 893, 893rd 894, 894th 895, 895th 896, 896th 897, 897th 898, 898th 899, 899th 900, 900th 901, 901st 902, 902nd 903, 903rd 904, 904th 905, 905th 906, 906th 907, 907th 908, 908th 909, 909th 910, 910th 911, 911st 912, 912nd 913, 913rd 914, 914th 915, 915th 916, 916th 917, 917th 918, 918th 919, 919th 920, 920th 921, 921st 922, 922nd 923, 923rd 924, 924th 925, 925th 926, 926th 927, 927th 928, 928th 929, 929th 930, 930th 931, 931st 932, 932nd 933, 933rd 934, 934th 935, 935th 936, 936th 937, 937th 938, 938th 939, 939th 940, 940th 941, 941st 942, 942nd 943, 943rd 944, 944th 945, 945th 946, 946th 947, 947th 948, 948th 949, 949th 950, 950th 951, 951st 952, 952nd 953, 953rd 954, 954th 955, 955th 956, 956th 957, 957th 958, 958th 959, 959th 960, 960th 961, 961st 962, 962nd 963, 963rd 964, 964th 965, 965th 966, 966th 967, 967th 968, 968th 969, 969th 970, 970th 971, 971st 972, 972nd 973, 973rd 974, 974th 975, 975th 976, 976th 977, 977th 978, 978th 979, 979th 980, 980th 981, 981st 982, 982nd 983, 983rd 984, 984th 985, 985th 986, 986th 987, 987th 988, 988th 989, 989th 990, 990th 991, 991st 992, 992nd 993, 993rd 994, 994th 995, 995th 996, 996th 997, 997th 998, 998th 999, 999th 1000, 1000th 1001, 1001st 1002, 1002nd 1003, 1003rd 1004, 1004th 1005, 1005th 1006, 1006th 1007, 1007th 1008, 1008th 1009, 1009th 1010, 1010th 1011, 1011st 1012, 1012nd 1013, 1013rd 1014, 1014th 1015, 1015th 1016, 1016th 1017, 1017th 1018, 1018th 1019, 1019th 1020, 1020th 1021, 1021st 1022, 1022nd 1023, 1023rd 1024, 1024th 1025, 1025th 1026, 1026th 1027, 1027th 1028, 1028th 1029, 1029th 1030, 1030th 1031, 1031st 1032, 1032nd 1033, 1033rd 1034, 1034th 1035, 1035th 1036, 1036th 1037, 1037th 1038, 1038th 1039, 1039th 1040, 1040th 1041, 1041st 1042, 1042nd 1043, 1043rd 1044, 1044th 1045, 1045th 1046, 1046th 1047, 1047th 1048, 1048th 1049, 1049th 1050, 1050th 1051, 1051st 1052, 1052nd 1053, 1053rd 1054, 1054th 1055, 1055th 1056, 1056th 1057, 1057th 1058, 1058th 1059, 1059th 1060, 1060th 1061, 1061st 1062, 1062nd 1063, 1063rd 1064, 1064th 1065, 1065th 1066, 1066th 1067, 1067th 1068, 1068th 1069, 1069th 1070, 1070th 1071, 1071st 1072, 1072nd 1073, 1073rd 1074, 1074th 1075, 1075th 1076, 1076th 1077, 1077th 1078, 1078th 1079, 1079th 1080, 1080th 1081, 1081st 1082, 1082nd 1083, 1083rd 1084, 1084th 1085, 1085th 1086, 1086th 1087, 1087th 1088, 1088th 1089, 1089th 1090, 1090th 1091, 1091st 1092, 1092nd 1093, 1093rd 1094, 1094th 1095, 1095th 1096, 1096th 1097, 1097th 1098, 1098th 1099, 1099th 1100, 1100th 1101, 1101st 1102, 1102nd 1103, 1103rd 1104, 1104th 1105, 1105th 1106, 1106th 1107, 1107th 1108, 1108th 1109, 1109th 1110, 1110th 1111, 1111st 1112, 1112nd 1113, 1113rd 1114, 1114th 1115, 1115th 1116, 1116th 1117, 1117th 1118, 1118th 1119, 1119th 1120, 1120th 1121, 1121st 11