

STATE OF VERMONT
AGENCY OF TRANSPORTATION




PROPOSED IMPROVEMENT
BRIDGE PROJECT
TOWN OF IRASBURG
COUNTY OF ORLEANS

INTERSTATE 91 (PRINCIPAL ARTERIAL) BRIDGE NO. 107N

PROJECT LOCATION: LOCATED IN THE TOWN OF IRASBURG, ON INTERSTATE 91, APPROXIMATELY 0.430 MILES
SOUTHERLY OF THE IRASBURG/BROWNINGTON TOWN LINE.

PROJECT DESCRIPTION: WORK TO BE PERFORMED UNDER THIS PROJECT INCLUDES THE REPLACEMENT OF THE EXISTING BRIDGE
DECK INCLUDING RELATED APPROACH WORK.



LENGTH OF STRUCTURE: 447.43 FEET
LENGTH OF ROADWAY: 152.57 FEET
LENGTH OF PROJECT: 600.00 FEET

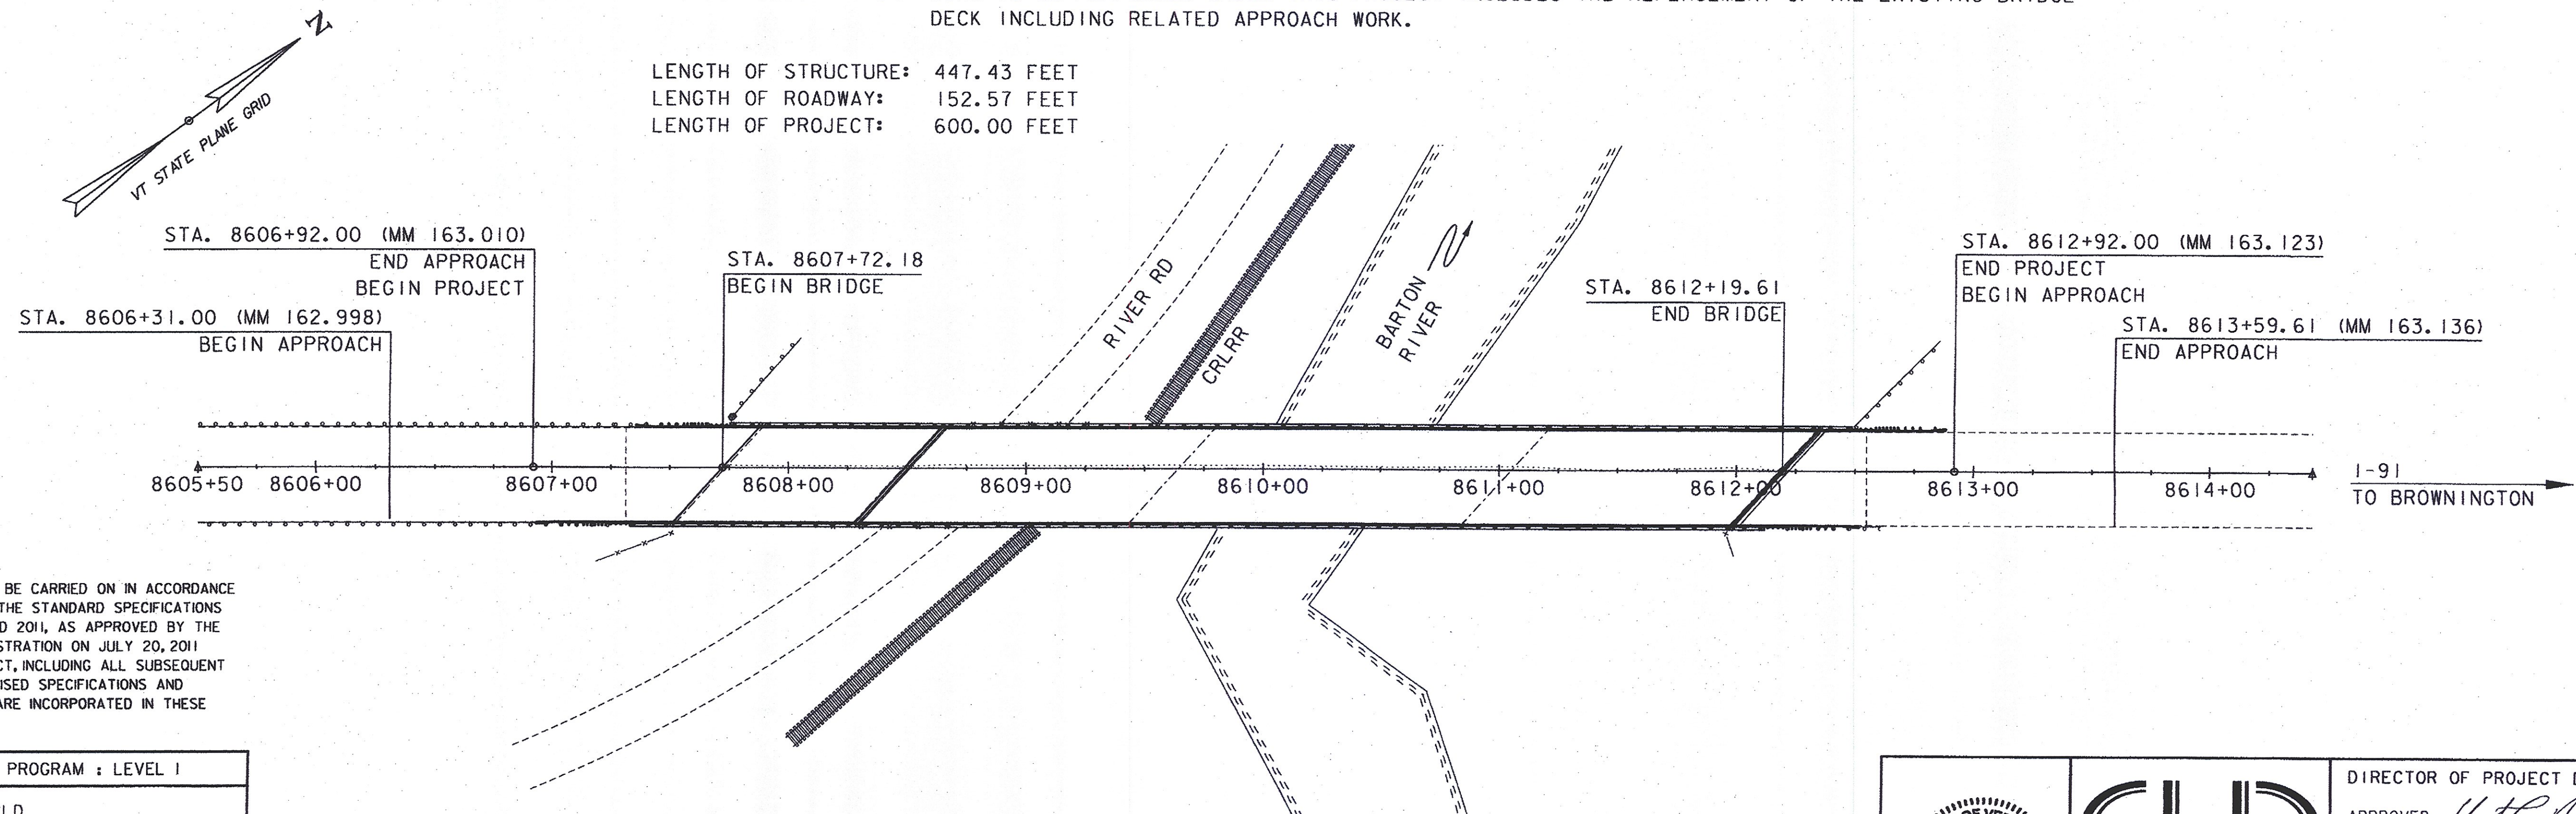

CONSTRUCTION IS TO BE CARRIED ON IN ACCORDANCE
WITH THESE PLANS AND THE STANDARD SPECIFICATIONS
FOR CONSTRUCTION DATED 2011, AS APPROVED BY THE
FEDERAL HIGHWAY ADMINISTRATION ON JULY 20, 2011
FOR USE ON THIS PROJECT, INCLUDING ALL SUBSEQUENT
REVISIONS AND SUCH REVISED SPECIFICATIONS AND
SPECIAL PROVISIONS AS ARE INCORPORATED IN THESE
PLANS.

QUALITY ASSURANCE PROGRAM : LEVEL I
SURVEYED BY : CLD
SURVEYED DATE : 09/21/2015
DATUM
VERTICAL NAVD 88
HORIZONTAL NAD 83

SCALE 1" = 40'-0"
40 0 40

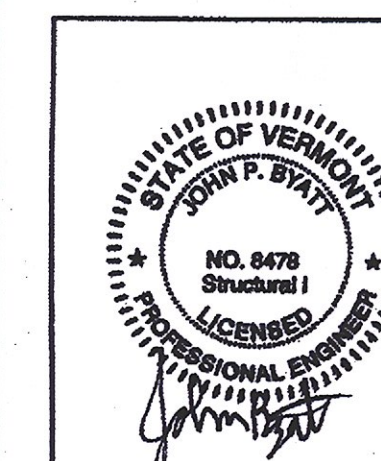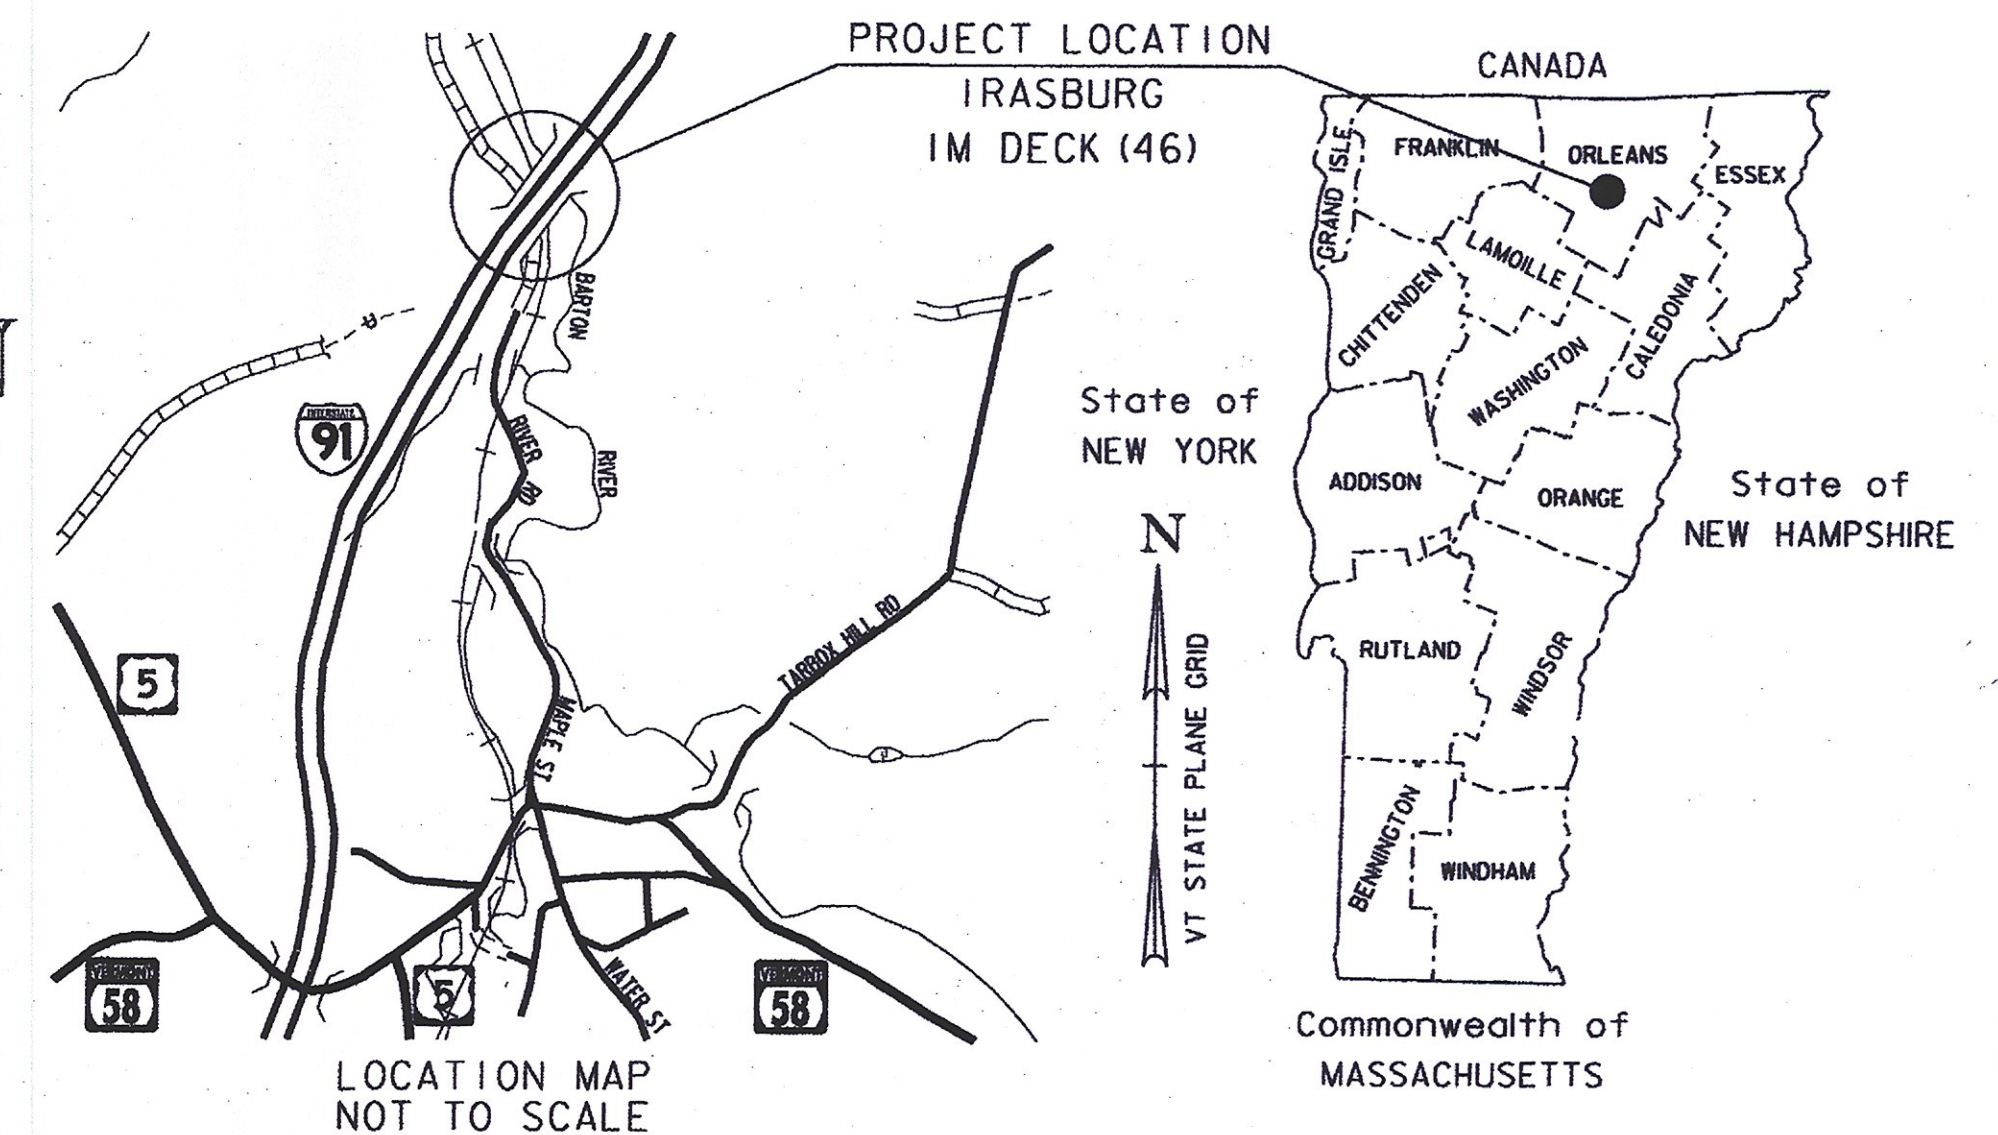

DIRECTOR OF PROJECT DELIVERY
APPROVED <i>[Signature]</i> DATE 2/4/2016
PROJECT MANAGER : JENNIFER FITCH, P.E.
PROJECT NAME : IRASBURG
PROJECT NUMBER : IM DECK (46)
SHEET 1 OF 49 SHEETS

INDEX OF SHEETS

- 1. TITLE SHEET
- 2.-3. INDEX OF SHEETS AND PROJECT NOTES SHEETS 1-2
- 4. TYPICAL BRIDGE SECTIONS SHEET
- 5. TYPICAL ROADWAY SECTIONS SHEET
- 6.-7. QUANTITY SHEETS 1-2
- 8. CONVENTIONAL SYMBOLOGY LEGEND SHEET
- 9. LAYOUT SHEET
- 10. PROFILE SHEET
- 11.-13. TRAFFIC CONTROL SHEETS 1-3
- 14. TRAFFIC CONTROL BARRIER SHEET
- 15.-16. PHASING SECTIONS SHEETS 1-2
- 17.-18. TEMPORARY TRAFFIC BARRIER - BRACED SHEETS 1-2
- 19.-20. DECK DETAILS SHEETS 1-2
- 21.-23. JOINT DETAILS SHEETS 1-3
- 24. CURB REPLACEMENT DETAILS SHEET
- 25. BITUMINOUS CONCRETE REMOVAL PLAN SHEET
- 26. RAIL LAYOUT SHEET
- 27.-49. REFERENCE PLAN SHEETS 1-23

STRUCTURE DETAIL SHEETS

- SD-501.00 02/09/2012 CONCRETE DETAILS AND NOTES
- SD-502.00 10/10/2012 CONCRETE DETAILS AND NOTES
- SD-516.10 08/29/2011 BRIDGE JOINT ASPHALTIC PLUG
- SD-601.00 06/04/2010 STRUCTURAL STEEL DETAILS & NOTES

HIGHWAY SAFETY AND DESIGN DETAIL SHEETS

- HSD-621.06 11/03/2015 GUARDRAIL TERMINAL LABEL DETAIL

VAOT STANDARD SHEETS

- E-193 08/18/1995 PAVEMENT MARKING DETAILS
- G-1 11/10/2015 STEEL BEAM GUARDRAIL WITH STEEL POSTS, STEEL BEAM GUARDRAIL WITH WOOD POSTS
- G-1d 02/10/2014 STEEL BEAM GUARDRAIL APPROACH END TERMINAL, STEEL BEAM GUARDRAIL TRAILING END TERMINAL
- T-1 08/06/2012 TRAFFIC CONTROL GENERAL NOTES
- T-11 08/06/2012 CONSTRUCTION APPROACH SIGNING DIVIDED HIGHWAY ONE LANE CLOSED
- T-12 08/06/2012 TRAFFIC CONTROL DIVIDED HIGHWAY ONE LANE CLOSED
- T-13 08/06/2012 TRAFFIC CONTROL DIVIDED HIGHWAY ONE LANE CLOSED
- T-22 08/06/2012 TRAFFIC CONTROL FOR PAVEMENT MARKING ON DIVIDED HIGHWAY
- T-31 08/06/2012 CONSTRUCTION SIGN DETAILS
- T-42 04/09/2014 BRIDGE NUMBER PLAQUE
- T-44 04/09/2014 MILEMARKER DETAILS STATE AND TOWN HIGHWAYS
- T-55 10/26/2015 SIGN PLACEMENT EXPRESSWAY & FREEWAY
- S-360A 04/23/2012 BRIDGE RAILING, GALVANIZED 2 RAIL BOX BEAM
- S-360B 04/23/2012 GUARDRAIL APPROACH SECTION, GALVANIZED 2 RAIL BOX BEAM
- S-391 01/16/2014 SNOW BARRIER

LRFR LOAD RATING FACTORS							
LOADING LEVELS	TRUCK						
	H-20	HL-93	3S2	6 AXLE	3A. STR.	4A. STR.	5A. SEMI
TONNAGE	20	36	36	66	30	34.5	38
INVENTORY	1.17	0.86					
POSTING							
OPERATING	1.52	1.11	2.48	1.46	2.10	2.15	2.21
COMMENTS:	H-20 AND 3A. STR. TRUCKS CONTROLLED BY DECK RATING, OTHER TRUCKS CONTROLLED BY GIRDER RATING. HL-93 INVENTORY RATING IS LESS THAN 1.00 FOR MOMENT.						

PROJECT NOTES

GENERAL


- 1. ALL MATERIALS AND CONSTRUCTION SHALL CONFORM TO STATE OF VERMONT, AGENCY OF TRANSPORTATION, 2011 STANDARD SPECIFICATIONS FOR CONSTRUCTION, AND ITS LATEST REVISIONS, AND THE AASHTO LRFD BRIDGE DESIGN SPECIFICATIONS, DATED 2014, AND ITS LATEST REVISIONS.
- 2. THE DESIGN LIVE LOAD SHALL BE HL-93.
- 3. ALL WORK AND ANY ASSOCIATED ACTIVITY ON THIS PROJECT SHALL BE PERFORMED WITHIN THE EXISTING RIGHT-OF-WAY LIMITS.
- 4. THE CONTRACTOR IS MADE AWARE THAT EXISTING UTILITIES MAY EXIST WITHIN THE CONSTRUCTION LIMITS OF BRIDGE NO. 107N. THE LOCATION OF ANY UTILITY INFORMATION ON THE PLANS IS APPROXIMATE. NO CLAIMS ARE MADE TO THE ACCURACY OR COMPLETENESS OF THE UTILITIES SHOWN. THE CONTRACTOR IS SOLELY RESPONSIBLE FOR LOCATING AND PROTECTING FROM DAMAGE ALL UTILITIES ON SITE DURING ALL STAGES OF CONSTRUCTION. ANY DAMAGE TO UTILIES DUE DIRECTLY TO THE CONTRACTOR'S OPERATIONS SHALL BE REPAIRED AS DIRECTED BY THE ENGINEER AT NO ADDITIONAL COST TO THE STATE. SEE SPECIAL PROVISIONS FOR ADDITIONAL INFORMATION AND REQUIREMENTS.
- 5. FOLLOWING THE COMPLETION OF ALL OTHER CONSTRUCTION ACTIVITIES, ALL BEAM SEATS SHALL BE CLEANED OFF. THE COST FOR CLEANING BEAM SEATS WILL BE CONSIDERED INCIDENTAL TO ALL OTHER ITEMS IN THE CONTRACT.
- 6. ANY DAMAGE TO PRIVATE OR PUBLIC PROPERTY DUE DIRECTLY TO THE CONTRACTOR'S OPERATIONS SHALL BE REPAIRED AS DIRECTED BY THE ENGINEER AT NO ADDITIONAL COST TO THE STATE.
- 7. LIMITS OF GROUND SURVEY ARE BETWEEN STA 8607+24 AND STA 8612+61. OUTSIDE THESE LIMITS ARE APPROXIMATE LOCATIONS TAKEN FROM AERIAL MAPPING.
- 8. THE CONTRACTOR SHALL REVIEW AND UNDERSTAND ALL APPLICABLE ENVIRONMENTAL PERMITS AND ENSURE THAT ALL CONSTRUCTION CONDITIONS ARE MET.
- 9. EROSION CONTROL MEASURES SHALL BE UTILIZED AS REQUIRED AND SHALL CONFORM TO SECTION 105 OF THE STANDARD SPECIFICATIONS AND THE LOW RISK SITE HANDBOOK FOR EROSION PREVENTION AND SEDIMENT CONTROL FROM THE AGENCY OF NATURAL RESOURCES. PAYMENT FOR EROSION CONTROL MEASURES, IF APPLICABLE, WILL BE PAID FOR AS EXTRA WORK IN ACCORDANCE WITH 104.03.
- 10. THE CONTRACTOR SHALL PREVENT ANY MATERIAL FROM ENTERING THE WATERWAY, RAILROAD, OR ROADWAY DURING EXCAVATION, PARTIAL REMOVAL OF STRUCTURE, OR CONSTRUCTING THE NEW DECK.
- 11. THE DESIGN INTENT IS TO ALLOW THE CONTRACTOR TO STAGE IN THE LANE CLOSURES OF THE TRAVELED ROADWAY OF THE APPROACHES TO THE BRIDGE. ANY STAGING AREAS OUTSIDE OF THIS SHALL BE CLEARED FOR RESOURCES THROUGH THE VTRANS ENVIRONMENTAL UNIT.

TRAFFIC CONTROL

- 12. SEE TRAFFIC CONTROL SHEET 1 FOR TRAFFIC CONTROL NOTES.

DECK REMOVAL AND RELATED ITEMS

- 13. ITEM 529.20, "PARTIAL REMOVAL OF STRUCTURE" WILL INCLUDE REMOVAL OF ANY PORTIONS OF THE EXISTING STRUCTURE AS SHOWN ON THE PLANS, INCLUDING THE EXISTING BRIDGE DECK AND CURBS, SCUPPERS, BARRIER MEMBRANE, PAVEMENT, AND BRIDGE RAILING, EXCEPT AS NOTED ON SHEET 25. ITEM 529.25, "REMOVAL OF CONCRETE OR MASONRY" WILL INCLUDE REMOVAL OF THE EXISTING CONCRETE CURBS ALONG THE TOPS OF THE WINGWALLS. ITEM 525.10, "REMOVAL OF EXISTING BRIDGE RAILING" WILL INCLUDE REMOVAL OF THE EXISTING BRIDGE RAIL ALONG THE TOP OF THE WINGWALLS. SEE BITUMINOUS CONCRETE/ CONCRETE REMOVAL DETAIL ON SHEET 25.
- 14. THE TOPS OF THE EXISTING WINGWALLS SHALL BE REMOVED BY MECHANICAL MEANS AND THE REMAINING CONCRETE SHALL HAVE NEAT LINES AND BE SMOOTH. PROTECT ALL ELEMENTS INTENDED TO REMAIN.
- 15. AFTER REMOVAL OF THE EXISTING BRIDGE DECK, ANY AREAS ON THE CONCRETE BEAM SEAT THAT ARE FOUND TO BE UNSOUND SHALL BE BROUGHT TO THE ATTENTION OF THE ENGINEER. THE METHOD FOR DETERMINING AREAS OF UNSOUND CONCRETE SHALL BE APPROVED BY THE ENGINEER. THE ENGINEER SHALL MAKE A DETERMINATION AS TO HOW TO REPAIR THE DETERIORATED PORTION OF THE CONCRETE BEAM SEAT AND THE LIMITS OF THE REPAIR. THE REPAIRS WILL BE PAID FOR UNDER ITEM 580.13, "REPAIR OF CONCRETE SUBSTRUCTURE SURFACE, CLASS 1" OR ITEM 580.14, "REPAIR OF CONCRETE SUBSTRUCTURE SURFACE, CLASS 11, AS APPLICABLE. QUANTITIES FOR ITEMS 580.13 AND 580.14 AS SHOWN ON THE QUANTITY SUMMARY SHEETS ARE ESTIMATED.
- 16. THE EXISTING STEEL AND HARDWARE FOR THE FINGER JOINT AT PIER #4 AND THE COMPRESSION JOINT AT ABUTMENT #4 SHALL REMAIN IN-PLACE DURING DECK REMOVAL OPERATIONS AS SHOWN ON SHEET 20, AND THE EXISTING STEEL SHALL BE CLEANED OF REMAINING CONCRETE OR LATENT MATERIAL. PAYMENT FOR THIS WORK WILL BE CONSIDERED INCIDENTAL TO ITEM 529.20, "PARTIAL REMOVAL OF STRUCTURE". IF REMOVAL OF THE JOINT HARDWARE IS DETERMINED TO BE REQUIRED BY THE CONTRACTOR TO FACILITATE THE WORK, THE COST FOR THE REMOVAL OF THE HARDWARE WILL BE CONSIDERED INCIDENTAL TO ITEM 529.20, "PARTIAL REMOVAL OF STRUCTURE". RESETTNG THE HARDWARE WILL BE CONSIDERED INCIDENTAL TO ITEM 501.33, "CONCRETE, HIGH PERFORMANCE CLASS A".
- 17. MINOR REPAIRS TO THE EXISTING COMPRESSION JOINT HARDWARE AT ABUTMENT #4, SPECIFICALLY TO THE STEEL ANGLES ALONG THE LENGTH OF THE JOINT AND ANY OTHER MINOR DAMAGE TO STEEL HARDWARE, MAY BE REQUIRED. ANY AREAS OF THE EXISTING JOINT HARDWARE THAT ARE FOUND TO BE MISSING OR DAMAGED SHALL BE BROUGHT TO THE ATTENTION OF THE ENGINEER. THE ENGINEER SHALL MAKE A DETERMINATION AS TO HOW TO REPAIR THE DAMAGED HARDWARE IN ACCORDANCE WITH THE PROVISIONS OF SECTION 506 AND THE LIMITS OF THE REPAIR. ANY REPAIRS SHALL BE MADE WITH GRADE A36 STEEL AND SHALL BE GALVANIZED. THE GALVANIZING OF THE NEW STEEL SHALL BE REPAIRED PER SUBSECTION 726.08, IF APPLICABLE. THE REPAIRS TO THE JOINT WILL BE PAID FOR UNDER ITEM 506.60, "STRUCTURAL STEEL". AN ESTIMATED QUANTITY FOR ITEM 506.60 IS SHOWN IN THE QUANTITY SUMMARY SHEETS.
- 18. THE COMPRESSION JOINT SEAL AT ABUTMENT #4 SHALL BE REMOVED AND REPLACED. THIS WORK WILL BE PAID FOR UNDER ITEM 900.640, "SPECIAL PROVISION (REMOVE AND REPLACE COMPRESSION JOINT SEAL)".

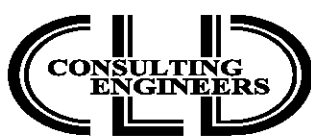

PROJECT NAME: IRASBURG	
PROJECT NUMBER: IM DECK(46)	
FILE NAME: z15all6notes-107N.dgn	PLOT DATE: 3/8/2016
PROJECT LEADER: J. BYATT	DRAWN BY: M. SMITH
DESIGNED BY: S. BEAUMONT	CHECKED BY: J. BYATT
INDEX OF SHEETS & PROJECT NOTES SHEET 1 SHEET 2 OF 49	

STEEL

19. AFTER ALL PAVEMENT AND MEMBRANE ARE REMOVED BUT PRIOR TO THE REMOVAL OF THE EXISTING CONCRETE DECK, THE CONTRACTOR SHALL TAKE TOP OF DECK ELEVATIONS ALONG THE CENTERLINE OF EACH BEAM AT TENTH POINTS FROM CENTERLINE TO CENTERLINE OF BEARING. AFTER THE EXISTING CONCRETE DECK HAS BEEN REMOVED, THE CONTRACTOR SHALL TAKE ELEVATIONS ALONG THE TOP OF EACH BEAM AT TENTH POINTS FROM CENTERLINE TO CENTERLINE OF BEARING. THE TOP OF DECK AND TOP OF BEAM ELEVATIONS SHALL THEN BE SENT TO THE ENGINEER FOR USE IN DETERMINING THE FINAL PROFILE AND HAUNCH DEPTHS. THE CONTRACTOR SHALL EXPECT 3 WORKING DAYS FOR VTRANS TO PREPARE THE REVISED PROFILE AND HAUNCH DEPTH CALCULATIONS.
20. THE EXISTING STRUCTURAL STEEL IS PAINTED WITH A MATERIAL THAT MAY CONTAIN LEAD. THE CONTRACTOR SHALL FOLLOW ALL APPLICABLE REGULATIONS WHEN HANDLING AND WORKING WITH THIS STEEL. ANY REMOVED STRUCTURAL STEEL, IF APPLICABLE, IS THE PROPERTY OF THE CONTRACTOR. THE CONTRACTOR SHALL INDEMNIFY AND HOLD THE STATE AND ITS OFFICERS AND EMPLOYEES HARMLESS CONCERNING THE CONTRACTOR'S USE OR DISPOSITION OF THE REMOVED EXISTING STRUCTURAL STEEL.
21. NEW BRIDGE SCUPPERS WILL BE PROVIDED AT THE SAME LOCATIONS AS THE REMOVED SCUPPERS. THE NEW SCUPPERS WILL BE PAID FOR UNDER ITEM 900.620, "SPECIAL PROVISION (BRIDGE SCUPPER)".

REINFORCED CONCRETE

22. ALL CONCRETE SHALL CONFORM TO THE SPECIFICATIONS FOR CONCRETE, HIGH PERFORMANCE CLASS A. THE CONTRACTOR SHALL PROVIDE TESTING EQUIPMENT FOR CONCRETE IN ACCORDANCE WITH SUBSECTION 631.05.
23. ALL REINFORCING STEEL SHALL BE LEVEL I - EPOXY COATED AND MEET THE REQUIREMENTS OF SECTION 507. A REINFORCING STEEL SCHEDULE AND SHOP DRAWINGS MEETING THE REQUIREMENTS OF SUBSECTION 105.03 SHALL BE SUBMITTED. PAYMENT FOR THIS WORK WILL BE CONSIDERED INCIDENTAL TO ITEM 507.11, "REINFORCING STEEL, LEVEL I".
24. TEST BARS SHALL BE PROVIDED IN ACCORANCE WITH THE "VERMONT AGENCY OF TRANSPORTATION MATERIAL SAMPLING MANUAL" AVAILABLE ON THE AGENCY WEBSITE. A MINIMUM OF TWO TEST SECTIONS ARE REQUIRED FOR EACH SIZE, BRAND, AND GRADE OR TYPE OF REINFORCING. SEE THE MANUAL FOR ACCEPTABLE DIMENSIONS OF TEST SECTIONS. EXTRA BARS FOR TESTING PURPOSES SHALL BE SPECIFIED IN THE WORKING DRAWING SUBMITTAL.
25. EPOXY COATED REINFORCING STEEL PROJECTING FROM THE DECK DURING CONSTRUCTION SHALL BE COVERED WITH CANVAS OR OTHER SUITABLE MATERIAL THAT WILL EFFECTIVELY PROTECT IT AGAINST DAMAGE FROM SUNLIGHT AND WEATHER EXPOSURE UNTIL IT WILL BE ENCASED IN CONCRETE. PAYMENT FOR THIS WORK WILL BE CONSIDERED INCIDENTAL TO ITEM 507.11, "REINFORCING STEEL, LEVEL I".
26. WATER REPELLENT, SILANE SHALL BE APPLIED TO ALL EXPOSED CONCRETE BRIDGE DECK SURFACES EXCEPT THE UNDERSIDE OF THE DECK BETWEEN THE DRIP NOTCHES. THIS WORK WILL BE PAID FOR UNDER ITEM 514.10, "WATER REPELLENT, SILANE".
27. ALL REINFORCING STEEL SHALL BE DETAILED AND FABRICATED USING PROCEDURES AND TOLERANCES IN ACCORDANCE WITH APPLICABLE PUBLICATIONS OF THE "CONCRETE REINFORCING INSTITUTE".
28. MINIMUM CLEAR COVER FOR REINFORCING STEEL SHALL BE AS FOLLOWS:

ALONG BACKFACES OF WALL AGAINST EARTH:	2.0 INCH
ALONG TOP SURFACE OF DECK SLAB:	2.5 INCH
ALONG BOTTOM SURFACE OF DECK SLAB:	1.5 INCH
ELSEWHERE UNLESS OTHERWISE INDICATED:	3.0 INCH

PAVEMENT REMOVAL AND DECK REPAIRS


29. PAVEMENT REMOVAL SHOULD BE LIMITED TO WHAT IS SHOWN ON THE PLANS. ALTHOUGH THE INTENT OF THE PLANS IS TO REMOVE AND REPLACE THE CONCRETE BRIDGE DECK FOR THE ENTIRE BRIDGE LENGTH, THE ENGINEER HAS THE OPTION TO MAINTAIN THE EXISTING SPAN I CONCRETE BRIDGE DECK IF THE CONCRETE APPEARS TO BE IN GOOD CONDITION WITH MINIMAL AREAS OF UNSOUND CONCRETE. THEREFORE, PAVEMENT AND MEMBRANE REMOVAL ON SPAN #1 SHALL BE REQUIRED PRIOR TO BRIDGE DECK REMOVAL OPERATIONS. THIS WORK SHALL BE IN ACCORDANCE WITH SECTION 529 OF THE STANDARD SPECIFICATIONS.
30. THE FINAL ONE HALF INCH OF PAVEMENT ON SPAN #1 OF THE CONCRETE BRIDGE DECK AND THE AT-GRADE APPROACH SLABS SHALL BE REMOVED BY LOADER, GRADER OR EQUIPMENT APPROVED BY THE ENGINEER. COLD PLANING TO REMOVE BRIDGE PAVEMENT WILL BE CONSIDERED INCIDENTAL TO ITEM 529.10, "REMOVAL OF BRIDGE PAVEMENT".
31. DURING BRIDGE AND AT-GRADE APPROACH SLAB PAVEMENT REMOVAL, THE CONTRACTOR SHALL EXERCISE CARE TO ENSURE THAT NO DAMAGE OCCURS TO SPAN #1 OF THE EXISTING CONCRETE BRIDGE DECK AND THE EXISTING AT-GRADE APPROACH SLABS. ANY DAMAGE TO SPAN #1 OF THE CONCRETE BRIDGE DECK OR AT-GRADE APPROACH SLABS SHALL BE REPAIRED AT THE CONTRACTOR'S EXPENSE. REPAIRS, IF APPLICABLE, SHALL BE MADE IN ACCORDANCE WITH SECTION 580.
32. THE AT-GRADE APPROACH SLABS AND SPAN I OF THE CONCRETE BRIDGE DECK (IF APPLICABLE) SHALL BE CLEANED IN ACCORDANCE WITH SUBSECTION 580.04 AND TO THE SATISFACTION OF THE ENGINEER. REMOVAL OF THE BARRIER MEMBRANE AND THE CLEANING OF THE AT-GRADE APPROACH SLABS AND SPAN #1 OF THE CONCRETE BRIDGE DECK WILL BE PAID FOR UNDER ITEM 580.16, "SURFACE PREPARATION FOR MEMBRANE".
33. ONCE THE EXISTING PAVEMENT AND MEMBRANE ARE REMOVED FROM THE SPAN #1 CONCRETE BRIDGE DECK, ANY AREAS THAT ARE FOUND TO BE UNSOUND SHALL BE BROUGHT TO THE ATTENTION OF THE ENGINEER. THE METHOD FOR DETERMINING AREAS OF UNSOUND CONCRETE SHALL BE APPROVED BY THE ENGINEER. THE ENGINEER SHALL MAKE A DETERMINATION AS TO WHETHER THE EXISTING SPAN #1 CONCRETE BRIDGE DECK SHOULD BE REPLACED OR REPAIRED. IF THE DECK IS TO BE REPLACED, BRIDGE DECK REMOVAL OPERATIONS SHALL COMMENCE. IF THE DECK IS TO BE MAINTAINED, THE ENGINEER SHALL MAKE A DETERMINATION AS TO HOW TO REPAIR THE DETERIORATED PORTION OF THE DECK AND THE LIMITS OF THE REPAIR. THE REPAIRS WILL BE PAID FOR UNDER ITEM 580.10, "REPAIR OF CONCRETE SUPERSTRUCTURE SURFACE, CLASS I", ITEM 580.11, "REPAIR OF CONCRETE SUPERSTRUCTURE SURFACE, CLASS II", OR ITEM 580.12, "REPAIR OF CONCRETE SUPERSTRUCTURE SURFACE, CLASS III". QUANTITIES FOR ITEMS 580.10, 580.11, AND 580.12 AS SHOWN ON THE QUANTITY SUMMARY SHEETS ARE ESTIMATED AND INCLUDED IN THE CONTRACT IN THE EVENT THE SPAN IS MAINTAINED.
34. ONCE THE EXISTING PAVEMENT AND MEMBRANE ARE REMOVED FROM THE AT-GRADE APPROACH SLABS, ANY AREAS THAT ARE FOUND TO BE UNSOUND SHALL BE BROUGHT TO THE ATTENTION OF THE ENGINEER. THE METHOD FOR DETERMINING AREAS OF UNSOUND CONCRETE SHALL BE APPROVED BY THE ENGINEER. THE ENGINEER SHALL MAKE A DETERMINATION AS TO HOW TO REPAIR THE DETERIORATED PORTION OF THE AT-GRADE APPROACH SLABS AND THE LIMITS OF THE REPAIR. THE REPAIRS WILL BE PAID FOR UNDER ITEM 580.10, "REPAIR OF CONCRETE SUPERSTRUCTURE SURFACE, CLASS I", ITEM 580.11, "REPAIR OF CONCRETE SUPERSTRUCTURE SURFACE, CLASS II", OR ITEM 580.12, "REPAIR OF CONCRETE SUPERSTRUCTURE SURFACE, CLASS III". QUANTITIES FOR ITEMS 580.10, 580.11, AND 580.12 AS SHOWN ON THE QUANTITY SUMMARY SHEETS ARE ESTIMATED.

PAVEMENT AND MEMBRANE


35. UPON THE ENGINEER'S APPROVAL OF THE CONCRETE BRIDGE DECK'S CONDITION, ITEM 519.20, "SHEET MEMBRANE WATERPROOFING, TORCH APPLIED" SHALL BE INSTALLED IN ACCORDANCE WITH SECTION 519. THE CONTRACTOR SHALL NOT INSTALL ITEM 519.20, "SHEET MEMBRANE WATERPROOFING, TORCH APPLIED" WHEN THE DECK CONCRETE AND/OR DECK PATCH AREAS' MOISTURE CONTENT IS ABOVE SECTION 519 SPECIFICATIONS OR MANUFACTURER'S SPECIFICATIONS, WHICHEVER IS LESS.
36. TRAFFIC WILL BE ALLOWED TO DRIVE ON THE BARE CONCRETE DECK PRIOR TO THE DECK BEING CLEANED AND PREPARED FOR THE NEW SHEET MEMBRANE. ONCE THE CONCRETE BRIDGE DECK IS PREPARED FOR THE NEW SHEET MEMBRANE, NO TRAFFIC WILL BE ALLOWED ON THE NEW MEMBRANE UNTIL THE SECOND LIFT OF BITUMINOUS CONCRETE PAVEMENT IS IN PLACE.
37. FOLLOWING THE INSTALLATION OF THE NEW SHEET MEMBRANE WATERPROOFING ON THE CONCRETE BRIDGE DECK, THE SOUTHERN ROADWAY APPROACH, CONCRETE BRIDGE DECK, AND AT-GRADE APPROACH SLAB #5 SHALL BE PAVED CURB TO CURB WITH ITEM 900.680, "SPECIAL PROVISION (BITUMINOUS CONCRETE PAVEMENT - BRIDGE MIX - TYPE IVB)" WITH ONE ¾" SHIM AND ONE 1¾" LIFT. THE TOP LIFT SHALL TAPER TO 1½" AT THE PIER #4 FINGER JOINT AND THE ABUTMENT #4 COMPRESSION JOINT TO ACCOMMODATE THE EXISTING STEEL PLATES AND HARDWARE. SEE JOINT DETAILS SHEET I ON SHEET 21 FOR TAPER LOCATIONS. AT-GRADE APPROACH SLAB #6 AND THE NORTHERN ROADWAY APPROACH SHALL BE PAVED CURB TO CURB WITH ITEM 900.680, "SPECIAL PROVISION (BITUMINOUS CONCRETE PAVEMENT - BRIDGE MIX - TYPE IVB)" WITH ONE ¾" SHIM AND ONE 1½" LIFT.
38. THE GRADE OF PG ASPHALT BINDER USED TO PRODUCE BITUMINOUS CONCRETE PAVEMENT SHALL BE 58-28. SUBSTITUTIONS WILL BE ACCEPTED BASED ON AVAILABILITY WHERE THE UPPER END TEMPERATURE VALUE IS GREATER THAN 58°C (136°F) AND/OR THE LOWER END TEMPERATURE VALUE IS LESS THAN -28°C (-18°F).
39. CARE SHALL BE EXERCISED TO SMOOTHLY TRANSITION THE NEW BRIDGE PAVEMENT INTO THE EXISTING PAVEMENT. ANY COLD PLANING NECESSARY FOR SHAPING BRIDGE APPROACHES WILL BE PAID FOR UNDER ITEM 210.10, "COLD PLANING, BITUMINOUS PAVEMENT".
40. ANY REQUIRED SAWCUT OF EXISTING PAVEMENT WILL BE CONSIDERED INCIDENTAL TO ITEM 900.680, "SPECIAL PROVISION (BITUMINOUS CONCRETE PAVEMENT - BRIDGE MIX - TYPE IVB)".
41. EMULSIFIED ASPHALT SHALL BE APPLIED AT A RATE OF 0.08 GAL/SY TO ALL COLD PLANED SURFACES AND AT A RATE OF 0.04 GAL/SY BETWEEN PAVEMENT LIFTS OR AS DIRECTED BY THE ENGINEER. EMULSIFIED ASPHALT WILL BE PAID FOR UNDER ITEM 404.65, "EMULSIFIED ASPHALT".
42. UPON COMPLETION OF ALL PAVING OPERATIONS, FINAL PAVEMENT MARKINGS SHALL BE INSTALLED TO REPLICATE THE EXISTING CONFIGURATION.
43. DURABLE PAVEMENT MARKINGS ARE OPTIONED AS SHOWN ON THE PLAN SHEETS FOR THIS PROJECT. THE CONTRACTOR SHALL BID THE SAME MARKING MATERIAL FOR ALL OPTION ITEMS.



REVISION	DATE	DESCRIPTION	BY
1	03-30-2016	ADDING AND CHANGING ITEMS	LG

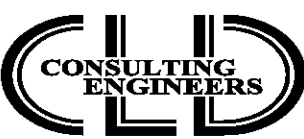


PROJECT NAME: IRASBURG	
PROJECT NUMBER: IM DECK(46)	
FILE NAME: z15dl6notes-107N.dgn	PLOT DATE: 3/28/2016
PROJECT LEADER: J. BYATT	DRAWN BY: M. SMITH
DESIGNED BY: S. BEAUMONT	CHECKED BY: J. BYATT
INDEX OF SHEETS & PROJECT NOTES SHEET 2 SHEET 3 OF 49	

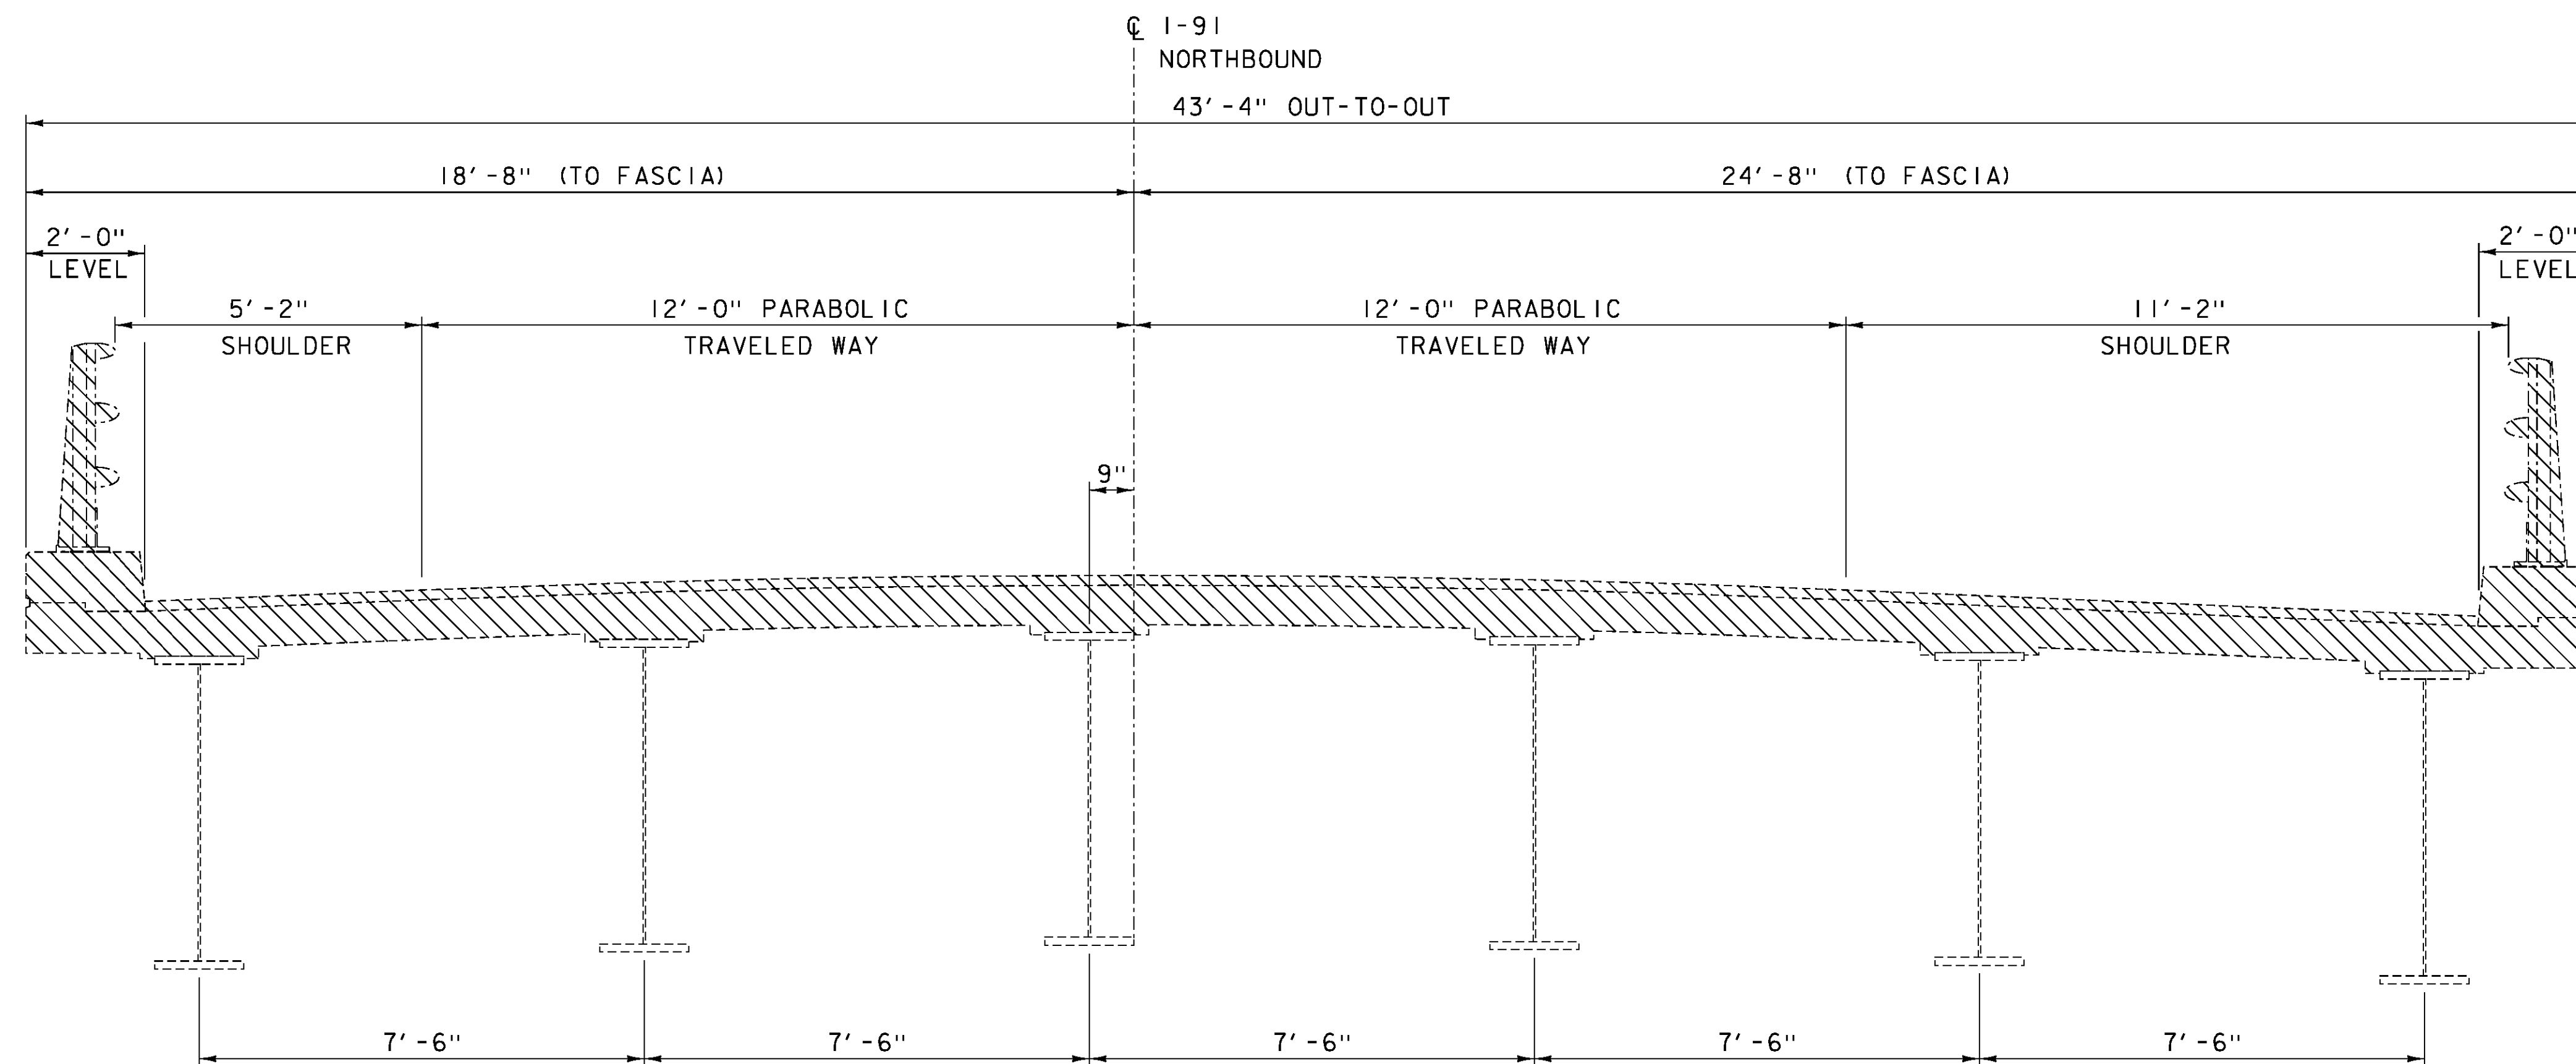

PARTIAL REMOVAL OF STRUCTURE

EXISTING BRIDGE TYPICAL


SCALE: 1/2" = 1'-0"

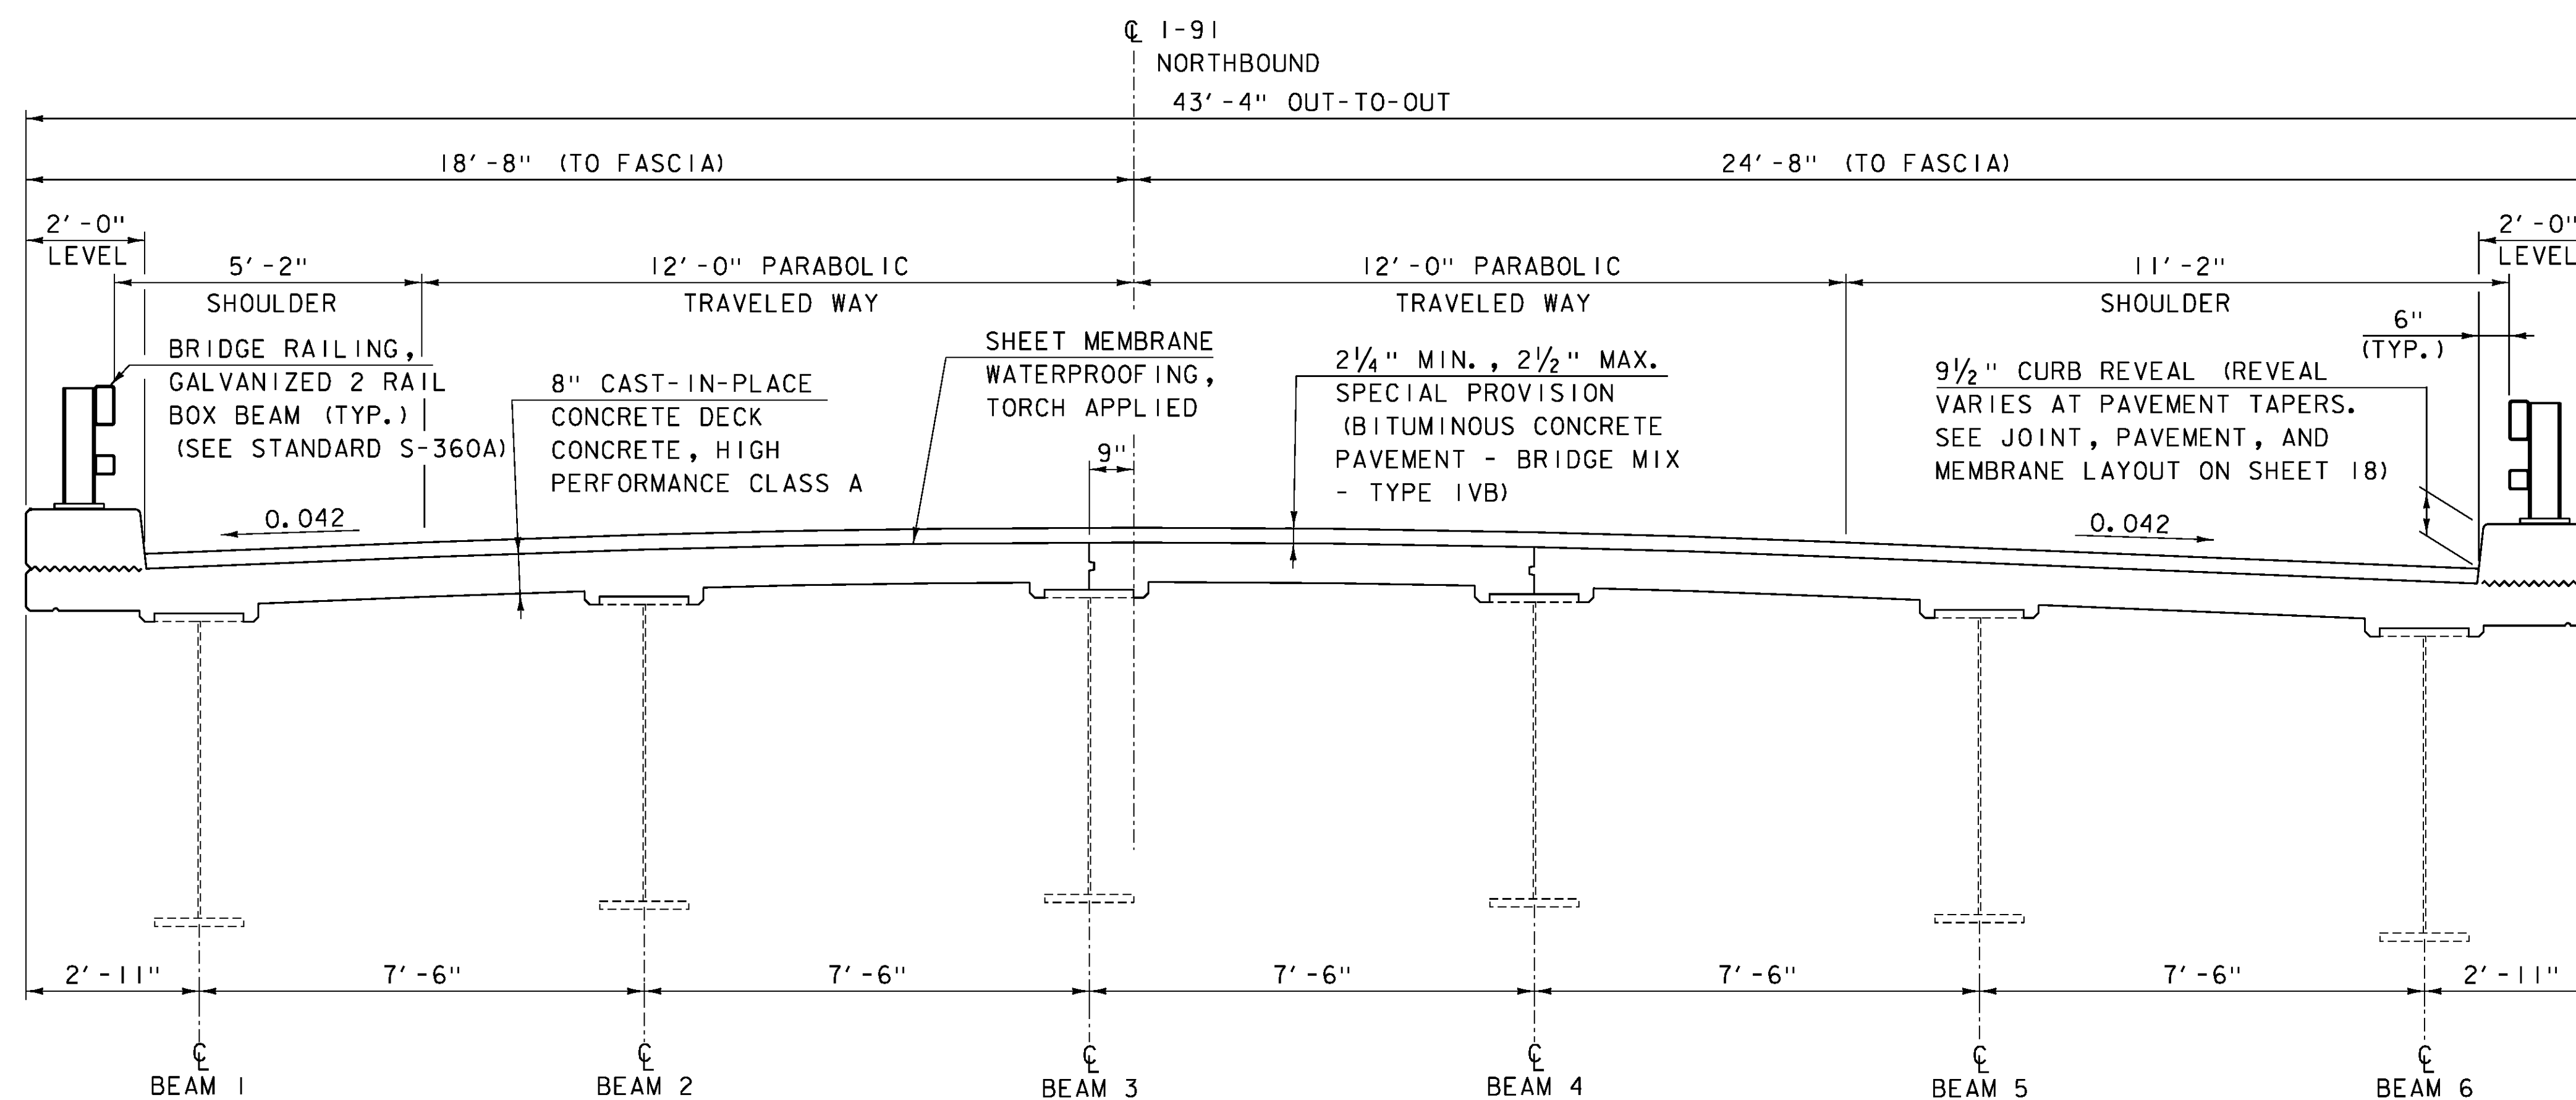

TYPICAL BRIDGE SECTION

(SPANS 2 THROUGH 4)

SCALE: 1/2" = 1'-0"

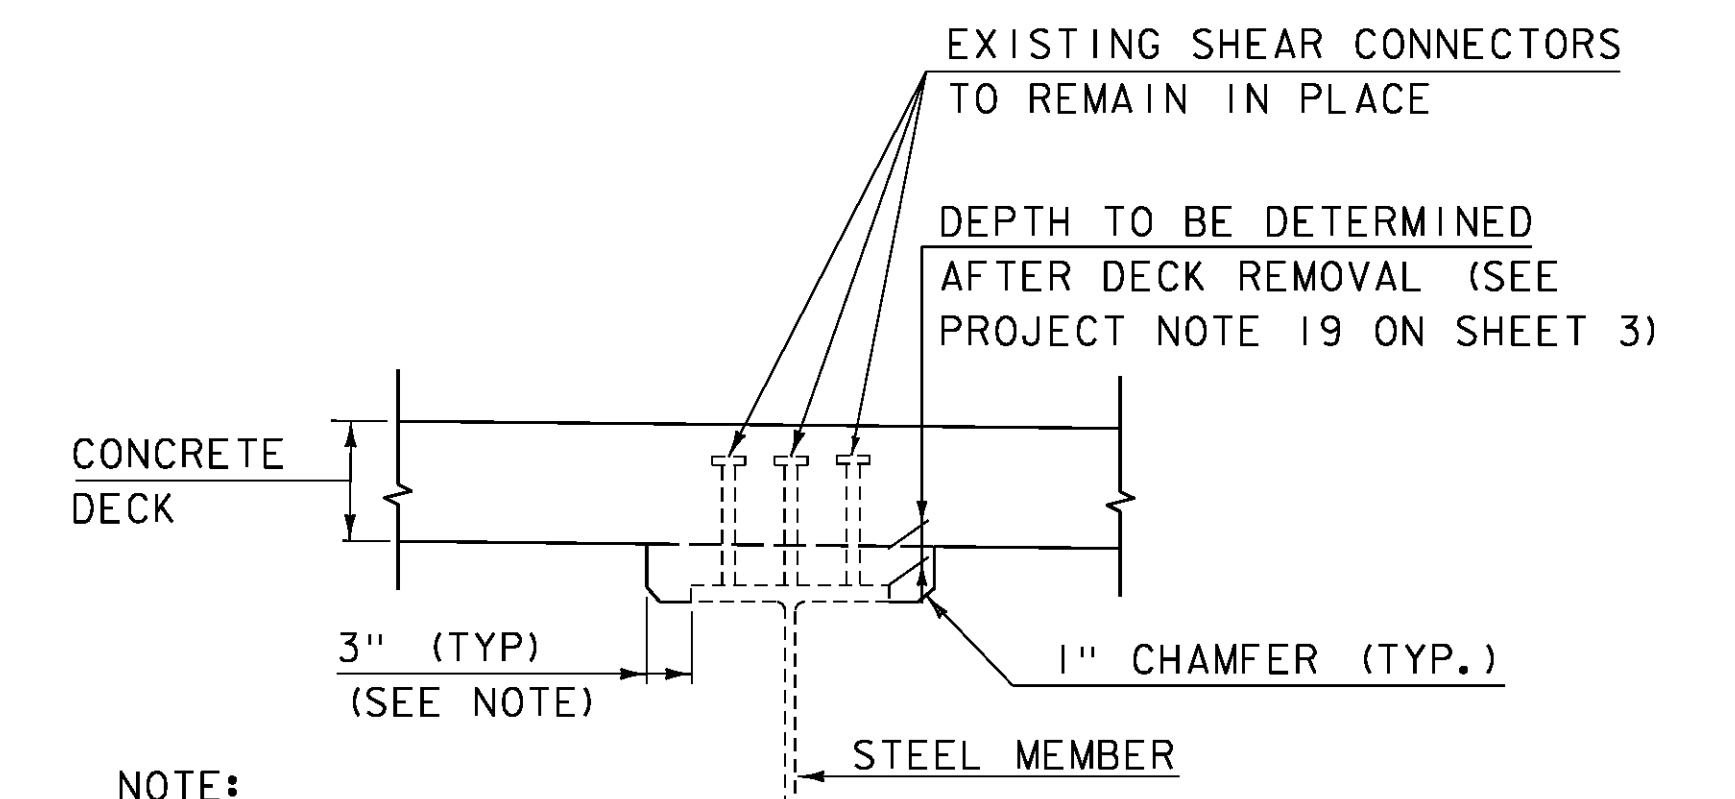


NOTE:

THE 3" HORIZONTAL SECTION MAY BE ELIMINATED FOR FORMING SYSTEMS DESIGNED FOR THE CONSTRUCTION OF VERTICAL HAUNCHES. ANY VOIDS RESULTING FROM FORMING SYSTEM ELEMENTS SHALL BE FILLED WITH JOINT SEALER, POLYURETHANE MEETING THE REQUIREMENTS OF SECTION 524. THE COST OF THE JOINT SEALER, POLYURETHANE WILL BE CONSIDERED INCIDENTAL TO THE ADJACENT CONCRETE ITEM.

HAUNCH AND SHEAR CONNECTOR DETAIL

SCALE: 3/4" = 1'-0"

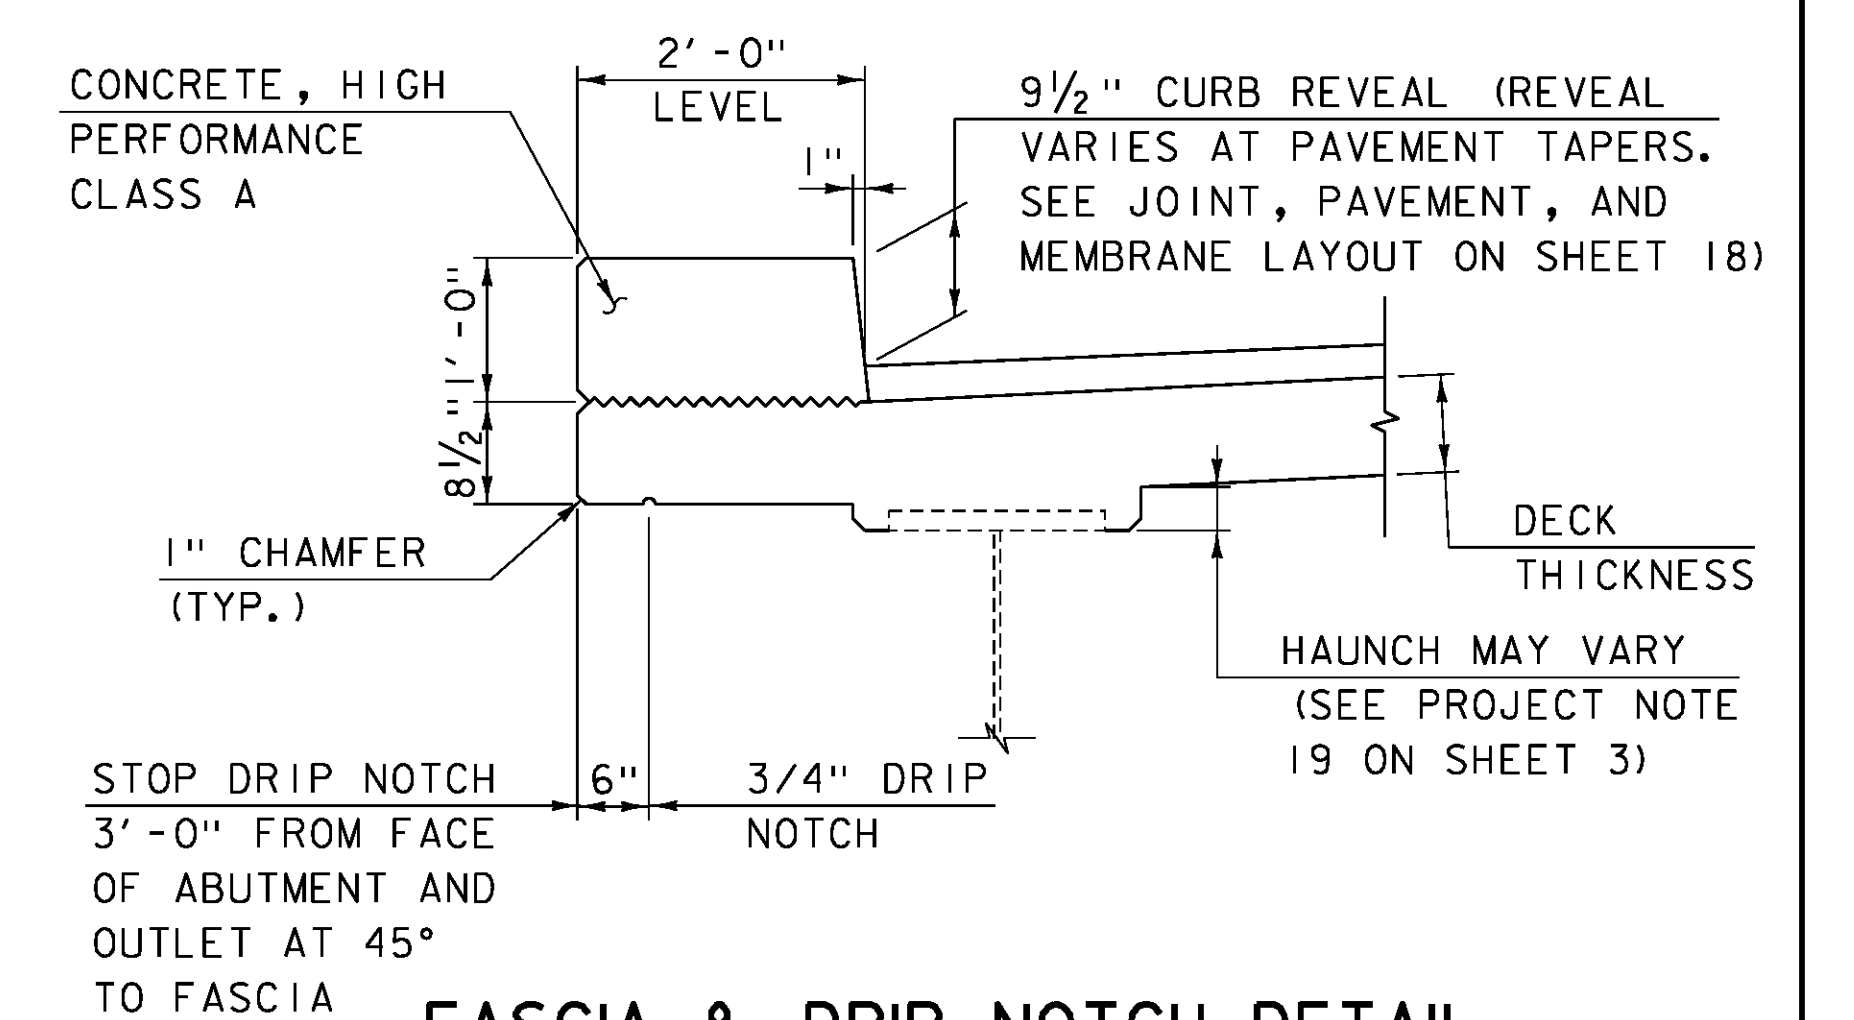

FASCIA & DRIP NOTCH DETAIL


SCALE: 3/4" = 1'-0"

PROJECT NAME: IRASBURG
PROJECT NUMBER: IM DECK(46)


FILE NAME: z15dl16+yp-107N.dgn
PROJECT LEADER: J. BYATT
DESIGNED BY: N. CARON
TYPICAL BRIDGE SECTIONS SHEET

PLOT DATE: 2/5/2016
DRAWN BY: M. SMITH
CHECKED BY: S. BEAUMONT
SHEET 4 OF 49



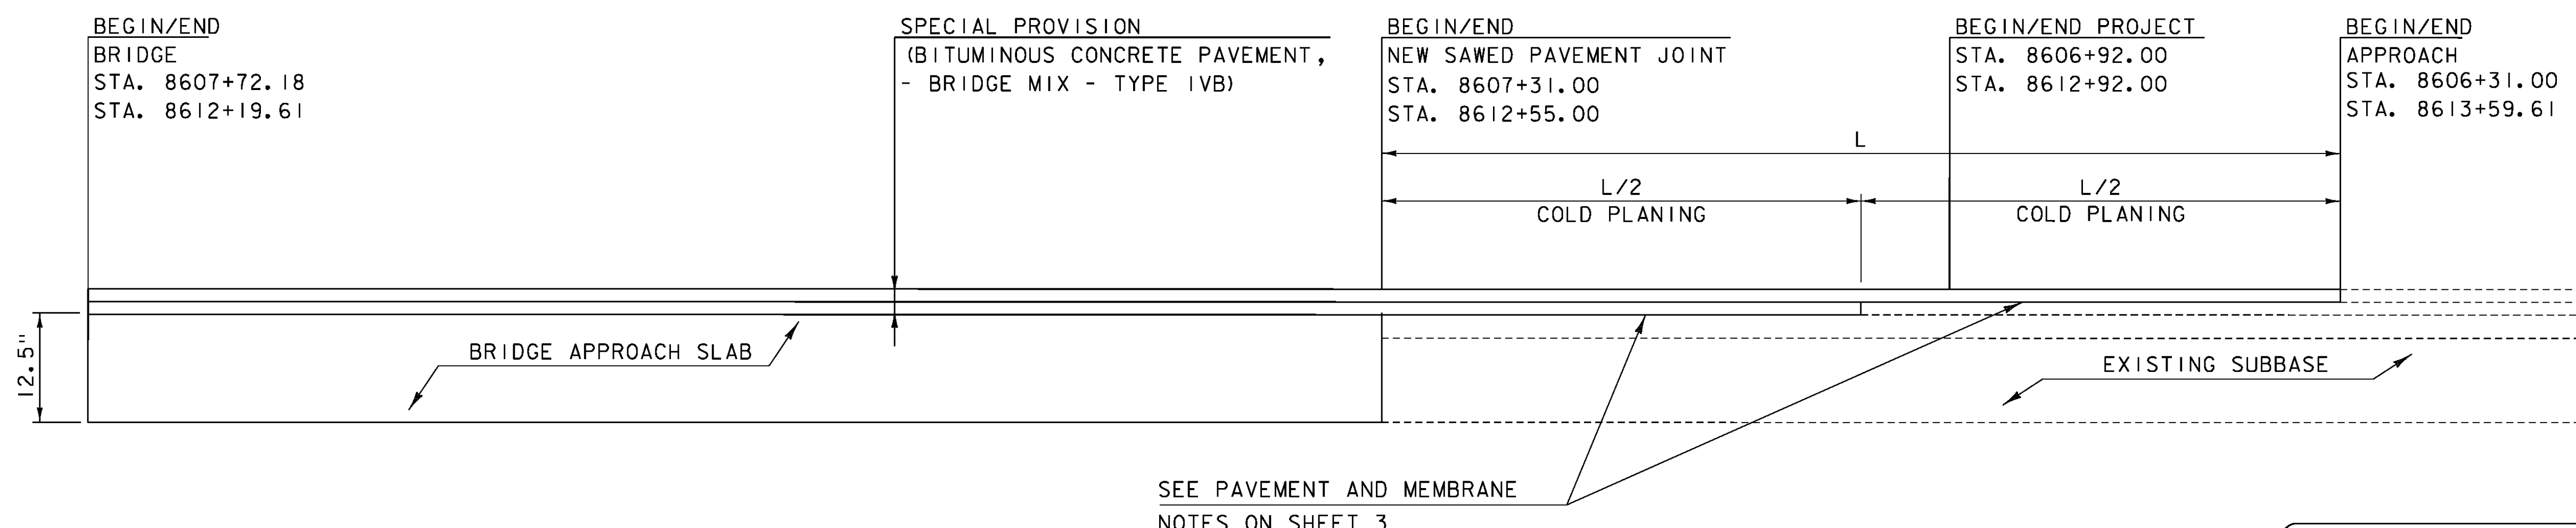

MATERIAL TRANSITION DIAGRAM
NOT TO SCALE

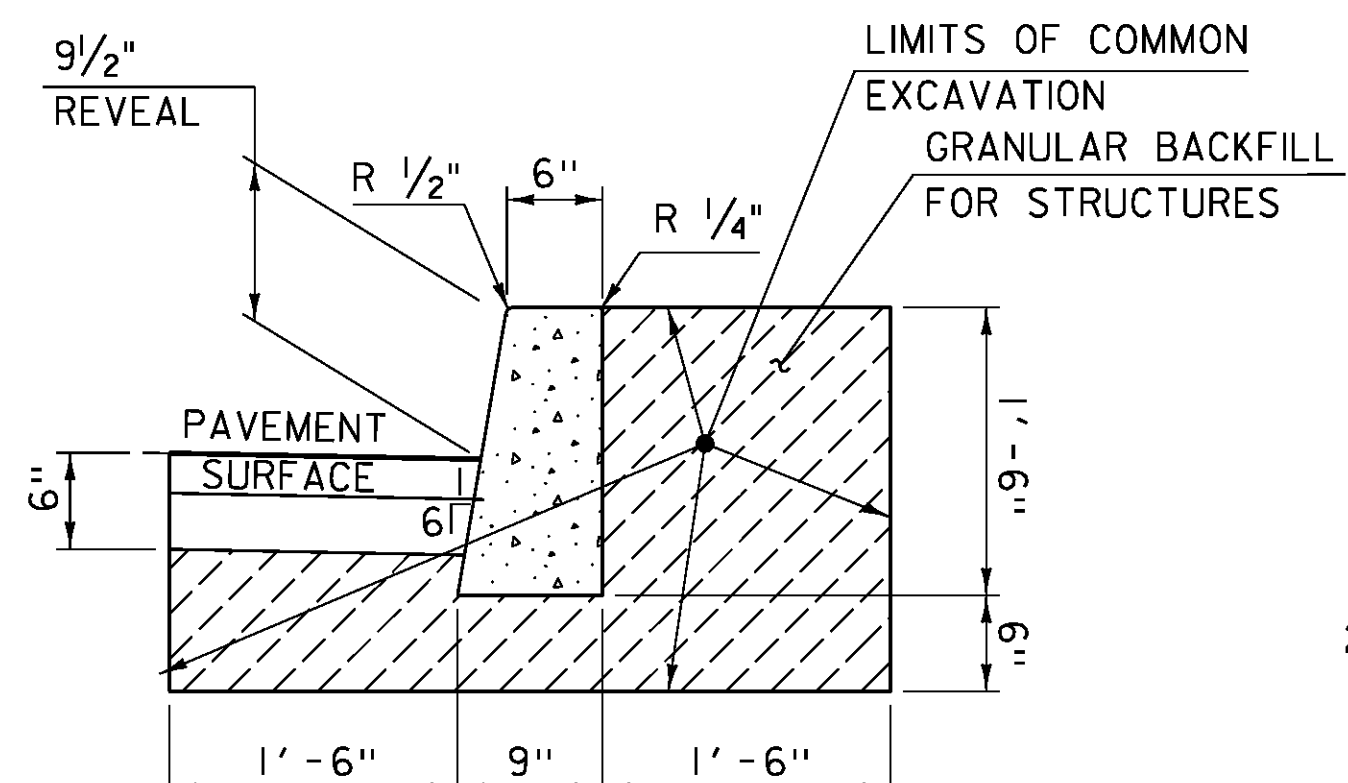


TYPICAL CAST-IN-PLACE CONCRETE CURB, TYPE B EARTHWORKS DETAIL

MATERIAL TOLERANCES	
SURFACE	
- PAVEMENT (TOTAL THICKNESS)	+/- 1/4"
- AGGREGATE SURFACE COURSE	+/- 1/2"

DESIGN NUMBER OF GYRATIONS - 65

NORTHERN APPROACH
2 1/4" SPECIAL PROVISION (BITUMINOUS CONCRETE PAVEMENT - BRIDGE MIX - TYPE IVB) (1 - 1 1/2" LIFT AND 1 - 3/4" SHIM)

SOUTHERN APPROACH
2 1/2" SPECIAL PROVISION (BITUMINOUS CONCRETE PAVEMENT - BRIDGE MIX - TYPE IVB) (1 - 1 3/4" LIFT AND 1 - 3/4" SHIM)

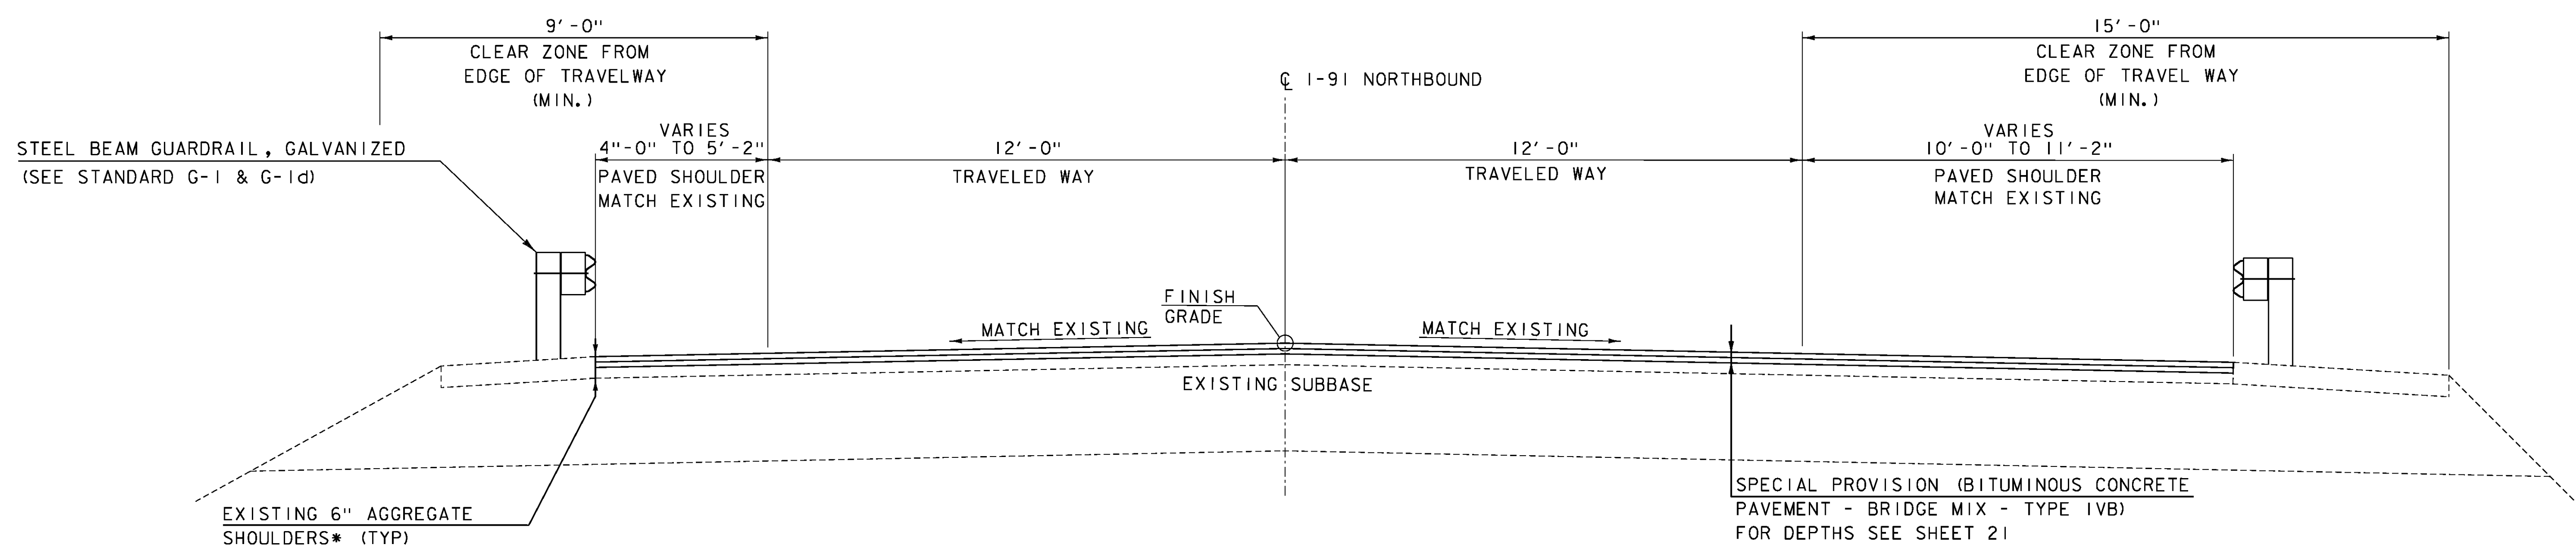


**I-91
TYPICAL SECTION**
SCALE: 1/2" = 1'-0"

NOTE:
IN THE EVENT THAT COLD PLANING OF THE RIGHT ROADWAY SHOULDERS ALONG BRIDGE APPROACHES EXPOSES GRAVEL SUBBASE, THE CONTRACTOR SHALL REMOVE 2" OF GRAVEL SUBBASE, PREPARE THE AREA AS DIRECTED BY THE ENGINEER, AND PROVIDE 2" BASE PAVEMENT. IN ADDITION TO THE PAVEMENT DEPTH TO BE PLACED IN ALL OTHER LOCATIONS PER THE JOINT DETAILS SHEET 1 ON SHEET 21, ADDITIONAL QUANTITIES HAVE BEEN INCLUDED IN THE ESTIMATE UNDER ITEM 900.680, "SPECIAL PROVISION (BITUMINOUS CONCRETE PAVEMENT - BRIDGE MIX - TYPE IVB)" AND ITEM 402.12, "AGGREGATE SHOULDERS" TO ADDRESS THIS WORK. WHERE DETERMINED BY THE ENGINEER, PAYMENT FOR BASE PREPARATION WILL BE CONSIDERED INCIDENTAL TO EQUIPMENT RENTAL ITEMS.

*REPLACE AGGREGATE SHOULDER AS NEEDED, AS DIRECTED BY THE ENGINEER

PROJECT NAME: IRASBURG	PLOT DATE: 3/8/2016
PROJECT NUMBER: IM DECK(46)	DRAWN BY: P. McKECHNIE
FILE NAME: z15dl16+yp-107N.dgn	CHECKED BY: S. FORTIER
PROJECT LEADER: J. BYATT	SHEET 5 OF 49
DESIGNED BY: L. GREER	
TYPICAL ROADWAY SECTIONS SHEET	

MODEL: Sheet 02
CLD 15-0223

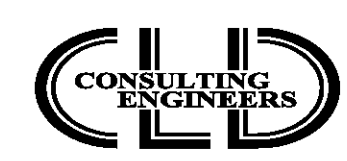

QUANTITY SHEET 1

SUMMARY OF ESTIMATED QUANTITIES												TOTALS		DESCRIPTIONS				DETAILED SUMMARY OF QUANTITIES		
								ROADWAY	EROSION CONTROL	BRIDGE NO. 107N	FULL C.E. ITEMS	GRAND TOTAL	FINAL	UNIT	ITEMS	ITEM NUMBER	ROUND	QUANTITIES	UNIT	ITEMS
								20				20		CY	COMMON EXCAVATION	203.15	4			
								1				1		CY	TRENCH EXCAVATION OF EARTH, EXPLORATORY (N.A.B.I.)	204.22	-			
								15				15		CY	GRANULAR BACKFILL FOR STRUCTURES	204.30	-			
								900				900		SY	COLD PLANING, BITUMINOUS PAVEMENT	210.10	9			
								6				6		TON	AGGREGATE SHOULDERS	402.12	0.8			
								15		23		38		CWT	EMULSIFIED ASPHALT	404.65	3.76			
								1				1		LU	PRICE ADJUSTMENT, ASPHALT CEMENT (N.A.B.I.)	406.50	-			
										618		618		CY	CONCRETE, HIGH PERFORMANCE CLASS A	501.33	0.58			
										500		500		LB	STRUCTURAL STEEL	506.60	EST.			
										184463		184463		LB	REINFORCING STEEL, LEVEL I	507.11	0.52			
										72		72		LF	DRILLING AND GROUTING DOWELS	507.16	-			
										38		38		GAL	WATER REPELLENT, SILANE	514.10	0.65			
										54		54		LF	BRIDGE EXPANSION JOINT, ASPHALTIC PLUG	516.10	0.65			
										1941		1941		SY	SHEET MEMBRANE WATERPROOFING, TORCH APPLIED	519.20	0.28			
										79		79		LF	JOINT SEALER, HOT POURED	524.11	0.33			
										58		58		LF	REMOVAL OF EXISTING BRIDGE RAILING	525.10	0.67			
										952.35		952.35		LF	BRIDGE RAILING, GALVANIZED 2 RAIL BOX BEAM	525.33	-			
										670		670		SY	REMOVAL OF BRIDGE PAVEMENT	529.10	0.87			
										1		1		EACH	PARTIAL REMOVAL OF STRUCTURE	529.20	-			
										5		5		CY	REMOVAL OF CONCRETE OR MASONRY	529.25	1.37			
										10		10		SY	REPAIR OF CONCRETE SUPERSTRUCTURE SURFACE, CLASS I	580.10	EST.			
										25		25		SY	REPAIR OF CONCRETE SUPERSTRUCTURE SURFACE, CLASS II	580.11	EST.			
										3		3		CY	REPAIR OF CONCRETE SUPERSTRUCTURE SURFACE, CLASS III	580.12	EST.			
										15		15		SY	REPAIR OF CONCRETE SUBSTRUCTURE SURFACE, CLASS I	580.13	EST.			
										15		15		SY	REPAIR OF CONCRETE SUBSTRUCTURE SURFACE, CLASS II	580.14	EST.			
										6025		6025		SF	SURFACE PREPARATION FOR MEMBRANE	580.16	2.77			
									5			5		HR	ALL PURPOSE EXCAVATOR RENTAL, TYPE I	608.25	EST.			
									5			5		HR	TRUCK RENTAL	608.37	EST.			
								160				160		LF	CAST-IN-PLACE CONCRETE CURB, TYPE B	616.28	-			
										238		238		LF	SNOW BARRIER	620.75	-			
								112.5				112.5		LF	STEEL BEAM GUARDRAIL, GALVANIZED	621.20	8.5			
								2				2		EACH	ANCHOR FOR STEEL BEAM RAIL	621.60	-			
										4		4		EACH	GUARDRAIL APPROACH SECTION, GALVANIZED 2 RAIL BOX BEAM	621.72	-			
								50				50		LF	REMOVE AND RESET GUARDRAIL	621.75	-			
								190				190		LF	REMOVAL AND DISPOSAL OF GUARDRAIL	621.80	9			
								80				80		HR	UNIFORMED TRAFFIC OFFICERS	630.10	EST.			
								150				150		HR	FLAGGERS	630.15	EST.			
											1	1		LS	FIELD OFFICE, ENGINEERS	631.10	-			
											1	1		LS	TESTING EQUIPMENT, CONCRETE	631.16	-			
											1	1		LS	TESTING EQUIPMENT, BITUMINOUS	631.17	-			

QUANTITY SHEET 2

PROJECT NAME: IRASBURG	
PROJECT NUMBER: IM DECK(46)	
FILE NAME: z15a116qss-107N.dgn	PLOT DATE: 3/28/2016
PROJECT LEADER: J. BYATT	DRAWN BY: M. SMITH
DESIGNED BY: J. FRENCH	CHECKED BY: A. GIRALDI
QUANTITY SHEET 2	SHEET 7 OF 49

GENERAL INFORMATION

SYMBOLGY LEGEND NOTE

THE SYMBOLGY ON THIS SHEET IS INTENDED TO COVER STANDARD CONVENTIONAL SYMBOLGY. THE SYMBOLGY IS USED FOR EXISTING & PROPOSED FEATURES WITH HEAVIER LINEWEIGHT, IN COMBINATION WITH PROJECT ANNOTATION, AS NOTED ON PROJECT PLAN SHEETS. THIS LEGEND SHEET COVERS THE BASICS. SYMBOLGY ON PLANS MAY VARY, PLAN ANNOTATIONS AND NOTES SHOULD BE USED TO CLARIFY AS NEEDED.

R. O. W. ABBREVIATIONS (CODES) & SYMBOLS

POINT	CODE	DESCRIPTION
	CH	CHANNEL EASEMENT
	CONST	CONSTRUCTION EASEMENT
	CUL	CULVERT EASEMENT
	D&C	DISCONNECT & CONNECT
	DIT	DITCH EASEMENT
	DR	DRAINAGE EASEMENT
	DRIVE	DRIVEWAY EASEMENT
	EC	EROSION CONTROL
	HWY	HIGHWAY EASEMENT
	I&M	INSTALL & MAINTAIN EASEMENT
	LAND	LANDSCAPE EASEMENT
	R&RES	REMOVE & RESET
	R&REP	REMOVE & REPLACE
	SR	SLOPE RIGHT
	UE	UTILITY EASEMENT
	(P)	PERMANENT EASEMENT
	(T)	TEMPORARY EASEMENT
■	BNDNS	BOUND SET
▣	BNDNS	BOUND TO BE SET
●	IPNS	IRON PIN SET
⊙	IPNS	IRON PIN TO BE SET
⊠	CALC	EXISTING ROW POINT
○	PROW	PROPOSED ROW POINT
[LENGTH]		LENGTH CARRIED ON NEXT SHEET

COMMON TOPOGRAPHIC POINT SYMBOLS

POINT	CODE	DESCRIPTION
⊕	APL	BOUND APPARENT LOCATION
▣	BM	BENCHMARK
▣	BND	BOUND
▣	CB	CATCH BASIN
⊕	COMB	COMBINATION POLE
▣	DITHR	DROP INLET THROATED DNC
⊕	EL	ELECTRIC POWER POLE
⊙	FPOLE	FLAGPOLE
○	GASFIL	GAS FILLER
○	GP	GUIDE POST
⊗	GSO	GAS SHUT OFF
⊙	GUY	GUY POLE
⊙	GUYW	GUY WIRE
⊗	GV	GATE VALUE
⊕	H	TREE HARDWOOD
△	HCTRL	CONTROL HORIZONTAL
△	HVCTRL	CONTROL HORIZ. & VERTICAL
⊕	HYD	HYDRANT
⊙	IP	IRON PIN
⊙	IPIPE	IRON PIPE
⊕	LI	LIGHT - STREET OR YARD
⊕	MB	MAILBOX
○	MH	MANHOLE (MH)
▣	MM	MILE MARKER
⊙	PM	PARKING METER
▣	PMK	PROJECT MARKER
⊙	POST	POST STONE/WOOD
⊕	RRSIG	RAILROAD SIGNAL
⊕	RRSL	RAILROAD SWITCH LEVER
⊕	S	TREE SOFTWOOD
⊕	SAT	SATELLITE DISH
⊕	SHRUB	SHRUB
⊕	SIGN	SIGN
⊕	STUMP	STUMP
⊕	TEL	TELEPHONE POLE
⊙	TIE	TIE
⊕	TSIGN	SIGN W/DOUBLE POST
⊕	VCTRL	CONTROL VERTICAL
⊙	WELL	WELL
⊗	WSO	WATER SHUT OFF

THESE ARE COMMON VAOT SURVEY POINT SYMBOLS FOR EXISTING FEATURES, ALSO USED FOR PROPOSED FEATURES WITH HEAVIER LINEWEIGHT, IN COMBINATION WITH PROPOSED ANNOTATION.

PROPOSED GEOMETRY CODES

CODE	DESCRIPTION
PC	POINT OF CURVATURE
PI	POINT OF INTERSECTION
CC	CENTER OF CURVE
PT	POINT OF TANGENCY
PCC	POINT OF COMPOUND CURVE
PRC	POINT OF REVERSE CURVE
POB	POINT OF BEGINNING
POE	POINT OF ENDING
STA	STATION PREFIX
AH	AHEAD STATION SUFFIX
BK	BACK STATION SUFFIX
D	CURVE DEGREE OF (100FT)
R	CURVE RADIUS OF
T	CURVE TANGENT LENGTH
L	CURVE LENGTH OF
E	CURVE EXTERNAL DISTANCE

UTILITY SYMBOLGY

UNDERGROUND UTILITIES

— UGU —	UTILITY (GENERIC-UNKNOWN)
— — — — —	TELEPHONE
— — — — —	ELECTRIC
— — — — —	CABLE (TV)
— UEC —	ELECTRIC+CABLE
— UET —	ELECTRIC+TELEPHONE
— UCT —	CABLE+TELEPHONE
— UECT —	ELECTRIC+CABLE+TELEP.
— — — — —	GAS LINE
— — — — —	WATER LINE
— — — — —	SANITARY SEWER (SEPTIC)

ABOVE GROUND UTILITIES (AERIAL)

— AGU —	UTILITY (GENERIC-UNKNOWN)
— — — — —	TELEPHONE
— — — — —	ELECTRIC
— C —	CABLE (TV)
— EC —	ELECTRIC+CABLE
— ET —	ELECTRIC+TELEPHONE
— — — — —	ELECTRIC+TELEPHONE
— CT —	CABLE+TELEPHONE
— ECT —	ELECTRIC+CABLE+TELEP.
— — — — —	UTILITY POLE GUY WIRE

PROJECT CONSTRUCTION SYMBOLGY

PROJECT DESIGN & LAYOUT SYMBOLGY

— CZ —	CLEAR ZONE
— — — — —	PLAN LAYOUT MATCHLINE

PROJECT CONSTRUCTION FEATURES

— — — — —	TOP OF CUT SLOPE
— — — — —	TOE OF FILL SLOPE
⊕ ⊕ ⊕ ⊕ ⊕	STONE FILL
— — — — —	BOTTOM OF DITCH &
— — — — —	CULVERT PROPOSED
— — — — —	STRUCTURE SUBSURFACE
— — — — —	PROJECT DEMARCATION FENCE
BF — — — — — BF	BARRIER FENCE
XXXXXXXXXXXXXXXXXXXX	TREE PROTECTION ZONE (TPZ)
//////	STRIPING LINE REMOVAL
~~~~~	SHEET PILES

CONVENTIONAL BOUNDARY SYMBOLGY

BOUNDARY LINES

— — — — —	TOWN BOUNDARY LINE
— — — — —	COUNTY BOUNDARY LINE
— — — — —	STATE BOUNDARY LINE
— — — — —	PROPOSED STATE R.O.W. (LIMITED ACCESS)
— — — — —	PROPOSED STATE R.O.W.
— — — — —	STATE ROW (LIMITED ACCESS)
— — — — —	STATE ROW
— — — — —	TOWN ROW
— — — — —	PERMANENT EASEMENT LINE (P)
— — — — —	TEMPORARY EASEMENT LINE (T)
— — — — —	SURVEY LINE
— — — — —	PROPERTY LINE (P/L)
— — — — —	SLOPE RIGHTS
— — — — —	6F PROPERTY BOUNDARY
— — — — —	4F PROPERTY BOUNDARY
— — — — —	HAZARDOUS WASTE

EPSC LAYOUT PLAN SYMBOLGY

EPSC MEASURES

ONNOONNOONNO	FILTER CURTAIN
— — — — —	SILT FENCE
— — — — —	SILT FENCE WOVEN WIRE
— — — — —	CHECK DAM
— — — — —	DISTURBED AREAS REQUIRING RE-VEGETATION
— — — — —	EROSION MATTING

ENVIRONMENTAL RESOURCES

— — — — —	WETLAND BOUNDARY
— — — — —	RIPARIAN BUFFER ZONE
— — — — —	WETLAND BUFFER ZONE
— — — — —	SOIL TYPE BOUNDARY
— — — — —	THREATENED & ENDANGERED SPECIES
— — — — —	HAZARDOUS WASTE AREA
— — — — —	AGRICULTURAL LAND
— — — — —	FISH & WILDLIFE HABITAT
— — — — —	FLOOD PLAIN
— — — — —	ORDINARY HIGH WATER (OHW)
— — — — —	STORM WATER
— — — — —	USDA FOREST SERVICE LANDS
— — — — —	WILDLIFE HABITAT SUIT/CONN


ARCHEOLOGICAL & HISTORIC

— — — — —	ARCHEOLOGICAL BOUNDARY
— — — — —	HISTORIC DISTRICT BOUNDARY
— — — — —	HISTORIC AREA
— — — — —	HISTORIC STRUCTURE

CONVENTIONAL TOPOGRAPHIC SYMBOLGY


EXISTING FEATURES

— — — — —	ROAD EDGE PAVEMENT
— — — — —	ROAD EDGE GRAVEL
— — — — —	DRIVEWAY EDGE
— — — — —	DITCH
— — — — —	FOUNDATION
— — — — —	FENCE (EXISTING)
— — — — —	FENCE WOOD POST
— — — — —	FENCE STEEL POST
— — — — —	GARDEN
— — — — —	ROAD GUARDRAIL
— — — — —	RAILROAD TRACKS
— — — — —	CULVERT (EXISTING)
— — — — —	STONE WALL
— — — — —	WALL
— — — — —	WOOD LINE
— — — — —	BRUSH LINE
— — — — —	HEDGE
— — — — —	BODY OF WATER EDGE
— — — — —	LEDGE EXPOSED

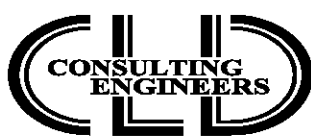

PROJECT NAME:	IRASBURG
PROJECT NUMBER:	IM DECK(46)
FILE NAME:	z15all6legend-i07N.dgn
PROJECT LEADER:	J. BYATT
DESIGNED BY:	L. GREER
CONVENTIONAL SYMBOLGY LEGEND SHEET	PLOT DATE: 2/5/2016 DRAWN BY: P. McKECHNIE CHECKED BY: S. FORTIER SHEET 8 OF 49



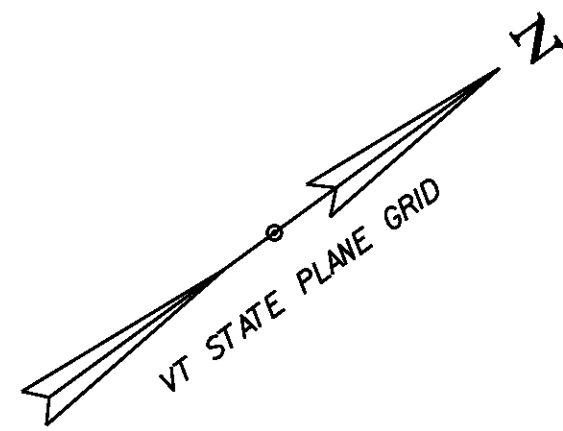

EXISTING BRIDGE DATA:

ROLLED BEAM, CONCRETE DECK-SPAN 1  
3-SPAN CONTINUOUS WELDED PLATE  
GIRDER, CONCRETE DECK-SPAN 2-4.  
LENGTH = 447'-0"  
WIDTH = 39'-4" RAIL-TO-RAIL  
BUILT IN 1971

DURABLE 6 INCH WHITE LINE (OPTION ITEM)

8606+31 TO 8613+60 LT (SOLID)  
8606+31 TO 8613+60 LT (DASHED)

DURABLE 6 INCH YELLOW LINE (OPTION ITEM)

8606+31 TO 8613+60 RT (SOLID)

REMOVAL AND DISPOSAL OF GUARDRAIL

8607+21 TO 8607+67 LT  
8606+79 TO 8607+24 RT  
8612+58 TO 8613+03 LT  
8612+21 TO 8612+66 RT

STEEL BEAM GUARDRAIL, GALVANIZED

8606+79 TO 8607+04 RT  
8607+21 TO 8607+46 LT  
8612+41 TO 8612+66 RT  
8612+78 TO 8613+03 LT

ANCHOR FOR STEEL BEAM RAIL

8612+66 RT  
8613+03 LT

DELINEATOR WITH STEEL POST

8612+66 RT  
8613+03 LT

CAST-IN-PLACE CONCRETE CURB, TYPE B

8606+93 TO 8607+33 RT  
8607+35 TO 8607+75 LT  
8612+12 TO 8612+52 RT  
8612+49 TO 8612+89 LT

REMOVING SIGNS

8607+23 RT  
8607+29 RT  
8607+29 LT  
8609+38 LT  
8612+00 LT

ERECTING SALVAGED SIGNS


8607+23 RT  
8607+29 RT  
8607+29 LT  
8609+38 LT  
8612+00 LT

SAWCUT FOR CAST-IN-PLACE  
CONCRETE CURB, TYPE B  
(INCIDENTAL TO ITEM 900.680,  
"SPECIAL PROVISION  
(BITUMINOUS CONCRETE PAVEMENT  
- BRIDGE MIX - TYPE IVB)")

BEGIN APPROACH  
STA 8606+31.00

END APPROACH  
BEGIN PROJECT  
STA 8606+92.00

BEGIN BRIDGE  
STA 8607+72.18


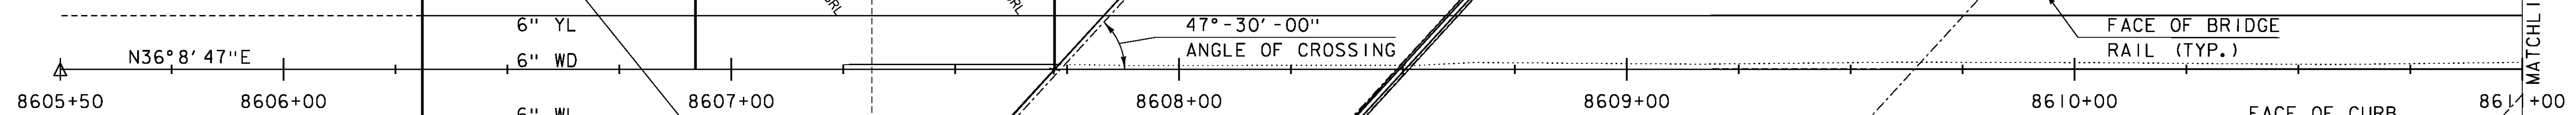


KEY TO PAVEMENT MARKINGS

WL = SOLID WHITE LINE  
YL = SOLID YELLOW LINE  
WD = WHITE DASHED LINE

BEGIN APPROACH SLAB  
SAWED PAVEMENT JOINT

ASPHALTIC PLUG JOINT  
(SEE STANDARD SD-516.10)

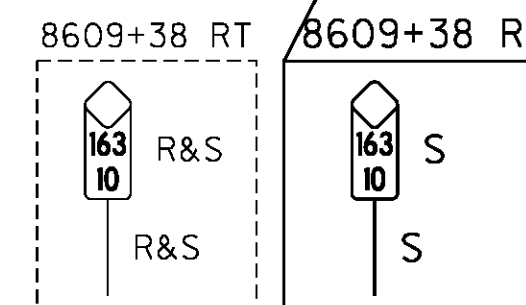
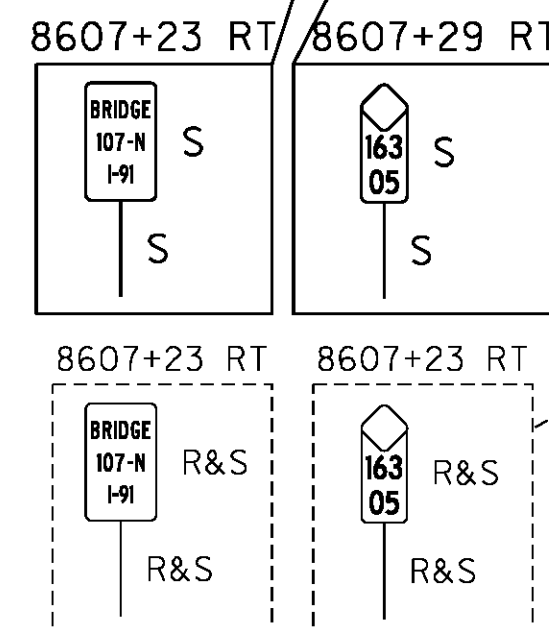


END BRIDGE  
STA 8612+19.61


END PROJECT  
BEGIN APPROACH  
STA 8612+92.00

SAWCUT FOR CAST-IN-PLACE  
CONCRETE CURB, TYPE B  
(INCIDENTAL TO ITEM 900.680,  
"SPECIAL PROVISION  
(BITUMINOUS CONCRETE PAVEMENT  
- BRIDGE MIX - TYPE IVB)")

END APPROACH  
STA 8613+59.61

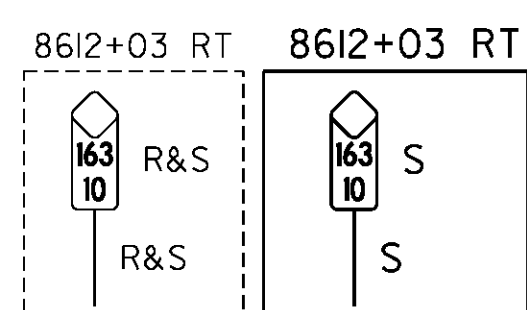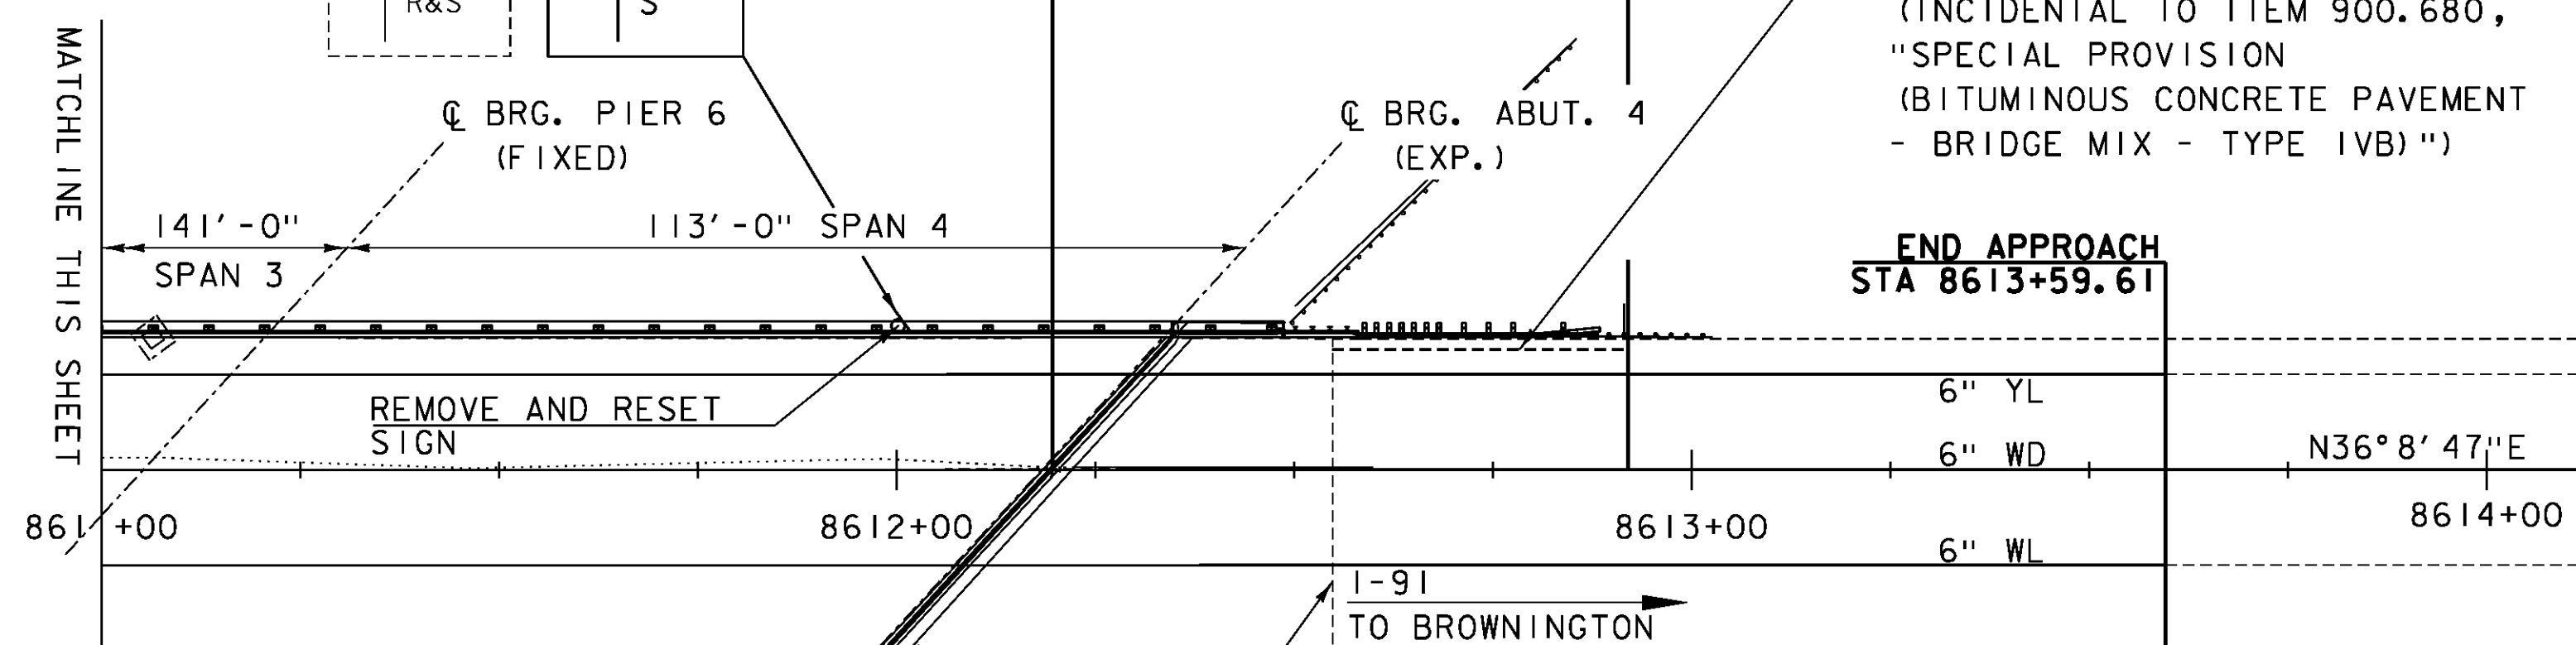

END APPROACH SLAB  
SAWED PAVEMENT JOINT

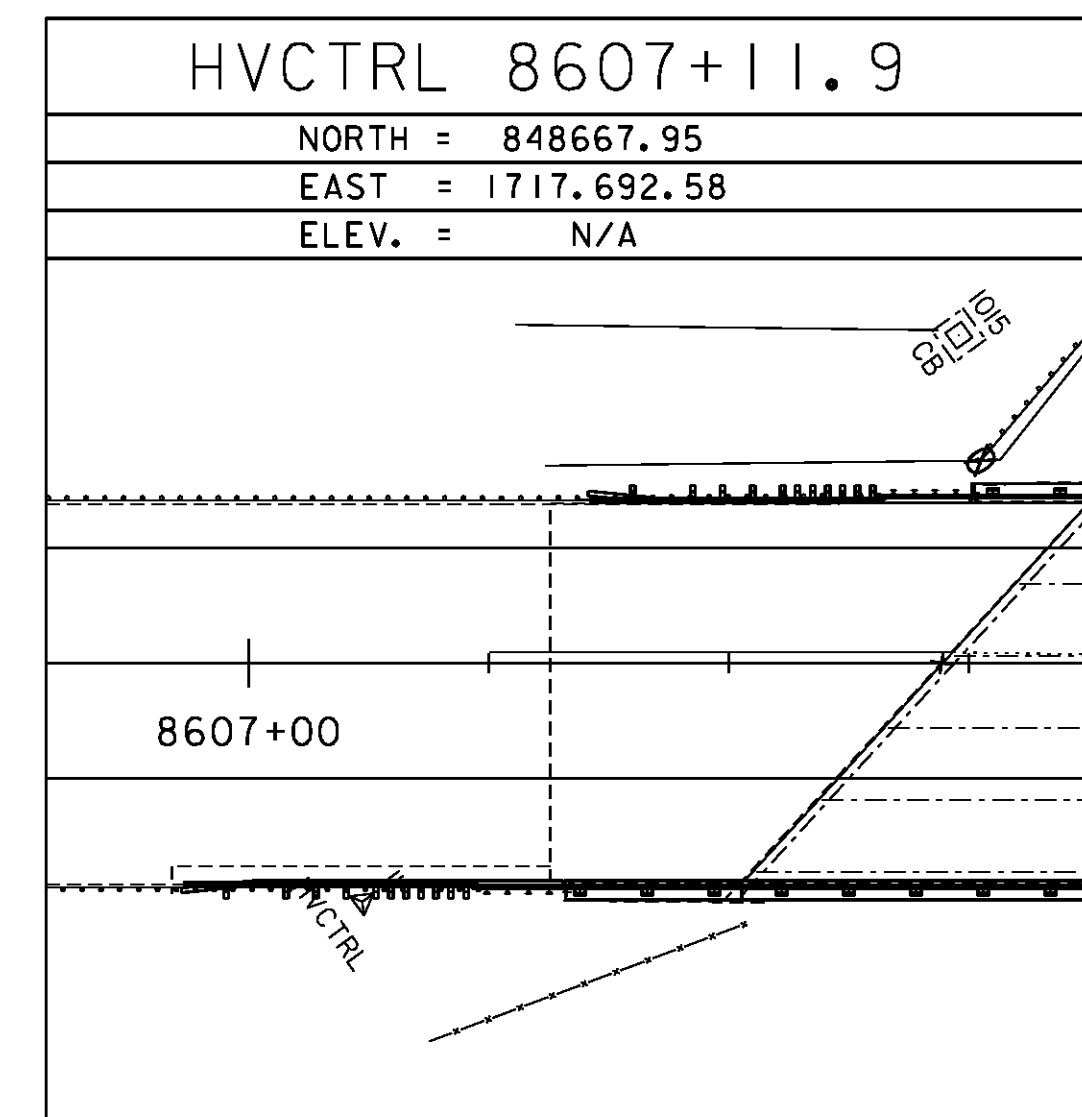


REVISION	DATE	DESCRIPTION	BY
1	03-30-2016	ADDING AND CHANGING ITEMS	LG



PROJECT NAME: IRASBURG  
PROJECT NUMBER: IM DECK(46)

FILE NAME: z15all6bdr-107N.dgn  
PROJECT LEADER: J. BYATT  
DESIGNED BY: L. GREER  
LAYOUT SHEET

PLOT DATE: 3/28/2016  
DRAWN BY: P. McKECHNIE  
CHECKED BY: S. FORTIER  
SHEET 9 OF 49

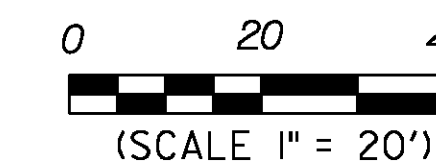



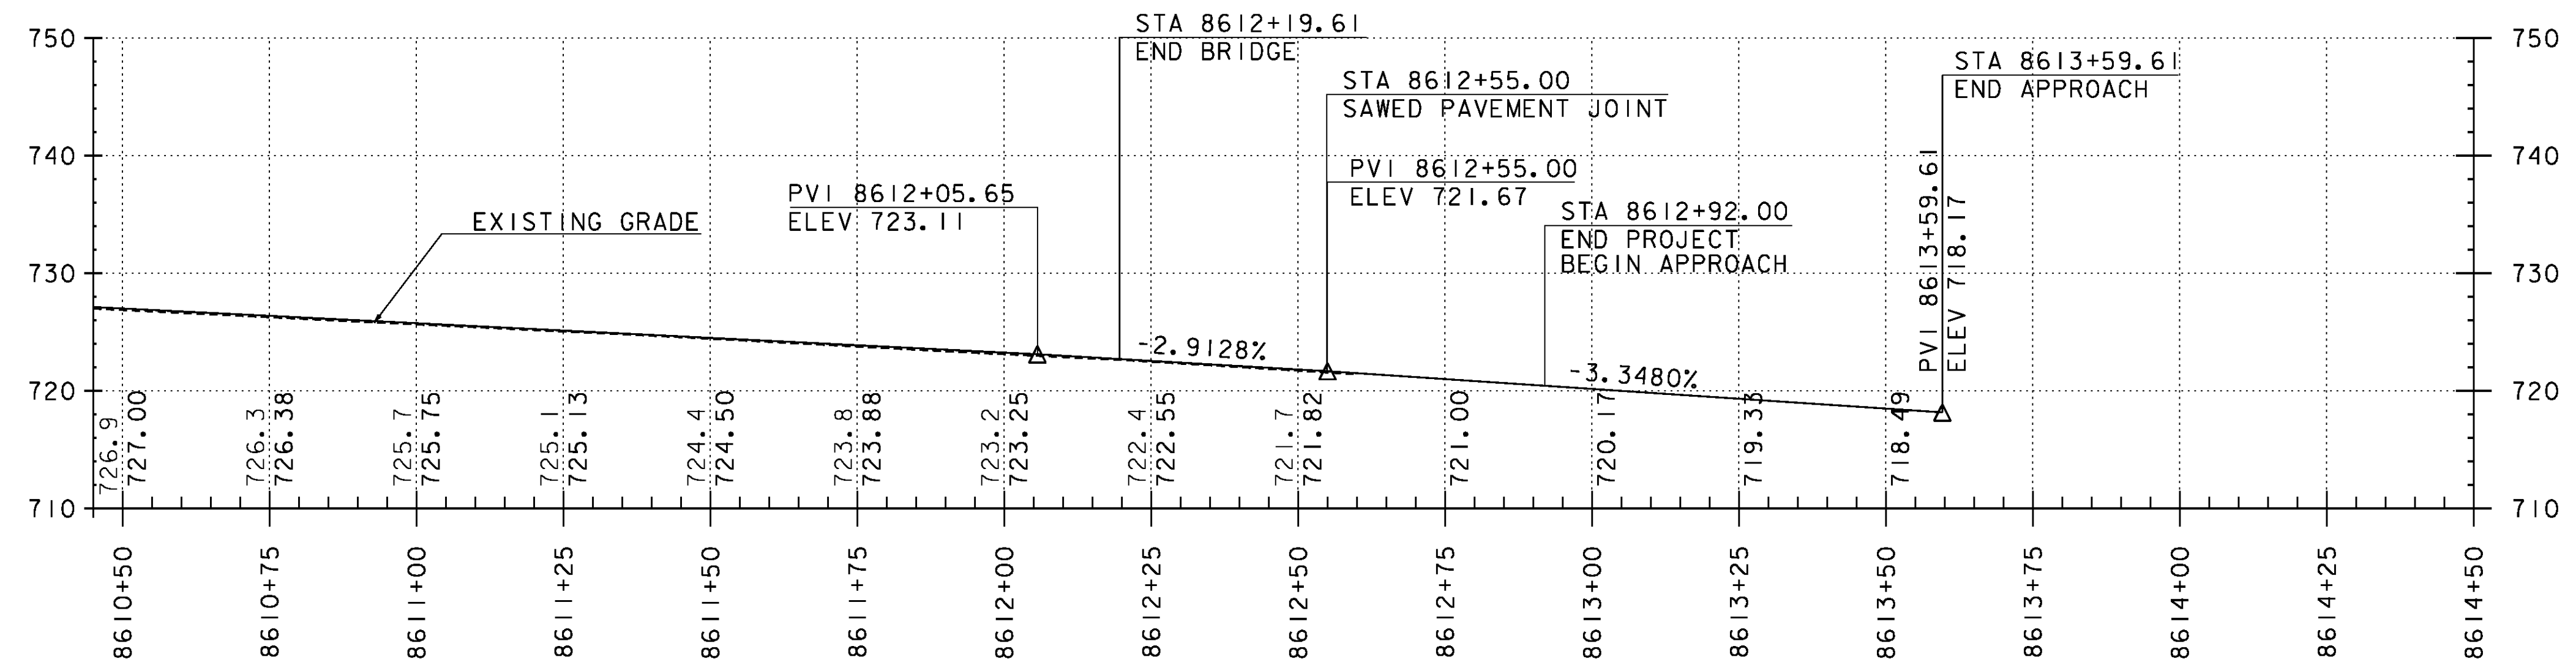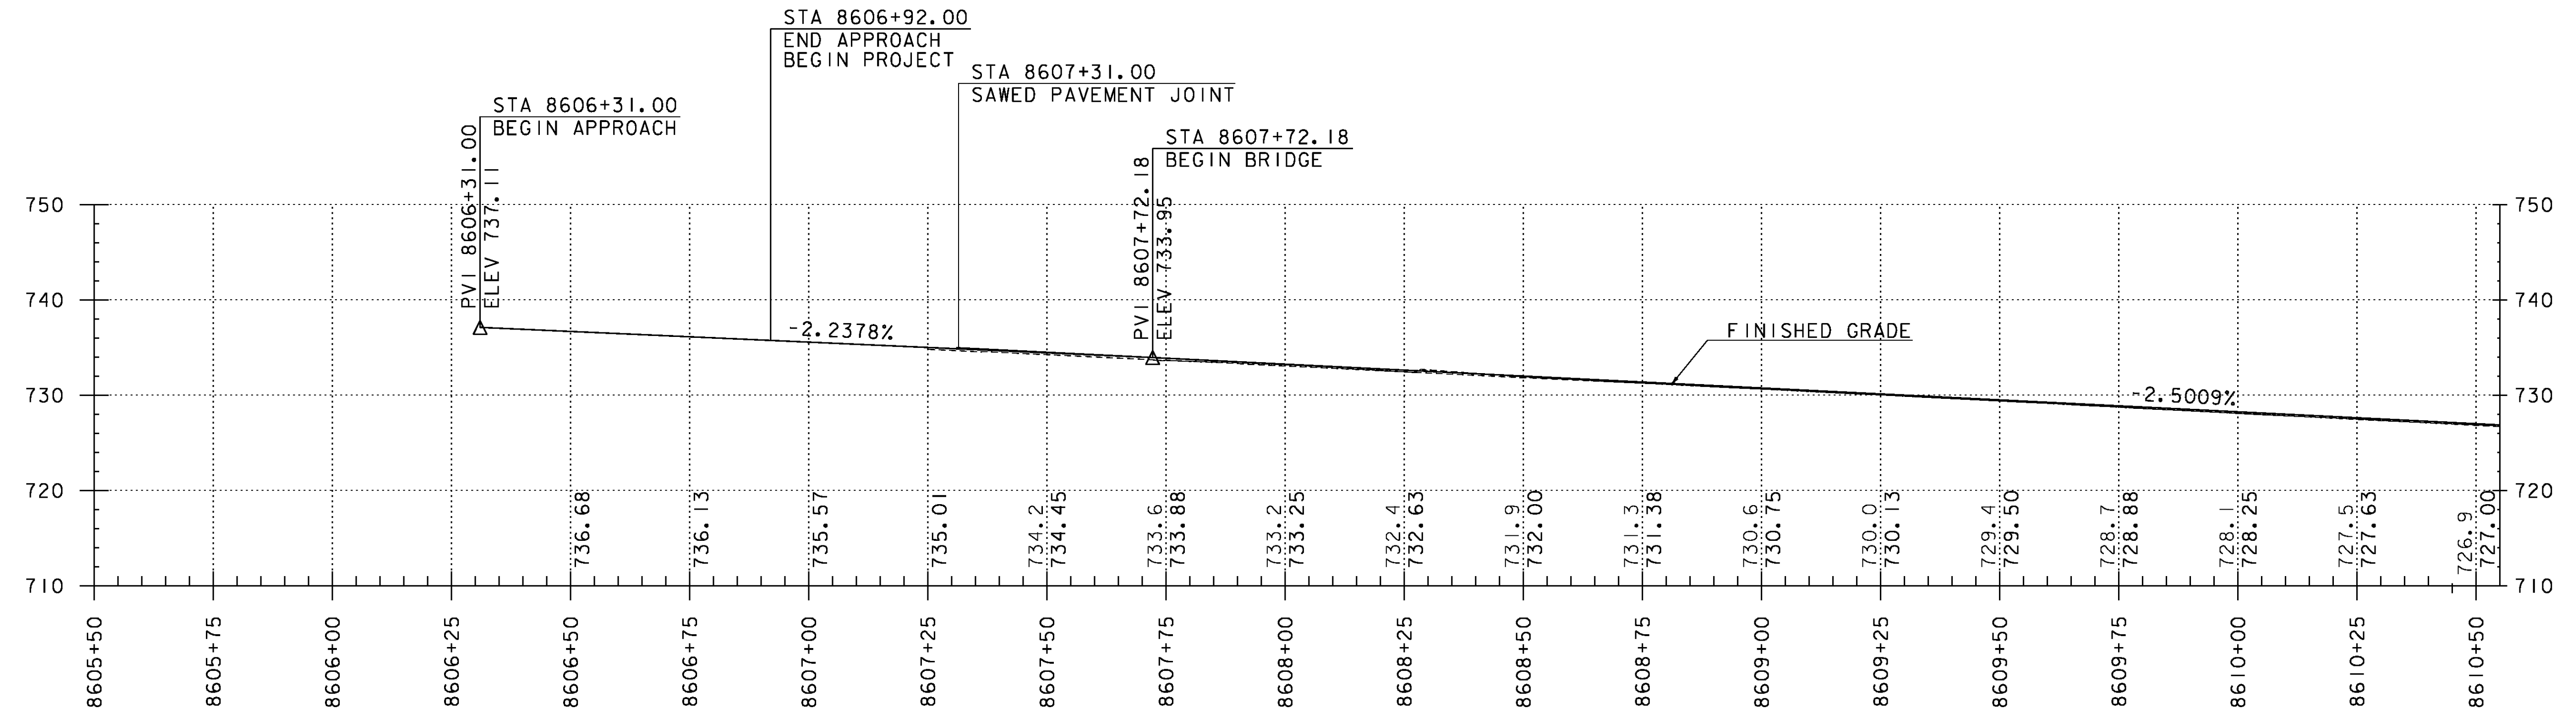

#### NOTES

1. STATIONS AND ELEVATIONS ARE IN FEET.
2. THE ELEVATIONS SHOWN TO THE NEAREST TENTH ARE THE EXISTING GROUND ALONG THE CENTERLINE.
3. THE ELEVATIONS SHOWN TO THE NEAREST HUNDRETH ARE THE FINISHED GRADE ALONG THE CENTERLINE.
4. PROPOSED PROFILE SHOWN IS FOR INFORMATIONAL PURPOSES ONLY. FINAL FINISHED GRADE SHALL BE DETERMINED BY THE PROJECT MANAGER AFTER EXISTING TOP OF DECK AND TOP OF BEAM ELEVATIONS ARE SURVEYED. SEE PROJECT NOTE 19 ON SHEET 3.

#### I-9I PROFILE

HOR. SCALE 1" = 40'-0"  
VER. SCALE 1" = 20'-0"



PROJECT NAME: IRASBURG  
PROJECT NUMBER: IM DECK(46)

FILE NAME: z15all6pro-107N.dgn  
PROJECT LEADER: J. BYATT  
DESIGNED BY: L. GREER  
PROFILE SHEET

PLOT DATE: 2/5/2016  
DRAWN BY: J. FOWLER  
CHECKED BY: S. FORTIER  
SHEET 10 OF 49



MODEL: TCPI  
CLD 15-0223

TRAFFIC CONTROL


1. AS PART OF 900.645, "SPECIAL PROVISION (TRAFFIC CONTROL, ALL INCLUSIVE)", THE CONTRACTOR SHALL SUBMIT A SITE SPECIFIC TRAFFIC CONTROL PLAN TO THE PROJECT MANAGER DEPICTING EACH PHASE OF THE PLANNED WORK. PLANS SHALL BE SUBMITTED FOR APPROVAL IN ACCORDANCE WITH SUBSECTION 105.03. THE PLAN SHALL INCLUDE A LAYOUT SHOWING ALL ON- AND OFF-PROJECT SIGNS AND BARRICADES, DETAILS FOR LANE CLOSURES, AND ANY OTHER DETAILS ASSOCIATED WITH THE TRAFFIC CONTROL.
- THE TRAFFIC CONTROL PLANS SHOWN ON TRAFFIC CONTROL SHEETS 2 AND 3, THE TRAFFIC CONTROL BARRIER SHEET ON SHEET 14, AND THE PHASING SECTIONS ON SHEETS 15 AND 16 ARE SCHEMATICS ONLY AND SHOULD BE USED AS REFERENCES. DIMENSIONS SHOWN ARE MINIMUMS BASED ON VTRANS STANDARDS AND THE MUTCD. THESE DIMENSIONS MAY BE REDUCED DUE TO SITE CONSTRAINTS WITH THE ENGINEER'S APPROVAL. ITEMS THAT MAY BE REVISED IN THE SITE SPECIFIC TRAFFIC CONTROL PLAN SUBMITTED BY THE CONTRACTOR INCLUDE, BUT ARE NOT LIMITED TO, APPROACH SIGN SPACING, TAPER LENGTHS/RATES, LANE WIDTHS, BUFFER SPACES, TANGENT LENGTHS, AND LOCATIONS OF PORTABLE CHANGEABLE MESSAGE SIGNS.
2. ALL ITEMS REQUIRED TO PREPARE, SUBMIT, AND IMPLEMENT THE CONTRACTOR'S PLAN, INCLUDING ANY NECESSARY REVISIONS TO THE PLAN, WILL BE INCLUDED IN THE UNIT BID PRICE FOR ITEM 900.645, "SPECIAL PROVISION (TRAFFIC CONTROL, ALL-INCLUSIVE)". THE PAY ITEM INCLUDES, BUT IS NOT LIMITED TO, THE FOLLOWING:
- TRAFFIC CONTROL PLAN  
TEMPORARY TRAFFIC BARRIERS  
BARRICADES  
DRUMS/CONES  
ON PROJECT CONSTRUCTION SIGNING  
TEMPORARY TAPE OR RAISED PAVEMENT MARKERS, TYPE II  
PORTABLE ARROW BOARDS  
ENERGY ABSORPTION ATTENUATORS
- TRAFFIC CONTROL ITEMS NOT PAID FOR IN THE UNIT PRICE BID FOR ITEM 900.645, "SPECIAL PROVISION (TRAFFIC CONTROL, ALL-INCLUSIVE)", AND PAID FOR SEPARATELY INCLUDE THE FOLLOWING:
- ITEM 630.10, "UNIFORMED TRAFFIC OFFICERS"  
ITEM 630.15, " FLAGGERS"  
ITEM 641.15, "PORTABLE CHANGEABLE MESSAGE SIGN"
- THE CONTRACTOR SHALL ALLOW TWO WEEKS FOR REVIEW OF THE TRAFFIC CONTROL PLAN. NO WORK SHALL COMMENCE UNTIL THE CONTRACTOR HAS AN APPROVED TRAFFIC CONTROL PLAN.
3. THE EXISTING SPEED LIMIT IS 65 MPH. THE SPEED LIMIT WILL BE REDUCED TO 55 MPH IN THE WORK ZONE FOR THIS PROJECT. ANY EXISTING SPEED LIMIT SIGNS WITHIN THE SPEED REDUCTION AREA SHALL BE COMPLETELY COVERED.
4. CONSTRUCTION SIGNS SHALL BE INSTALLED SO AS NOT TO OBSTRUCT EXISTING SIGNS.
5. ALL SIGNS SHALL BE IN ACCORDANCE WITH THE CURRENT EDITIONS OF THE "MANUAL ON UNIFORM TRAFFIC CONTROL DEVICES" (MUTCD) AND THE "STANDARD HIGHWAY SIGNS AND MARKINGS" BOOK (SHSM) PUBLISHED BY THE FEDERAL HIGHWAY ADMINISTRATION (FHWA).
6. SOLID SUBSTRATE CONSTRUCTION SIGNS SHALL HAVE RETROREFLECTIVE SHEETING EQUAL TO OR EXCEEDING "AMERICAN SOCIETY FOR TESTING AND MATERIALS" (ASTM D 4956) TYPE VII, VIII OR IX REQUIREMENTS, UNLESS OTHERWISE NOTED. BLACK AND WHITE REGULATORY SIGNS SHALL BE A MINIMUM OF TYPE III, UNLESS OTHERWISE NOTED.
7. ROLL UP SIGNS SHALL HAVE RETROREFLECTIVE SHEETING EQUAL TO OR EXCEEDING ASTM D 4956 TYPE VI.
8. CONSTRUCTION SIGNS SHALL BE ERECTED BEFORE THE START OF ANY WORK AND SHALL BE COVERED UNTIL WORK COMMENCES, DURING PERIODS OF INACTIVITY OR UPON COMPLETION OF THE WORK. EACH SIGN SHALL BE ERECTED IN A NEAT AND WORKMANLIKE MANNER. SIGNS SHALL BE REMOVED UPON COMPLETION OF THE WORK AT THE DISCRETION OF THE ENGINEER.

TRAFFIC CONTROL (CONTINUED)

9. FIXED SIGNS SHALL BE SET SECURELY IN THE GROUND. THE BOTTOM OF A SIGN SHALL BE AT LEAST SEVEN FEET ABOVE THE EDGE OF PAVEMENT. THE NEAREST EDGE OF A SIGN SHALL BE AT LEAST SIX FEET OUTSIDE THE SHOULDER POINT OR FOUR FEET OUTSIDE GUARDRAIL.
10. PORTABLE SIGNS SHALL BE PLACED ON THE EDGE OF ROADWAY AND ONE FOOT MINIMUM ABOVE TRAVELED WAY. ALL VEGETATION THAT INTERFERES WITH VISIBILITY OF THE SIGNS SHALL BE REMOVED AT THE CONTRACTOR'S EXPENSE. WHEN PLACED BEHIND GUARDRAIL, THE BOTTOM OF THE SIGN FACE SHALL BE ABOVE THE TOP OF THE GUARDRAIL.
11. WHERE SIGN INSTALLATIONS ARE NOT PROTECTED BY GUARDRAIL OR OTHER APPROVED TRAFFIC BARRIERS, ALL SIGN STANDS AND POST INSTALLATIONS SHALL BE "NATIONAL COOPERATIVE HIGHWAY RESEARCH PROGRAM" (NCHRP) REPORT 350 COMPLIANT. NO SIGN POSTS SHALL EXTEND OVER THE TOP OF THE SIGN INSTALLED ON SAID POST(S). WHEN ANCHORS ARE INSTALLED, STUB SHALL NOT BE GREATER THAN FOUR INCHES ABOVE EXISTING GROUND.
12. THE CONTRACTOR SHALL HAVE SIGNS FOR CLOSURE OF RIGHT AND LEFT LANES ON PROJECT BEFORE WORK COMMENCES.
13. THE TRAFFIC CONTROL CONFIGURATIONS SHOWN ON TRAFFIC CONTROL SHEET 2 MAY BE UTILIZED FOR ALL WORK REQUIRING A LANE CLOSURE OF 3 DAYS OR LESS SUCH AS MEMBRANE AND PAVING OPERATIONS THAT DO NOT REQUIRE OPEN DECK WORK. ANY WORK REQUIRING A LANE CLOSURE LONGER THAN 3 DAYS OR INCLUDES OPEN DECK WORK SUCH AS DECK REMOVAL AND REPLACEMENT OPERATIONS SHALL UTILIZE THE TRAFFIC CONTROL CONFIGURATIONS SHOWN ON TRAFFIC CONTROL SHEET 3.
14. CHANNELIZING DEVICES OTHER THAN RETROREFLECTIVE PLASTIC DRUMS SHALL BE ALLOWED ALONG THE BUFFER SPACE AND WORK AREA FOR MEMBRANE AND PAVING OPERATIONS ONLY. THE TYPE OF DEVICE SHALL BE CONSISTENT THROUGHOUT THE BUFFER SPACE AND WORK AREA AND SHALL REMAIN STABLE WHILE UNATTENDED.
15. THE NUMBER OF CHANNELIZING DEVICES, TYPE III BARRICADE AND OTHER TRAFFIC CONTROL DEVICES SHOWN ARE FOR ILLUSTRATIVE PURPOSES ONLY. THE ACTUAL NUMBER REQUIRED ARE TO BE DETERMINED BASED ON INDIVIDUAL DETOUR CONDITIONS (TAPERS, SPEED LIMITS, LENGTH OF DETOUR, CURVE, ETC.). WARNING LIGHTS SHALL NOT BE USED ON CHANNELIZING DEVICES.
16. PLACE LAST CHANNELIZING DEVICE A MINIMUM 100 FEET BEYOND THE ANTICIPATED WORK ZONE TERMINAL POINT EACH DAY FOR MEMBRANE AND PAVING OPERATIONS ONLY.
17. THE ARROW PANEL SHALL BE PLACED ON THE SHOULDER OF THE ROADWAY AS CLOSE AS PRACTICAL TO THE BEGINNING OF THE MERGING TAPER.
18. THE PORTABLE CHANGEABLE MESSAGE SIGNS (PCMS) SHALL BE USED AT THE DISCRETION OF THE ENGINEER AND WILL BE PAID FOR UNDER ITEM 641.15, "PORTABLE CHANGEABLE MESSAGE SIGN)". THE PCMS SHALL BE PLACED AS SHOWN IN THE "CONSTRUCTION APPROACH SIGNING ON I-91" DETAIL ON TRAFFIC CONTROL SHEET 2. THE PCMS SHALL BE USED IN ACCORDANCE WITH SECTION 6F.60 OF THE MUTCD. THE PCMS SHALL READ "LEFT (OR RIGHT) LANE CLOSED AHEAD, PLEASE MERGE EARLY".
19. TRAVEL LANE SHALL BE A MINIMUM OF 12 FEET WIDE.
20. DURING MEMBRANE AND PAVING OPERATIONS, THE CONTRACTOR MAY REDUCE TRAFFIC TO ONE LANE DURING WORKING HOURS IN ACCORDANCE WITH THIS SHEET. ALL EQUIPMENT SHALL BE MOVED TO A LOCATION OFF PAVED SHOULDERS AND OUTSIDE THE CLEAR ZONE (MINIMUM 30 FEET) DURING NON-WORK PERIODS AND PROTECTED BY BARRELS OR CONES, UNLESS PROTECTED BY TRAFFIC BARRIER OR GUARDRAIL.
21. AT THE DISCRETION OF THE ENGINEER, MERGING TAPER, BUFFER SPACE, AND TANGENT LENGTHS MAY BE EXTENDED BEYOND MINIMUM VALUES, ESPECIALLY IN CLOSE PROXIMITY TO INTERCHANGE RAMPS, CURVES, OR OTHER INFLUENCING FACTORS.
22. EXTEND MERGING TAPER TO ACCOUNT FOR REQUIRED LANE SHIFT OFFSET.
23. PROVIDE MERGING TAPER LENGTH AS REQUIRED FOR LANE SHIFT.



TEMPORARY TRAFFIC BARRIER

24. TEMPORARY TRAFFIC BARRIER SHALL BE A CONCRETE MEDIAN BARRIER (CMB) TYPE. STEEL BEAM GUARDRAIL WILL NOT BE ALLOWED FOR USE AS A TEMPORARY TRAFFIC BARRIER. PLACEMENT OF CMBs AND REMOVING AND RESETTNG CMBs WILL BE CONSIDERED INCIDENTAL TO ITEM 900.645, "SPECIAL PROVISION (TRAFFIC CONTROL, ALL-INCLUSIVE)".
25. THE END OF THE BARRIER FACING APPROACHING TRAFFIC SHALL MEET THE FOLLOWING REQUIREMENTS.
- A. WHEN NO GUARDRAIL IS PRESENT, A 30' OFFSET SHALL BE USED FROM THE EDGE OF TRAVELED WAY. IF A 30' OFFSET IS NOT ATTAINABLE, THEN AN ENERGY ABSORPTION ATTENUATOR SHALL BE LOCATED AT THE END OF THE BARRIER.
- B. IF GUARDRAIL IS PRESENT, THEN TEMPORARY CONCRETE TRAFFIC BARRIER SHALL BE CONNECTED TO EXISTING GUARDRAIL. PAYMENT WILL BE CONSIDERED INCIDENTAL TO ITEM 900.645, "SPECIAL PROVISION (TRAFFIC CONTROL, ALL-INCLUSIVE)". (COSTS FOR DISMANTLING BARRIER CONNECTION AND RESTORING EXISTING BARRIER TO ORIGINAL CONFIGURATION WILL BE CONSIDERED INCIDENTAL TO ITEM 900.645, "SPECIAL PROVISION (TRAFFIC CONTROL, ALL-INCLUSIVE)".) SEE BARRIER RAIL DETAILS ON SHEET 14. AN ENERGY ABSORTION ATTENUATOR SHALL BE LOCATED AT THE END OF THE BARRIER.
26. THE CONTRACT INCLUDES AN ESTIMATED QUANTITY OF THREE ENERGY ABSORPTION ATTENUATORS, WHICH INCLUDES ONE BACKUP ATTENUATOR TO BE USED IN THE EVENT AN IN-SERVICE ATTENUATOR IS DAMAGED AND NEEDS TO BE REPLACED. PAYMENT FOR THE ATTENUATORS AND TO MOVE ATTENUATORS FOR SHIFTING LANE CLOSURES WILL BE CONSIDERED INCIDENTAL TO ITEM 900.645, "SPECIAL PROVISION (TRAFFIC CONTROL, ALL-INCLUSIVE)". PAYMENT FOR ENERGY ABSORPTION ATTENUATORS USED FOR ANY OTHER TRAFFIC CONTROL SETUP WILL BE CONSIDERED INCIDENTAL TO ITEM 900.645, "SPECIAL PROVISION (TRAFFIC CONTROL, ALL-INCLUSIVE)".
27. TEMPORARY TAPE EDGELINES SHALL BE APPLIED AND SHALL MAINTAIN A ONE FOOT MINIMUM DISTANCE FROM THE BARRIER WITH TWO FEET BEING DESIRABLE. ALL TEMPORARY TAPE EDGE LINES AND PAVEMENT MARKING MASKS WILL BE CONSIDERED INCIDENTAL TO ITEM 900.645, "SPECIAL PROVISION (TRAFFIC CONTROL, ALL-INCLUSIVE)".
28. THE RAISED PAVEMENT MARKERS (RPM'S), TYPE II SHALL BE PLACED TO THE OUTSIDE OF THE TEMPORARY TAPE PAVEMENT MARKINGS. THE RPM'S SHALL BE SPACED AT A MINIMUM OF 20 FEET AND WILL BE CONSIDERED INCIDENTAL TO ITEM 900.645, "SPECIAL PROVISION (TRAFFIC CONTROL, ALL-INCLUSIVE)".
29. DASHED LINE REMOVAL SHALL BEGIN A MINIMUM OF 750 FEET IN ADVANCE OF THE BEGINNING OF THE SHOULDER TAPER FOR TRAFFIC CONTROL WITH TEMPORARY BARRIER PROTECTION.

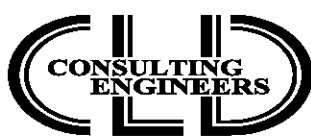


PROJECT NAME: IRASBURG	
PROJECT NUMBER: IM DECK(46)	
FILE NAME: z15dl16+cp-107N.dgn	PLOT DATE: 3/8/2016
PROJECT LEADER: J. BYATT	DRAWN BY: S. BEAUMONT
DESIGNED BY: S. BEAUMONT	CHECKED BY: L. GREER
TRAFFIC CONTROL SHEET I	SHEET II OF 49




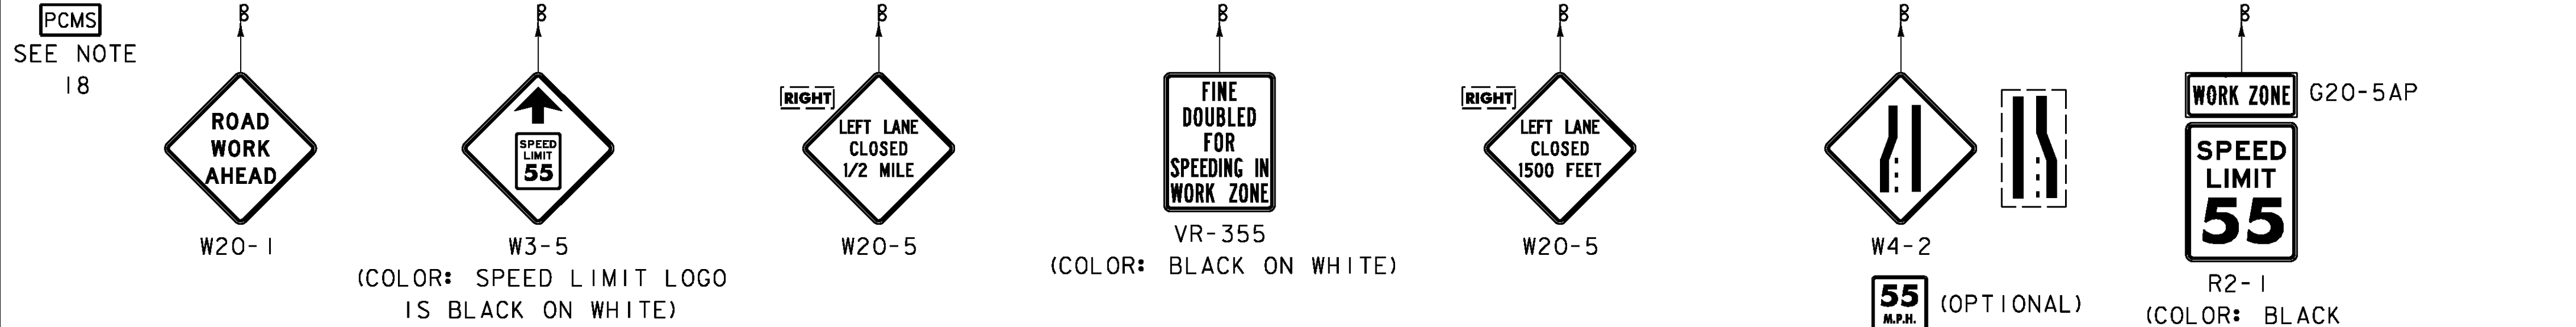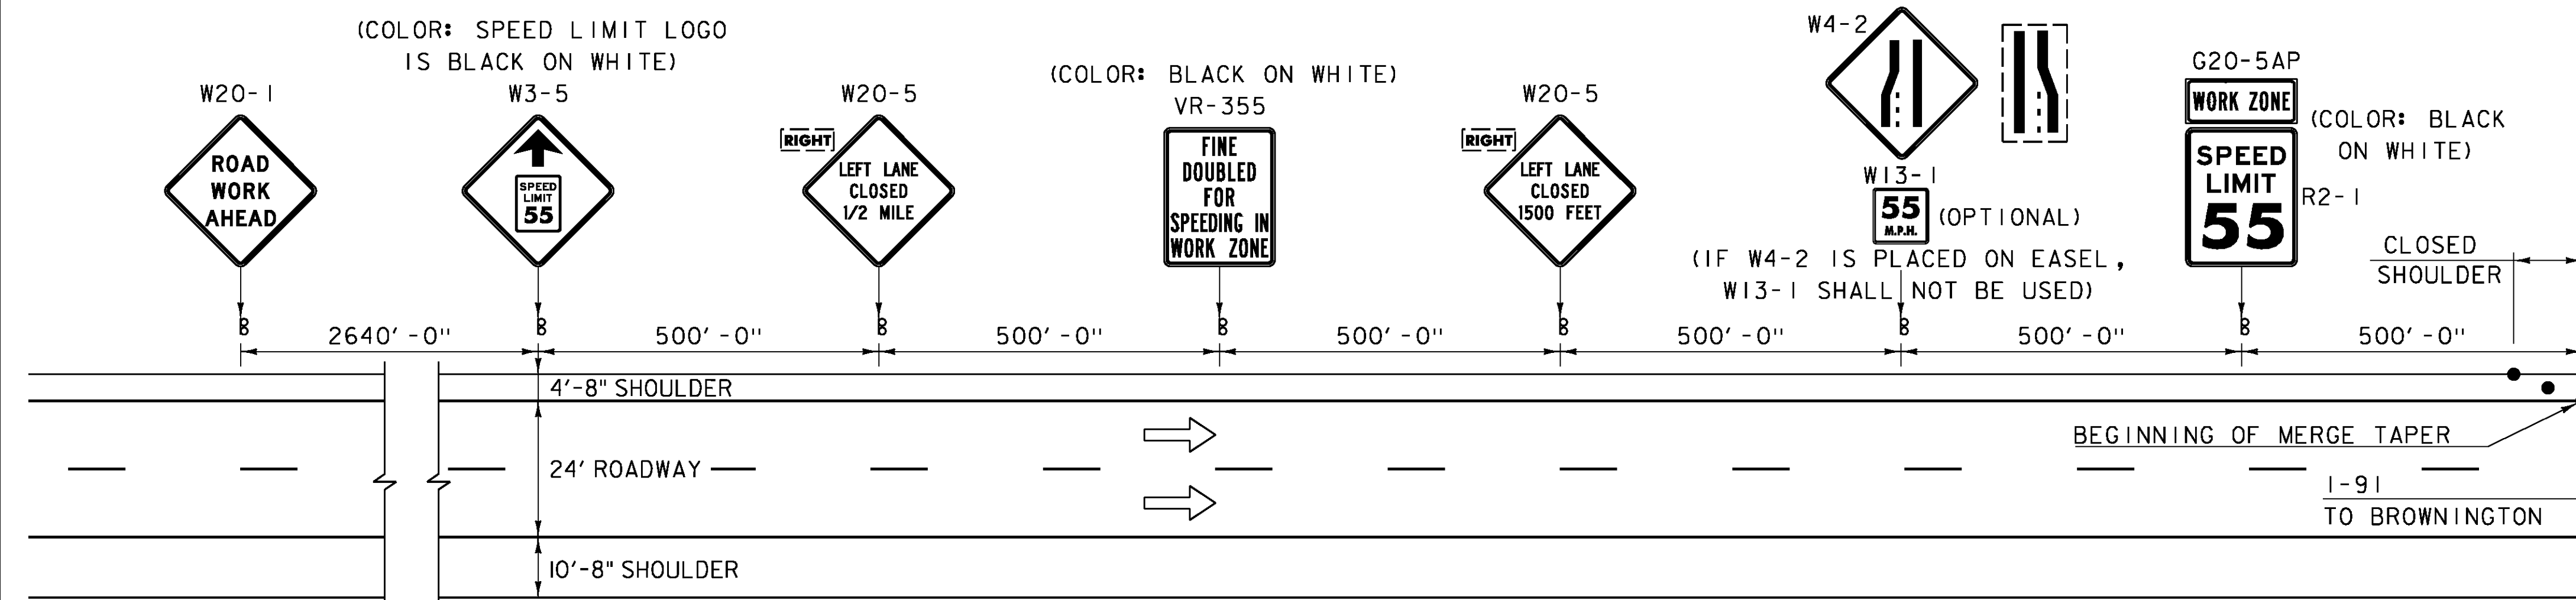


**CONSTRUCTION APPROACH SIGNING ON I-91**  
(LEFT LANE CLOSED, RIGHT LANE SIMILAR)

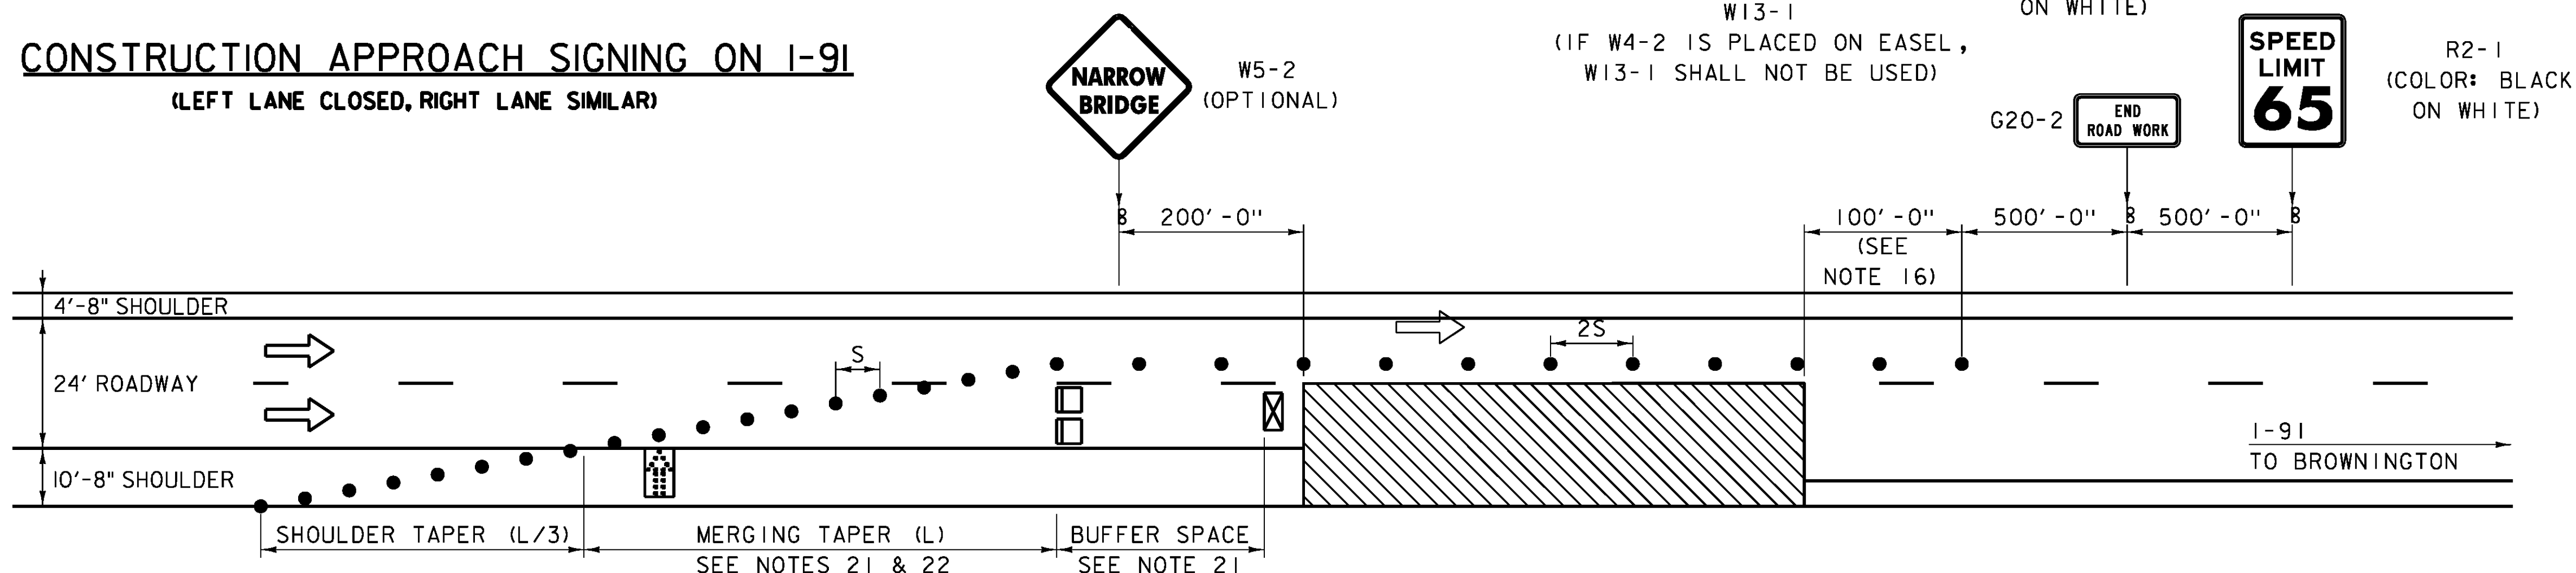

**TRAFFIC CONTROL ON I-91 RIGHT LANE CLOSED**  
(SEE NOTE 13)

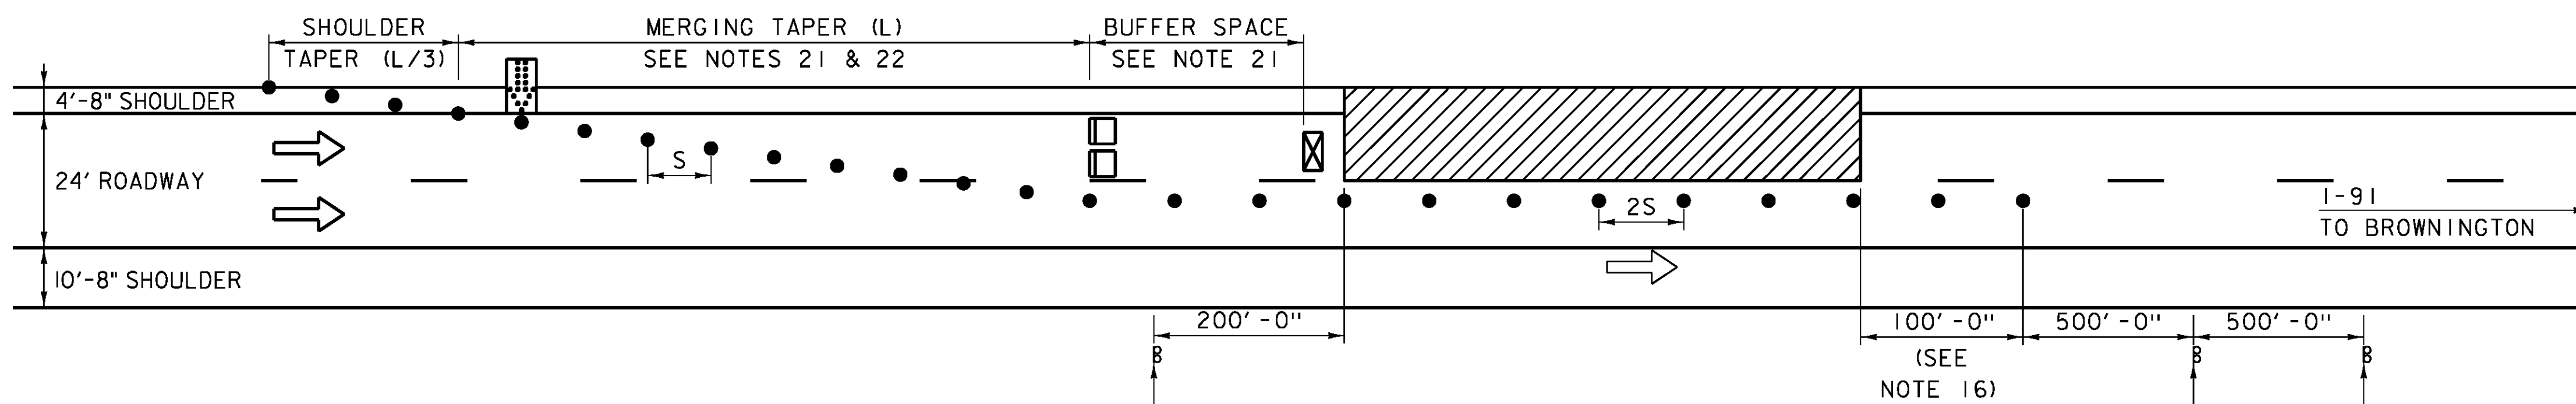

**TRAFFIC CONTROL ON I-91 LEFT LANE CLOSED**  
(SEE NOTE 13)

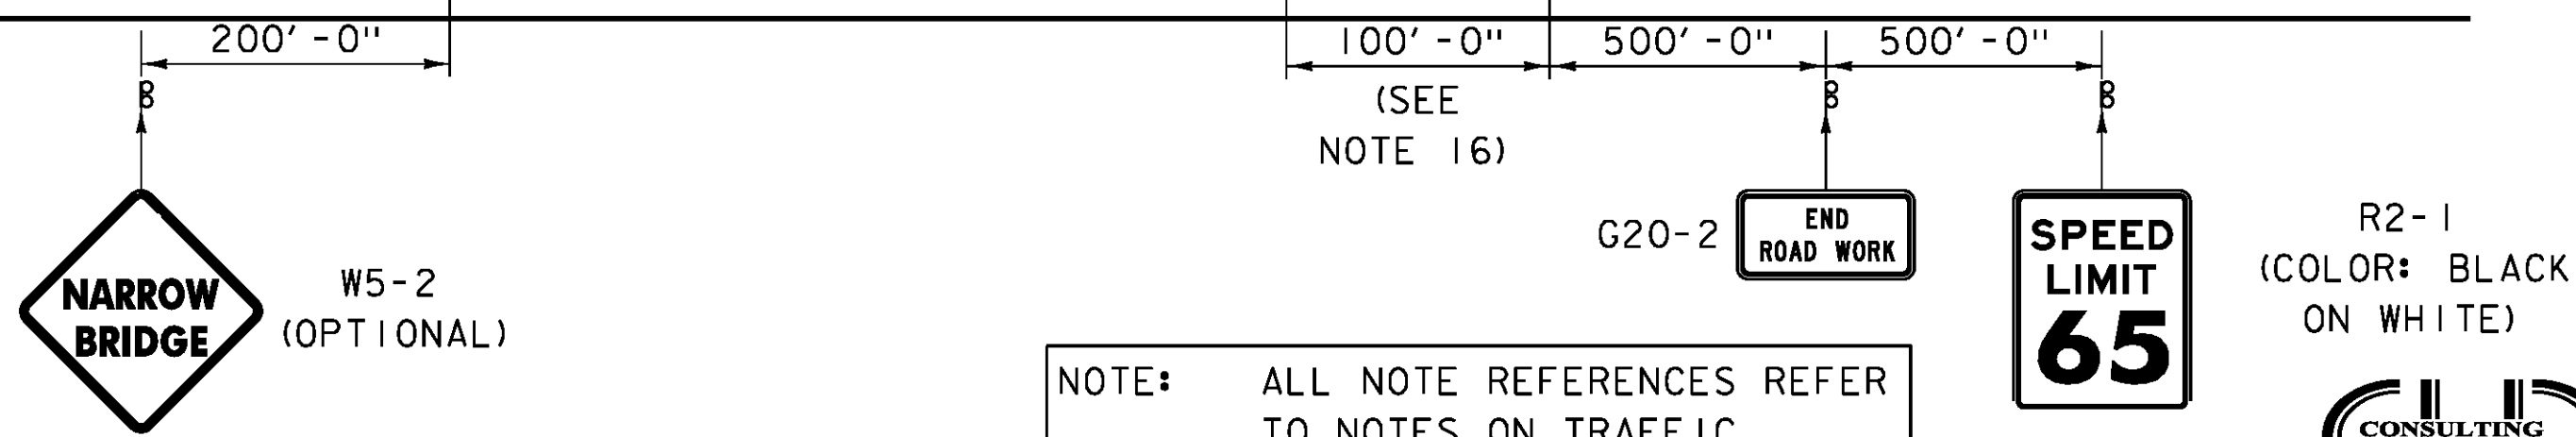

NOTE: ALL NOTE REFERENCES REFER TO NOTES ON TRAFFIC CONTROL SHEET 1.

POSTED SPEED (MPH)	TAPER LENGTHS (FT)		TANGENT W=12 FT (L/2)	BARRIER FLARE RATE (MIN.)	MIN. BUFFER SPACE LENGTH (FT)	MAXIMUM CHANNELIZING DEVICE SPACING (FT)	
	SHOULDER W=10 FT (L/3)	MERGING 12 FT LANE* (L)				TAPER (S)	TANGENT (2S)
	(L/3)	(L)	(L/2)		(FT)	(S)	(2S)
≤40	90	320	160	1:9	305	40	80
45	150	540	270	1:9	360	45	90
50	170	600	300	1:11	425	50	100
55	185	660	330	1:13	495	55	110
60	200	720	360	1:13	570	60	120
65	215	780	390	1:13	645	65	130

* SEE NOTE 22.

TAPER RATES ARE DETERMINED USING THE FOLLOWING EQUATION:  
L = WS FOR POSTED SPEEDS OF 45 MPH OR GREATER  
L = WS²/60 FOR POSTED SPEEDS OF 40 MPH OR LESS


L = MINIMUM LENGTH OF TAPER  
W = WIDTH OF OFFSET IN FEET. (TYPICAL)  
S = POSTED SPEED IN MPH

TRAFFIC DATA								
LOCATION	AADT		DHV		%T		%D	
	2015	2035	2015	2035	2015	2035	2015	2035
I-91 NORTH	3600	4000	680	760	16.3	22.5	100	100


**LEGEND**

- ➡ FLOW OF TRAFFIC
- RETROREFLECTIVE PLASTIC DRUM
- ▤ PORTABLE ARROW BOARD
- TYPE III BARRICADE
- ▨ WORK AREA
- ⊠ TRUCK-MOUNTED ATTENUATOR
- PCMS PORTABLE CHANGEABLE MESSAGE SIGN (ITEM 641.15) (SEE NOTE 18)


PROJECT NAME:	IRASBURG
PROJECT NUMBER:	IM DECK(46)
FILE NAME:	z15dl16+cp-107N.dgn
PROJECT LEADER:	J. BYATT
DESIGNED BY:	S. BEAUMONT
TRAFFIC CONTROL SHEET 2	
PLOT DATE:	2/5/2016
DRAWN BY:	S. BEAUMONT
CHECKED BY:	L. GREER
SHEET	12 OF 49

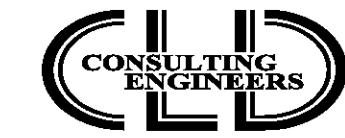



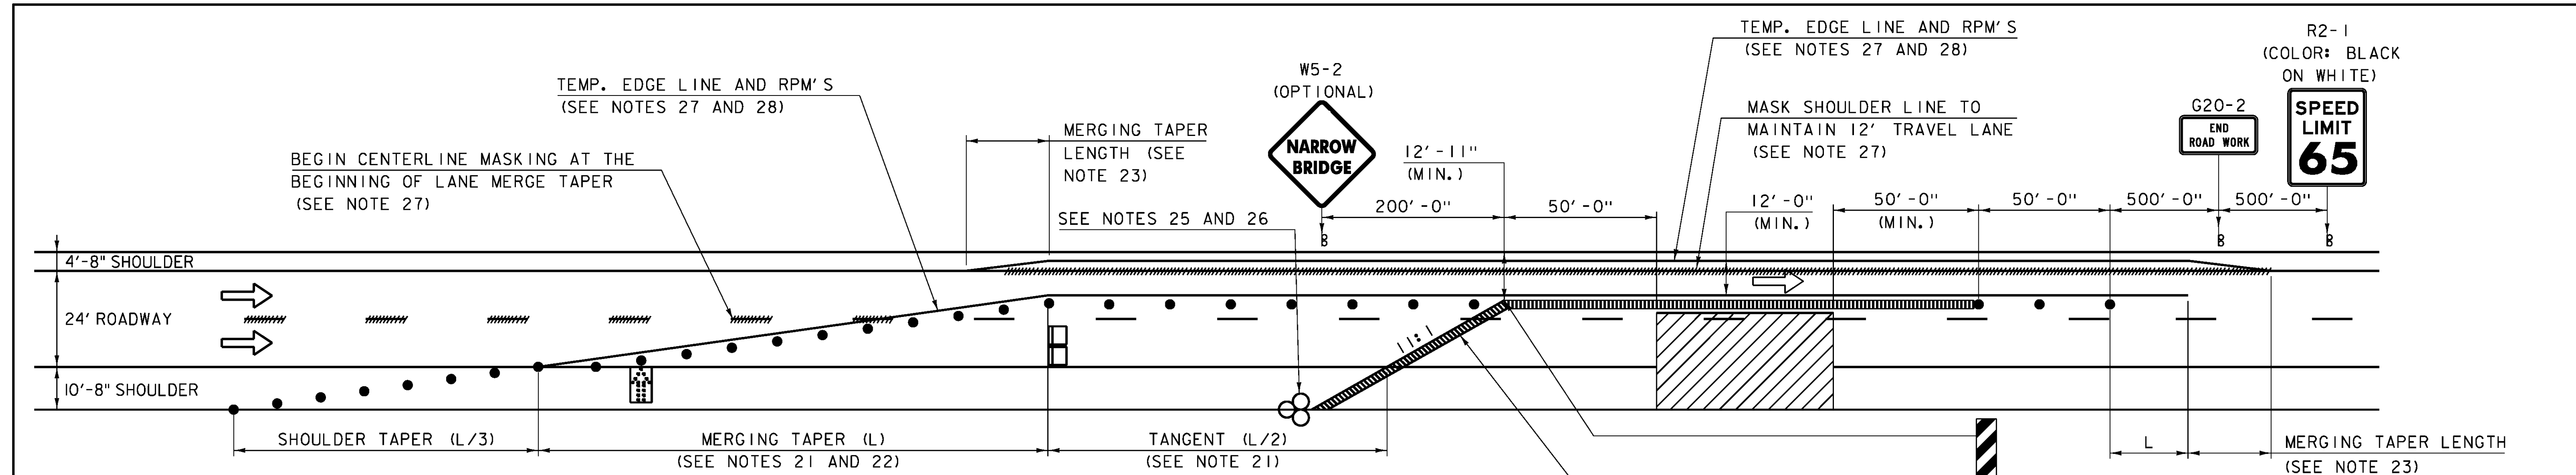

**TRAFFIC CONTROL ON I-91 RIGHT LANE CLOSED WITH TEMPORARY BARRIER PROTECTION**  
(SEE NOTE 13)

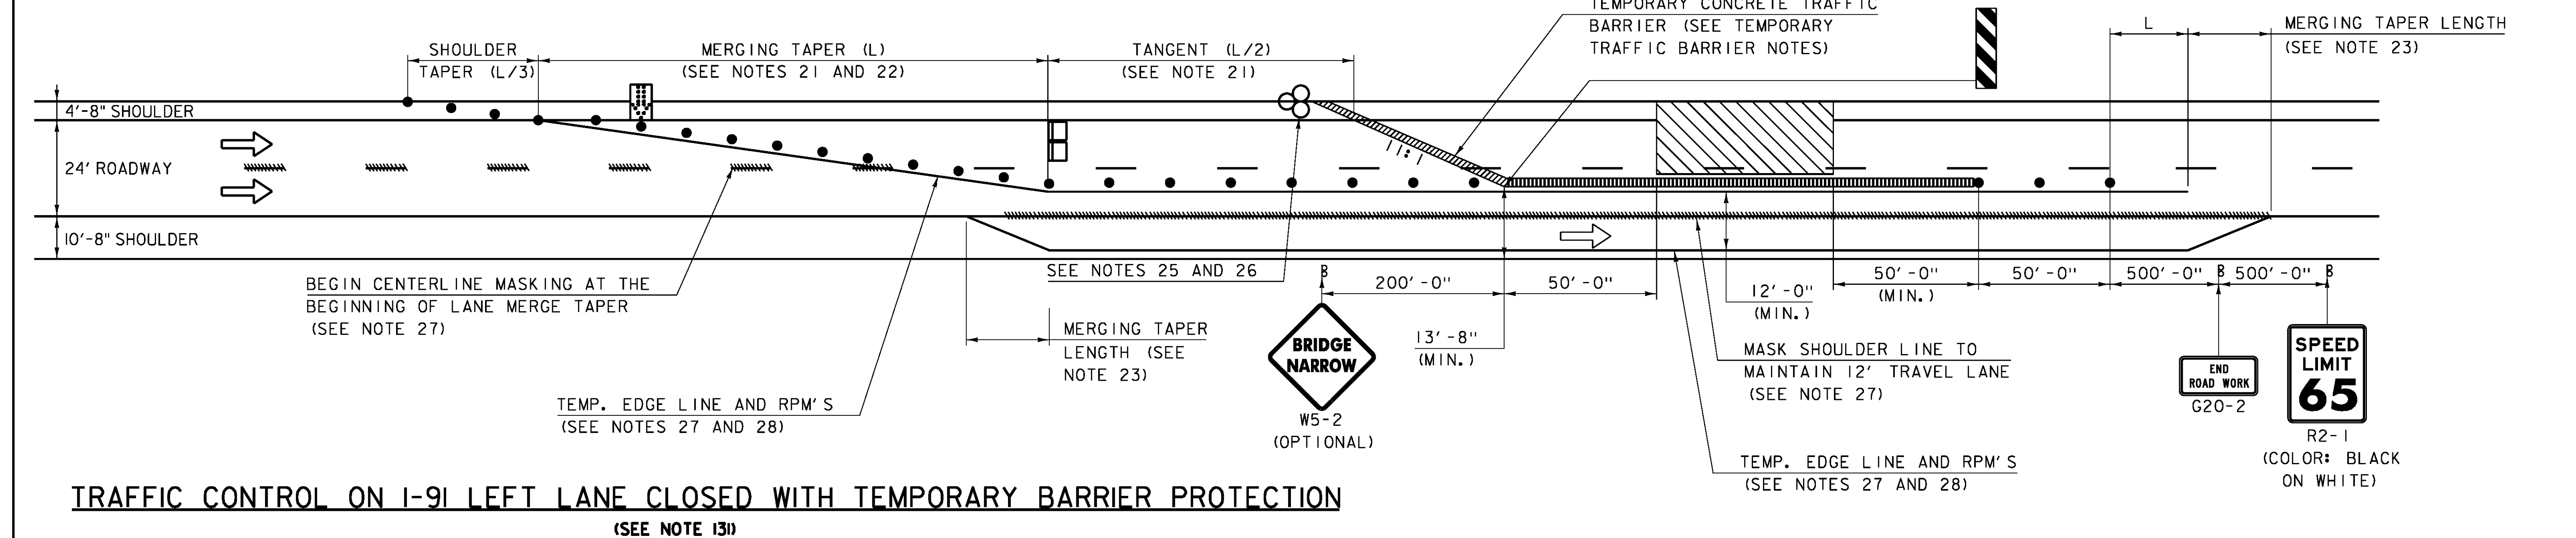

**TRAFFIC CONTROL ON I-91 LEFT LANE CLOSED WITH TEMPORARY BARRIER PROTECTION**  
(SEE NOTE 13)

**LEGEND**

- FLOW OF TRAFFIC
- RETROREFLECTIVE PLASTIC DRUM
- PORTABLE ARROW BOARD
- TYPE III BARRICADE
- WORK AREA
- TRUCK-MOUNTED ATTENUATOR
- ENERGY ABSORPTION ATTENUATOR

POSTED SPEED	TAPER LENGTHS		TANGENT W=12 FT	BARRIER FLARE RATE (MIN.)	MIN. BUFFER SPACE LENGTH	MAXIMUM CHANNELIZING DEVICE SPACING (FT)	
	SHOULDER W=10 FT	MERGING 12 FT LANE*				TAPER	TANGENT
(MPH)	(L/3)	(L)	(L/2)		(FT)	(S)	(2S)
≤40	90	320	160	1:9	305	40	80
45	150	540	270	1:9	360	45	90
50	170	600	300	1:11	425	50	100
55	185	660	330	1:13	495	55	110
60	200	720	360	1:13	570	60	120
65	215	780	390	1:13	645	65	130

* SEE NOTE 22.

TAPER RATES ARE DETERMINED USING THE FOLLOWING EQUATION:  
 $L = WS$  FOR POSTED SPEEDS OF 45 MPH OR GREATER  
 $L = WS^2/60$  FOR POSTED SPEEDS OF 40 MPH OR LESS

L = MINIMUM LENGTH OF TAPER  
W = WIDTH OF OFFSET IN FEET. (TYPICAL)  
S = POSTED SPEED IN MPH

NOTE: ALL NOTE REFERENCES REFER TO NOTES ON TRAFFIC CONTROL SHEET 1.

PROJECT NAME: IRASBURG  
PROJECT NUMBER: IM DECK(46)

FILE NAME: z15all6+cp-107N.dgn  
PROJECT LEADER: J. BYATT  
DESIGNED BY: S. BEAUMONT  
TRAFFIC CONTROL SHEET 3


PLOT DATE: 2/5/2016  
DRAWN BY: S. BEAUMONT  
CHECKED BY: L. GREER  
SHEET 13 OF 49










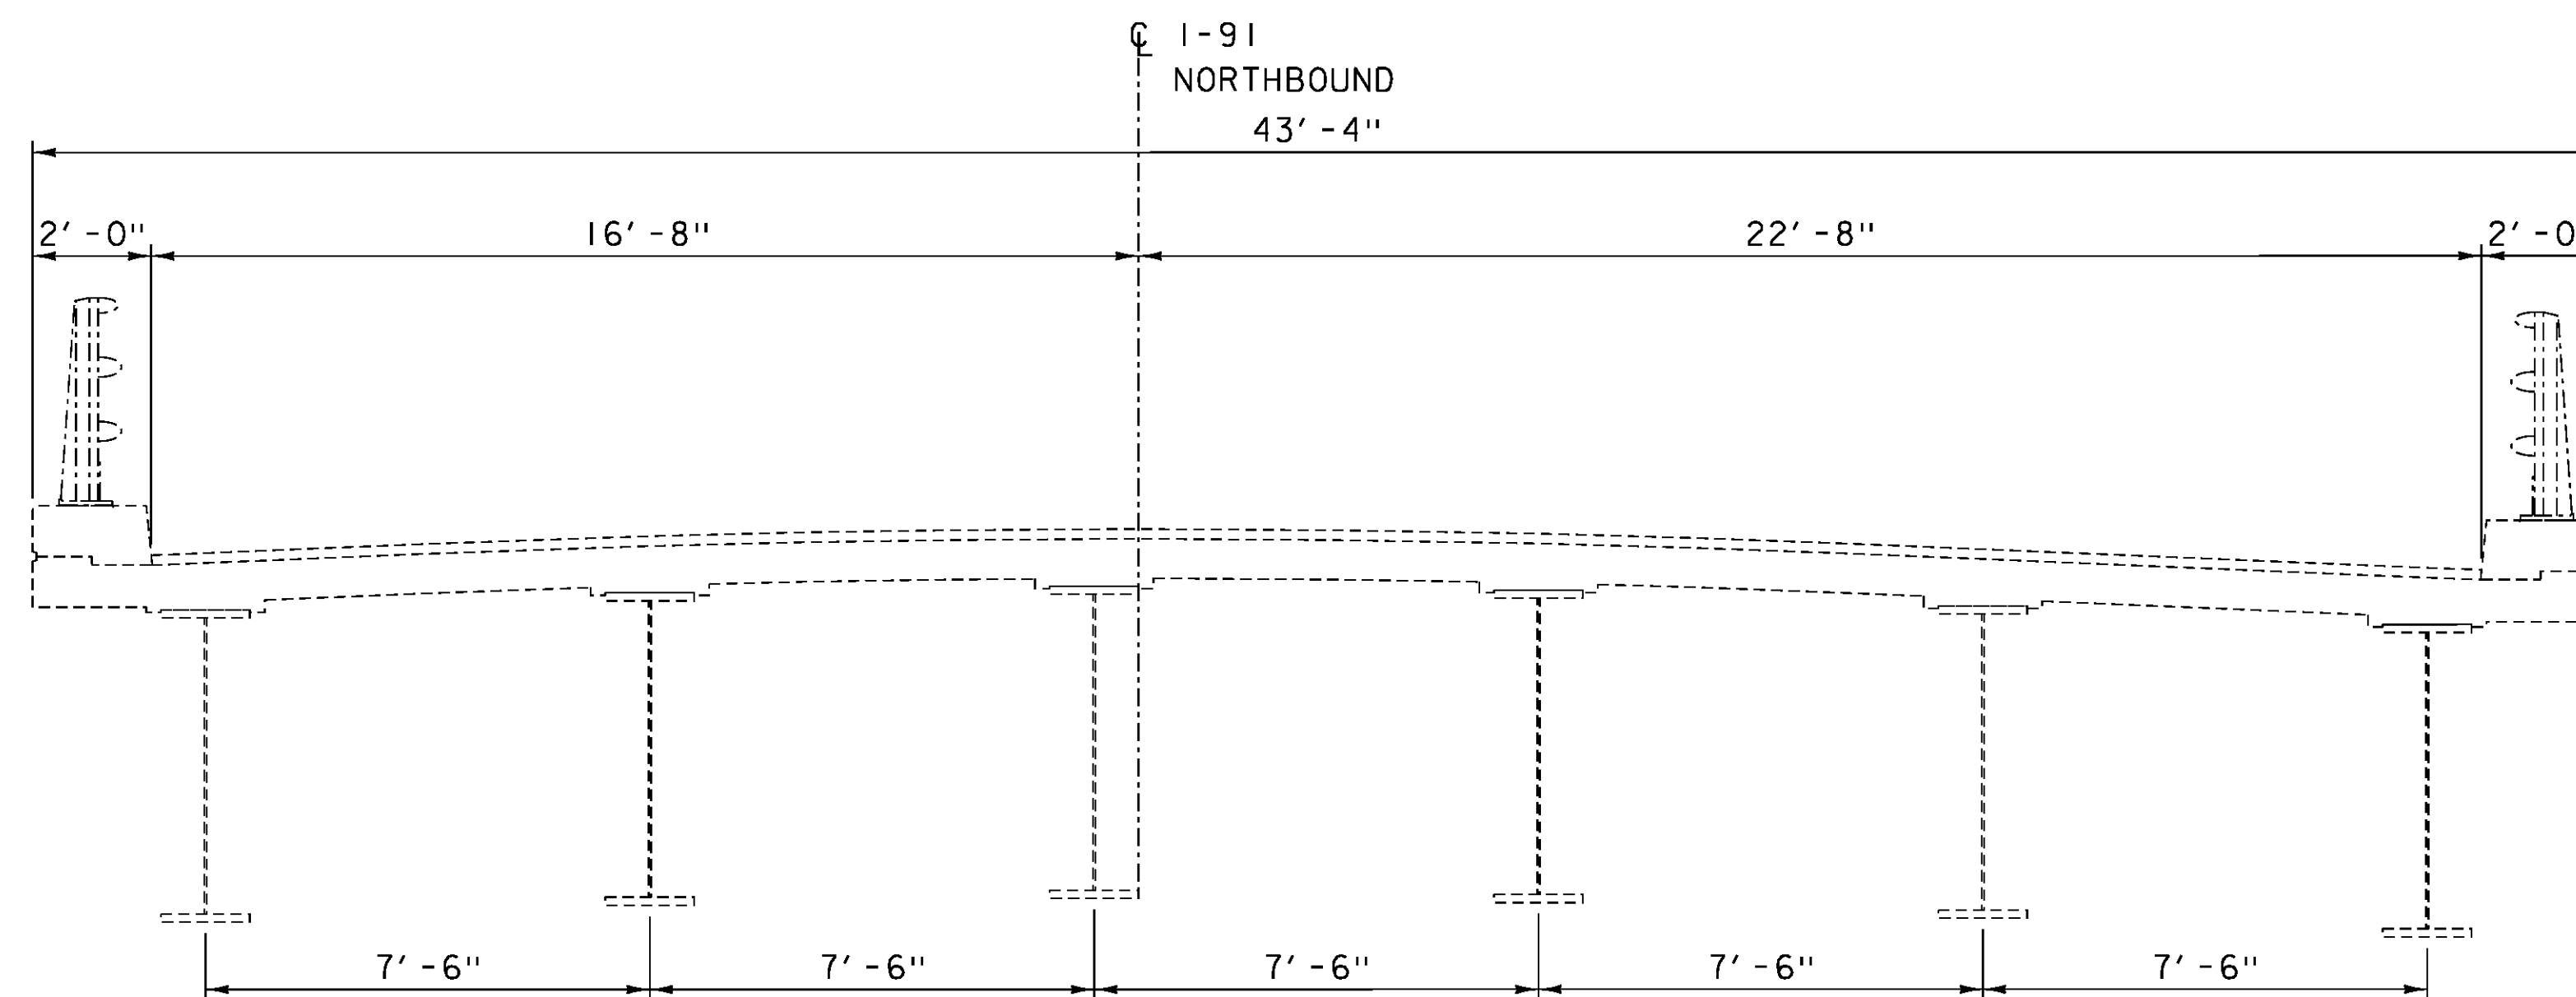

### EXISTING TYPICAL BRIDGE SECTION

SCALE:  $\frac{3}{8}$ " = 1'-0"

SPECIAL PROVISION (BITUMINOUS CONCRETE PAVEMENT - BRIDGE MIX - TYPE IVB) (DEPTH VARIES - SEE JOINT, PAVEMENT, AND MEMBRANE LAYOUT ON SHEET 21 FOR PAVEMENT LIFT INFORMATION.)

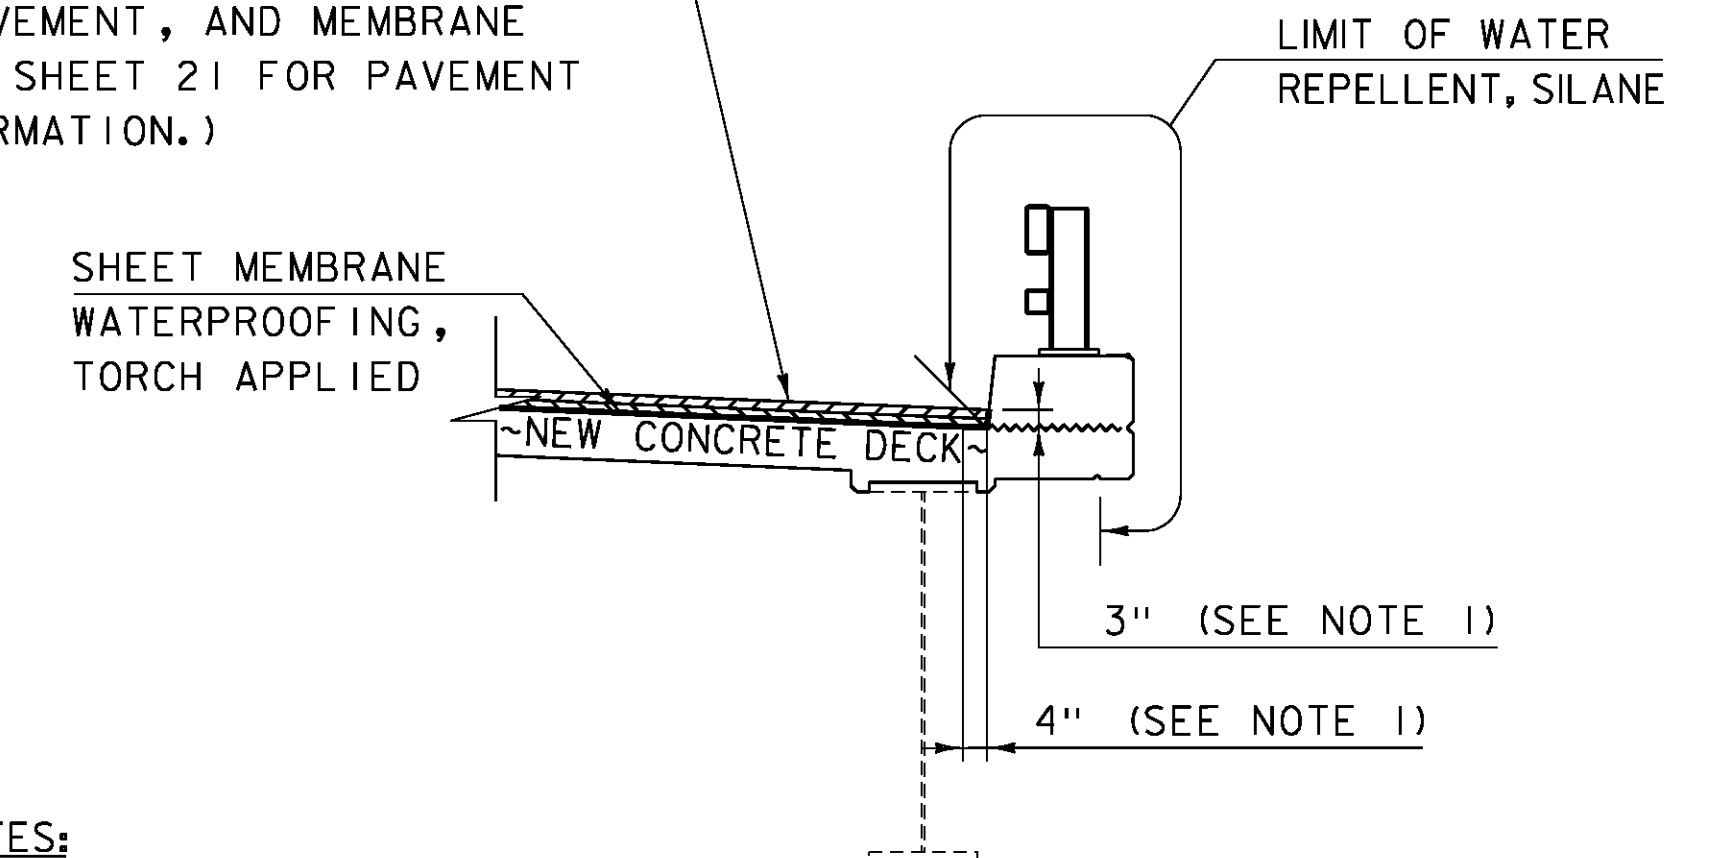


#### DETAIL A NOTES:

1. INDICATES AREA ALONG DECK AND UP FACE OF CURB FOR PLACEMENT OF TWO COATS OF POLYURETHANE MEMBRANE.
2. POLYURETHANE MEMBRANE AND BLAST CLEANING SHALL BE INCLUDED IN THE UNIT PRICE BID FOR SHEET MEMBRANE WATERPROOFING, TORCH APPLIED.
3. SHEET MEMBRANE WATERPROOFING SHALL EXTEND TO FACE OF CURB AS SHOWN.
4. IN ADDITION TO THE REQUIREMENTS OF SUBSECTION 519.04, BLAST CLEAN 3" UP THE FACE OF CURB PRIOR TO PLACING THE MEMBRANE.

### DETAIL A

SCALE:  $\frac{3}{8}$ " = 1'-0"

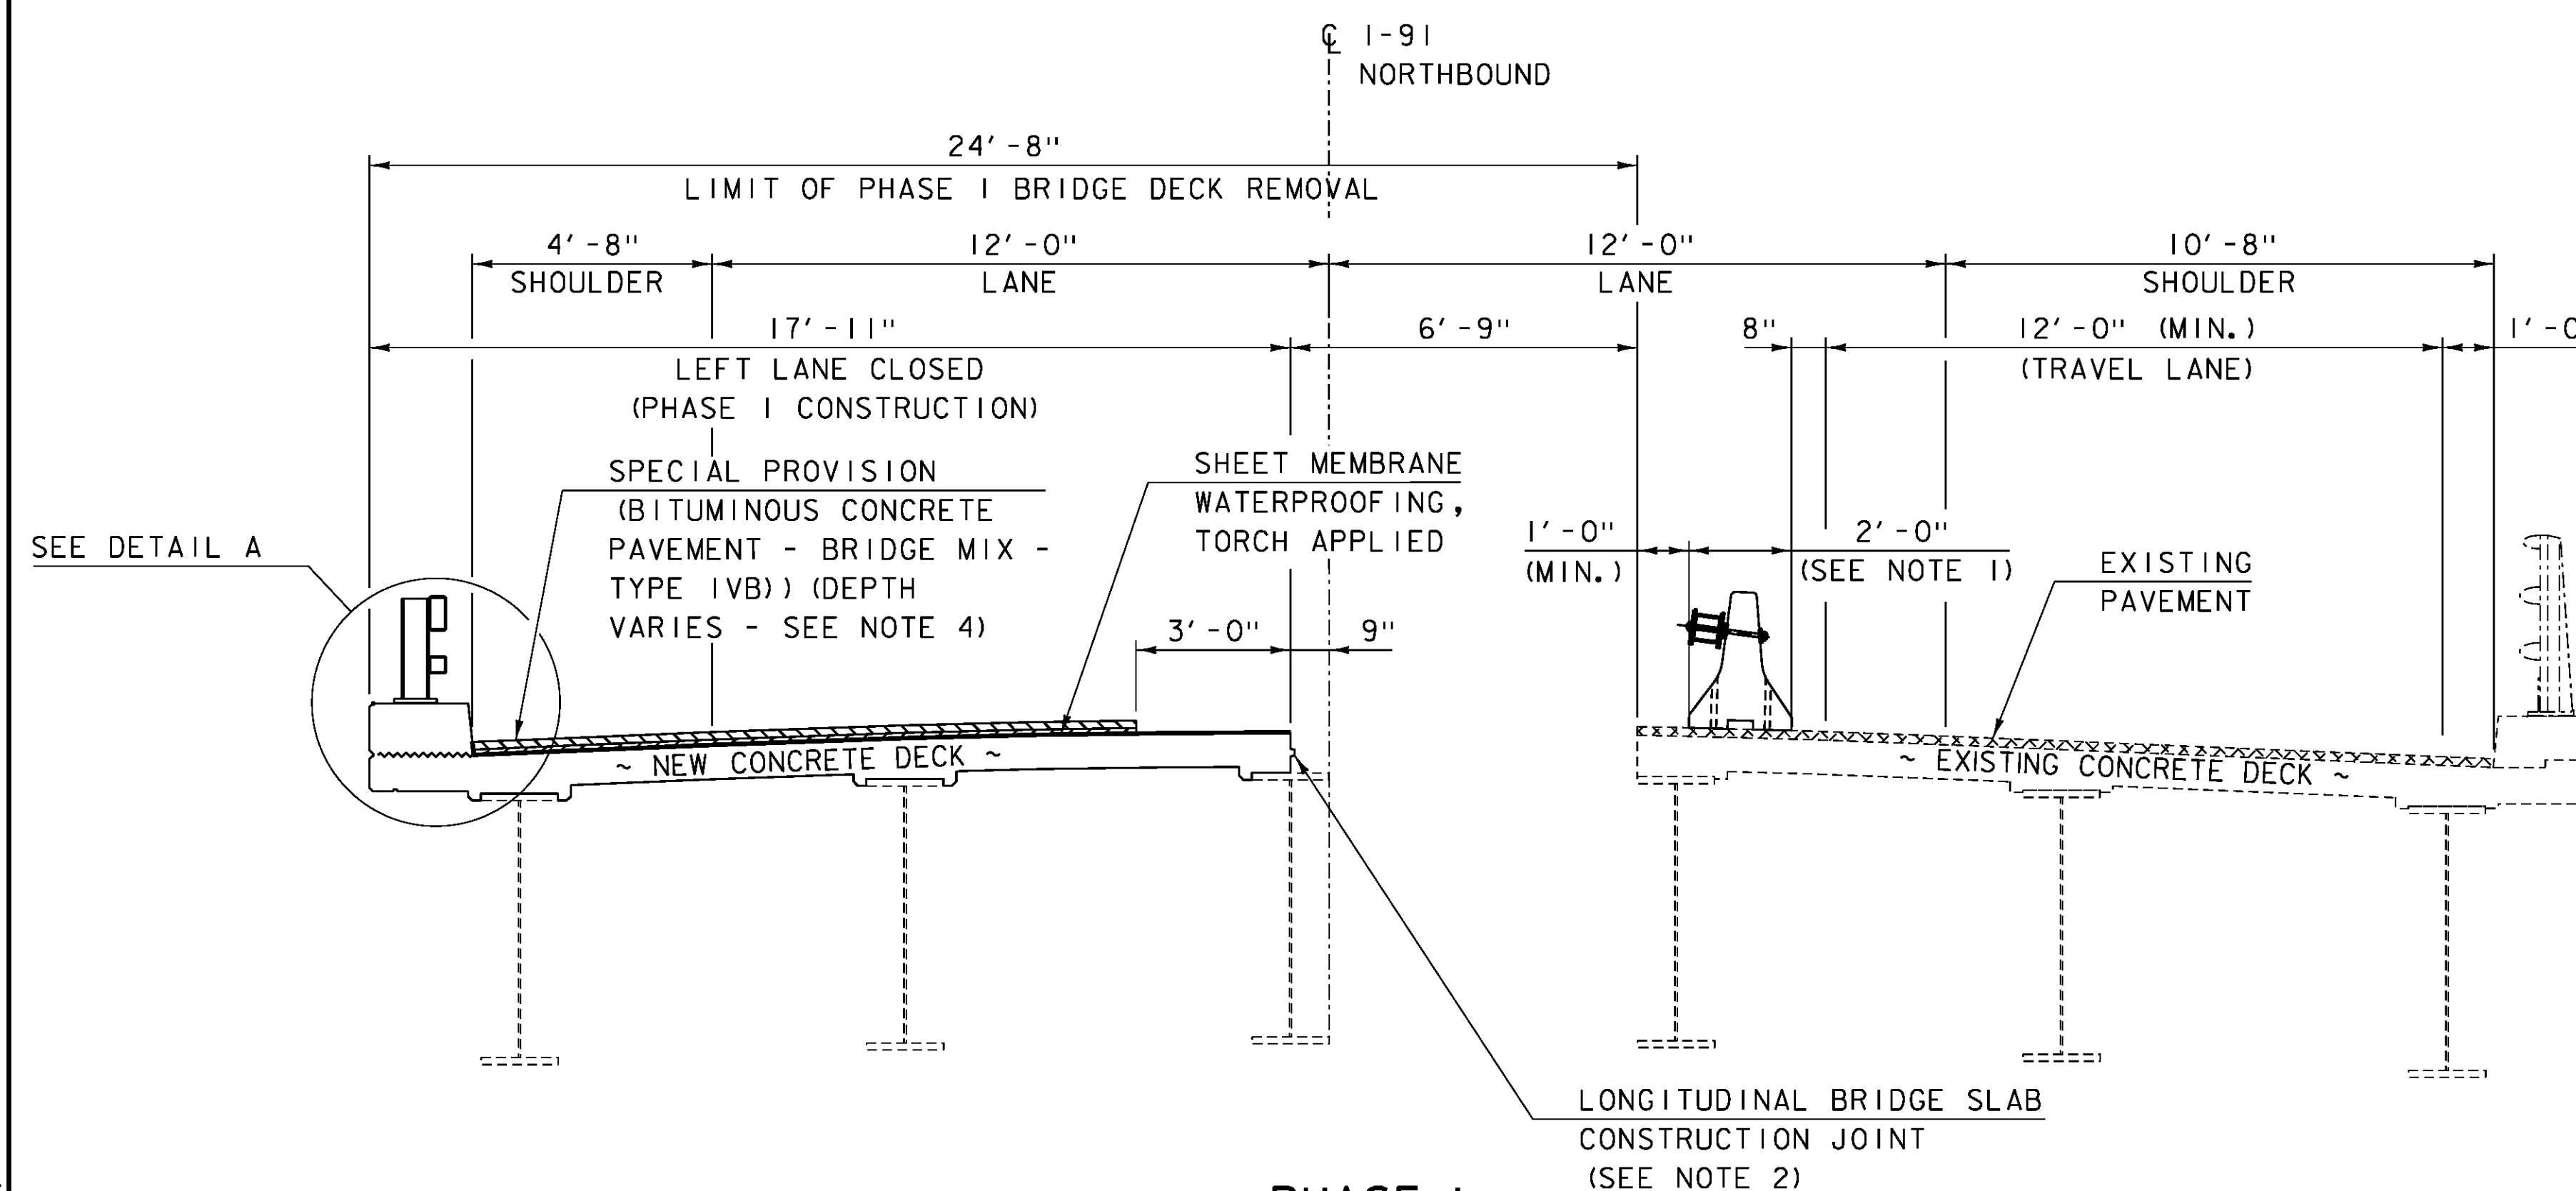



### PHASE I

SCALE:  $\frac{3}{8}$ " = 1'-0"

#### NOTES:




1. TEMPORARY CONCRETE TRAFFIC BARRIER AND TEMPORARY CONCRETE TRAFFIC BARRIER - BRACED SHALL BE REQUIRED DURING BRIDGE DECK CONSTRUCTION OPERATIONS. CHANNELIZING DEVICES SUCH AS RETROREFLECTIVE PLASTIC DRUMS MAY BE UTILIZED DURING PAVING AND MEMBRANE OPERATIONS. SEE TRAFFIC CONTROL NOTES ON TRAFFIC CONTROL SHEET 1.
2. SEE BRACED BARRIER, MEMBRANE OVERLAP, AND LONGITUDINAL BRIDGE SLAB CONSTRUCTION JOINT DETAILS ON SHEET 16 AND TEMPORARY CONCRETE TRAFFIC BARRIER - BRACED DETAILS ON SHEETS 17 AND 18 FOR ADDITIONAL INFORMATION.
3. PLACEMENT OF THE MEMBRANE SHALL START AT THE LOW SIDE OF THE BRIDGE. THE SPLICE SHALL BE AS SHOWN IN THE DETAILS ON THIS PAGE WITH THE HIGH SIDE OVERLAPPING THE LOW SIDE.
4. SEE JOINT, PAVEMENT, AND MEMBRANE LAYOUT ON SHEET 21 FOR PAVEMENT LIFT INFORMATION.



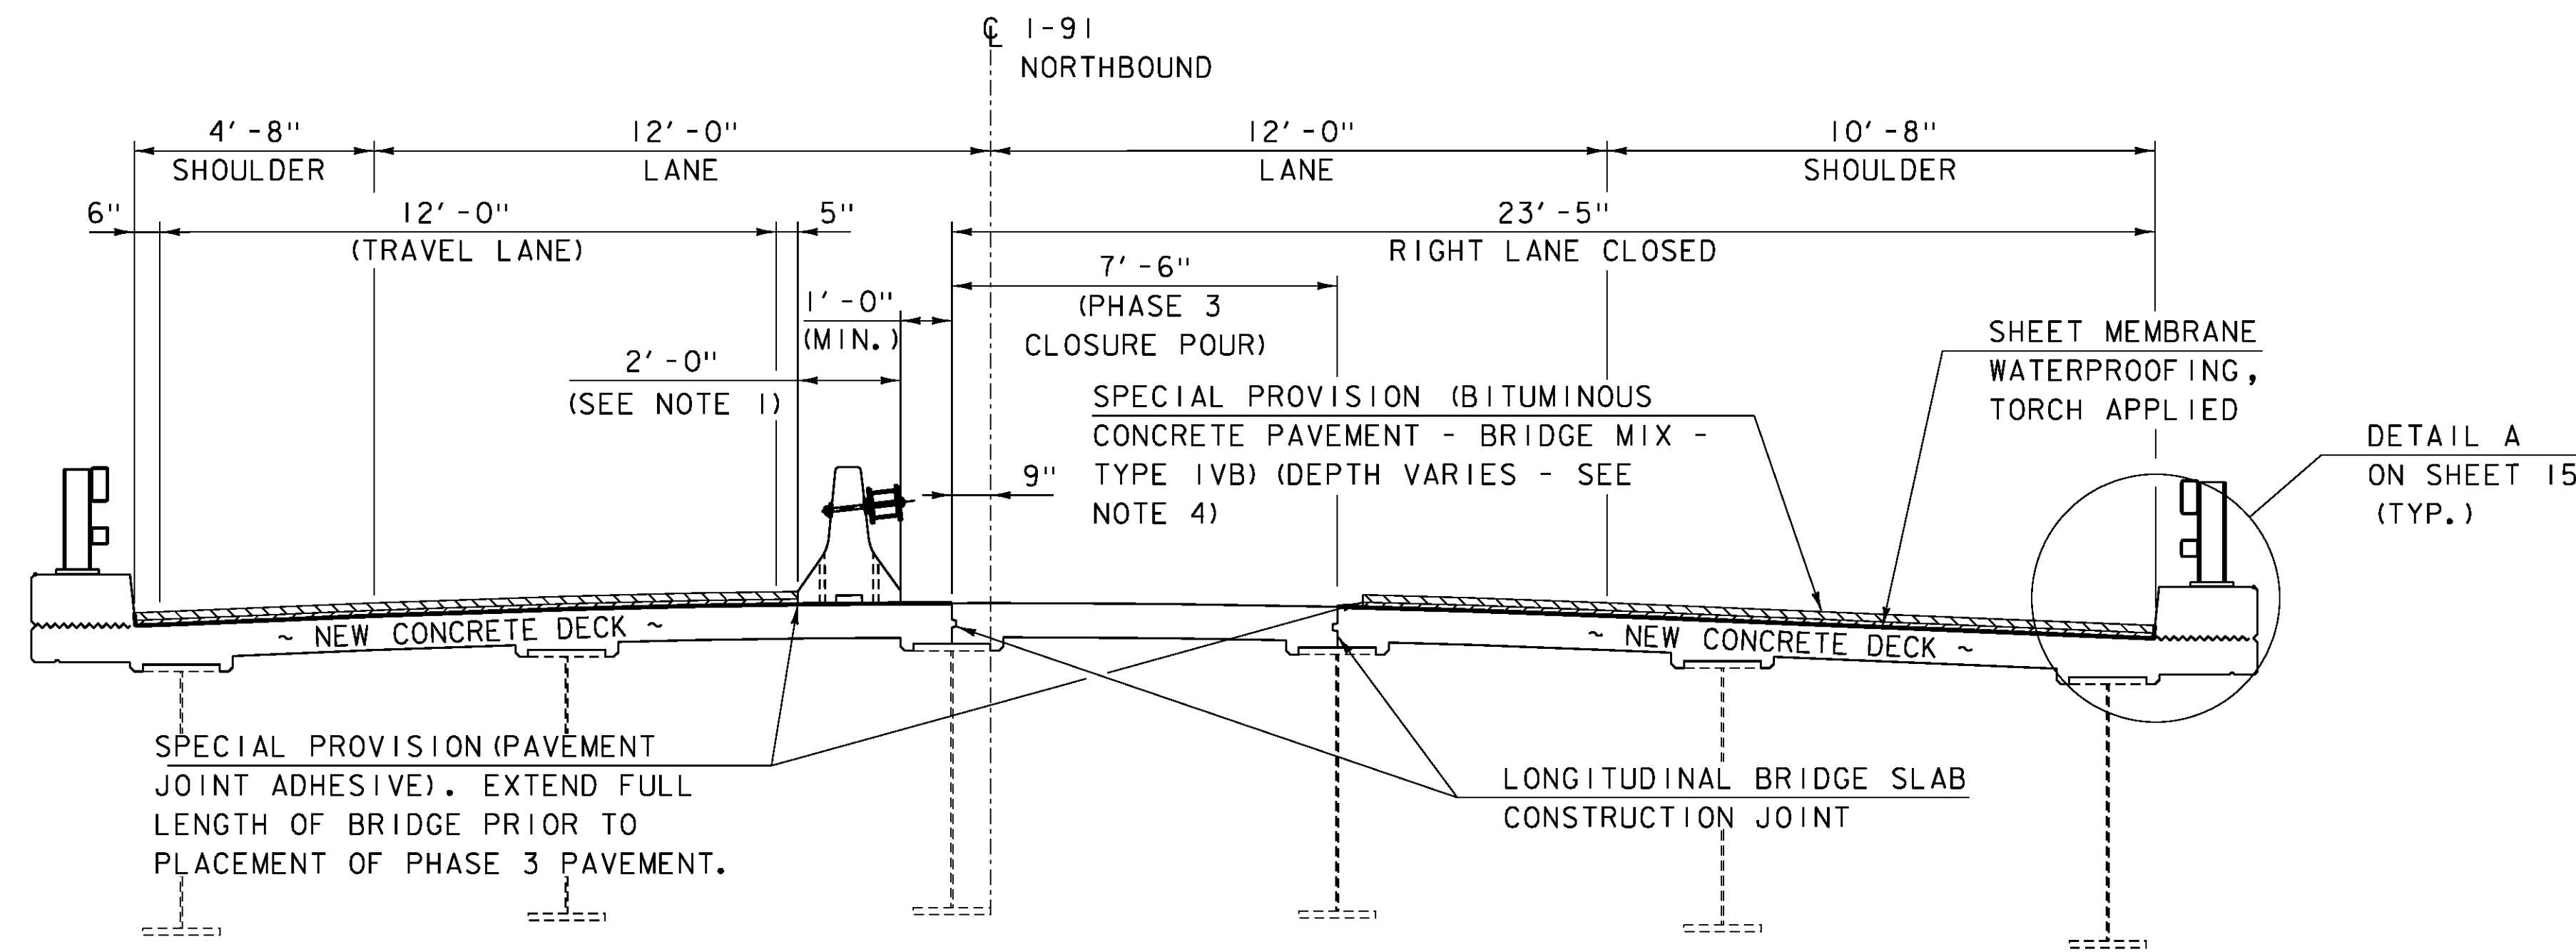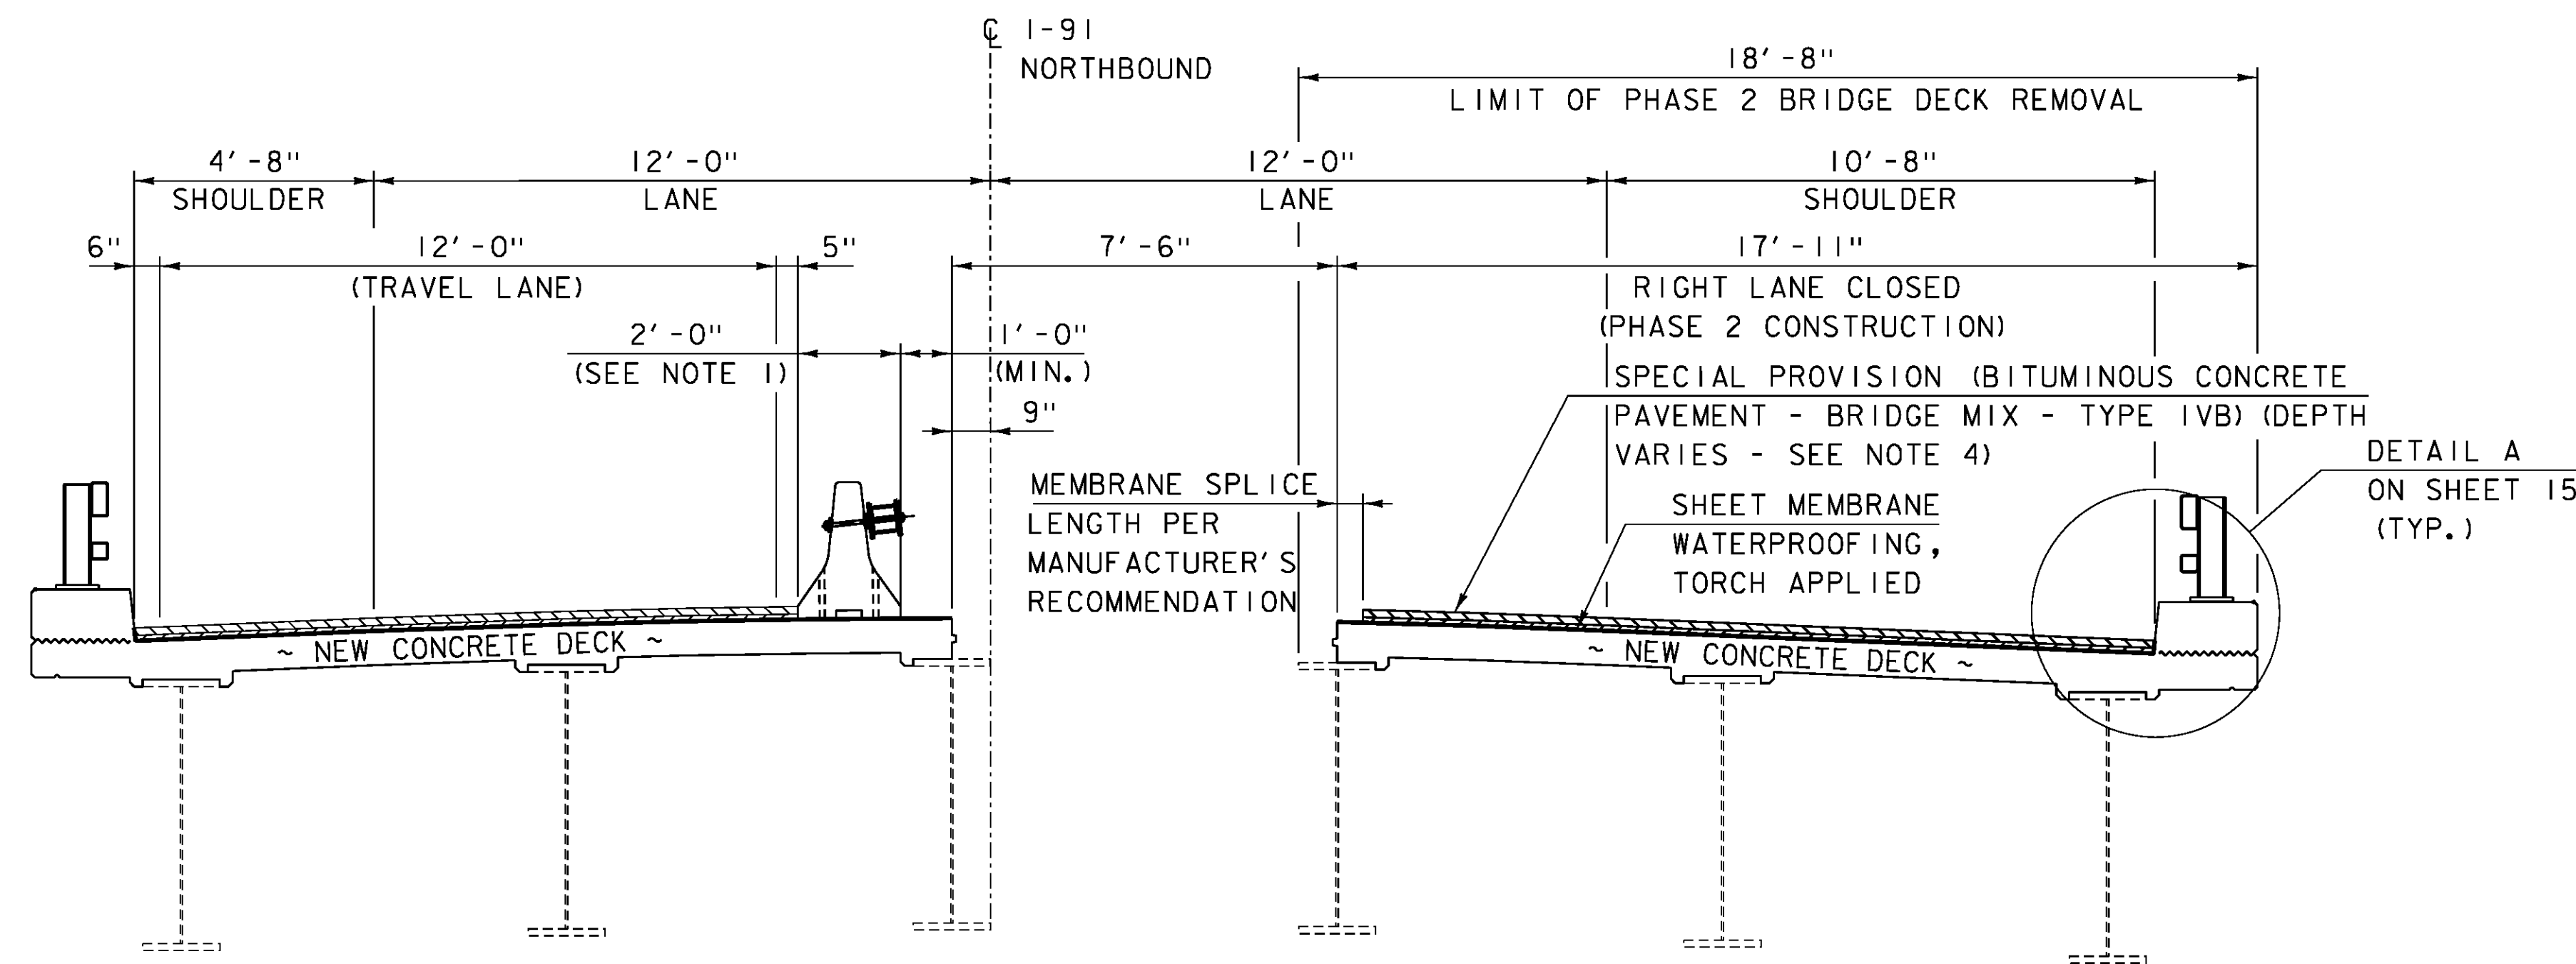

NOTES:










1. TEMPORARY CONCRETE TRAFFIC BARRIER AND TEMPORARY CONCRETE TRAFFIC BARRIER - BRACED SHALL BE REQUIRED DURING BRIDGE DECK CONSTRUCTION OPERATIONS. CHANNELIZING DEVICES SUCH AS RETROREFLECTIVE PLASTIC DRUMS MAY BE UTILIZED DURING PAVING AND MEMBRANE OPERATIONS. SEE TRAFFIC CONTROL NOTES ON TRAFFIC CONTROL SHEET 1.
2. SEE TEMPORARY CONCRETE TRAFFIC BARRIER - BRACED DETAILS ON SHEETS 17 AND 18 FOR ADDITIONAL INFORMATION.
3. PLACEMENT OF THE MEMBRANE SHALL START AT THE LOW SIDE OF THE BRIDGE. THE SPLICE SHALL BE AS SHOWN IN THE DETAILS ON THIS PAGE WITH THE HIGH SIDE OVERLAPPING THE LOW SIDE.
4. SEE JOINT, PAVEMENT, AND MEMBRANE LAYOUT ON SHEET 21 FOR PAVEMENT LIFT INFORMATION.
5. AFTER PHASE 3 IS COMPLETE, SHIFT TRAFFIC TO THE RIGHT LANE AND COMPLETE MEMBRANE AND PAVING OPERATIONS.

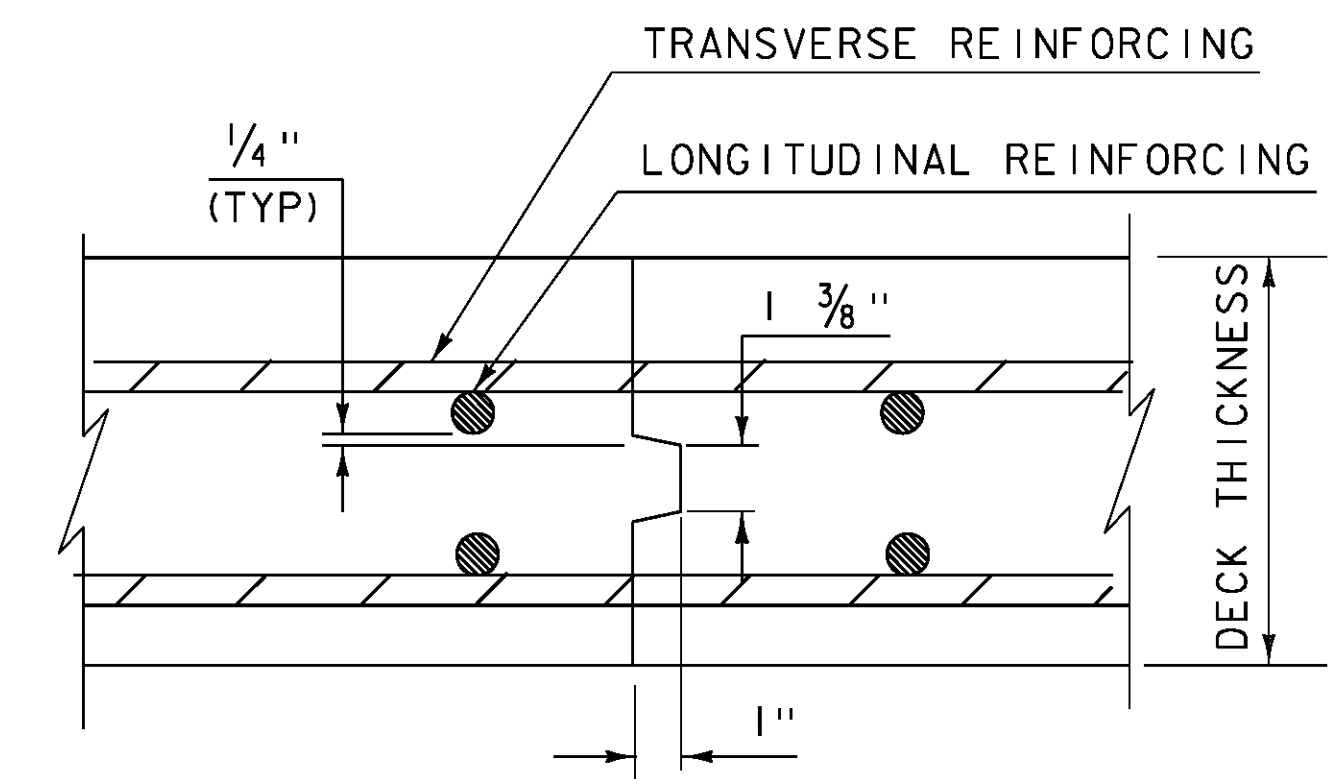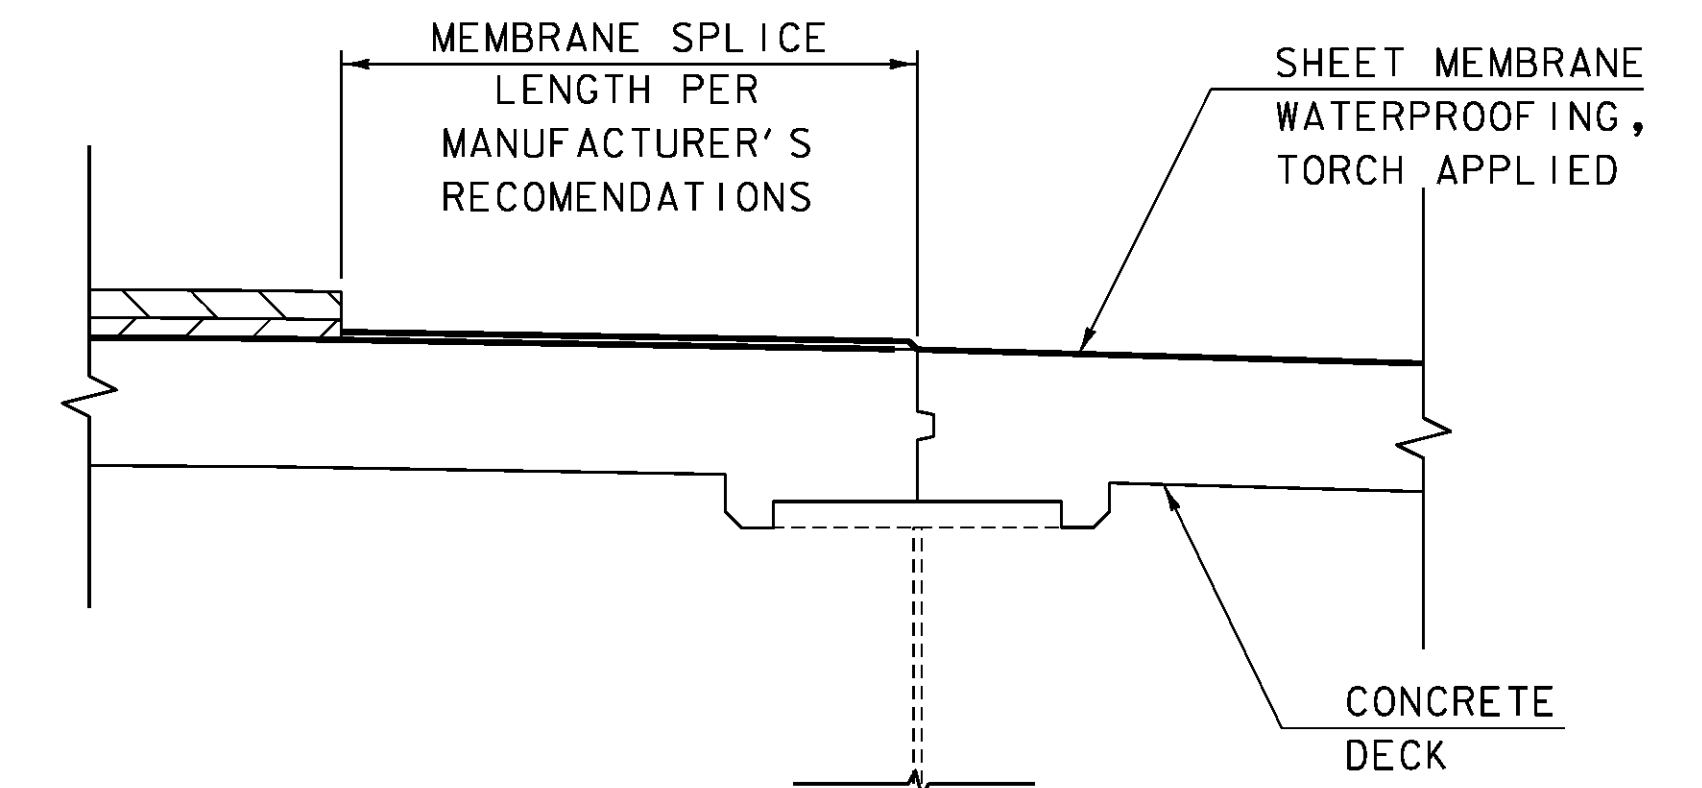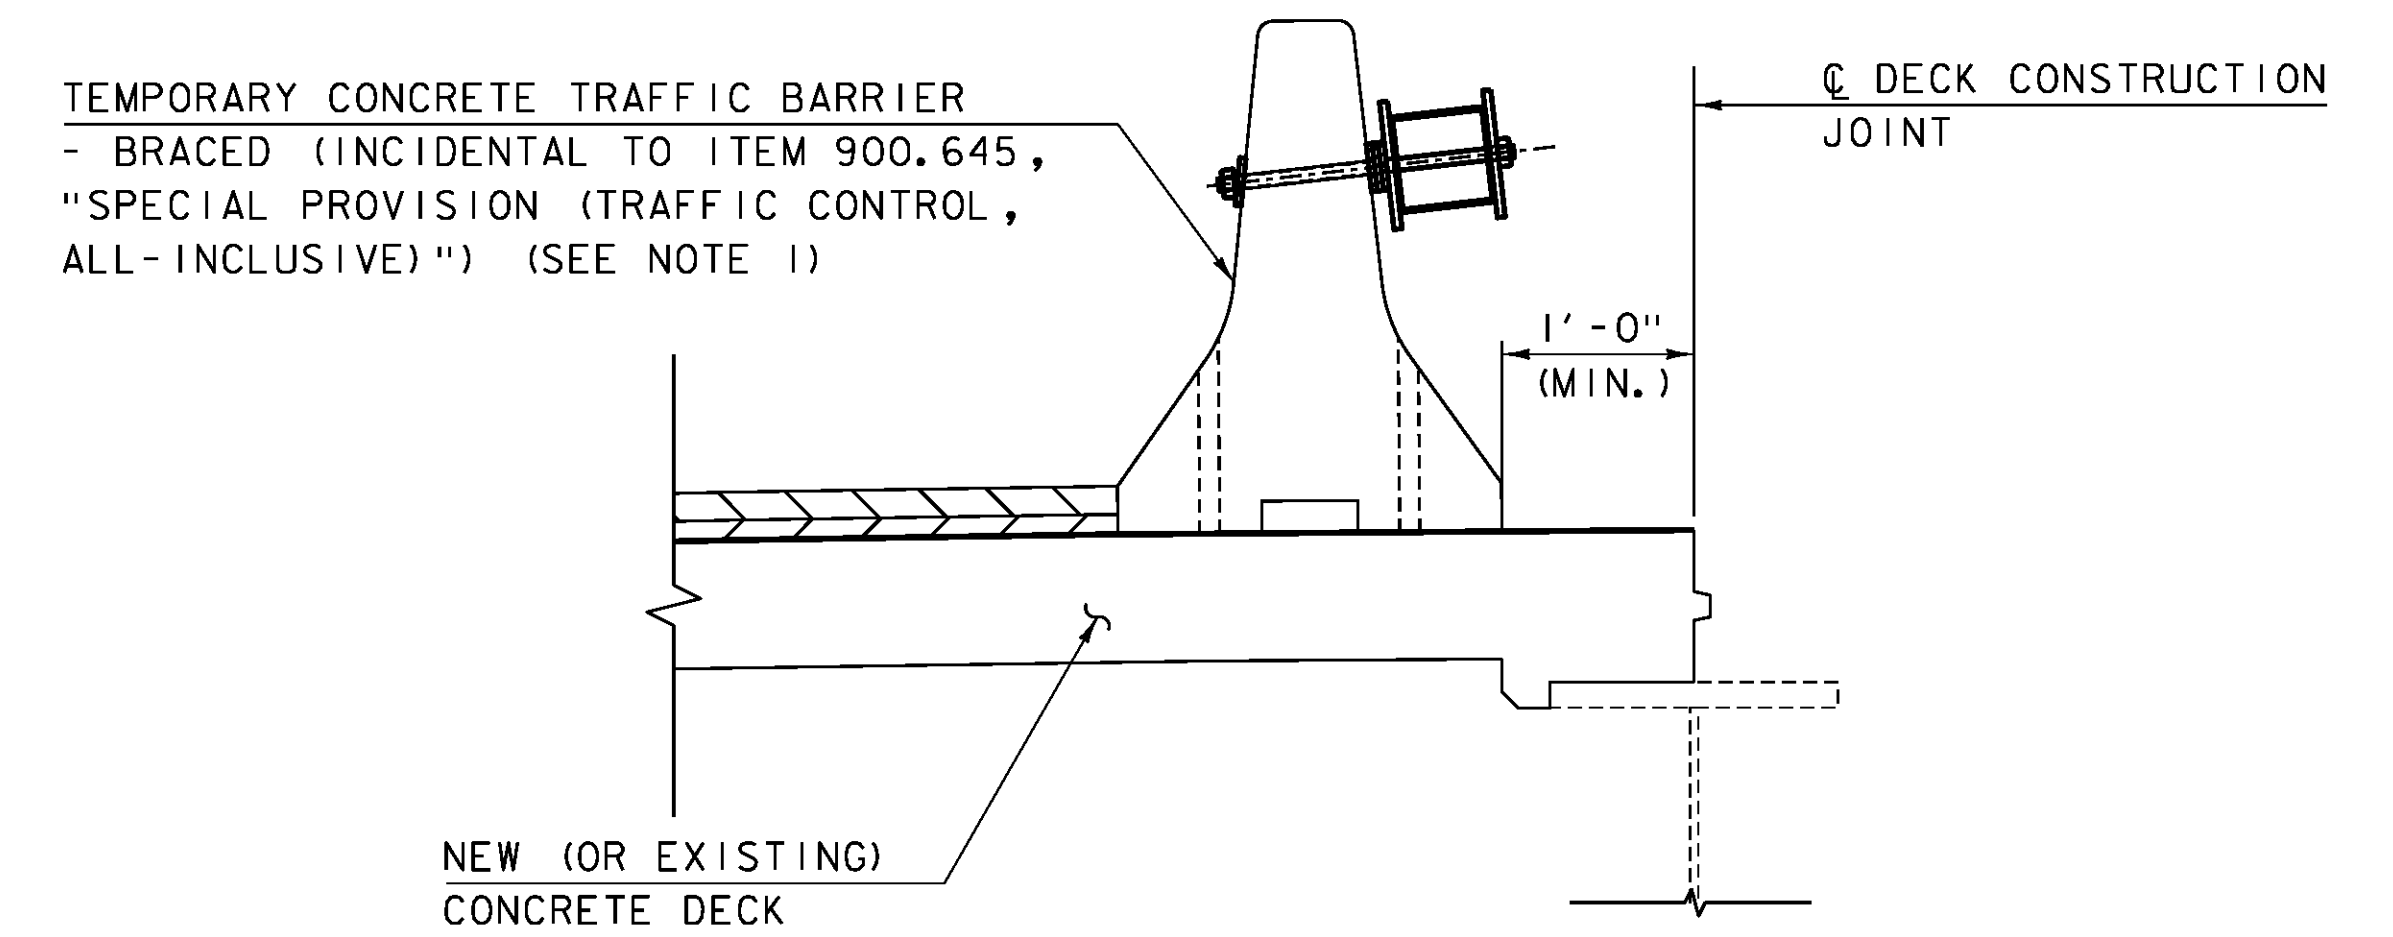

PROJECT NAME:	IRASBURG	PLOT DATE:	2/5/2016
PROJECT NUMBER:	IM DECK(46)	DRAWN BY:	M. SMITH
FILE NAME:	z15dl6+cp-107N.dgn	CHECKED BY:	S. BEAUMONT
PROJECT LEADER:	J. BYATT	SHEET	16 OF 49
DESIGNED BY:	J. FRENCH		
PHASING SECTIONS SHEET 2			





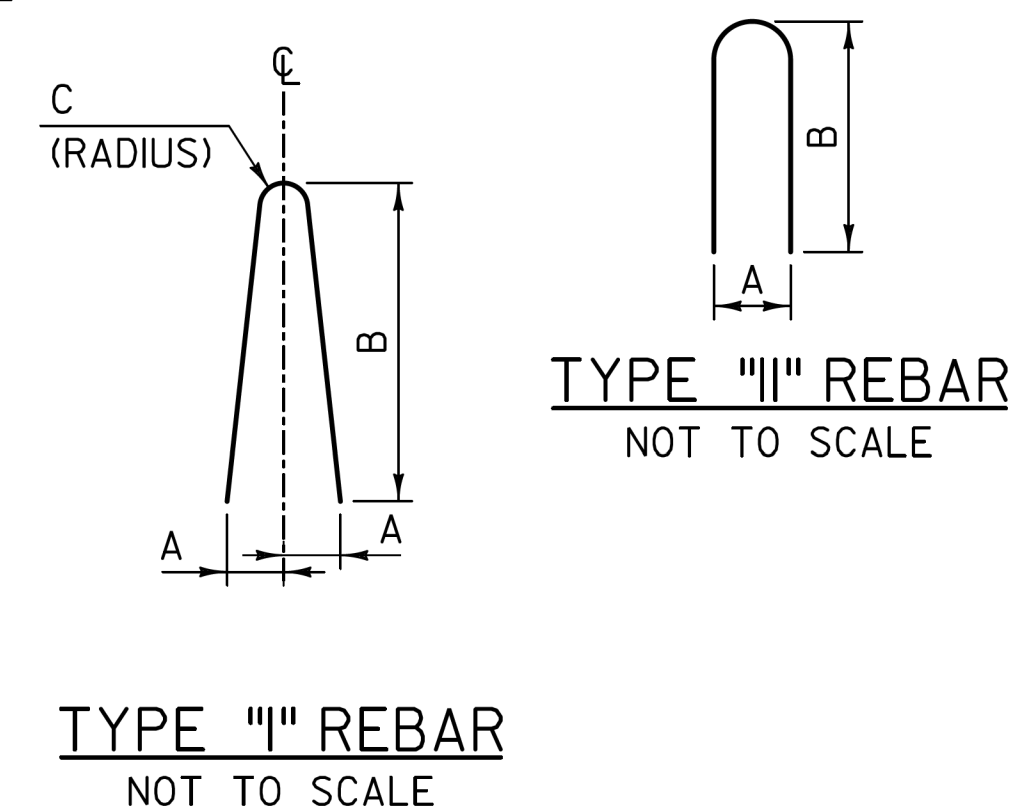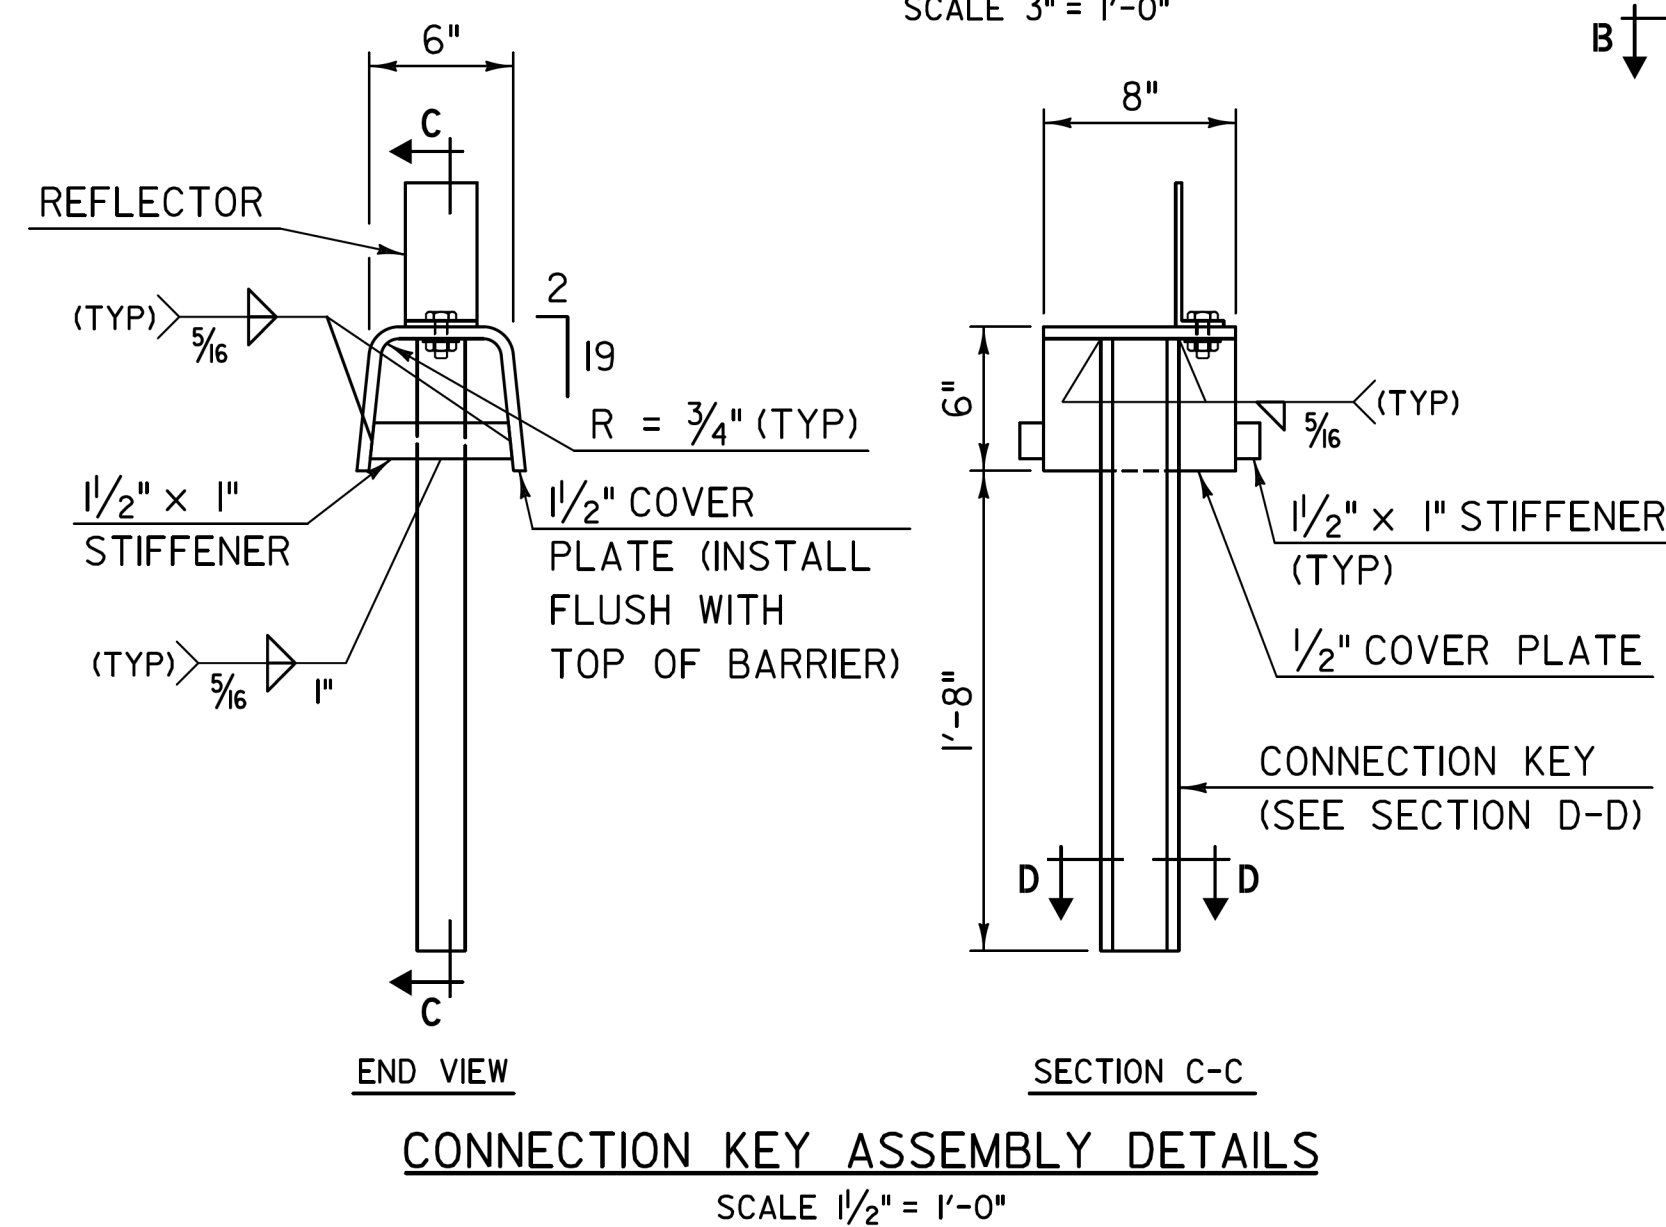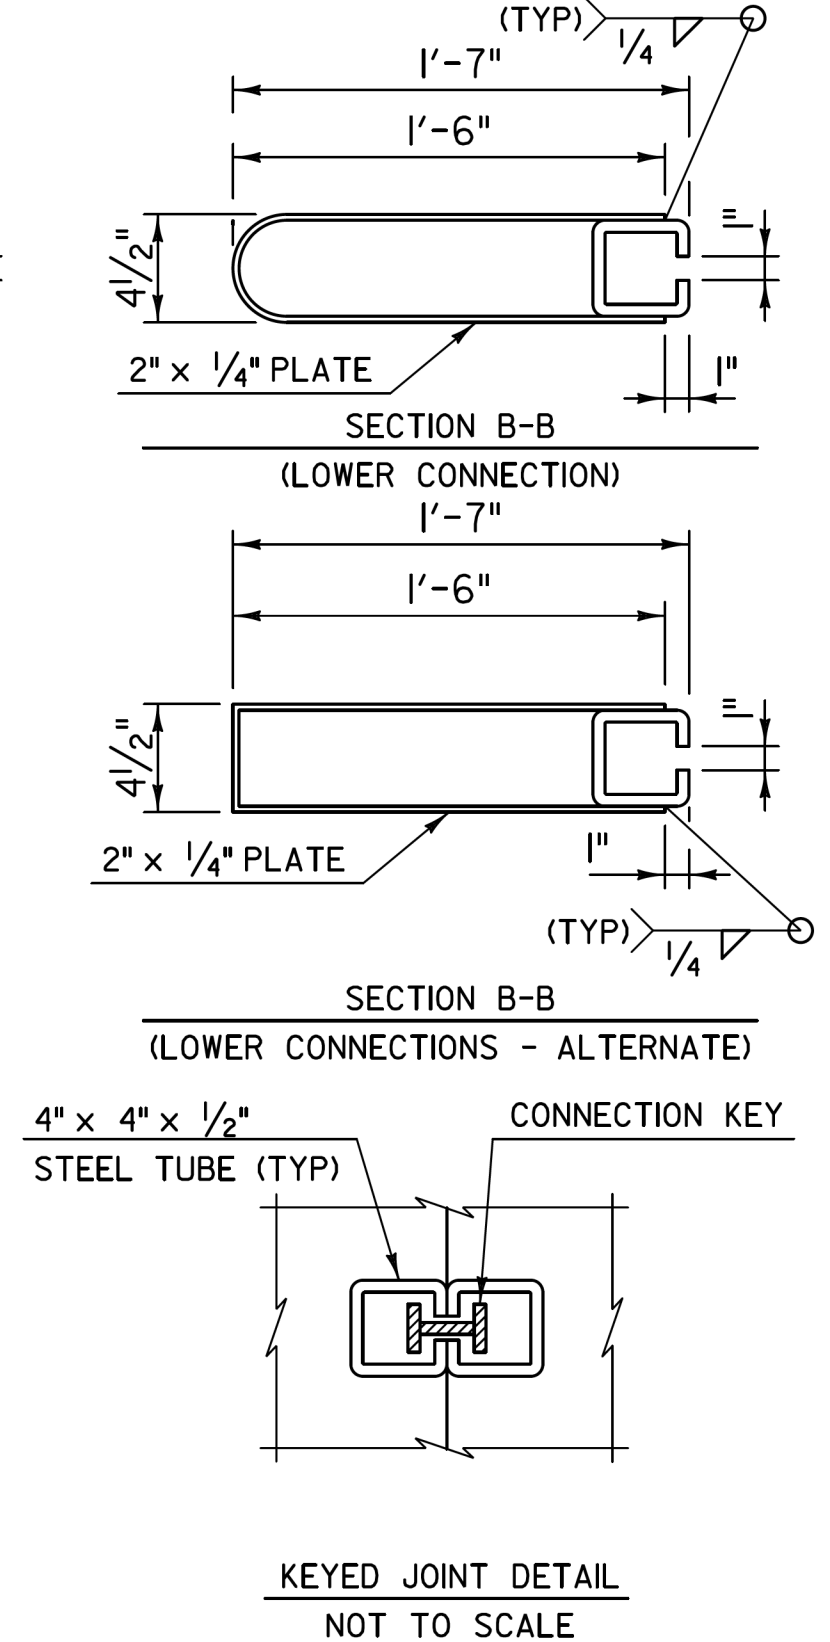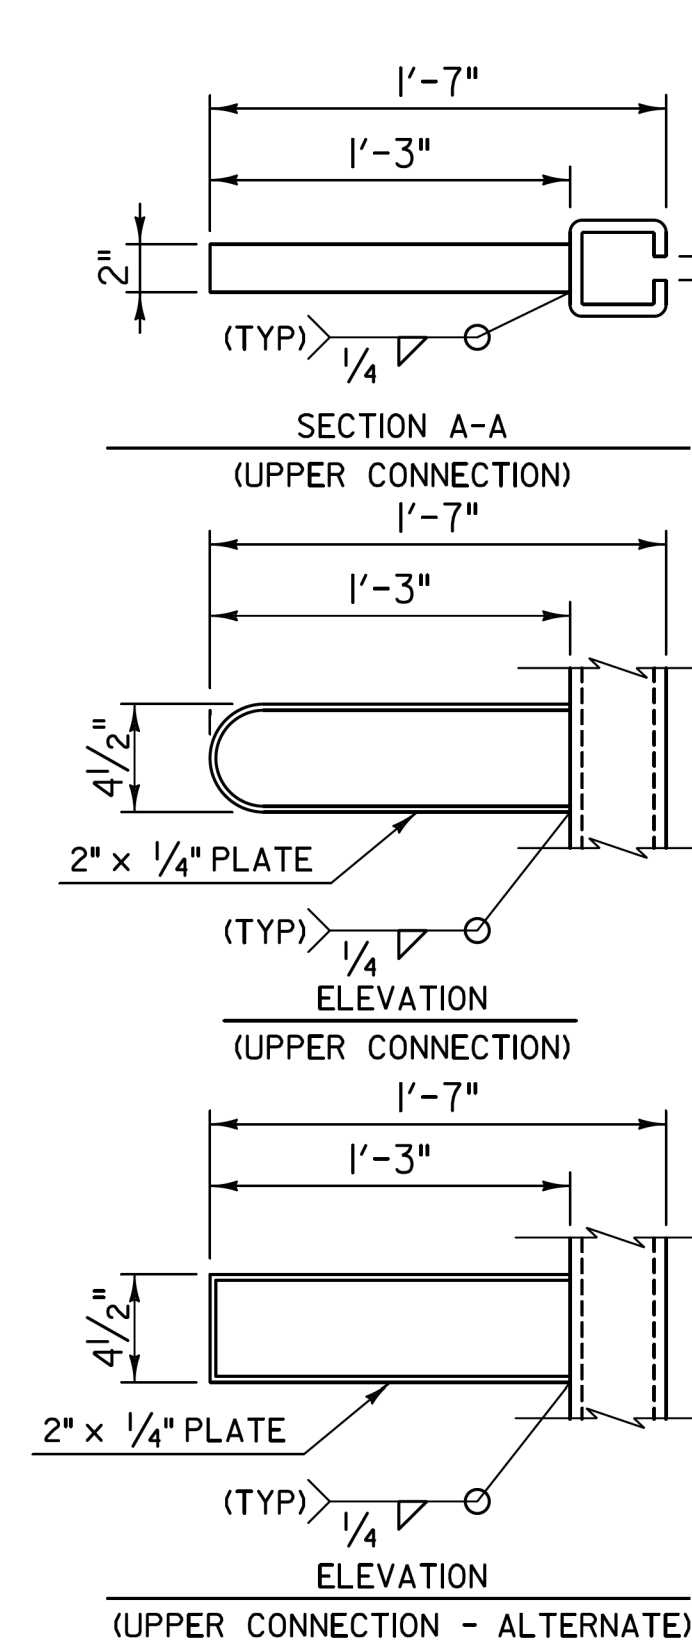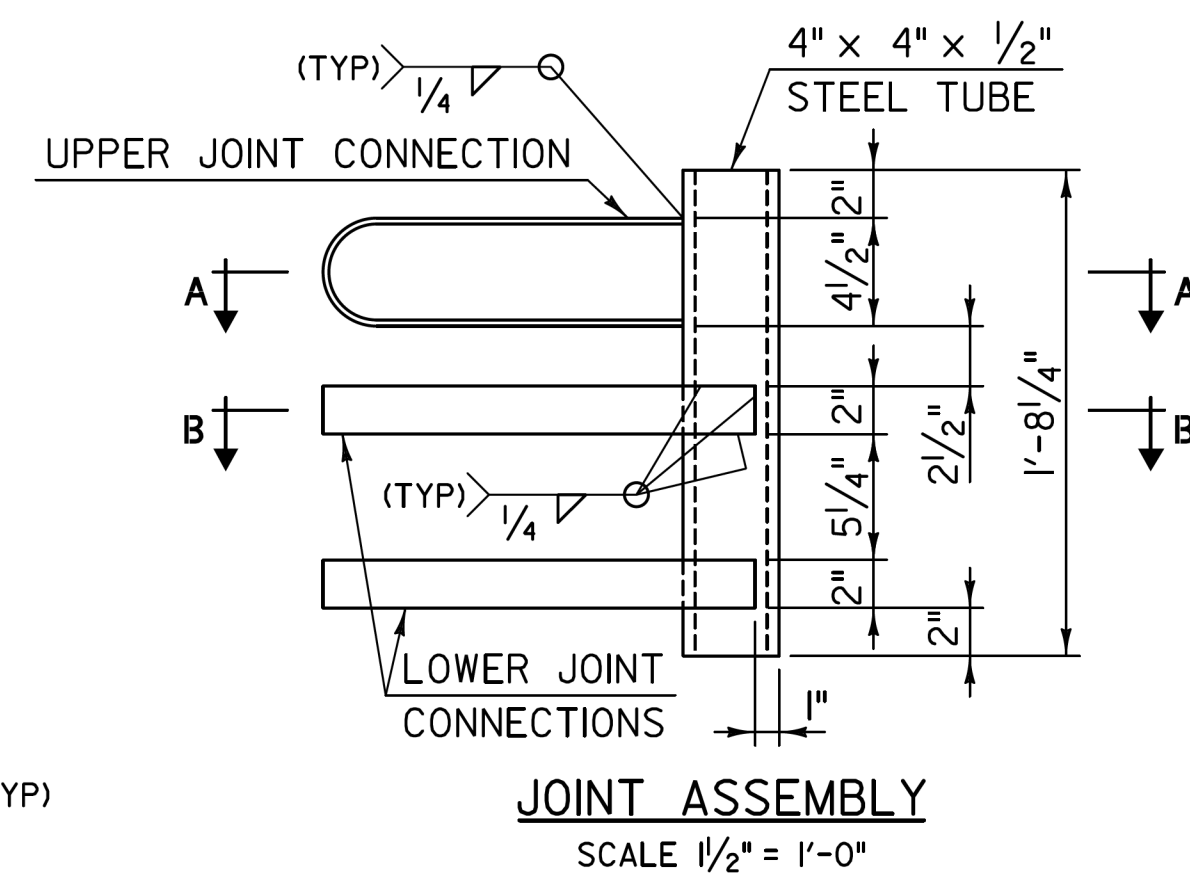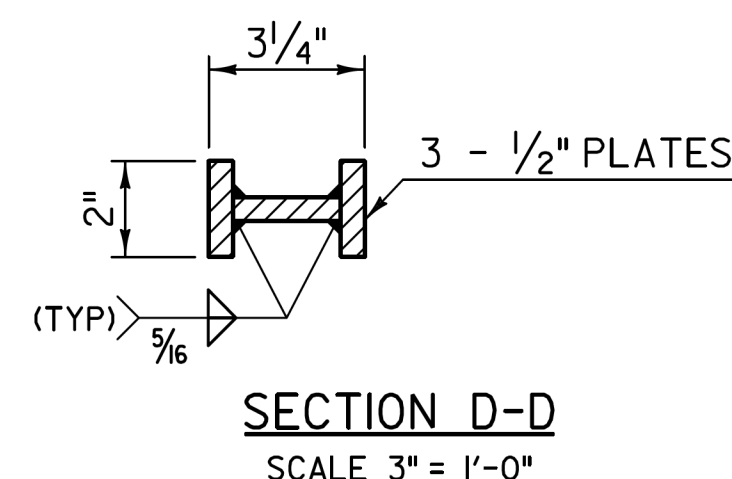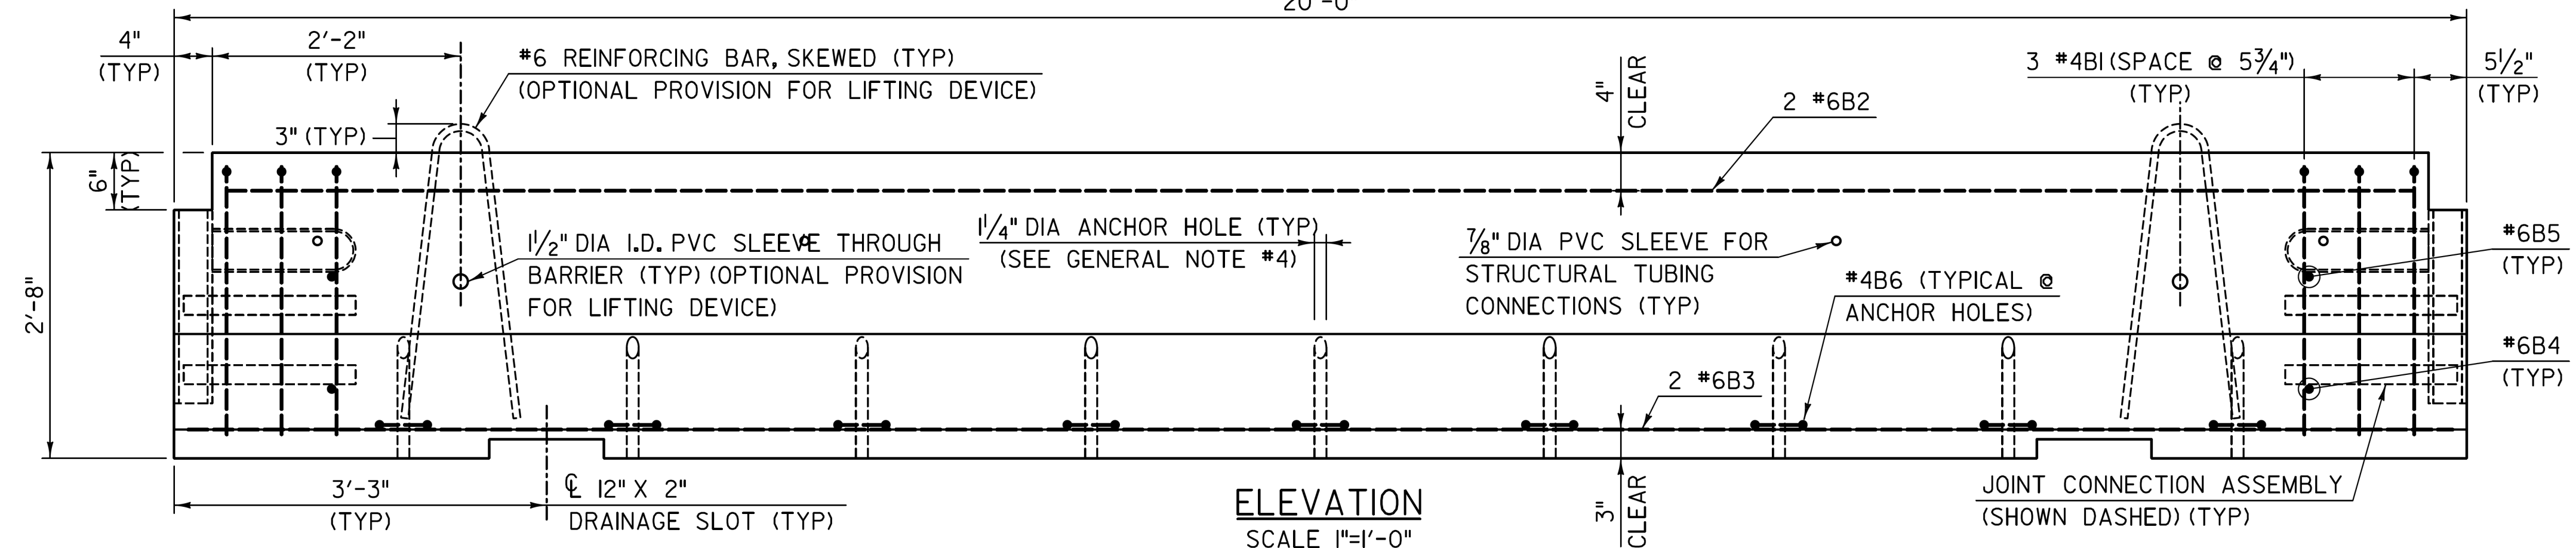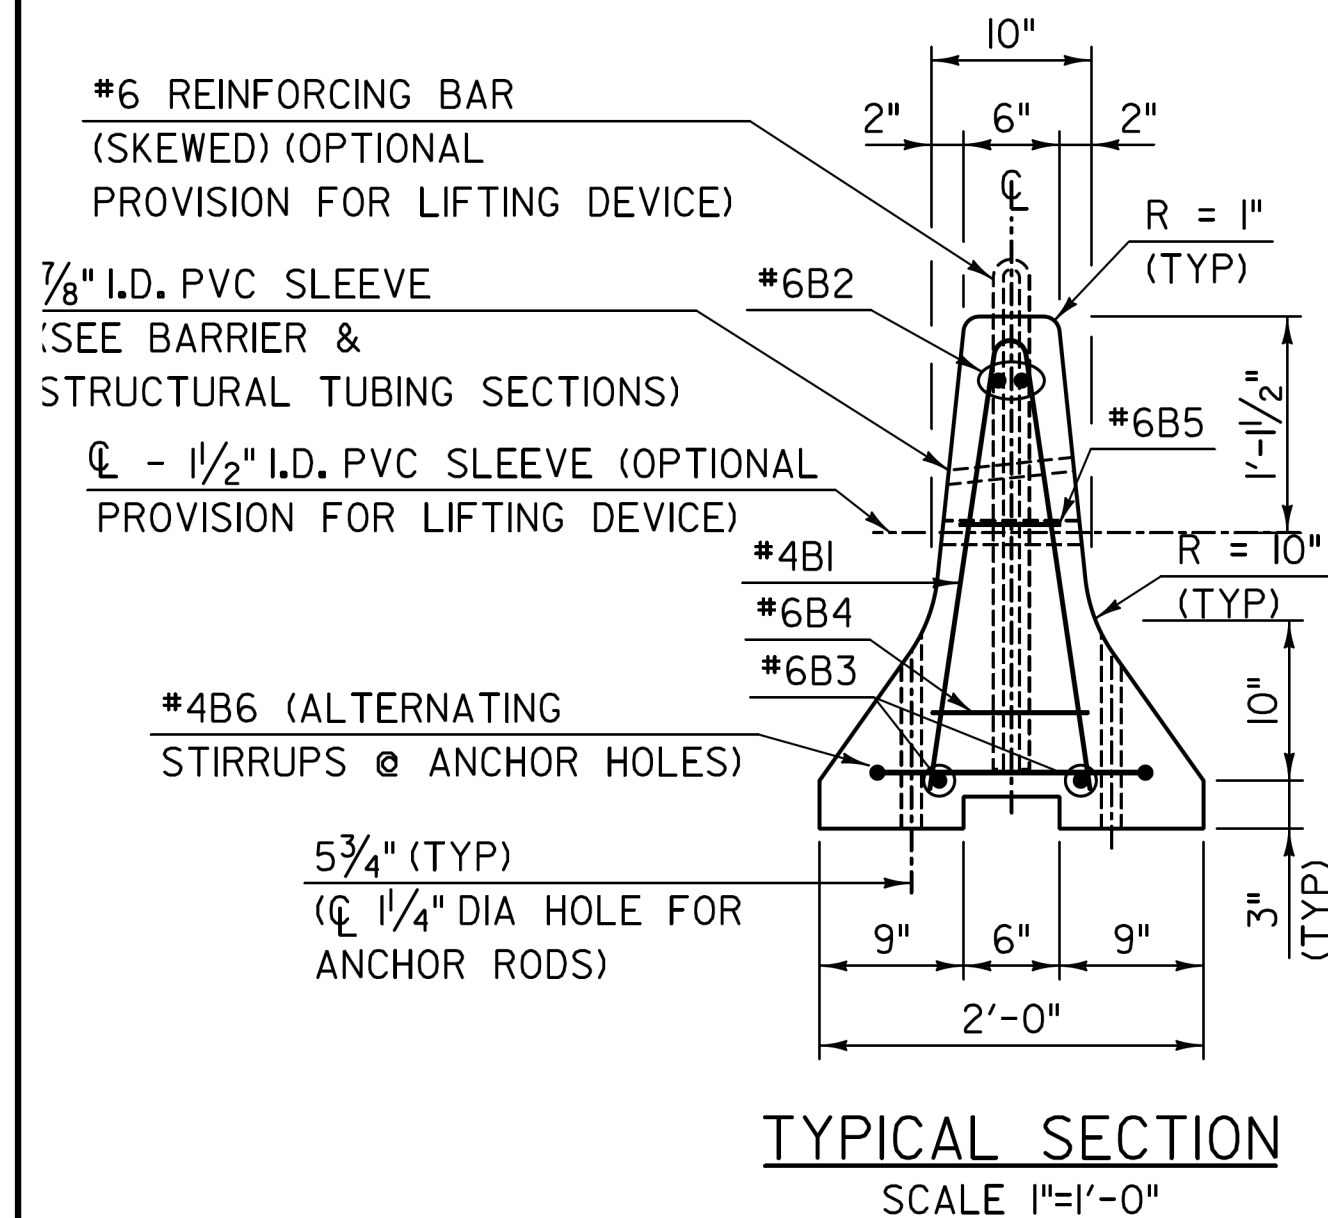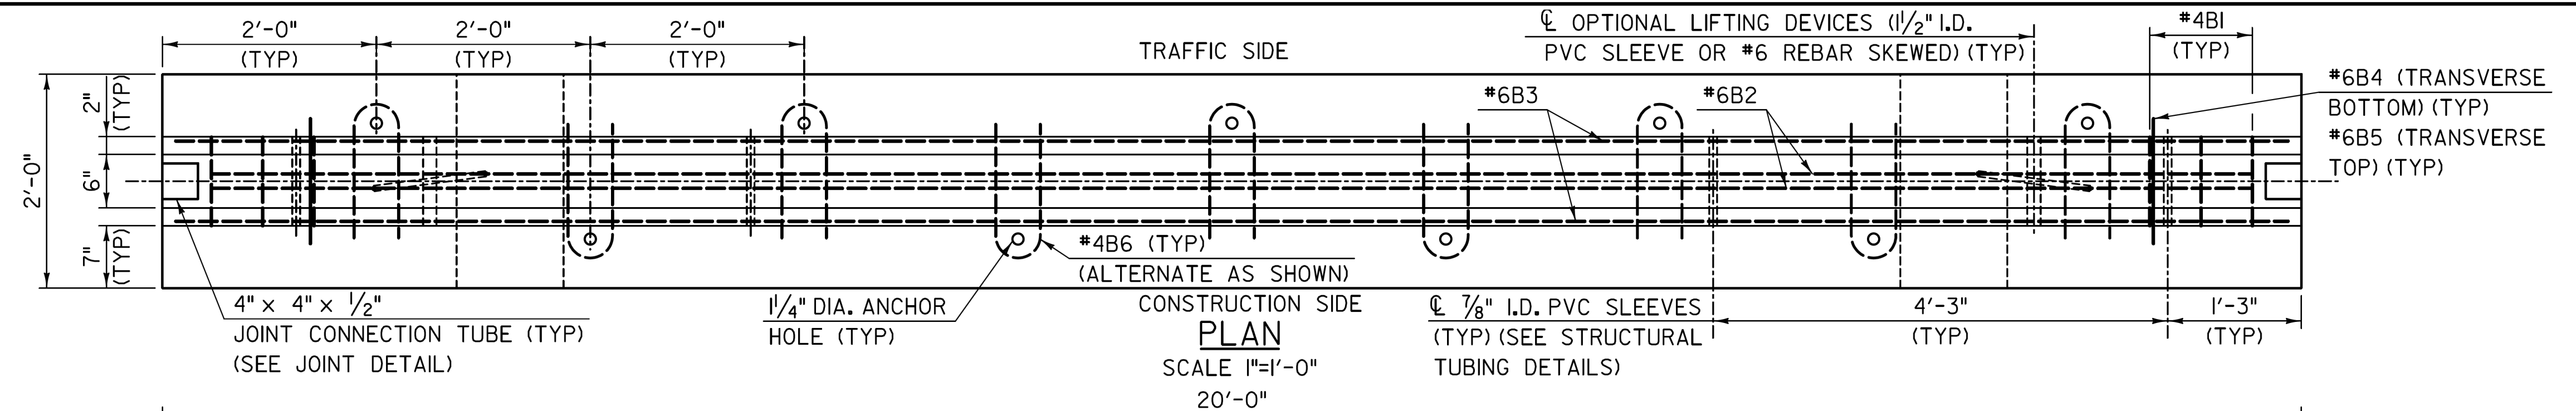

- ## GENERAL NOTES

1. TEMPORARY TRAFFIC BARRIER-BRACED SHALL BE FURNISHED BY THE CONTRACTOR AND PAYMENT SHALL BE INCLUDED IN PAY ITEM 900.645 SPECIAL PROVISION (TRAFFIC CONTROL, ALL INCLUSIVE). CONCRETE BARRIER AND ALL ATTACHMENTS SHALL BE FABRICATED IN ACCORDANCE WITH SECTION 62L. ALL BARRIER UNITS FOR BRACED SYSTEMS SHALL BE 20' LONG.
2. TEMPORARY TRAFFIC BARRIER-BRACED DETAILS, AS SHOWN IN THESE PLANS, ARE IN COMPLIANCE WITH REQUIREMENTS PER UPDATED NCHRP REPORT 350 FOR TEST NO. 3-1, TL-3 CRASH TESTED BY MIDWEST ROADSIDE SAFETY; NY BOX BEAM STIFFENING OF UNANCHORED TCB, MARCH 2008, THE BARRIER SYSTEM TESTED WITH A 27.6" DYNAMIC DEFLECTION AND ALLOWS FOR PLACEMENT AT A MINIMUM 12" DISTANCE BETWEEN BARRIERS AND EDGE OF BRIDGE DECK.
3. A MINIMUM OF TWO BARRIER UNITS WITH BRACED JOINTS ARE REQUIRED TO BE PLACED BEYOND BOTH ENDS OF THE BRIDGE WORK AREA FOR SPEEDS GREATER THAN 45 MPH. FOR SPEEDS ≤ 45 MPH, A MINIMUM OF ONE BRACED BARRIER IS REQUIRED TO BE FULLY SET BEYOND EACH END OF BRIDGE WORK AREA.
4. THE LAST CONCRETE BARRIER UNIT, AT EACH END OF BARRIER LAYOUT, SHALL BE ANCHORED A MINIMUM 18" BELOW THE ROADWAY SURFACE. REQUIRED 1" DIA. ANCHOR RODS (A36 STEEL) SHALL BE INSTALLED WITH 5 ANCHORS ON THE TRAFFIC SIDE OF BARRIER AND 4 ON THE CONSTRUCTION SIDE. IF THE END(S) OF THE BRACED CONCRETE BARRIER SYSTEM EXTENDS 50' OR MORE BEYOND LIMITS OF BRIDGE WORK THE LAST BARRIER UNIT DOES NOT REQUIRE ANCHORAGE.
5. TEMPORARY TRAFFIC BARRIER - BRACED MAY BE INSTALLED WITH A 230' MINIMUM RADIUS. GAPS CREATED BETWEEN STRUCTURAL TUBES AND CONCRETE BARRIER, DURING A RADIAL LAYOUT, SHALL BE SHIMMED WITH 8"x8"x1/2" PLATES & FENDER WASHERS TO FIRMLY ATTACH STRUCTURAL TUBING TO BARRIER.
6. THE CONTRACTOR SHALL FURNISH AND INSTALL APPROVED RETROREFLECTIVE DELINEATORS AT 25-FOOT INTERVALS ALONG TOP AND/OR ONE FOOT DOWN THE SIDE OF PORTABLE CONCRETE BARRIER. PAYMENT SHALL BE INCLUDED IN ITEM 900.645 "SPECIAL PROVISION (TRAFFIC CONTROL, ALL INCLUSIVE)". THE COLOR OF DELINEATORS SHALL, IN ALL INSTANCES, CONFORM TO THE COLOR OF EDGE LINE MARKINGS. DELINEATORS SUPPLEMENT, BUT DO NOT REPLACE, THE NEED FOR RETROREFLECTIVE SOLID EDGE LINE MARKINGS.

- ## MATERIAL NOTES

1. BARRIERS SHALL BE LIGHT COLORED CLASS AA CONCRETE, WITH MINIMUM COMPRESSIVE STRENGTH OF 4000 psi, AND SHALL HAVE A SMOOTH UNIFORM SURFACE FREE OF DEFECTS AND IRREGULARITIES. CASTING DATE SHALL BE SHOWN ON BARRIER. ALL EXPOSED EDGES OF CONCRETE SHALL BE CHAMFERED  $\frac{3}{4}$ ", UNLESS OTHERWISE NOTED.
2. ALL REINFORCING STEEL SHALL BE AASHTO M31 (ASTM A615) GRADE 60. ALL REINFORCEMENT SHALL HAVE  $\frac{1}{2}$ " MINIMUM CLEAR COVER, UNLESS OTHERWISE NOTED.
3. STRUCTURAL STEEL, EXCEPT THE STEEL TUBES, SHALL BE AASHTO M270 GRADE 50. ALL STEEL SHALL BE FABRICATED IN ACCORDANCE WITH SECTION 506.
4. STEEL TUBES,  $6 \times 6 \times \frac{3}{8}$  &  $4 \times 4 \times \frac{1}{2}$ , SHALL BE ASTM A 500 GRADE B OR C. THE  $6 \times 6 \times \frac{3}{8}$  TUBES SHALL BE 12' LONG AND GALVANIZED IN ACCORDANCE WITH SUBSECTION 726.08.
5. A MINIMUM OF 2 RECESSED LIFTING DEVICES, EACH WITH THE CAPACITY TO LIFT A MASS OF 6 TONS (MINIMUM), SHALL BE INSTALLED TO EACH BARRIER UNIT. TWENTY FOOT LONG CONCRETE BARRIER UNITS ARE APPROXIMATELY 400 LBS./FT.
6. DELINEATORS SHALL BE ATTACHED TO BARRIER USING AN APPROVED ADHESIVE MATERIAL OR AS SHOWN ON THIS SHEET.

REINFORCING SCHEDULE (PER 20' BARRIER UNIT)								
MARK	SIZE	LENGTH	# PIECES	TYPE	A	B	C	LOCATION
B1	#4	4'-10"	6	I	5"	2'-4"	I"	STIRRUPS
B2	#6	19'-1"	2	---				LONGITUDINAL (TOP)
B3	#6	19'-9"	2	---				LONGITUDINAL (BOTTOM)
B4	#6	1'-2"	2	---				TRANSVERSE (BOTTOM)
B5	#6	6"	2	---				TRANSVERSE (TOP)
B6	#4	2'-9"	9	II	5"	1'-3"		STIRRUPS





CLD 15-0223 MODEL: Sheet 01




PROJECT NAME:	IRASBURG
PROJECT NUMBER:	IM DECK(46)

FILE NAME: z15all6barrier-107N.dgn	PLOT DATE: 2/5/2016
PROJECT LEADER: J. BYATT	DRAWN BY: M. SMITH
DESIGNED BY: S. BEAUMONT	CHECKED BY: J. BYATT
TEMPORARY TRAFFIC BARRIER - BRACED SHEET 1	SHEET 17 OF 49



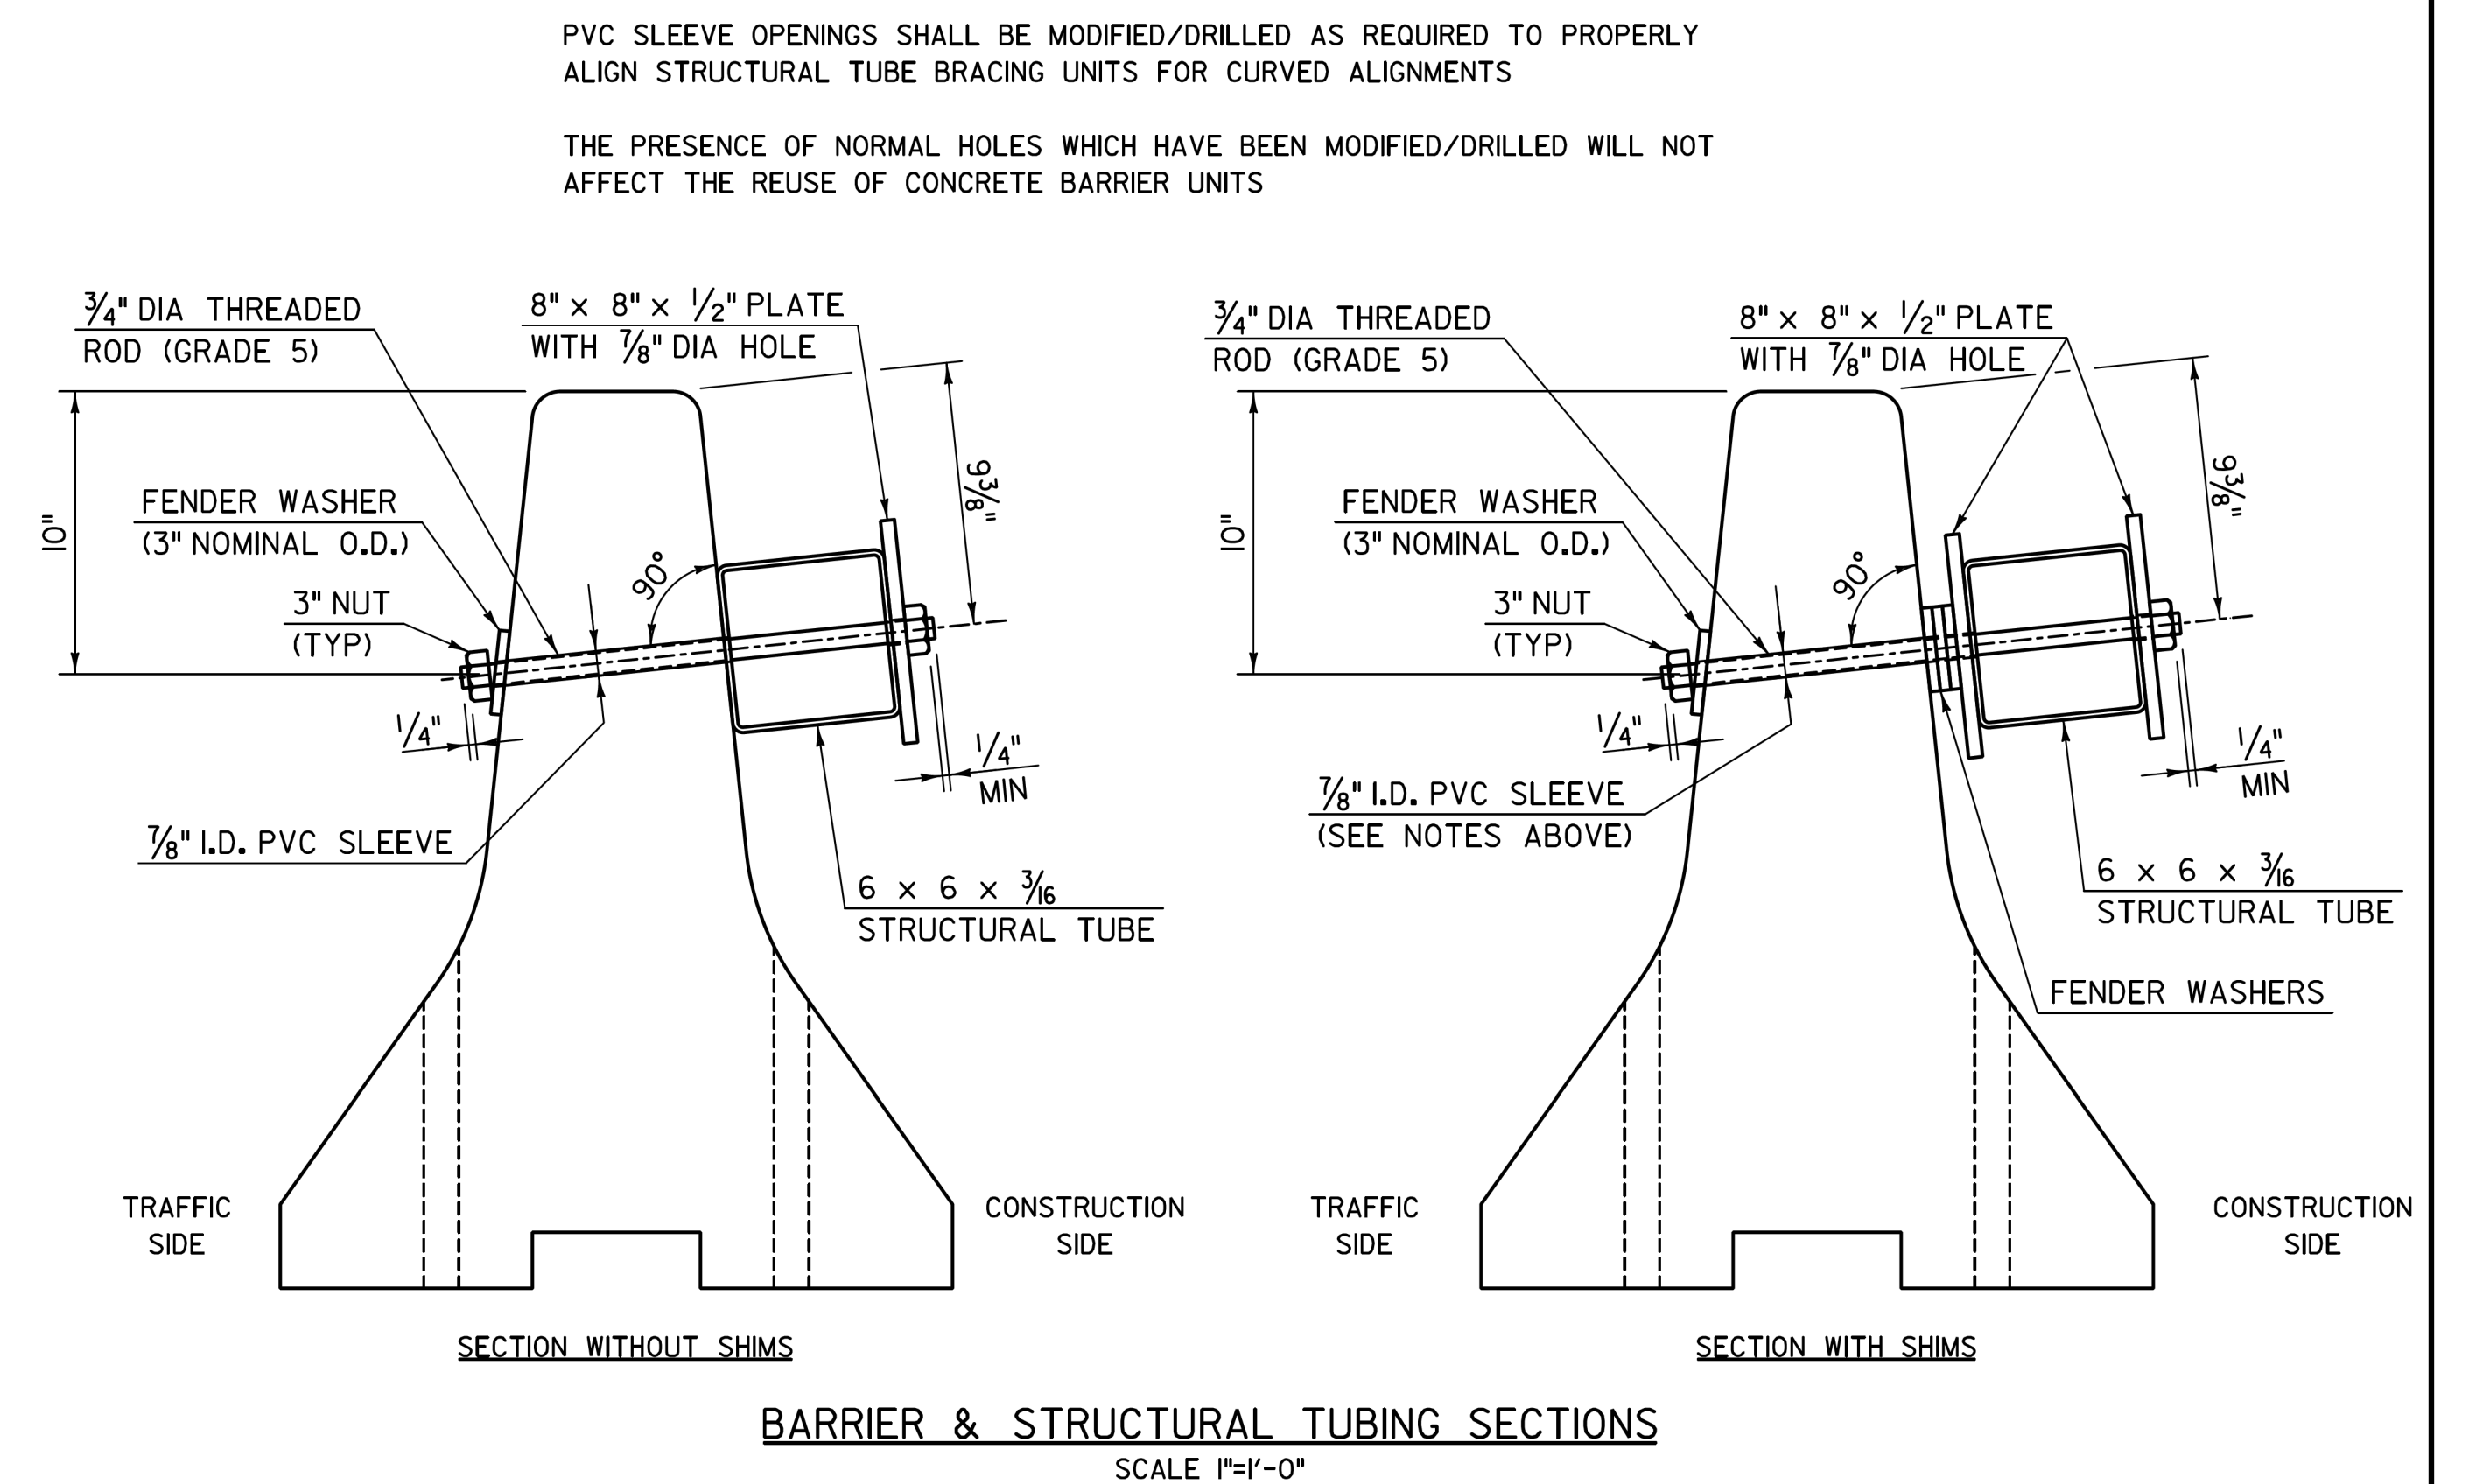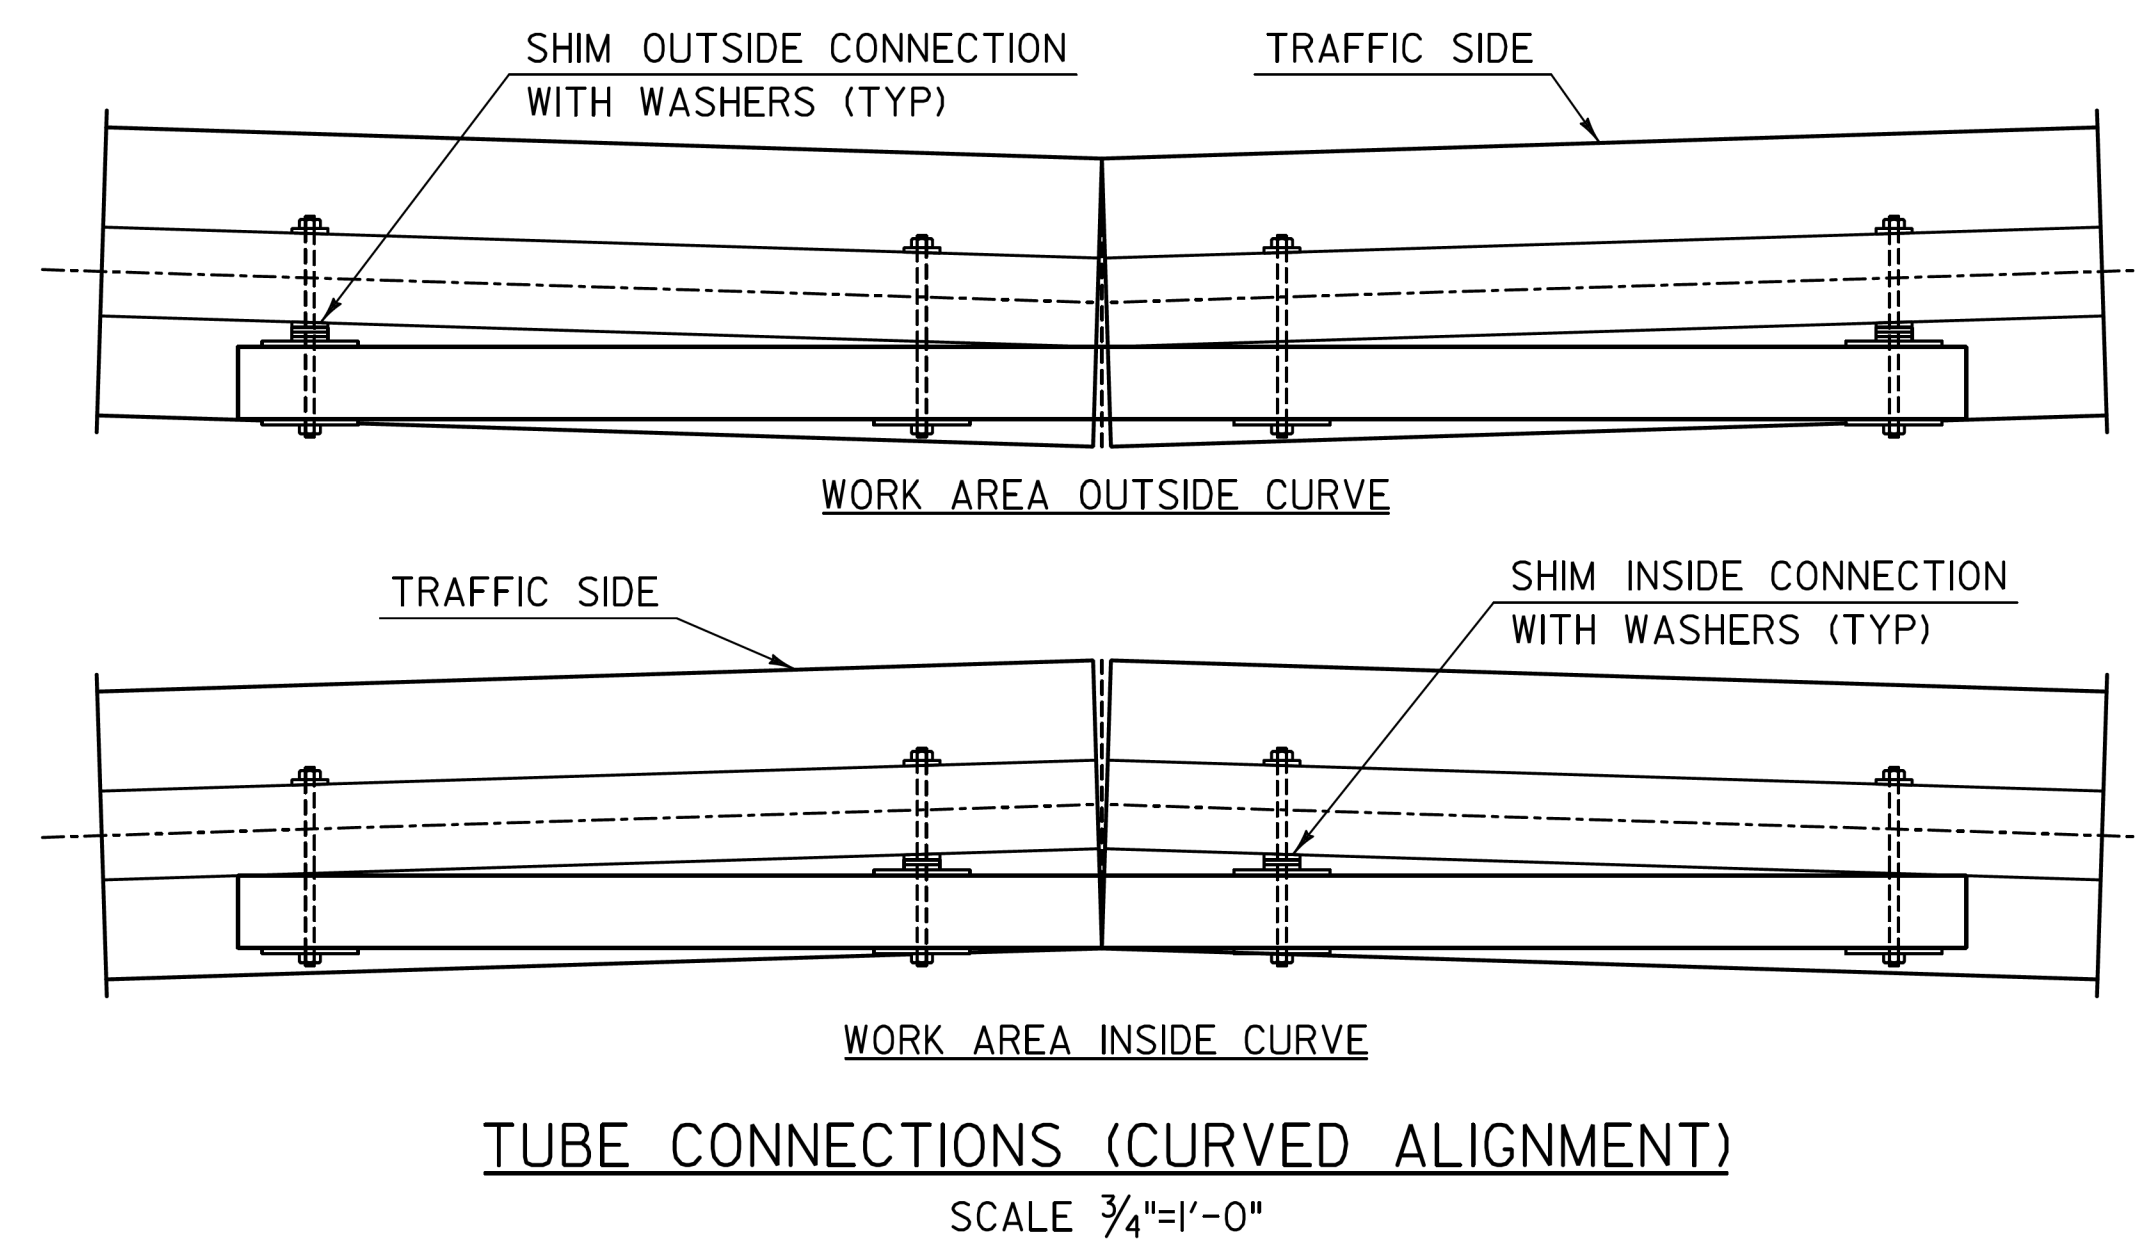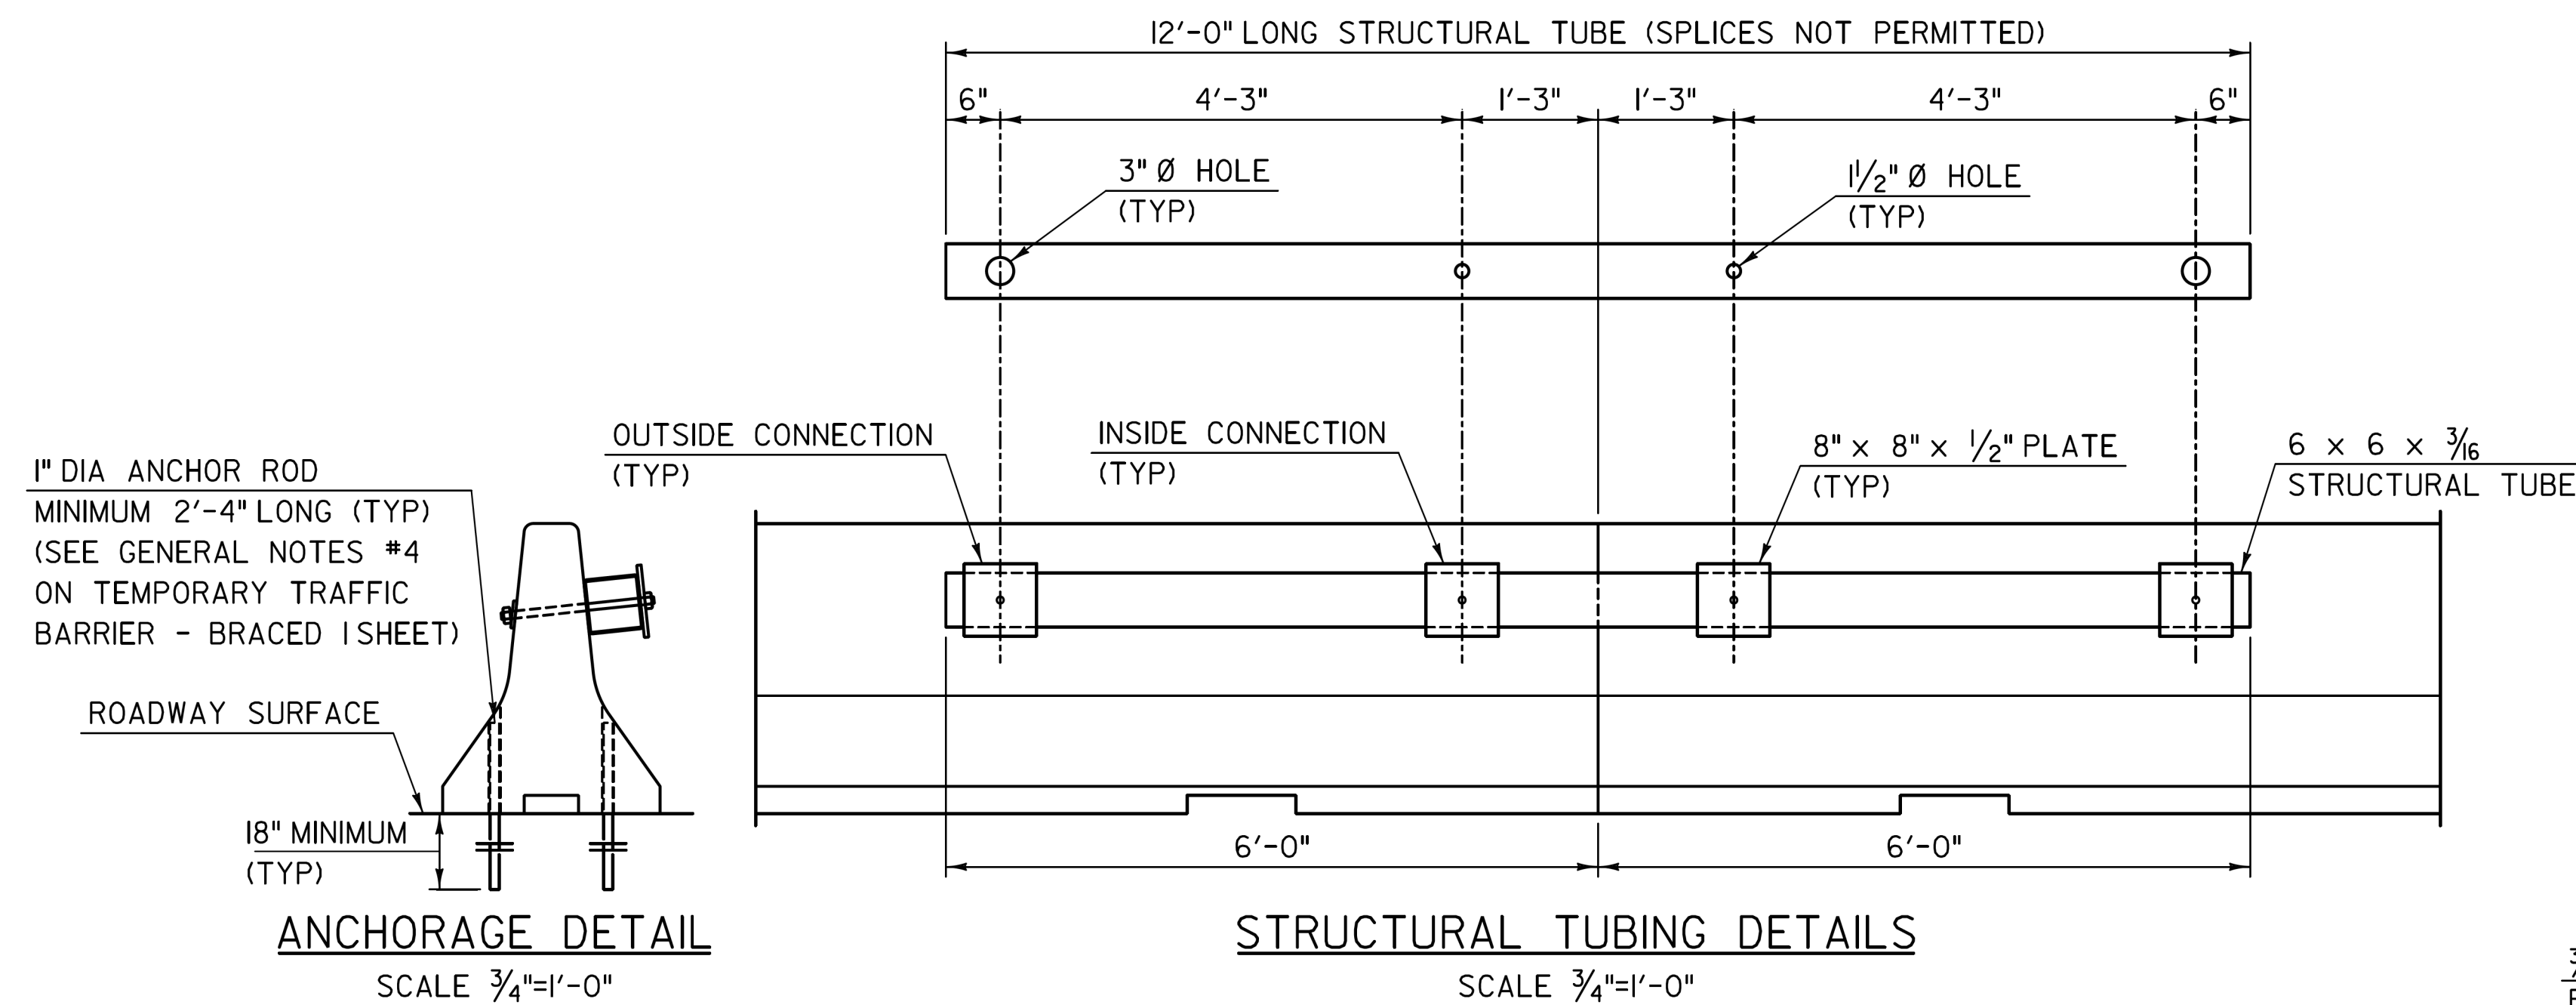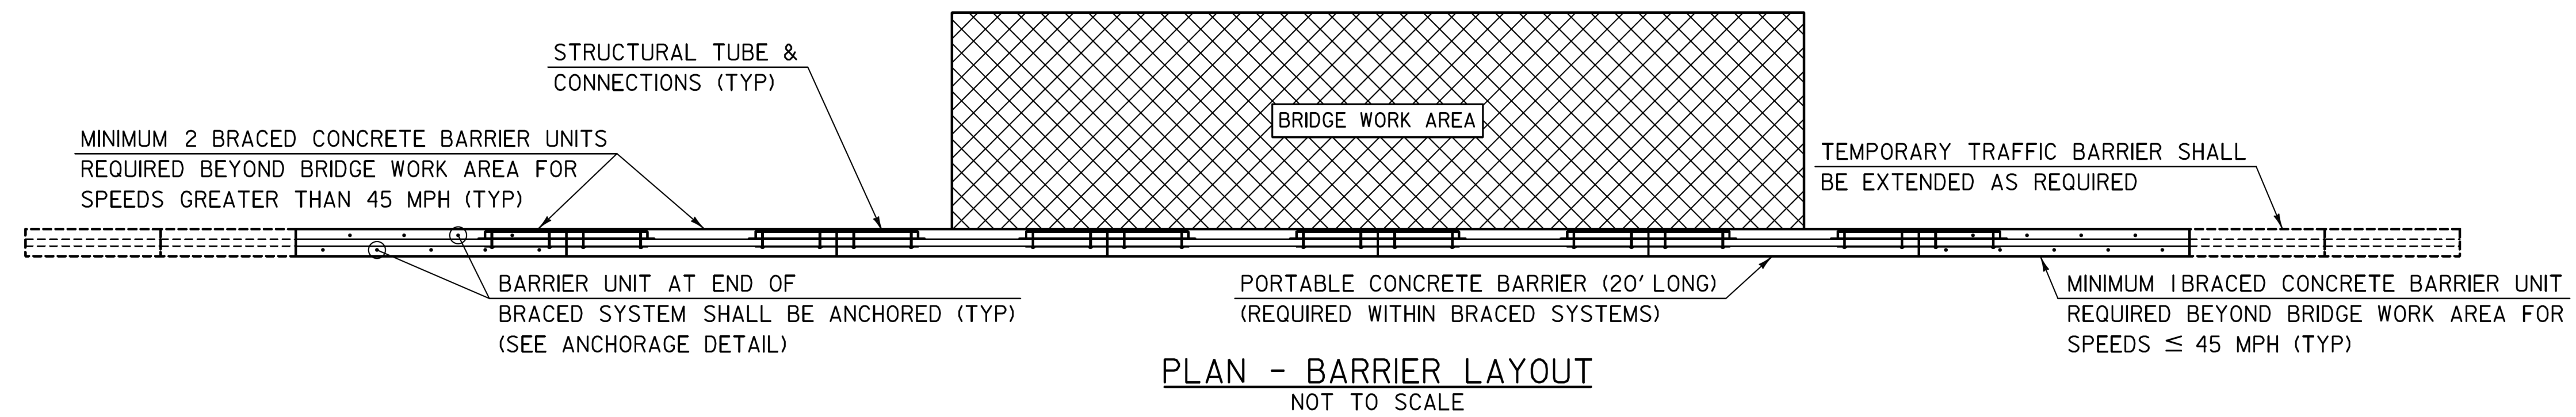




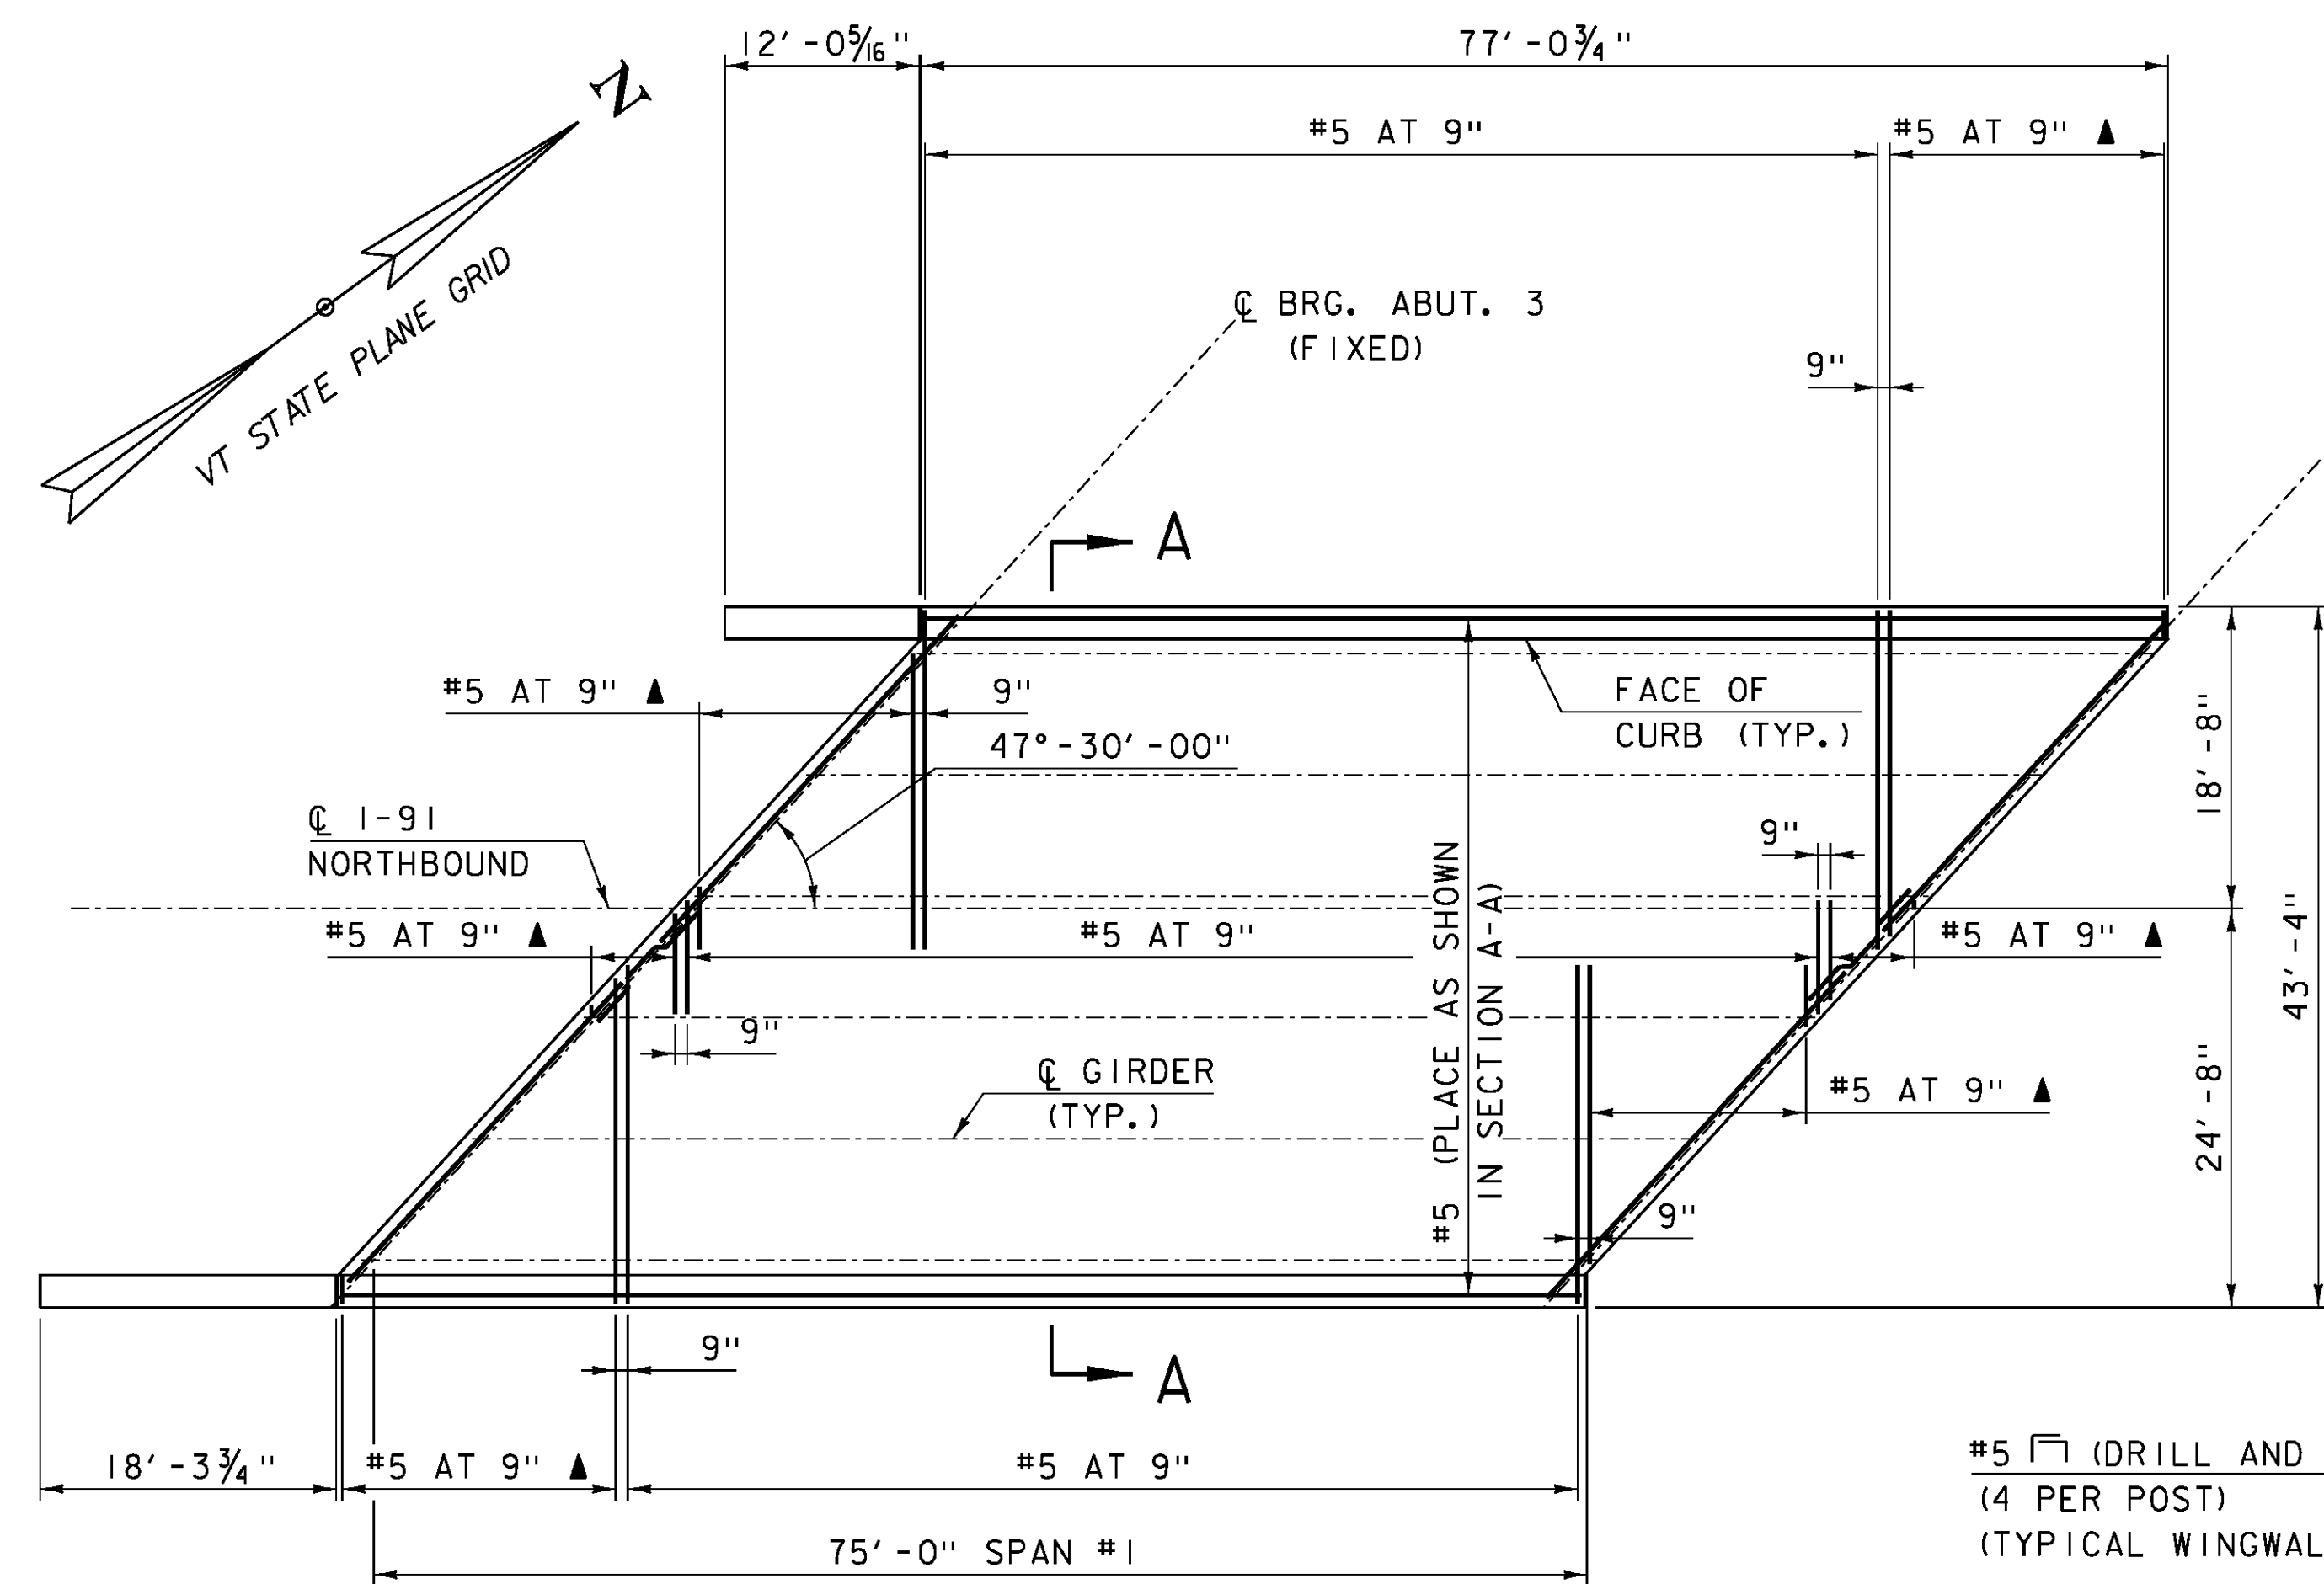


DECK REINFORCEMENT PLAN - BOTTOM BARS - SPAN #1

SCALE: 1" = 10'-0"

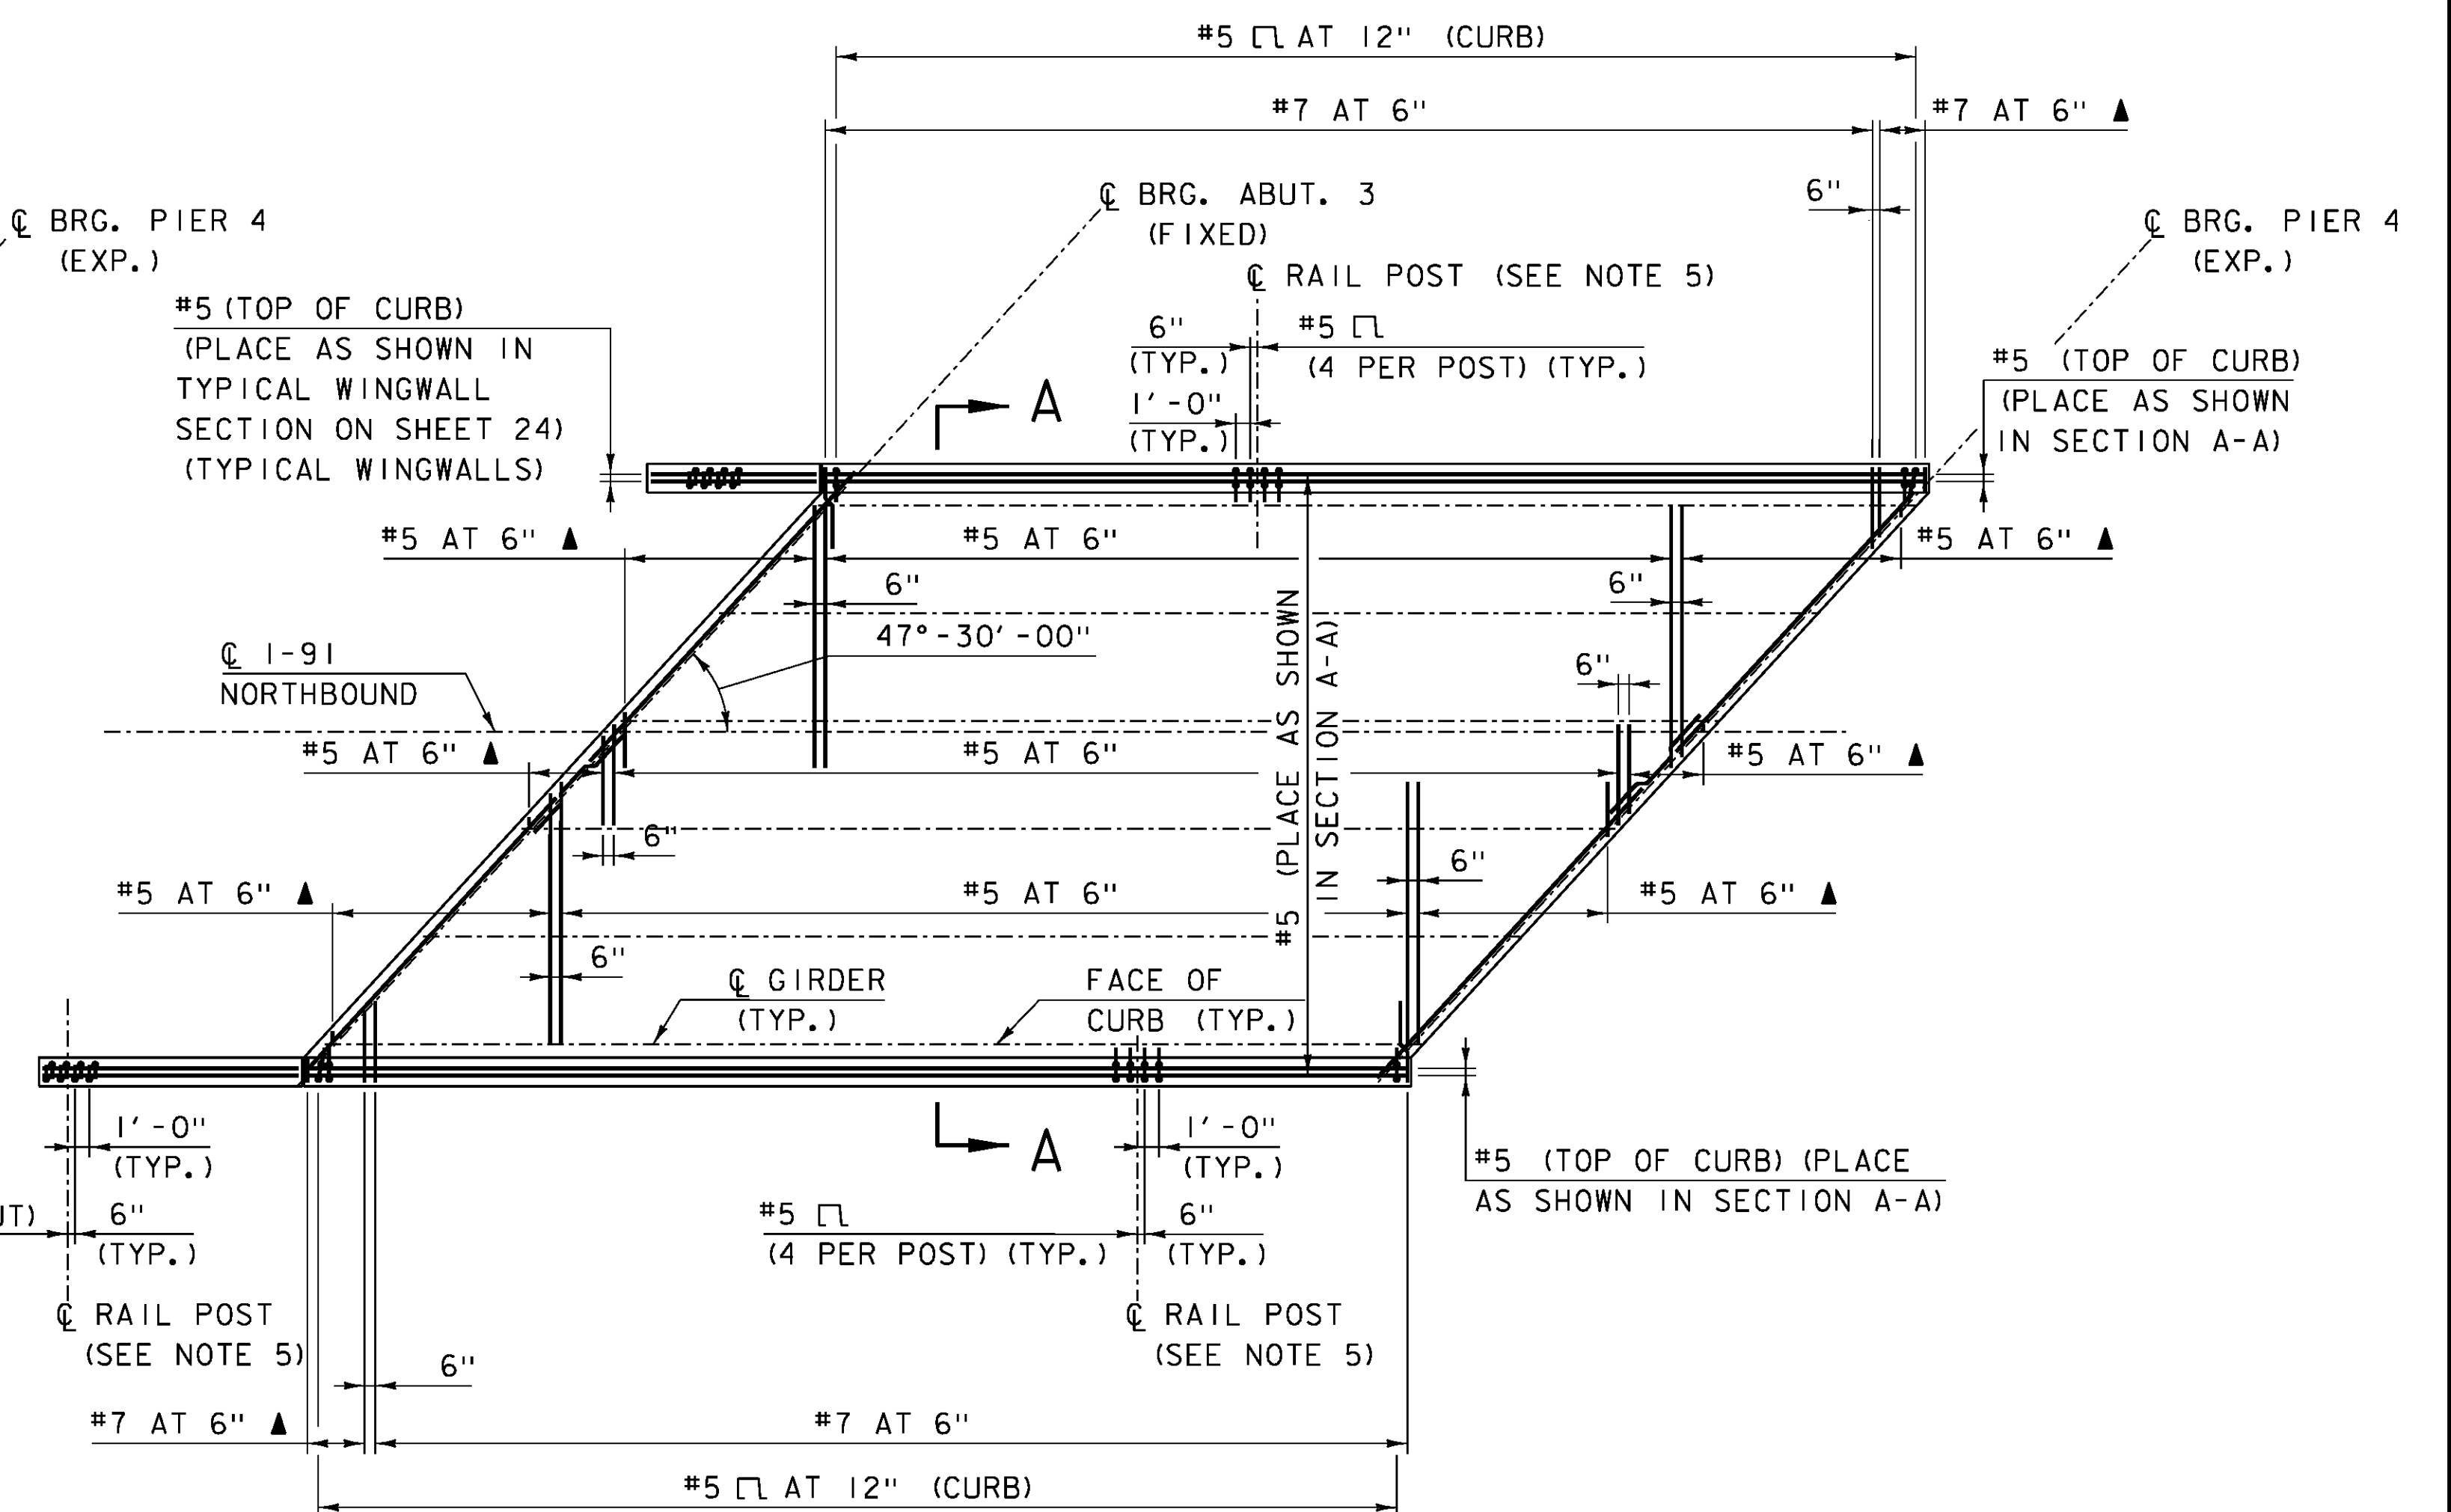

DECK REINFORCEMENT PLAN - TOP BARS - SPAN #1

SCALE: 1" = 10'-0"

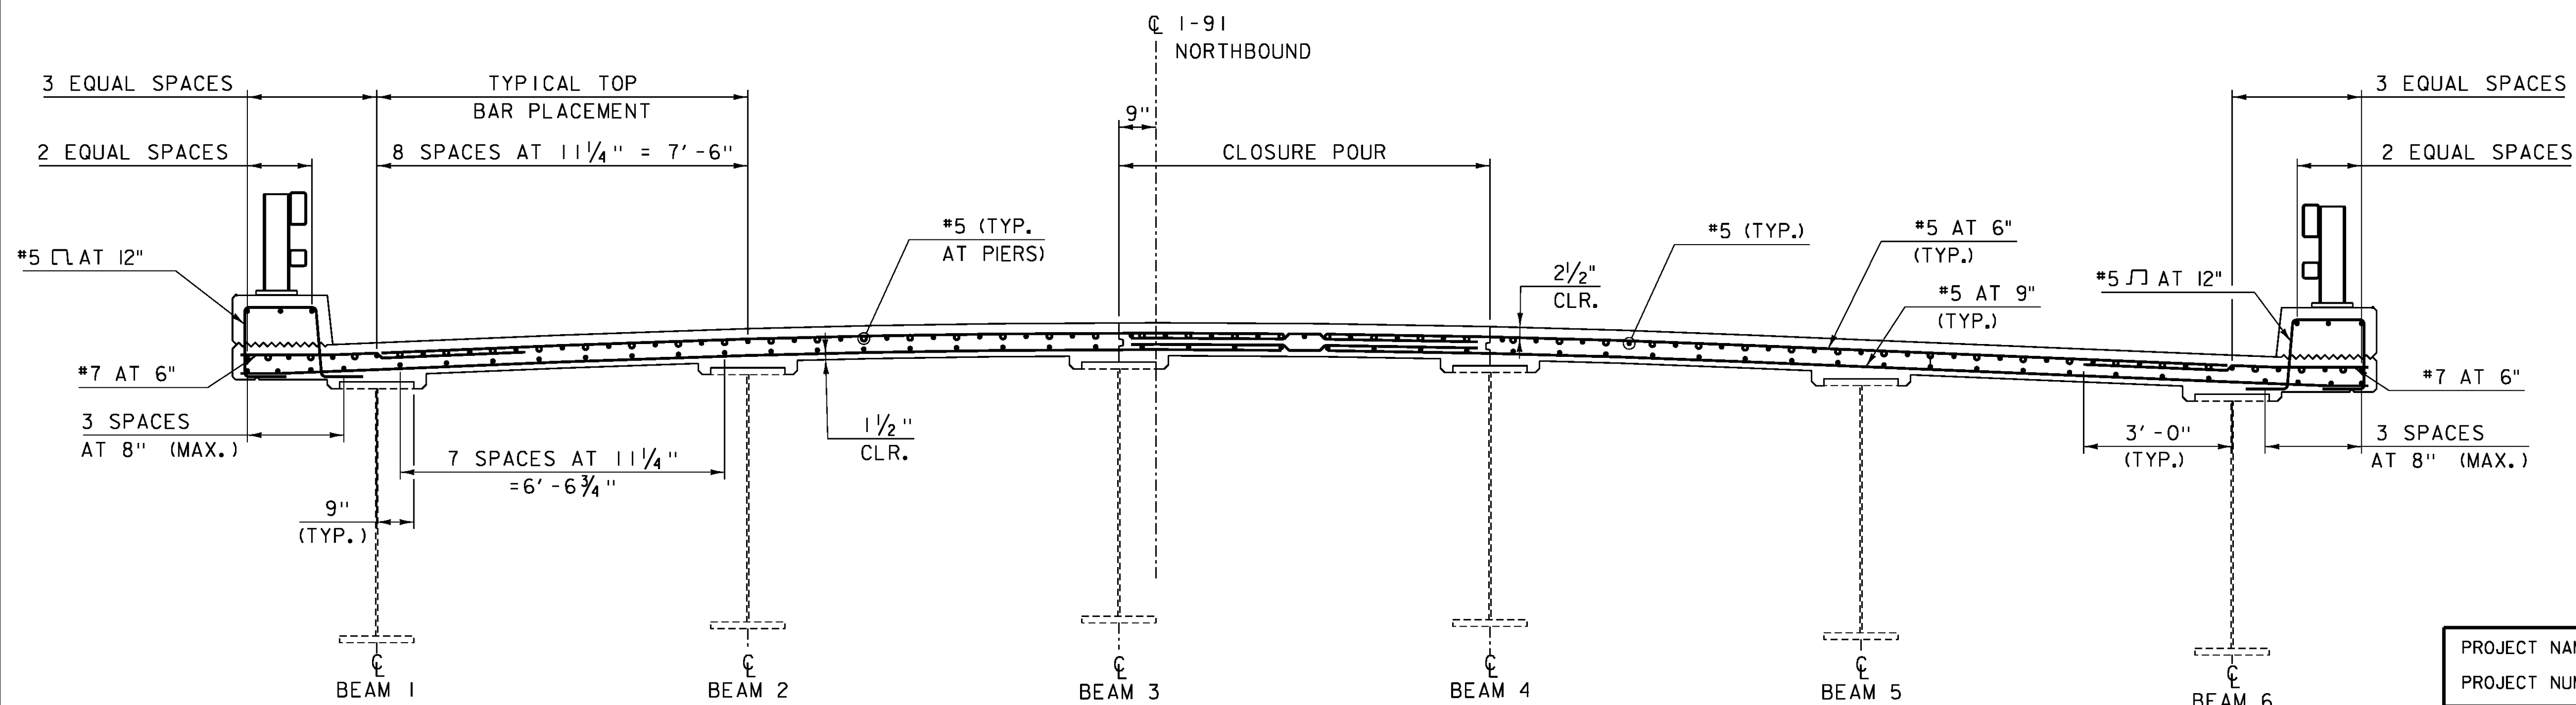

SECTION A-A

SCALE: 1/2" = 1'-0"

NOTES:

- 3" CLEAR, UNLESS OTHERWISE SPECIFIED ON THE PLANS.
- 3'-0" BAR LAP UNLESS OTHERWISE SPECIFIED ON THE PLANS.
- 1'-0" HOOK UNLESS OTHERWISE SPECIFIED ON THE PLANS.
- SEE SHEET 20 FOR SPAN #2 THROUGH SPAN #4 DECK REINFORCEMENT PLANS.
- SEE SHEET 26 FOR RAIL LAYOUT PLAN.
- DECK DIMENSIONS ARE APPROXIMATED FROM REFERENCE PLANS. CONTRACTOR SHALL FIELD VERIFY.


PROJECT NAME: IRASBURG  
PROJECT NUMBER: IM DECK(46)

FILE NAME: z15oll6+yp-107N.dgn  
PROJECT LEADER: J. BYATT  
DESIGNED BY: N. CARON  
DECK DETAILS SHEET 1

PLOT DATE: 2/5/2016  
DRAWN BY: M. SMITH  
CHECKED BY: S. BEAUMONT  
SHEET 19 OF 49






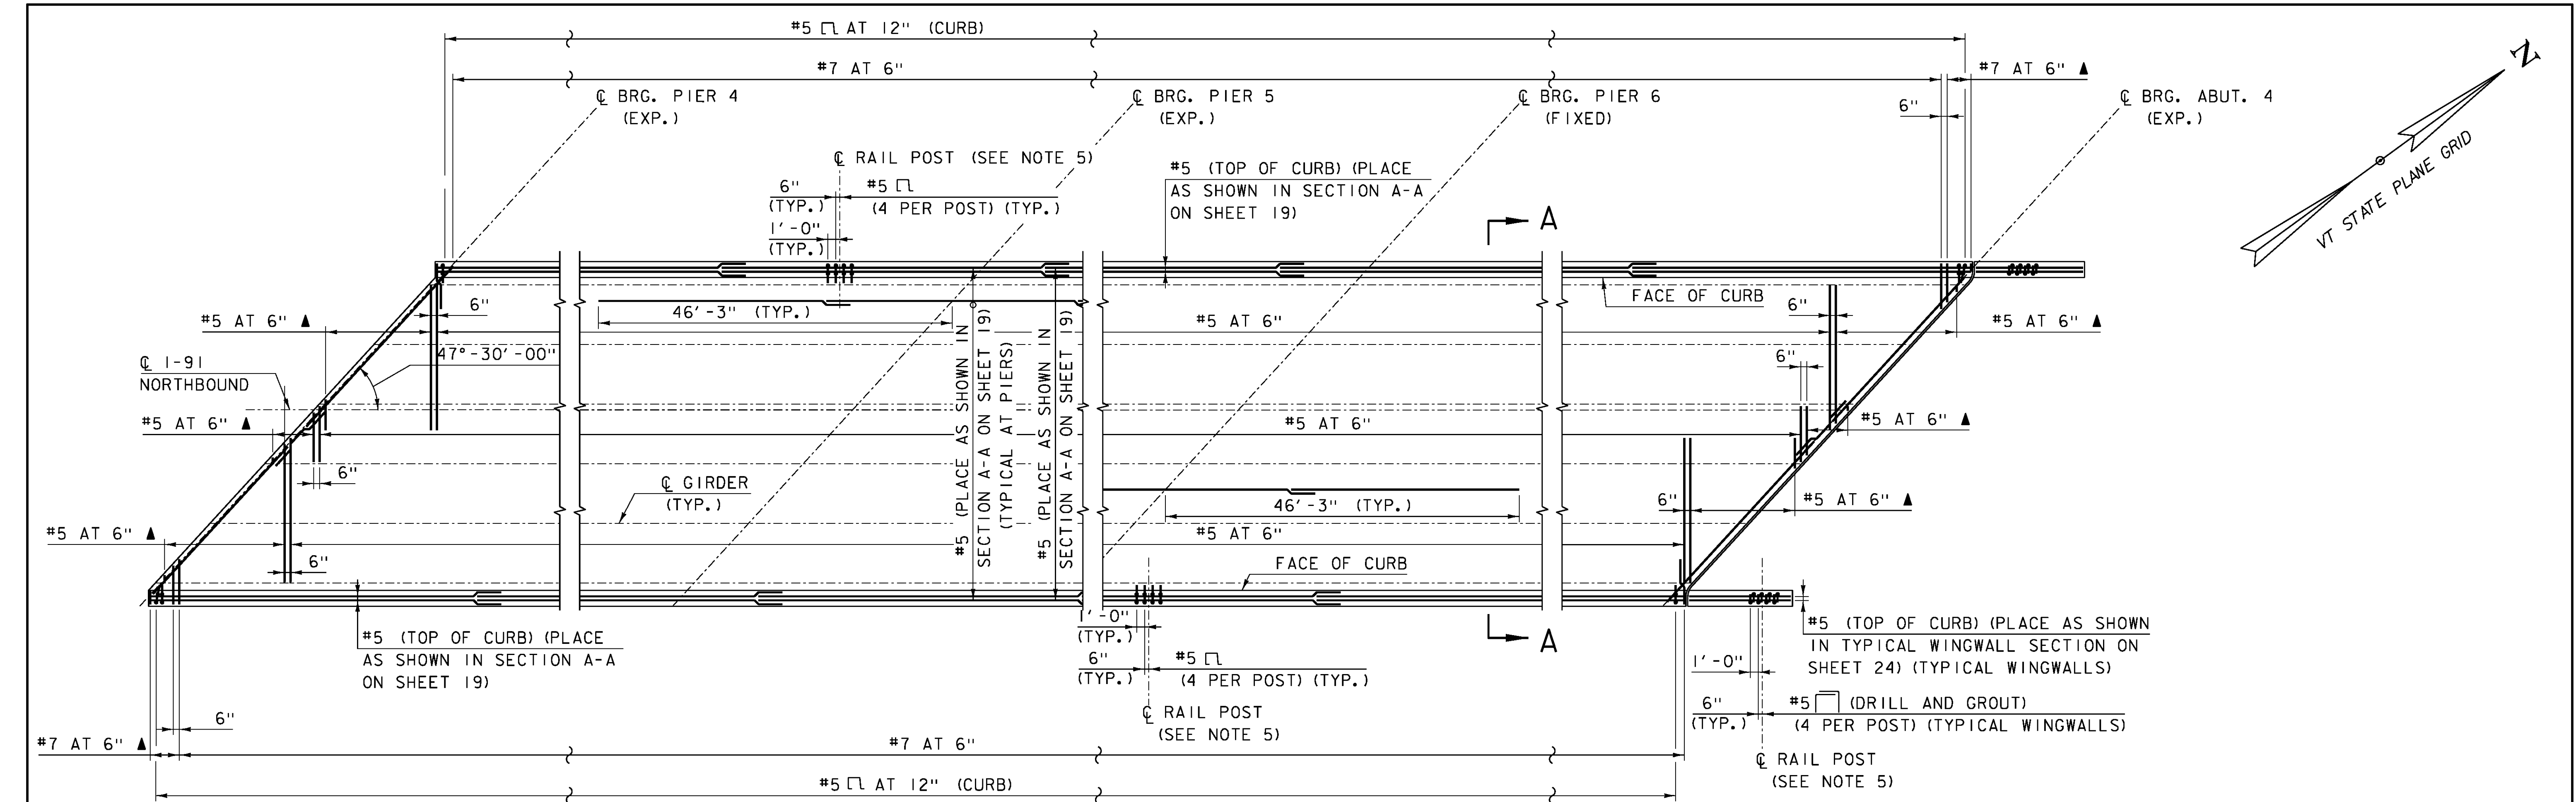

DECK REINFORCEMENT PLAN - TOP BARS - SPAN #2 THROUGH SPAN #4

SCALE: 1" = 10'-0"

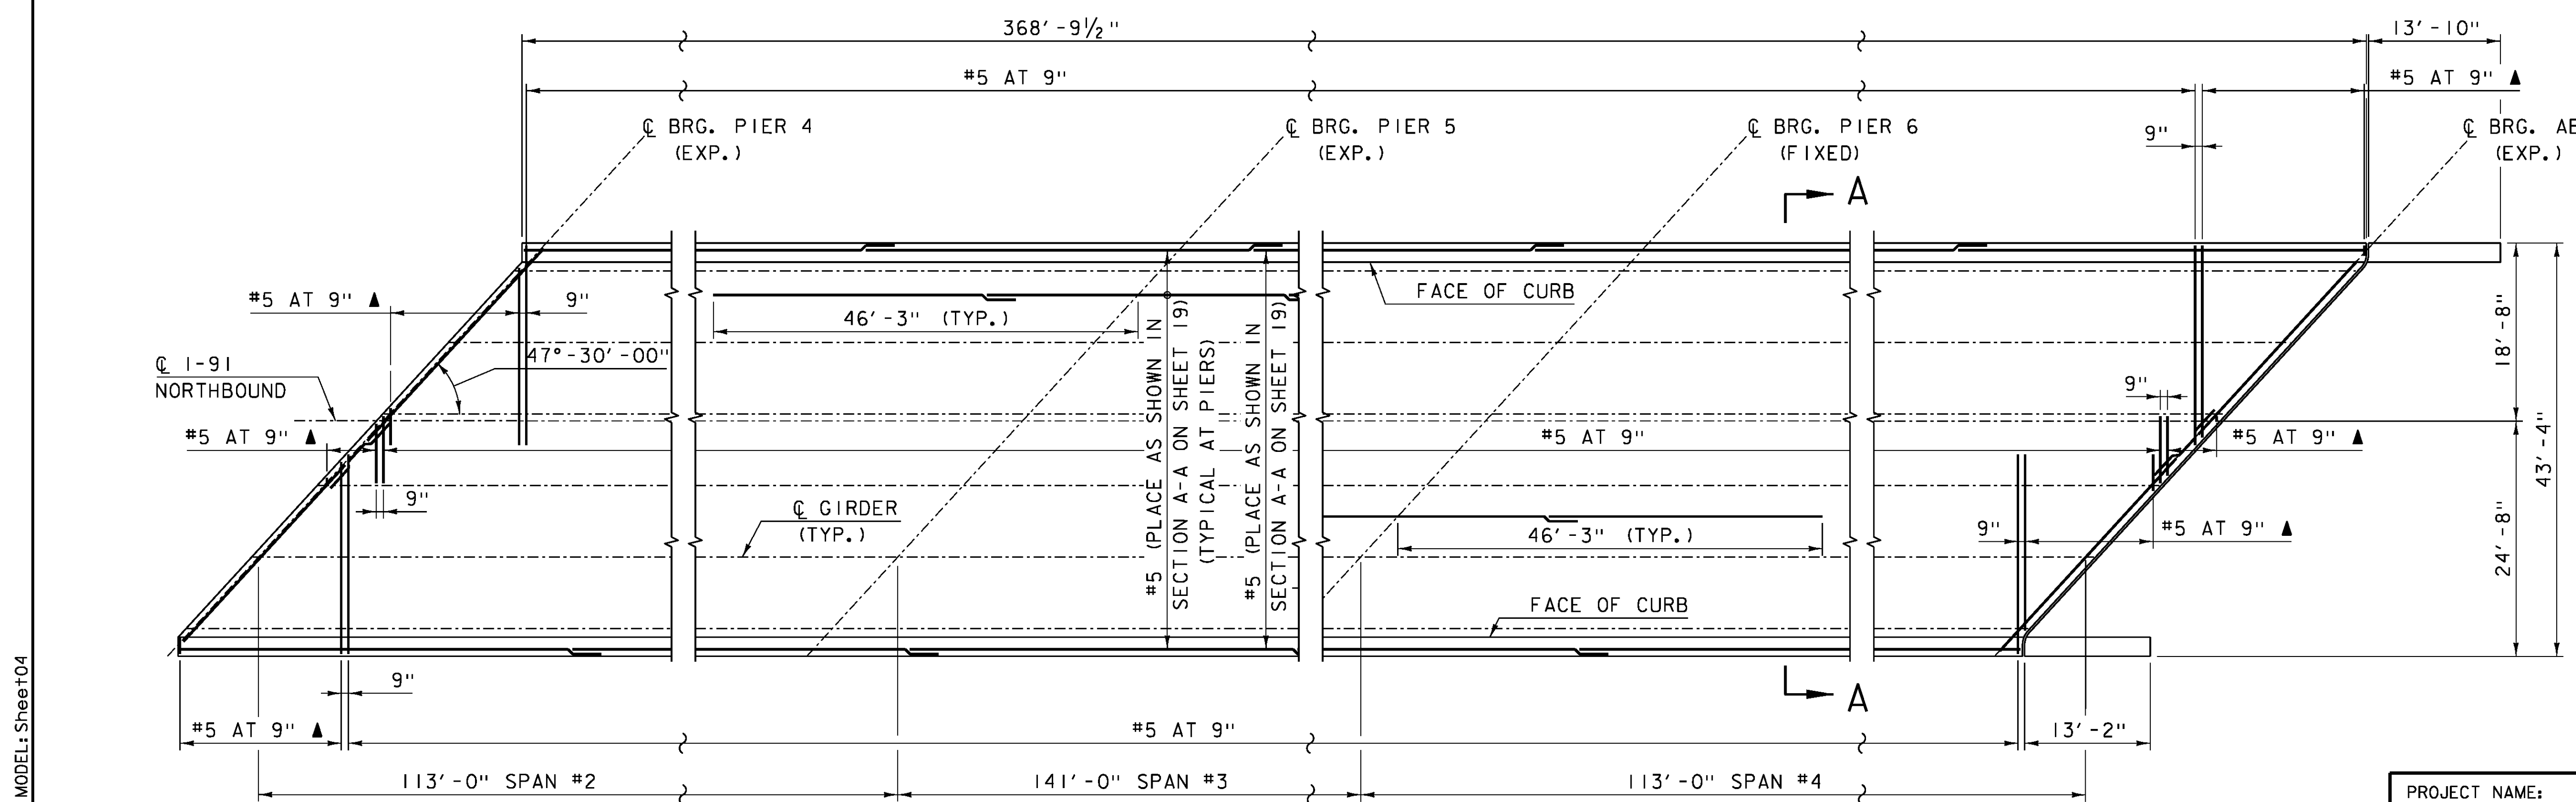


DECK REINFORCEMENT PLAN - BOTTOM BARS - SPAN #2 THROUGH SPAN #4

SCALE: 1" = 10'-0"


- NOTES:
1. 3" CLEAR, UNLESS OTHERWISE SPECIFIED ON THE PLANS.
  2. 3'-0" BAR LAP UNLESS OTHERWISE SPECIFIED ON THE PLANS.
  3. 1'-0" HOOK UNLESS OTHERWISE SPECIFIED ON THE PLANS.
  4. SEE SHEET 19 FOR SPAN #1 REINFORCEMENT PLANS AND SECTION A-A.
  5. SEE SHEET 26 FOR RAIL LAYOUT PLAN.
  6. DECK DIMENSIONS ARE APPROXIMATED FROM REFERENCE PLANS. CONTRACTOR SHALL FIELD VERIFY.

PROJECT NAME: IRASBURG	
PROJECT NUMBER: IM DECK(46)	
FILE NAME: z15oll6+yp-107N.dgn	PLOT DATE: 2/5/2016
PROJECT LEADER: J. BYATT	DRAWN BY: M. SMITH
DESIGNED BY: N. CARON	CHECKED BY: S. BEAUMONT
DECK DETAILS SHEET	SHEET 20 OF 49

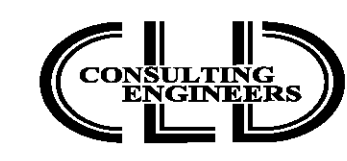

CLD 15-0223 MODEL: Sheet04



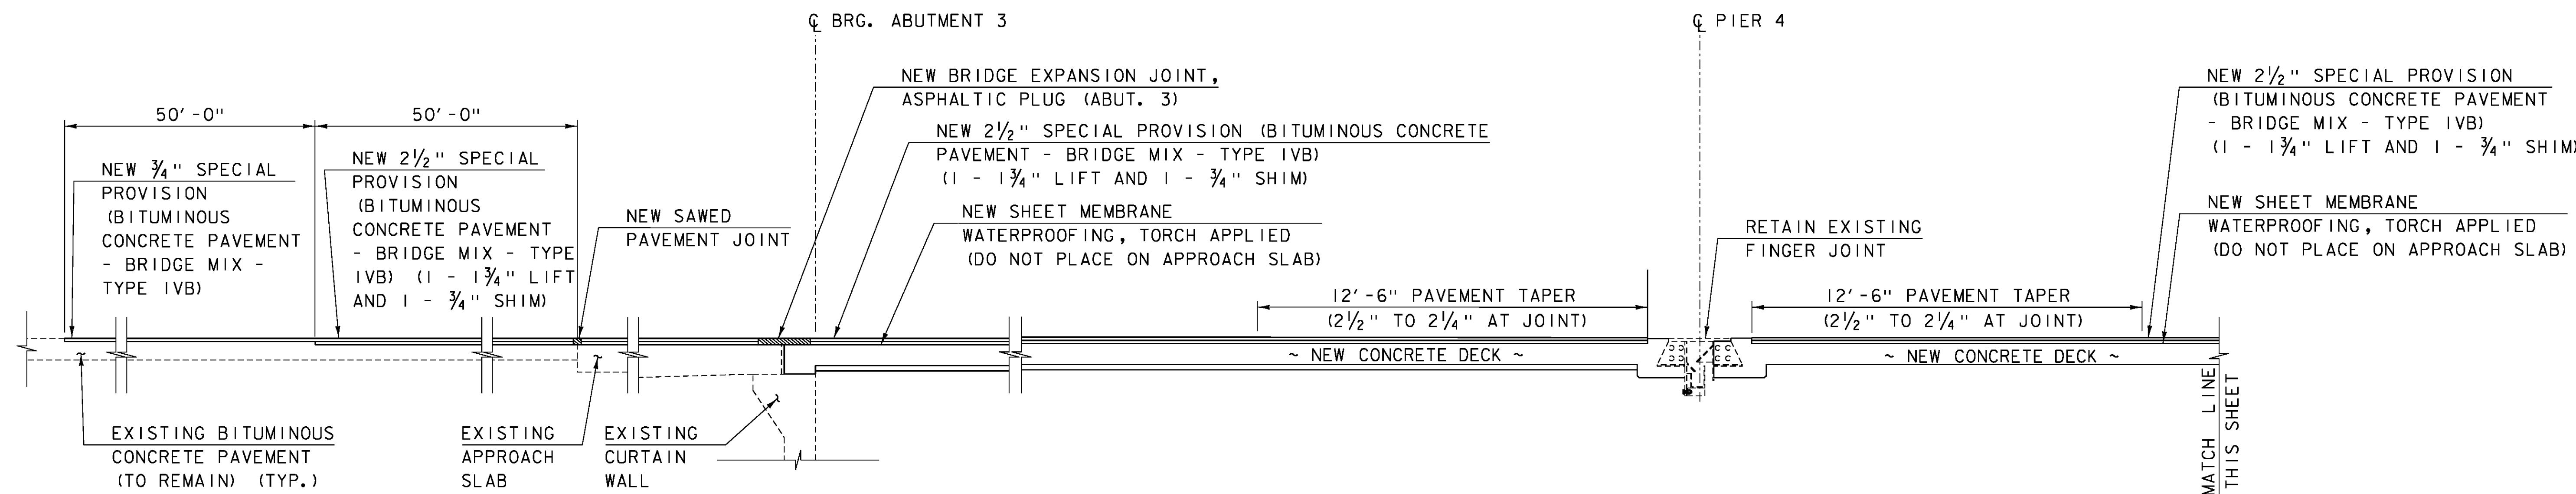


### SAWED PAVEMENT JOINT REPLACEMENT SCHEDULE

BRIDGE NO.	APPROACH SLAB 3	APPROACH SLAB 4
I07N	40 LF	40 LF


### JOINT SCHEDULE

	ABUT. 3	PIER 4	PIER 5	PIER 6	ABUT. 4
JOINT TYPE	ASPHALTIC PLUG	FINGER JOINT	N/A	N/A	COMPRESSION SEAL
REQUIRED JOINT WORK	REPLACE	RETAIN (SEE NOTE)	N/A	N/A	REPLACE SEAL, RETAIN HARDWARE (SEE NOTE)
LENGTH	54 LF	58 LF	N/A	N/A	58 LF

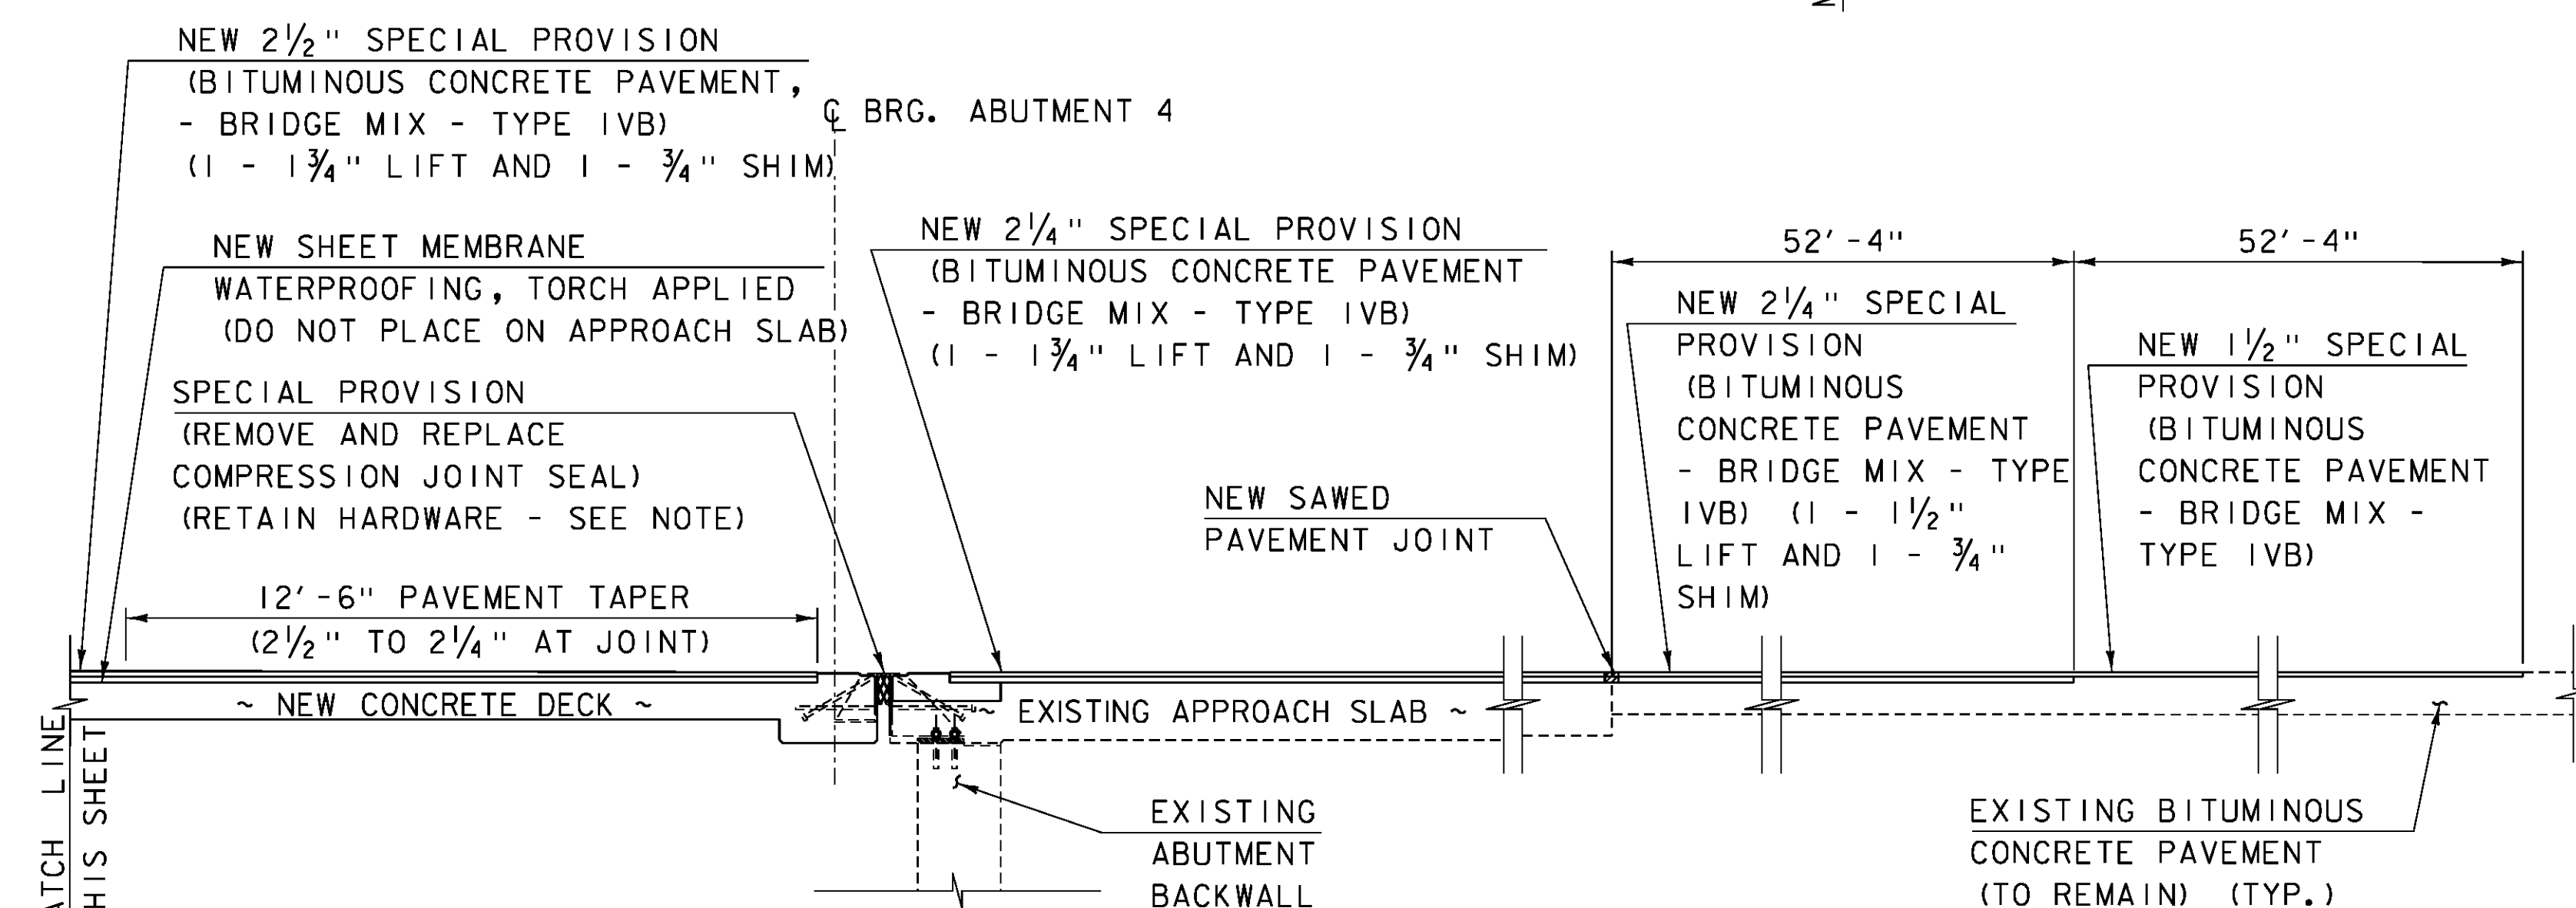

### JOINT, PAVEMENT, AND MEMBRANE LAYOUT

SCALE: 3/8" = 1'-0"

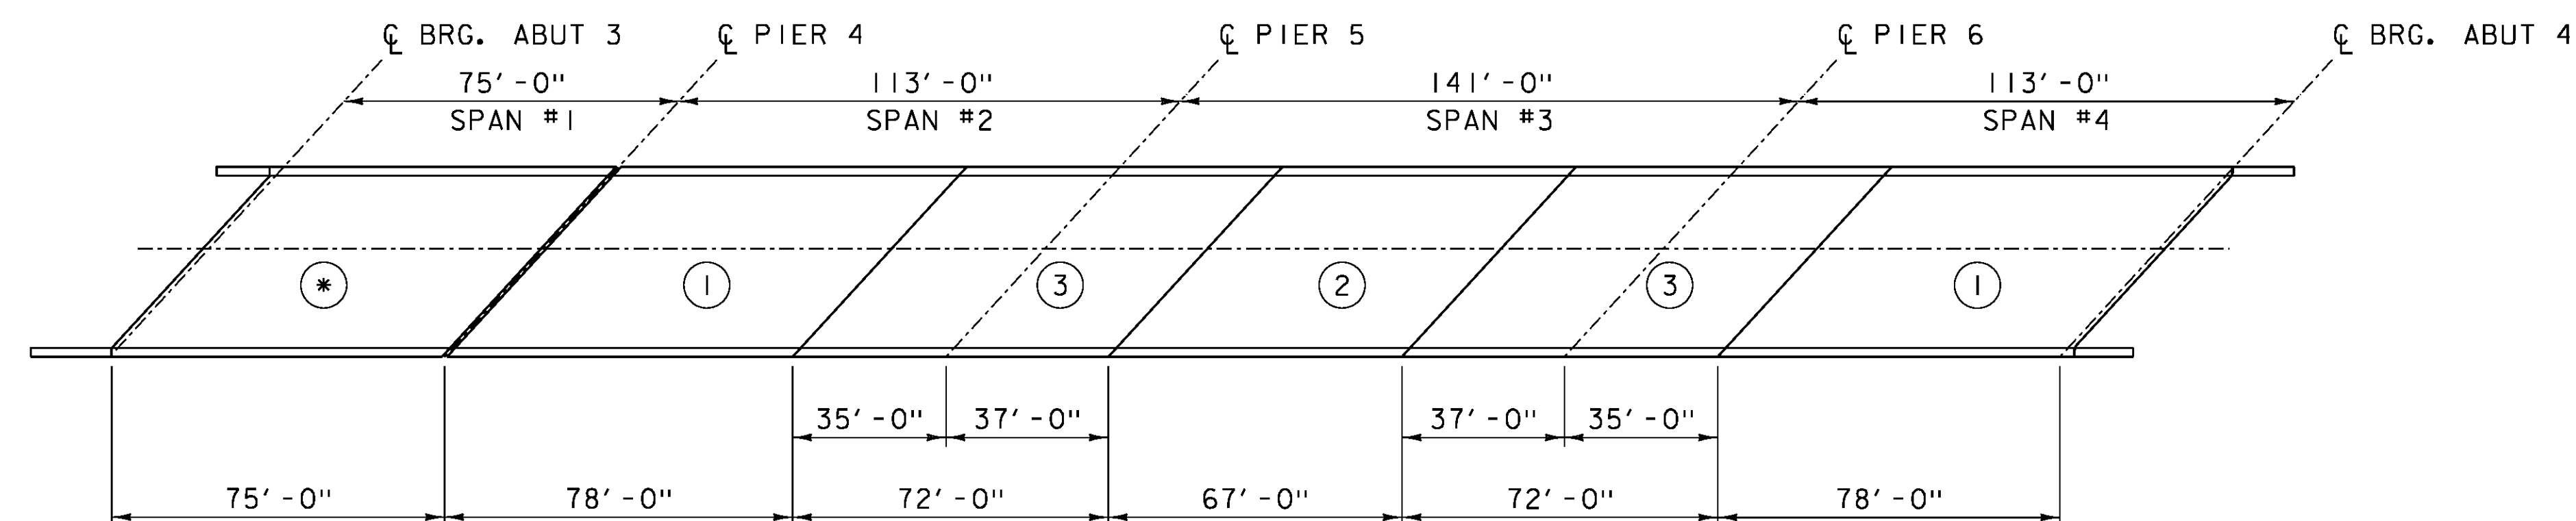


* SPAN #1 IS A SIMPLE SPAN AND CAN BE POURED AT ANY TIME.

### DECK POUR SEQUENCE

SCALE: N.T.S.

NOTE: SEE NOTES 17 THROUGH 19 ON SHEET 2 FOR ADDITIONAL JOINT INFORMATION.

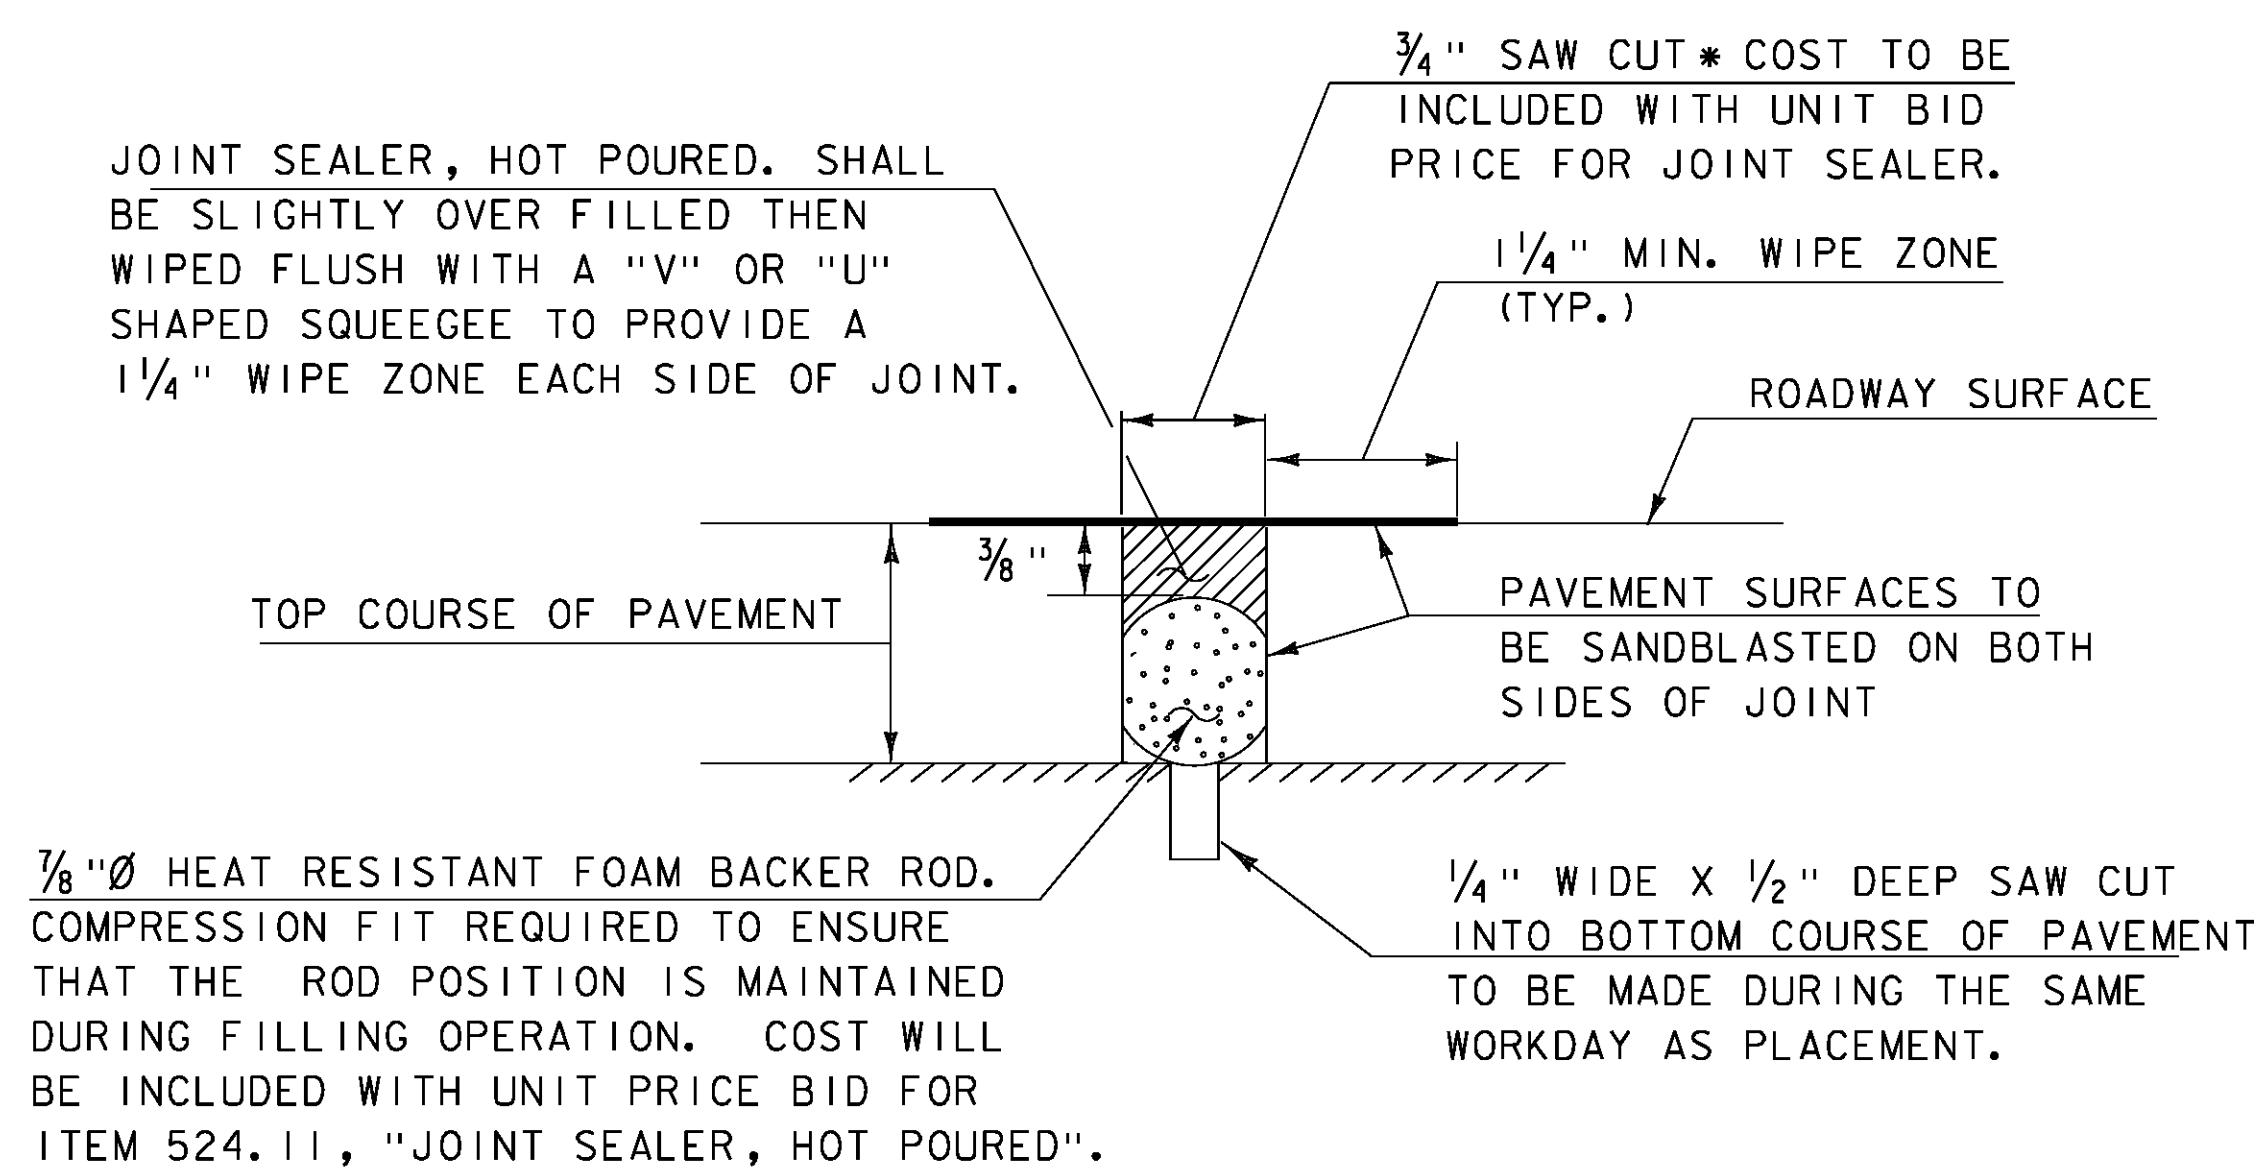

### SAWED PAVEMENT JOINT DETAIL

(NOT TO SCALE)

* JOINT IS TO BE LOCATED ACCURATELY BY STRING LINING, OR OTHER MEANS, PRIOR TO PAVING, SO THAT THE SAW CUT WILL BE MADE DIRECTLY OVER THE END OF CONCRETE DECK. JOINT SHALL BE CUT DRY IN A SINGLE PASS AND BE SEALED WITHIN 24 HOURS OR PRIOR TO EXPOSURE TO TRAFFIC. JOINT SHALL BE CLEANED PRIOR TO APPLYING THE JOINT SEALER. ALL WORK WILL BE PAID UNDER ITEM 524.11, "JOINT SEALER, HOT POURED".




PROJECT NAME: IRASBURG  
PROJECT NUMBER: IM DECK(46)

FILE NAME: z15oll6+yp-i07N.dgn  
PROJECT LEADER: J. BYATT  
DESIGNED BY: J. FRENCH  
JOINT DETAILS SHEET 1


PLOT DATE: 2/5/2016  
DRAWN BY: M. SMITH  
CHECKED BY: S. BEAUMONT  
SHEET 21 OF 49



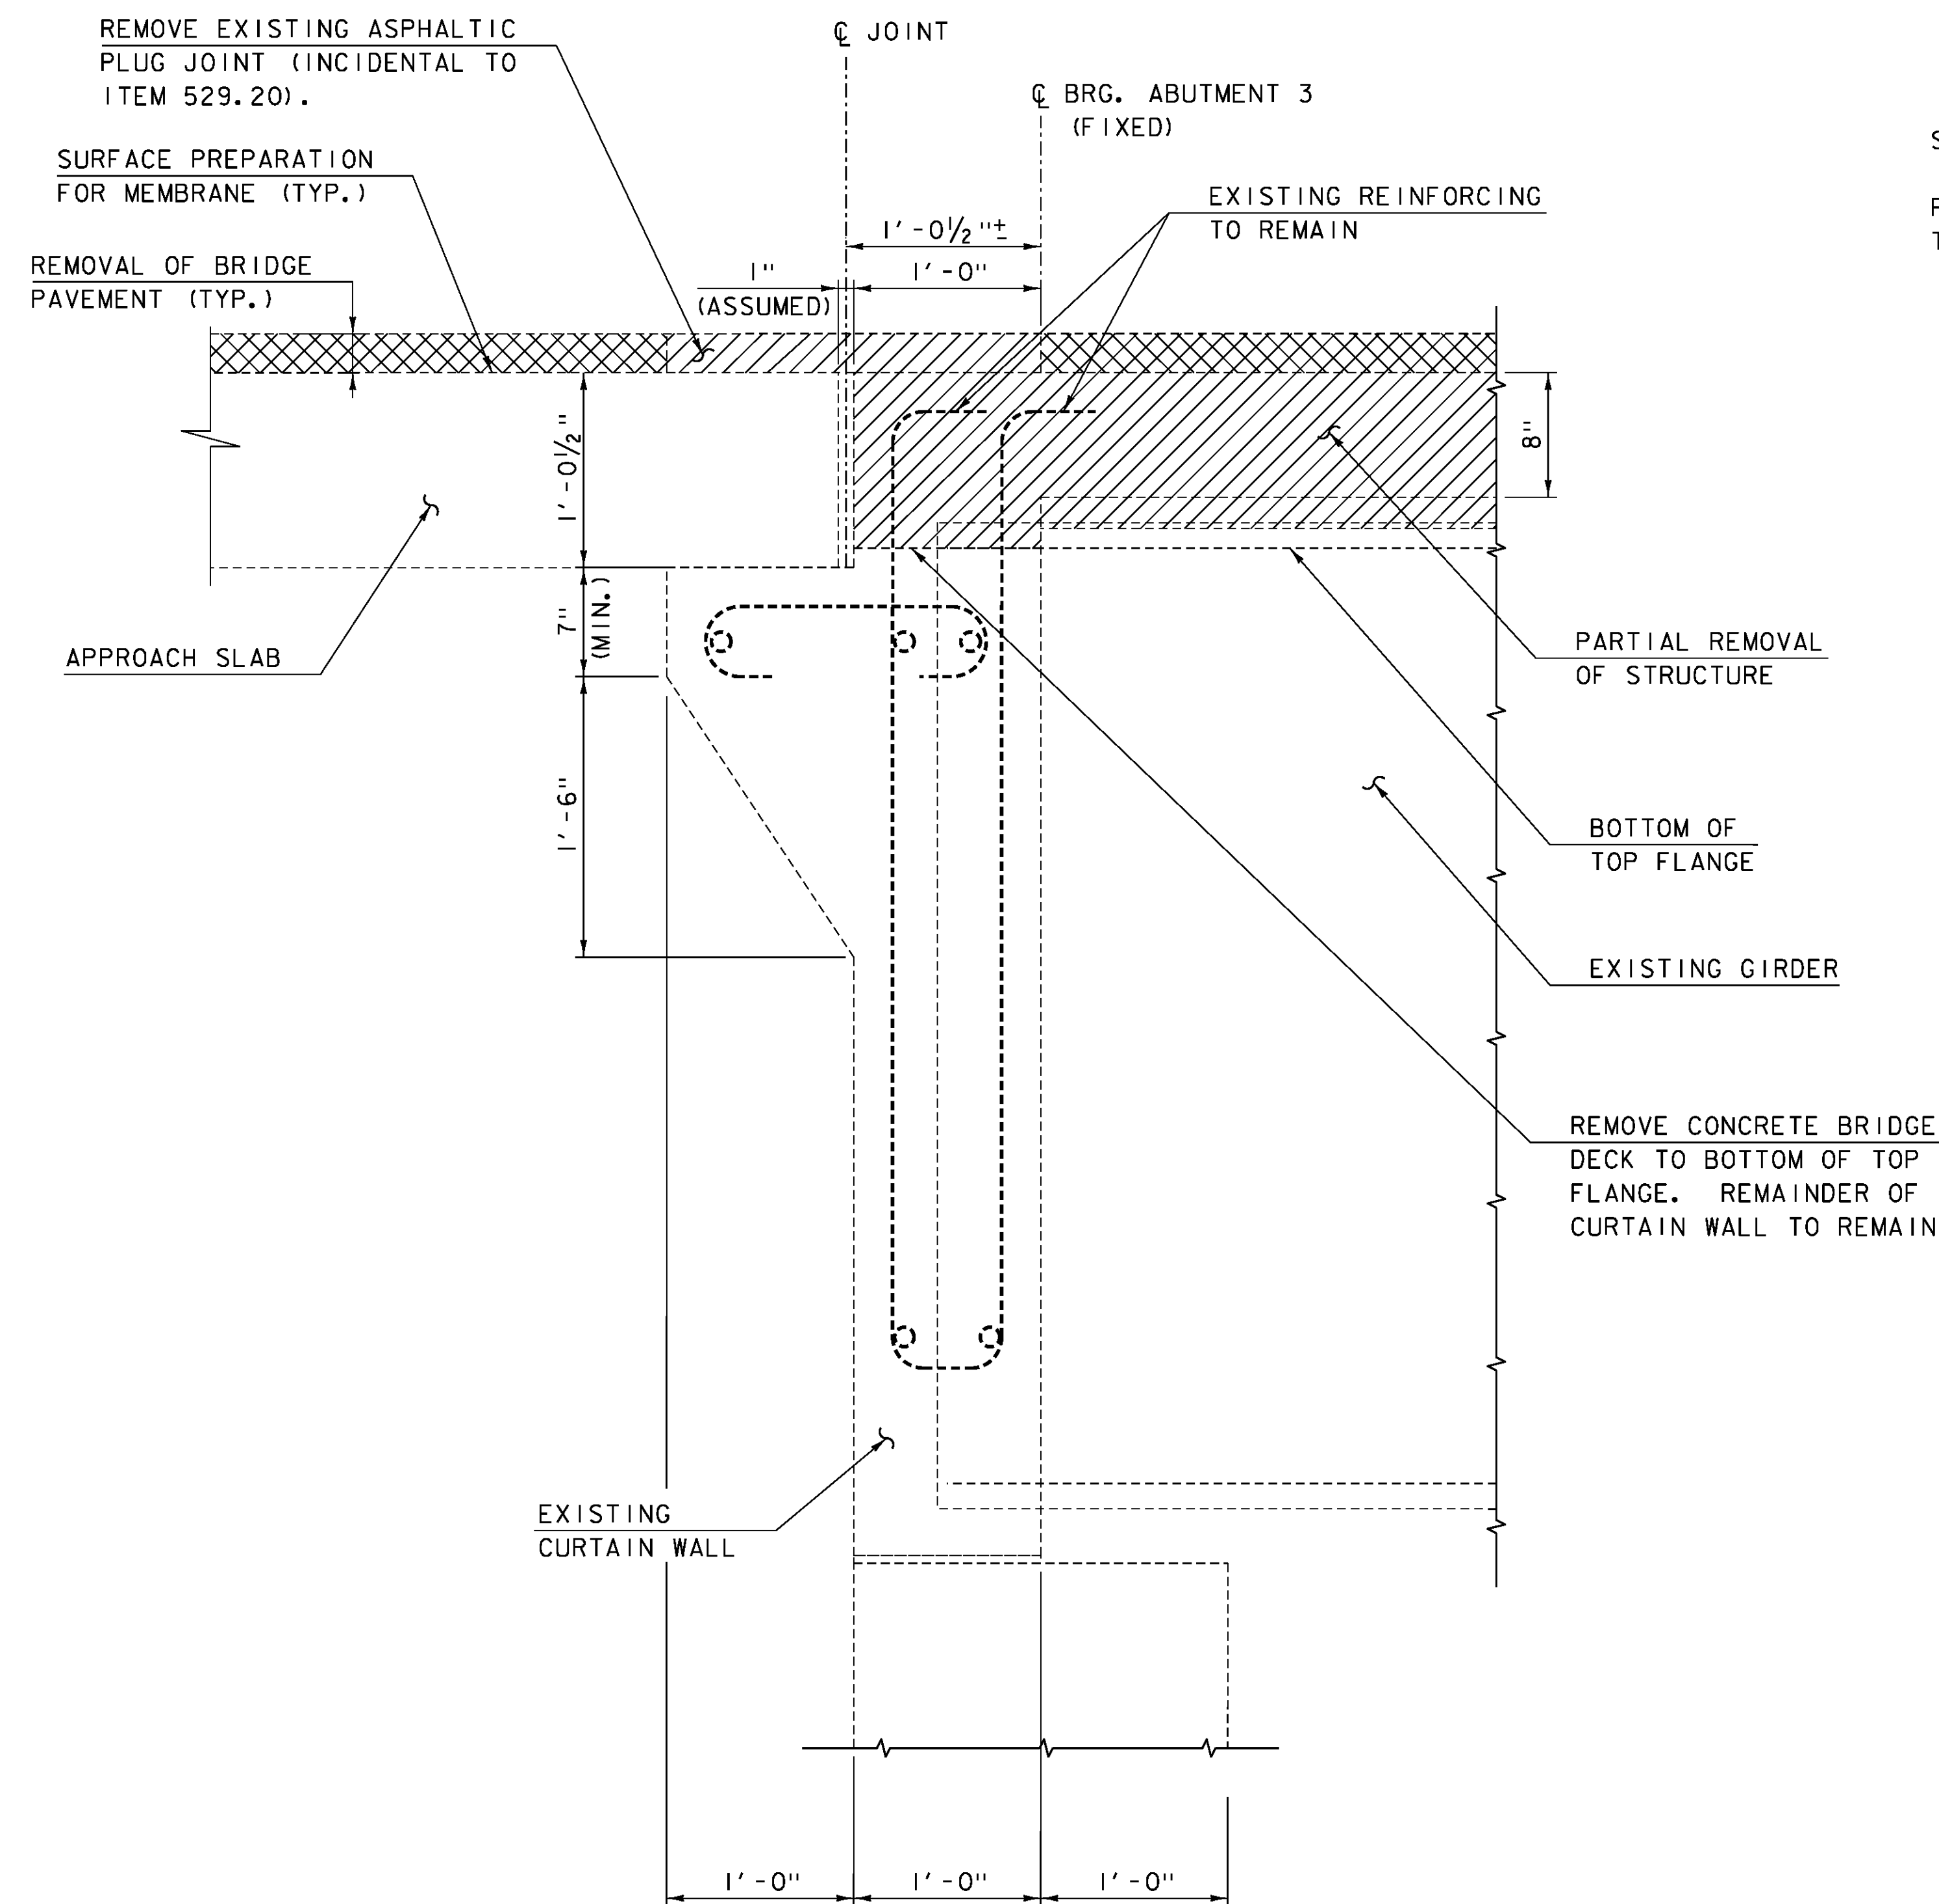

**DECK REMOVAL DETAIL AT ABUTMENT 3**

SCALE: 1 1/2" = 1'-0"

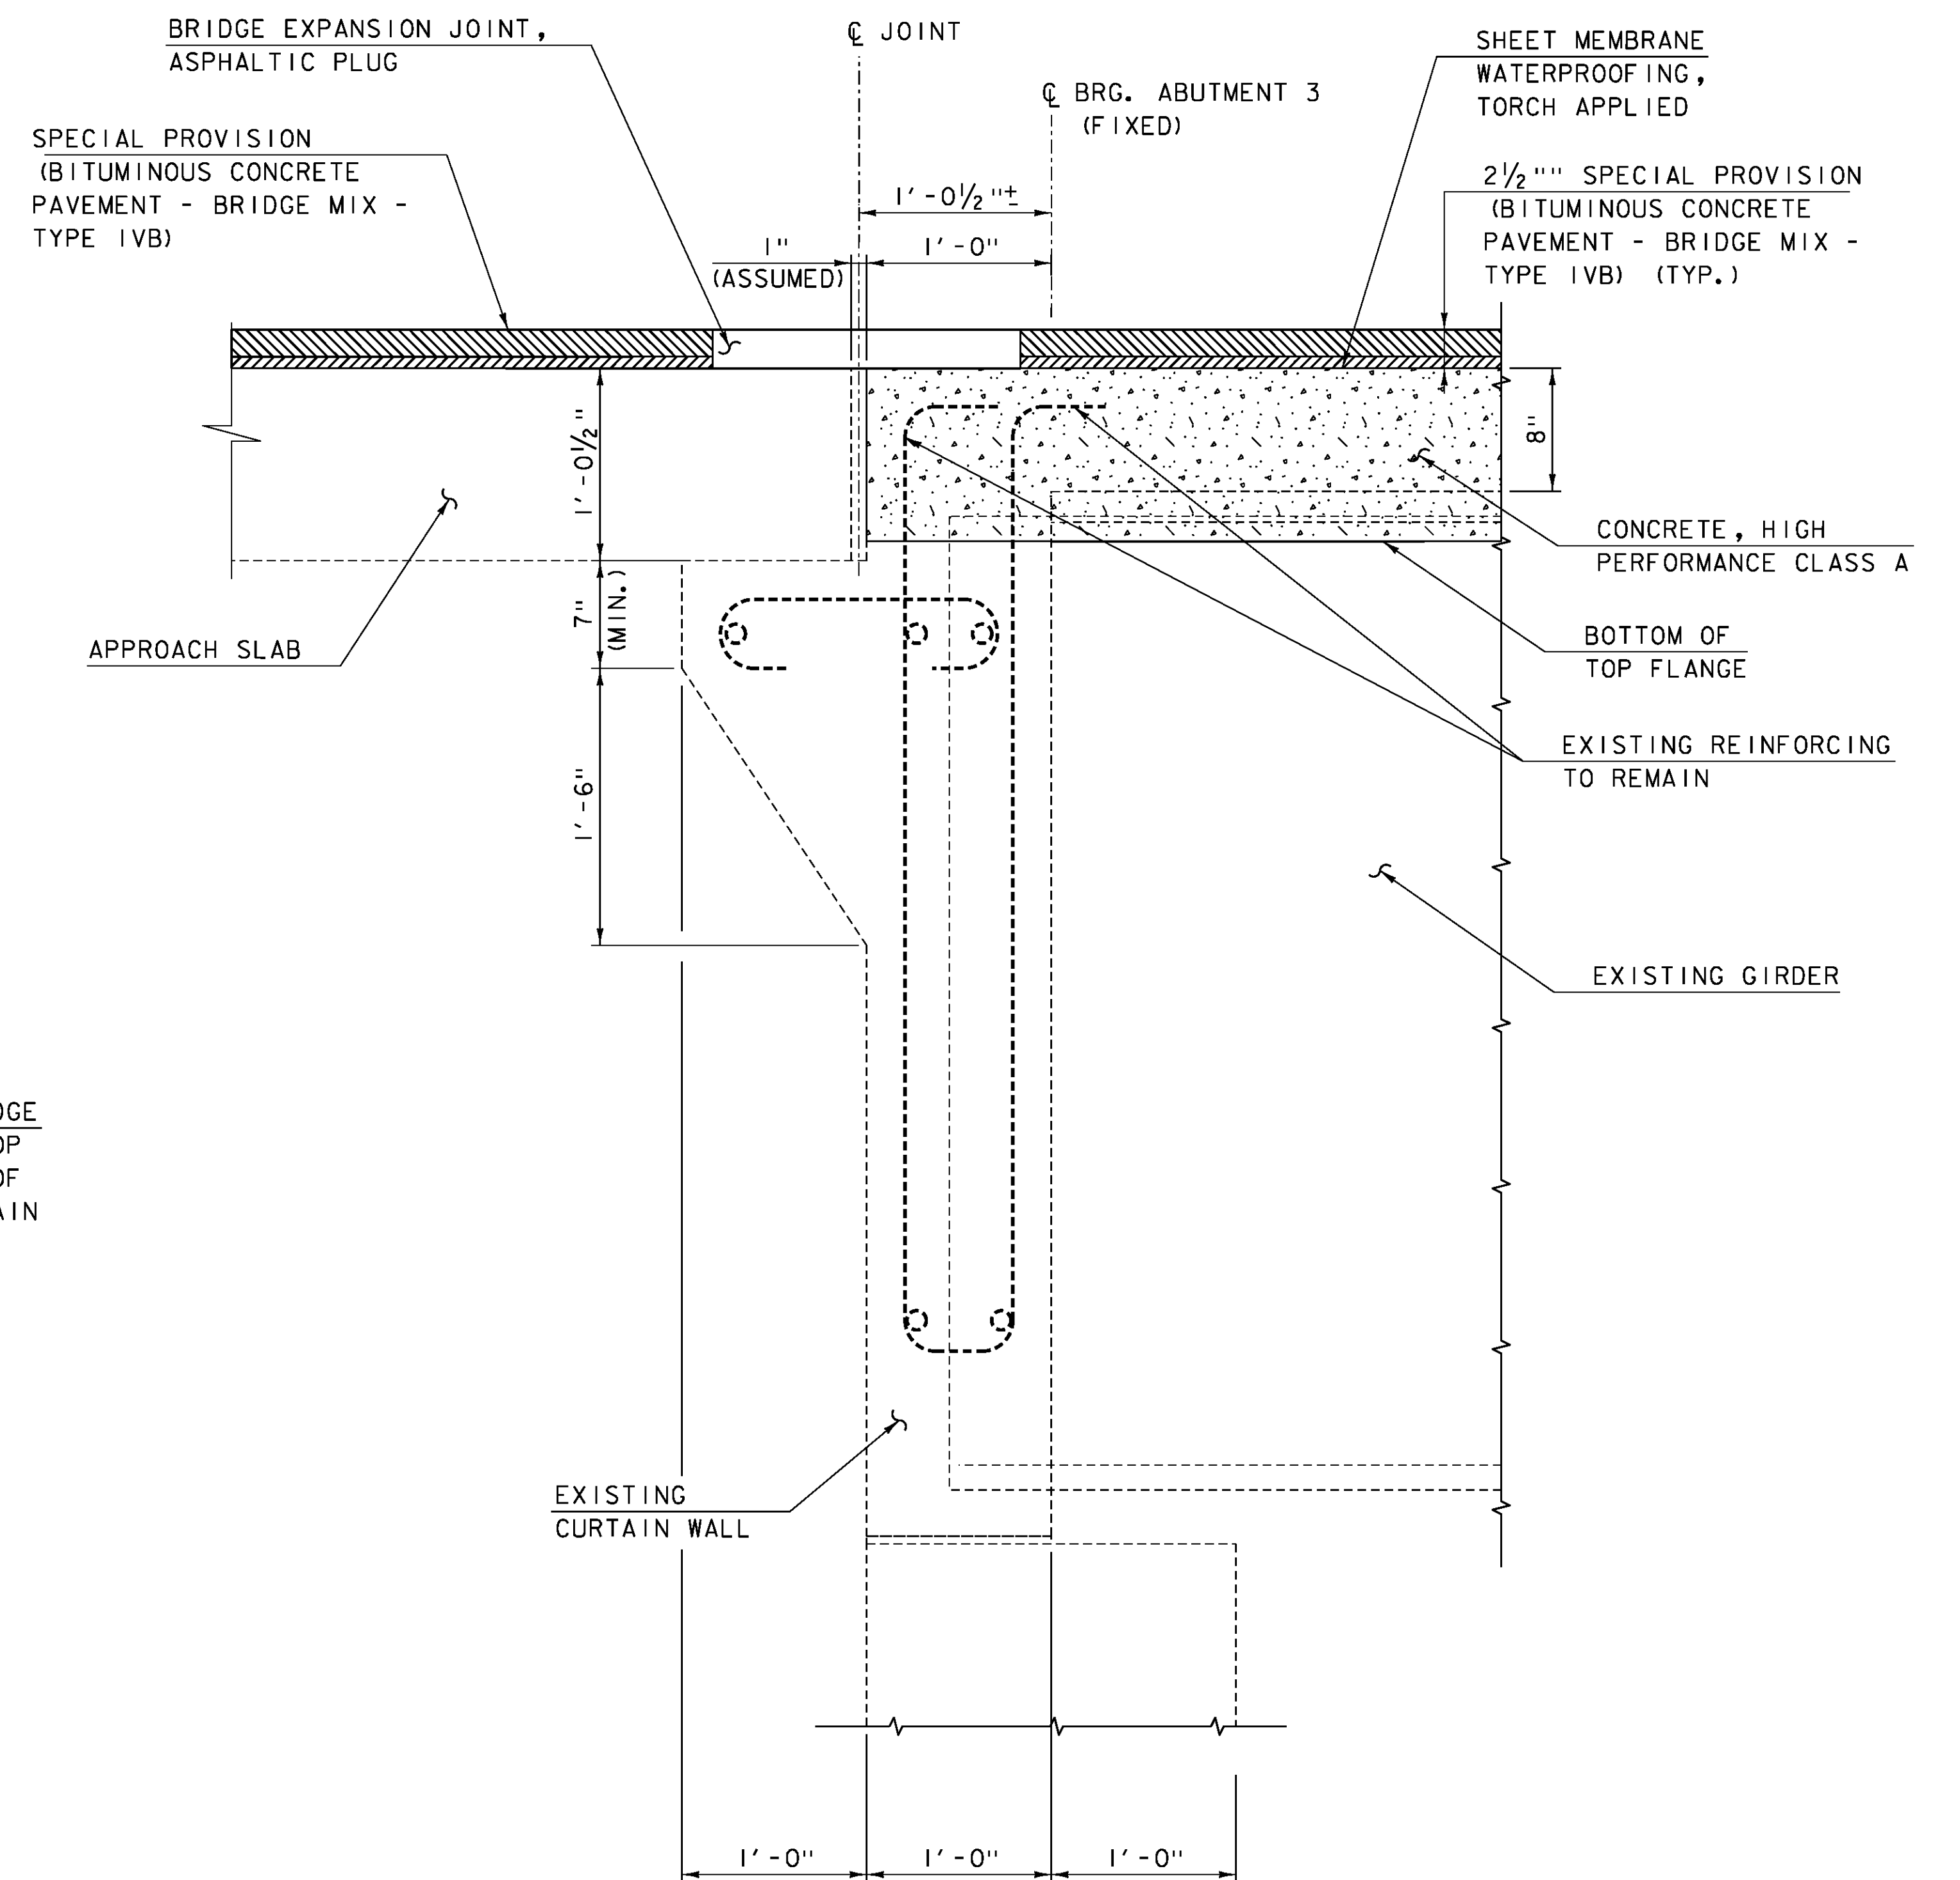

**JOINT DETAIL AT ABUTMENT 3**

SCALE: 1 1/2" = 1'-0"







PROJECT NAME: IRASBURG  
PROJECT NUMBER: IM DECK(46)

FILE NAME: z15oll6+yp-l07N.dgn  
PROJECT LEADER: J. BYATT  
DESIGNED BY: J. FRENCH  
JOINT DETAILS SHEET 2

PLOT DATE: 2/5/2016  
DRAWN BY: M. SMITH  
CHECKED BY: S. BEAUMONT  
SHEET 22 OF 49



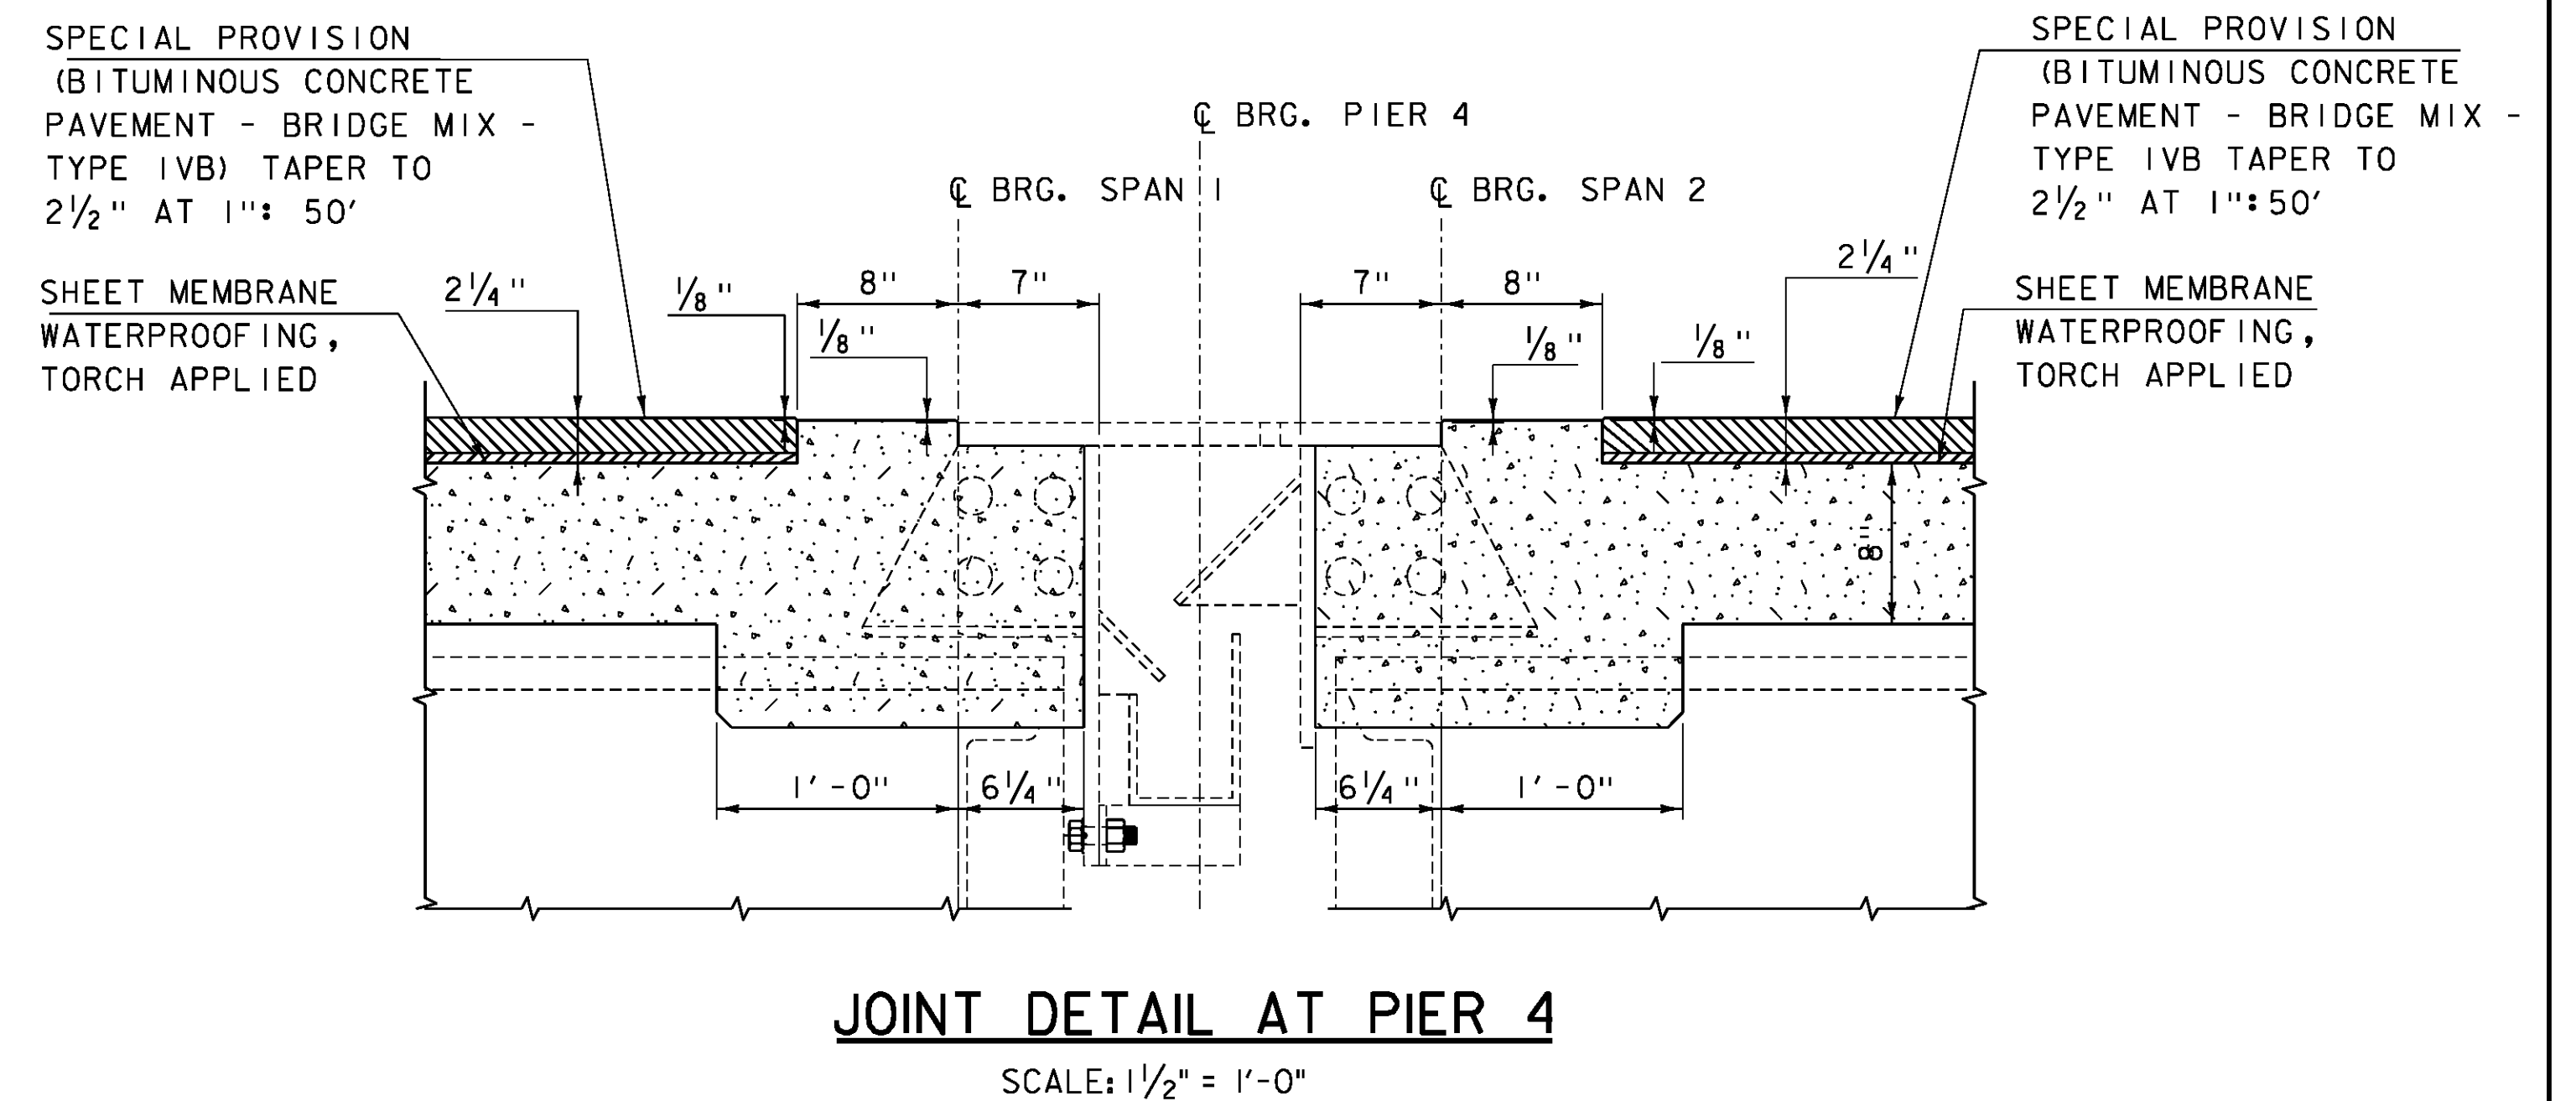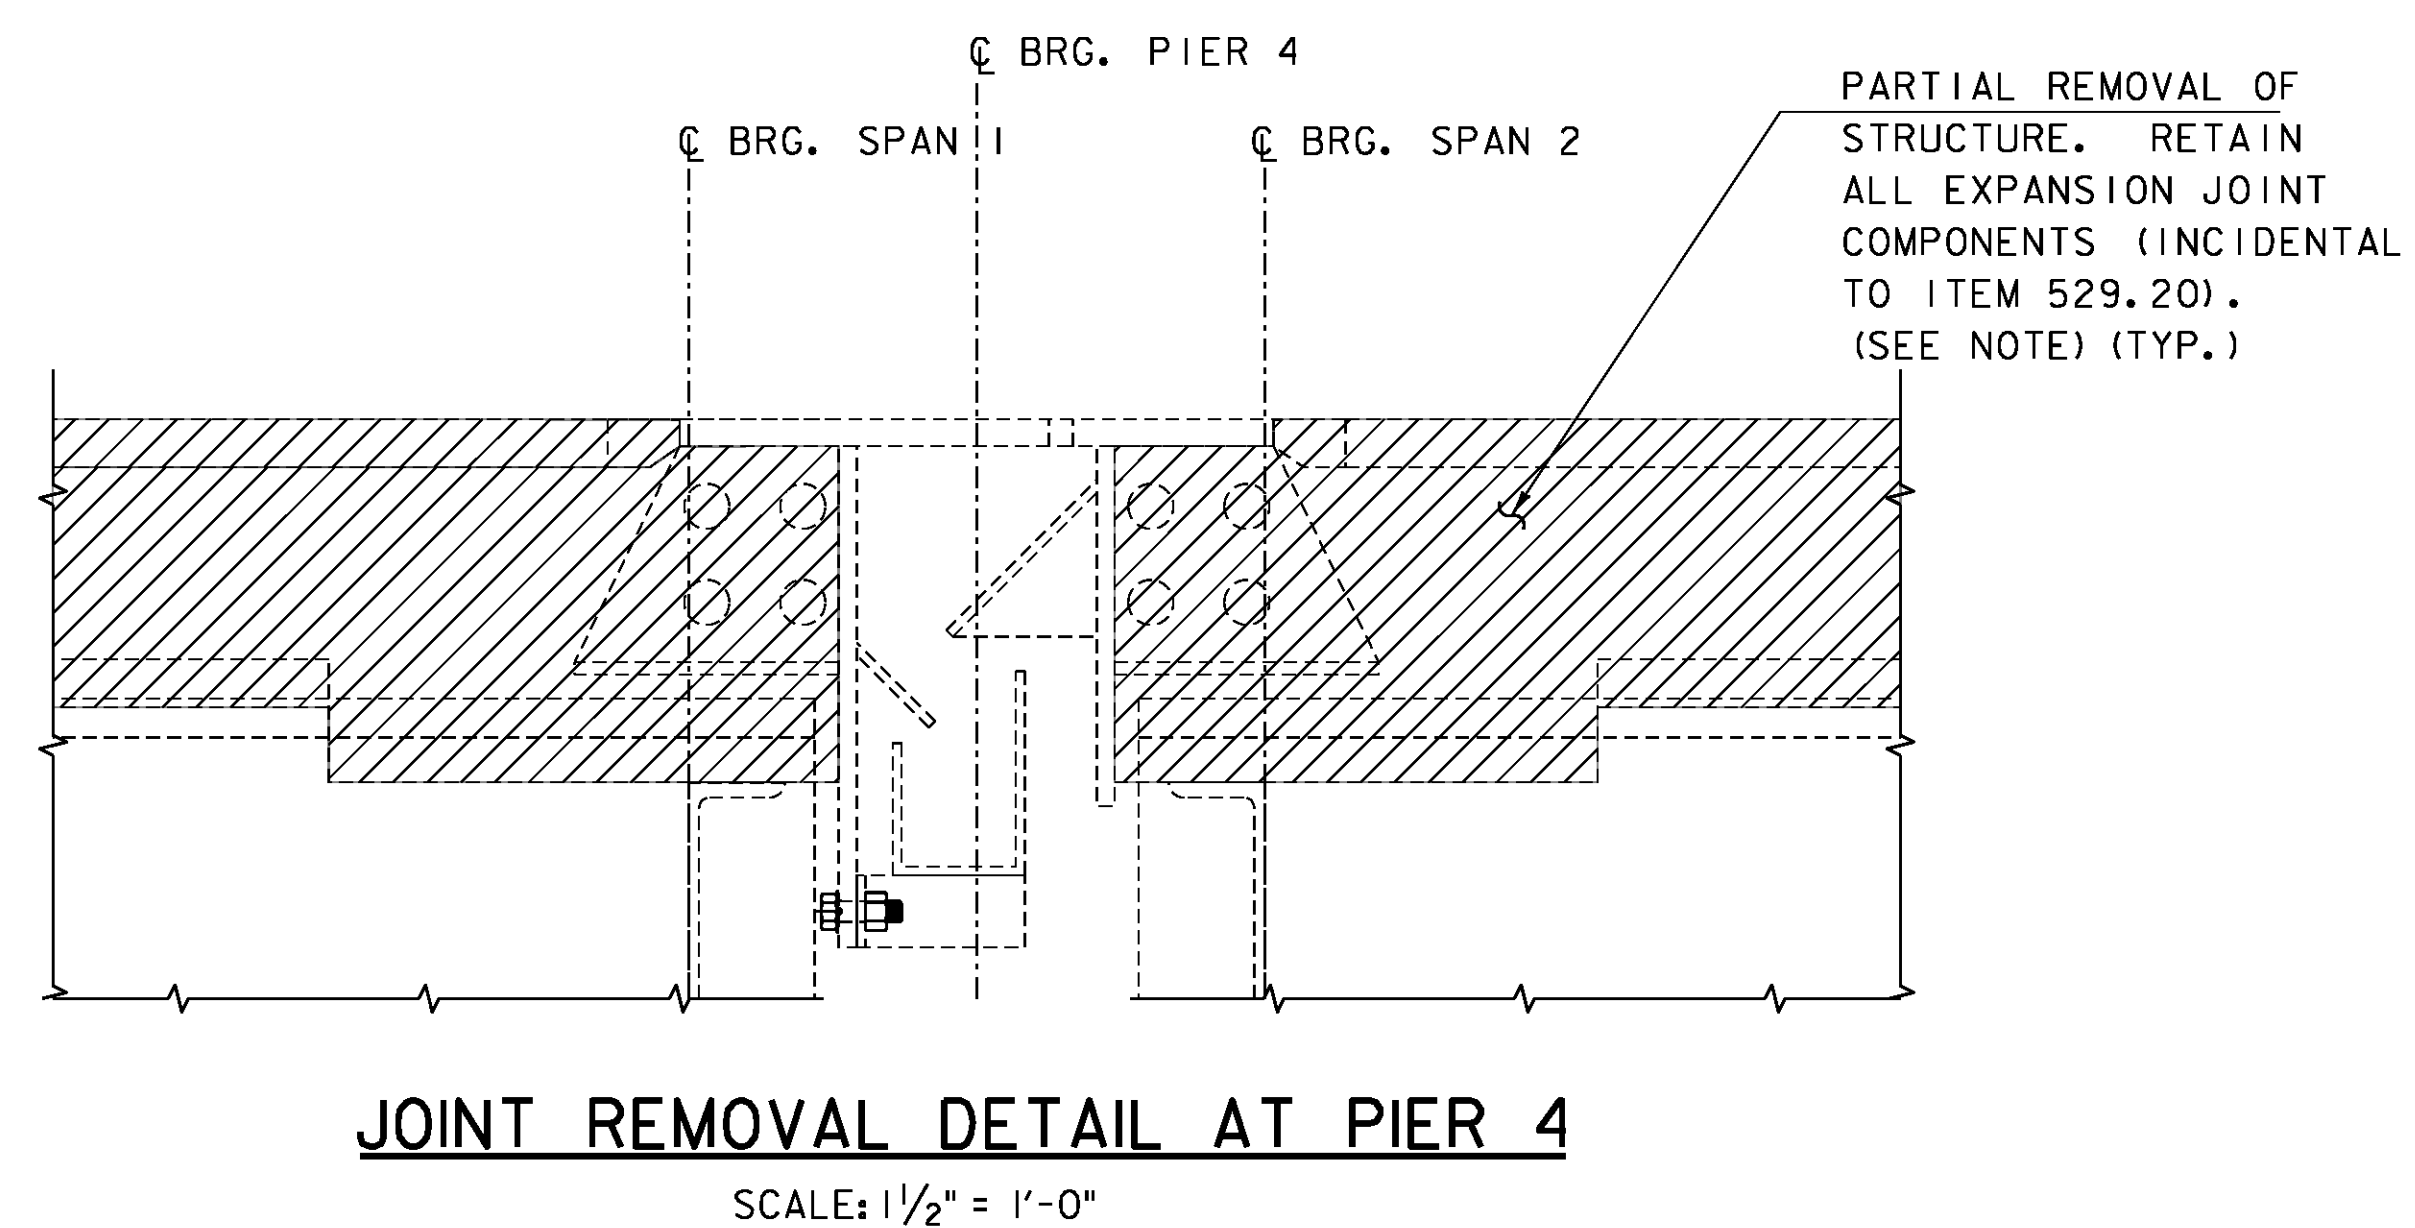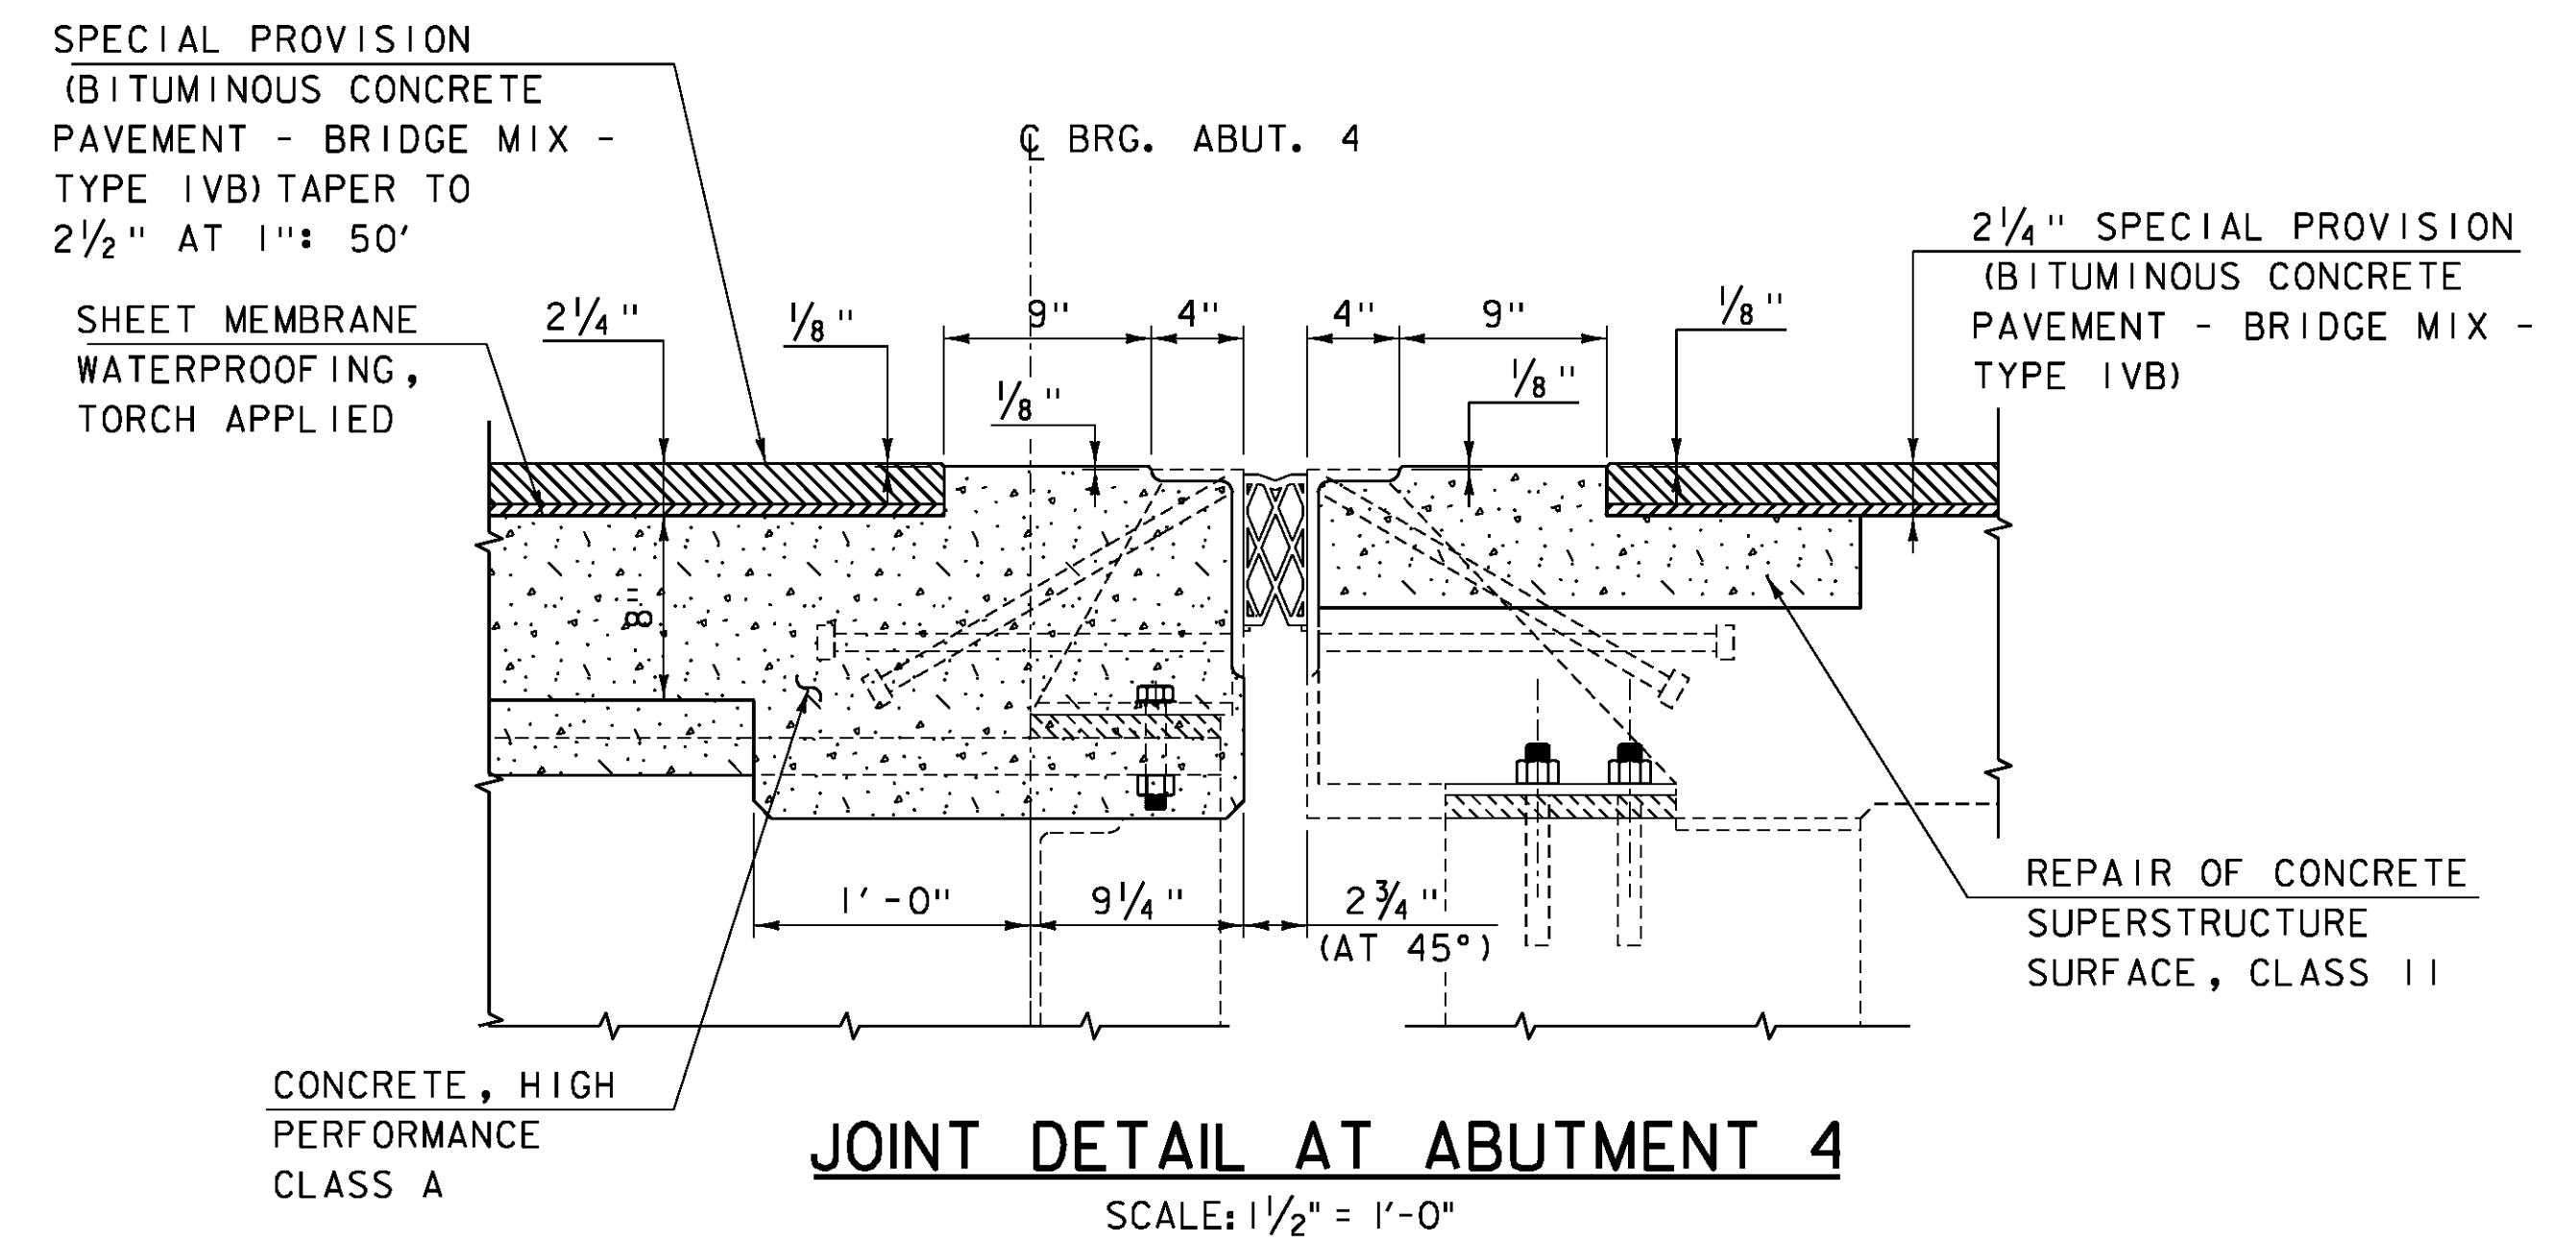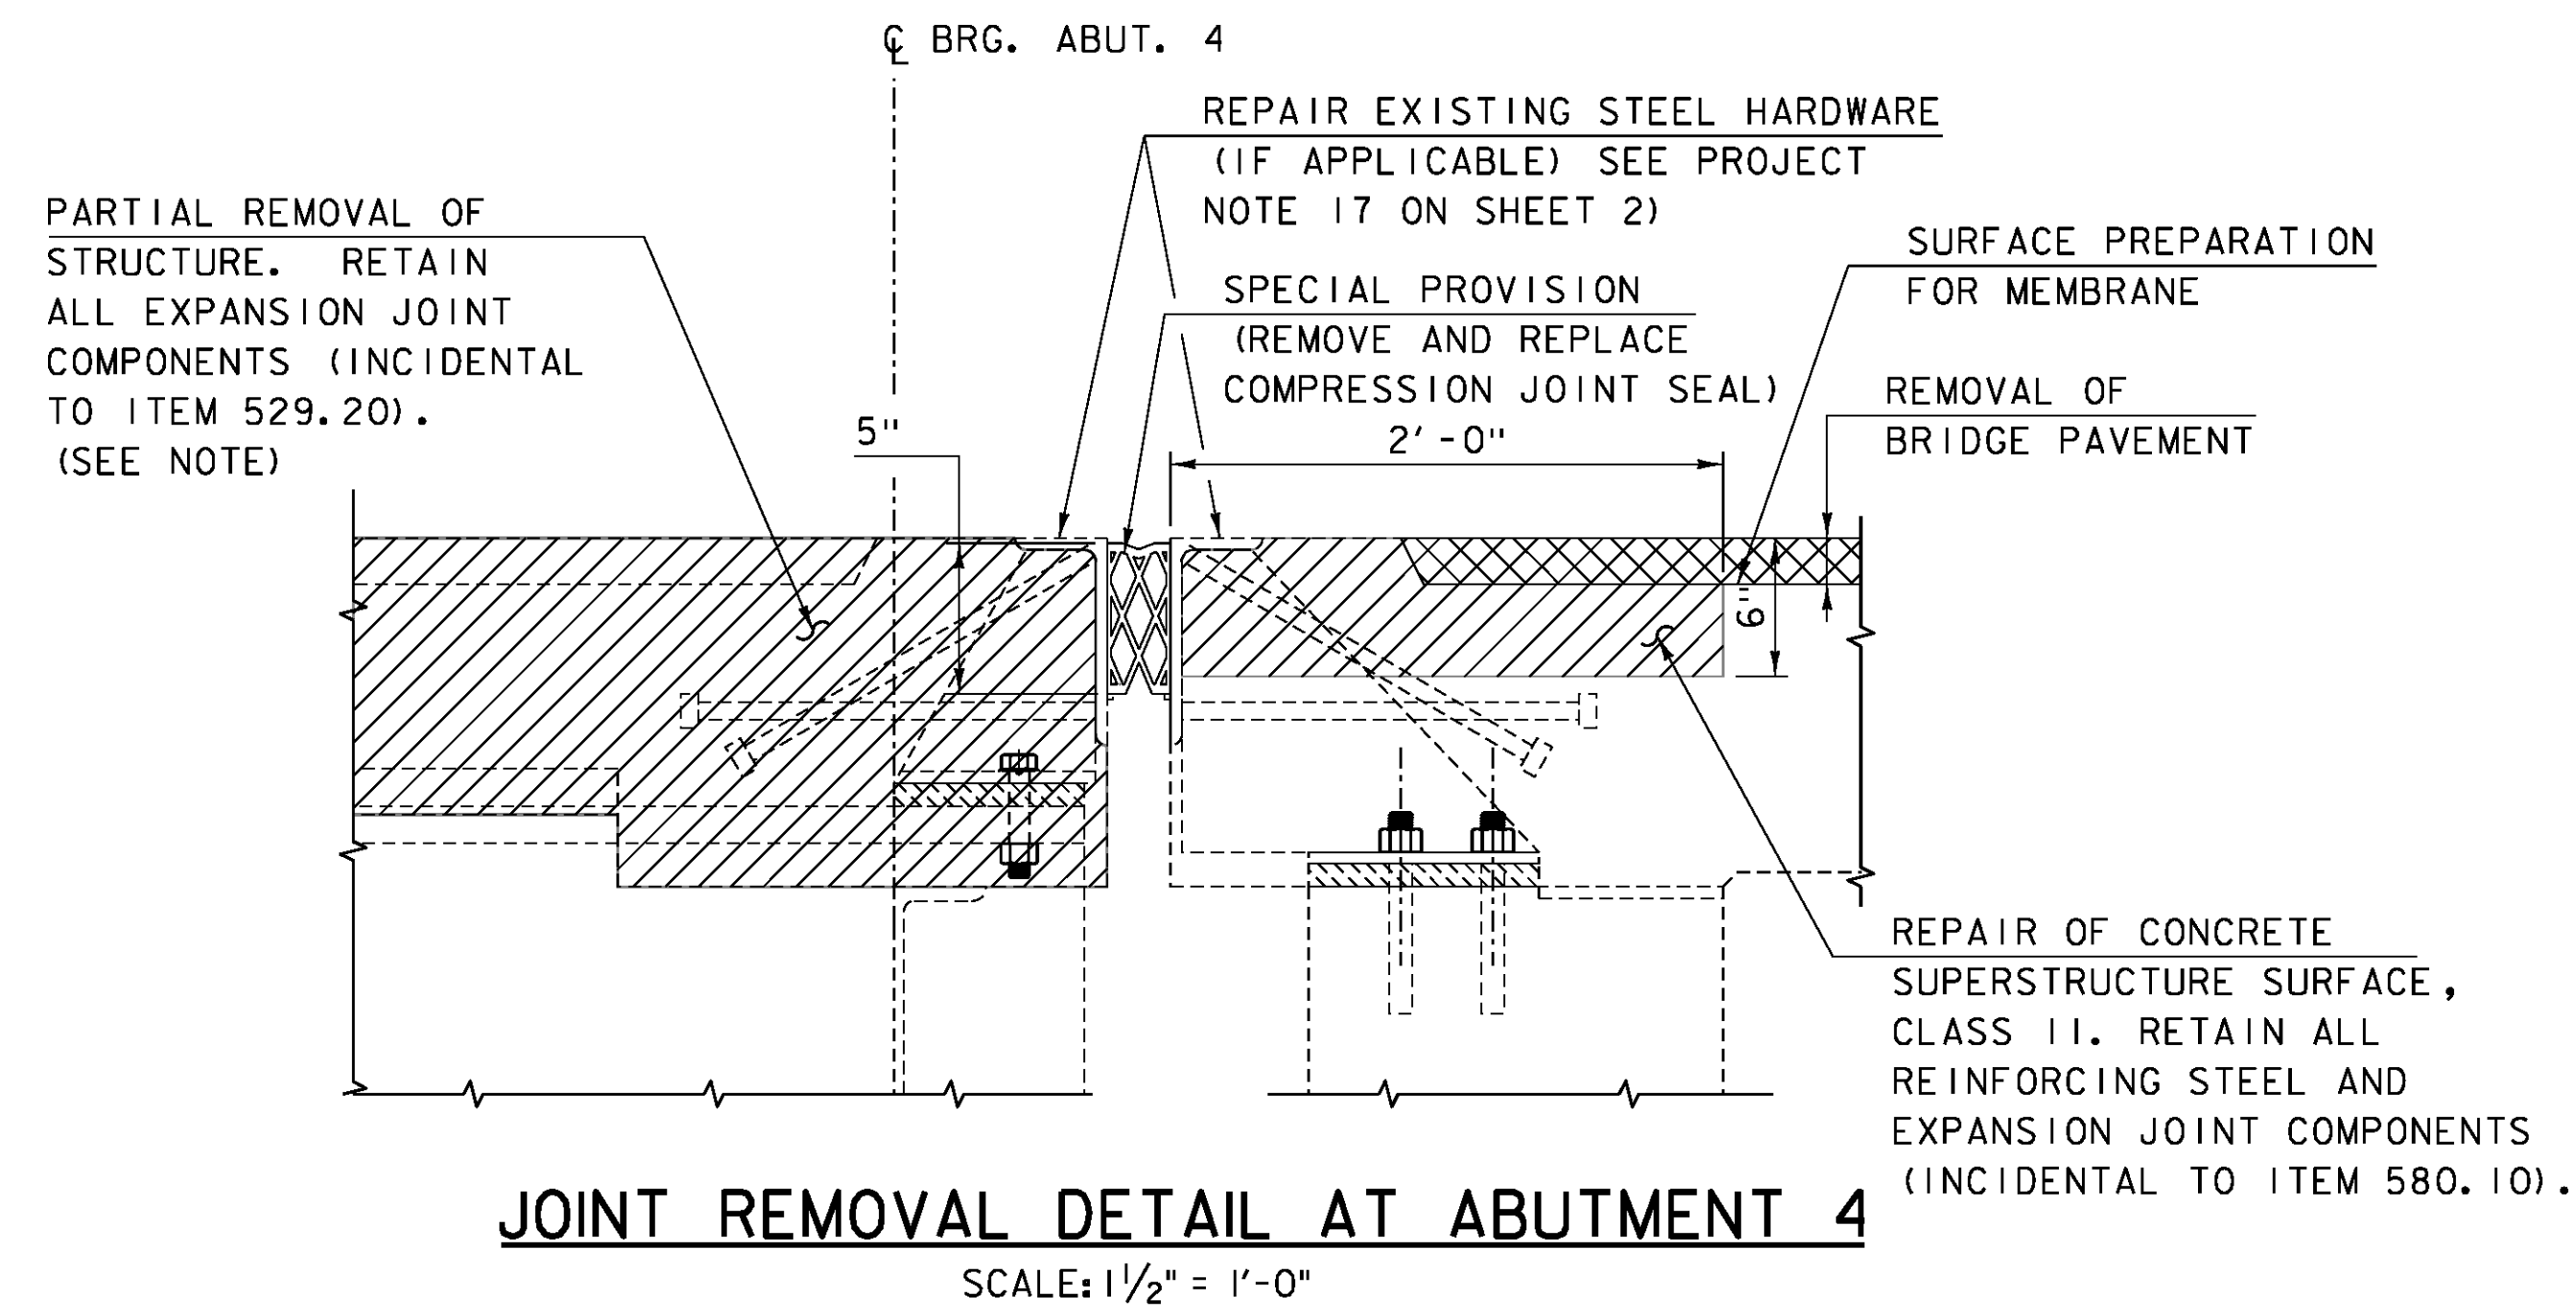


NOTE: SEE PROJECT NOTES 16 THROUGH 18 ON SHEET 2 FOR ADDITIONAL JOINT INFORMATION.

PROJECT NAME:	IRASBURG
PROJECT NUMBER:	IM DECK(46)
FILE NAME:	z15all6+yp-107N.dgn
PROJECT LEADER:	J. BYATT
DESIGNED BY:	J. FRENCH
JOINT DETAILS SHEET 3	
PLOT DATE:	2/5/2016
DRAWN BY:	M. SMITH
CHECKED BY:	S. BEAUMONT
SHEET	23 OF 49






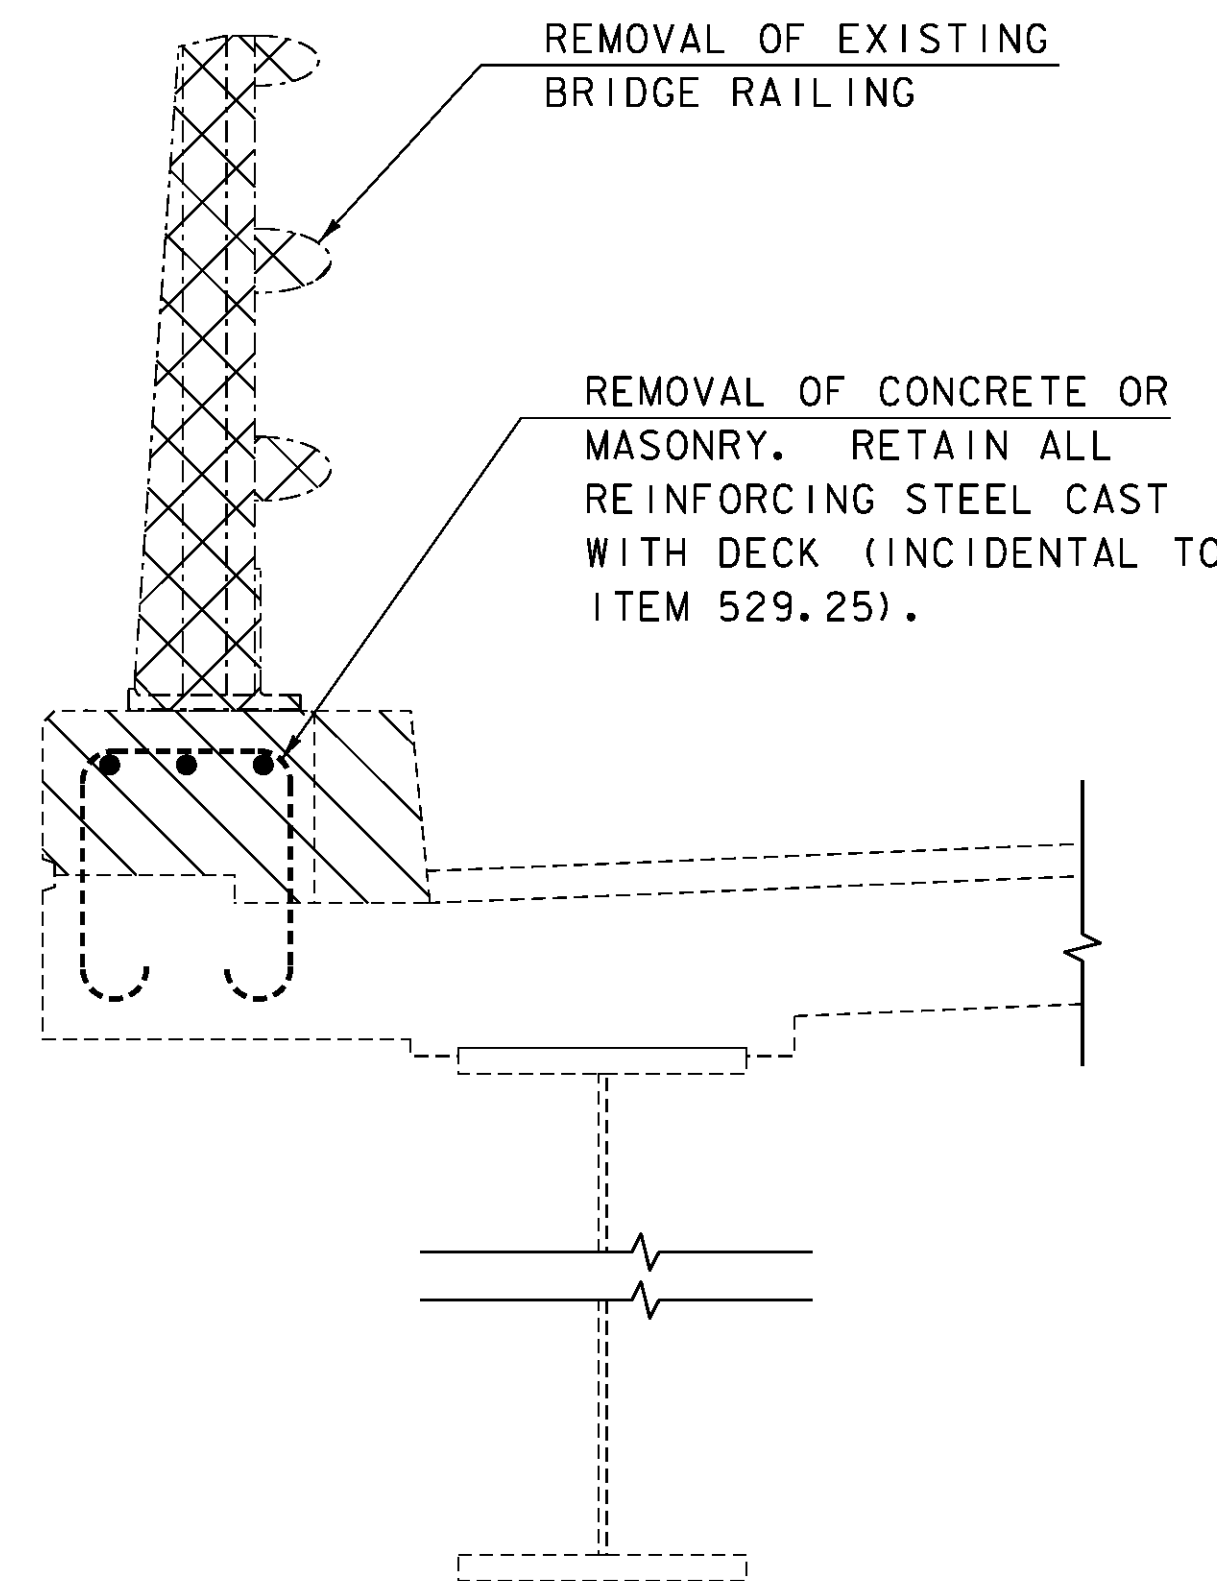

**SPAN I REMOVAL LIMITS**


SCALE: 1" = 1'-0"

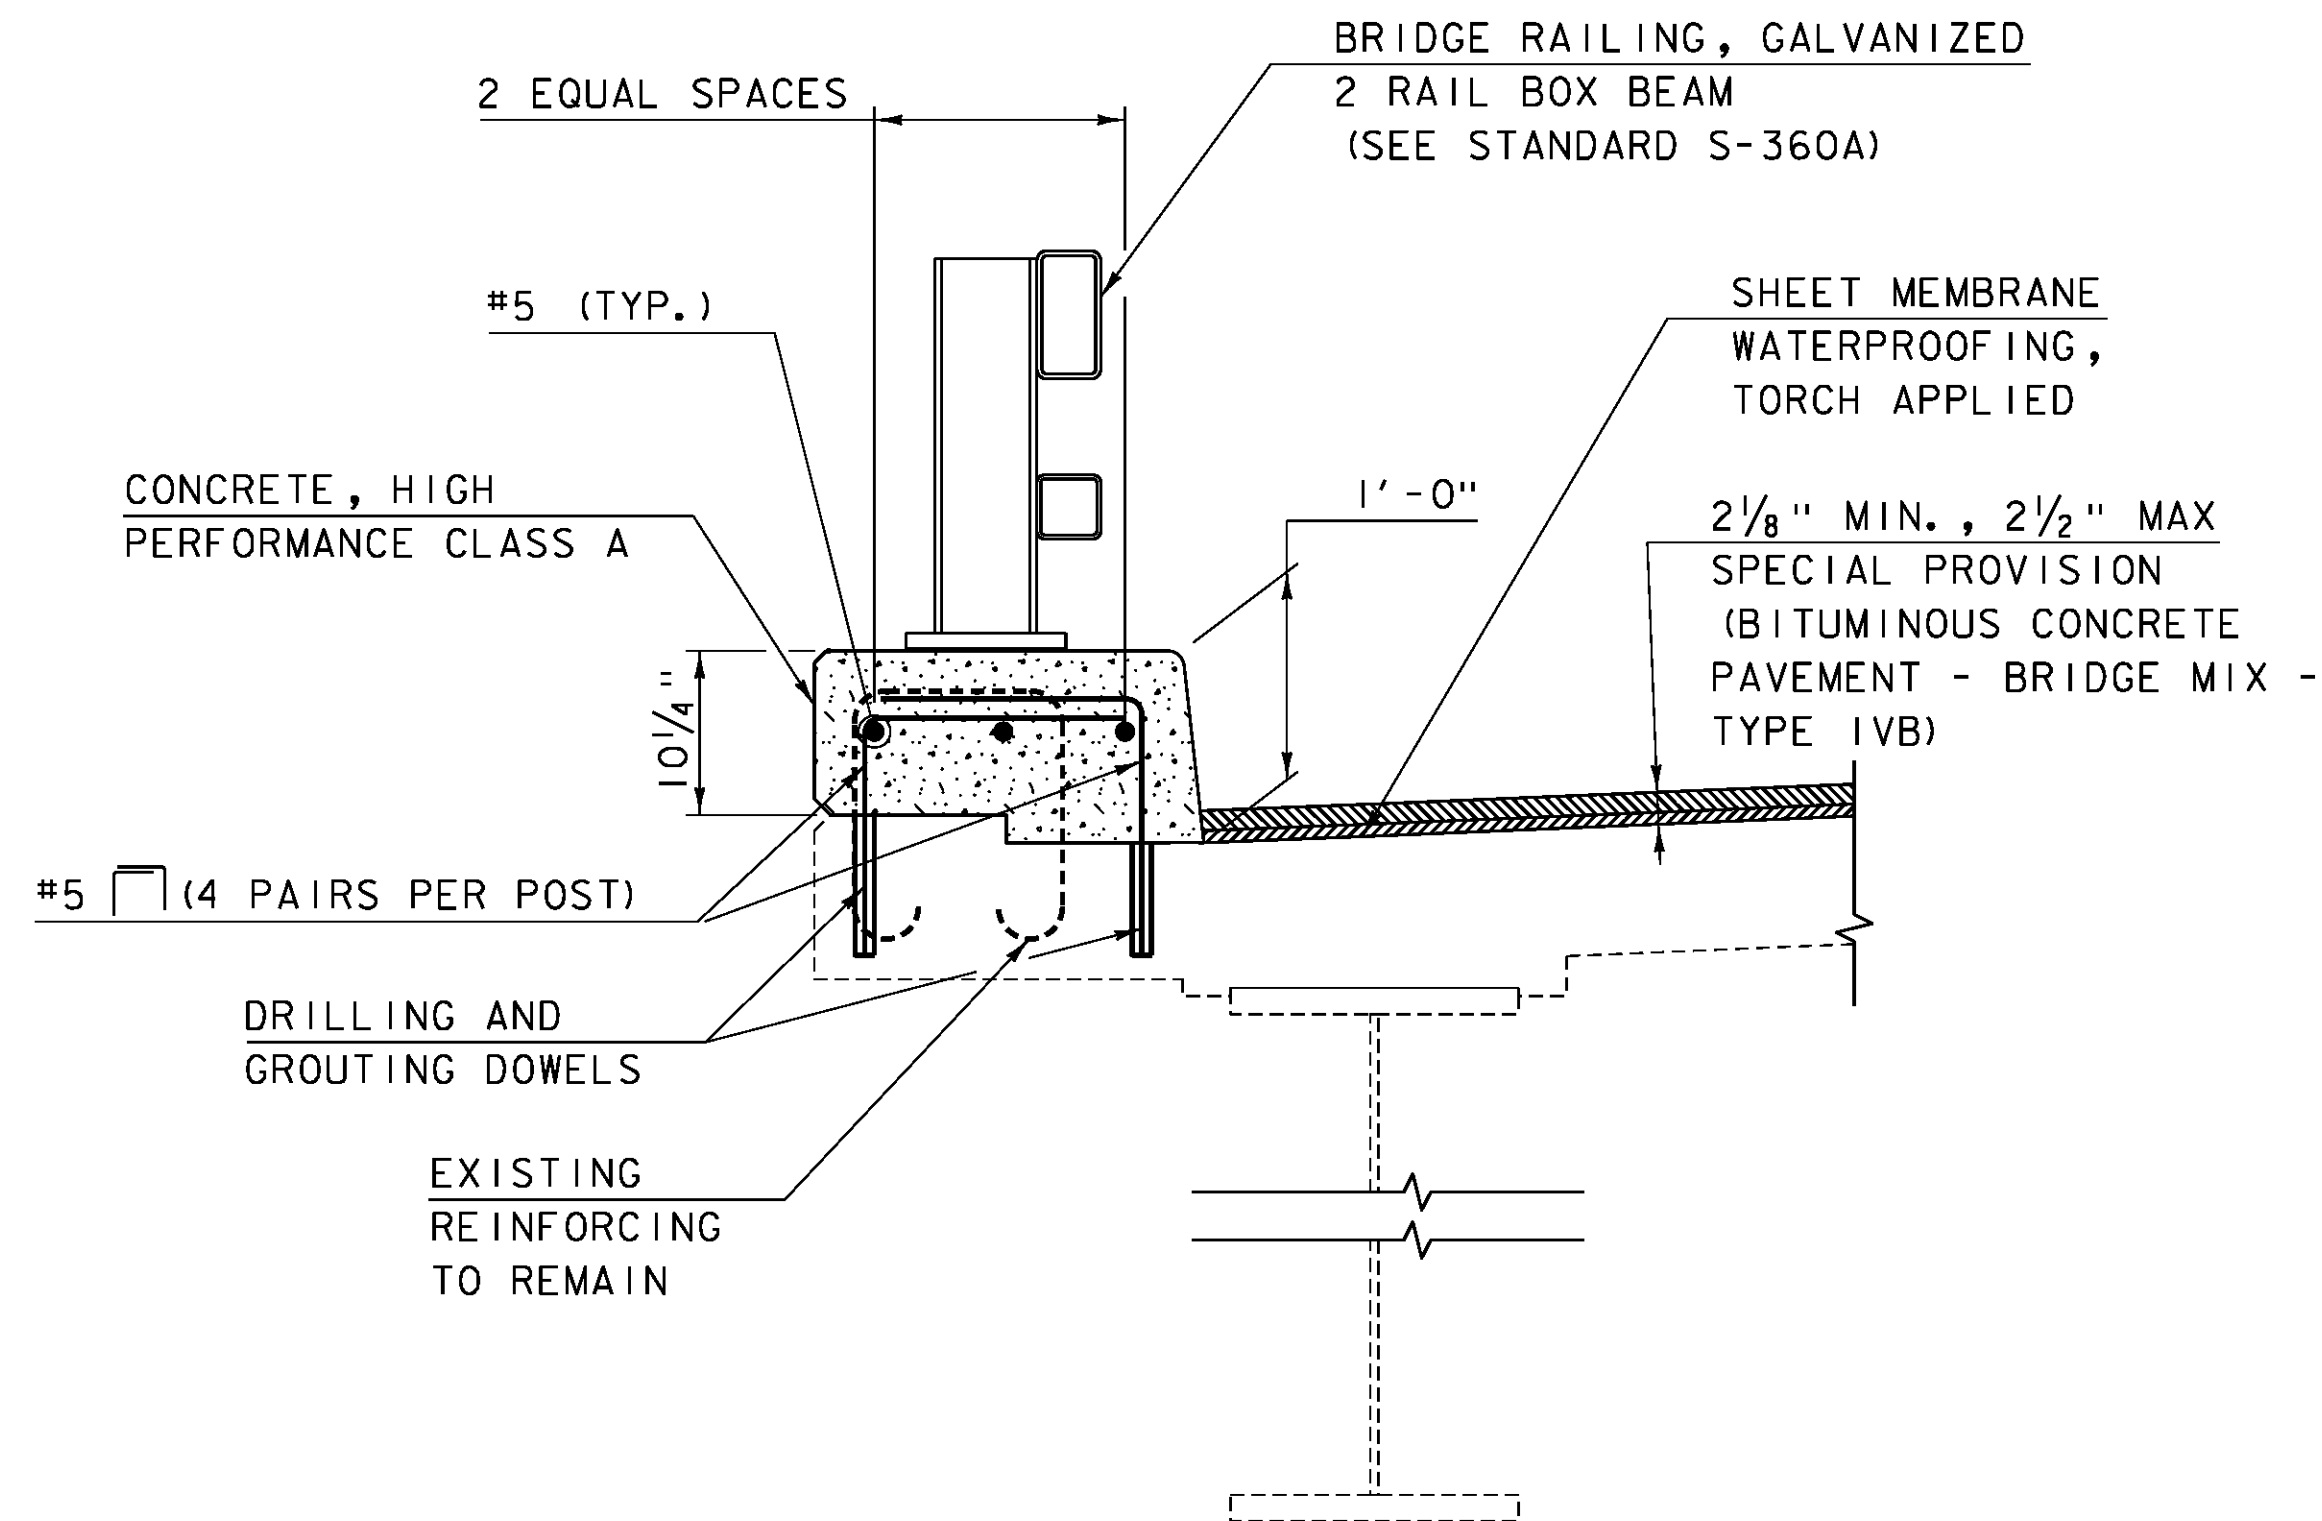

**TYPICAL SPAN I SECTION**


SCALE: 1" = 1'-0"

TO BE USED IF SPAN I REMAINS IN-PLACE

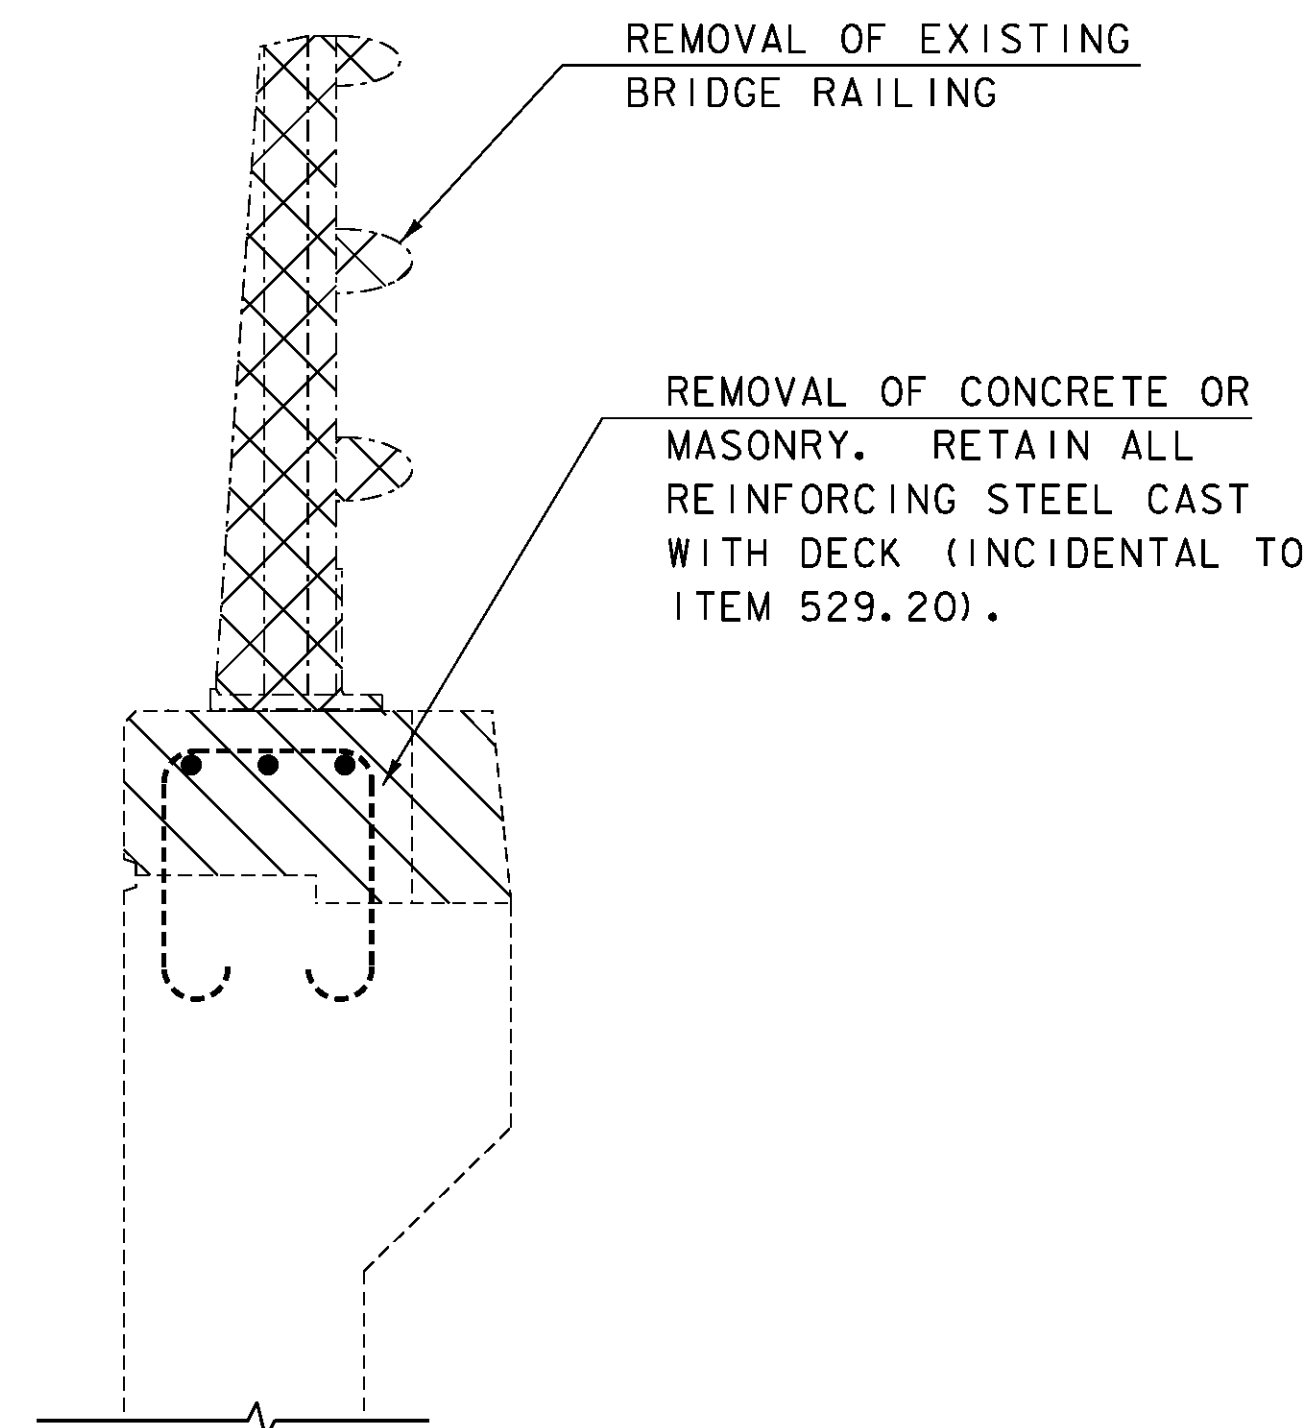


**WINGWALL REMOVAL LIMITS**

SCALE: 1" = 1'-0"

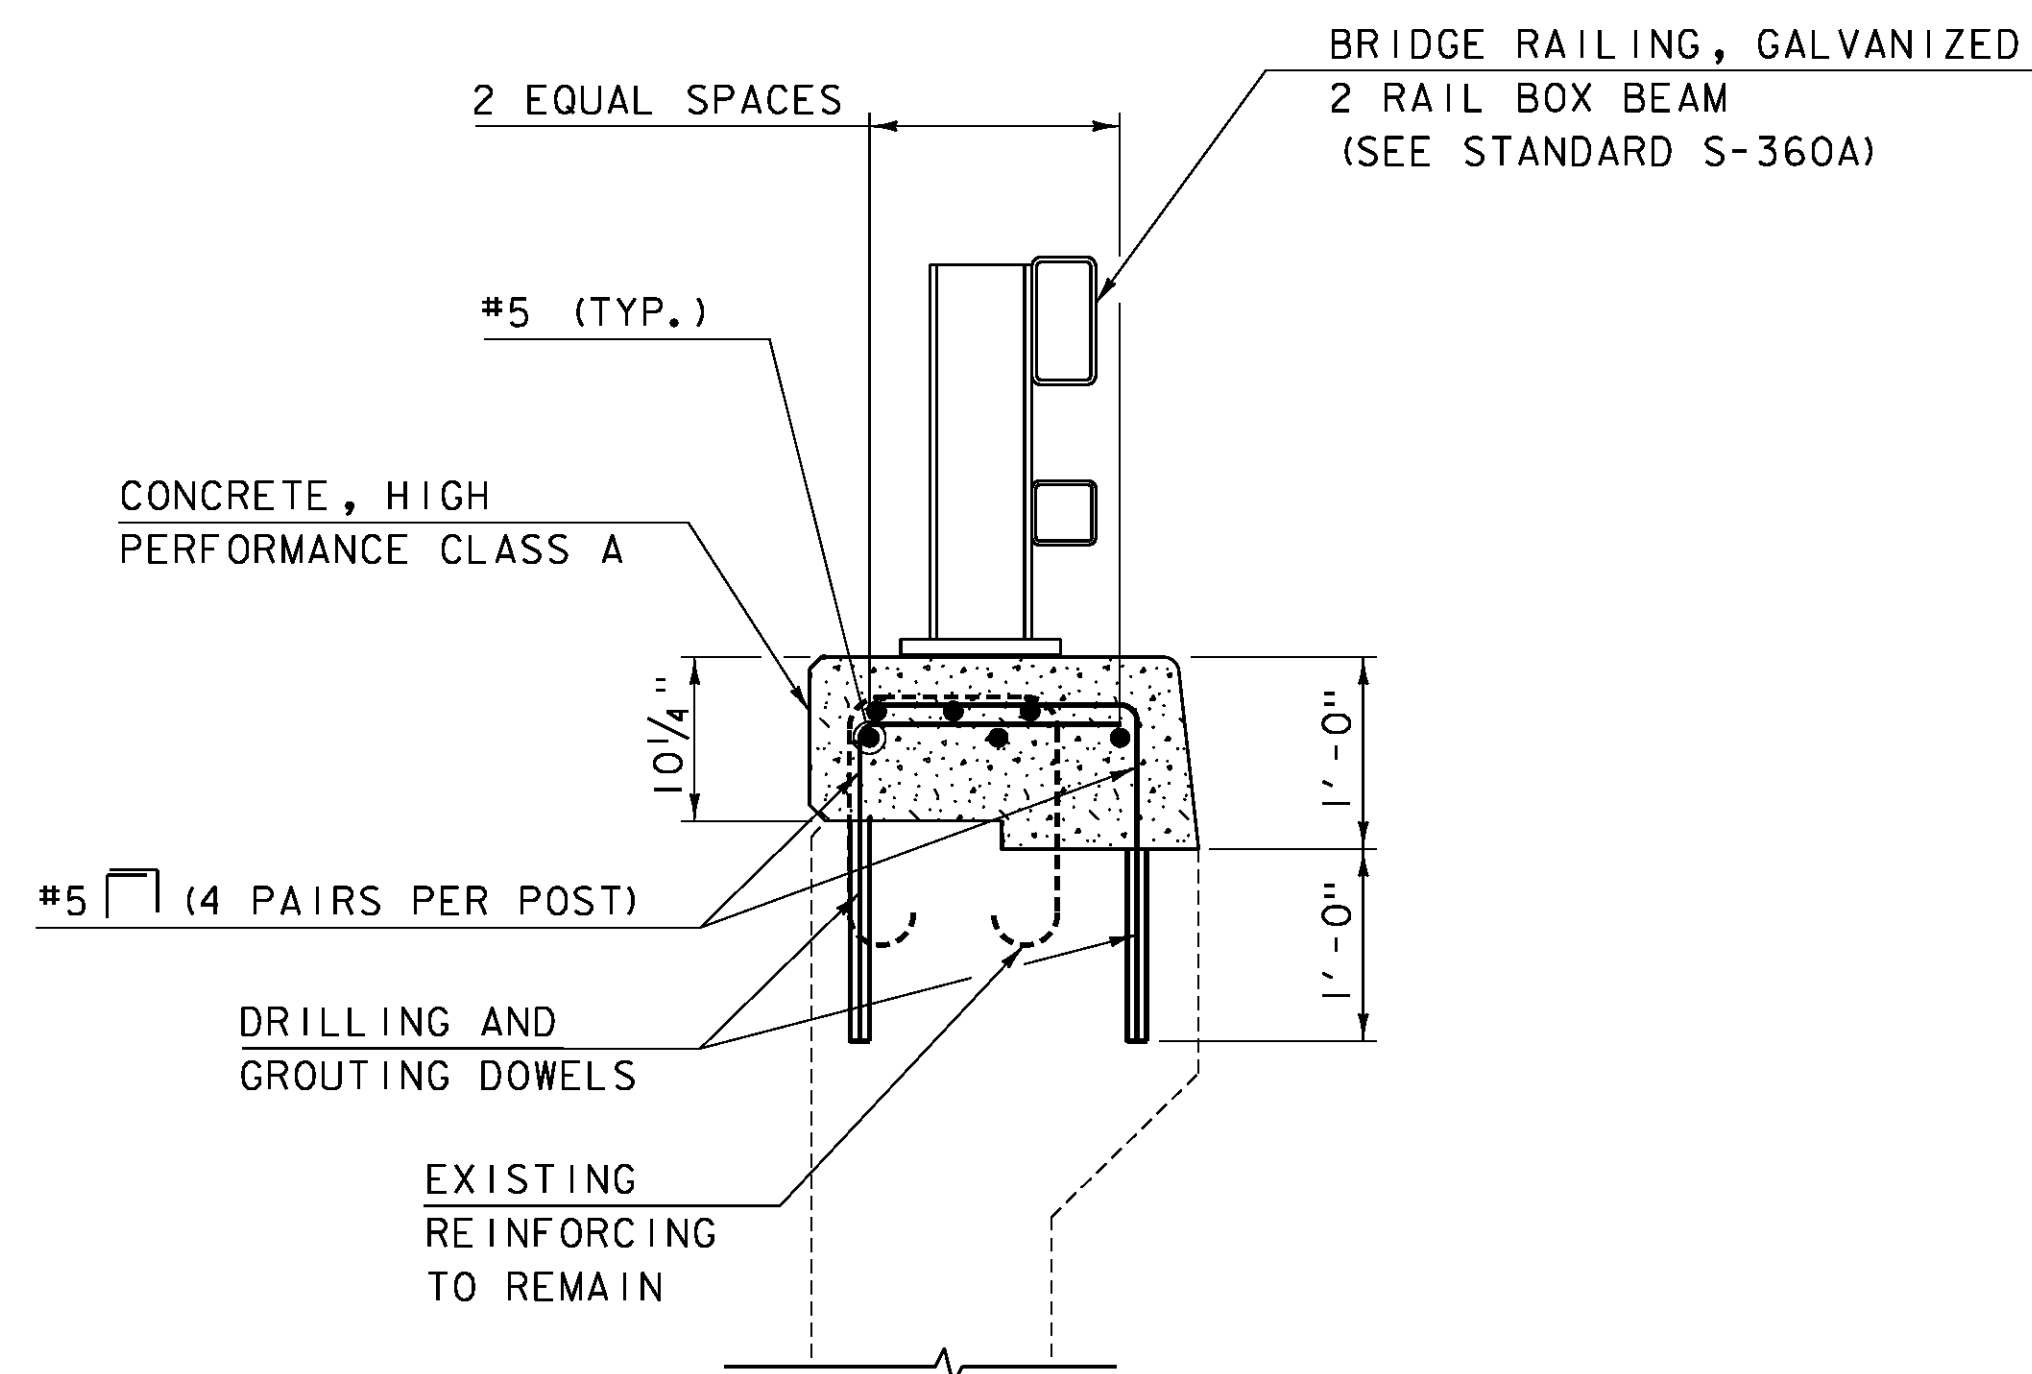


**TYPICAL WINGWALL SECTION**

SCALE: 1" = 1'-0"

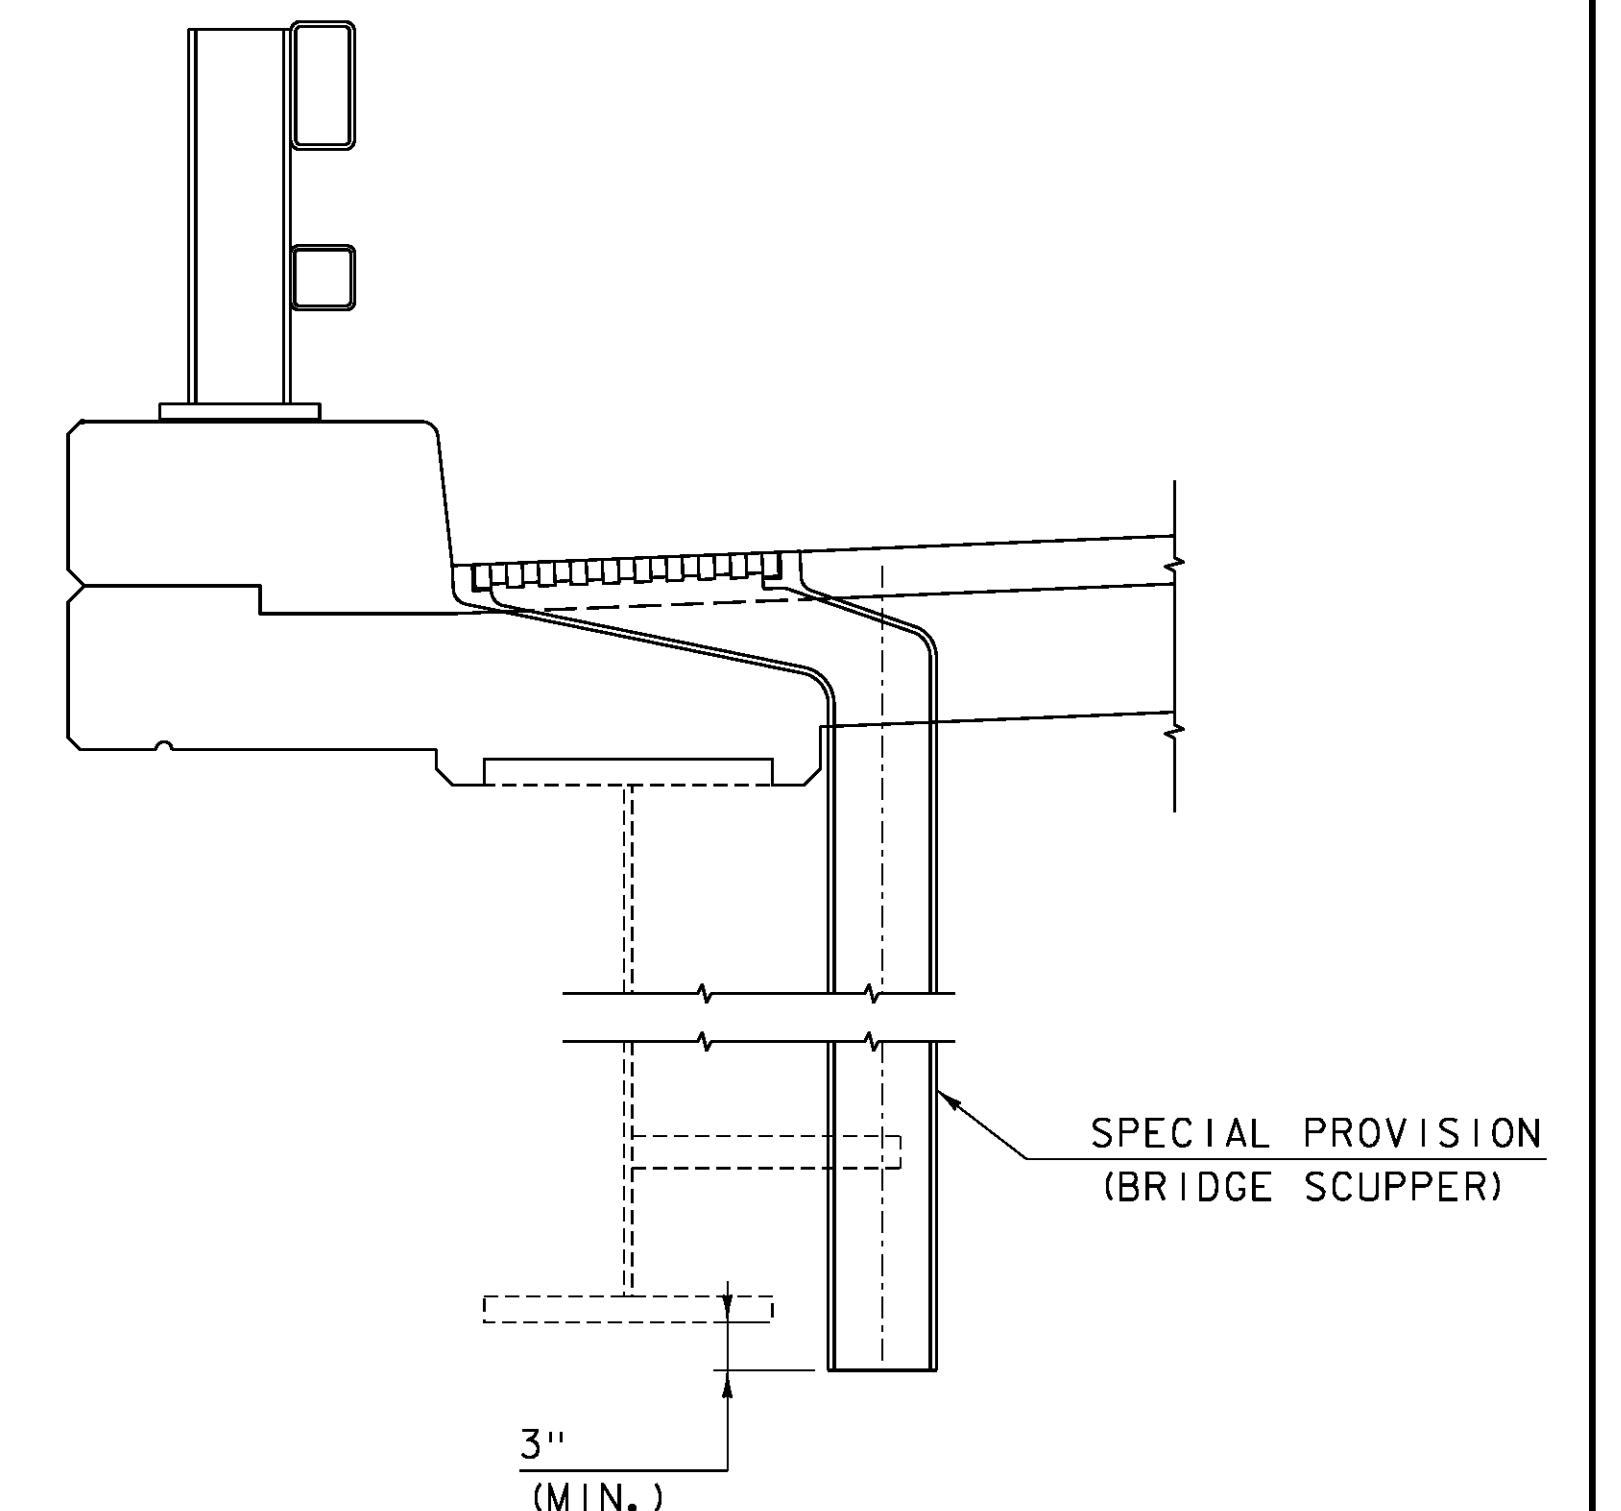

**TYPICAL SCUPPER DETAIL**

SCALE: 1" = 1'-0"

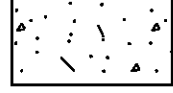-  REMOVAL OF EXISTING BRIDGE RAILING
-  REMOVAL OF CONCRETE OR MASONRY  
SEE PROJECT NOTES 13 AND 14 ON  
SHEET 2.
-  CONCRETE, HIGH PERFORMANCE CLASS A


PROJECT NAME: IRASBURG  
PROJECT NUMBER: IM DECK(46)

FILE NAME: z15dl16typ-107N.dgn  
PROJECT LEADER: J. BYATT  
DESIGNED BY: J. FRENCH  
CURB REPLACEMENT DETAILS SHEET

PLOT DATE: 2/5/2016  
DRAWN BY: M. SMITH  
CHECKED BY: S. BEAUMONT  
SHEET 24 OF 49









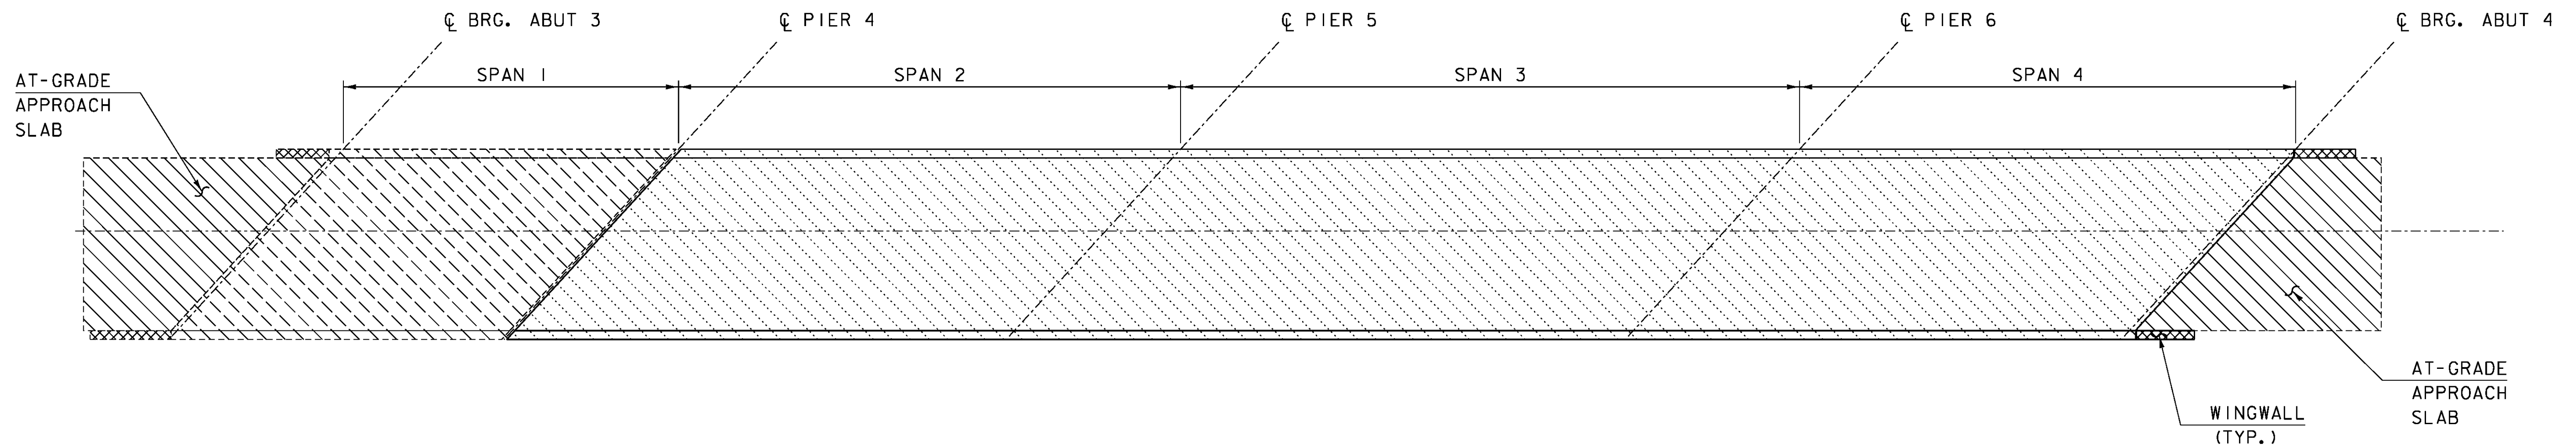

## BITUMINOUS CONCRETE/ CONCRETE REMOVAL



SCALE: 1" = 20'-0"

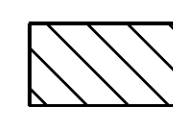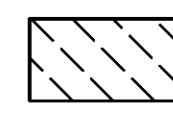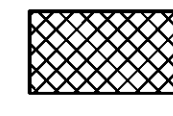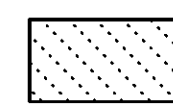-  REMOVE BIT. CONC. PAVEMENT TO TOP OF AT-GRADE APPROACH SLABS (PAID FOR UNDER ITEM 529.10). NO MORE THAN 4" OF PAVEMENT SHALL BE REMOVED. SEE PROJECT NOTE 30 ON SHEET 3. REMOVE BARRIER MEMBRANE (PAID FOR UNDER ITEM 580.16), IF APPLICABLE. SEE PROJECT NOTE 32 ON SHEET 3.
-  REMOVE BIT. CONC. PAVEMENT TO TOP OF BRIDGE DECK (PAID FOR UNDER ITEM 529.10) AND REMOVE THE BARRIER MEMBRANE (PAID FOR UNDER ITEM 580.16). REMOVE BRIDGE DECK (PAID FOR UNDER ITEM 529.20), IF APPLICABLE. SEE PROJECT NOTE 30 ON SHEET 3 AND NOTE 1 THIS SHEET.
-  REMOVE BRIDGE RAIL (PAID FOR UNDER ITEM 525.10) AND CONCRETE CURB (PAID FOR UNDER ITEM 529.25).
-  REMOVE BRIDGE DECK (PAID FOR UNDER ITEM 529.20). SEE NOTE 2 THIS SHEET.



### NOTES:

1. PAYMENT UNDER ITEM 529.20, "PARTIAL REMOVAL OF STRUCTURE" FOR THE REMOVAL OF THE BRIDGE DECK FOR SPAN #1 WILL INCLUDE THE CONCRETE DECK AND CURBS AND THE BRIDGE RAILING.
2. PAYMENT UNDER ITEM 529.20, "PARTIAL REMOVAL OF STRUCTURE" FOR THE REMOVAL OF THE BRIDGE DECK FOR SPANS #2 THROUGH #4 WILL INCLUDE THE REMOVAL OF THE CONCRETE DECK AND CURBS, BARRIER MEMBRANE, PAVEMENT, AND BRIDGE RAILING.



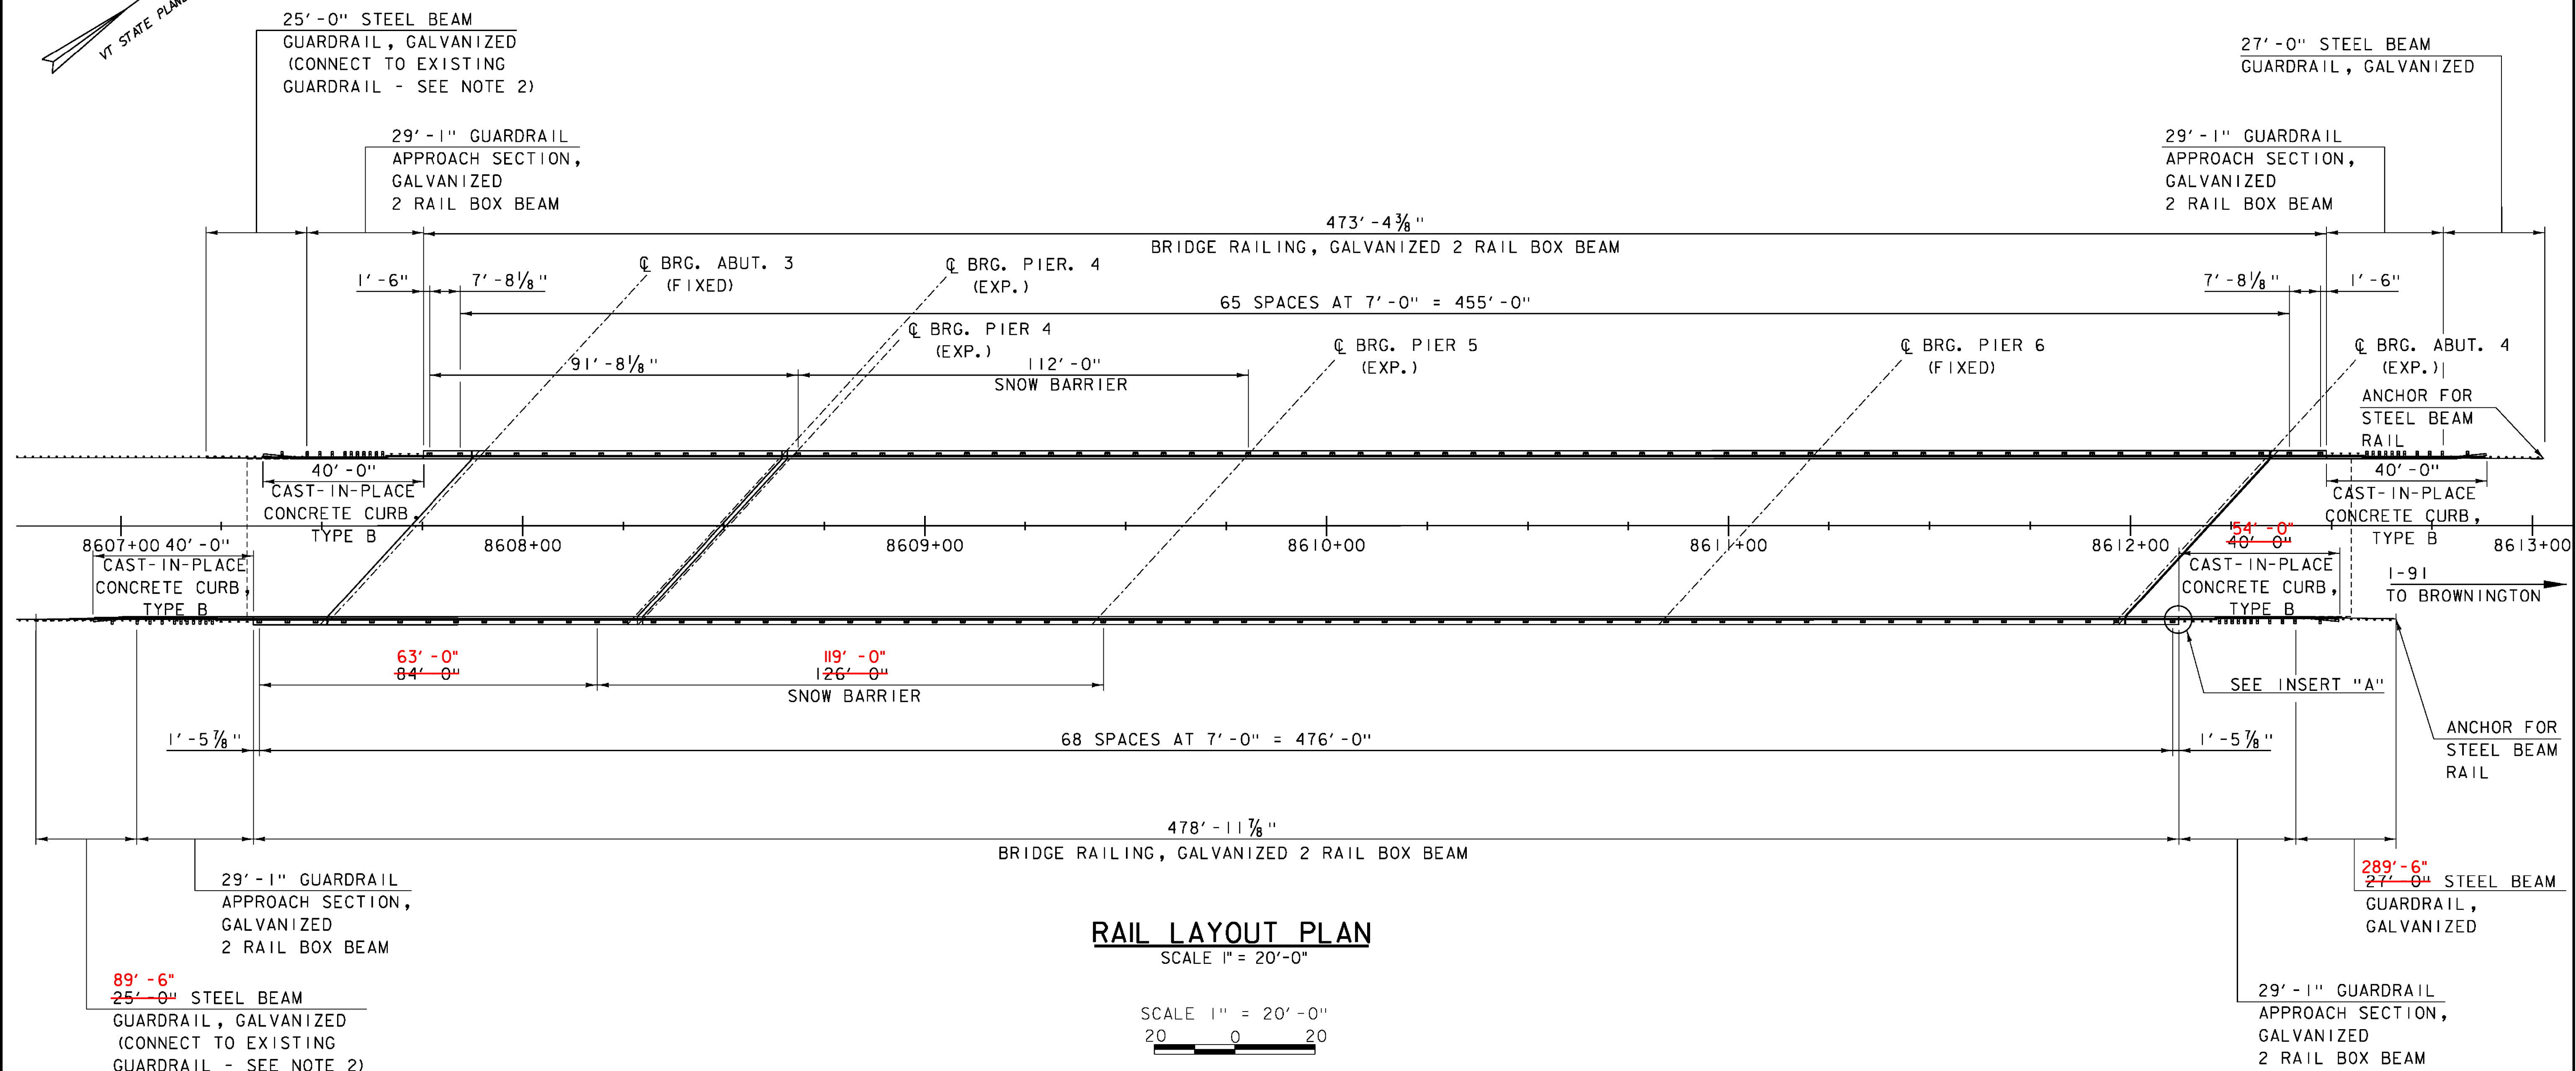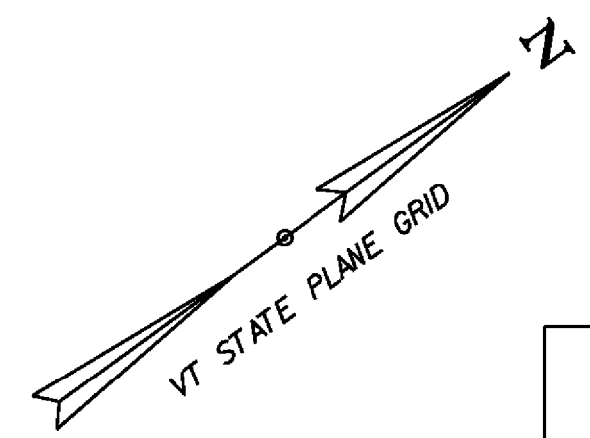

**RAIL LAYOUT PLAN**  
SCALE 1" = 20'-0"

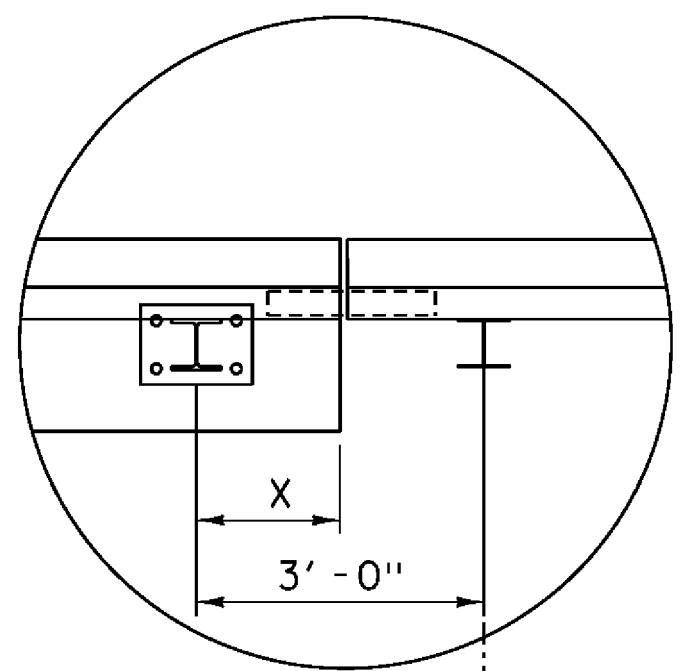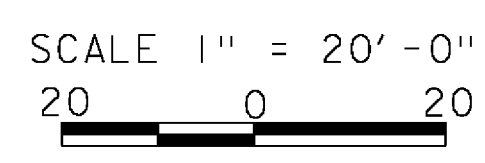

X = 1'-6" NW AND SW CORNERS  
= 1'-5 7/8" NE AND SE CORNERS

**INSERT "A"**  
(NE CORNER SHOWN, OTHERS SIMILAR)  
SCALE: 1/2" = 1'-0"

**NOTES:**

1. REFER TO STANDARDS G-1, G-1d, S-360A, AND S360B.
2. PAYMENT FOR NEW STEEL BEAM GUARDRAIL CONNECTION TO EXISTING RAIL WILL BE CONSIDERED INCIDENTAL TO ITEM 621.20, "STEEL BEAM GUARDRAIL, GALVANIZED".


PROJECT NAME:	IRASBURG
PROJECT NUMBER:	IM DECK(46)
FILE NAME:	z15a16rail_bdr-107N.dgn
PROJECT LEADER:	J. BYATT
DESIGNED BY:	L. GREER
PLOT DATE:	2/5/2016
DRAWN BY:	P. McKECHNIE
CHECKED BY:	S. FORTIER
RAIL LAYOUT SHEET	SHEET 26 OF 49



MODEL: Sheet01  
CLD 15-0223




750-A

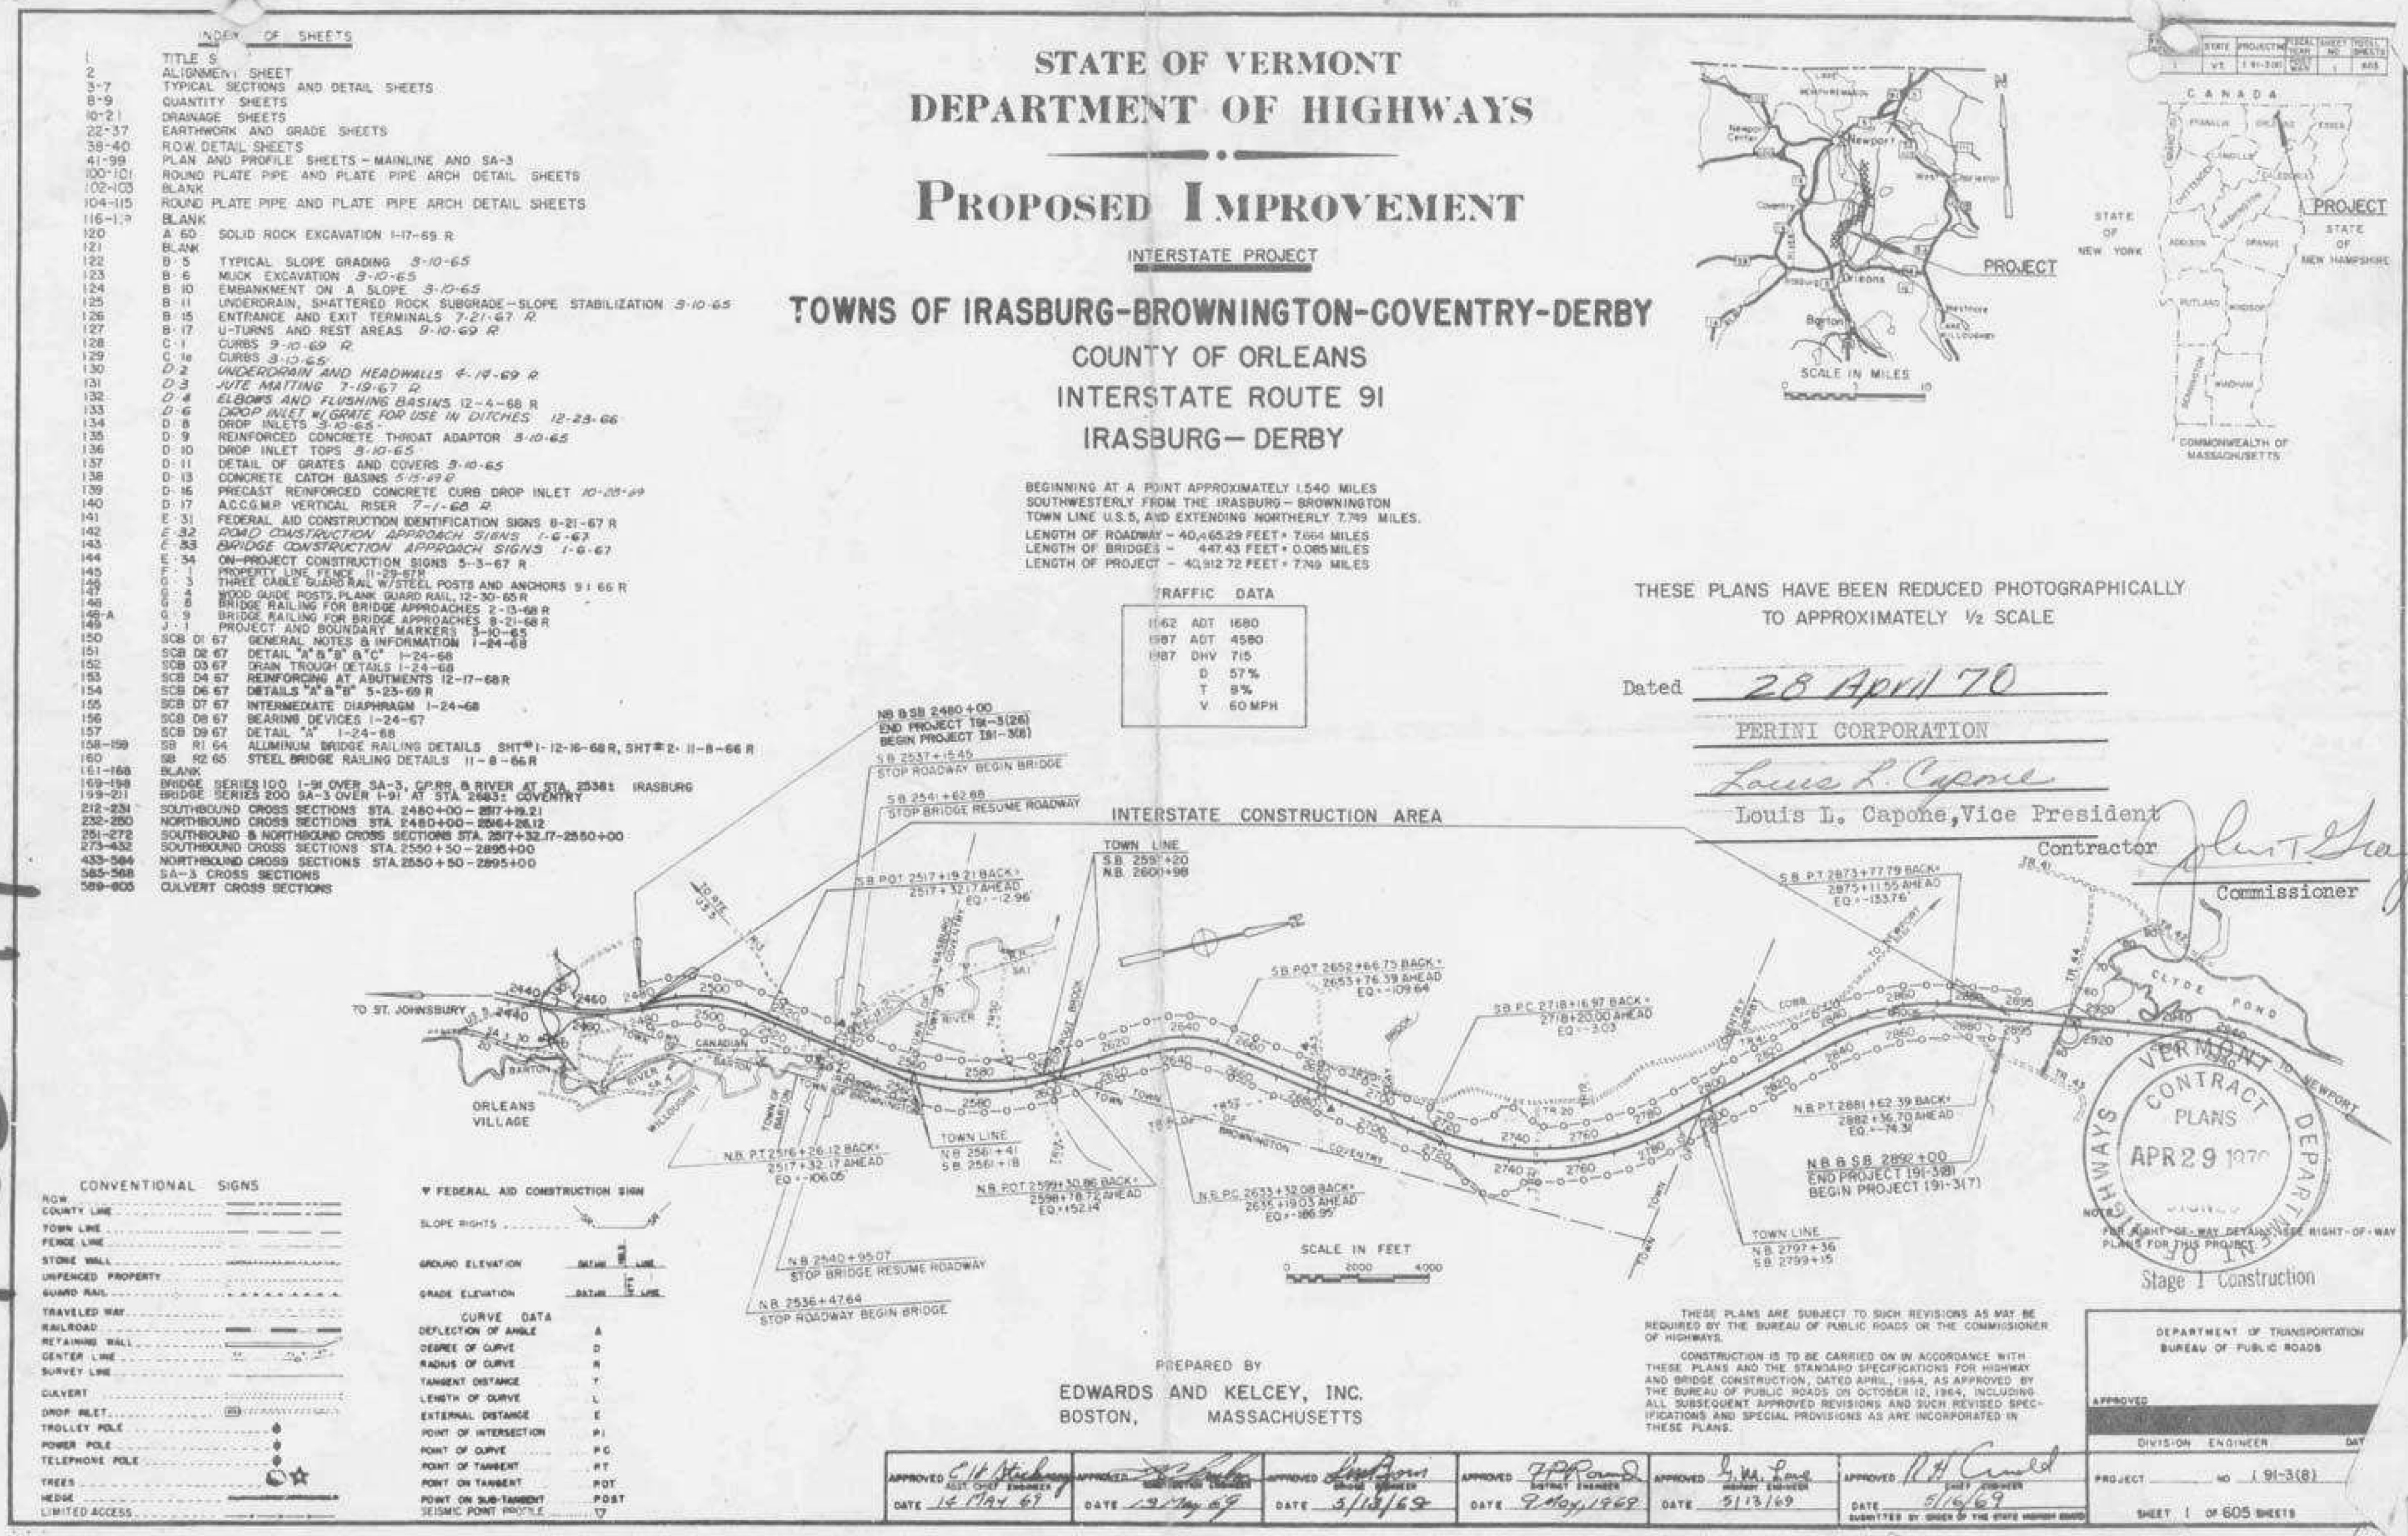

IRASBURG  
IM DECK(46)  
BRIDGE NO. 107N  
SHEET 27 OF 49  
FOR REFERENCE ONLY



PLAN  
 DATE  
 BY  
 CHECKED  
 APPROVED  
 NO. 1  
 NO. 2  
 NO. 3  
 NO. 100

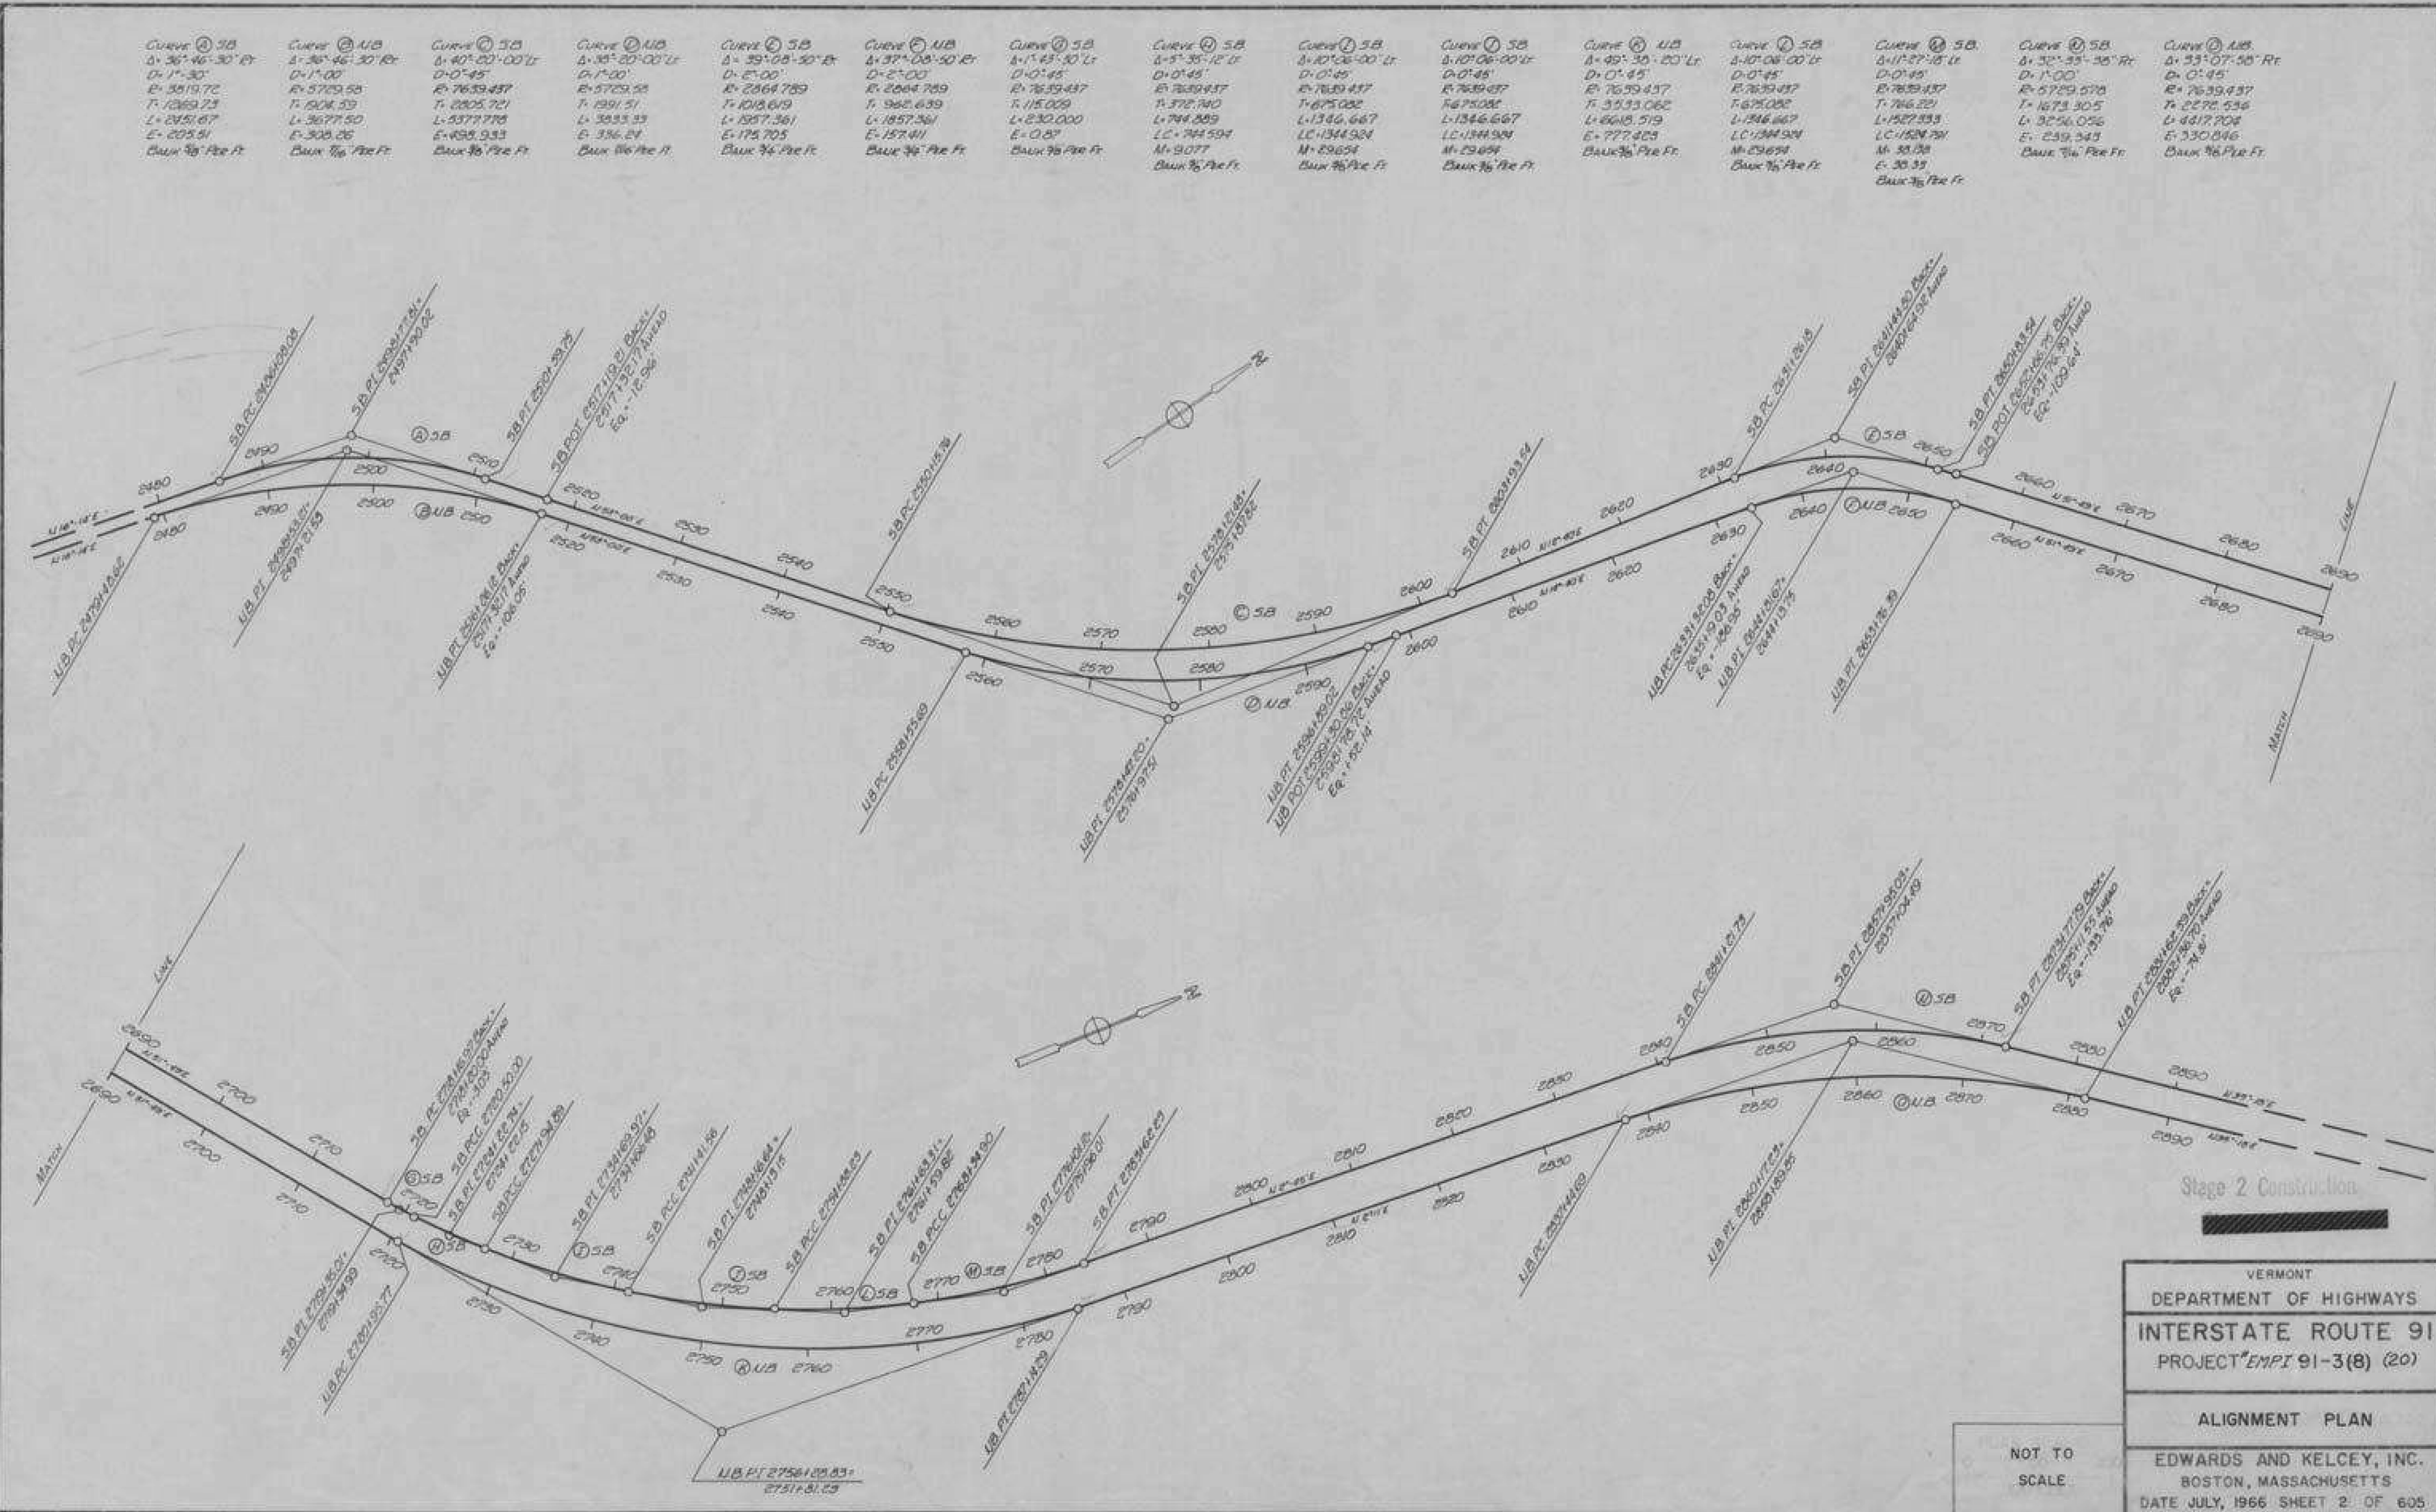


VERMONT  
 DEPARTMENT OF HIGHWAYS  
 INTERSTATE ROUTE 91  
 PROJECT EMT 91-3(8) (20)  
 ALIGNMENT PLAN  
 EDWARDS AND KELCEY, INC.  
 BOSTON, MASSACHUSETTS  
 DATE JULY, 1966 SHEET 2 OF 605  
 NOT TO SCALE

IRASBURG  
 IM DECK(46)  
 BRIDGE NO. 107N  
 SHEET 28 OF 49  
 FOR REFERENCE ONLY








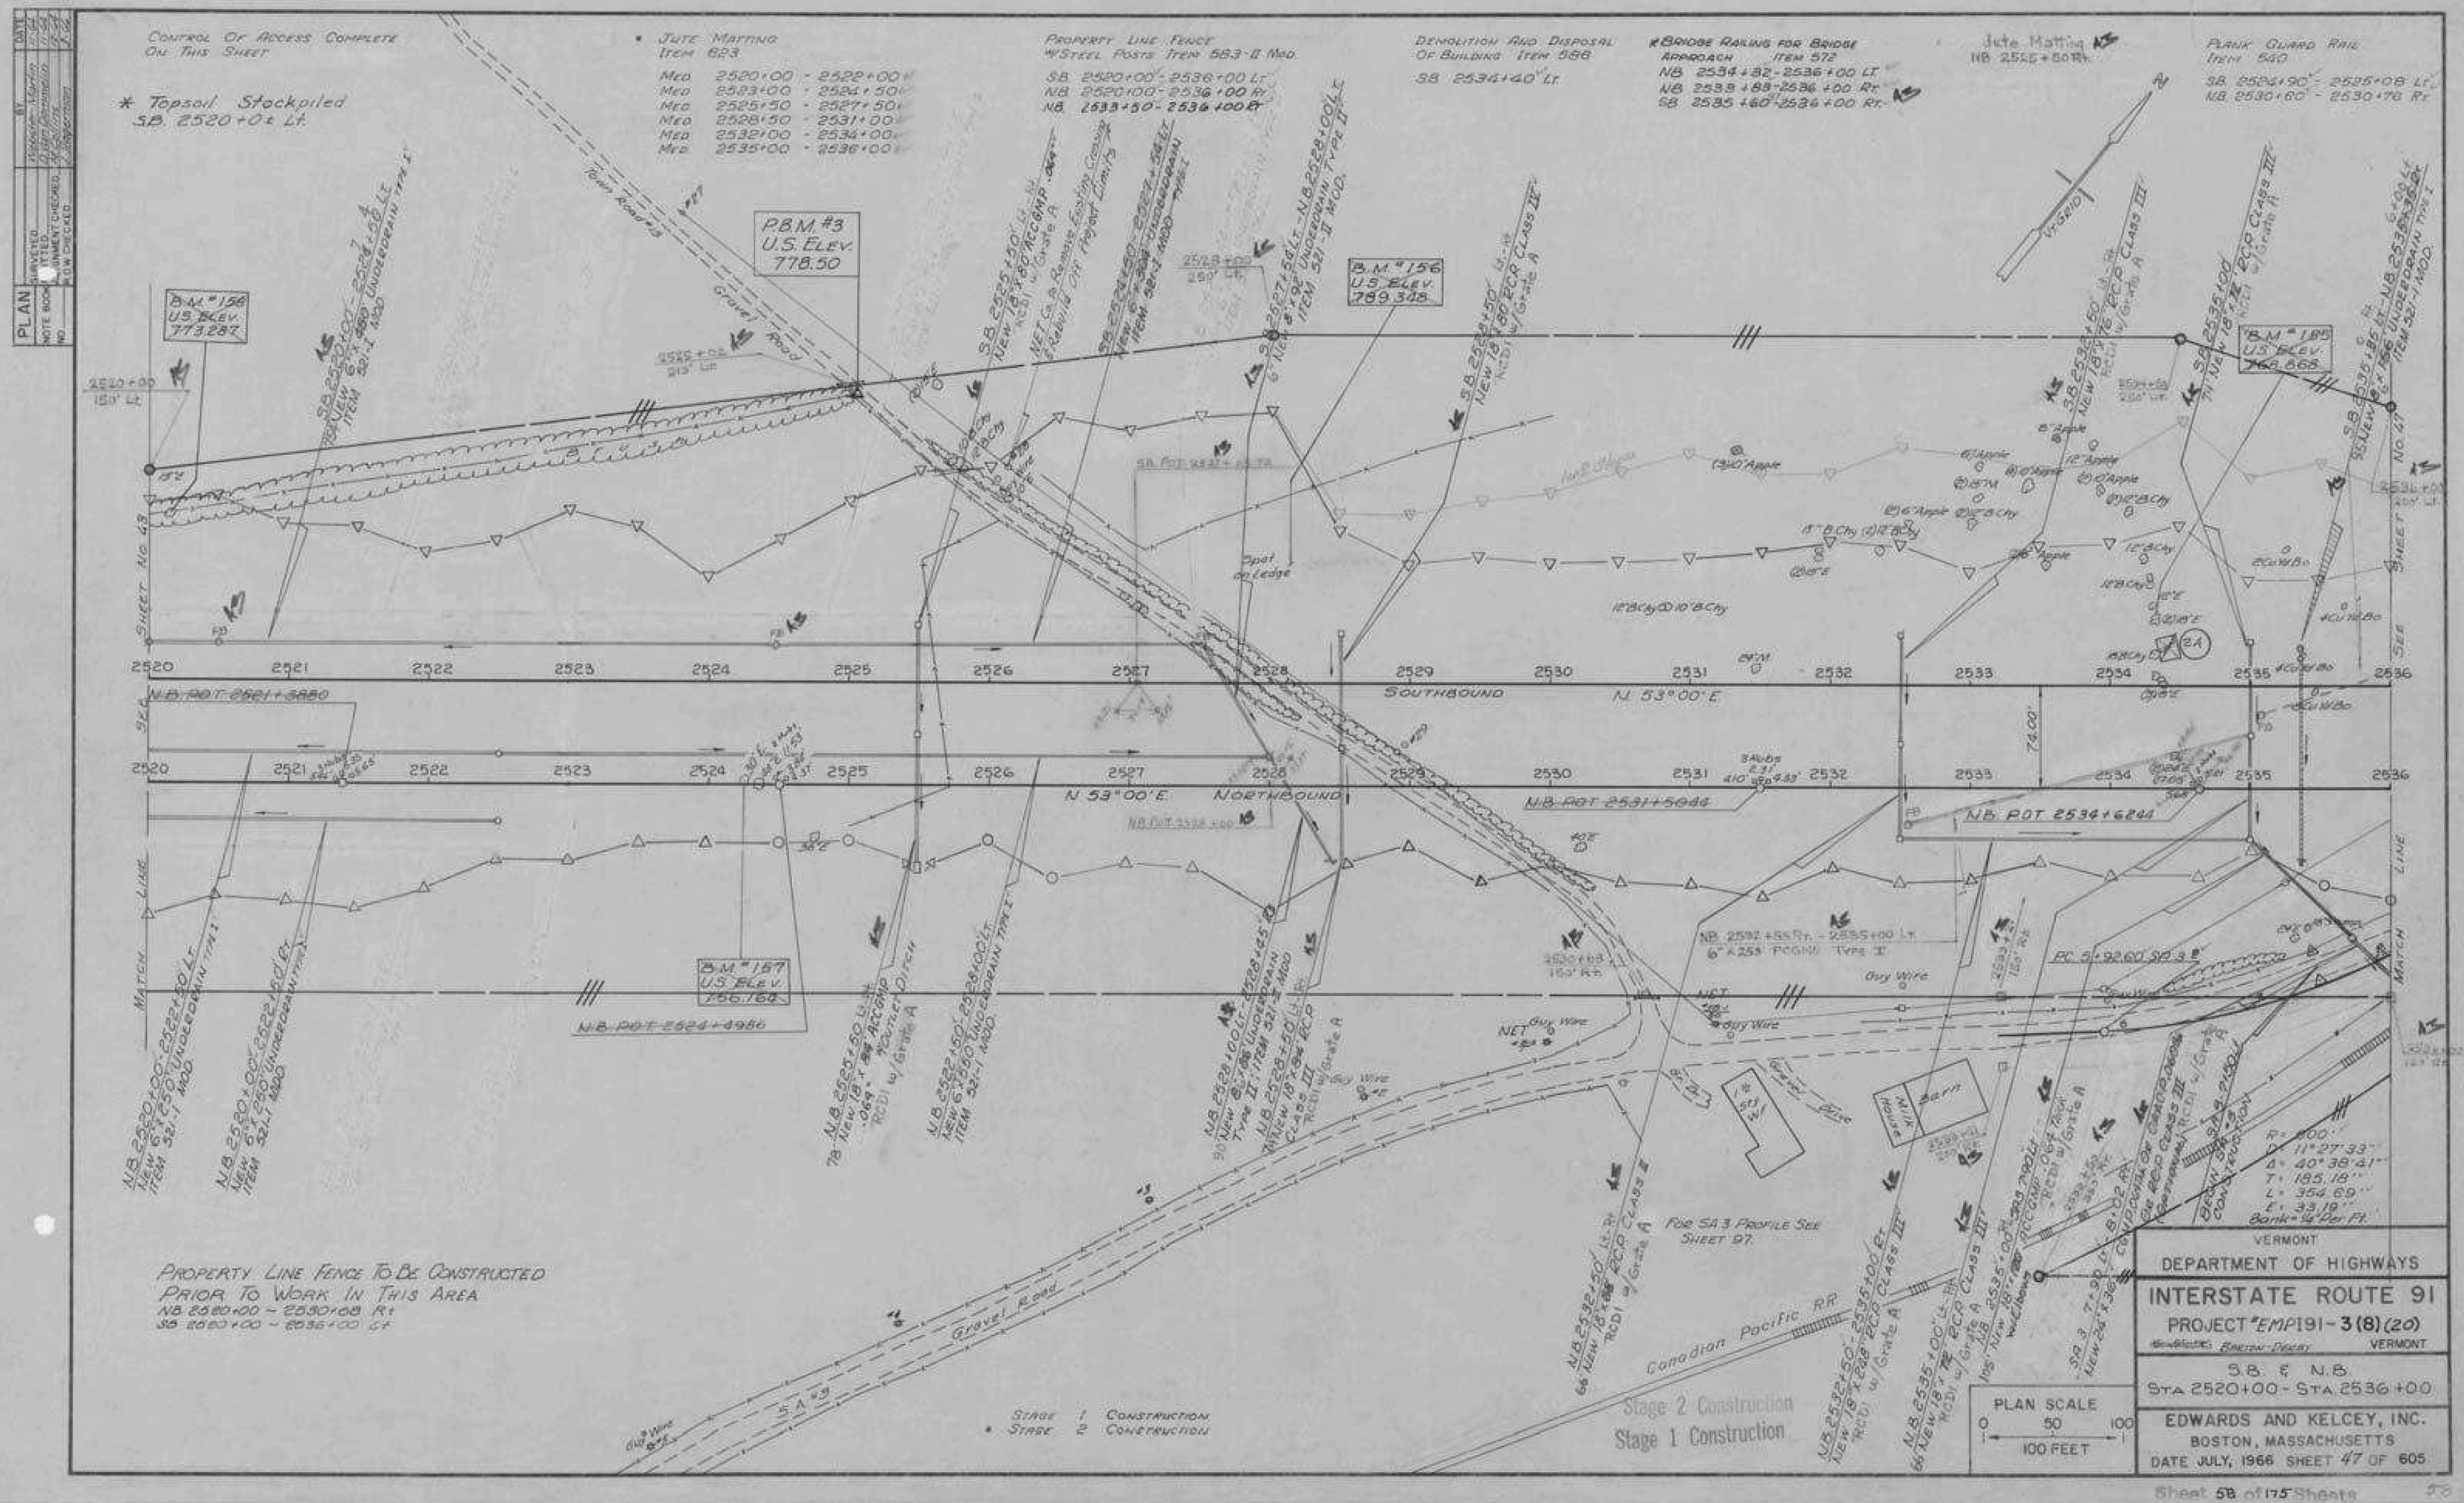


IRASBURG  
 IM DECK(46)  
 BRIDGE NO. 107N  
 SHEET 30 OF 49  
 FOR REFERENCE ONLY



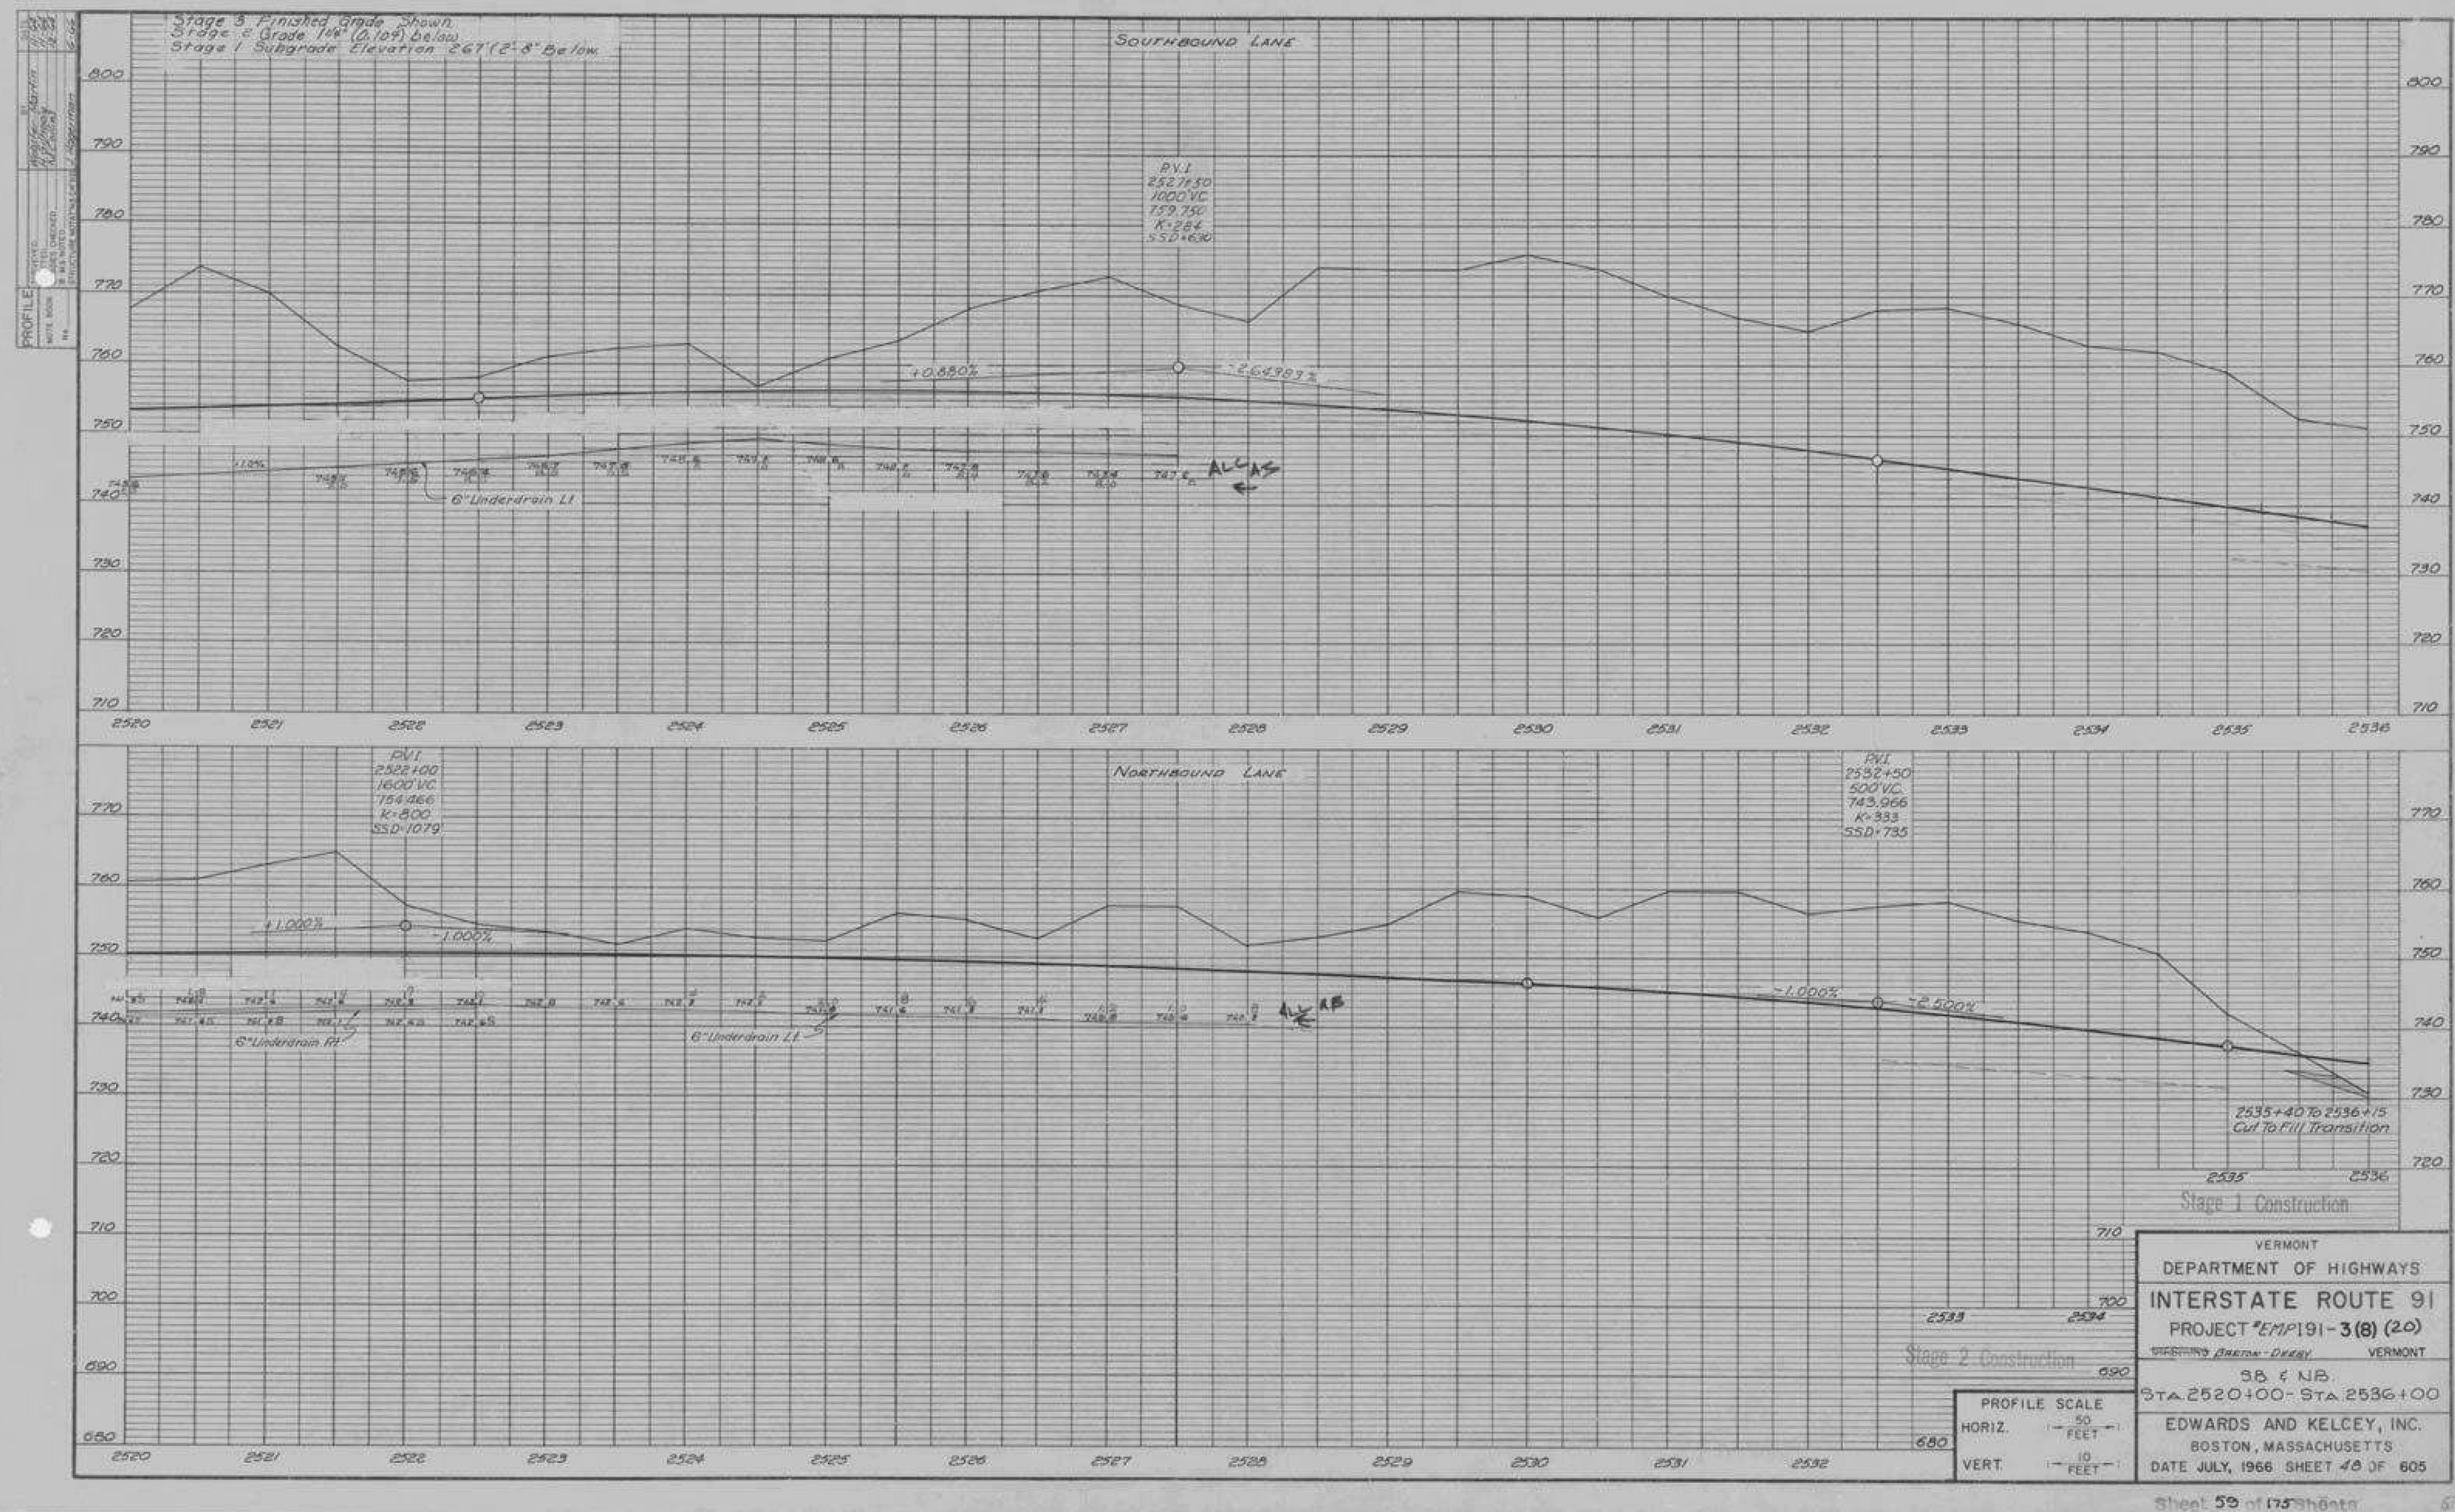


IRASBURG  
IM DECK(46)  
BRIDGE NO. 107N  
SHEET 31 OF 49  
FOR REFERENCE ONLY



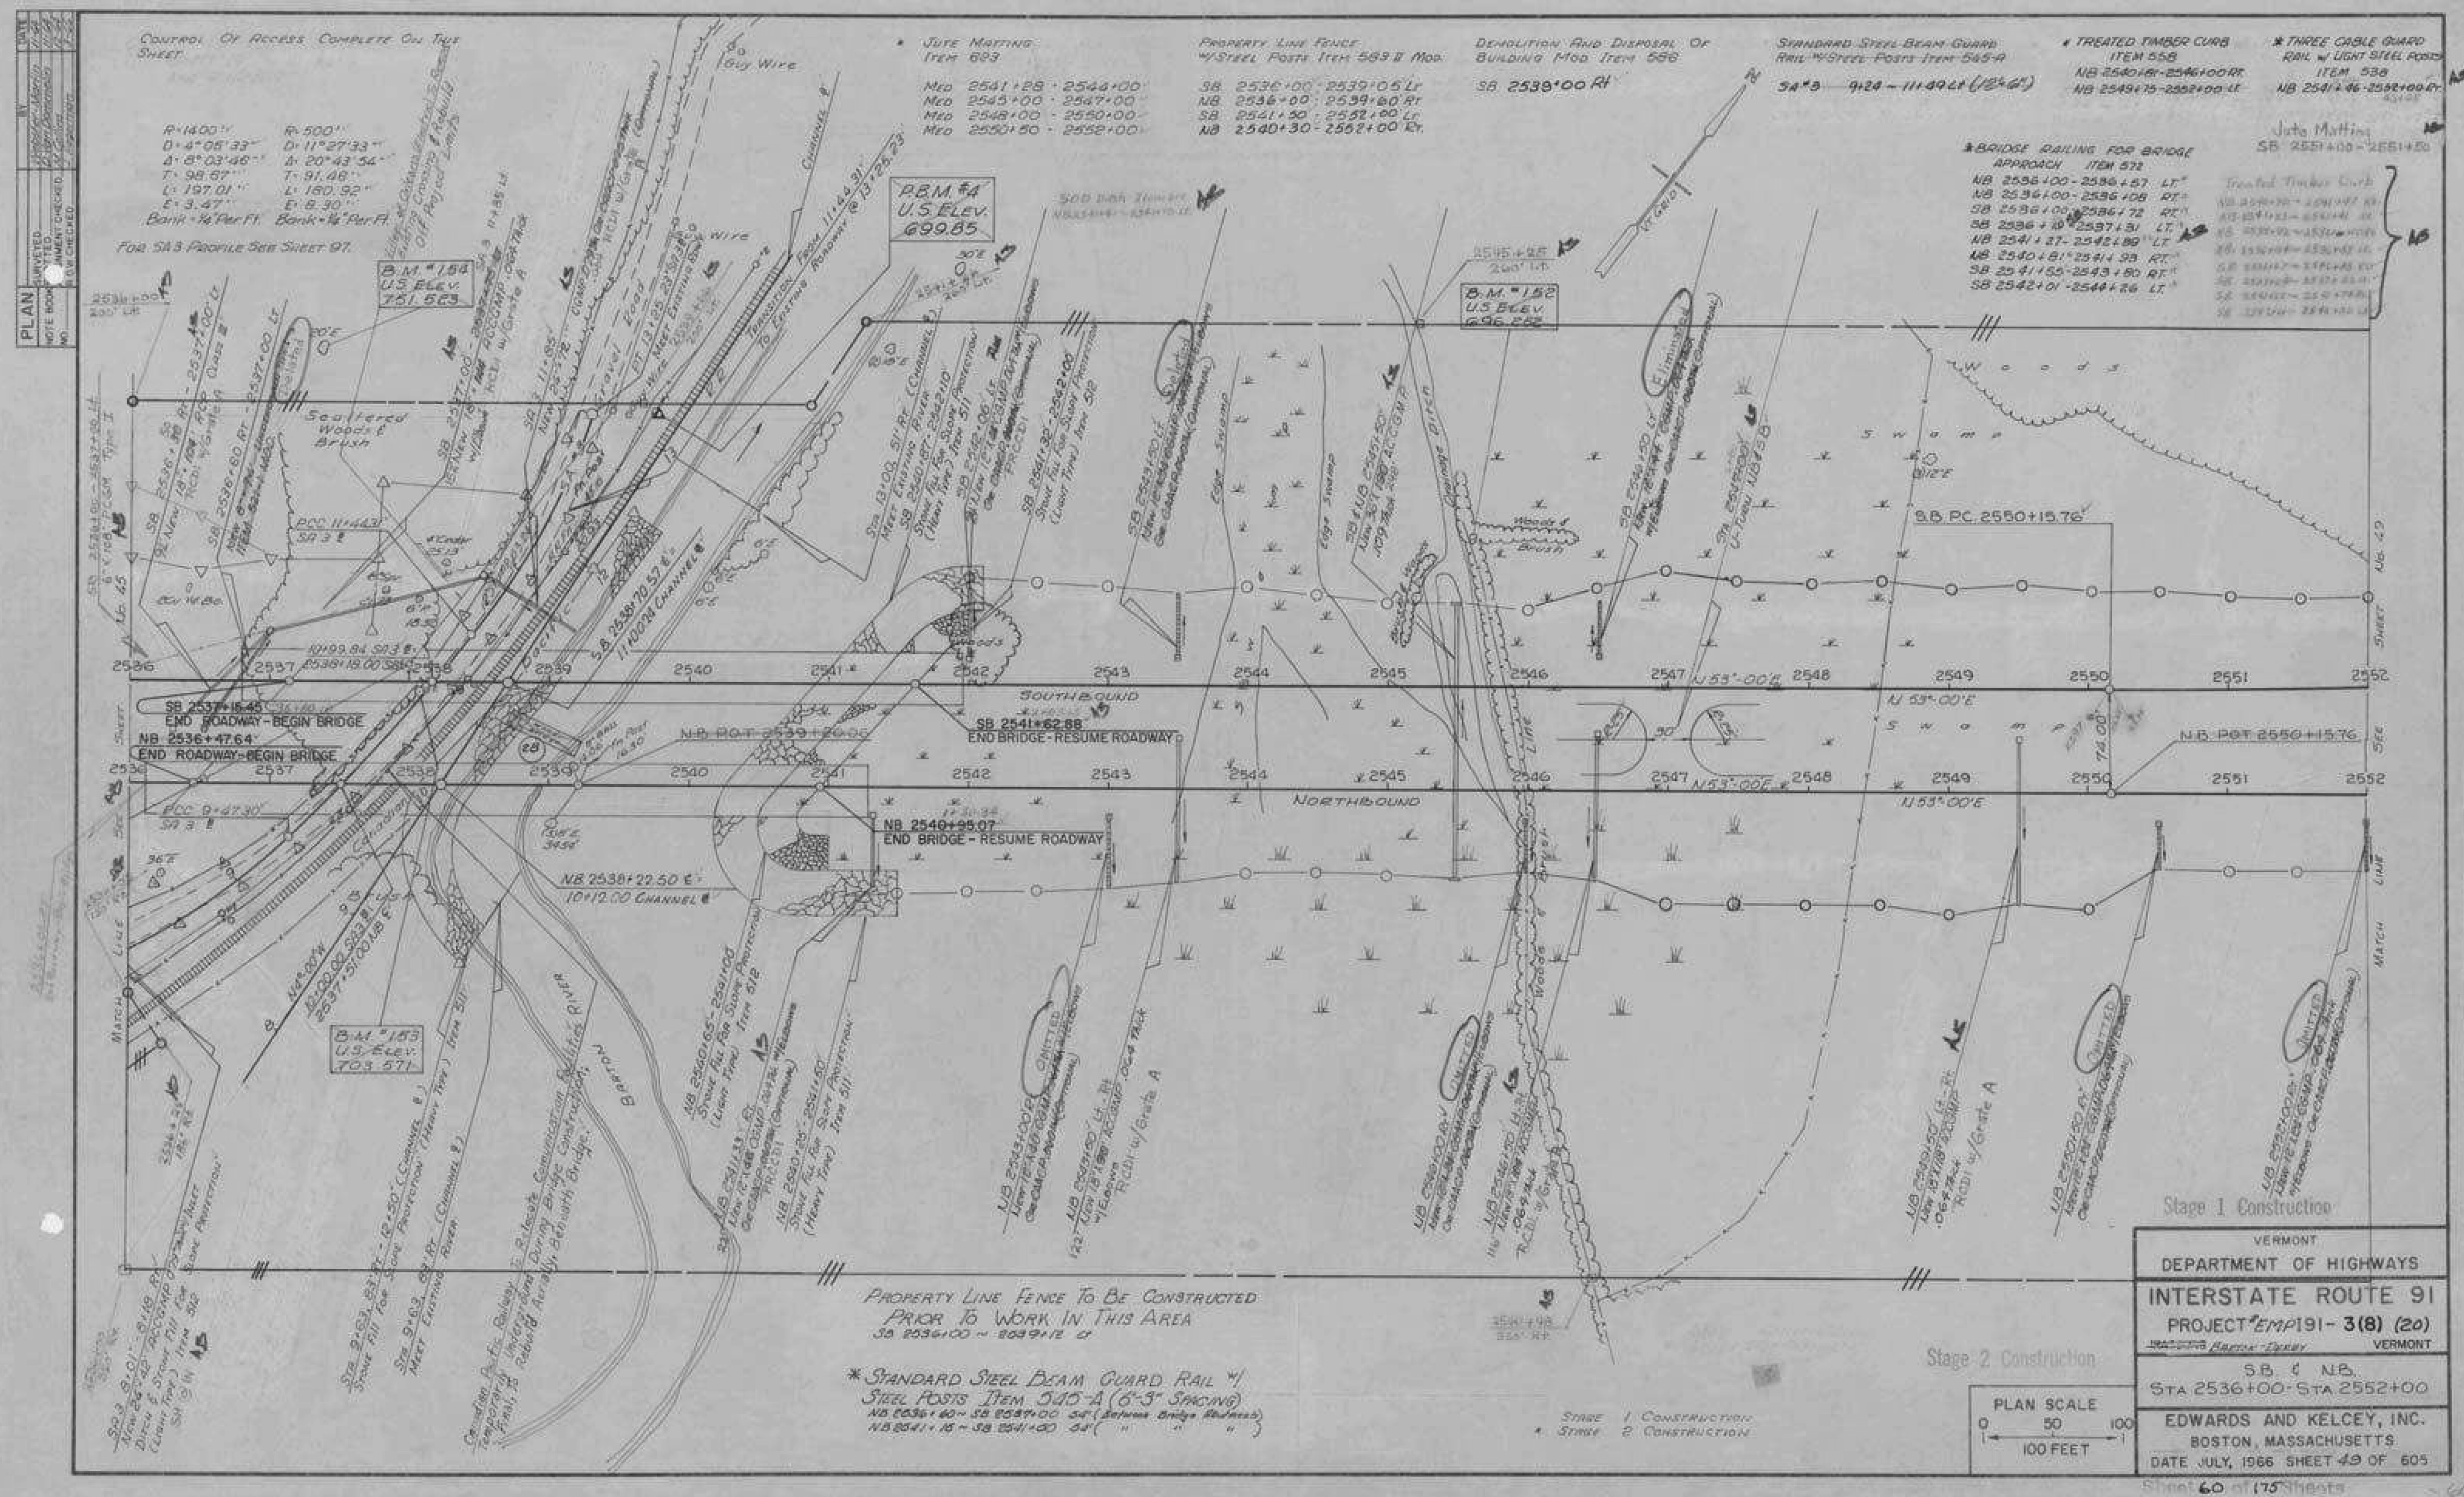


IRASBURG  
IM DECK(46)  
BRIDGE NO. 107N  
SHEET 32 OF 49  
FOR REFERENCE ONLY



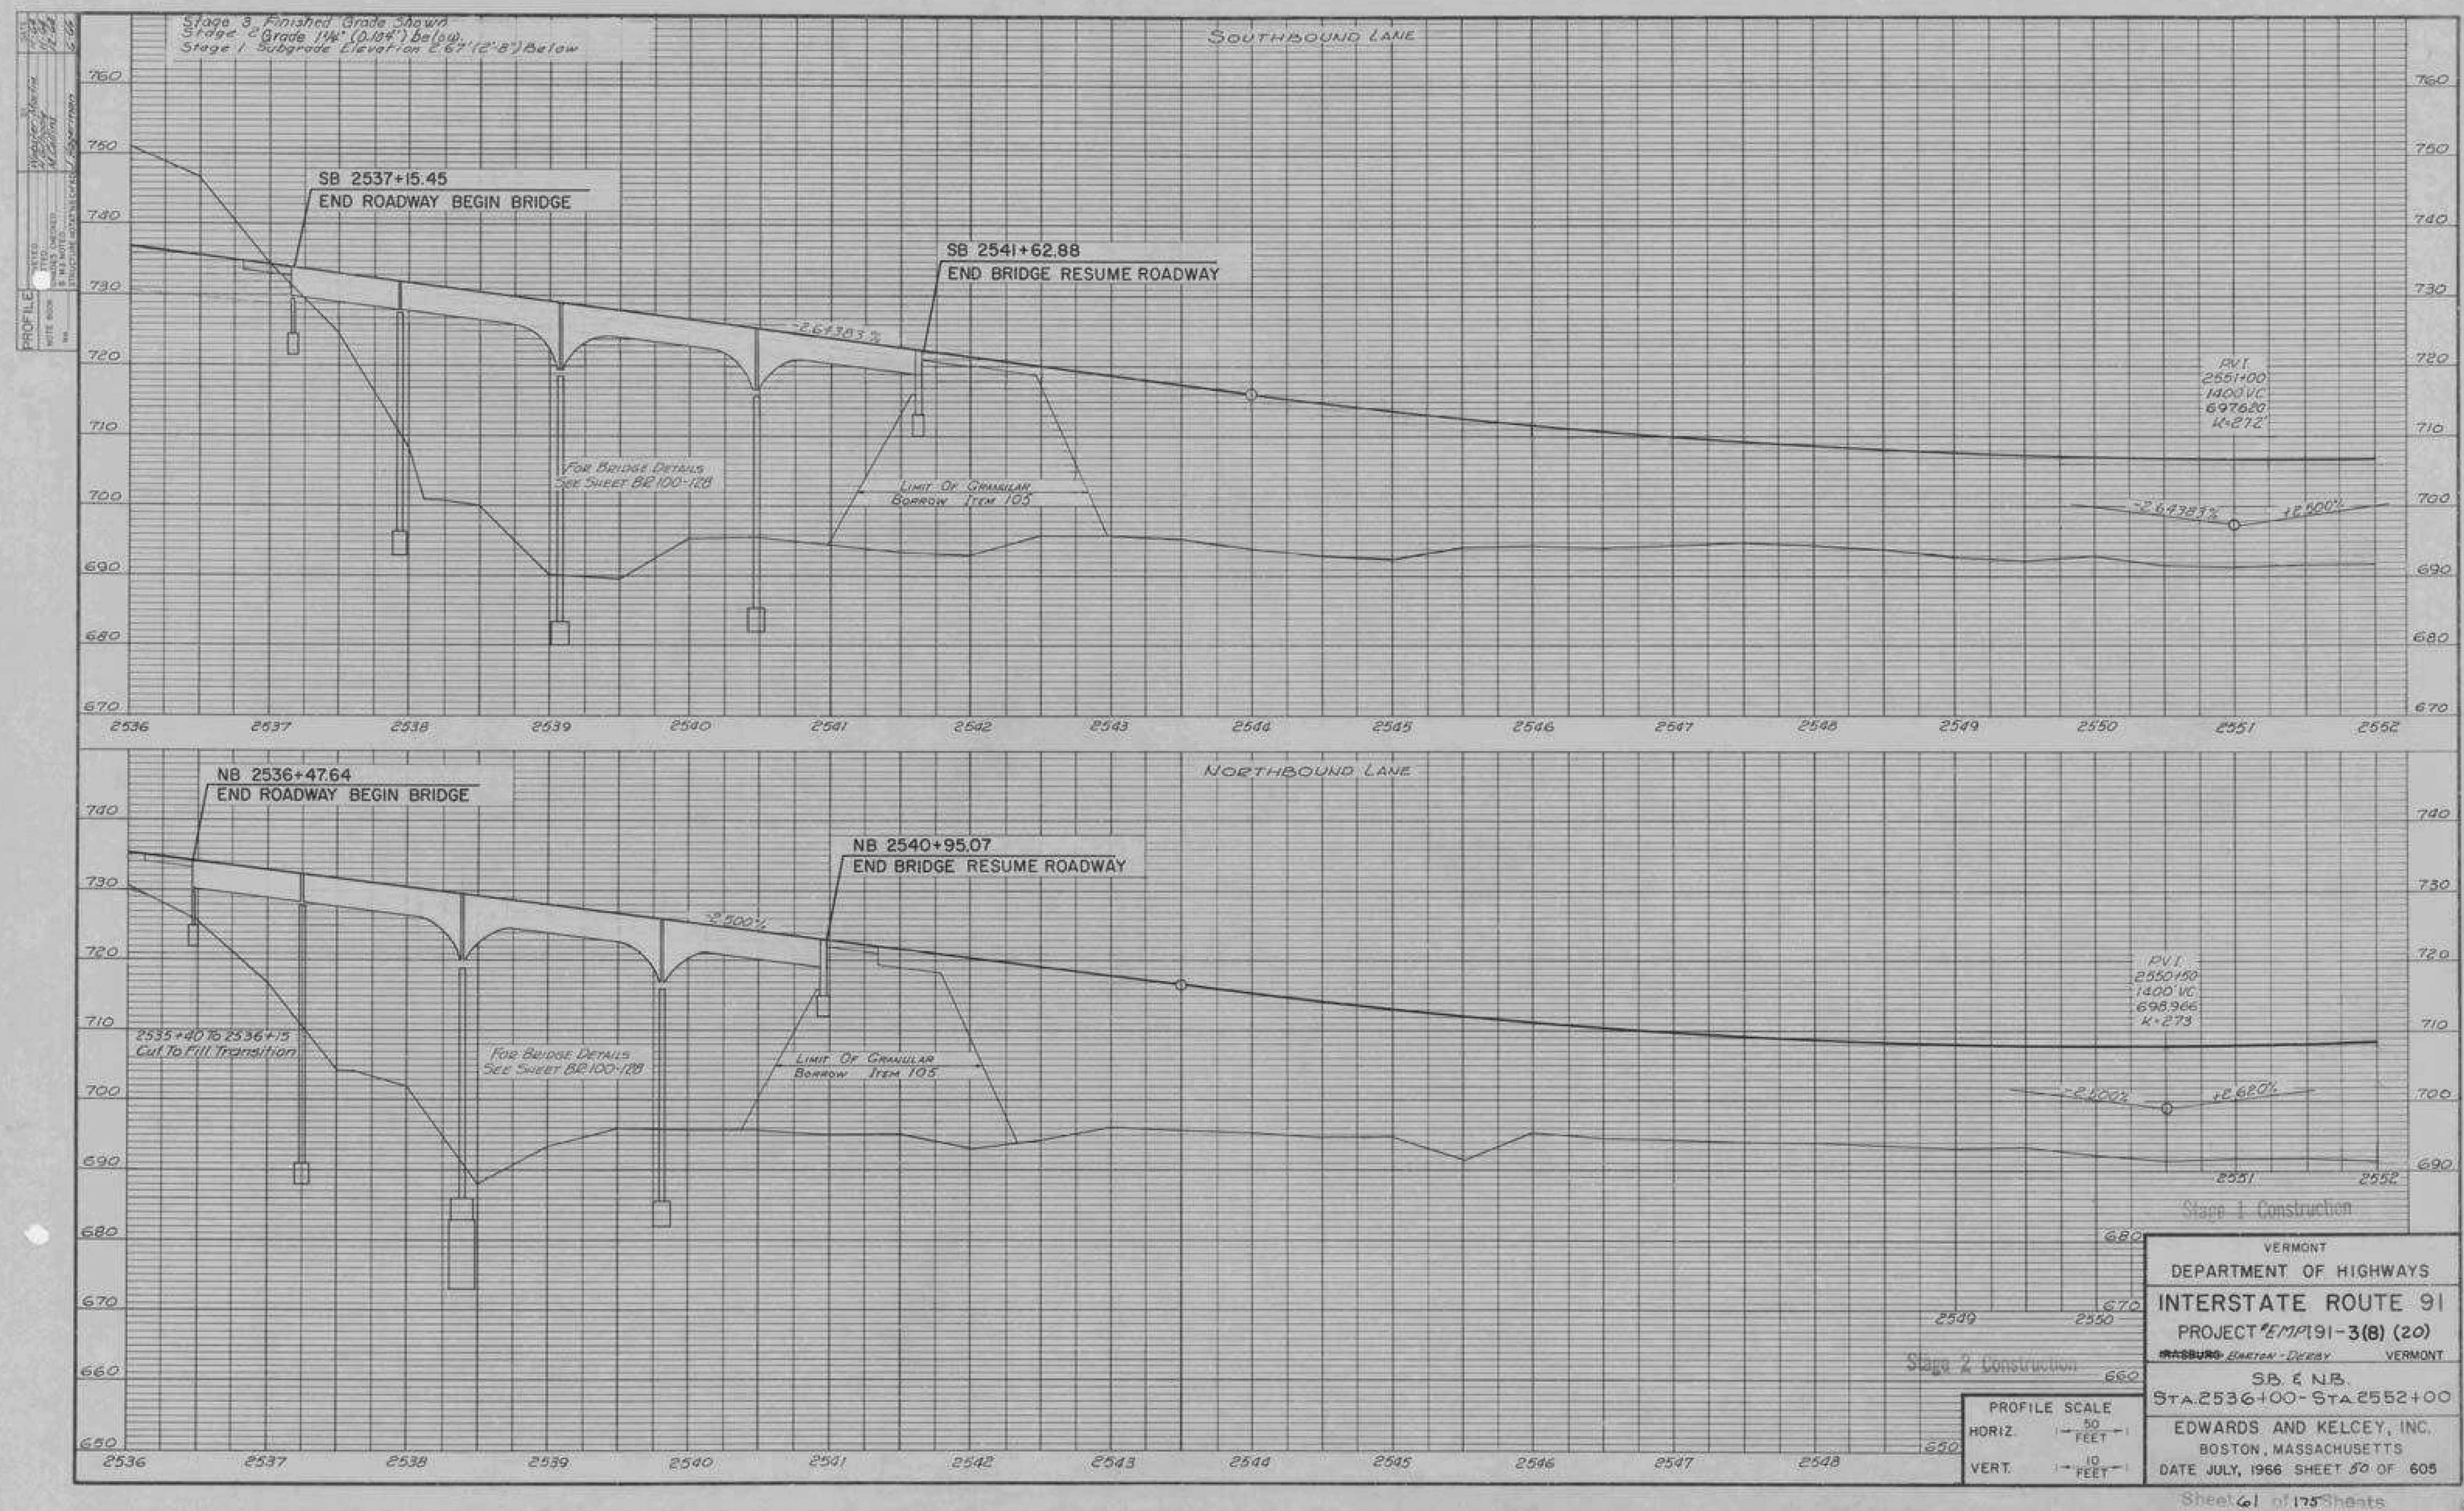


IRASBURG  
IM DECK(46)  
BRIDGE NO. 107N  
SHEET 33 OF 49  
FOR REFERENCE ONLY



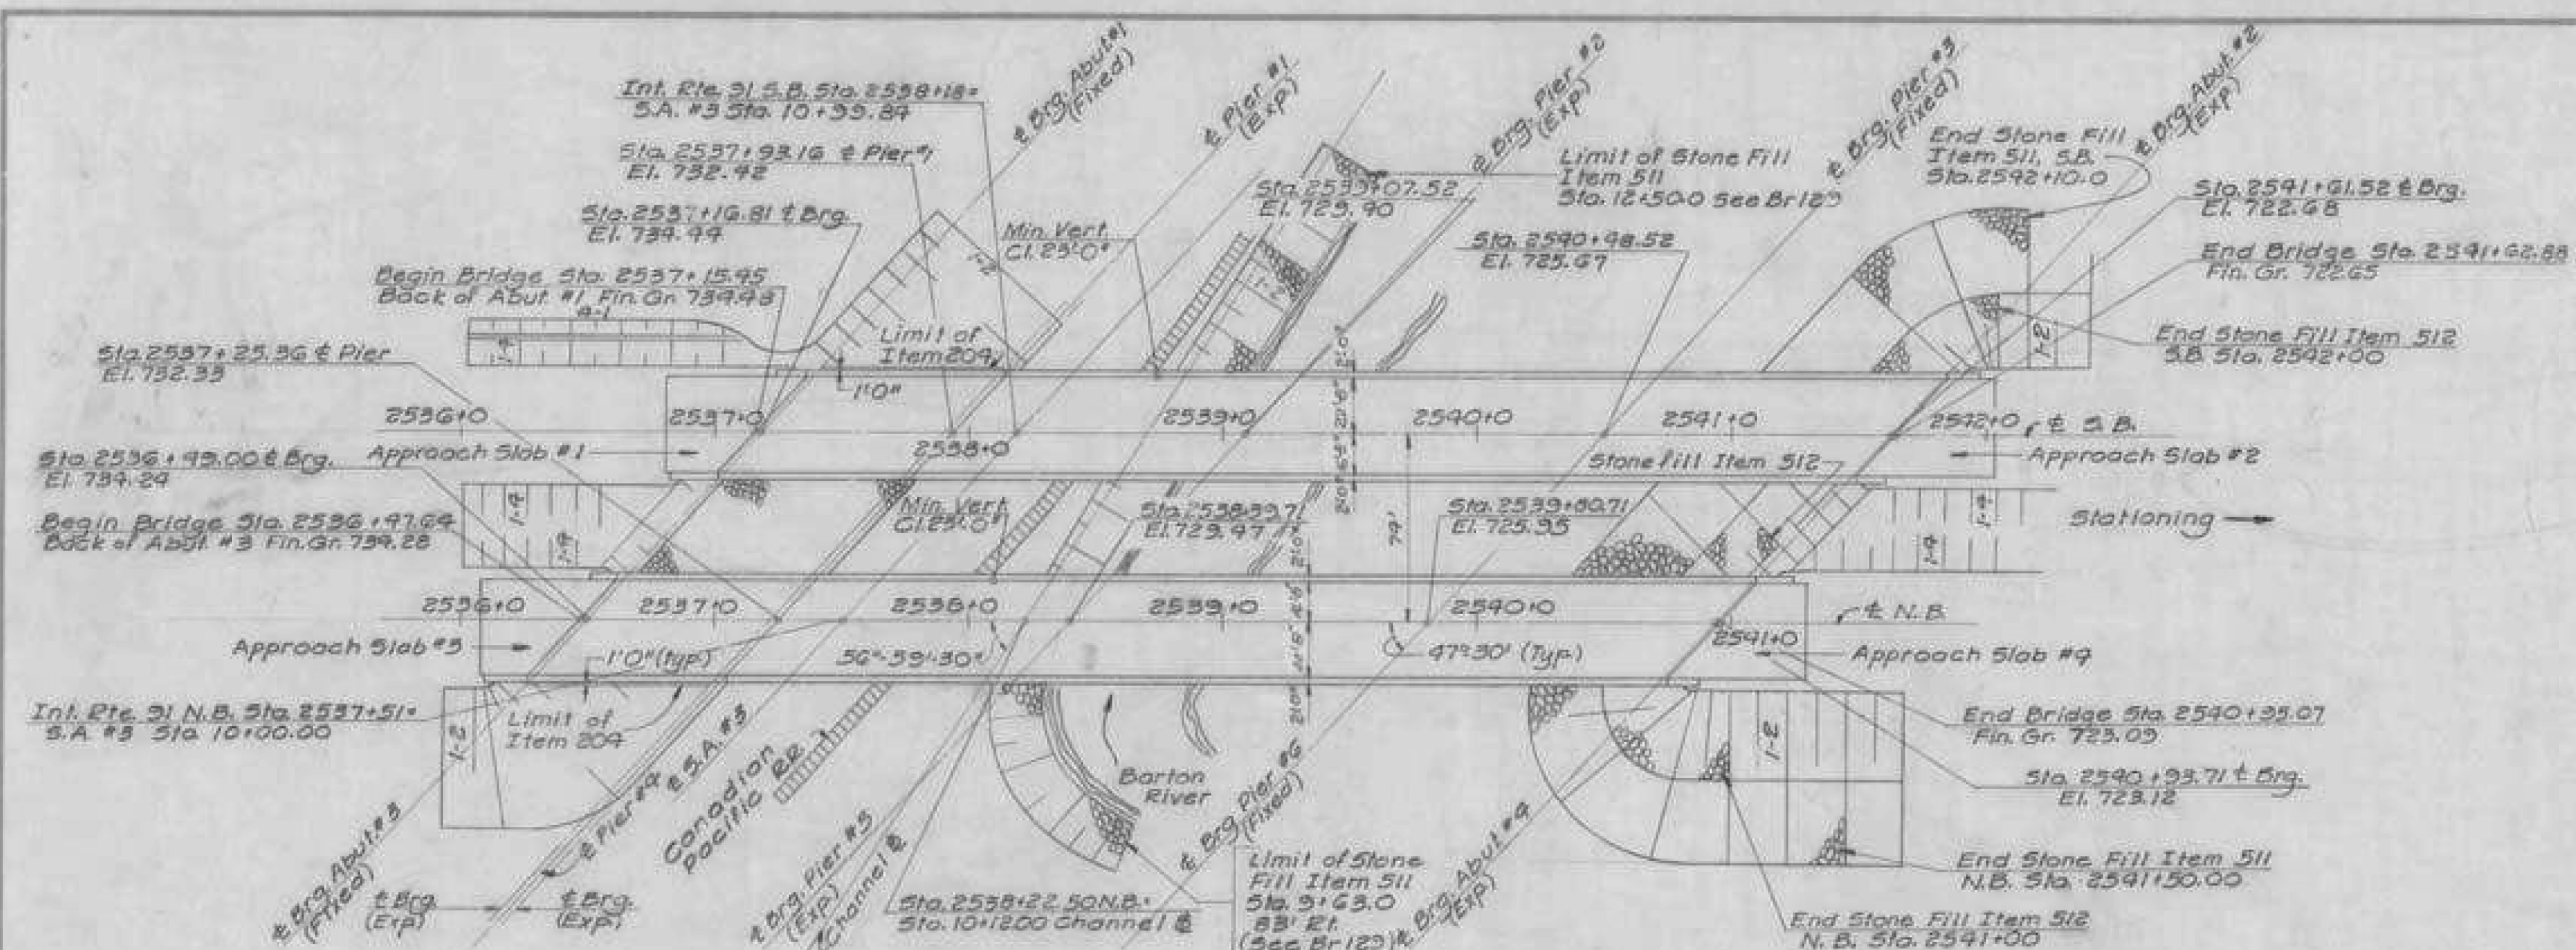

PLAN

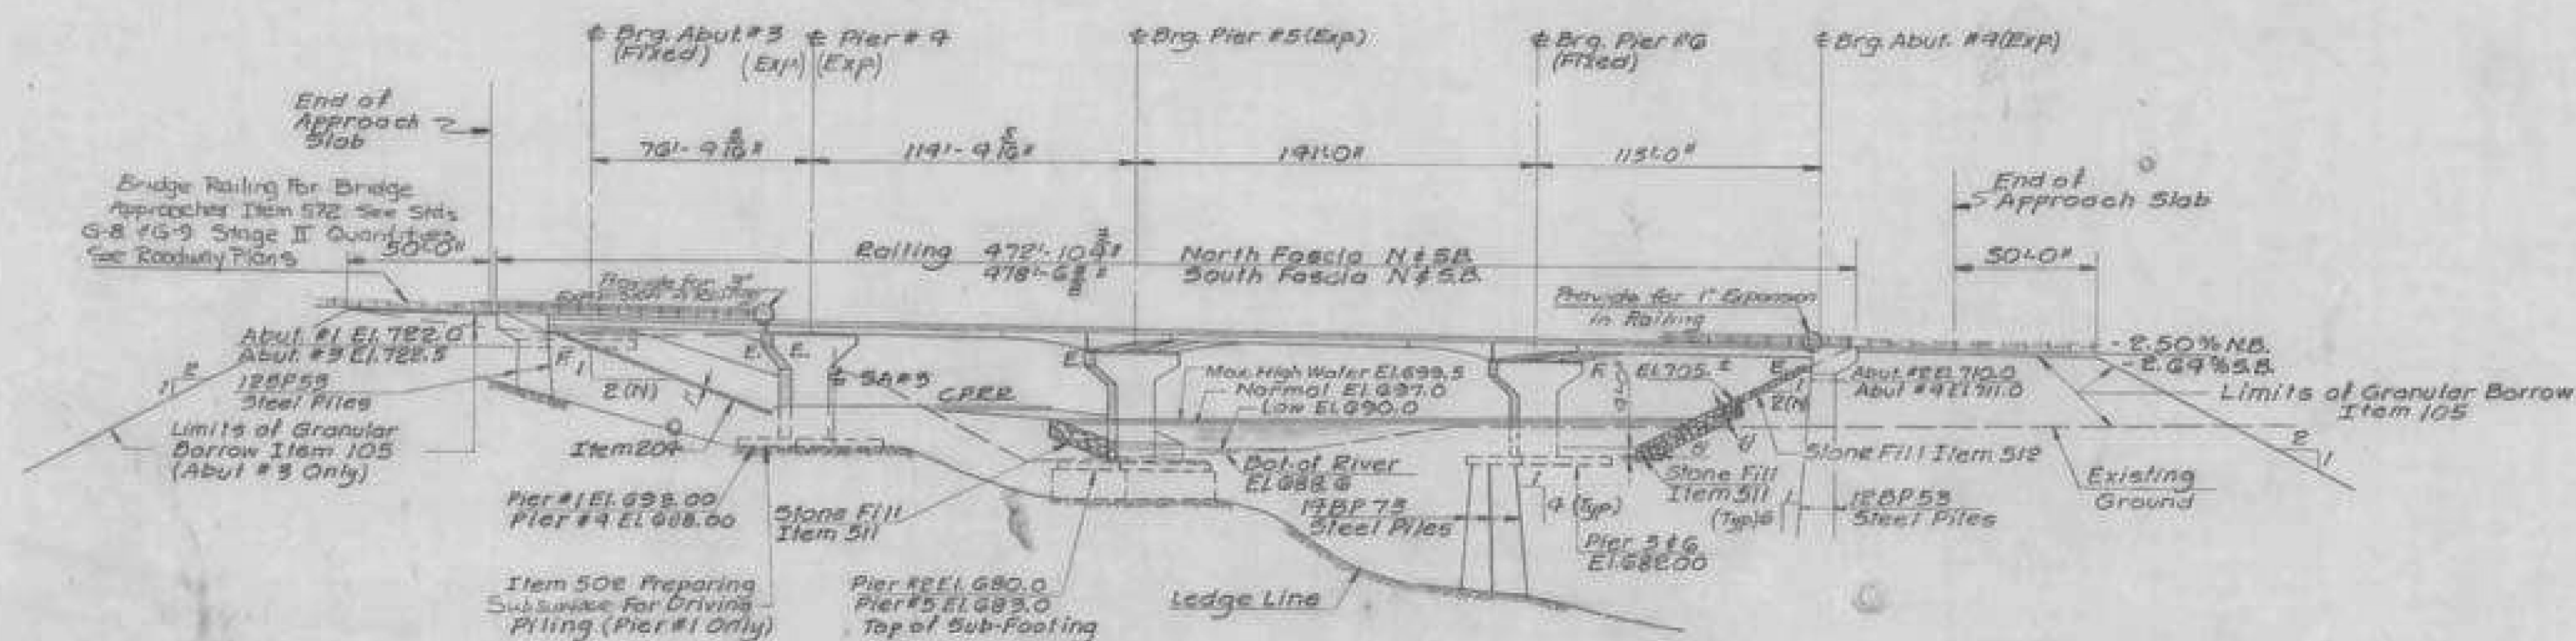

ELEVATION





# LIST OF SHEETS

- Br.100 Plan & Elevation
- Br.101-102 Bridge Quantity Sheets
- Br.103 Preliminary Information Sheet
- Br.104-106 Borings Logs
- Br.107 Framing Plan & Girder Details
- Br.108 Girder Elevation & Conn. Details
- Br.109 Deck Section & Splice
- Br.110 Expansion Dam & Scupper Details
- Br.111 Rafter Bearings
- Br.112 Abutment #1
- Br.113 Abutment #2
- Br.114 Abutment #3
- Br.115 Abutment #4
- Br.116 Abutment #2 & #4 Details
- Br.117 Abutment #1 & #3 Approach Slab
- Br.118 Abutment #2 & #4 Approach Slab
- Br.119 Pier #1
- Br.120 Pier #2
- Br.121 Pier #3
- Br.122 Pier #4
- Br.123 Pier #5
- Br.124 Pier #6
- Br.125-128 Reinforcing Schedules
- Br.129 Channel Sections

## STANDARD SHEETS REQUIRED

- SCB D1 67 General Notes & Information Jan 24, '48
- SCB D2 67 Detail A&B'10 Jan 24, '48
- SCB D3 67 Drain Trough Details Jan 24, '48
- SCB D4 67 Reinforcing at Abutments Dec 17, '48
- SCB D5 67 Detail A&B May 23, 1949
- SCB D7 67 Intermediate Diaphragm Jan 24, '48
- SCB D8 67 Bearing Devices Jan 24, '48
- SCB D9 67 Detail A Jan 24, '48
- SB R1 64 Aluminum Railing (12 Sheet) Sheet 1st 2, 2nd 3, 3rd 4, 4th 5, 5th 6, 6th 7, 7th 8, 8th 9, 9th 10, 10th 11, 11th 12, 12th 13, 13th 14, 14th 15, 15th 16, 16th 17, 17th 18, 18th 19, 19th 20, 20th 21, 21st 22, 22nd 23, 23rd 24, 24th 25, 25th 26, 26th 27, 27th 28, 28th 29, 29th 30, 30th 31, 31st 32, 32nd 33, 33rd 34, 34th 35, 35th 36, 36th 37, 37th 38, 38th 39, 39th 40, 40th 41, 41st 42, 42nd 43, 43rd 44, 44th 45, 45th 46, 46th 47, 47th 48, 48th 49, 49th 50, 50th 51, 51st 52, 52nd 53, 53rd 54, 54th 55, 55th 56, 56th 57, 57th 58, 58th 59, 59th 60, 60th 61, 61st 62, 62nd 63, 63rd 64, 64th 65, 65th 66, 66th 67, 67th 68, 68th 69, 69th 70, 70th 71, 71st 72, 72nd 73, 73rd 74, 74th 75, 75th 76, 76th 77, 77th 78, 78th 79, 79th 80, 80th 81, 81st 82, 82nd 83, 83rd 84, 84th 85, 85th 86, 86th 87, 87th 88, 88th 89, 89th 90, 90th 91, 91st 92, 92nd 93, 93rd 94, 94th 95, 95th 96, 96th 97, 97th 98, 98th 99, 99th 100, 100th 101, 101st 102, 102nd 103, 103rd 104, 104th 105, 105th 106, 106th 107, 107th 108, 108th 109, 109th 110, 110th 111, 111st 112, 112nd 113, 113rd 114, 114th 115, 115th 116, 116th 117, 117th 118, 118th 119, 119th 120, 120th 121, 121st 122, 122nd 123, 123rd 124, 124th 125, 125th 126, 126th 127, 127th 128, 128th 129, 129th 130, 130th 131, 131st 132, 132nd 133, 133rd 134, 134th 135, 135th 136, 136th 137, 137th 138, 138th 139, 139th 140, 140th 141, 141st 142, 142nd 143, 143rd 144, 144th 145, 145th 146, 146th 147, 147th 148, 148th 149, 149th 150, 150th 151, 151st 152, 152nd 153, 153rd 154, 154th 155, 155th 156, 156th 157, 157th 158, 158th 159, 159th 160, 160th 161, 161st 162, 162nd 163, 163rd 164, 164th 165, 165th 166, 166th 167, 167th 168, 168th 169, 169th 170, 170th 171, 171st 172, 172nd 173, 173rd 174, 174th 175, 175th 176, 176th 177, 177th 178, 178th 179, 179th 180, 180th 181, 181st 182, 182nd 183, 183rd 184, 184th 185, 185th 186, 186th 187, 187th 188, 188th 189, 189th 190, 190th 191, 191st 192, 192nd 193, 193rd 194, 194th 195, 195th 196, 196th 197, 197th 198, 198th 199, 199th 200, 200th 201, 201st 202, 202nd 203, 203rd 204, 204th 205, 205th 206, 206th 207, 207th 208, 208th 209, 209th 210, 210th 211, 211st 212, 212nd 213, 213rd 214, 214th 215, 215th 216, 216th 217, 217th 218, 218th 219, 219th 220, 220th 221, 221st 222, 222nd 223, 223rd 224, 224th 225, 225th 226, 226th 227, 227th 228, 228th 229, 229th 230, 230th 231, 231st 232, 232nd 233, 233rd 234, 234th 235, 235th 236, 236th 237, 237th 238, 238th 239, 239th 240, 240th 241, 241st 242, 242nd 243, 243rd 244, 244th 245, 245th 246, 246th 247, 247th 248, 248th 249, 249th 250, 250th 251, 251st 252, 252nd 253, 253rd 254, 254th 255, 255th 256, 256th 257, 257th 258, 258th 259, 259th 260, 260th 261, 261st 262, 262nd 263, 263rd 264, 264th 265, 265th 266, 266th 267, 267th 268, 268th 269, 269th 270, 270th 271, 271st 272, 272nd 273, 273rd 274, 274th 275, 275th 276, 276th 277, 277th 278, 278th 279, 279th 280, 280th 281, 281st 282, 282nd 283, 283rd 284, 284th 285, 285th 286, 286th 287, 287th 288, 288th 289, 289th 290, 290th 291, 291st 292, 292nd 293, 293rd 294, 294th 295, 295th 296, 296th 297, 297th 298, 298th 299, 299th 300, 300th 301, 301st 302, 302nd 303, 303rd 304, 304th 305, 305th 306, 306th 307, 307th 308, 308th 309, 309th 310, 310th 311, 311st 312, 312nd 313, 313rd 314, 314th 315, 315th 316, 316th 317, 317th 318, 318th 319, 319th 320, 320th 321, 321st 322, 322nd 323, 323rd 324, 324th 325, 325th 326, 326th 327, 327th 328, 328th 329, 329th 330, 330th 331, 331st 332, 332nd 333, 333rd 334, 334th 335, 335th 336, 336th 337, 337th 338, 338th 339, 339th 340, 340th 341, 341st 342, 342nd 343, 343rd 344, 344th 345, 345th 346, 346th 347, 347th 348, 348th 349, 349th 350, 350th 351, 351st 352, 352nd 353, 353rd 354, 354th 355, 355th 356, 356th 357, 357th 358, 358th 359, 359th 360, 360th 361, 361st 362, 362nd 363, 363rd 364, 364th 365, 365th 366, 366th 367, 367th 368, 368th 369, 369th 370, 370th 371, 371st 372, 372nd 373, 373rd 374, 374th 375, 375th 376, 376th 377, 377th 378, 378th 379, 379th 380, 380th 381, 381st 382, 382nd 383, 383rd 384, 384th 385, 385th 386, 386th 387, 387th 388, 388th 389, 389th 390, 390th 391, 391st 392, 392nd 393, 393rd 394, 394th 395, 395th 396, 396th 397, 397th 398, 398th 399, 399th 400, 400th 401, 401st 402, 402nd 403, 403rd 404, 404th 405, 405th 406, 406th 407, 407th 408, 408th 409, 409th 410, 410th 411, 411st 412, 412nd 413, 413rd 414, 414th 415, 415th 416, 416th 417, 417th 418, 418th 419, 419th 420, 420th 421, 421st 422, 422nd 423, 423rd 424, 424th 425, 425th 426, 426th 427, 427th 428, 428th 429, 429th 430, 430th 431, 431st 432, 432nd 433, 433rd 434, 434th 435, 435th 436, 436th 437, 437th 438, 438th 439, 439th 440, 440th 441, 441st 442, 442nd 443, 443rd 444, 444th 445, 445th 446, 446th 447, 447th 448, 448th 449, 449th 450, 450th 451, 451st 452, 452nd 453, 453rd 454, 454th 455, 455th 456, 456th 457, 457th 458, 458th 459, 459th 460, 460th 461, 461st 462, 462nd 463, 463rd 464, 464th 465, 465th 466, 466th 467, 467th 468, 468th 469, 469th 470, 470th 471, 471st 472, 472nd 473, 473rd 474, 474th 475, 475th 476, 476th 477, 477th 478, 478th 479, 479th 480, 480th 481, 481st 482, 482nd 483, 483rd 484, 484th 485, 485th 486, 486th 487, 487th 488, 488th 489, 489th 490, 490th 491, 491st 492, 492nd 493, 493rd 494, 494th 495, 495th 496, 496th 497, 497th 498, 498th 499, 499th 500, 500th 501, 501st 502, 502nd 503, 503rd 504, 504th 505, 505th 506, 506th 507, 507th 508, 508th 509, 509th 510, 510th 511, 511st 512, 512nd 513, 513rd 514, 514th 515, 515th 516, 516th 517, 517th 518, 518th 519, 519th 520, 520th 521, 521st 522, 522nd 523, 523rd 524, 524th 525, 525th 526, 526th 527, 527th 528, 528th 529, 529th 530, 530th 531, 531st 532, 532nd 533, 533rd 534, 534th 535, 535th 536, 536th 537, 537th 538, 538th 539, 539th 540, 540th 541, 541st 542, 542nd 543, 543rd 544, 544th 545, 545th 546, 546th 547, 547th 548, 548th 549, 549th 550, 550th 551, 551st 552, 552nd 553, 553rd 554, 554th 555, 555th 556, 556th 557, 557th 558, 558th 559, 559th 560, 560th 561, 561st 562, 562nd 563, 563rd 564, 564th 565, 565th 566, 566th 567, 567th 568, 568th 569, 569th 570, 570th 571, 571st 572, 572nd 573, 573rd 574, 574th 575, 575th 576, 576th 577, 577th 578, 578th 579, 579th 580, 580th 581, 581st 582, 582nd 583, 583rd 584, 584th 585, 585th 586, 586th 587, 587th 588, 588th 589, 589th 590, 590th 591, 591st 592, 592nd 593, 593rd 594, 594th 595, 595th 596, 596th 597, 597th 598, 598th 599, 599th 600, 600th 601, 601st 602, 602nd 603, 603rd 604, 604th 605, 605th 606, 606th 607, 607th 608, 608th 609, 609th 610, 610th 611, 611st 612, 612nd 613, 613rd 614, 614th 615, 615th 616, 616th 617, 617th 618, 618th 619, 619th 620, 620th 621, 621st 622, 622nd 623, 623rd 624, 624th 625, 625th 626, 626th 627, 627th 628, 628th 629, 629th 630, 630th 631, 631st 632, 632nd 633, 633rd 634, 634th 635, 635th 636, 636th 637, 637th 638, 638th 639, 639th 640, 640th 641, 641st 642, 642nd 643, 643rd 644, 644th 645, 645th 646, 646th 647, 647th 648, 648th 649, 649th 650, 650th 651, 651st 652, 652nd 653, 653rd 654, 654th 655, 655th 656, 656th 657, 657th 658, 658th 659, 659th 660, 660th 661, 661st 662, 662nd 663, 663rd 664, 664th 665, 665th 666, 666th 667, 667th 668, 668th 669, 669th 670, 670th 671, 671st 672, 672nd 673, 673rd 674, 674th 675, 675th 676, 676th 677, 677th 678, 678th 679, 679th 680, 680th 681, 681st 682, 682nd 683, 683rd 684, 684th 685, 685th 686, 686th 687, 687th 688, 688th 689, 689th 690, 690th 691, 691st 692, 692nd 693, 693rd 694, 694th 695, 695th 696, 696th 697, 697th 698, 698th 699, 699th 700, 700th 701, 701st 702, 702nd 703, 703rd 704, 704th 705, 705th 706, 706th 707, 707th 708, 708th 709, 709th 710, 710th 711, 711st 712, 712nd 713, 713rd 714, 714th 715, 715th 716, 716th 717, 717th 718, 718th 719, 719th 720, 720th 721, 721st 722, 722nd 723, 723rd 724, 724th 725, 725th 726, 726th 727, 727th 728, 728th 729, 729th 730, 730th 731, 731st 732, 732nd 733, 733rd 734, 734th 735, 735th 736, 736th 737, 737th 738, 738th 739, 739th 740, 740th 741, 741st 742, 742nd 743, 743rd 744, 744th 745, 745th 746, 746th 747, 747th 748, 748th 749, 749th 750, 750th 751, 751st 752, 752nd 753, 753rd 754, 754th 755, 755th 756, 756th 757, 757th 758, 758th 759, 759th 760, 760th 761, 761st 762, 762nd 763, 763rd 764, 764th 765, 765th 766, 766th 767, 767th 768, 768th 769, 769th 770, 770th 771, 771st 772, 772nd 773, 773rd 774, 774th 775, 775th 776, 776th 777, 777th 778, 778th 779, 779th 780, 780th 781, 781st 782, 782nd 783, 783rd 784, 784th 785, 785th 786, 786th 787, 787th 788, 788th 789, 789th 790, 790th 791, 791st 792, 792nd 793, 793rd 794, 794th 795, 795th 796, 796th 797, 797th 798, 798th 799, 799th 800, 800th 801, 801st 802, 802nd 803, 803rd 804, 804th 805, 805th 806, 806th 807, 807th 808, 808th 809, 809th 810, 810th 811, 811st 812, 812nd 813, 813rd 814, 814th 815, 815th 816, 816th 817, 817th 818, 818th 819, 819th 820, 820th 821, 821st 822, 822nd 823, 823rd 824, 824th 825, 825th 826, 826th 827, 827th 828, 828th 829, 829th 830, 830th 831, 831st 832, 832nd 833, 833rd 834, 834th 835, 835th 836, 836th 837, 837th 838, 838th 839, 839th 840, 840th 841, 841st 842, 842nd 843, 843rd 844, 844th 845, 845th 846, 846th 847, 847th 848, 848th 849, 849th 850, 850th 851, 851st 852, 852nd 853, 853rd 854, 854th 855, 855th 856, 856th 857, 857th 858, 858th 859, 859th 860, 860th 861, 861st 862, 862nd 863, 863rd 864, 864th 865, 865th 866, 866th 867, 867th 868, 868th 869, 869th 870, 870th 871, 871st 872, 872nd 873, 873rd 874, 874th 875, 875th 876, 876th 877, 877th 878, 878th 879, 879th 880, 880th 881, 881st 882, 882nd 883, 883rd 884, 884th 885, 885th 886, 886th 887, 887th 888, 888th 889, 889th 890, 890th 891, 891st 892, 892nd 893, 893rd 894, 894th 895, 895th 896, 896th 897, 897th 898, 898th 899, 899th 900, 900th 901, 901st 902, 902nd 903, 903rd 904, 904th 905, 905th 906, 906th 907, 907th 908, 908th 909, 909th 910, 910th 911, 911st 912, 912nd 913, 913rd 914, 914th 915, 915th 916, 916th 917, 917th 918, 918th 919, 919th 920, 920th 921, 921st 922, 922nd 923, 923rd 924, 924th 925, 925th 926, 926th 927, 927th 928, 928th 929, 929th 930, 930th 931, 931st 932, 932nd 933, 933rd 934, 934th 935, 935th 936, 936th 937, 937th 938, 938th 939, 939th 940, 940th 941, 941st 942, 942nd 943, 943rd 944, 944th 945, 945th 946, 946th 947, 947th 948, 948th 949, 949th 950, 950th 951, 951st 952, 952nd 953, 953rd 954, 954th 955, 955th 956, 956th 957, 957th 958, 958th 959, 959th 960, 960th 961, 961st 962, 962nd 963, 963rd 964, 964th 965, 965th 966, 966th 967, 967th 968, 968th 969, 969th 970, 970th 971, 971st 972, 972nd 973, 973rd 974, 974th 975, 975th 976, 976th 977, 977th 978, 978th 979, 979th 980, 980th 981, 981st 982, 982nd 983, 983rd 984, 984th 985, 985th 986, 986th 987, 987th 988, 988th 989, 989th 990, 990th 991, 991st 992, 992nd 993, 993rd 994, 994th 995, 995th 996, 996th 997, 997th 998, 998th 999, 999th 1000, 1000th 1001, 1001st 1002, 1002nd 1003, 1003rd 1004, 1004th 1005, 1005th 1006, 1006th 1007, 1007th 1008, 1008th 1009, 1009th 1010, 1010th 1011, 1011st 1012, 1012nd 1013, 1013rd 1014, 1014th 1015, 1015th 1016, 1016th 1017, 1017th 1018, 1018th 1019, 1019th 1020, 1020th 1021, 1021st 1022, 1022nd 1023, 1023rd 1024, 1024th 1025, 1025th 1026, 1026th 1027, 1027th 1028, 1028th 1029, 1029th 1030, 1030th 1031, 1031st 1032, 1032nd 1033, 1033rd 1034, 1034th 1035, 1035th 1036, 1036th 1037, 1037th 1038, 1038th 1039, 1039th 1040, 1040th 1041, 1041st 1042, 1042nd 1043, 1043rd 1044, 1044th 1045, 1045th 1046, 1046th 1047, 1047th 1048, 1048th 1049, 1049th 1050, 1050th 1051, 1051st 1052, 1052nd 1053, 1053rd 1054, 1054th 1055, 1055th 1056, 1056th 1057, 1057th 1058, 1058th 1059, 1059th 1060, 1060th 1061, 1061st 1062, 1062nd 1063, 1063rd 1064, 1064th 1065, 1065th 1066, 1066th 1067, 1067th 1068, 1068th 1069, 1069th 1070, 1070th 1071, 1071st 1072, 1072nd 1073, 1073rd 1074, 1074th 1075, 1075th 1076, 1076th 1077, 1077th 1078, 1078th 1079, 1079th 1080, 1080th 1081, 1081st 1082, 1082nd 1083, 1083rd 1084, 1084th 1085, 1085th 1086, 1086th 1087, 1087th 1088, 1088th 1089, 1089th 1090, 1090th 1091, 1091st 1092, 1092nd 1093, 1093rd 1094, 1094th 1095, 1095th 1096, 1096th 1097, 1097th 1098, 1098th 1099, 1099th 1100, 1100th 1101, 1101st 1102, 1102nd 1103, 1103rd 1104, 1104th 1105, 1105th 1106, 1106th 1107, 1107th 1108, 1108th 1109, 1109th 1110, 1110th 1111, 1111st 1112, 1112nd 1113, 1113rd 1114, 1114th 1115, 1115th 1116, 1116th 1117, 1117th 1118, 1118th 1119, 1119th 1120, 1120th 1121, 1121st 1122, 1122



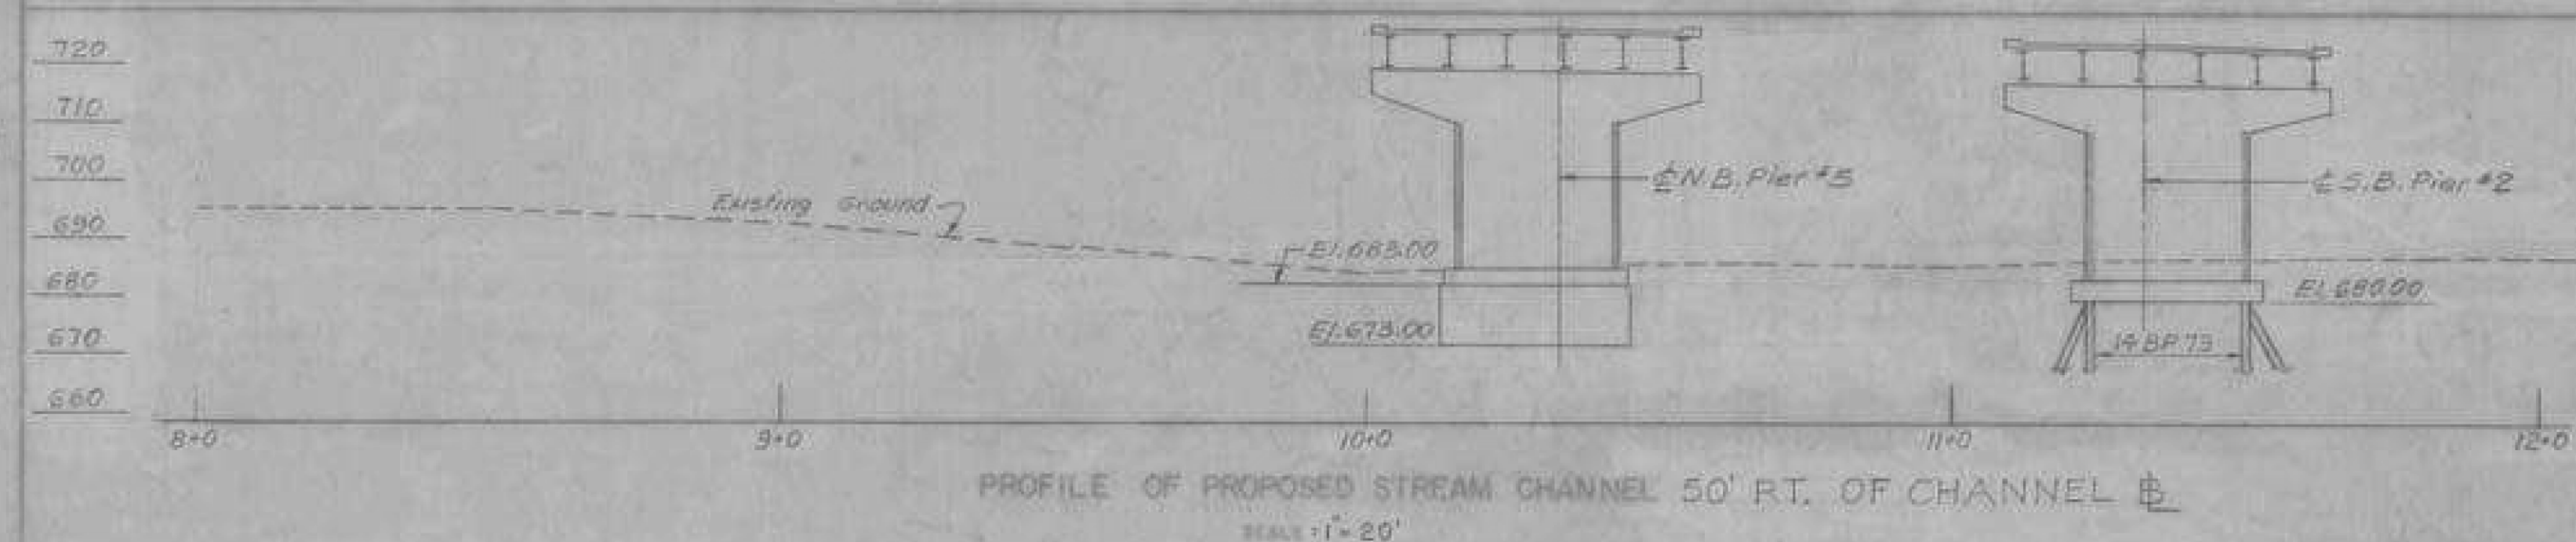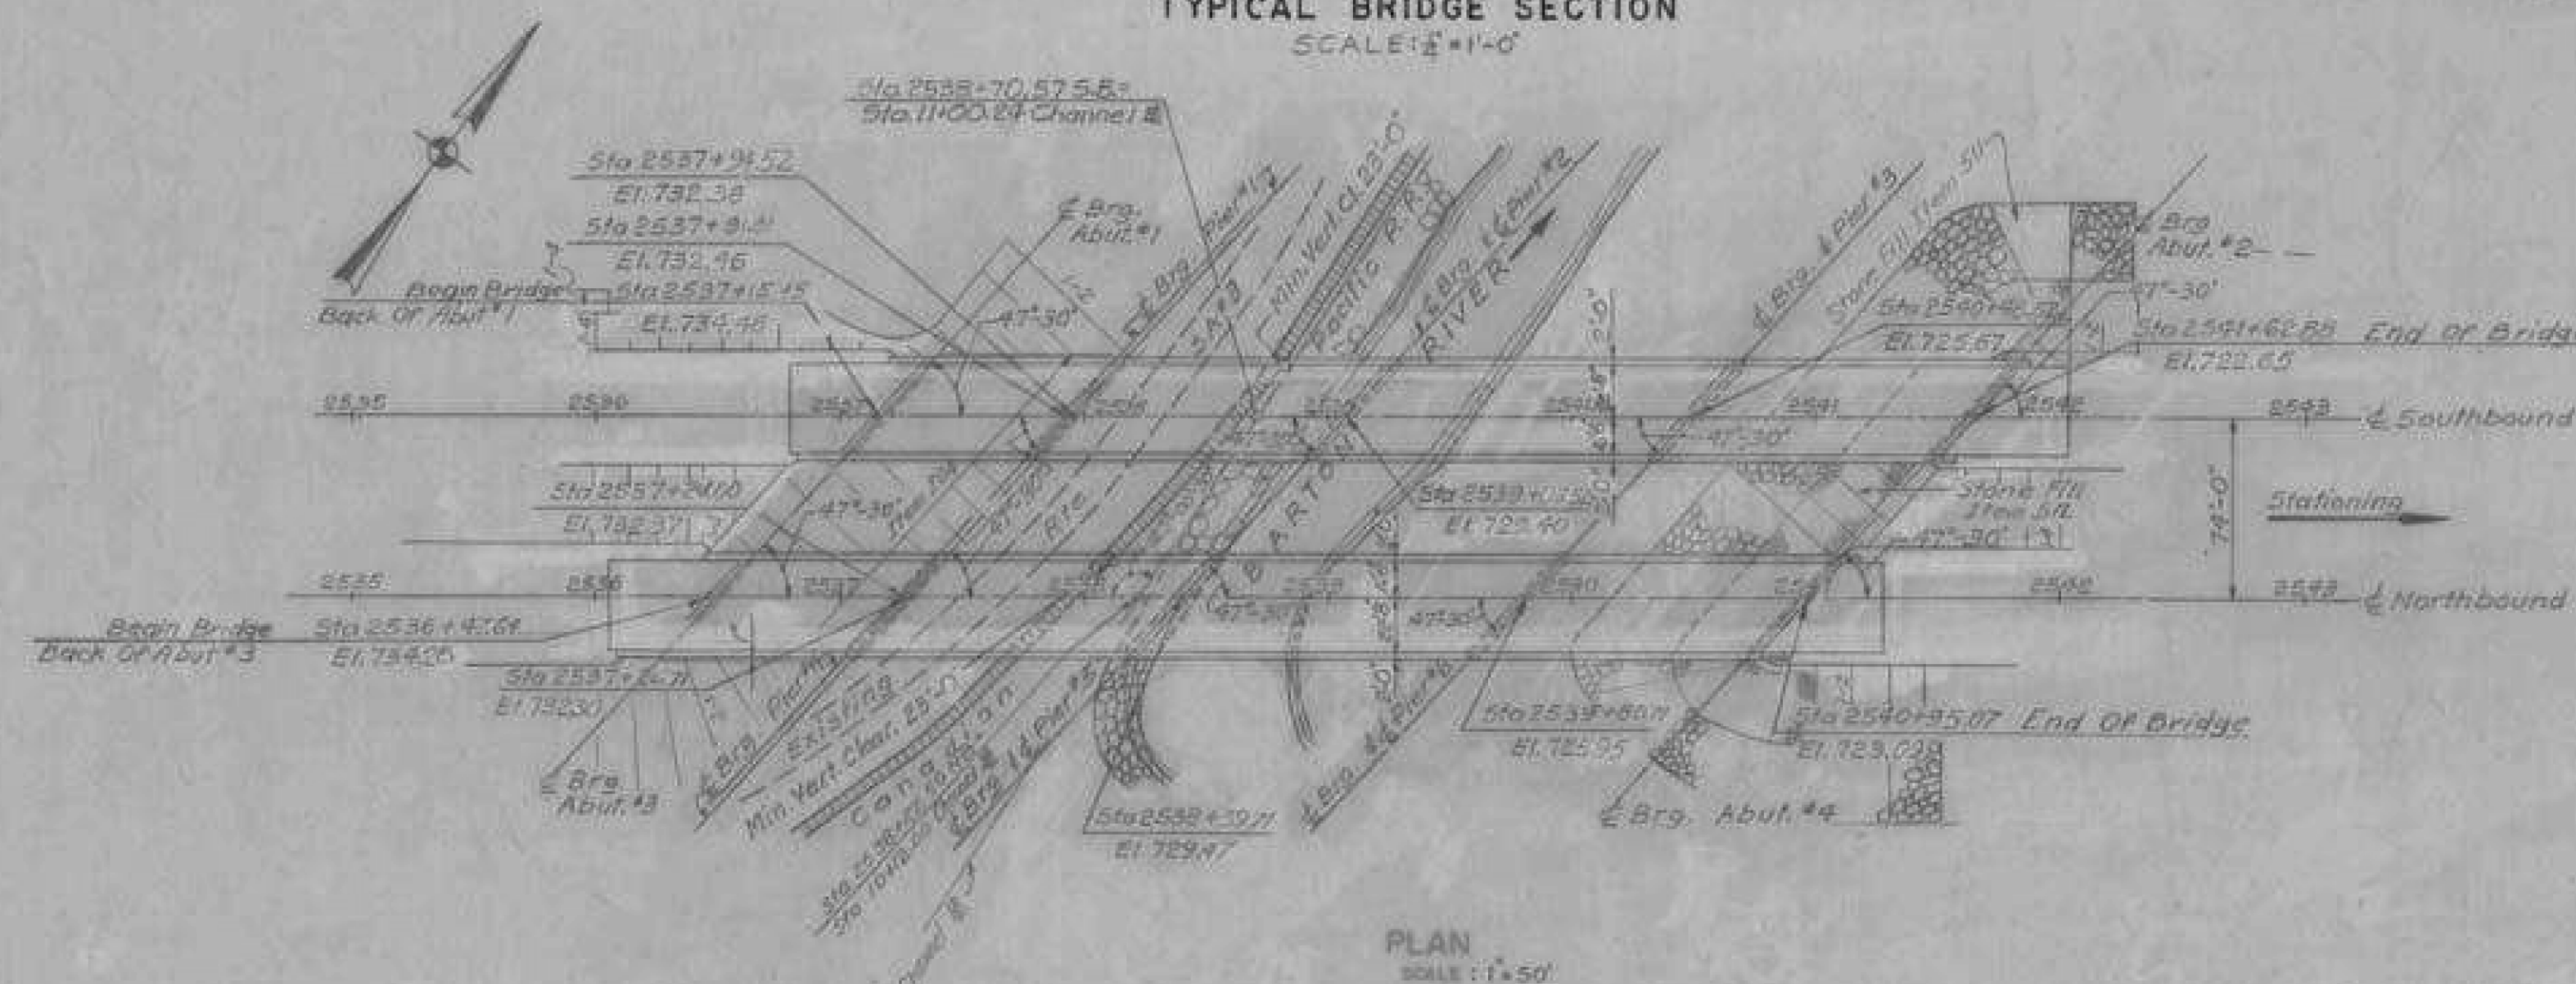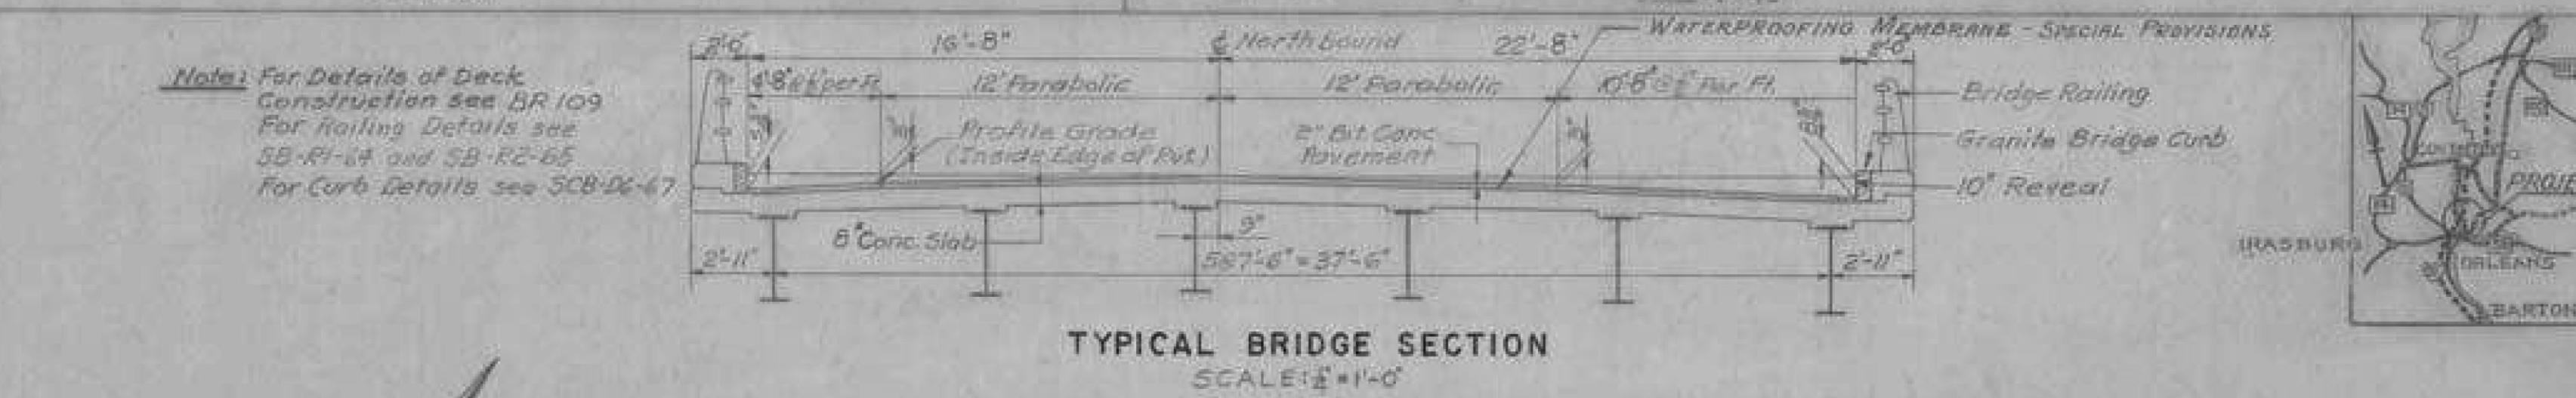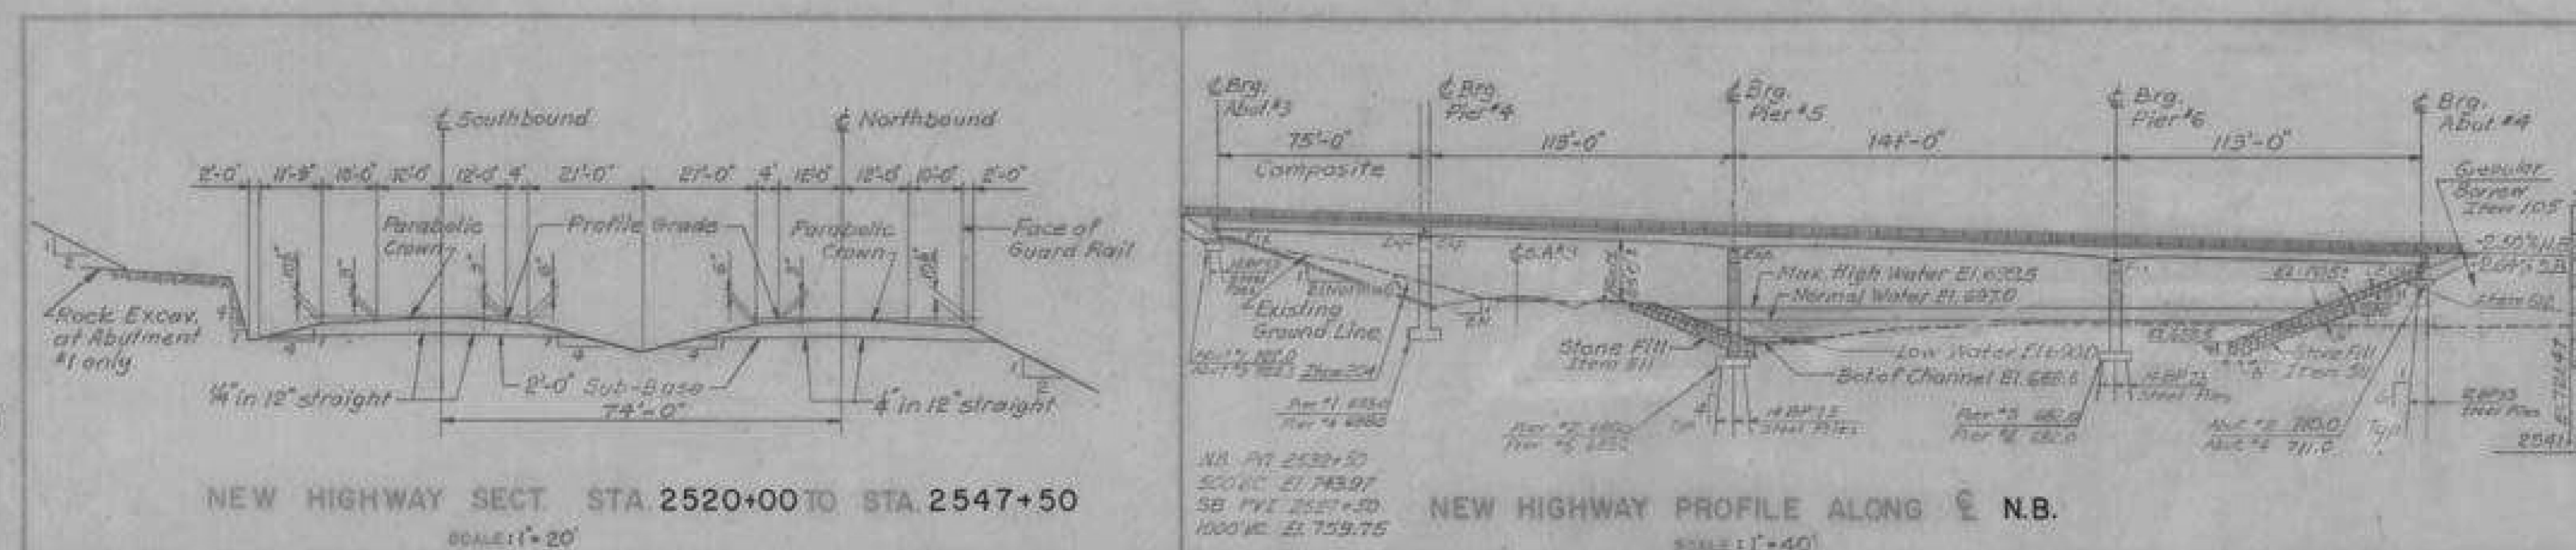

Highway No. **I-91** NAME OF HIGHWAY **INTERSTATE**  
STRUCTURE NO. **ORLEANS** COUNTY **ORLEANS** TOWN **IRAS**  
PROJECT NO. **I-91-3(B)** LOCATION **191 OVER BARTON RIVER, C.P.R.R.**

**EXISTING STRUCTURE**

1. RATED LOADING OF EXISTING STRUCTURE **N.A.**
2. TYPE OF EXISTING STRUCTURE **N.A.**
3. UNDERCLEARANCE ELEVATION OF EXISTING STRUCTURE **N.A.**
4. WHY DISPOSITION SHOULD BE MADE OF EXISTING STRUCTURE **N.A.** COST OF NEW
5. SHOULD EXISTING STRUCTURE BE USED TO MAINTAIN TRAFFIC DURING CONSTRUCTION OF NEW **N.A.**
6. SHOULD NEW TEMPORARY STRUCTURE BE BUILT? **N.A.**
7. ORDINARY HIGH WATER SURFACE ELEV. AT EXISTING STRUCTURE **N.A.** WATERWAY TO
8. EXTREME HIGH WATER AT EXISTING STRUCTURE **N.A.**
9. DRAIN OF EXISTING BRIDGE DOWNSTREAM **N.A.** WATERWAY TO EXTREME H.W.
10. TYPE OF FOUNDATION UNDER EXISTING ABUTMENTS **N.A.**
11. DOES ALL WATER AT FLOOD ELEVATION PASS THROUGH EXISTING STRUCTURE? **N.A.**
12. IF NOT AT WHAT ELEVATION IS RELIEF AFFORDED? **N.A.**
13. ADDITIONAL WATERWAY AREA PROVIDED **N.A.**

**NEW STRUCTURE**

1. RECOMMENDED TYPE OF STRUCTURE **ONE SINGLE SPAN CONCRETE**
2. RECOMMENDED CLEAR SPAN OR SPANS **75.0'-113.0'-141.0'-163.0'**
3. MEASURED PARALLEL TO E. HIGHWAY **75.0'-113.0'-141.0'-163.0'**
4. MEASURED AT RIGHT ANGLES TO E. STREAM **55.0'-84.0'-104.0'-24.0'**
5. ARE THERE OBSTRUCTIONS TO A PIEN IN THE STREAM? ANSWER YES OR NO **No**
6. ORDINARY HIGH WATER ELEVATION AT NEW STRUCTURE **637.0**
7. EXTREME HIGH WATER ELEVATION AT NEW STRUCTURE **637.0** SOURCE OF INFO.
8. IS ALL WATER INTENDED TO PASS THROUGH NEW STRUCTURE? **Yes**
9. DOES STREAM REACH ITS MAXIMUM HIGH WATER ELEVATION FREQUENTLY? **No**
10. LOW WATER ELEVATION AT NEW STRUCTURE **630.0**
11. DRAINAGE AREA IN ACRES ABOVE STRUCTURE **99.3/2** CHARACTER OF TERRAIN
12. IS STREAM EVER DRY? **No**
13. VELOCITY OF STREAM AT HIGH WATER STAGE **6.21 C.F.S.** ESTIMATED DISCHARGE
14. AREA FULL OPENING **125.0 C.F.** AREA BELOW OBSTRUCTION **N.A.** **125.0 C.F.**
15. CHARACTER OF SOIL **N.A.** DRIFT **N.A.** **125.0 C.F.**
16. ESTIMATED DRAINAGE AREA ABOVE NATURAL OR ARTIFICIAL OBSTRUCTION **125.0**
17. VERTICAL CLEARANCE ABOVE FLOOD ELEVATION **18.0'** BOTH SIDES
18. ARE SIDEWALKS REQUIRED? **No** ON WHAT SIDE? **18.0'**
19. RECOMMENDED TYPE OF PAVEMENT **2. BITUMINOUS CONCRETE, 8" C**
20. TRAFFIC TO BE MAINTAINED UNDER IT? **N.A.** ONE OR TWO WAYS
21. PROBABLE COST OF CLEANING AND GRUBBING STREAM CHANNEL AT STRUCTURE SITE
22. SHOULD PROVISIONS BE MADE FOR PUBLIC UTILITIES? **No**
23. ESTIMATED ALLOWABLE LOAD ON FOUNDATIONS **See Below**

**FOUNDATION INFORMATION**

OBTAINED FOR DESIGN PURPOSES ONLY, AND THE STATE ASSUMES NO RESPONSIBILITY FOR THE SUFFICIENCY OR ACCURACY OF THE INFORMATION SHOWN, INCLUDING ENCOUNTERED AT ANY PIER OR ABUTMENT LOCATION.

Pier No. 4 & 5 - 5 Tons / 5 F  
Abutment No. 2 - 12 BP 53 110' Long  
Abutment No. 1 & 3 - 12 BP 53 80' Long, 58 Tons / Pile  
Abutment No. 4 - 12 BP 53 100' Long  
Pier No. 1 - 14 BP 73 20' Long  
Pier No. 2 - 14 BP 73 30' Long  
Pier No. 3 - 14 BP 73 55' Long  
Pier No. 6 - 14 BP 73 45' Long


**Design Stresses:**  
Concrete  $f_c = 3000$  p.s.i.  $f_t = 1200$  p.s.i.  
Structural Steel  $f_s = 20,000$  p.s.i. (A-36) others per  
Reinforcing Steel  $f_s = 20,000$  p.s.i. Tension  
 $f_c = 16,000$  p.s.i. Compression  
Welding per A.W.S. Spec's  
**Design Loading: HS 20-44**

RECOMMENDED FOR APPROVAL **20.000** DATE **9-15-69**  
CONSTRUCTION ENGINEER  
RECOMMENDED FOR APPROVAL **20.000** DATE **9-15-69**  
DATE  
RECOMMENDED FOR APPROVAL **20.000** DATE **9-15-69**  
DATE  
APPROVED BY **20.000** DATE **9-15-69**  
DATE


STATE OF  
DEPARTMENT OF  
PROJECT **BARTON**  
ROUTE NO **I-91**  
191 OVER BARTON RIVER  
PRELIMINARY INFO  
PROJECT **EMPT 91-3(20)**

Changed Roadway width from 38' to 40'  
Changed Curb width from 2' to 2.5'  
2. Road 9/15/69




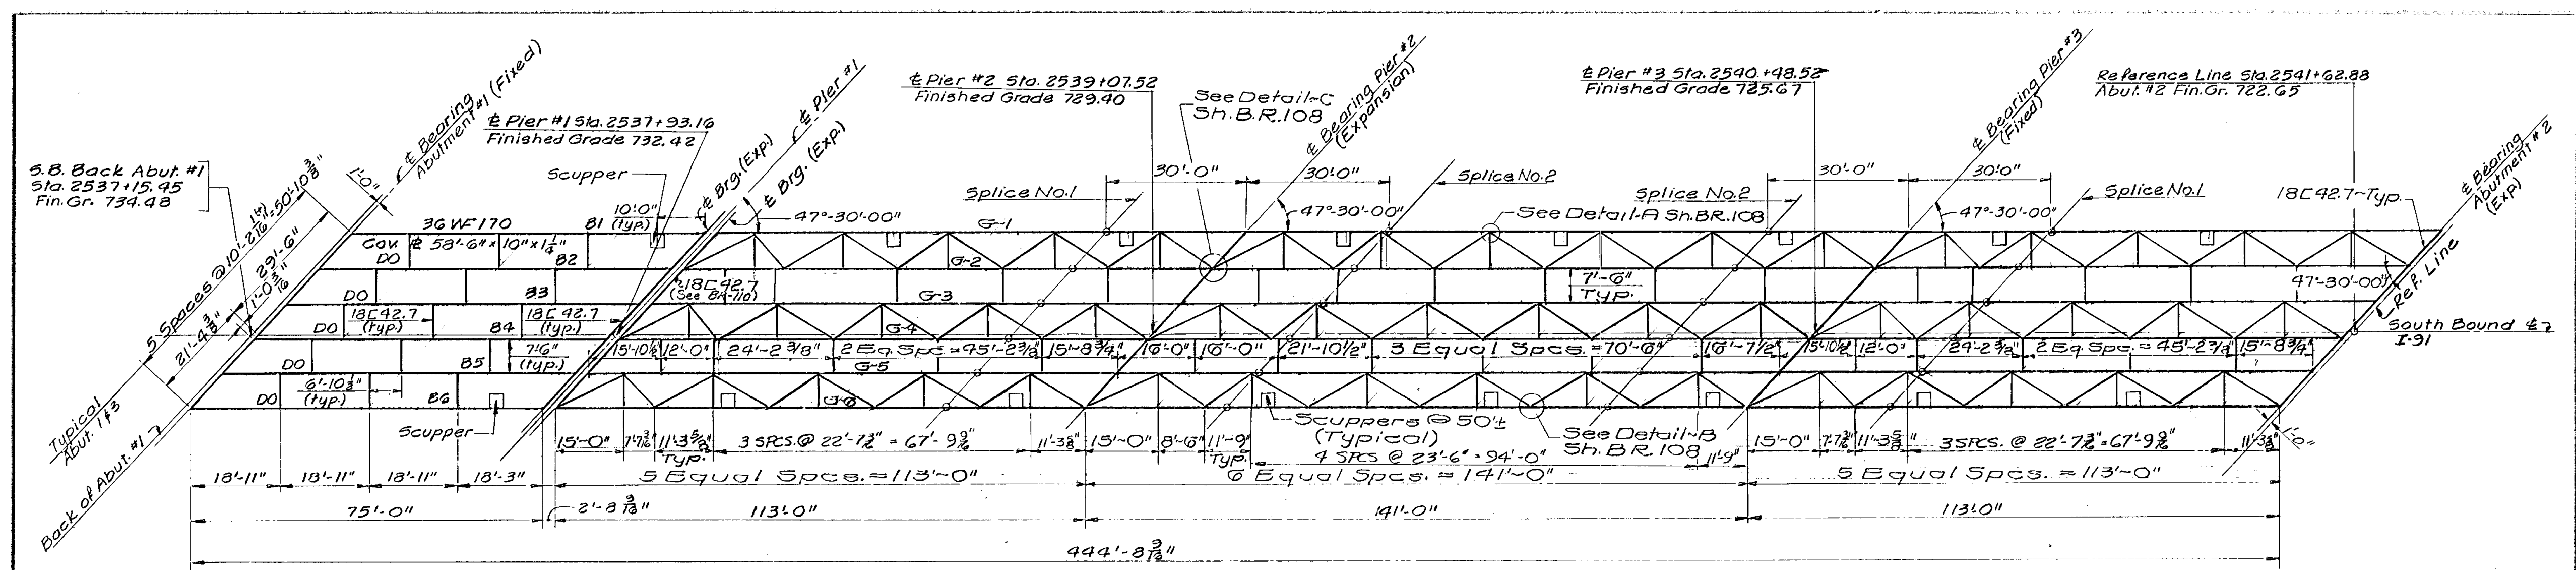


SOUTHBOUND FRAMING PLAN  
SCALE: 1/16" = 1'-0"

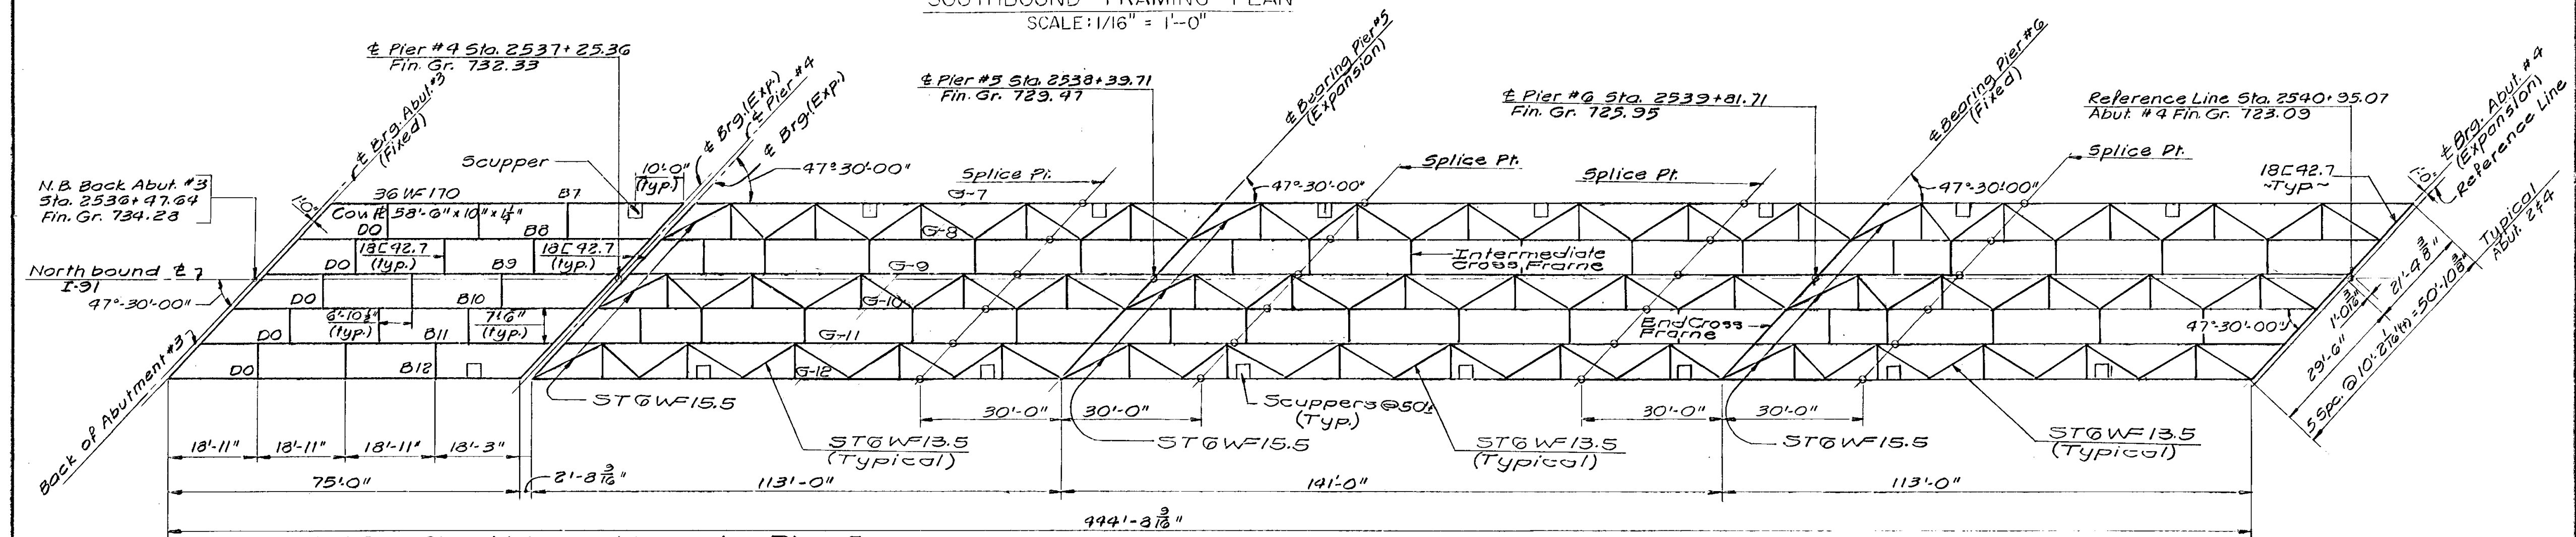


NORTHBOUND FRAMING PLAN  
SCALE: 1/16" = 1'-0"

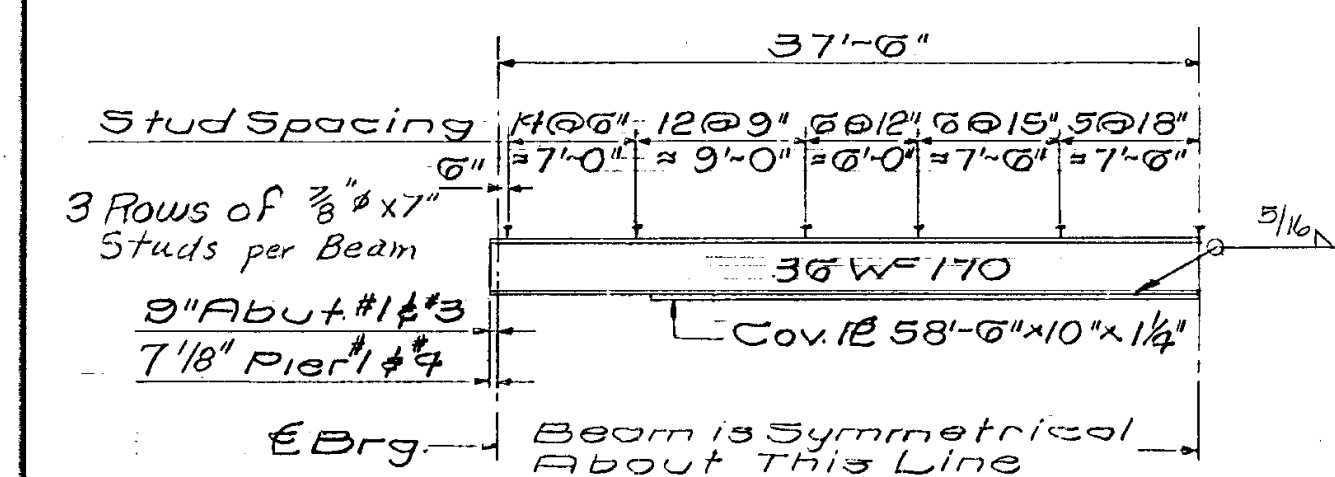

BEAM HALF ELEVATION B-1 THRU B-12  
SCALE: 1/8" = 1'-0"

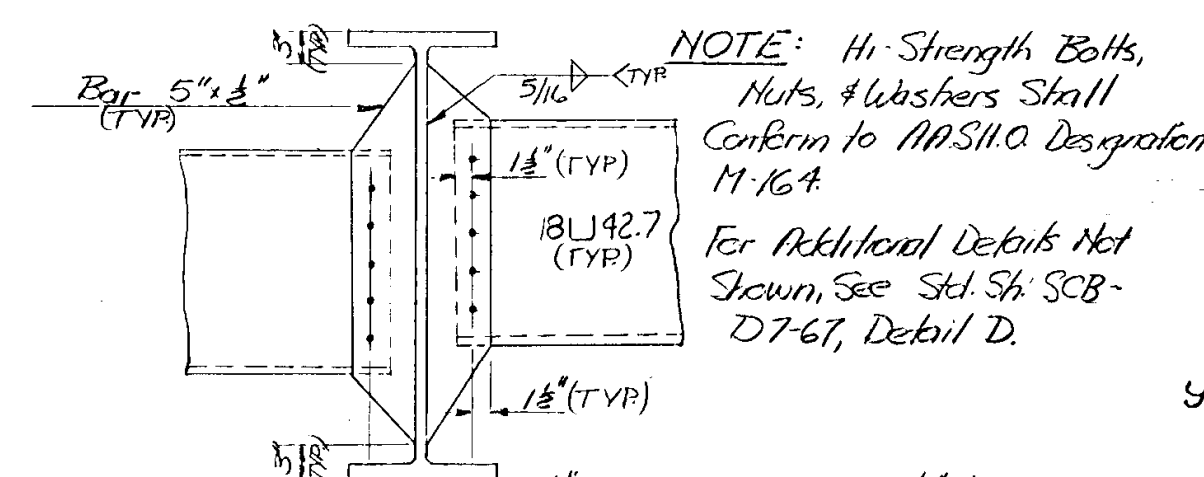

INTERMEDIATE DIAPHRAGM CONNECTION FOR ROLLED BEAM SECTION  
1" = 1'-0"

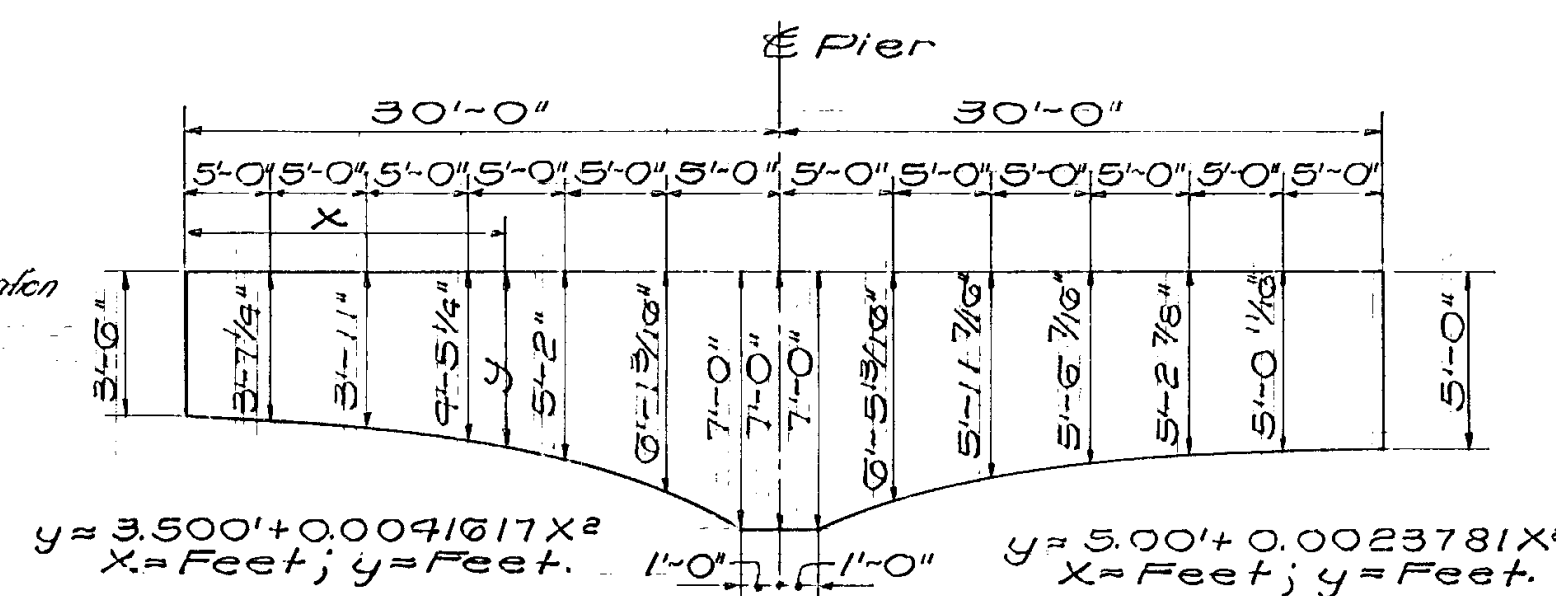

PARABOLIC HAUNCH DETAIL  
N.T.S.


Br. 107 of 129

STATE OF VERMONT  
DEPARTMENT OF HIGHWAYS




PROJECT IRASBURG-DEERY  
TOWN OF IRASBURG  
ROUTE No. 1-91 STA. 2539+  
1-91 OVER BARTON RIVER AND SA 3  
FRAMING PLAN AND GIRDER DETAILS  
SCALE AS NOTED  
IN CHARGE C. TERENZIO  
DRAWN BY JMB CHECKED BY A. CENTORE  
PROJECT No. 191-3(8) 9-67  
SHEET 176 OF 605 BR. 107

IRASBURG  
IM DECK(46)  
BRIDGE NO. 107N  
SHEET 36 OF 49  
FOR REFERENCE ONLY



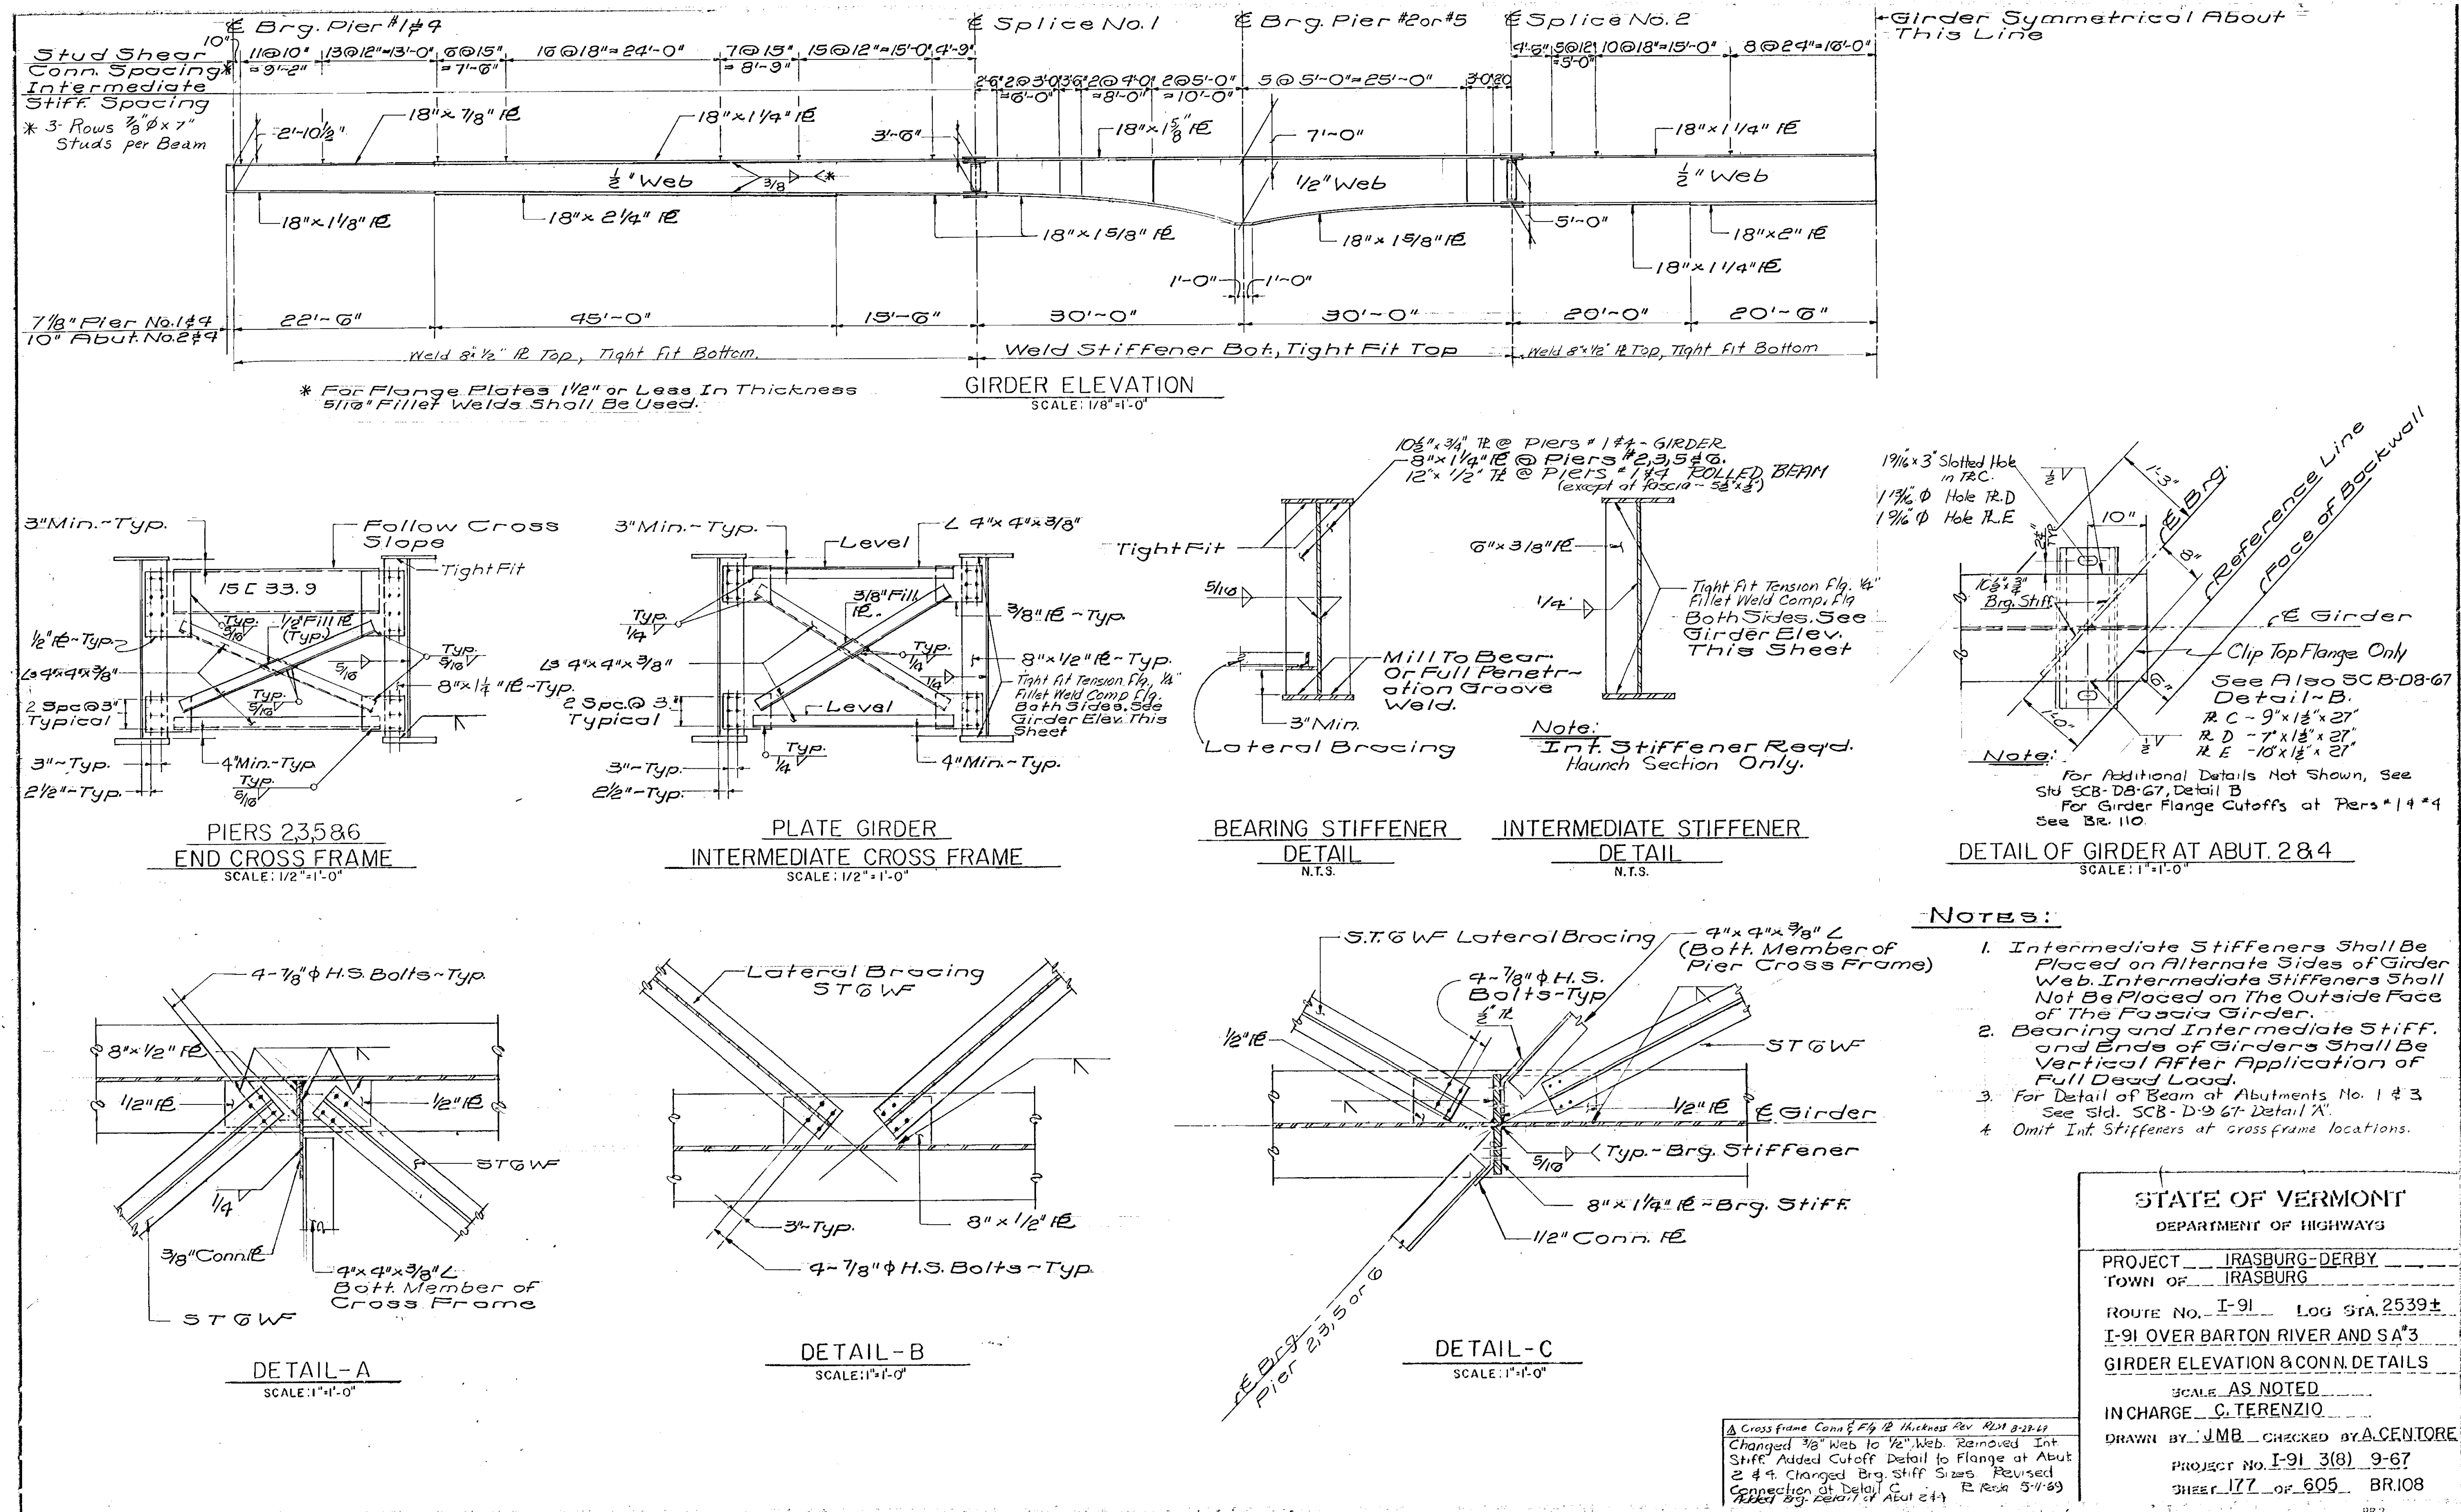



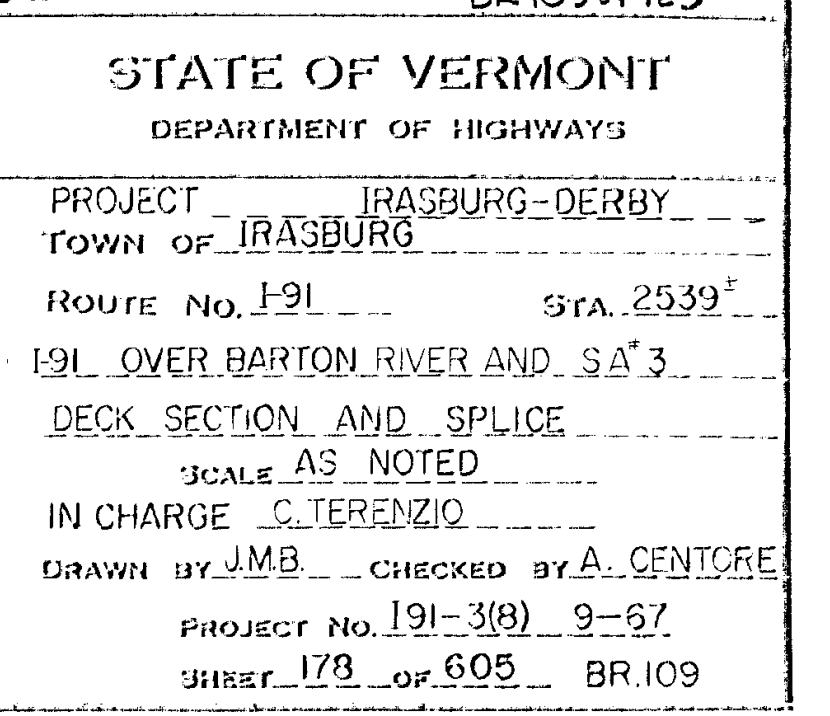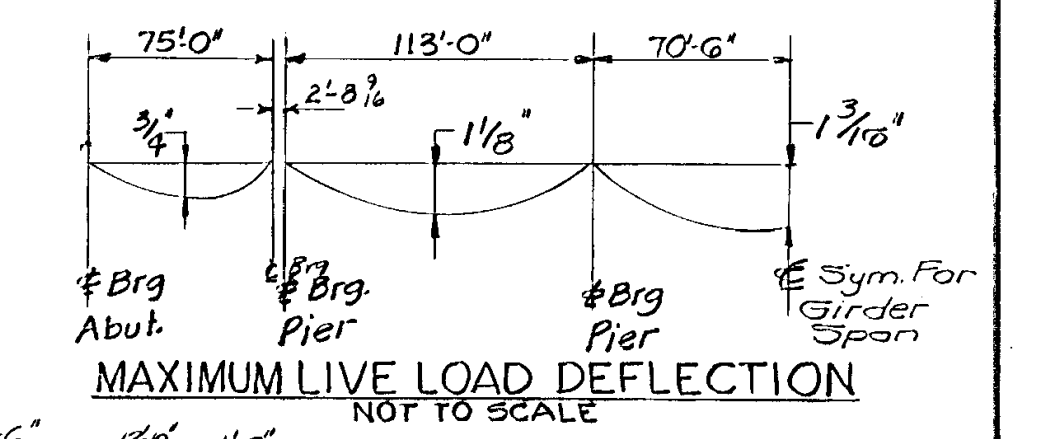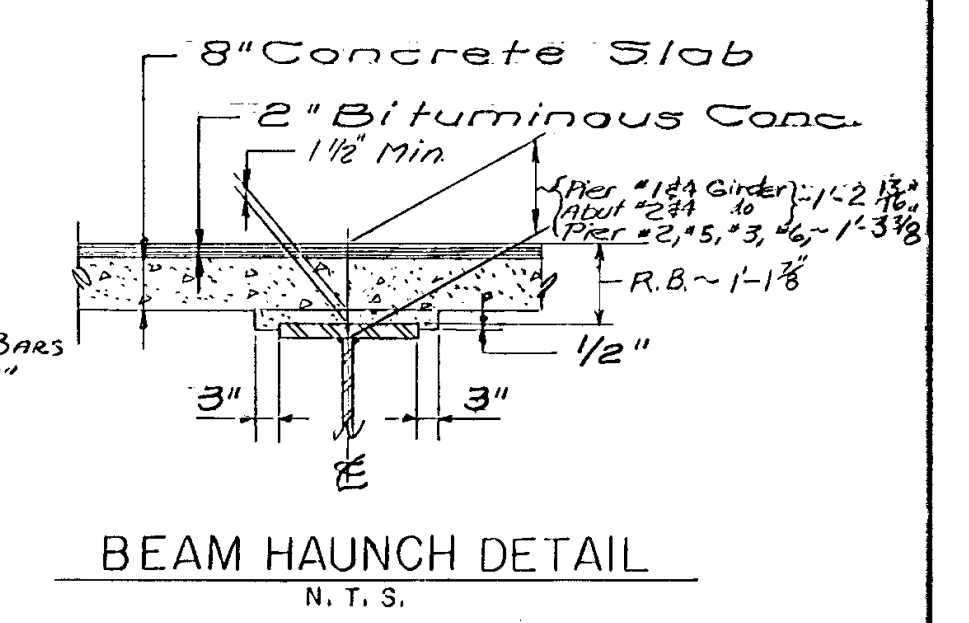


IRASBURG  
IM DECK(46)  
BRIDGE NO. 107N  
SHEET 38 OF 49  
FOR REFERENCE ONLY








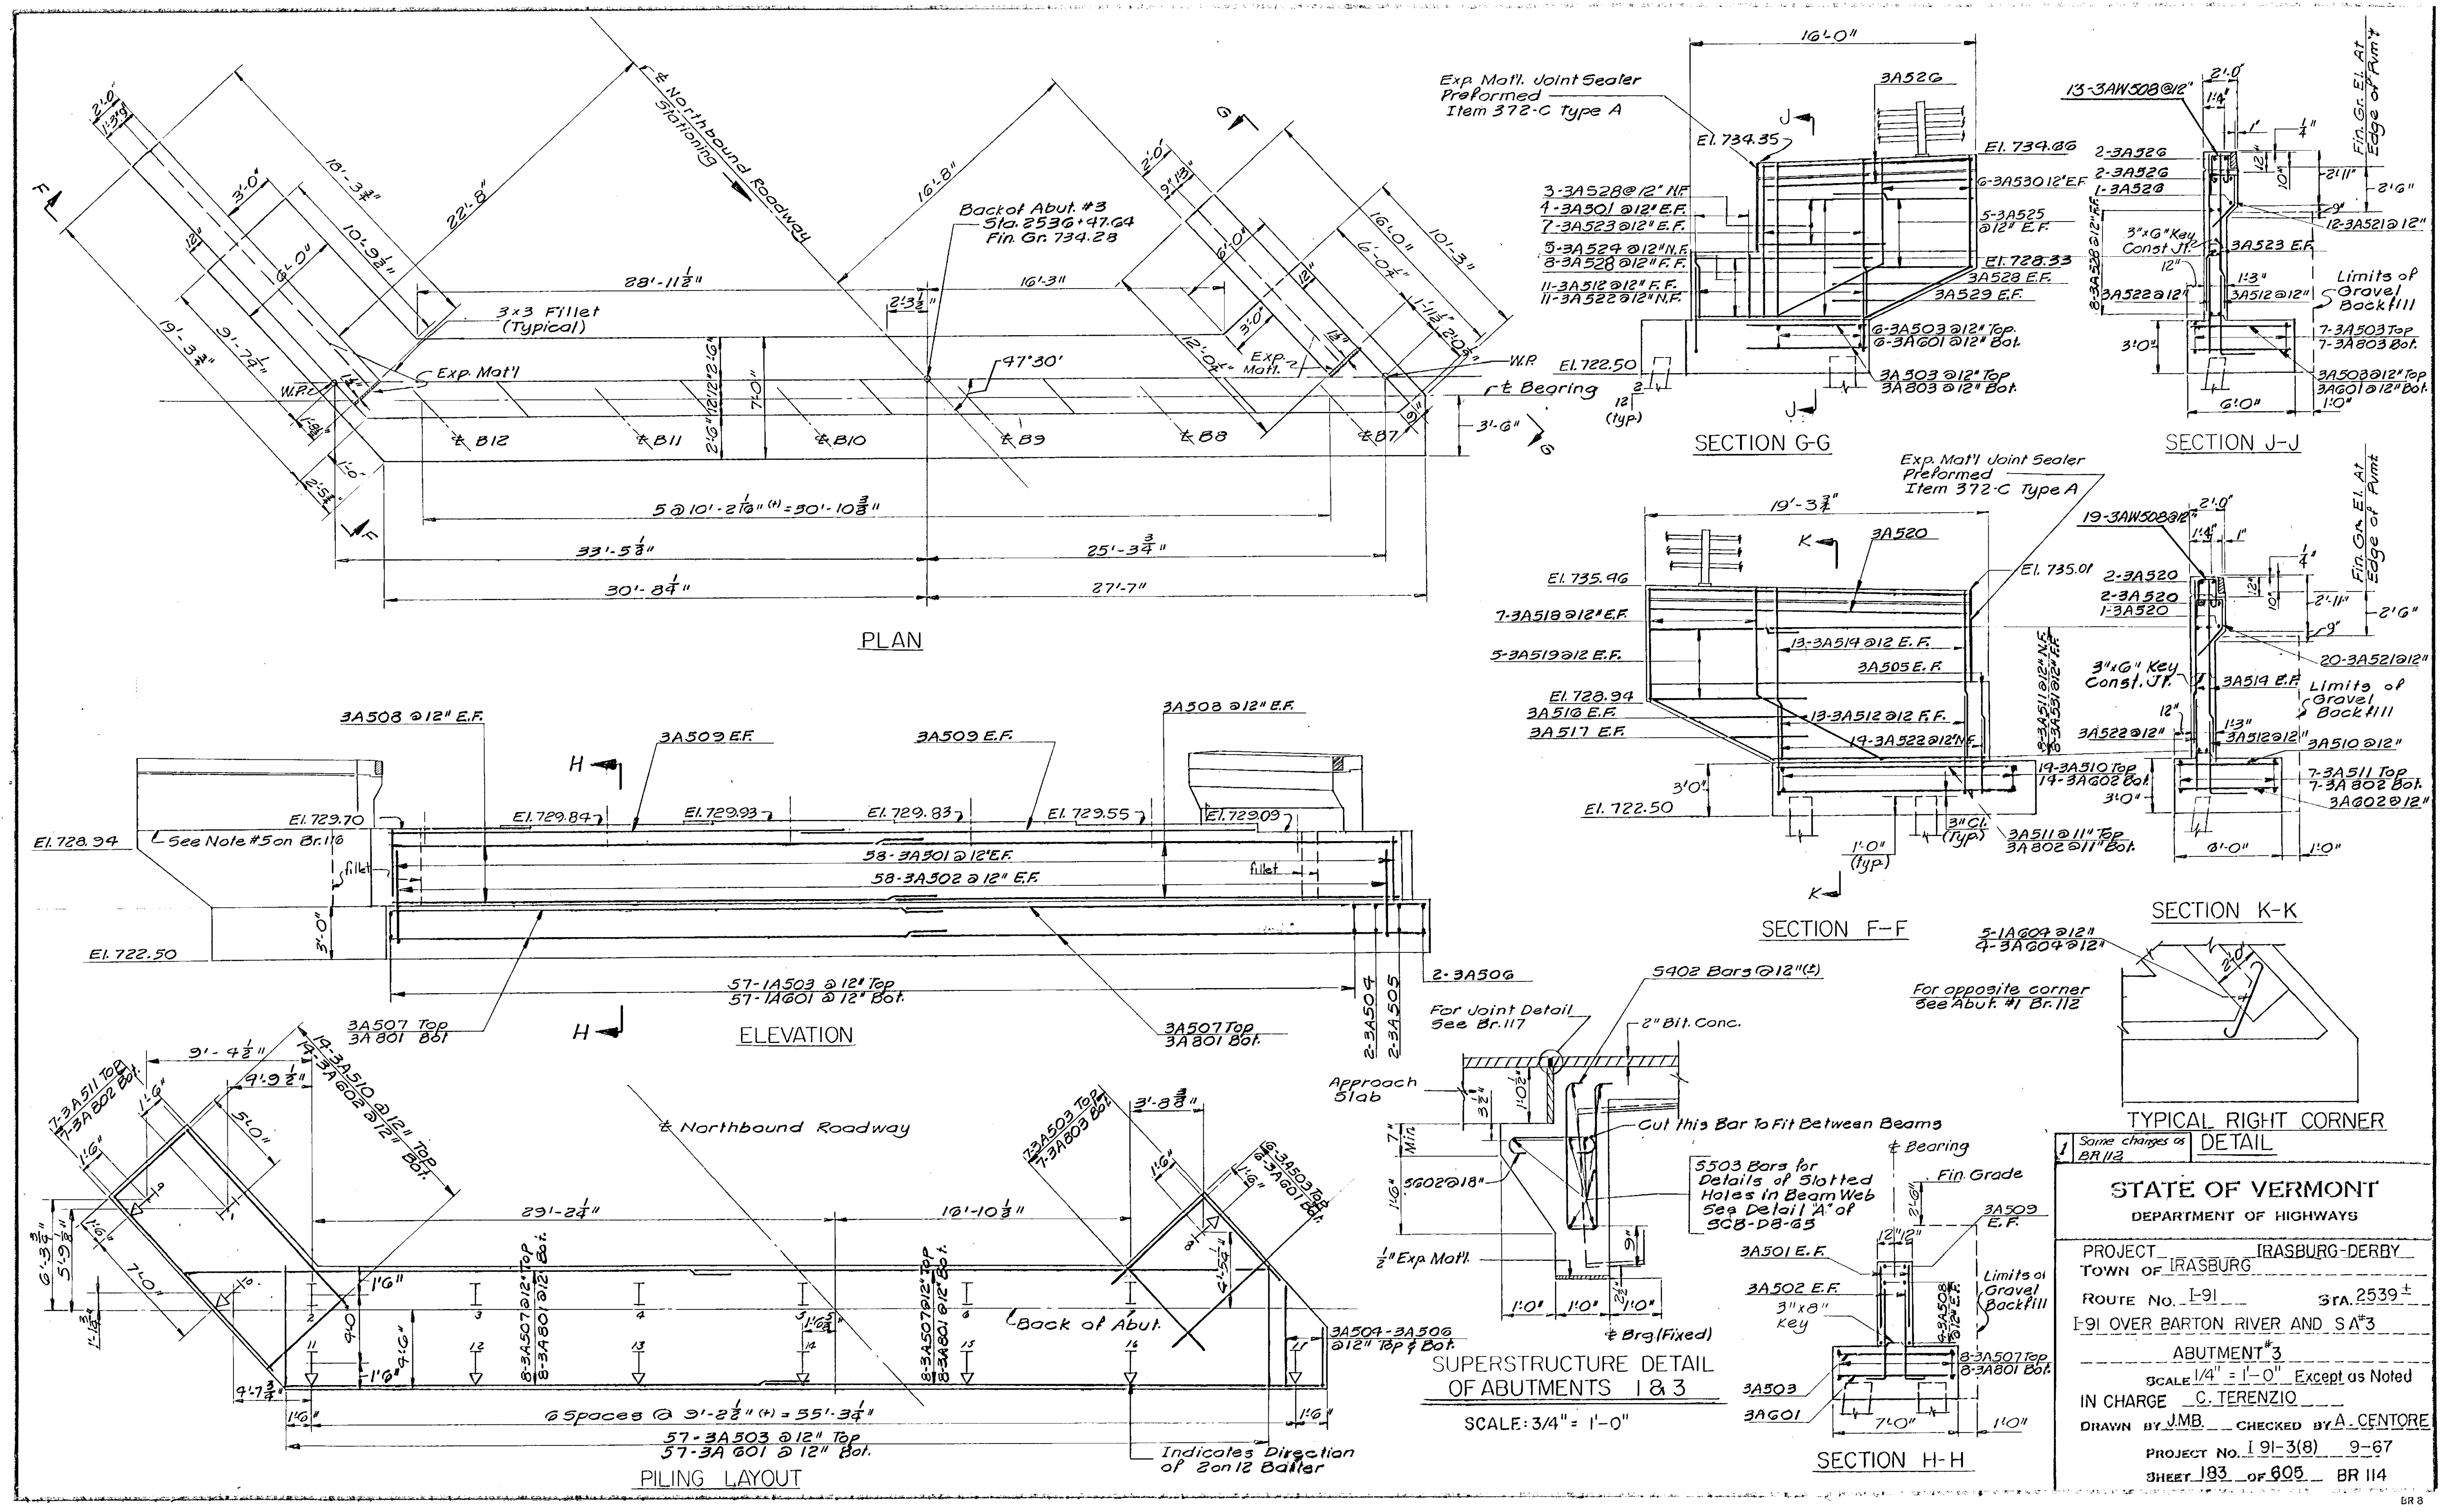


IRASBURG  
IM DECK(46)  
BRIDGE NO. 107N  
SHEET 40 OF 49  
FOR REFERENCE ONLY






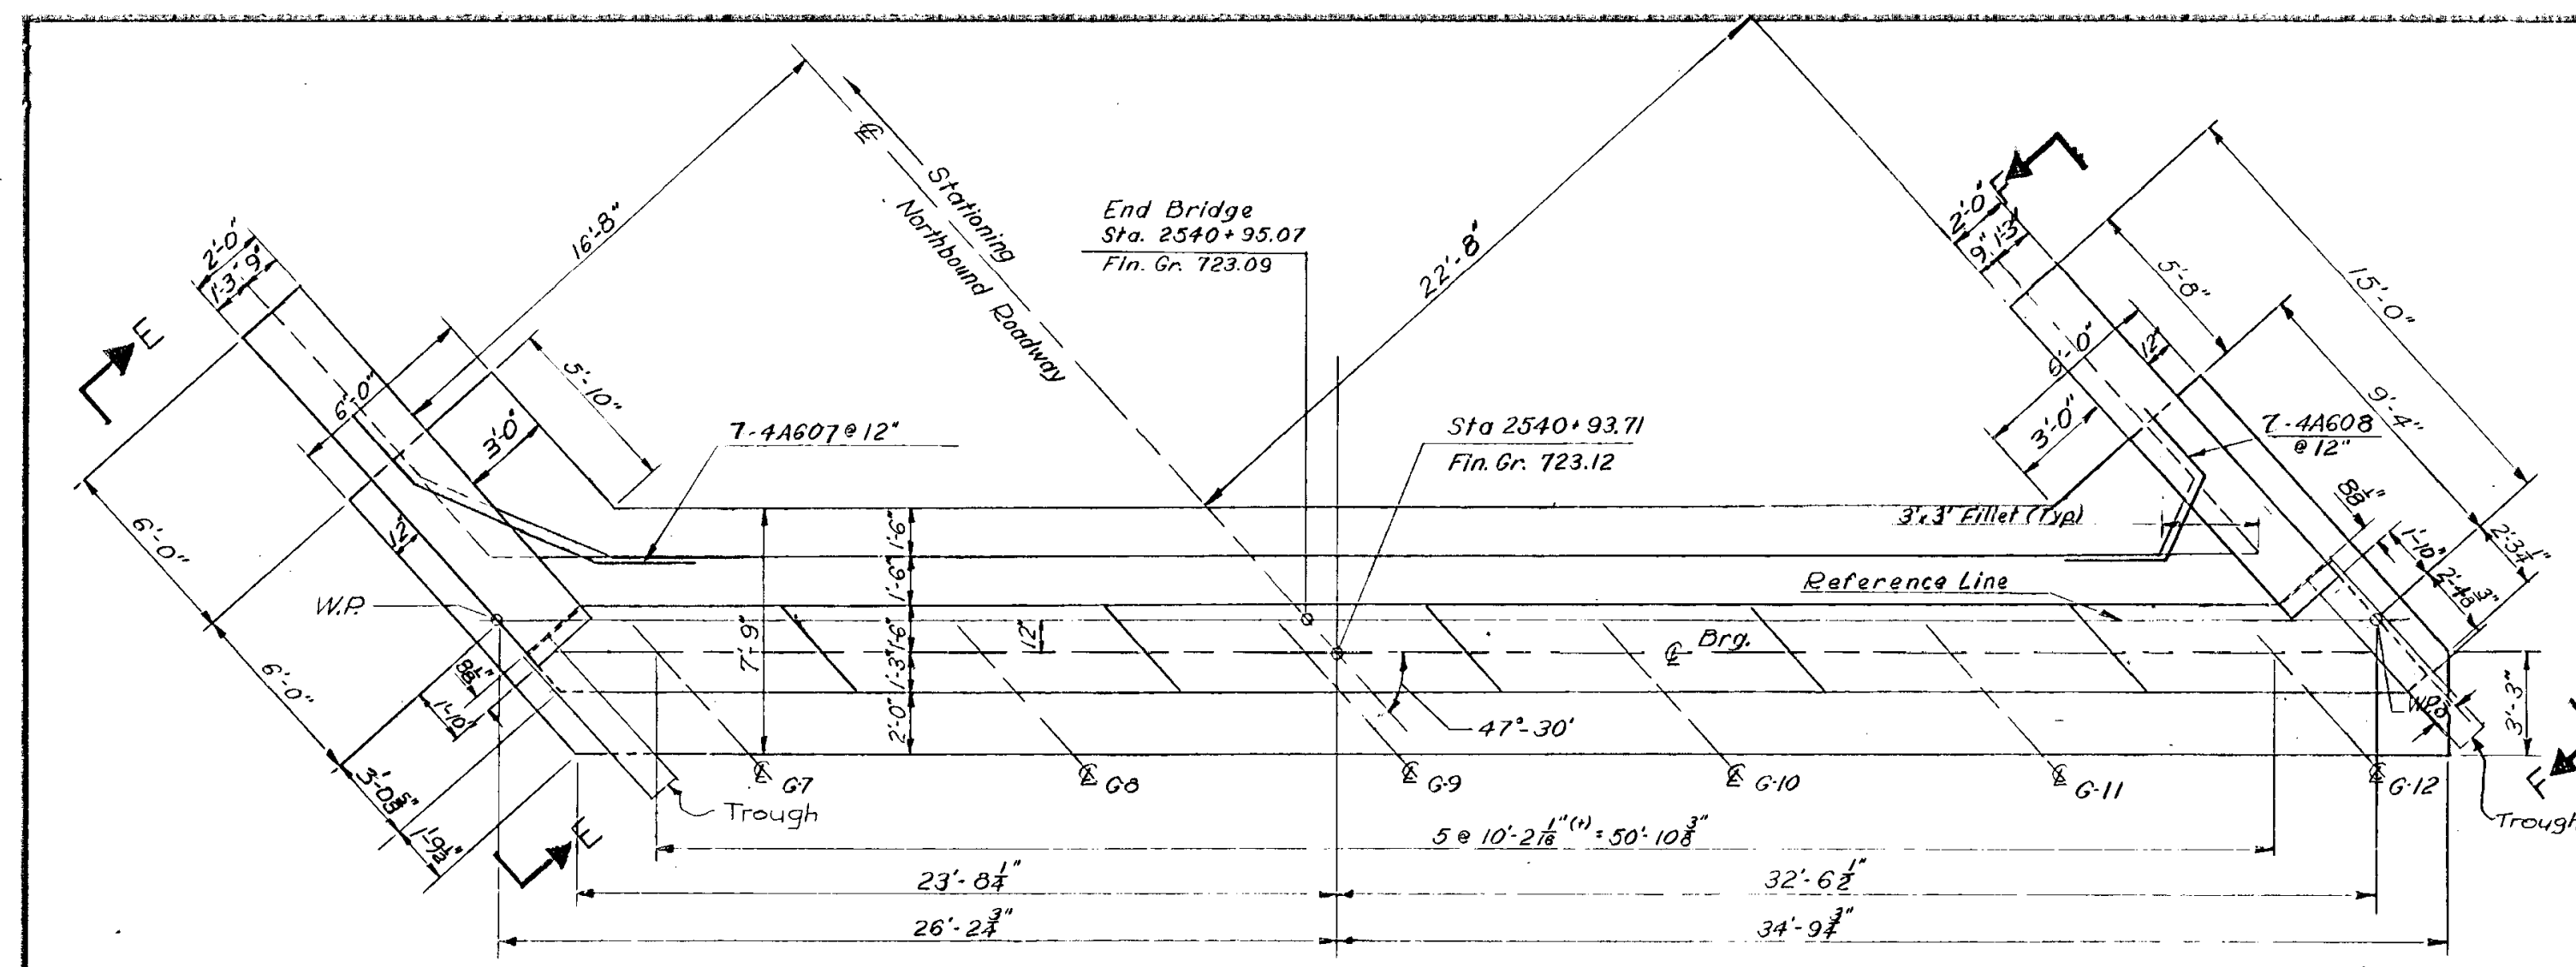

PLAN  
1/4" = 1'-0"

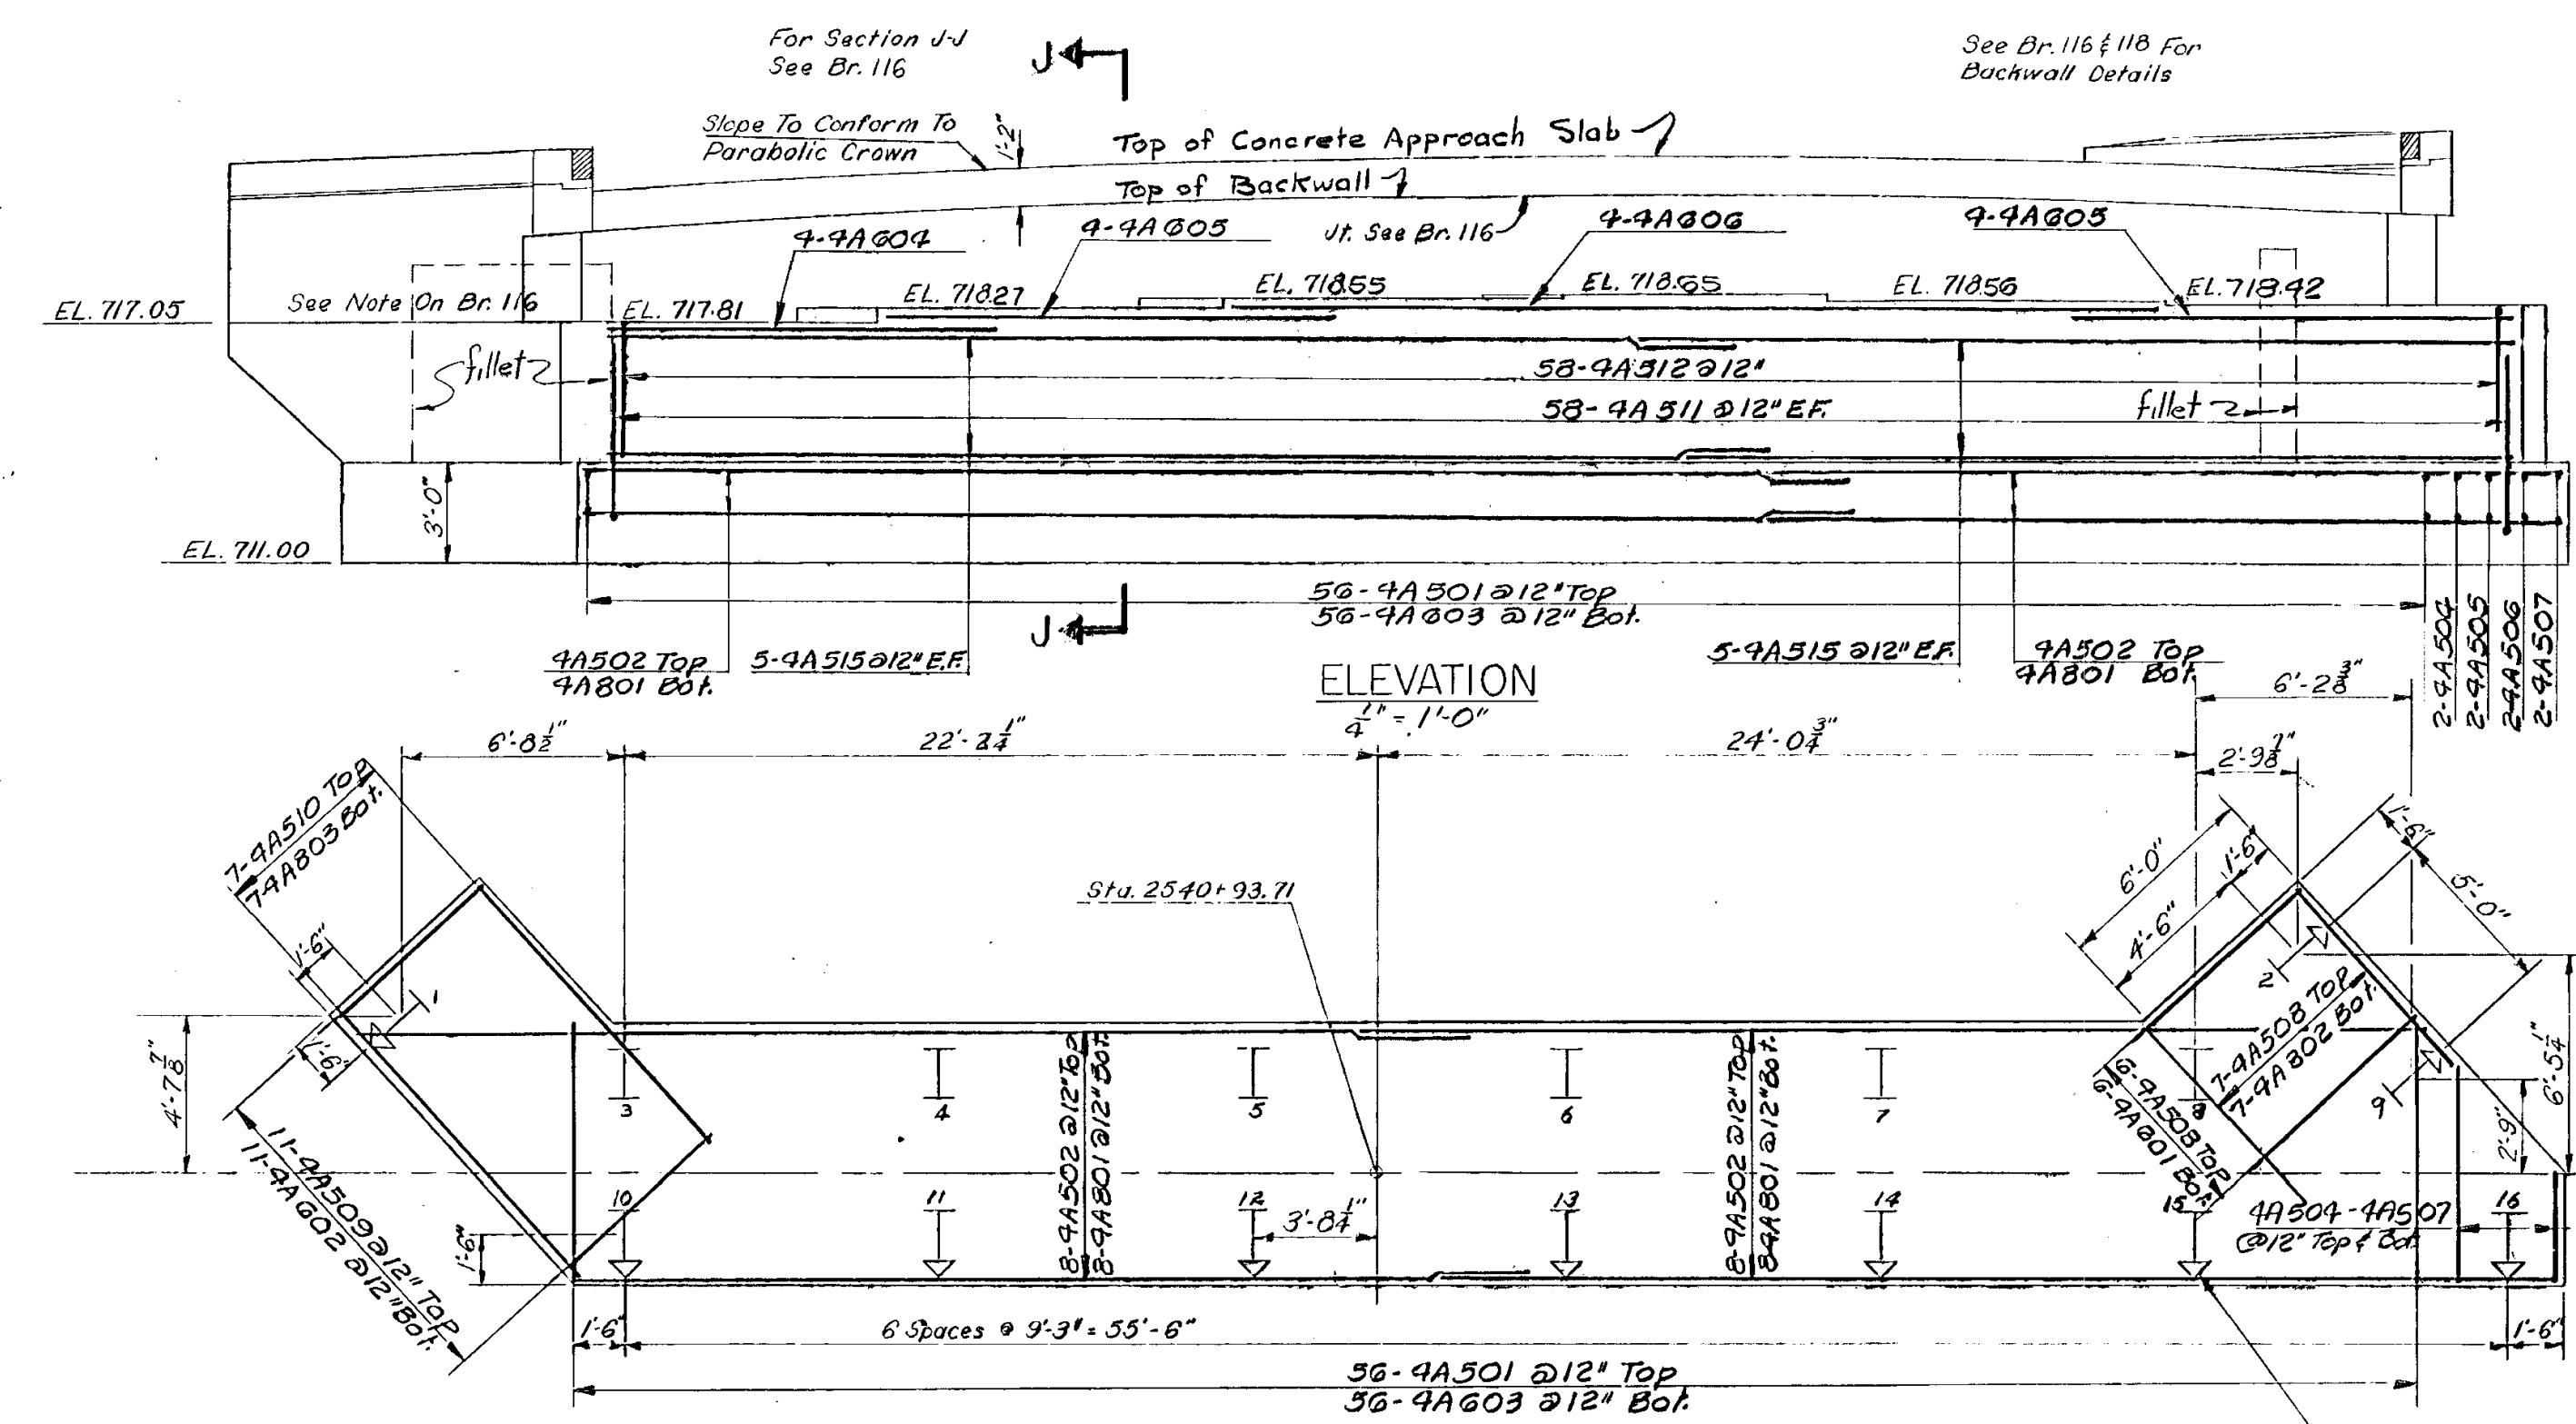


FOOTING REINFORCEMENT AND PILING LAYOUT  
1/4" = 1'-0"

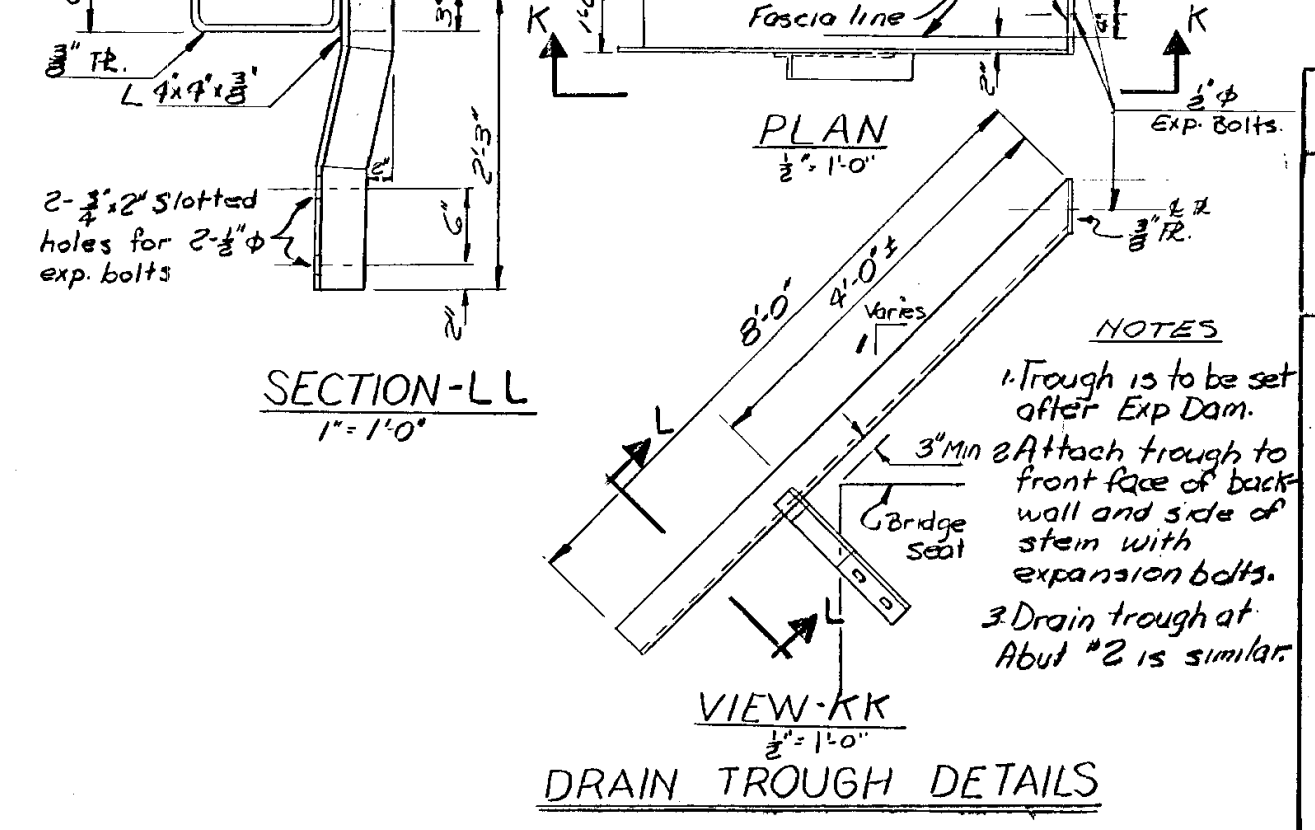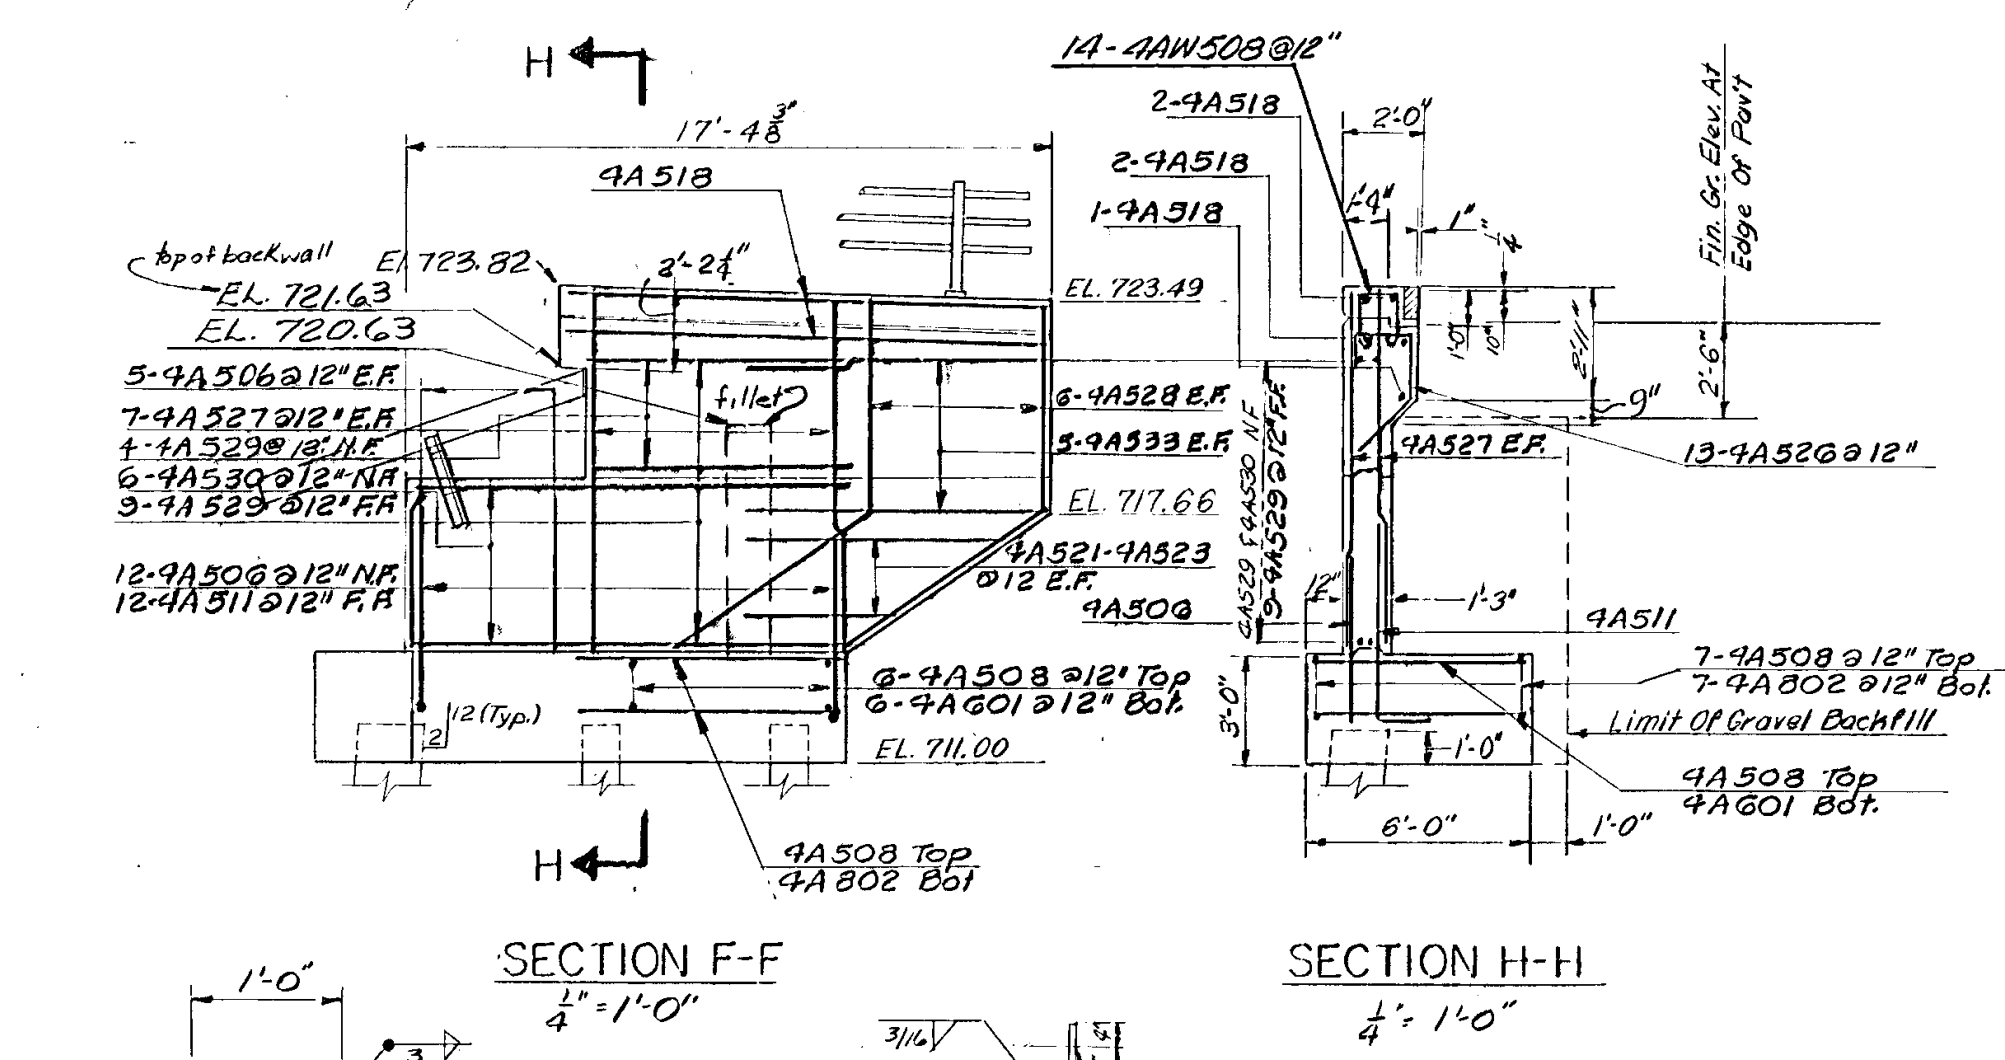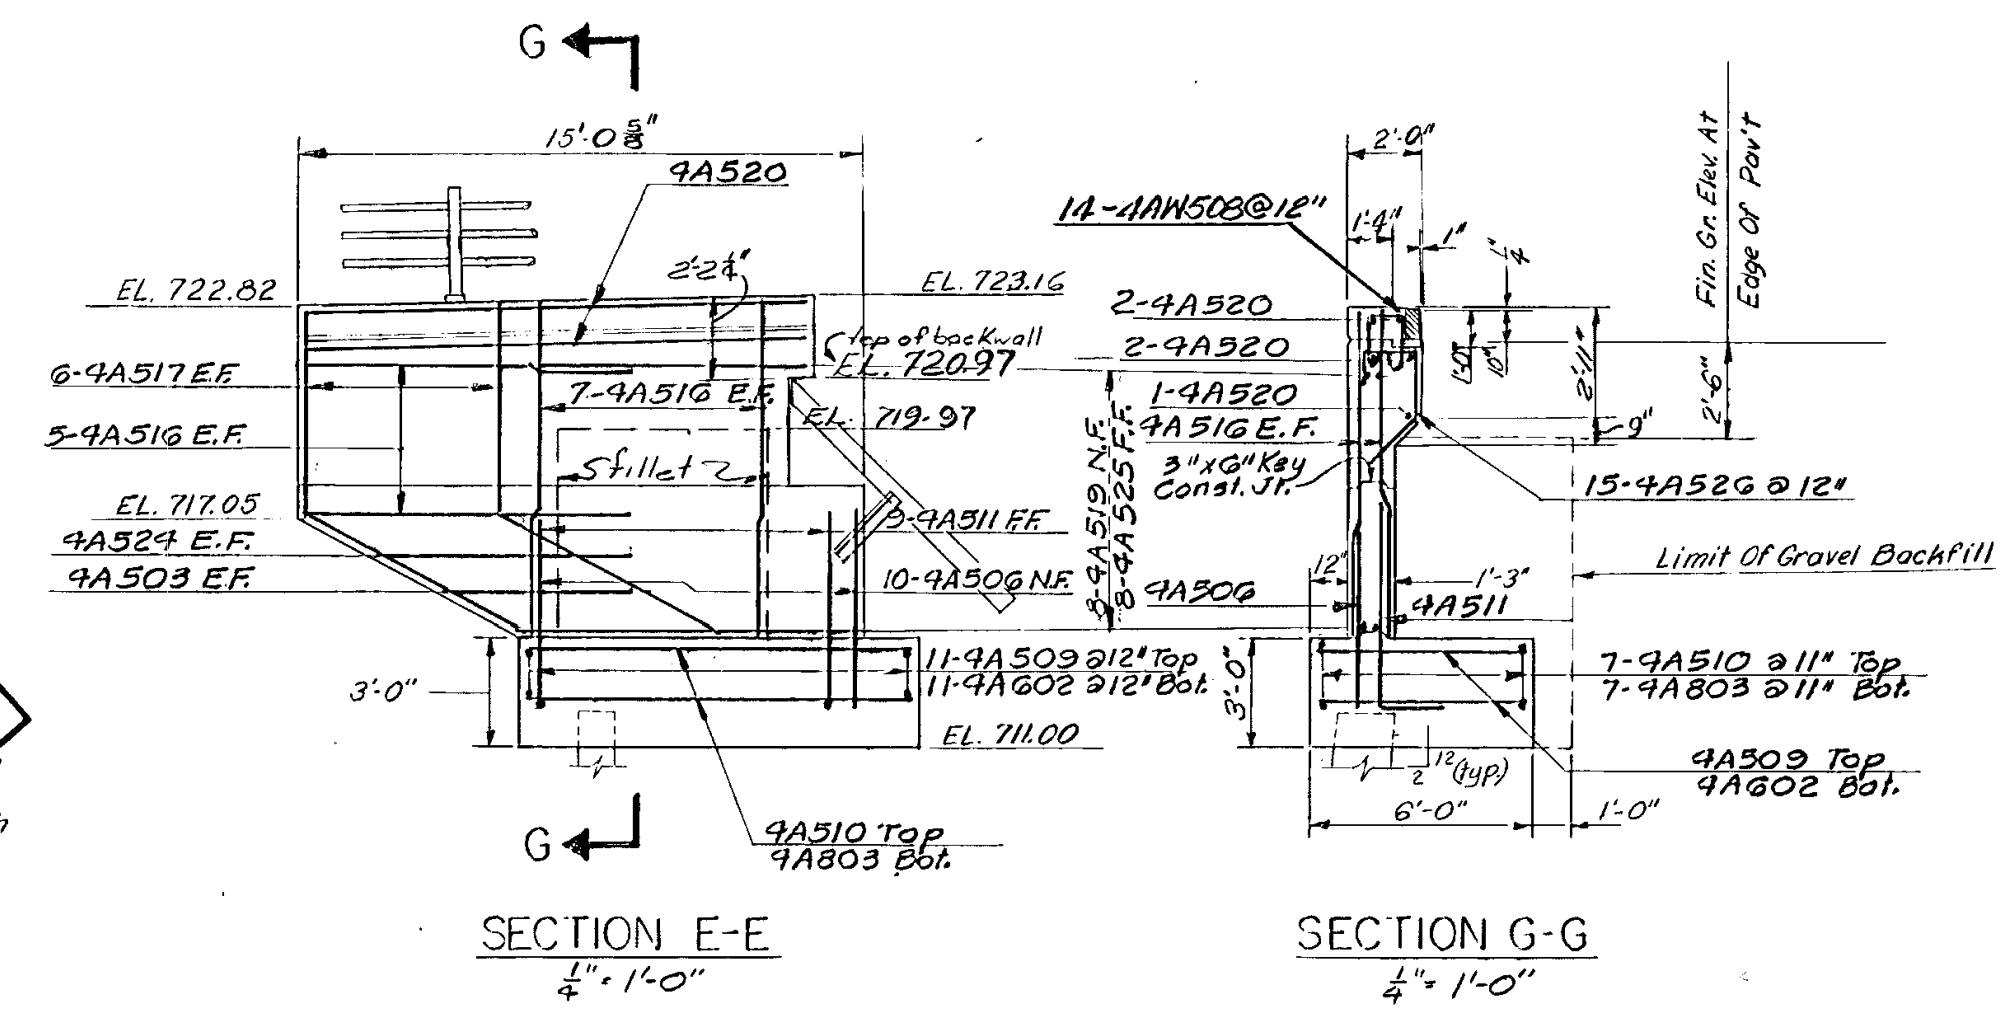


1 Same changes as on BR 113 - R 7850 3/69 Added Detail of Drain Trough - 5/1/69	
STATE OF VERMONT DEPARTMENT OF HIGHWAYS	
PROJECT IRASBURG	IRASBURG-DERBY
TOWN OF IRASBURG	IRASBURG-DERBY
ROUTE No. 191	STA 2539 ±
91 OVER BARTON RIVER AND SA#3	
ABUTMENT #4	
SCALE AS SHOWN	
IN CHARGE C. TERENZIO	
DRAWN BY D.L.	CHECKED BY A. CENTORE
PROJECT No. 191-3(8) 2-67.	
SHEET 184 OF 605 BR 115	

IRASBURG  
IM DECK(46)  
BRIDGE NO. 107N  
SHEET 41 OF 49  
FOR REFERENCE ONLY




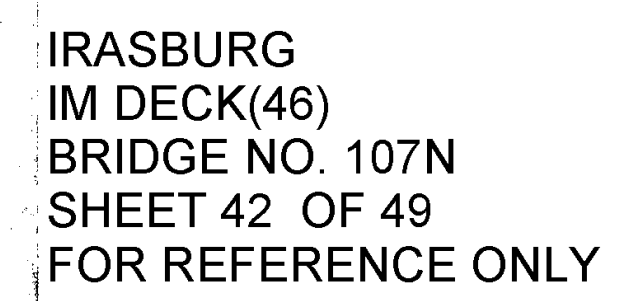




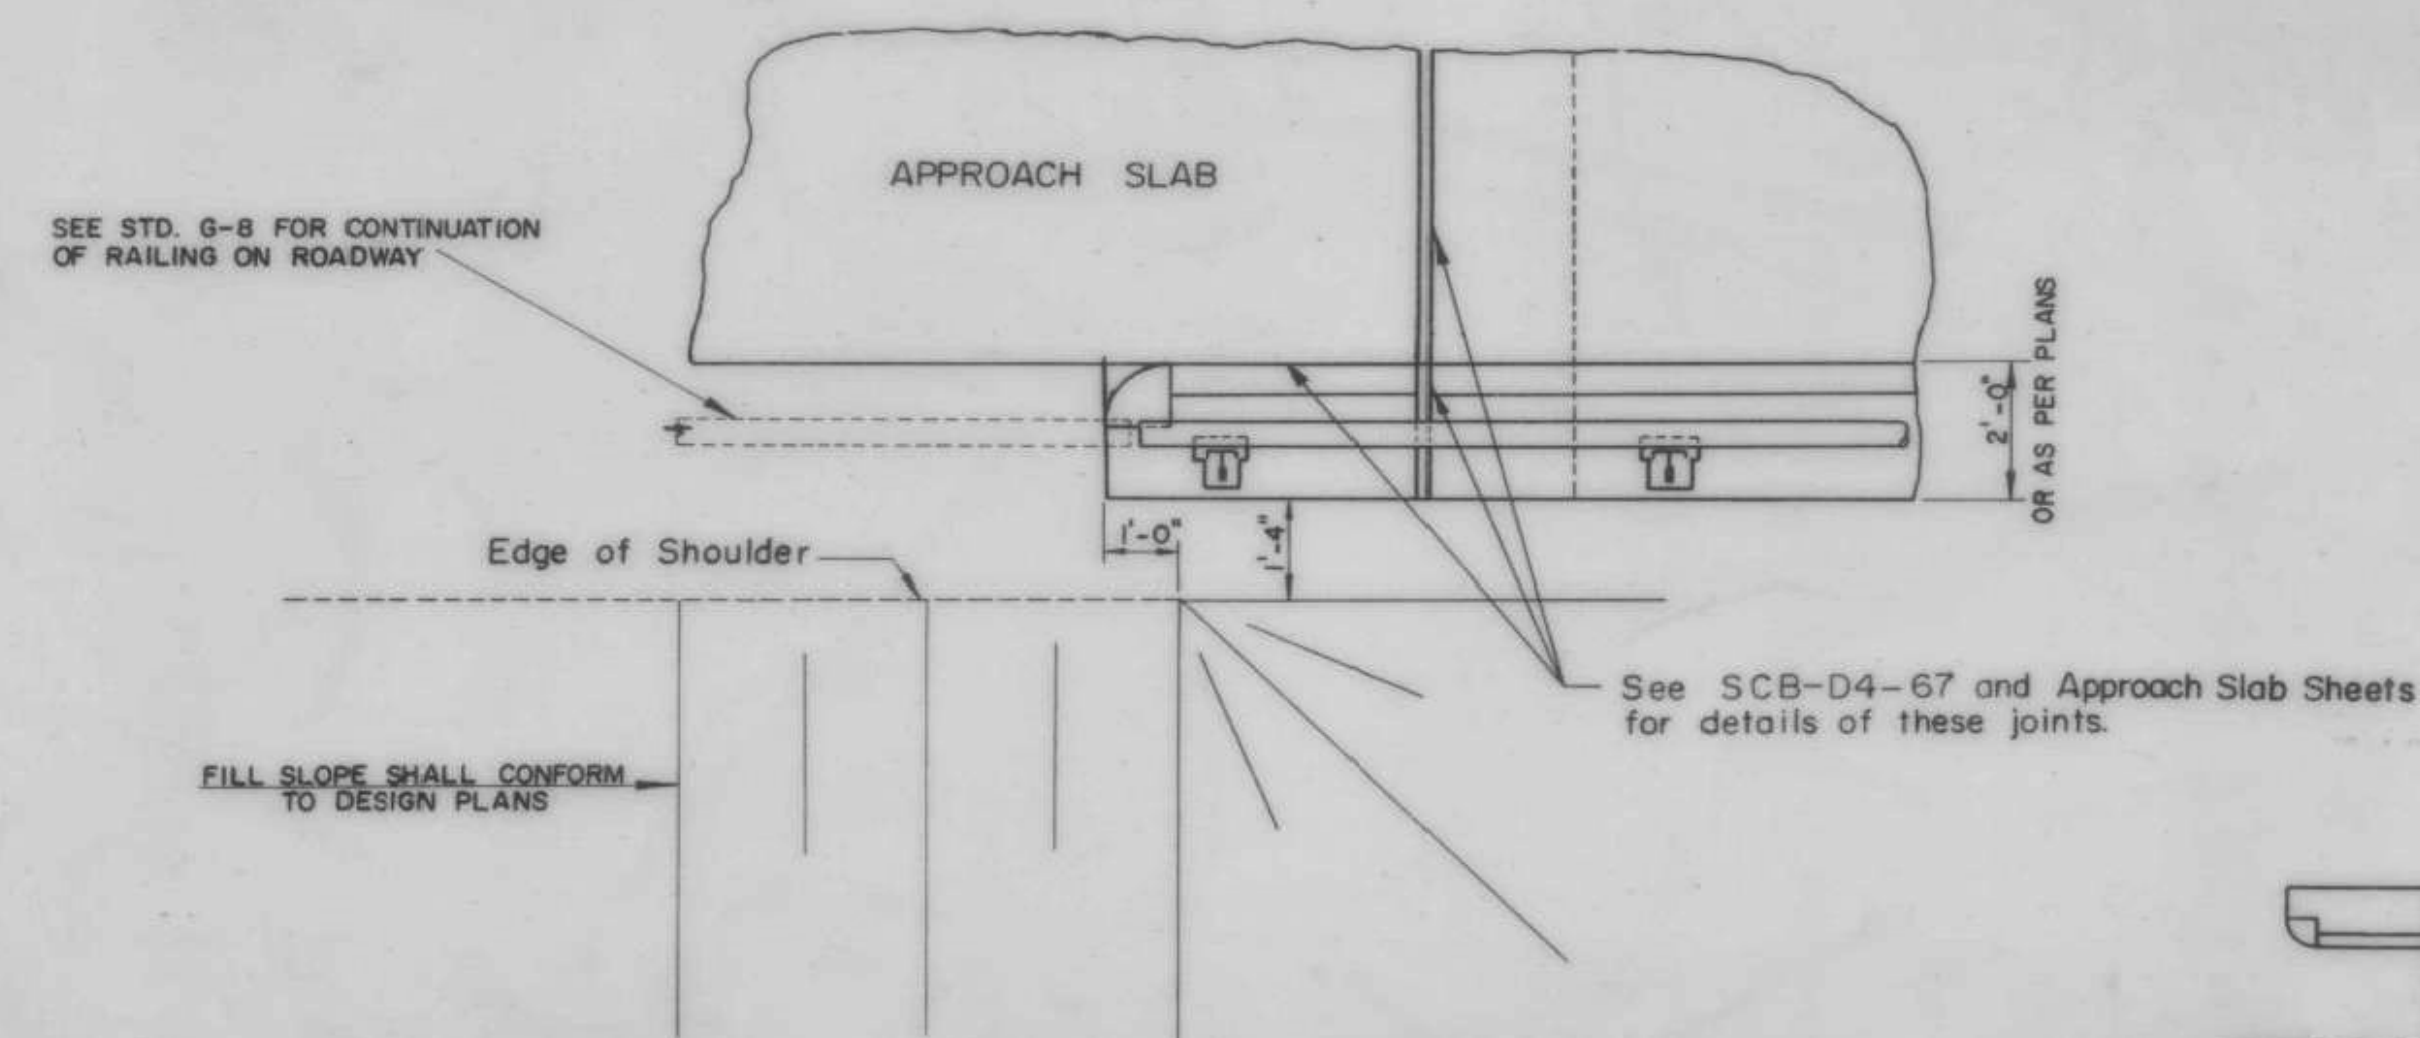

PLAN AT ABUTMENT

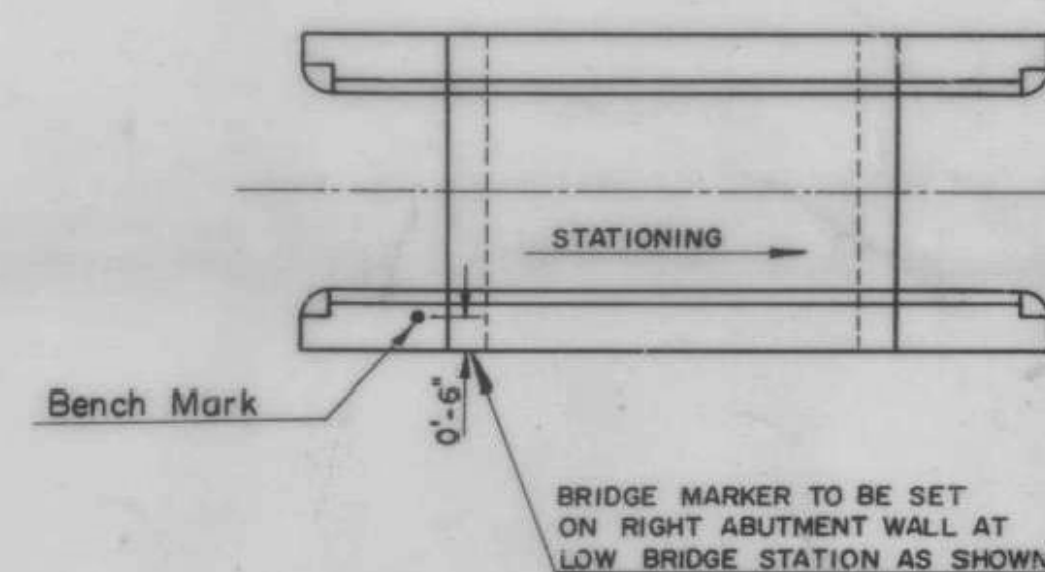

SECTION A-A

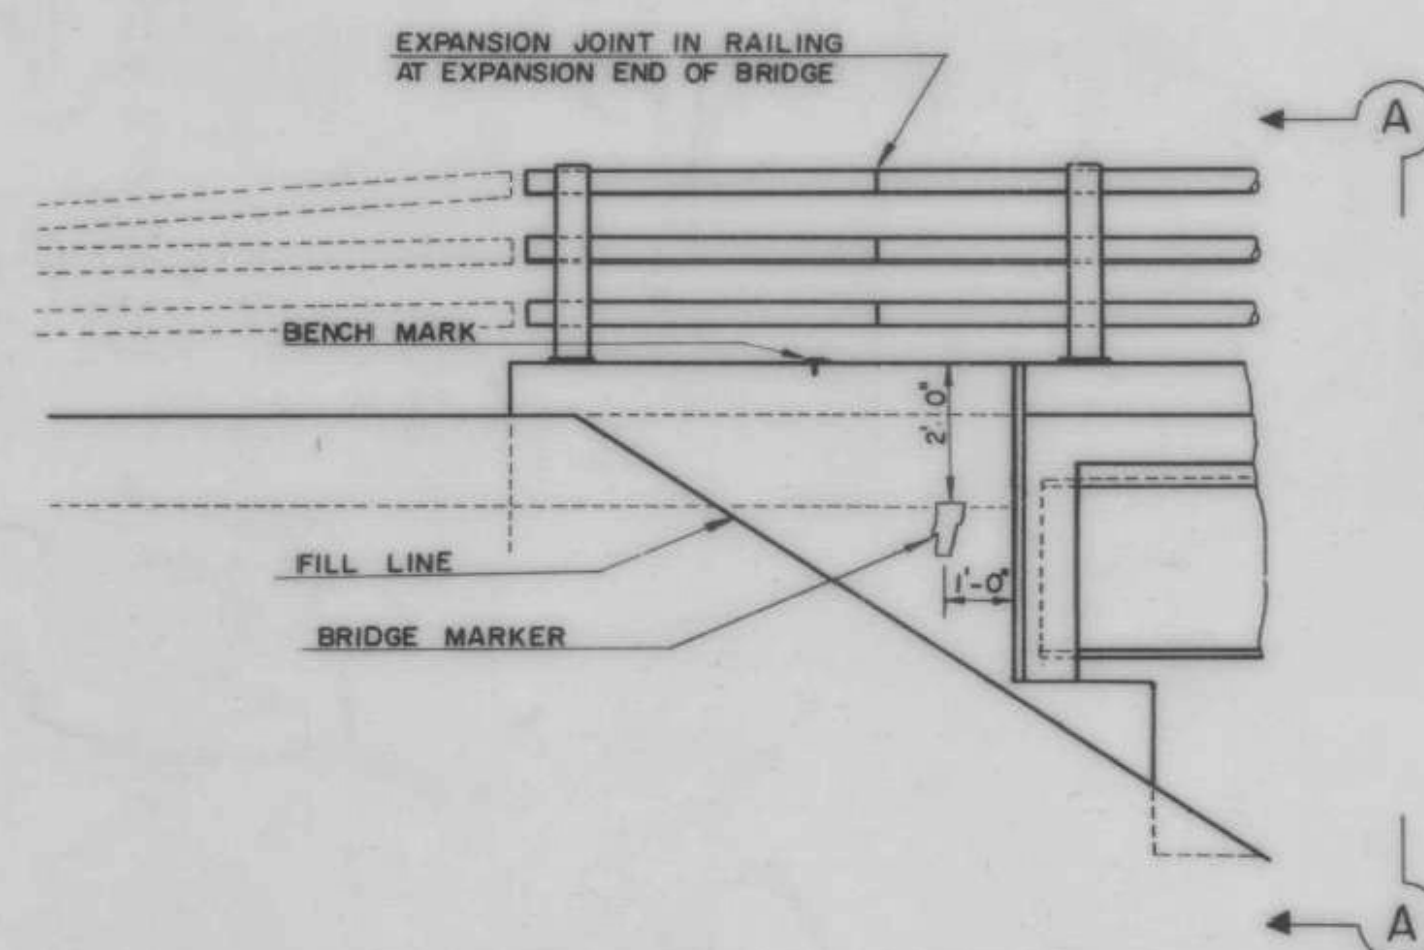

ELEVATION AT ABUTMENT

# GENERAL NOTES

ALL MATERIALS AND CONSTRUCTION SHALL CONFORM TO STATE OF VERMONT, DEPARTMENT OF HIGHWAYS, STANDARD SPECIFICATIONS FOR HIGHWAY AND BRIDGE CONSTRUCTION, DATED APRIL 1964, AND TO A.A.S.H.O. STANDARD SPECIFICATIONS FOR HIGHWAY BRIDGES, DATED 1965 AND ITS LATEST REVISIONS. DESIGN IS FOR HS20-44 LOADING MODIFIED FOR THE NATIONAL SYSTEM OF INTERSTATE HIGHWAYS, APPLIED IN ACCORDANCE WITH THE PROVISIONS OF A.A.S.H.O. STANDARD SPECIFICATIONS.

THE FOLLOWING NOTES SHALL APPLY UNLESS OTHERWISE NOTED ON PROJECT PLANS.

- ALL STRUCTURAL STEEL SHALL CONFORM TO A.S.T.M. DESIGNATION A-36. ALL FIELD CONNECTIONS SHALL BE MADE WITH 7/8" Ø A.S.T.M. A325 BOLTS IN 15/16" Ø HOLES. WHERE CONNECTIONS ARE NOT DETAILED ON THE PLANS THEY SHALL BE DETAILED BY THE FABRICATOR AND SUBMITTED TO THE STATE FOR APPROVAL.
- SIMPLE BEAMS SHALL BE CAMBERED FOR THE DEAD LOAD DEFLECTION PLUS ONE-EIGHTH (1/8) INCH FOR EACH TEN FEET OF SPAN OR FRACTION THEREOF. THE CAMBER SHALL APPROXIMATE A SIMPLE CIRCULAR CURVE FROM END TO END OF BEAM. TOLERANCES IN CAMBER SHALL BE AS INDICATED IN THE A.I.S.C. HANDBOOK FOR ROLLED BEAMS AND AS INDICATED IN THE A.W.S. SPECIFICATIONS FOR WELDED GIRDERS.
- THE DIMENSIONS OF WELDED STRUCTURAL MEMBERS SHALL BE WITHIN THE LIMITS SET UP IN PARAGRAPH 407, DIMENSIONAL TOLERANCES AWS D2.0-66, "SPECIFICATIONS FOR WELDED HIGHWAY AND RAILWAY BRIDGES".
- AFTER SUPERSTRUCTURE STEEL HAS BEEN ERECTED, ELEVATIONS AT INTERVALS ALONG THE TOP OF THE ERECTED BEAMS SHALL BE TAKEN UNDER THE DIRECTION OF THE ENGINEER FOR USE IN DETERMINING THE FINAL GRADE.
- SCUPPERS SHALL BE USED ONLY WHEN INDICATED ON THE PROJECT PLANS. THEY SHALL BE PLACED MIDWAY BETWEEN INTERMEDIATE DIAPHRAGMS. ON SUPERELEVATED BRIDGES PLACE SCUPPERS ON LOW SIDE ONLY. PAYMENT FOR SCUPPERS SHALL BE AT THE UNIT PRICE BID FOR STRUCTURAL STEEL, ITEM 404-A.
- CHANNEL SHEAR CONNECTORS MAY BE SUBSTITUTED FOR THE STUDS SHOWN ON THE STANDARDS. DETAILS OF SHEAR CONNECTORS SHALL BE SUBMITTED TO THE STATE FOR APPROVAL.
- THE FINAL COAT OF FIELD PAINT SHALL BE GREEN.
- ALL CONCRETE IN THE SUPERSTRUCTURE SHALL BE CLASS AA, MODIFIED. ALL EXPOSED EDGES OF CONCRETE IN THE SUBSTRUCTURE AND SUPERSTRUCTURE SHALL BE CHAMFERED 1" X 1".
- SLAB REINFORCING STEEL FOR SKEWED BRIDGES SHALL BE MODIFIED FROM THAT INDICATED ON THE STANDARDS FOR SQUARE SPANS AS FOLLOWS:
  - TRANSVERSE BARS SHALL BE FURNISHED AS FOR A SQUARE SPAN. THESE BARS SHALL BE CUT IN THE FIELD TO FIT ONE END, WITH CUT-OFF BARS USED AT THE OPPOSITE END OF THE SPAN.
  - THE S506 BARS SHALL BE LENGTHENED.
  - THE QUANTITY OF S502 AND S 602 BARS SHALL BE INCREASED.
  - S506 AND S507 BARS SHALL BE INCREASED.
- SPIRAL COLUMN REINFORCEMENT SHALL CONFORM TO A.A.S.H.O. SPECIFICATION M-32 COLD DRAWN STEEL WIRE FOR CONCRETE REINFORCEMENT.
- MINIMUM COVER FOR REINFORCING STEEL SHALL BE 2" MEASURED FROM THE CONCRETE SURFACE TO THE FACE OF THE REINFORCEMENT.
- LAYOUT AND DETAIL DRAWINGS FOR GRANITE BRIDGE CURB, ITEM 556-C, SHALL BE SUBMITTED IN TRIPLICATE TO THE STATE OF VERMONT FOR APPROVAL PRIOR TO FABRICATION AND SHIPMENT. GRANITE CURB ENDS SHALL BE SAWS ON EACH SIDE OF ALL JOINTS WHERE JOINT SEALER - PREFORMED, ITEM 372-C IS USED OR WHERE THE CURB BUTTS A METAL EXPANSION JOINT. GRANITE CURB SHALL BE FURNISHED IN RANDOM LENGTHS RANGING FROM 4' MINIMUM TO 10' MAXIMUM.
- WATER REPELLENT, ITEM 440, SHALL BE APPLIED TO ALL EXPOSED CONCRETE SURFACES NOT OTHERWISE TREATED IN BOTH SUPERSTRUCTURE AND SUBSTRUCTURE, EXCEPT FOR THAT PORTION OF THE DECK SLAB AND CURTAIN OR BACKWALLS BETWEEN FASCIA BEAMS.
- TOP SURFACES OF ALL PIERS AND ABUTMENTS SHALL BE SLOPED 1/2" PER FOOT EXCEPT UNDER BEARING PLATES WHERE THE SURFACES SHALL BE LEVEL. ABUTMENT BRIDGE SEATS SHALL BE SLOPED FROM THE FRONT EDGE OF THE CURTAIN WALL OR BACKWALL, AND PIER BRIDGE SEATS SHALL BE SLOPED FROM THE CENTERLINE OF PIER.
- THE ENTIRE EXPOSED TOP SURFACE OF THE ABUTMENTS AND PIERS, EXCEPT THE TOP OF ABUTMENT WINGS SHALL BE COATED WITH ASPHALTIC-ASBESTOS COATING ITEM 407. THIS ITEM SHALL BE APPLIED AFTER ALL PAINTING AND INCIDENTAL ITEMS ARE COMPLETED.
- ALL EXPANSION MATERIAL SHALL CONFORM TO A.A.S.H.O. DESIGNATION M153, AND SHALL NOT CONTAIN ASPHALT OR BITUMINOUS MATERIAL.
- WHERE BITUMINOUS CONCRETE PAVEMENT IS CALLED FOR AS A WEARING SURFACE ON BRIDGE DECKS AND APPROACH SLABS, IT SHALL BE TYPE IV MIX APPLIED IN TWO COURSES.
- BORINGS INDICATED ON THE DRAWINGS HAVE BEEN MADE FOR DESIGN PURPOSES ONLY AND ARE NOT WARRANTED TO SHOW ACTUAL SUB-SURFACE CONDITIONS.
- ALL DIMENSIONS ARE HORIZONTAL OR VERTICAL.
- ALLOWABLE DESIGN STRESSES:

CONCRETE:  $f'_c = 3,000$  P.S.I.  $f_c = 1,200$  P.S.I.

STRUCTURAL STEEL:  $F_y = 20,000$  P.S.I. - A36 (ALL OTHER STEELS AS PER A.A.S.H.O. SPECIFICATIONS)

REINFORCING STEEL:  $F_y = 20,000$  P.S.I. TENSION  
 $F_y = 16,000$  P.S.I. COMPRESSION

- WHEN PILE SUPPORTED SUBSTRUCTURES ARE PLACED ON EMBANKMENTS, THE CONSTRUCTION PROCEDURE OUTLINED UNDER ITEM 503, ARTICLE 503.03A SHALL BE FOLLOWED. MATERIAL REMOVED WITHIN THE SIX (6) INCH DEPTH SHALL BE PAID FOR AS STRUCTURE EXCAVATION, ITEM 109.

VERMONT  
 DEPARTMENT OF HIGHWAYS  
 STRUCTURE STANDARDS  
 SCB-D1-67  
 242A 242A

## REVISIONS AND CORRECTIONS

DRAWN BY: W.T. JAN. 1965  
 RETRACED BY: AJA MAY 1967  
 CHECKED BY: W.M. Smith DEC. 1967


RECOMMENDED FOR APPROVAL: [Signature] BRIDGE ENGINEER  
 RECOMMENDED FOR APPROVAL: [Signature] CONSTRUCTION ENGINEER  
 RECOMMENDED FOR APPROVAL: [Signature] ASST. CHIEF ENGINEER  
 APPROVED BY: [Signature] CHIEF ENGINEER DATE: 10/4/68

## DETAILS OF W BEAM BRIDGES GENERAL INFORMATION AND GENERAL NOTES





VERMONT  
 DEPARTMENT OF HIGHWAYS  
 STRUCTURE STANDARDS

SCB-D1-67



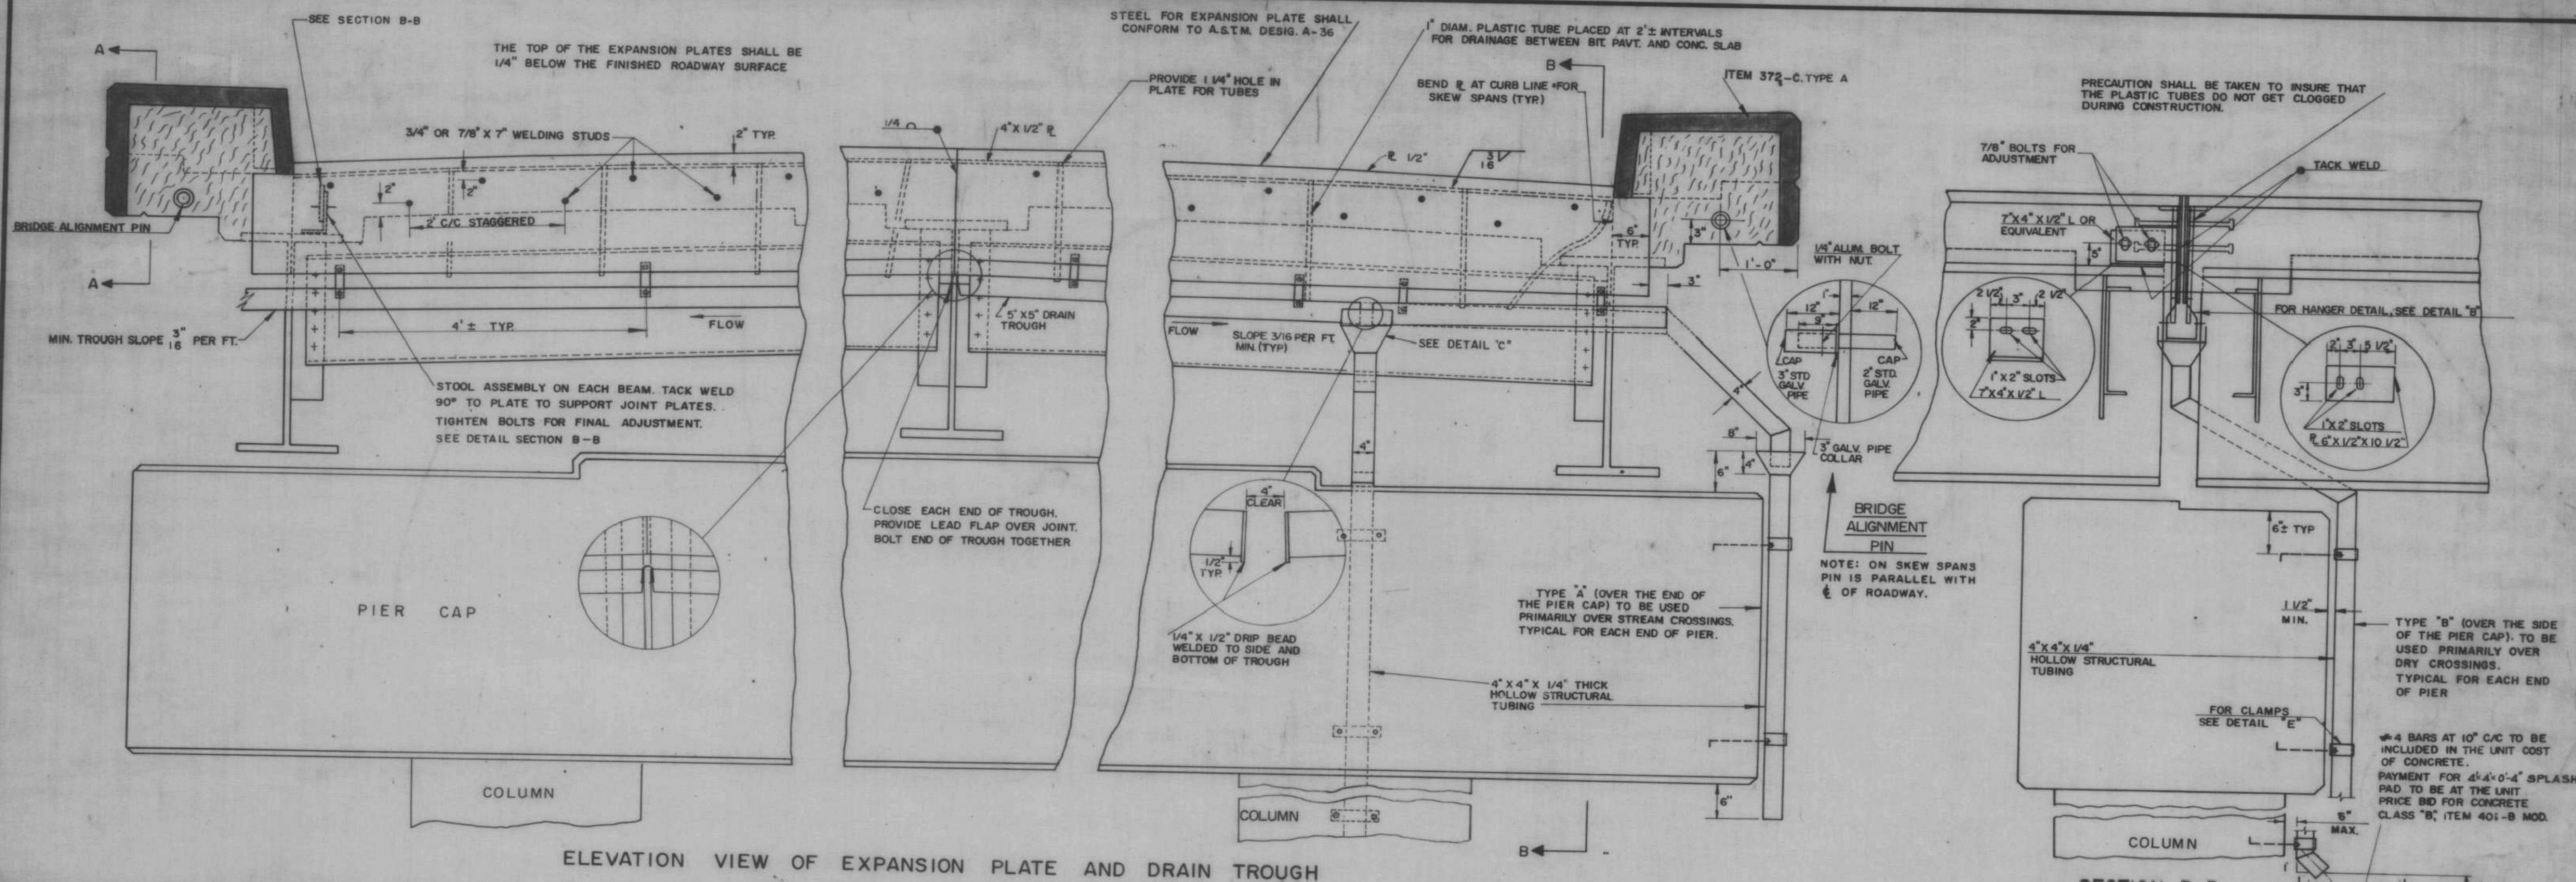

ELEVATION VIEW OF EXPANSION PLATE AND DRAIN TROUGH

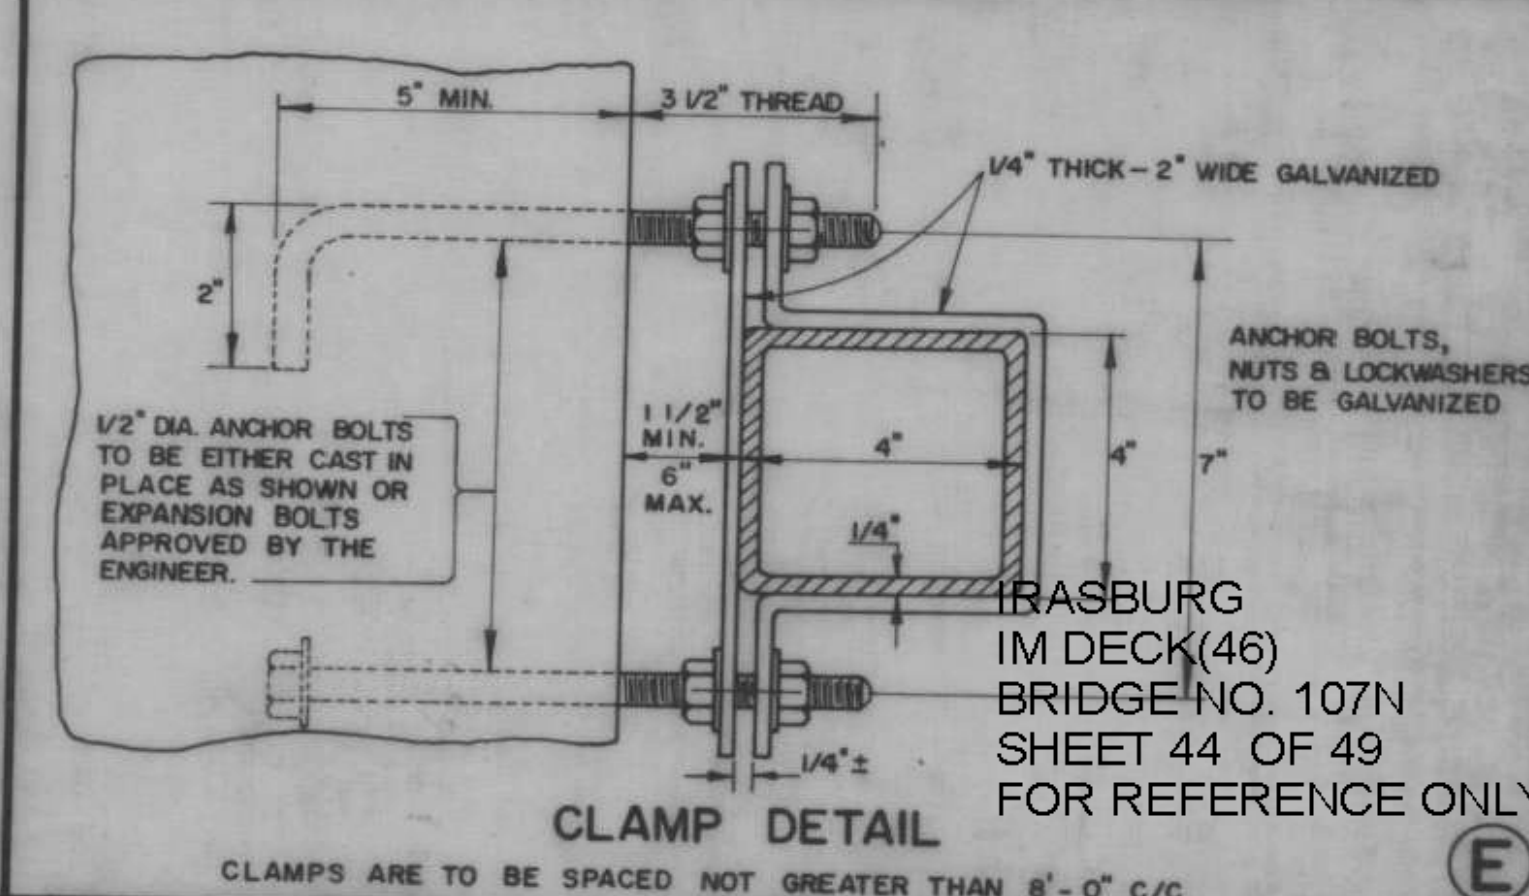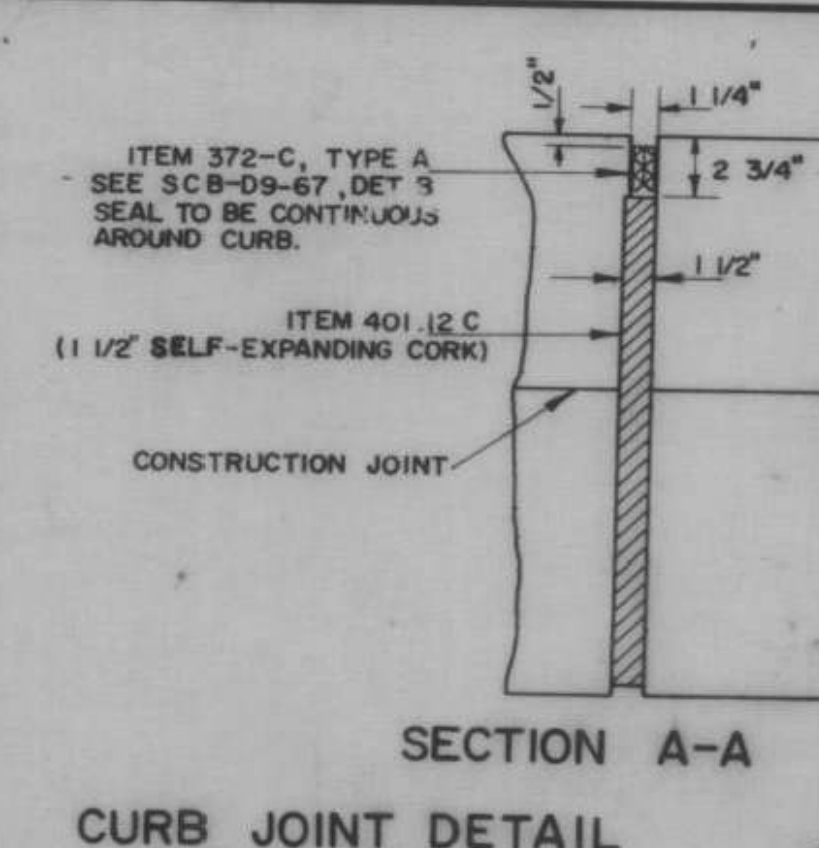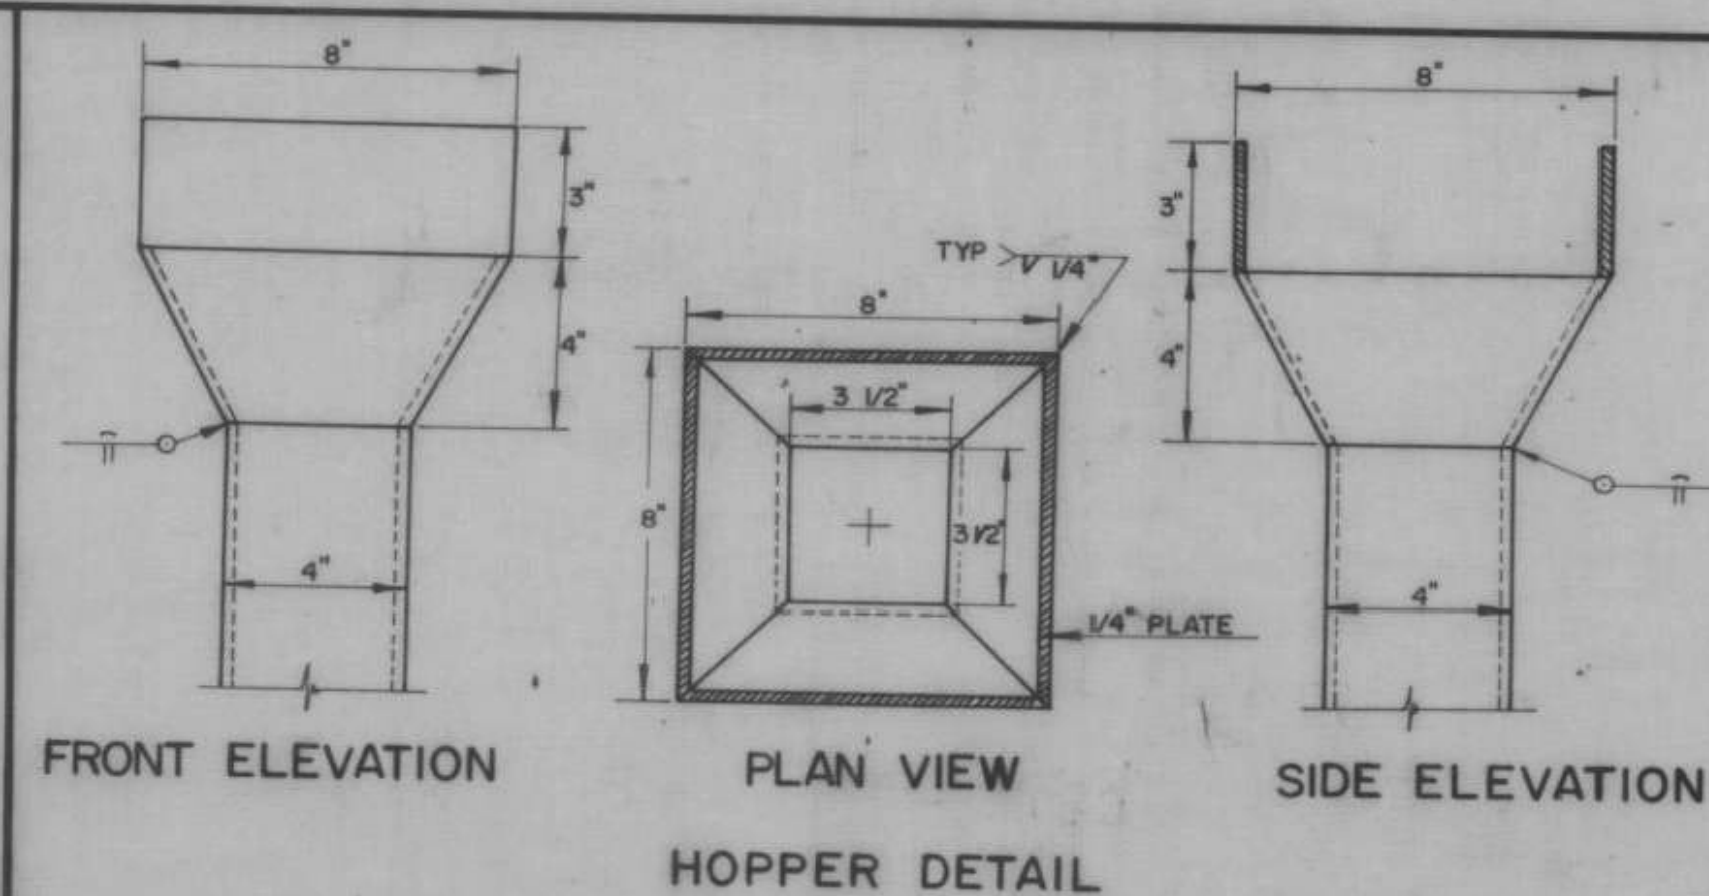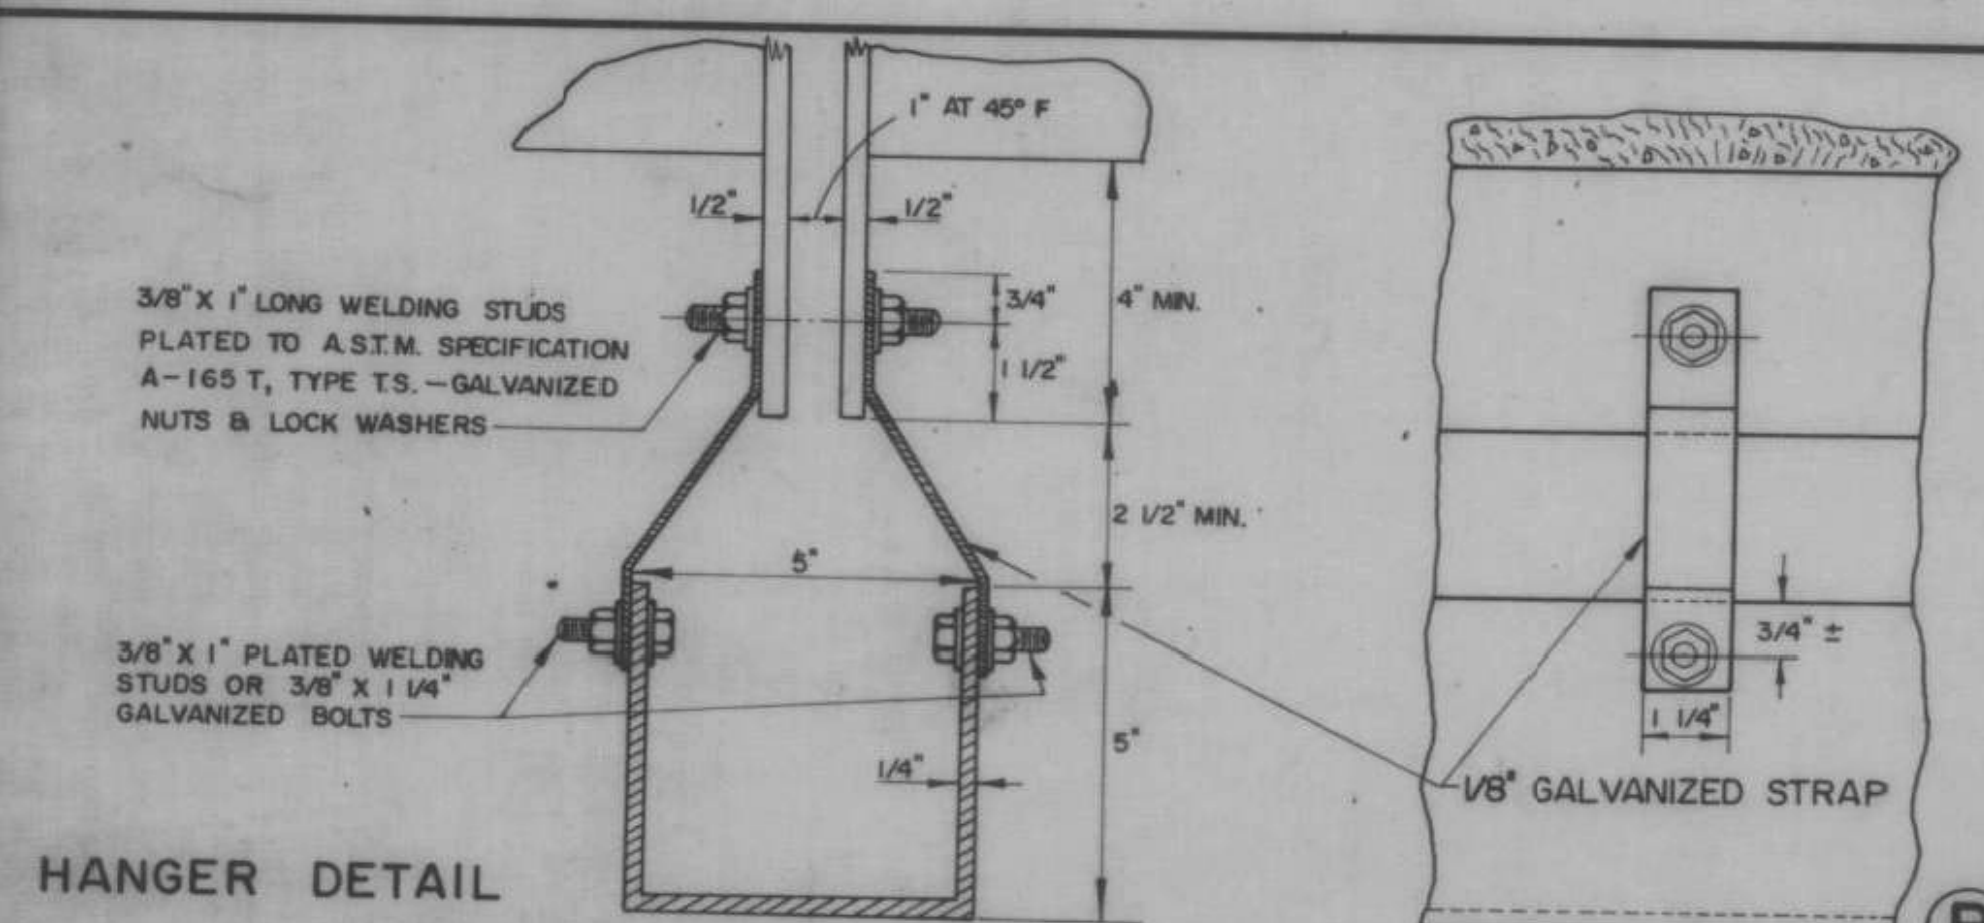

REVISIONS AND CORRECTIONS

DRAWN BY: A. V. DEC. 1962

RETRACTED BY: A.J.A. MAY 1967

CHECKED BY: W. SMITH DEC. 1967

RECOMMENDED FOR APPROVAL: *[Signature]* 1/24/68

RECOMMENDED FOR APPROVAL: *[Signature]* 1/24/68

RECOMMENDED FOR APPROVAL: *[Signature]* 1/24/68

APPROVED BY: *[Signature]* 1/24/68


CHIEF ENGINEER

DATE


# DETAIL OF W BEAM BRIDGES PIER EXPANSION PLATES AND DRAIN TROUGH DETAILS

VERMONT  
DEPARTMENT OF HIGHWAYS  
STANDARD STRUCTURES  
SCB-D3-67



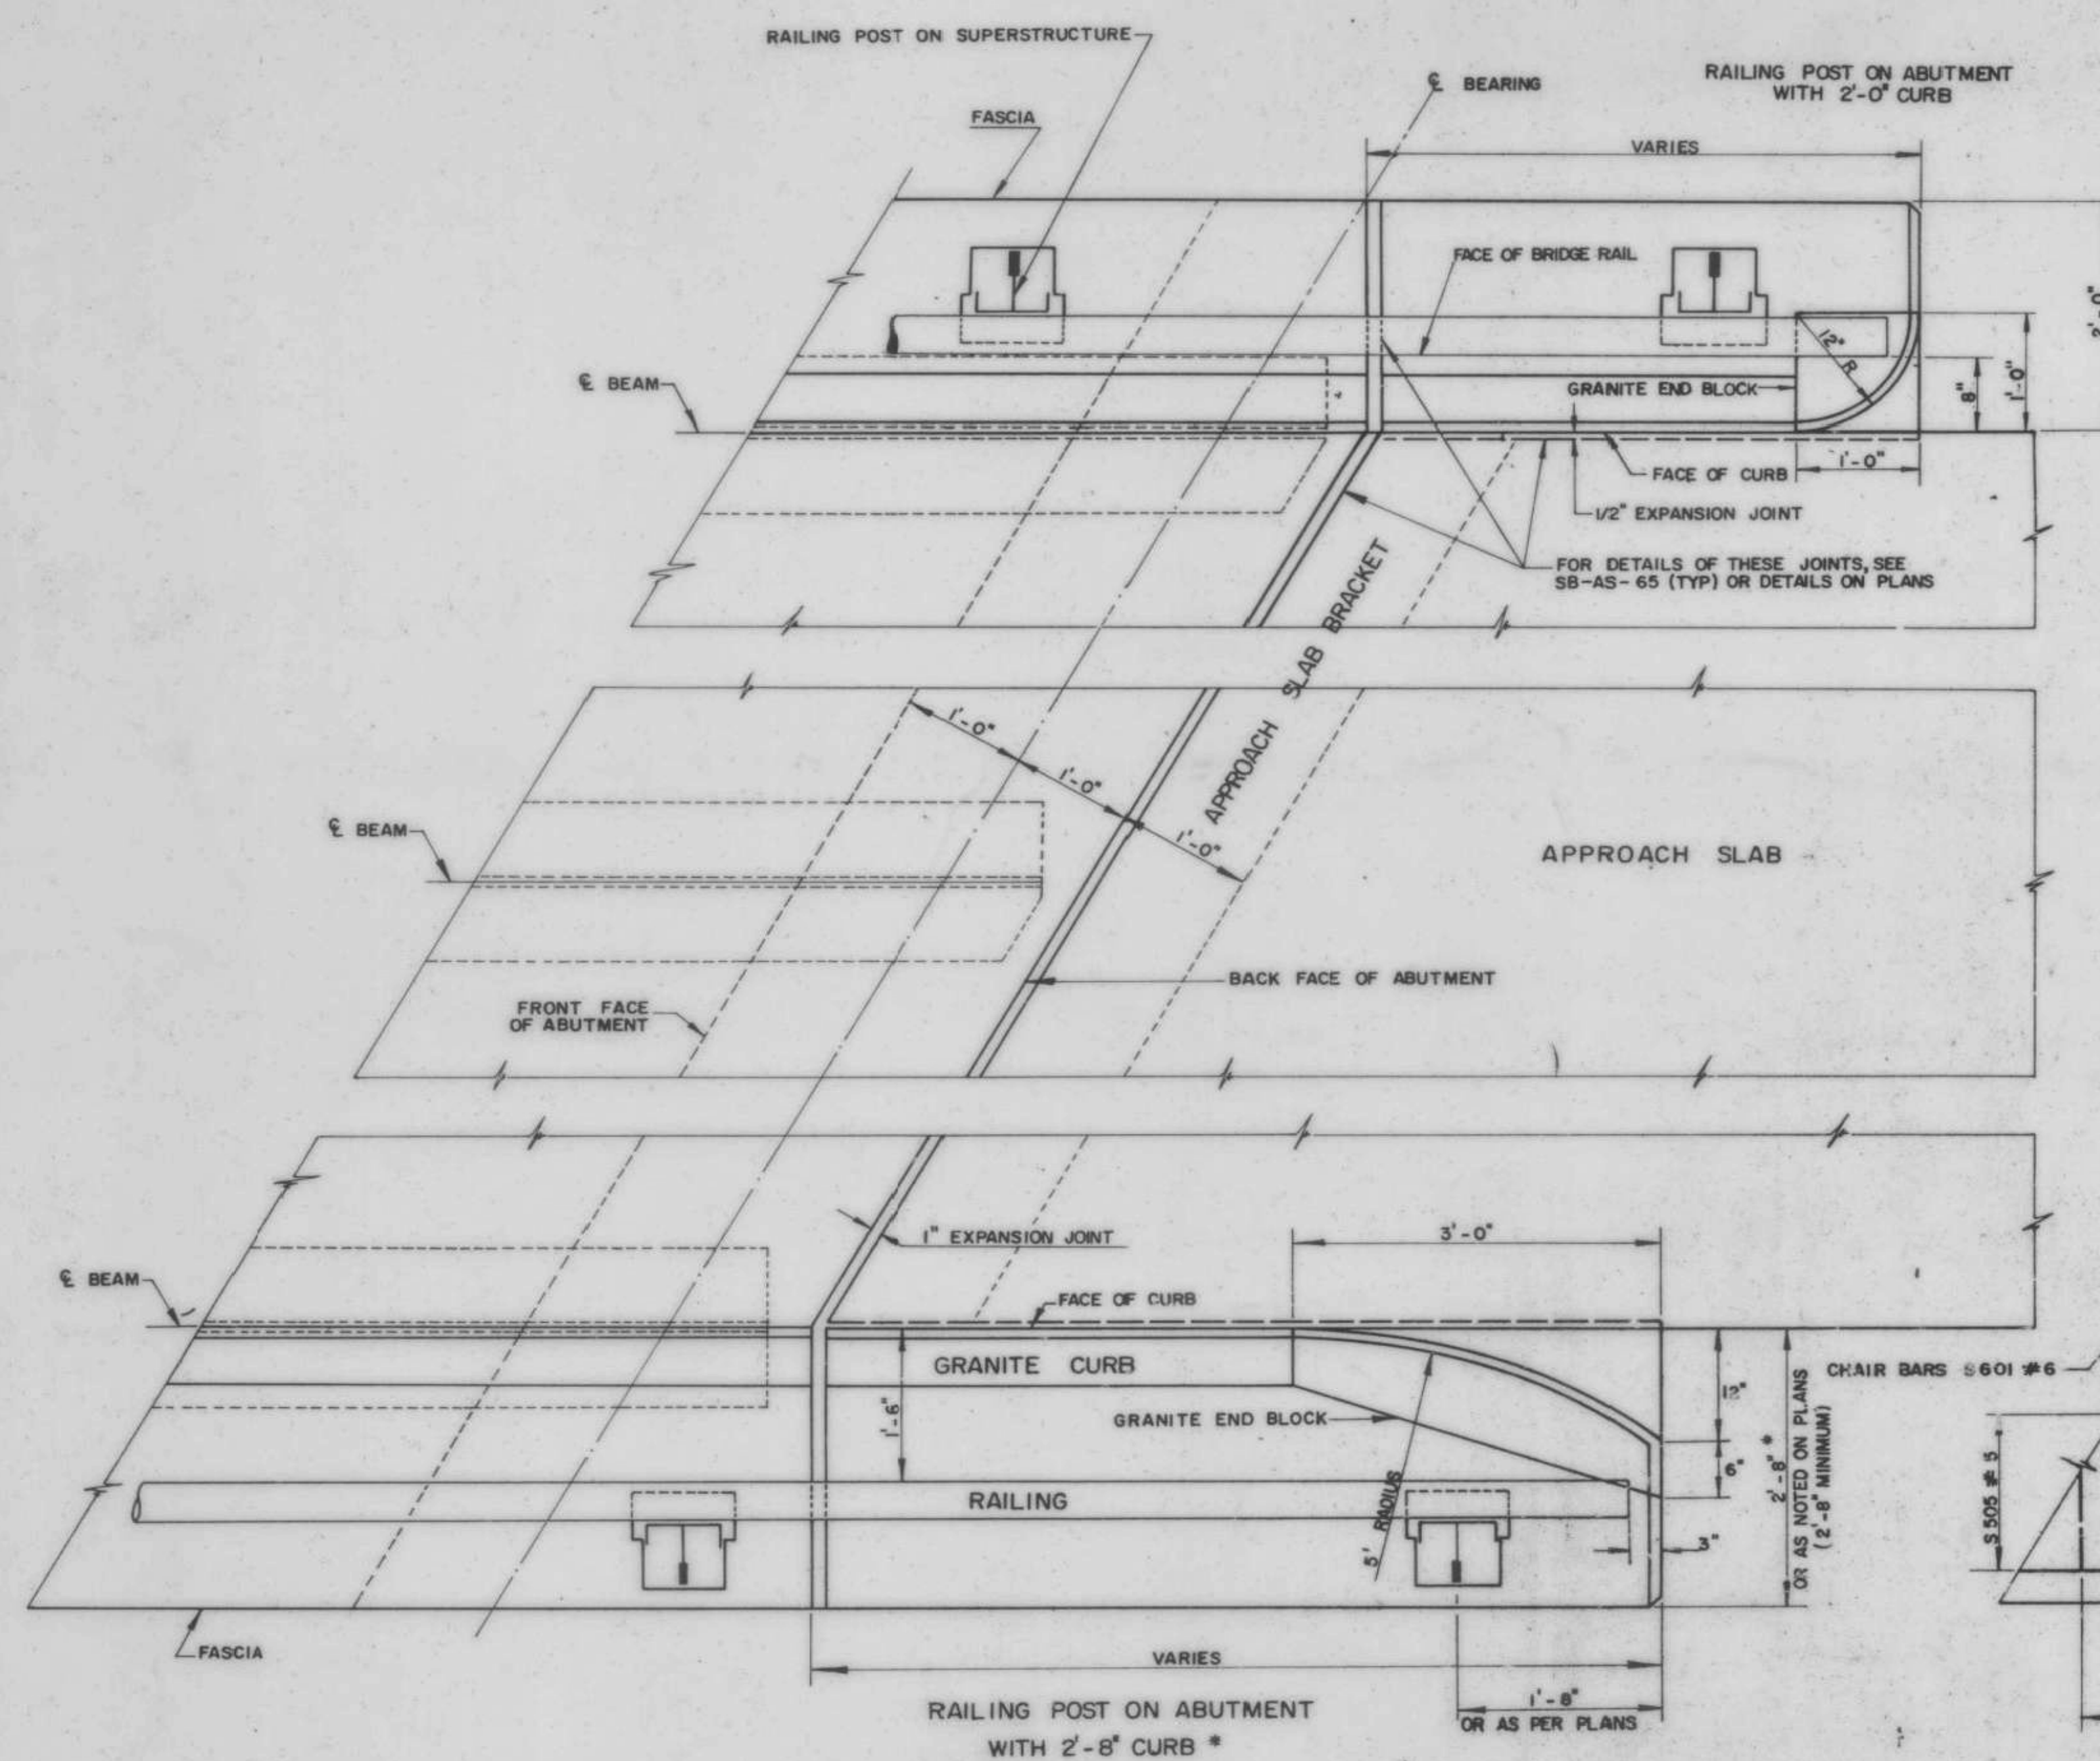

PLAN AT ABUTMENT

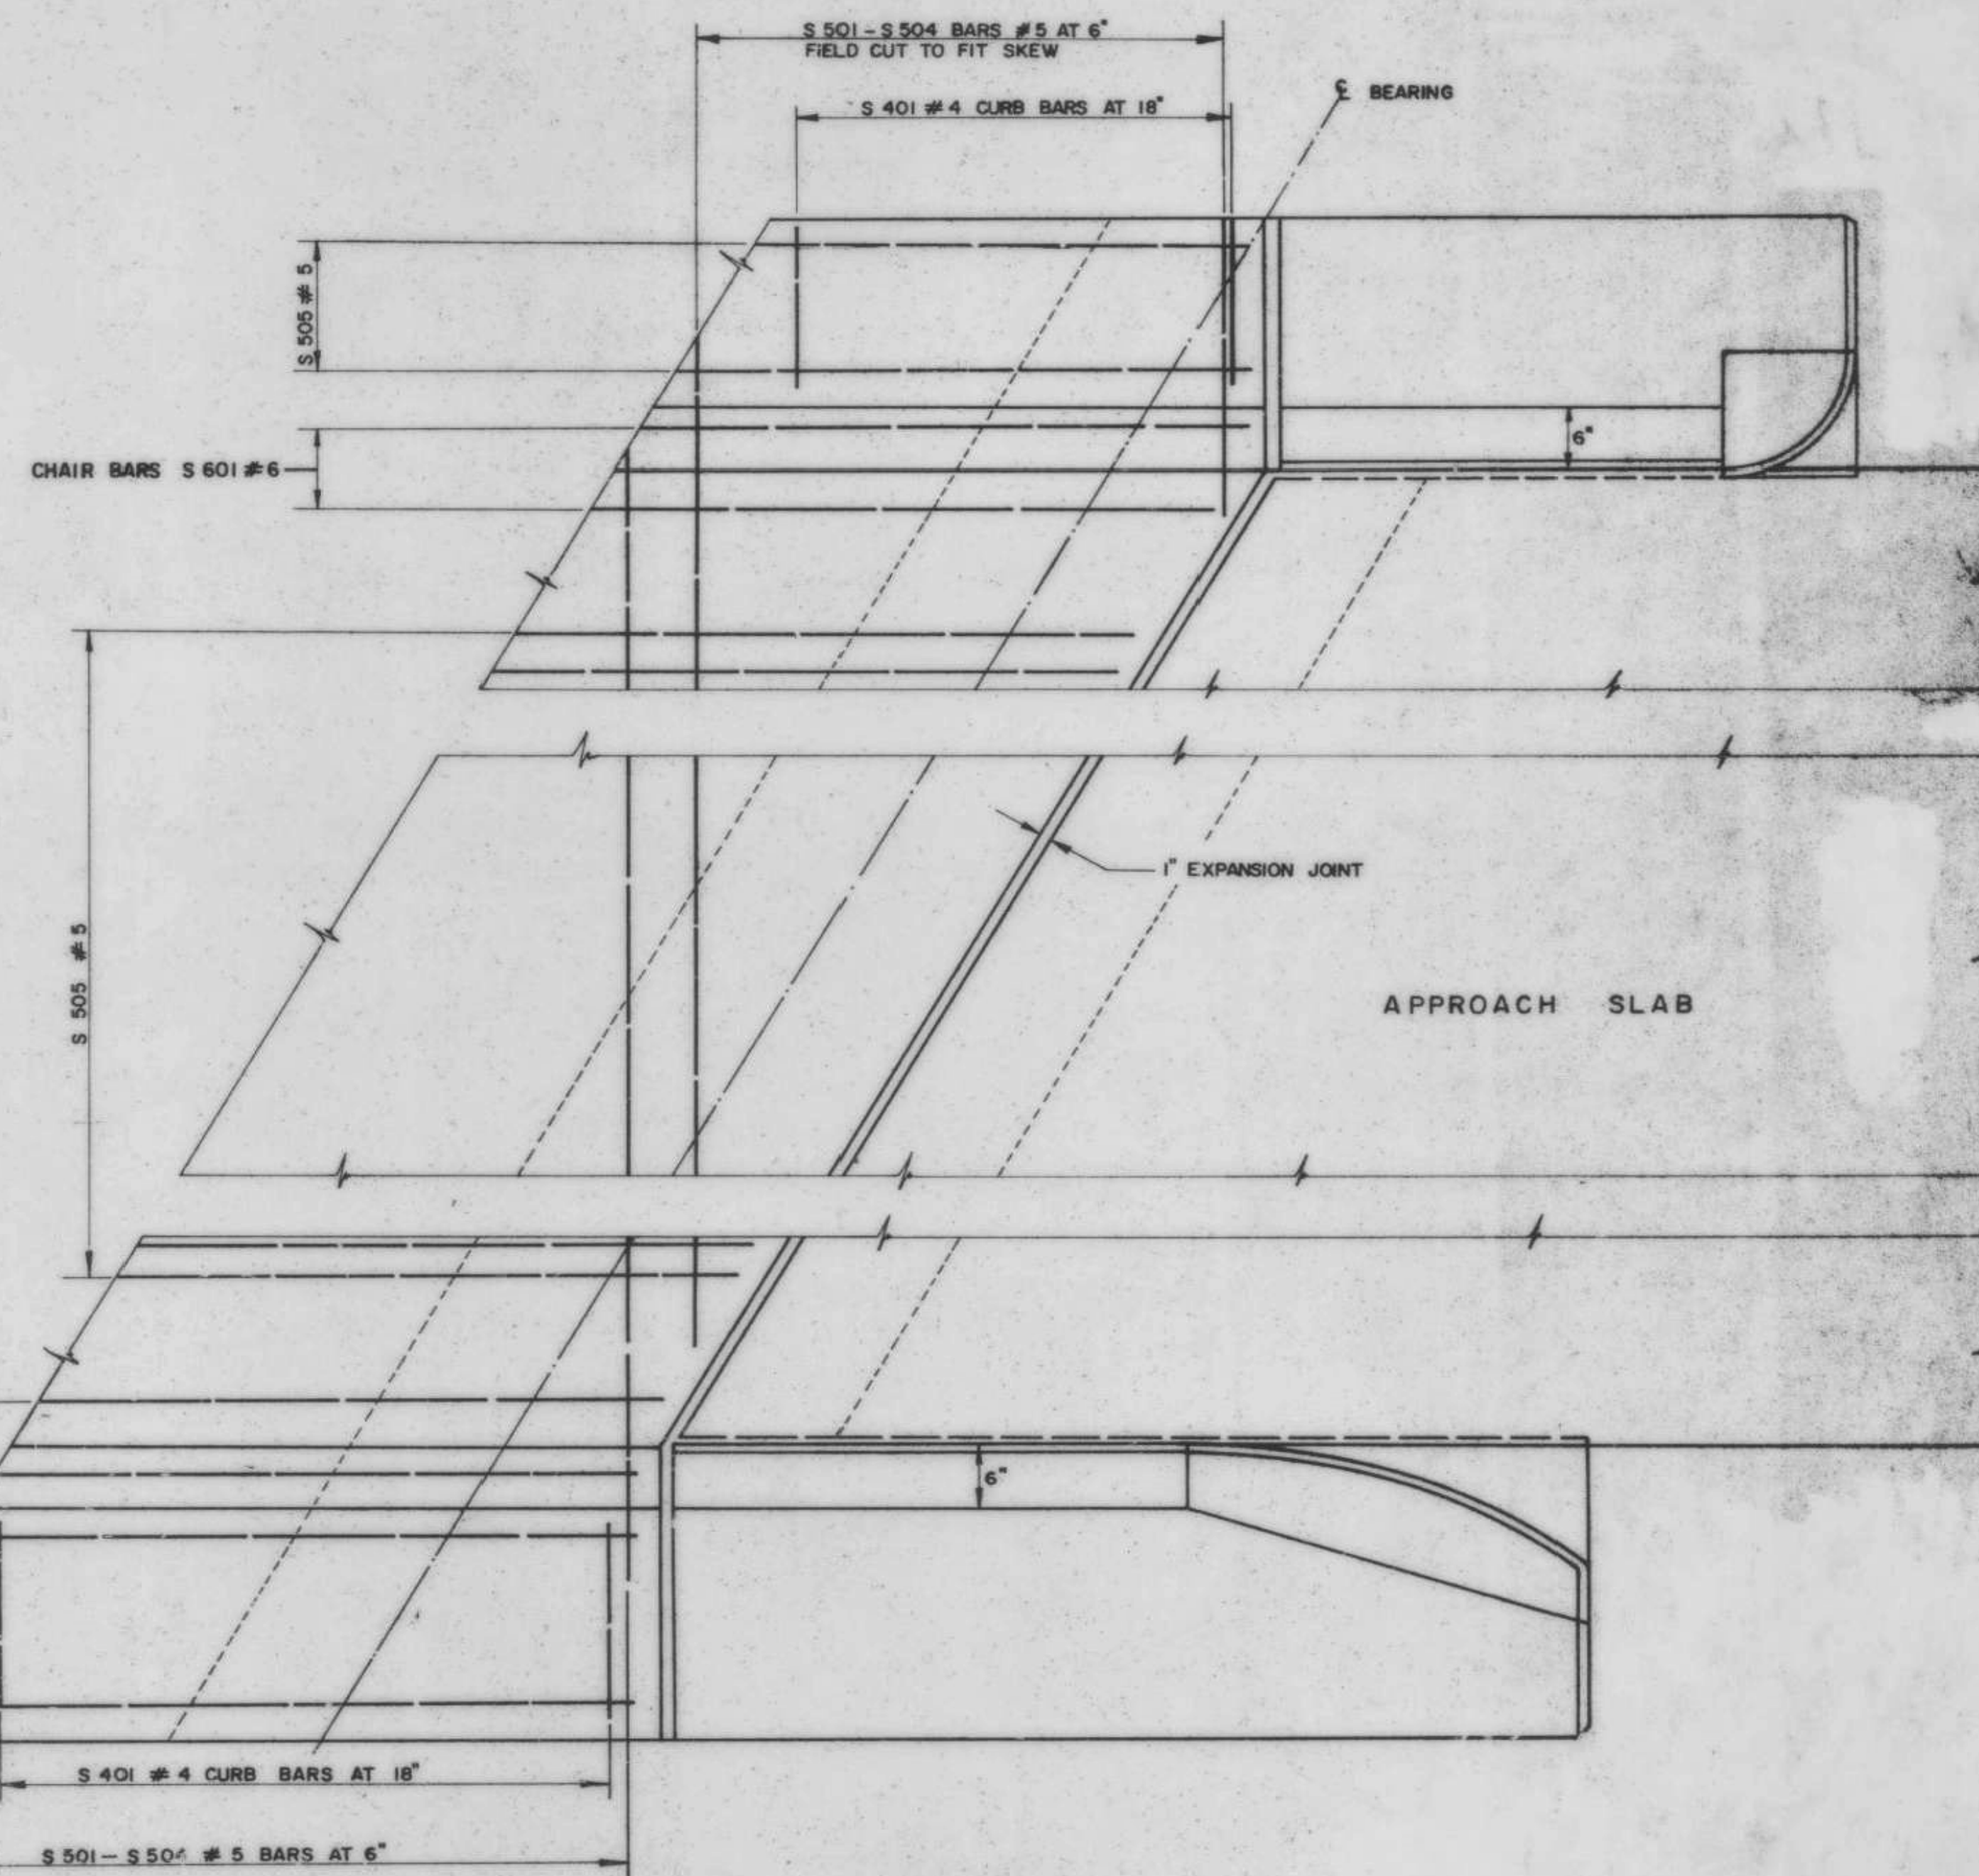

REINFORCEMENT LAYOUT AT ABUTMENT

* NOTE: DETAILS FOR "RAILING POST ON ABUTMENT WITH 2'-8" CURB" SHALL NOT BE USED ON FEDERAL AID PROJECTS.

IRASBURG  
IM DECK(46)  
BRIDGE NO. 107N  
SHEET 45 OF 49  
FOR REFERENCE ONLY

REVISIONS AND CORRECTIONS  
1. NOTE CONCERNING 2'-8" CURB SECTION ADDED DEC. 17, 1968 R.S.H.

DRAWN BY: A.V. DEC. 1962  
RETRACED BY: A.J.A. MAY 1967  
CHECKED BY: W. SMITH DEC. 1967

RECOMMENDED FOR APPROVAL  
RECOMMENDED FOR APPROVAL  
RECOMMENDED FOR APPROVAL  
APPROVED BY: *[Signature]* 1/24/68  
CHIEF ENGINEER DATE

# DETAILS OF W BEAM BRIDGES PLAN AND REINFORCEMENT LAYOUT AT ABUTMENT


VERMONT  
DEPARTMENT OF HIGHWAYS  
STRUCTURE STANDARDS

# SCB-D4-67







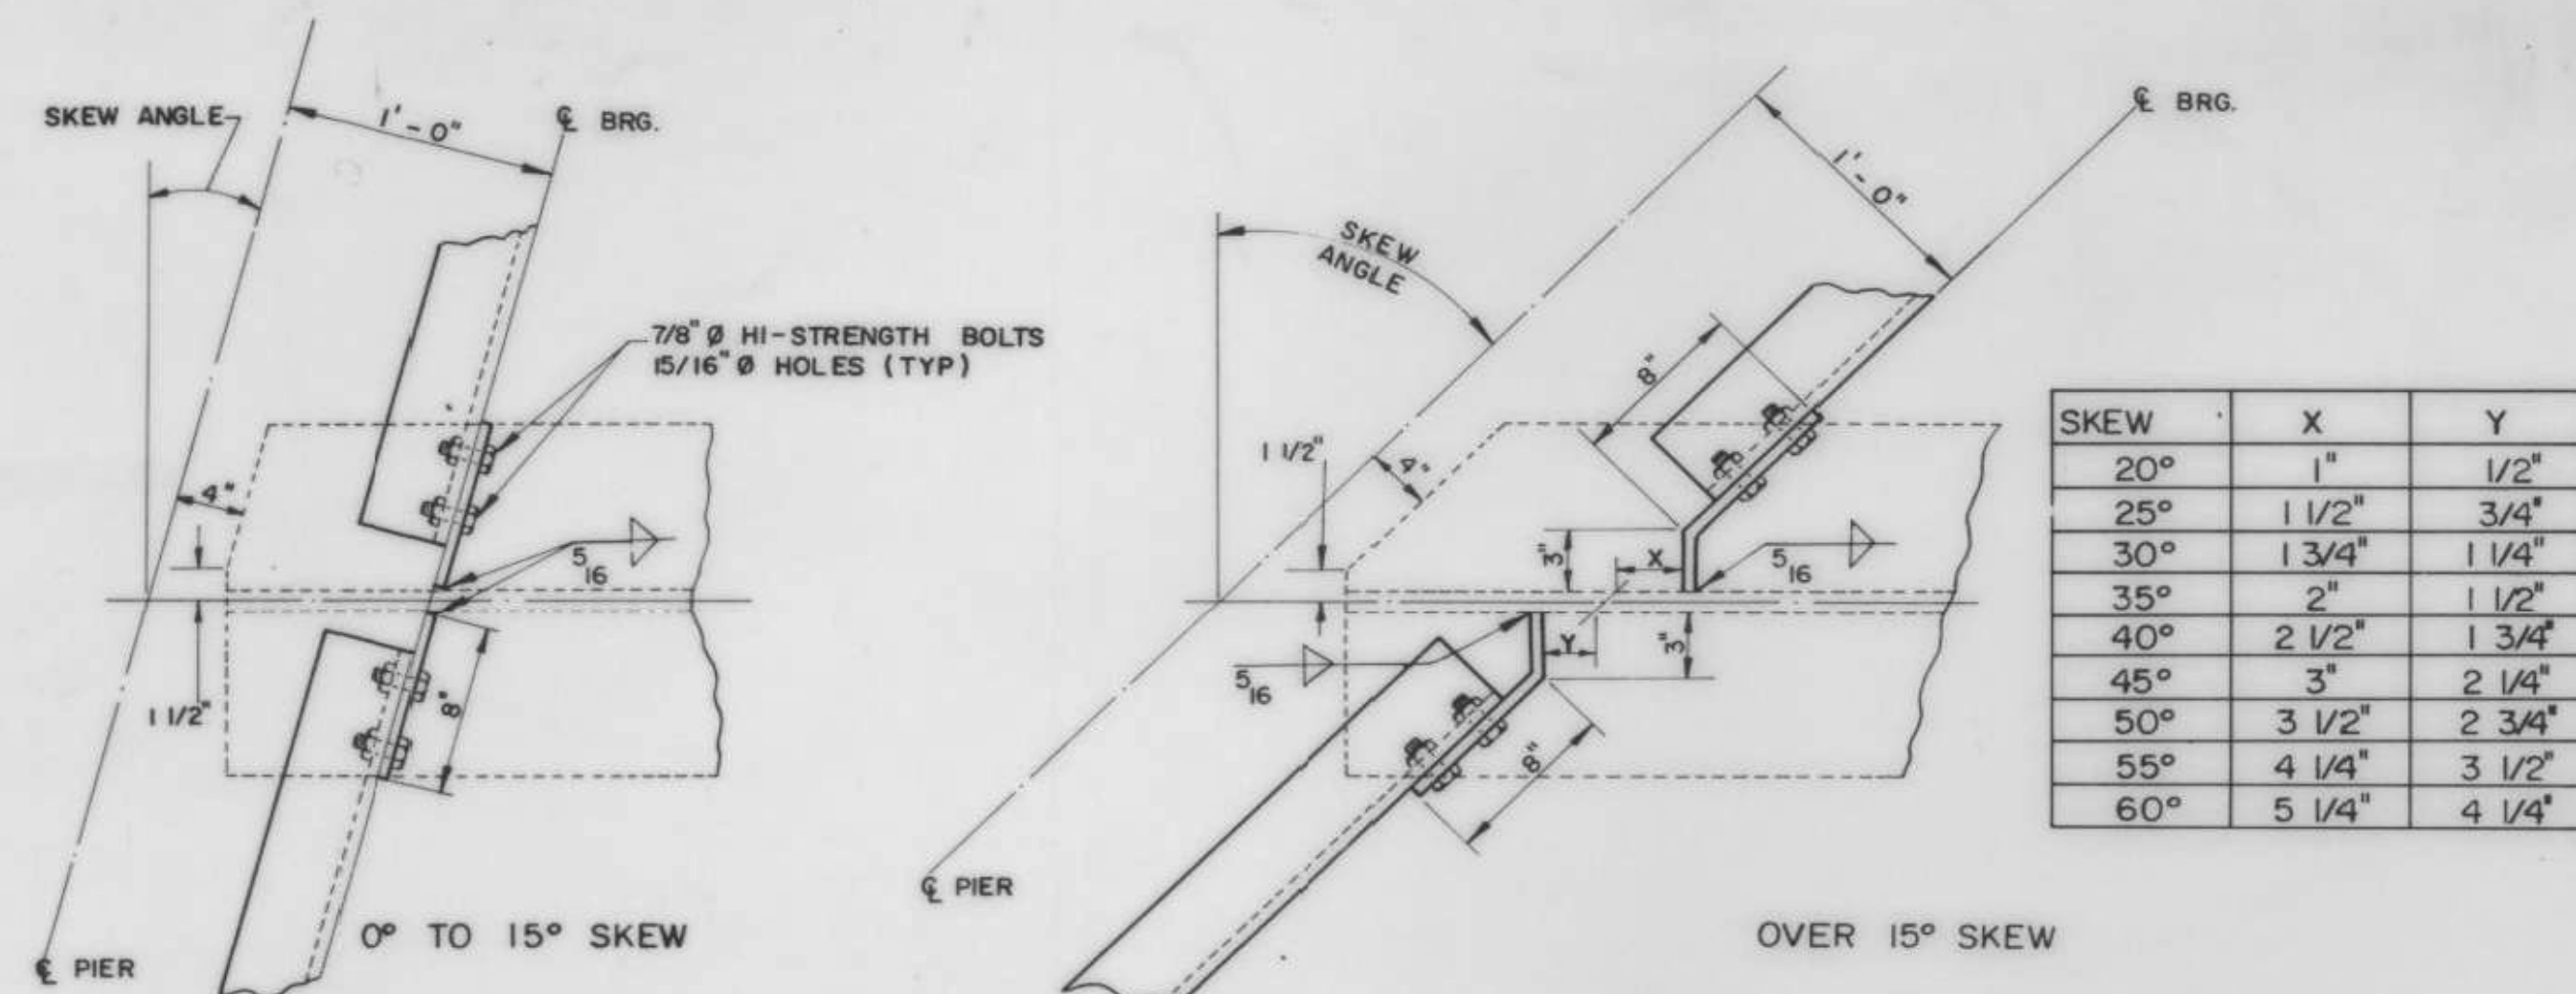


DETAILS OF PIER DIAPHRAGM CONNECTIONS


7'-6" BEAM SPACING - S.C.B. - 24-67

SPAN	COVER PLATE LENGTH	WIDTH	THICKNESS	TAPER	WELD "A"	WELD "B"	L I
99'-0"	64'-10"	15"	2 1/4"	1'-10"	3/8"	5/8"	2'-5"
94'-0"	62'-2"	15"	2"	1'-10"	3/8"	5/8"	2'-1"
89'-0"	56'-6"	15"	1 5/8"	1'-10"	3/8"	1/2"	2'-3"
84'-0"	57'-4"	11"	1 3/4"	1'-4"	3/8"	1/2"	1'-8"
79'-0"	50'-9"	11"	1 3/8"	1'-4"	5/16"	1/2"	1'-4"
74'-0"	48'-9"	11"	1 1/4"	1'-4"	5/16"	1/2"	1'-4"
69'-0"	43'-0"	11"	1"	1'-4"	5/16"	3/8"	1'-6"
64'-0"	40'-9"	11"	3/4"	1'-4"	5/16"	5/16"	---
59'-0"	30'-9"	11"	1/2"	1'-4"	5/16"	5/16"	---
54'-0"	18'-9"	11"	1/2"	1'-4"	5/16"	5/16"	---


7' - 4" BEAM SPACING S.C.B. - 30, 38, 44-67						
COVER PL LENGTH	WIDTH	THICK- NESS	TAPER	WELD "A"	WELD "B"	L I
60' - 0"	15"	2 1/4"	1' - 10"	3/8"	5/8"	2' - 5"
60' - 2"	15"	2"	1' - 10"	3/8"	5/8"	2' - 1"
54' - 6"	15"	1 1/2"	1' - 10"	5/16"	1/2"	2' - 3"
55' - 4"	11"	1 5/8"	1' - 4"	3/8"	1/2"	1' - 8"
48' - 9"	11"	1 1/8"	1' - 4"	5/16"	1/2"	1' - 4"
46' - 9"	11"	1"	1' - 4"	5/16"	1/2"	1' - 4"
45' - 0"	11"	1"	1' - 4"	5/16"	3/8"	1' - 6"
38' - 9"	11"	3/4"	1' - 4"	5/16"	5/16"	—
28' - 9"	11"	1/2"	1' - 4"	5/16"	5/16"	—
14' - 9"	11"	1/2"	1' - 4"	5/16"	5/16"	—

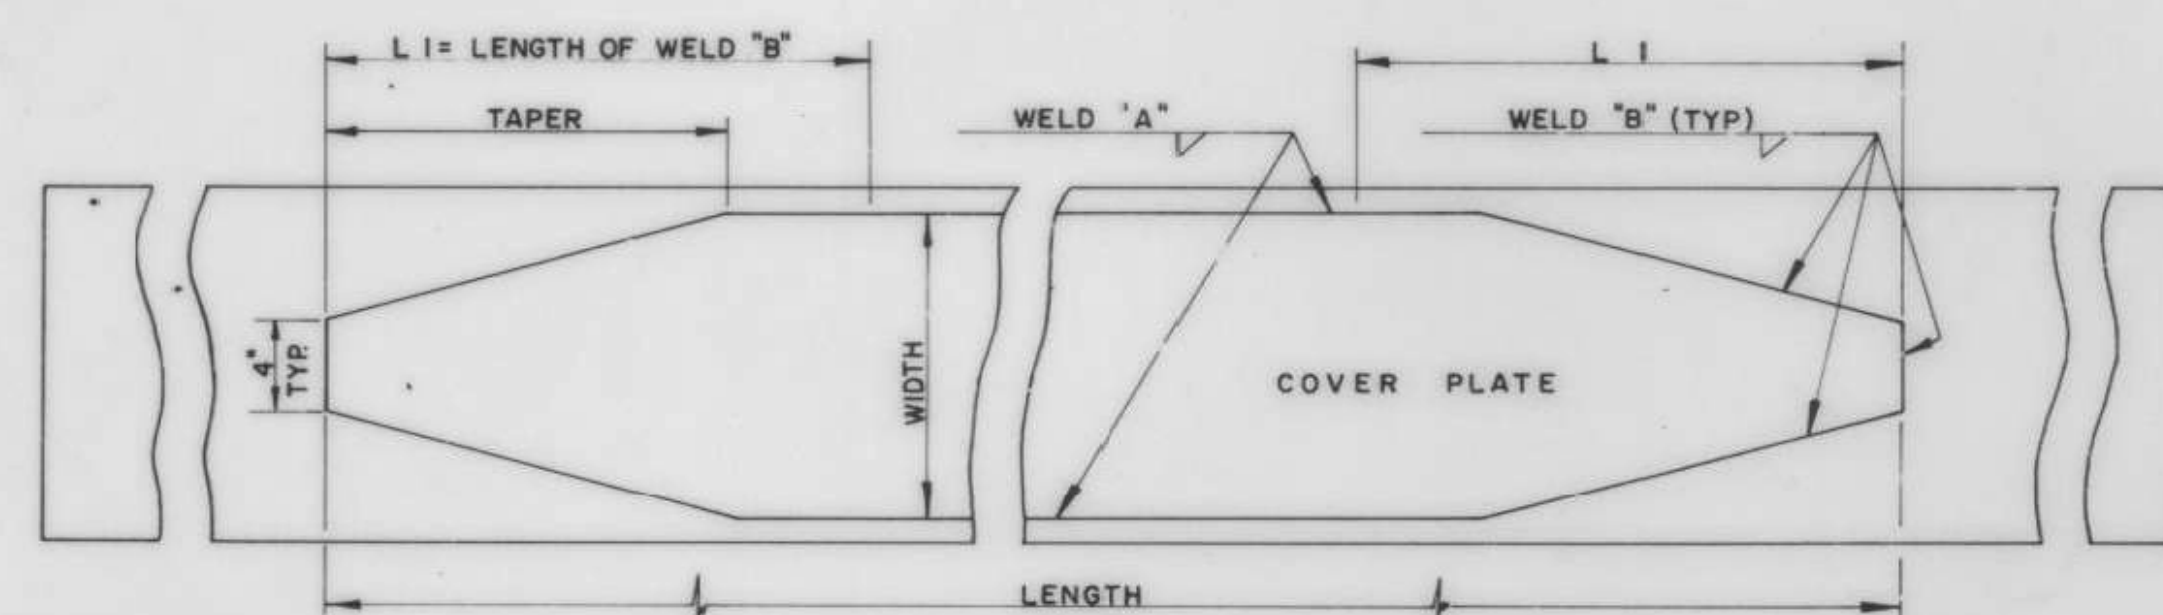


COVER PLATE DETAILS

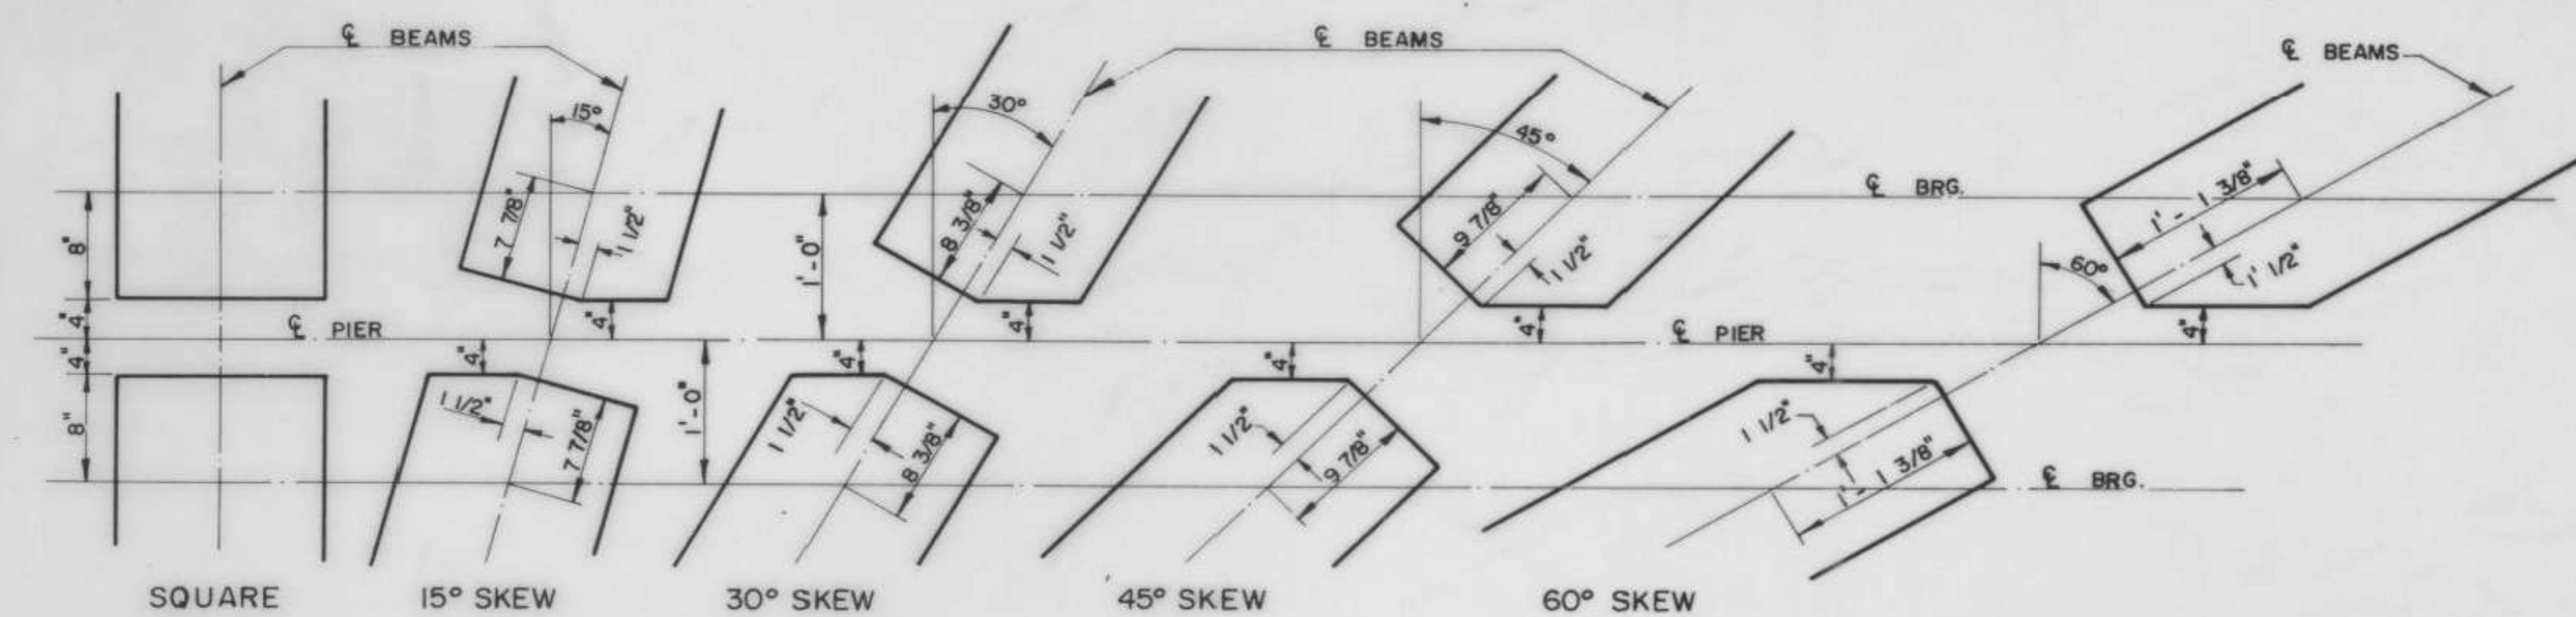


INTERIOR WF BEAM CUT-OFFS AT PIER

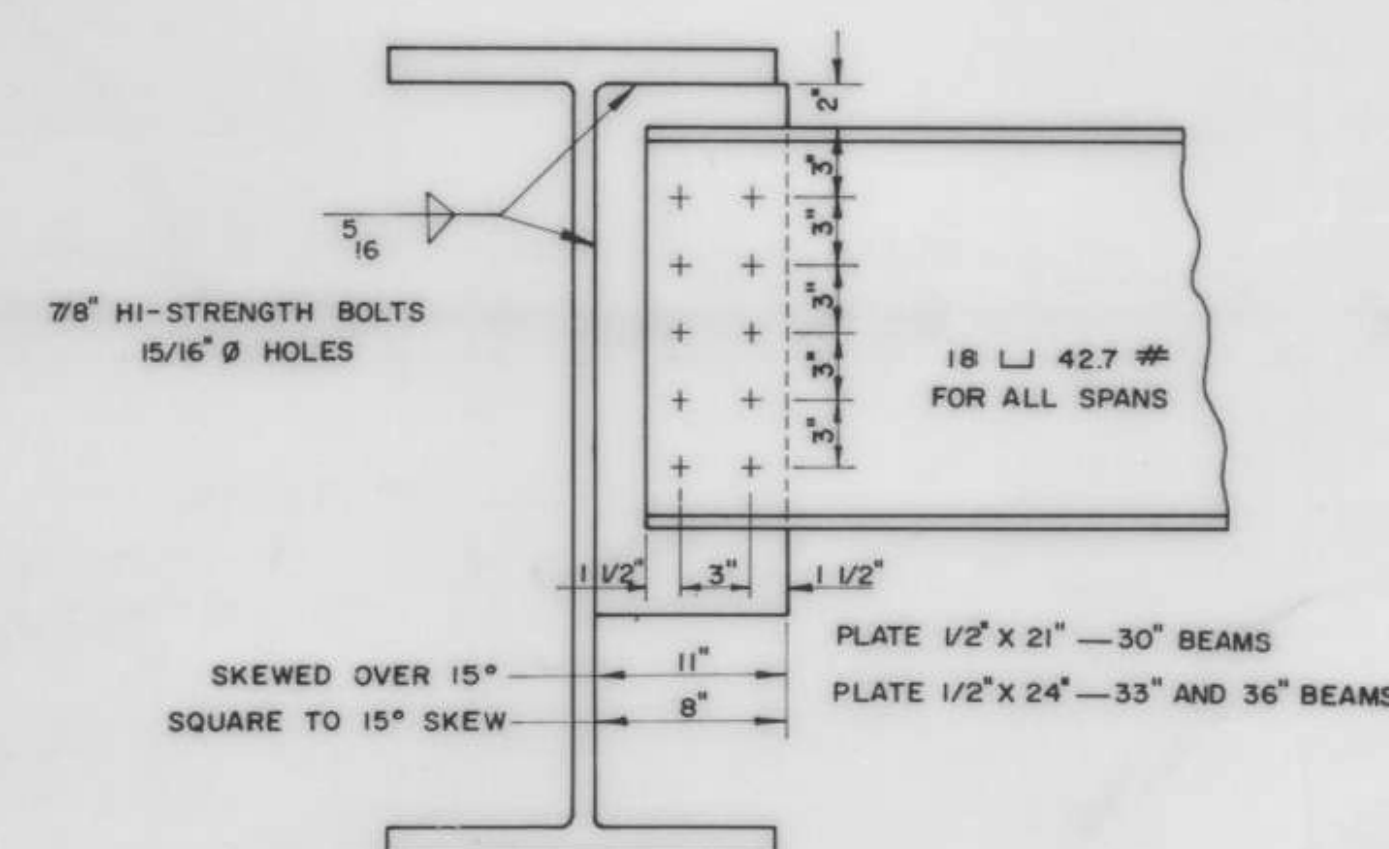

PIER DIAPHRAGMS

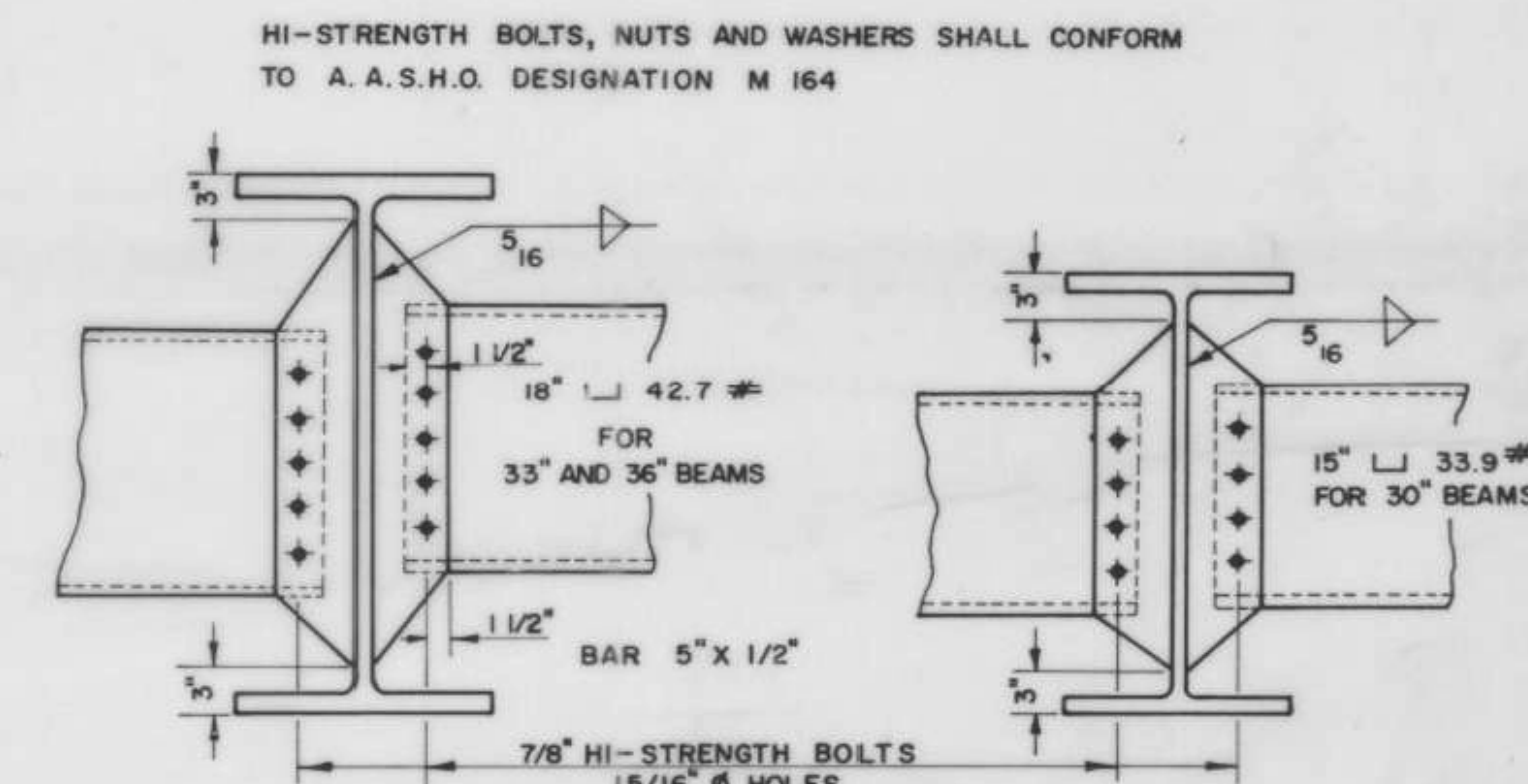

INTERMEDIATE DIAPHRAGMS

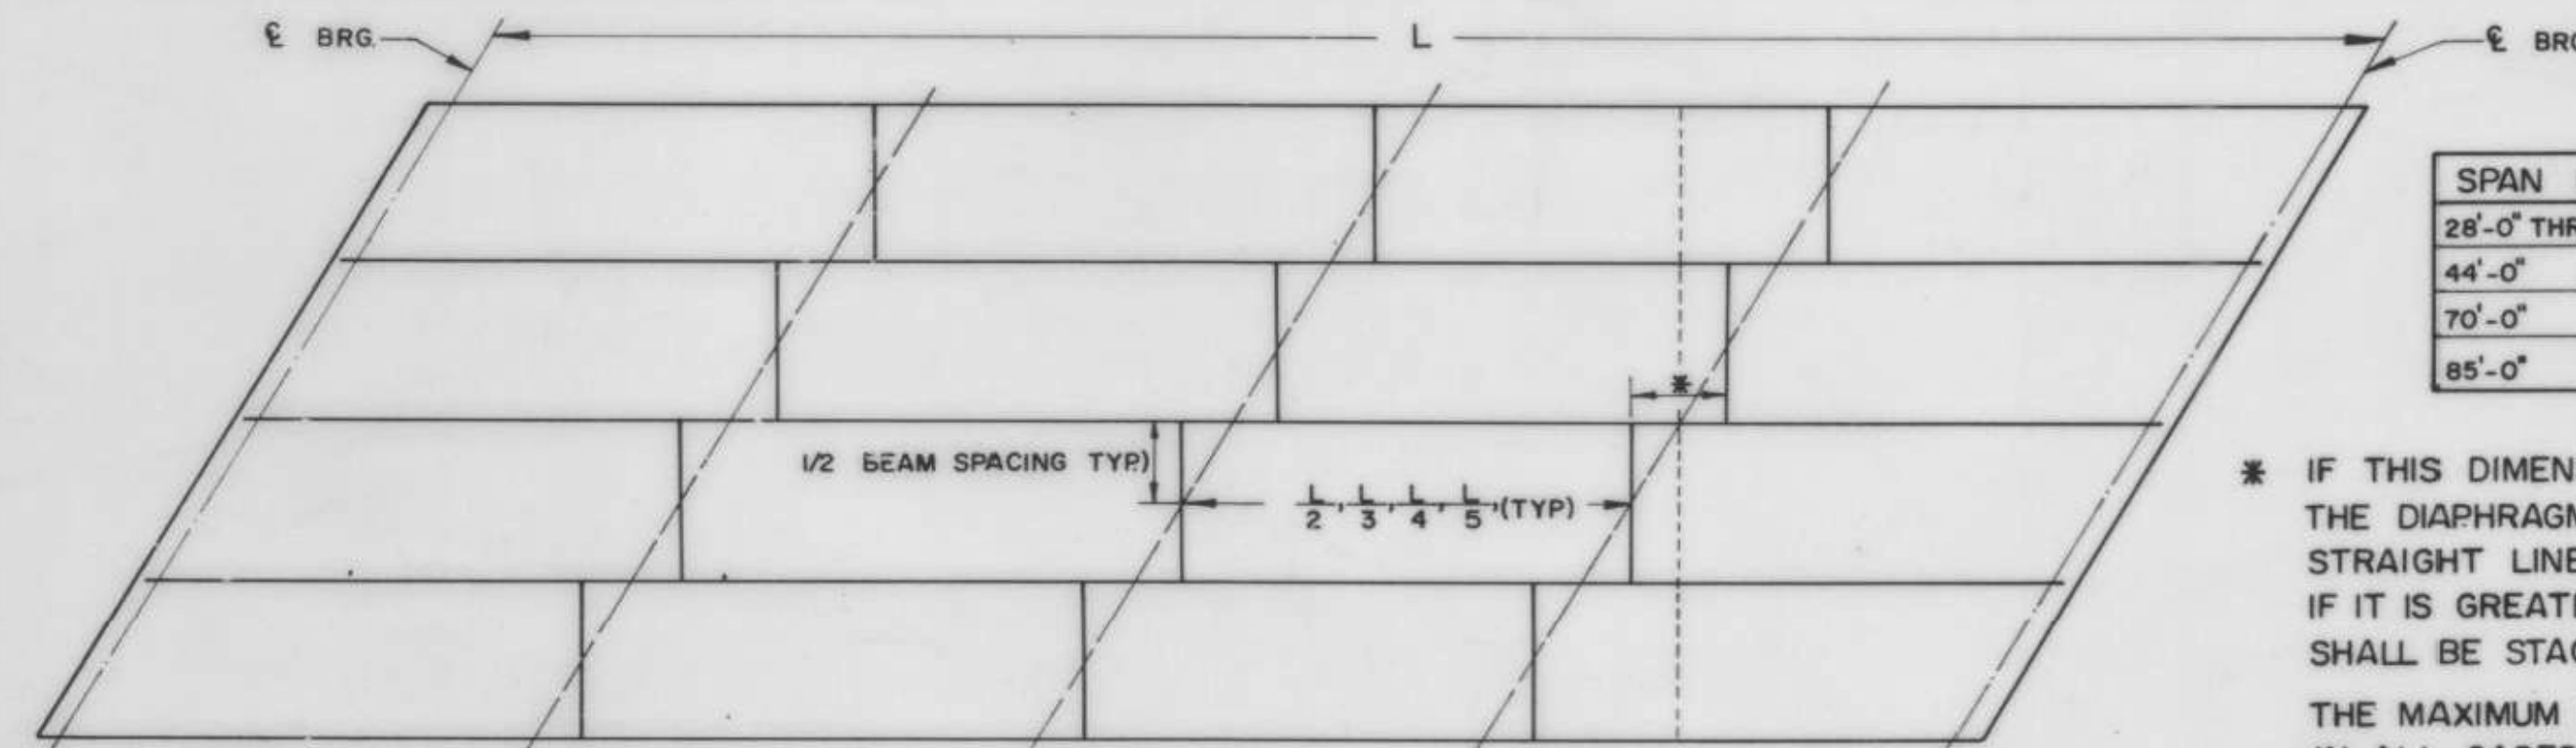

DIAPHRAGM LOCATION PLAN

SPAN LENGTH	SETS OF DIAPH. REQUIRED
28'-0" THROUGH 43'-0"	1
44'-0" 69'-0"	2
70'-0" 84'-0"	3
85'-0" 99'-0"	4

* IF THIS DIMENSION IS LESS THAN 1'-0" THE DIAPHRAGMS MAY BE PLACED IN A STRAIGHT LINE AS INDICATED BY DASH LINE. IF IT IS GREATER THAN 1'-0" THE DIAPHRAGMS SHALL BE STAGGERED AS SHOWN.

THE MAXIMUM UNBOLTED LENGTH OF BEAM IN ALL CASES SHALL NOT EXCEED 40'-0"

IRASBURG  
BRIDGE NO. 107N  
SHEET 47 OF 49  
FOR REFERENCE ONLY

REVISIONS AND CORRECTIONS

DRAWN BY: A.V. DEC. 1962  
 RETRACED BY: A.J.A. MAY 1967  
 CHECKED BY: W. SMITH DEC. 1967  
 RECOMMENDED FOR APPROVAL: [Signature] 1/24/68  
 RECOMMENDED FOR APPROVAL: [Signature] 1/24/68  
 RECOMMENDED FOR APPROVAL: [Signature] 1/24/68  
 APPROVED BY: [Signature] 1/24/68  
 CHIEF ENGINEER DATE

DETAILS OF WF BEAM BRIDGES  
 STRUCTURAL STEEL DETAILS  
 (A) (D) (E) DIAPHRAGM DETAILS  
 (B) WF BEAM CUT-OFFS  
 (C) COVER PLATE DETAILS

VERMONT  
 DEPARTMENT OF HIGHWAYS  
 STRUCTURE STANDARDS  
 SCB-D7-67 254A



When bridge is on a grade exceeding 5%, plate "A" shall be beveled to fit with a mean thickness of 1".

CUT END OF BEAM VERTICAL FOR GRADES OVER 5%

2 3/4" 2 3/4"

3/8"

1/2"

PLATE "A" - 7" X 1" X 0'-1" LONGER THAN BEAM FLANGE WIDTH

PLATE "B" 9" X 1 1/2" X 0'-10" - SPANS 29' TO 69'  
9" X 1 1/2" X 1'-1" - SPANS OVER 69'

1/8" BEARING PAD

1/8" BEARING PAD

SWEDGE NUT

1 1/4"

APPROX. WGT = 90 LBS.

BACK OF ABUTMENT

5" B

2 1/2"

1 1/2" V

BRG

2 1/2" FOR SQUARE SPANS

1 3/16" X 2 1/2" SLOTTED HOLES - SQUARE

1 3/16" X 2 3/4" 15° SKEW

1 3/16" X 3" 30°

1 3/16" X 3 1/2" 45°

VARIES FOR SKEWED SPANS

1 3/16" Ø IN PLATE "A", PLATE "B" AND BM. FLG. AT FIXED END

1 3/8" X 3" SLOTTED HOLES IN PLATE "A" AND BM. FLG. AT EXP. END.

PLATE "A"

PLATE "B"

ASA 125

RELIEF

1 1/2" V

BRG

1 1/2" V

5" B

2 1/2"

1 1/2" V

BRG

DETAILS OF PLATE "A" ARE SHOWN FOR 0° TO 15° SKEW SEE DETAIL "B" FOR SKEW OVER 15°

Attention is called to State of Vermont

Plate "C". -  $9' \times 1 \frac{1}{2}' \times 1'$  longer than the beam flange width. When the bridge is on a grade exceeding 5%, plate "C" shall be beveled to fit the grade with a mean thickness of  $1 \frac{1}{2}$ ."

Plate "D". -  $7' \times$  (outer edge thickness  $1 \frac{1}{2}$ ", center thickness  $1'$ )  $\times 1'-1'$ . To be Cast Bronze - A.S.T.M. - B 22-40 T, Class "B" unless otherwise specified. This plate shall have trepanned recesses filled with a lubricating compound. The lubricating area shall comprise not less than 25 % of the total bearing area. The manufacturer shall supply additional lubricant in liquid form with which the Contractor shall thoroughly coat the bearing surfaces that contact the lubricated portion of the bronze plate. The coefficient of friction shall not exceed 0.0.

Plate "E". -  $10' \times 1 \frac{1}{2}' \times 1'-1'$ .

Plate "E" - 10' x 1 1/2' x 1'-1".

## EXPANSION END BEARING DEVICE FOR SPANS OVER 69'

FIXED END BEARING DEVICE  
USE FOR EXPANSION END ON SPANS UP TO AND INCLUDING 69'

# DETAILS OF WF BEAM BRIDGES

- ☐ (A) FIXED END BEARING DEVICE  
☐ (B) EXPANSION END BEARING DEVICE


VERMONT  
DEPARTMENT OF HIGHWAYS  
STRUCTURE STANDARDS

SCB-D8-67

256 A

IRASBURG  
IM DECK(46)  
BRIDGE NO. 1107N  
SHEET 48 OF 48  
~~FOR REFERENCE ONLY~~




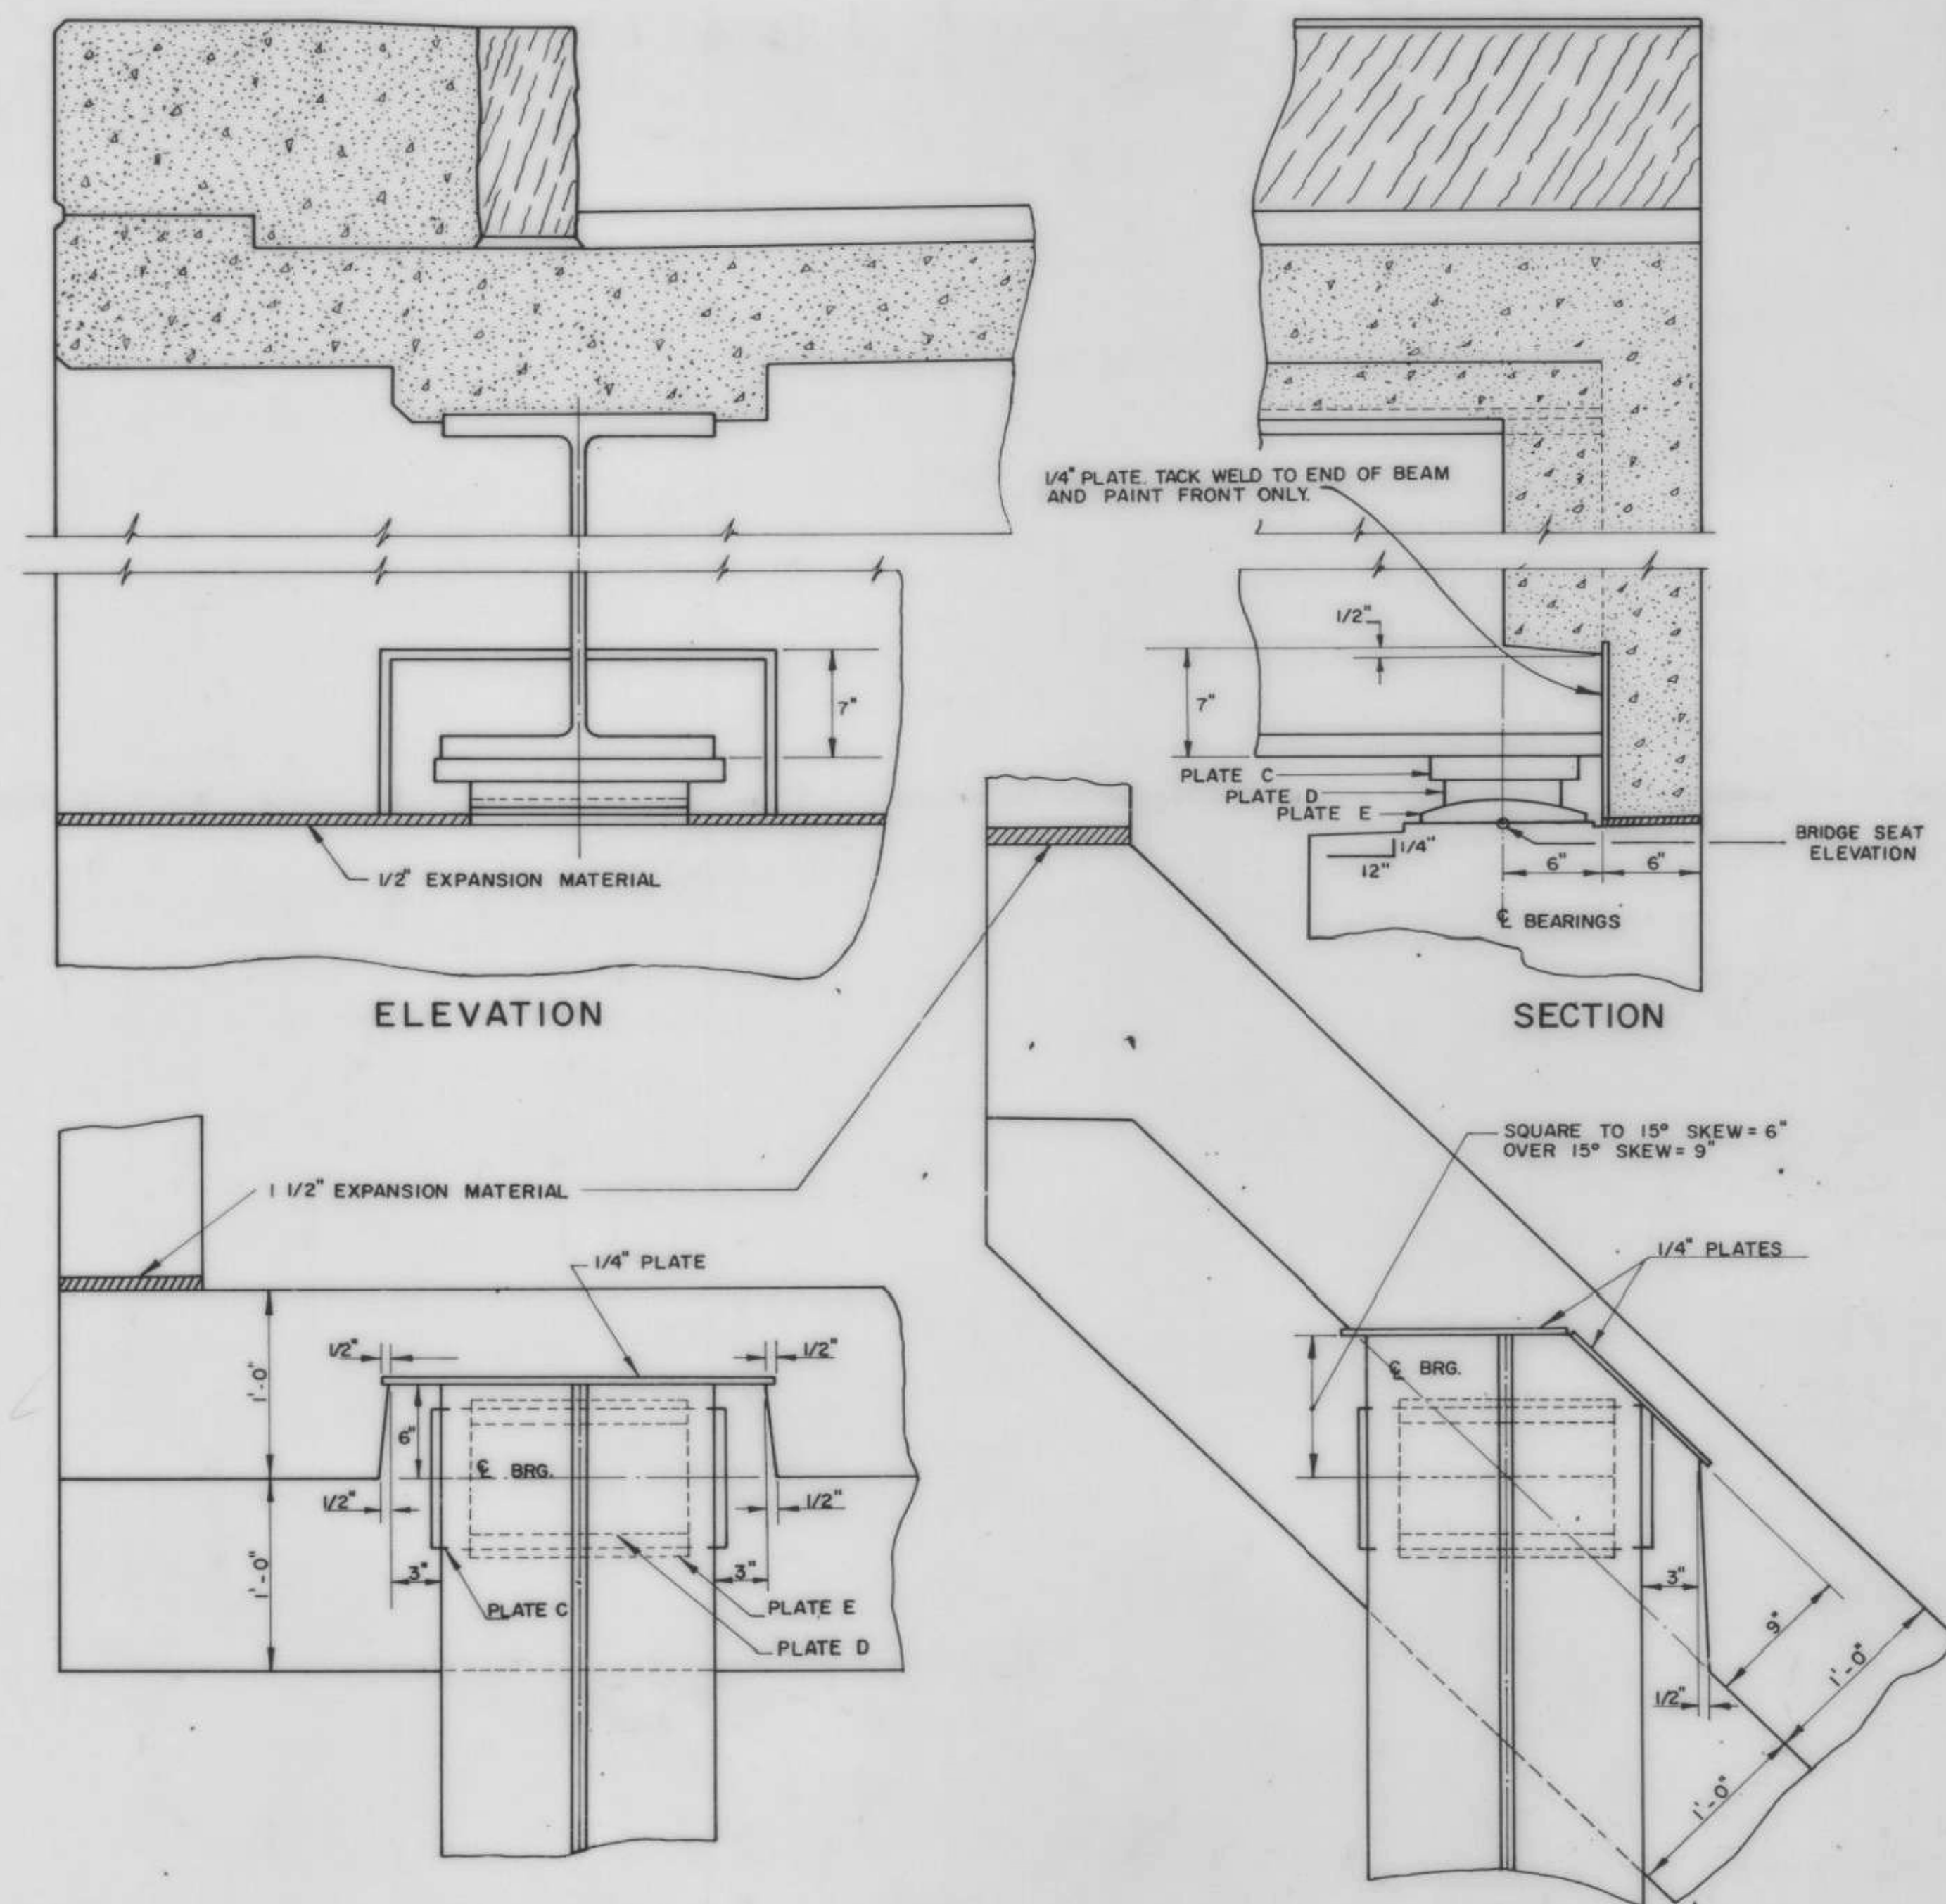


PLAN FOR SQUARE BRIDGES

PLAN FOR SKEWED BRIDGES


(DETAILS SHOWN FOR EXP. END; FIXED END SIMILAR EXCEPT  $P_s$  A AND B IN LIEU OF  $P_s$  C, D AND E; SEE SCB-D8-69)

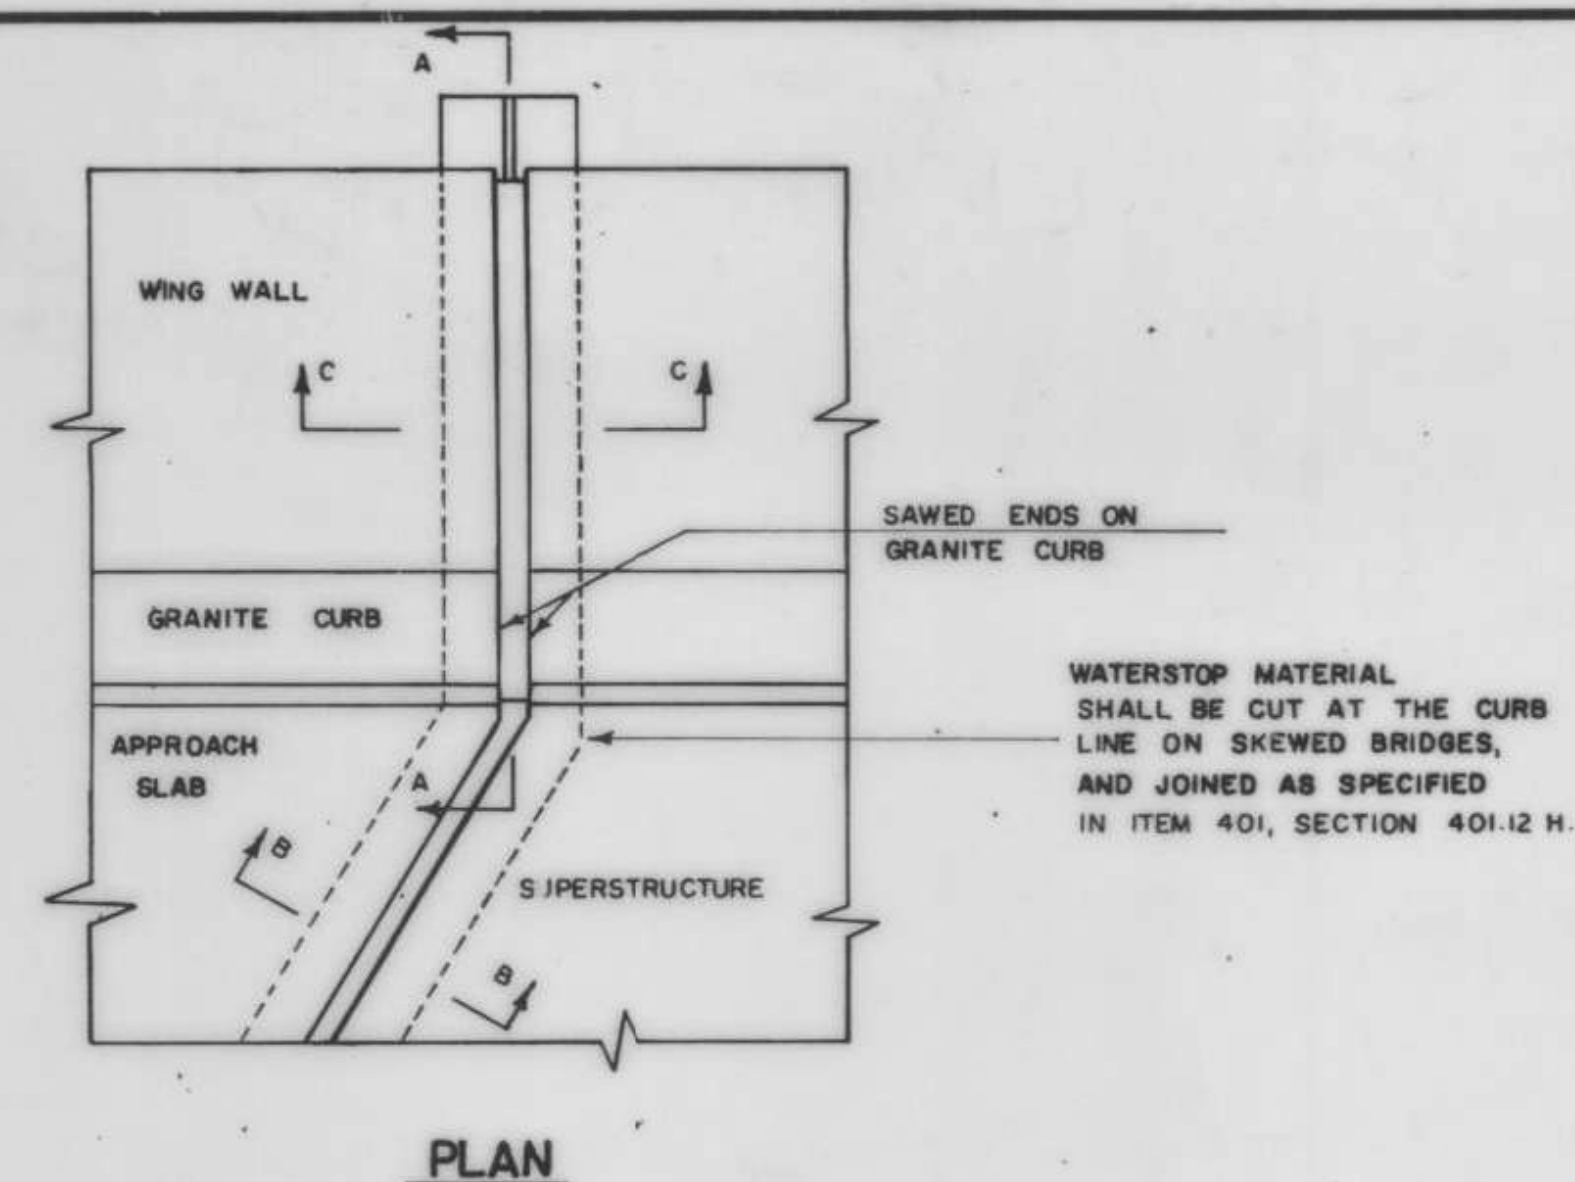

JOINT IS TO BE LOCATED ACCURATELY BY STRING LINING, OR OTHER MEANS, PRIOR TO PAVING, SO THAT THE SAW CUT WILL BE MADE DIRECTLY OVER THE JOINT.

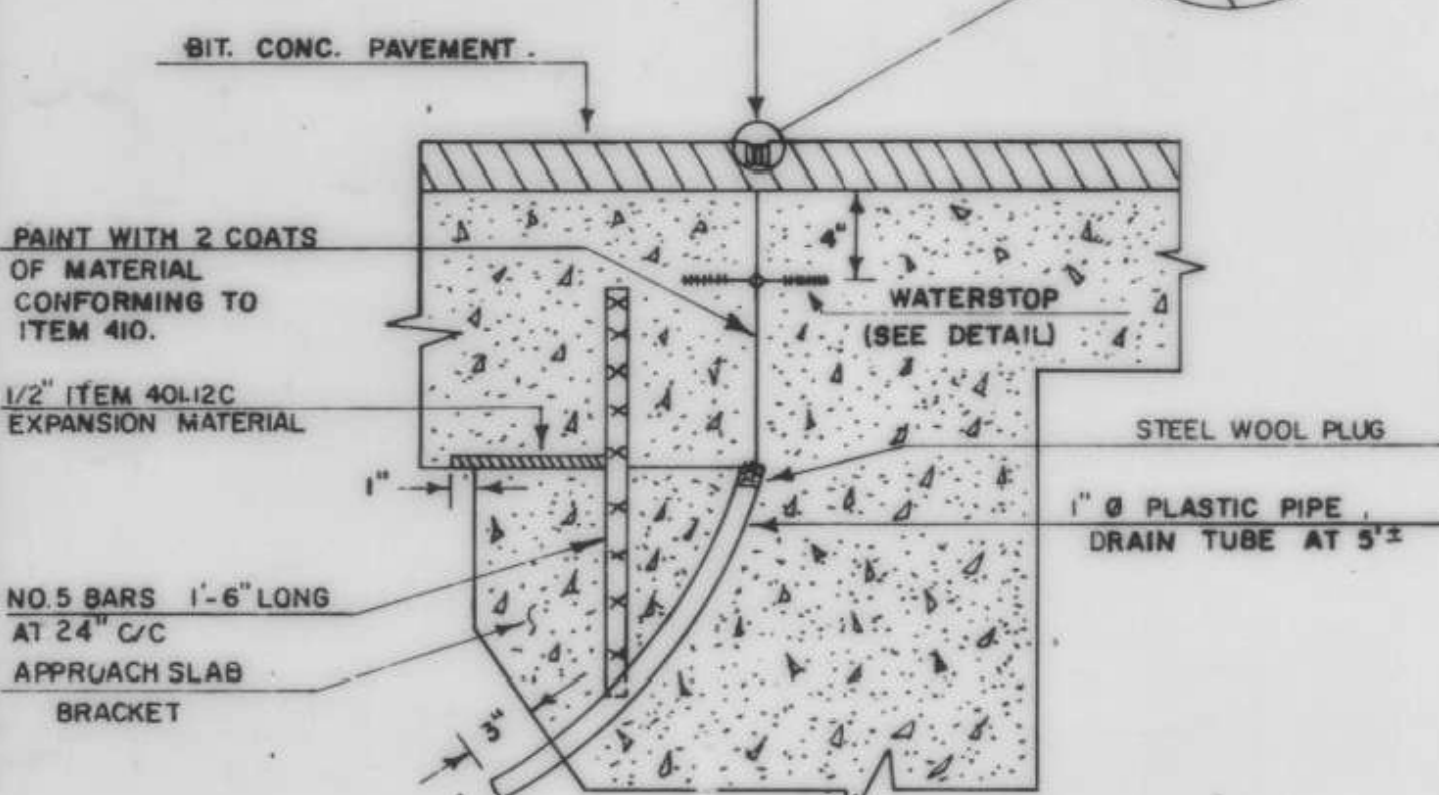



SECTION B-B

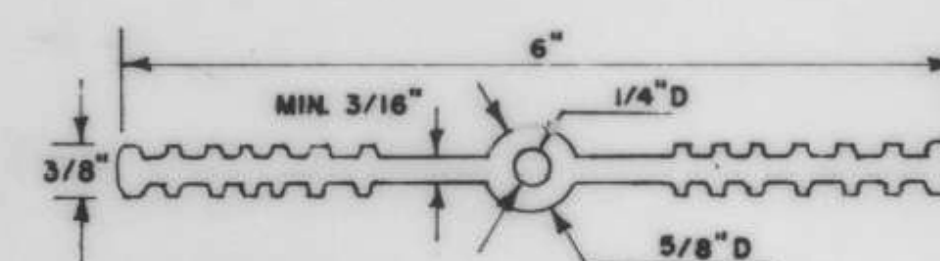


MATERIAL TO BE POLYVINYLCHLORIDE, AS SPECIFIED IN ITEM 401.12 H. OTHER CONFIGURATIONS, WITH MINOR DIMENSION VARIATIONS, MAY BE USED WITH THE APPROVAL OF THE BRIDGE ENGINEER.

COST OF THE WATERSTOP SHALL BE INCLUDED IN THE UNIT PRICE BID FOR ITEM 401, CONCRETE.


THE CONTRACTOR SHALL PROVIDE ADEQUATE SUPPORT TO MAINTAIN PROPER ALIGNMENT OF WATERSTOP DURING CONSTRUCTION.

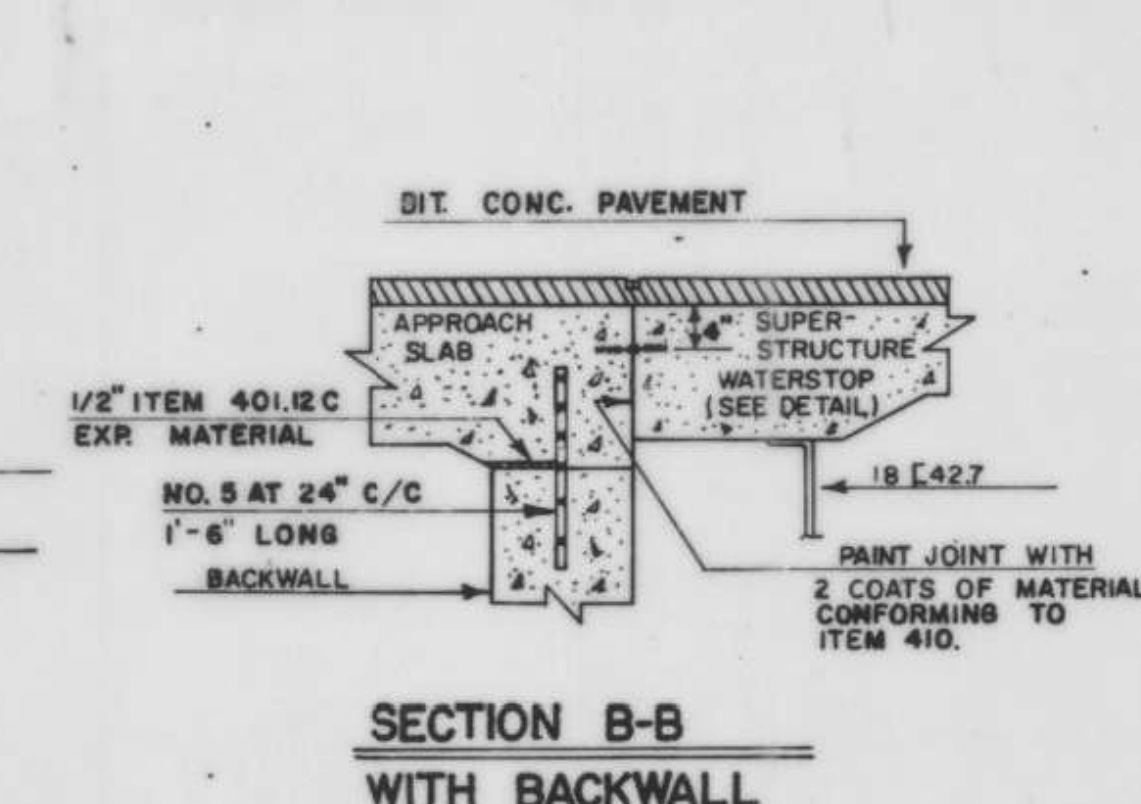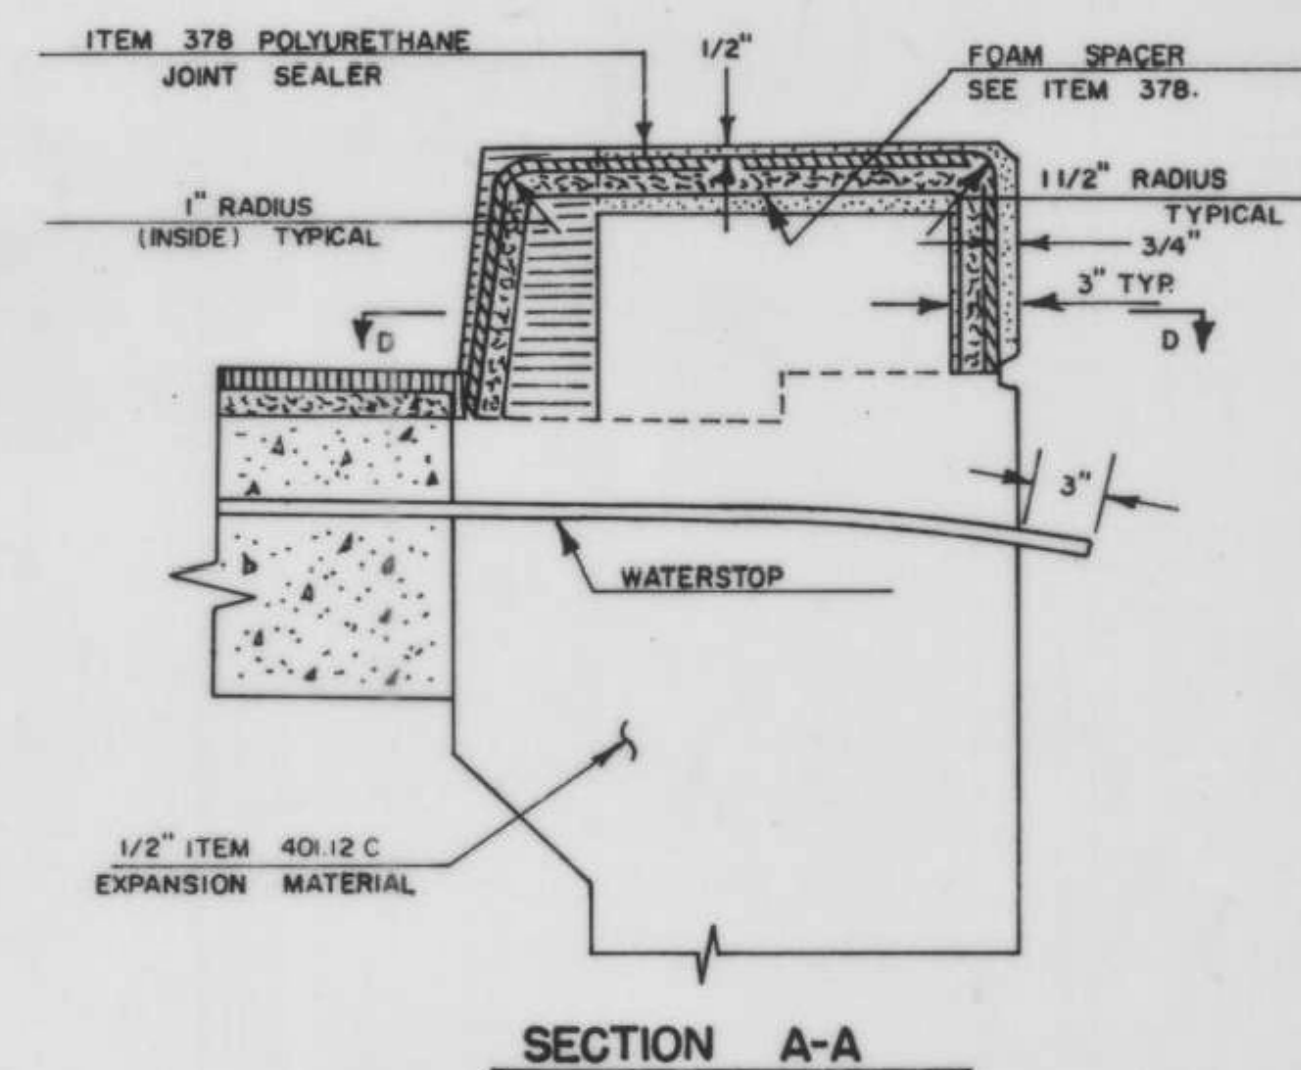


SECTION B-B WITH BACKWALL

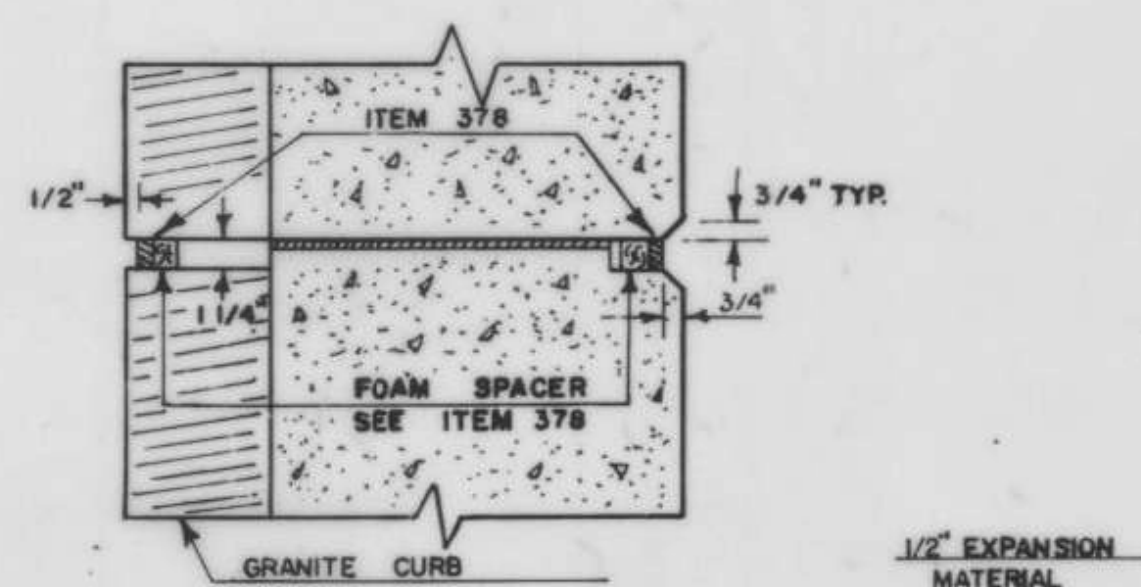

SECTION D-D

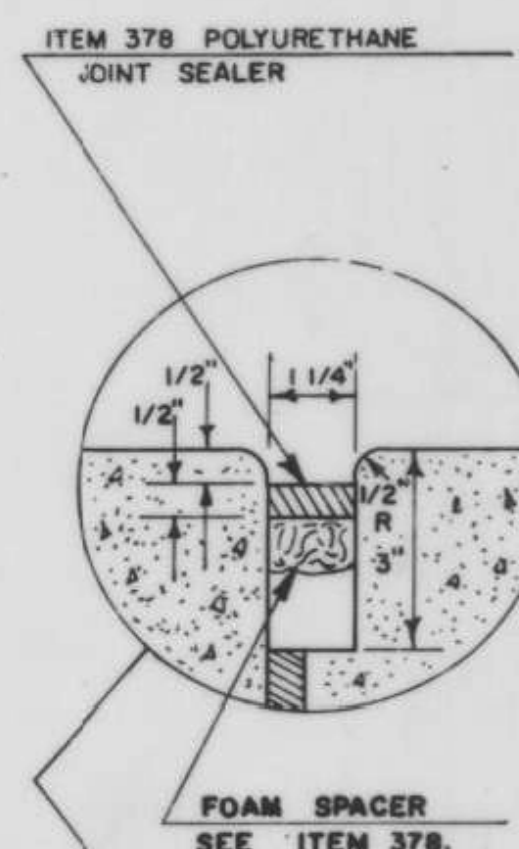

FOAM SPACER SEE ITEM 378.

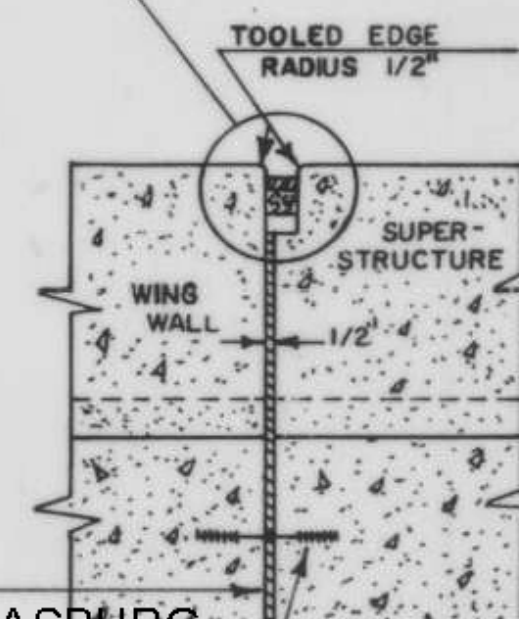

IRASBURG  
IM DECK(46)  
BRIDGE NO. 1074  
SHEET 30 OF 49  
FOR REFERENCE ONLY

REVISIONS AND CORRECTIONS

- 1 (B) FIXED END JOINT DETAILS - ADDED 4-28-70 J. WOOD
- 2 ADDED " SEE SCB-D8-69 " TO NOTE ON DET. (A) 12-11-70 J. WOOD

DRAWN BY: AV. DEC 1962  
RETRACTED BY: A.J.A. MAY 1967  
CHECKED BY: W. SMITH DEC. 1967

RECOMMENDED FOR APPROVAL  
RECOMMENDED FOR APPROVAL  
RECOMMENDED FOR APPROVAL  
APPROVED BY: *[Signature]* 1/24/68  
BRIDGE ENGINEER  
CONSTRUCTION ENGINEER  
ASST. CHIEF ENGINEER  
CHIEF ENGINEER  
DATE


DETAILS OF W BEAM BRIDGES

- (A) CURTAIN WALL AT BEARING DEVICES
- (B) FIXED END JOINT DETAILS

VERMONT  
DEPARTMENT OF HIGHWAYS  
STRUCTURE STANDARDS

SCB-D9-67



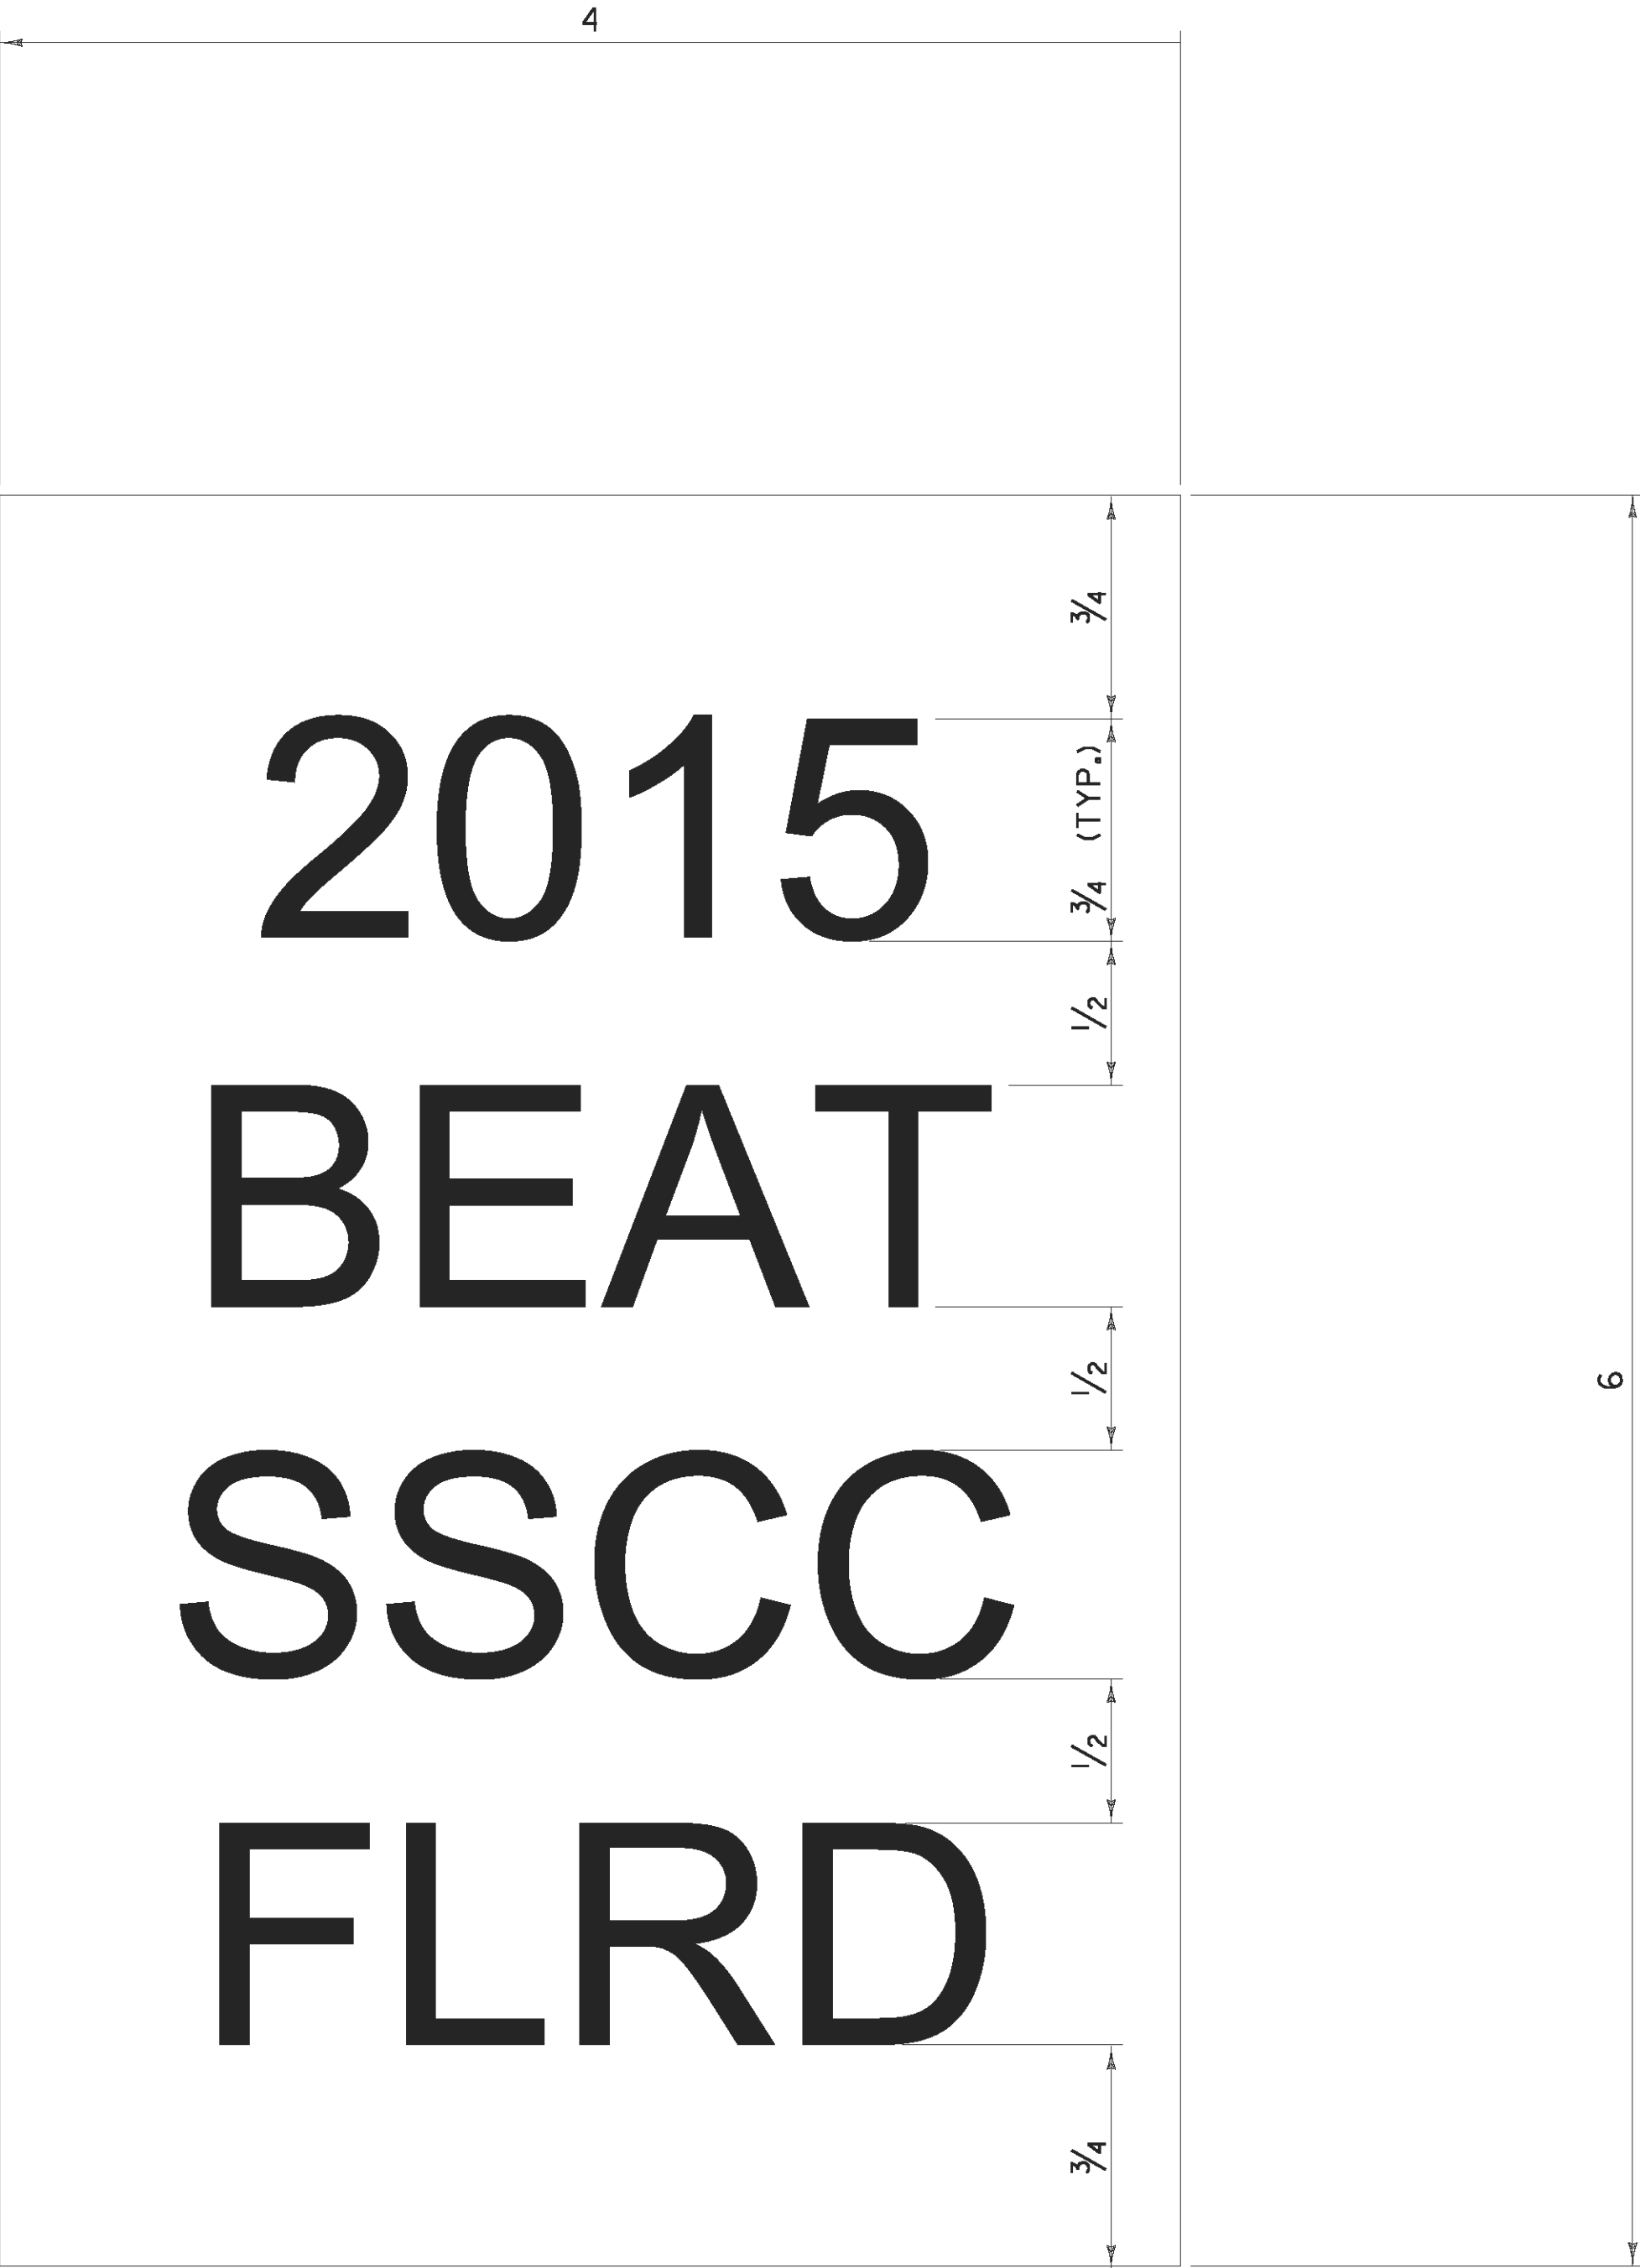

**GENERAL NOTES:**

1. LINE ONE SHALL INDICATE THE INSTALLATION YEAR (YYYY).
2. LINE TWO SHALL INDICATE THE MODEL AS IDENTIFIED ON THE APPROVED PRODUCTS LIST. FOR GENERIC INSTALLATIONS THE STANDARD DRAWING DESIGNATION OR NAME AS IDENTIFIED IN THE FHWA ELIGIBILITY LETTER SHALL BE USED.
3. LINE THREE SHALL INDICATE ADDITIONAL MODEL INFORMATION IF NECESSARY.
4. LINE FOUR SHALL INDICATE FLARED (FLRD) OR TANGENT (TANG).
5. LEGEND SHALL BE ONE ARIEL FONT.
6. LEGEND SHALL BE BLACK ON A WHITE BACKGROUND, LEGEND AND BACKGROUND SHALL NOT BE REFLECTIVE.
7. SUITABLE MATERIAL SHALL BE USED SO AS TO NOT DETERIORATE DURING EXPOSURE TO WEATHER.
8. LABELS SHALL BE APPLIED IN SUCH A WAY THAT THEY REMAIN INTACT DURING THE LIFE OF THE TERMINAL.
9. FOR W-BEAM GUARDRAIL, LABEL SHALL BE PLACED ON THE TOP OF POST ONE FACING AWAY FROM TRAFFIC.
10. FOR BOX BEAM GUARDRAIL, LABEL SHALL BE PLACED ON THE BOX BEAM ADJACENT TO POST ONE FACING AWAY FROM TRAFFIC.
11. PAYMENT SHALL BE INCIDENTAL TO OTHER TRAFFIC BARRIER ITEMS.
12. ALL DIMENSIONS IN INCHES.

REV.	DATE	DESCRIPTION
0	NOV. 3, 2015	ORIGINAL APPROVAL
OTHER DETAILS REQUIRED: NONE		
DETAILS APPROVED FOR USE BY HIGHWAY SAFETY & DESIGN		

GUARDRAIL TERMINAL LABEL DETAIL




HIGHWAY SAFETY  
& DESIGN DETAIL  
HSD - 621.06




CONCRETE GENERAL NOTES

- 1. ALL EXPOSED EDGES OF CONCRETE SHALL BE CHAMFERED 1" x 1"
- 2. REINFORCING STEEL SIZE AND SPACING SHOWN IN THE PLANS IS BASED ON 60 KSI STEEL, UNLESS NOTED OTHERWISE. WITH THE ENGINEER'S PERMISSION, BAR SIZE AND SPACING MAY BE MODIFIED ACCORDING TO THE LATEST AASHTO LRFD BRIDGE DESIGN SPECIFICATION AND STRUCTURES DESIGN MANUAL WHEN USING HIGHER STRENGTH STEEL.

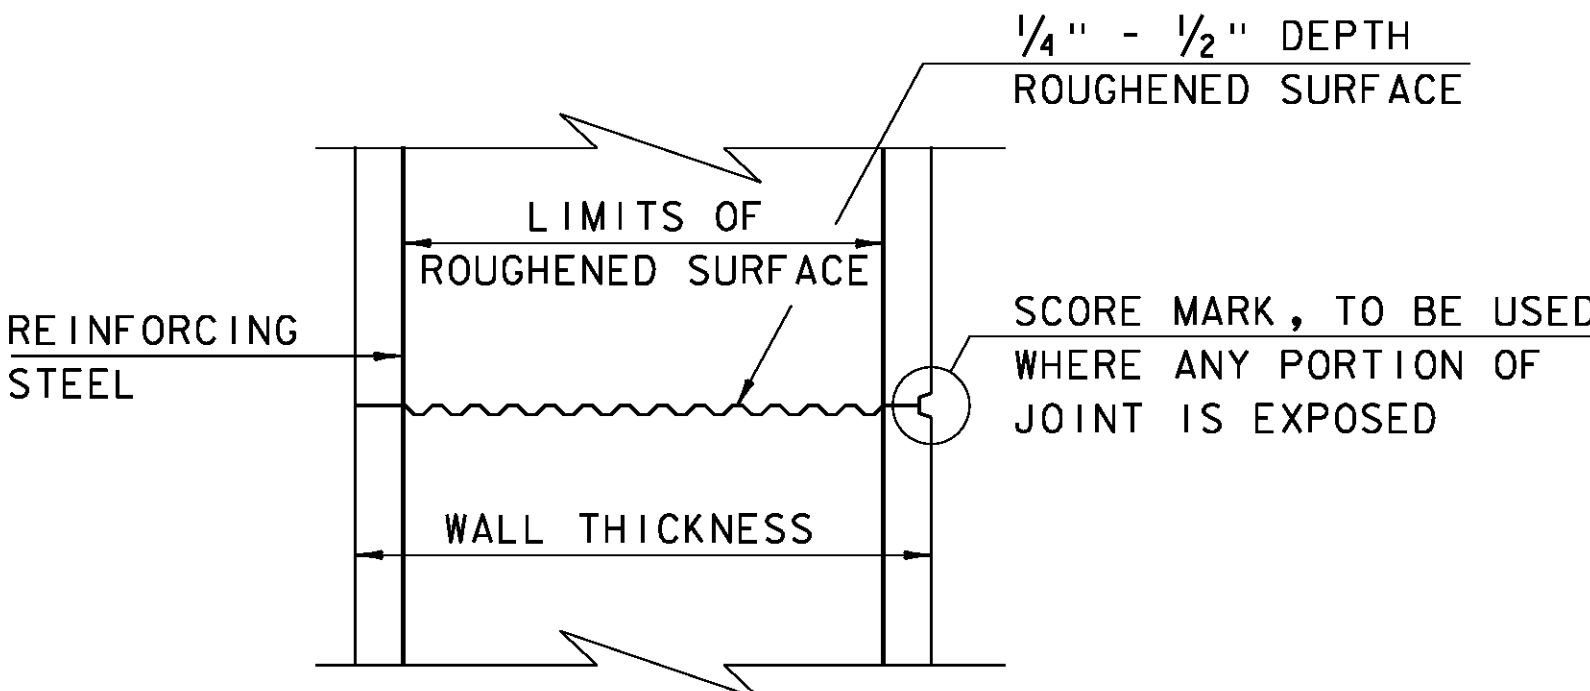


TYPICAL HORIZONTAL CONSTRUCTION JOINT  
(NOT TO SCALE)


- 1. THE SURFACE OF THE CONCRETE CONSTRUCTION JOINTS SHALL BE CLEANED AND FREE OF LAITANCE.
- 2. IMMEDIATELY BEFORE NEW CONCRETE IS PLACED, ALL CONSTRUCTION JOINTS SHALL BE WETTED AND STANDING WATER REMOVED.

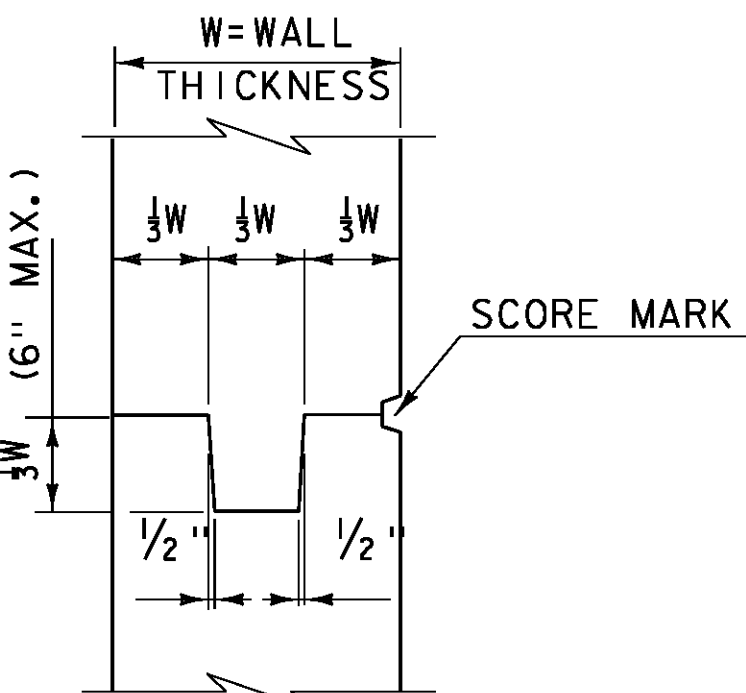


TYPICAL CONCRETE CONSTRUCTION JOINT  
(NOT TO SCALE)

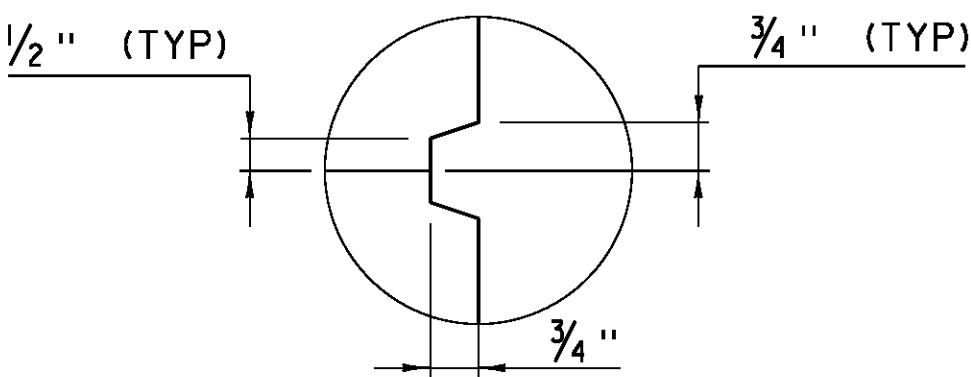


SCORE MARK DETAIL  
(NOT TO SCALE)

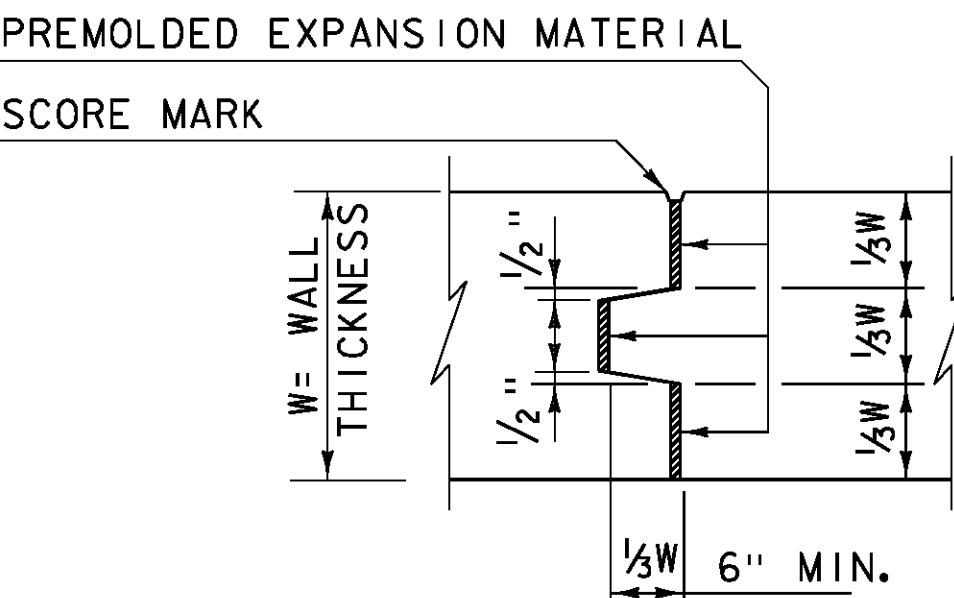

TYPICAL CONCRETE EXPANSION JOINT  
(NOT TO SCALE)

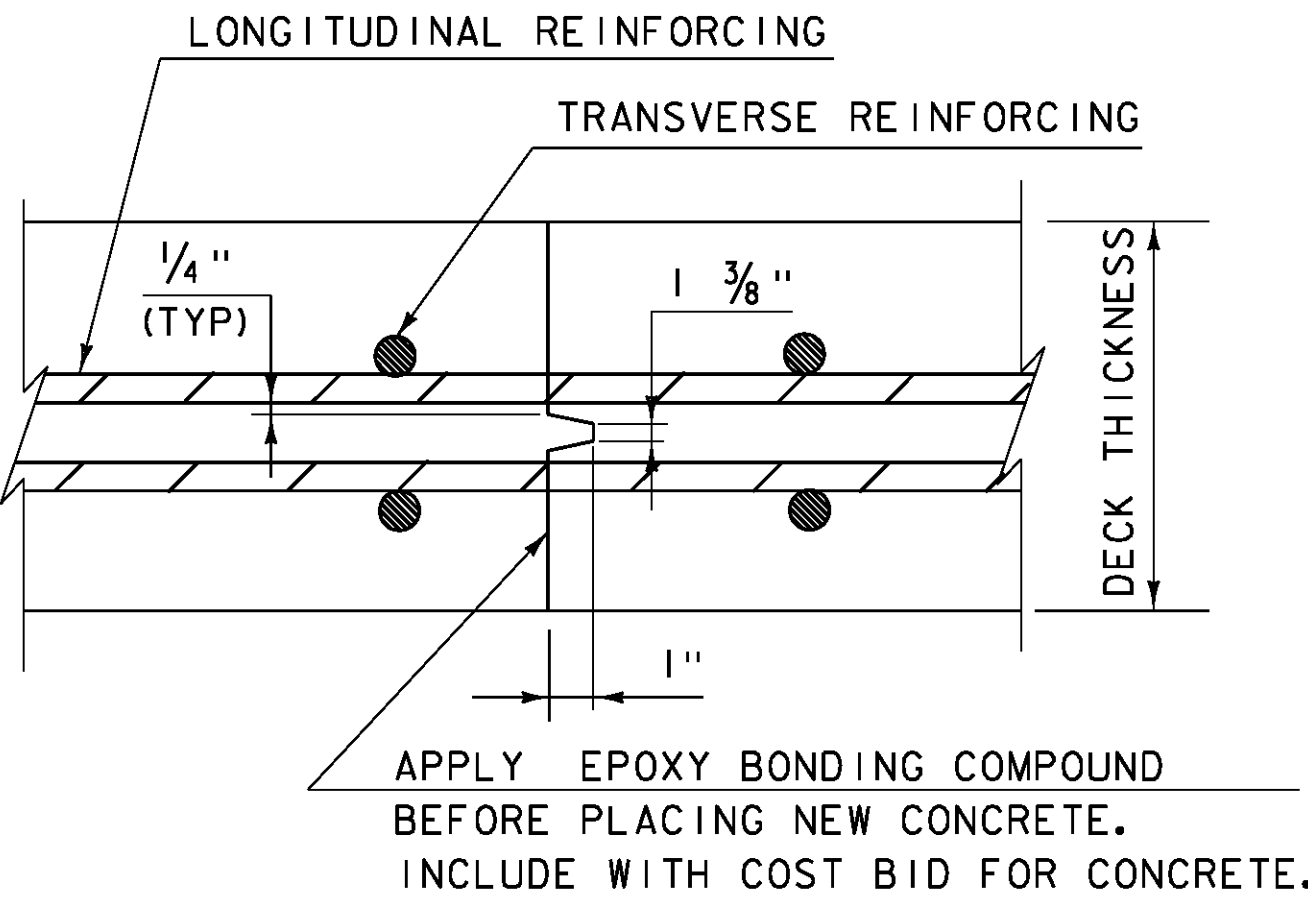


TRANSVERSE BRIDGE SLAB  
CONSTRUCTION JOINT DETAILS  
(NOT TO SCALE)

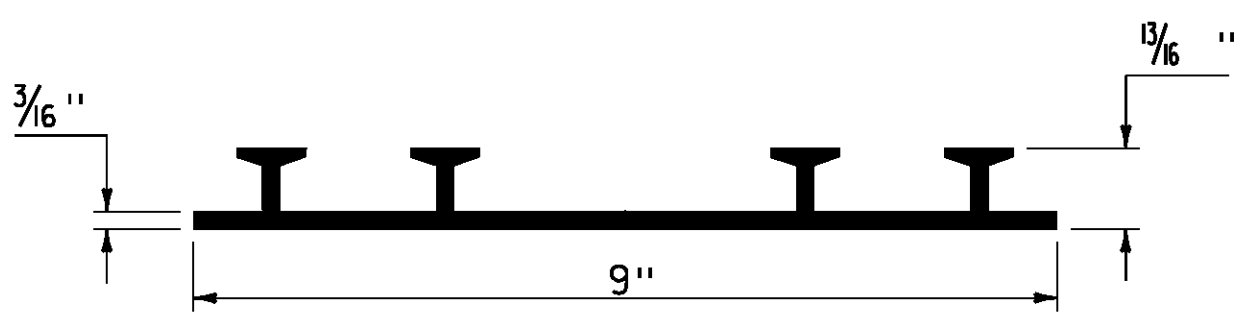

P.V.C. WATERSTOP FOR  
CONSTRUCTION JOINTS  
(NOT TO SCALE)

PAYMENT FOR THE P.V.C. WATERSTOP SHALL BE INCIDENTAL TO THE UNIT BID PRICE FOR THE ADJACENT CONCRETE.


OTHER CONFIGURATIONS OF WATERSTOP MAY BE USED UPON APPROVAL OF THE ENGINEER.

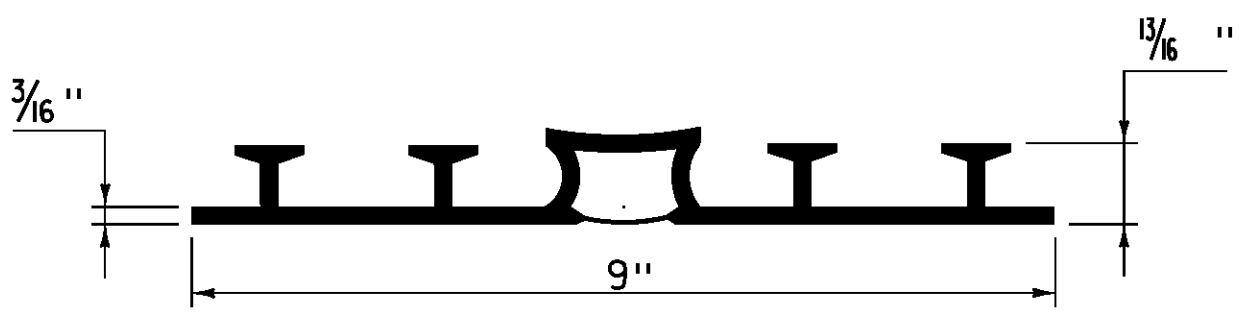

P.V.C. WATERSTOP FOR  
EXPANSION JOINTS  
(NOT TO SCALE)

PAYMENT FOR THE P.V.C. WATERSTOP SHALL BE INCIDENTAL TO THE UNIT BID PRICE FOR THE ADJACENT CONCRETE.


OTHER CONFIGURATIONS OF WATERSTOP MAY BE USED UPON APPROVAL OF THE ENGINEER.

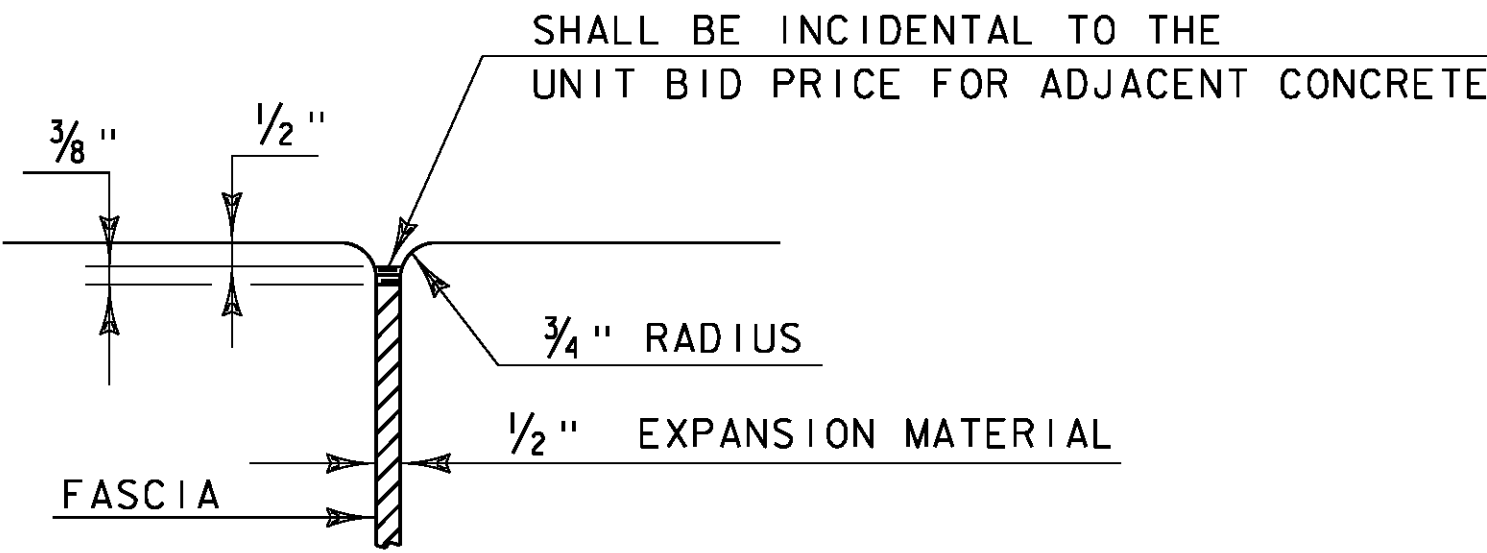

JOINT BETWEEN FASCIA  
AND WINGWALL  
(NOT TO SCALE)


REVISIONS	
MAY 7, 2010	APPROVED FOR USE BY VAOT STRUCTURES SECTION
FEBRUARY 9, 2012	REBAR SUBSTITUTION ALLOWANCE ADDED TO CONCRETE GENERAL NOTES.

CONCRETE  
DETAILS AND NOTES

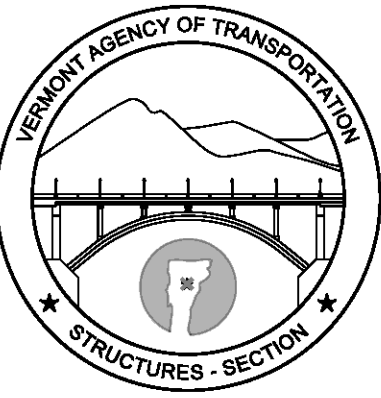


STRUCTURES  
DETAIL  
SD-501.00



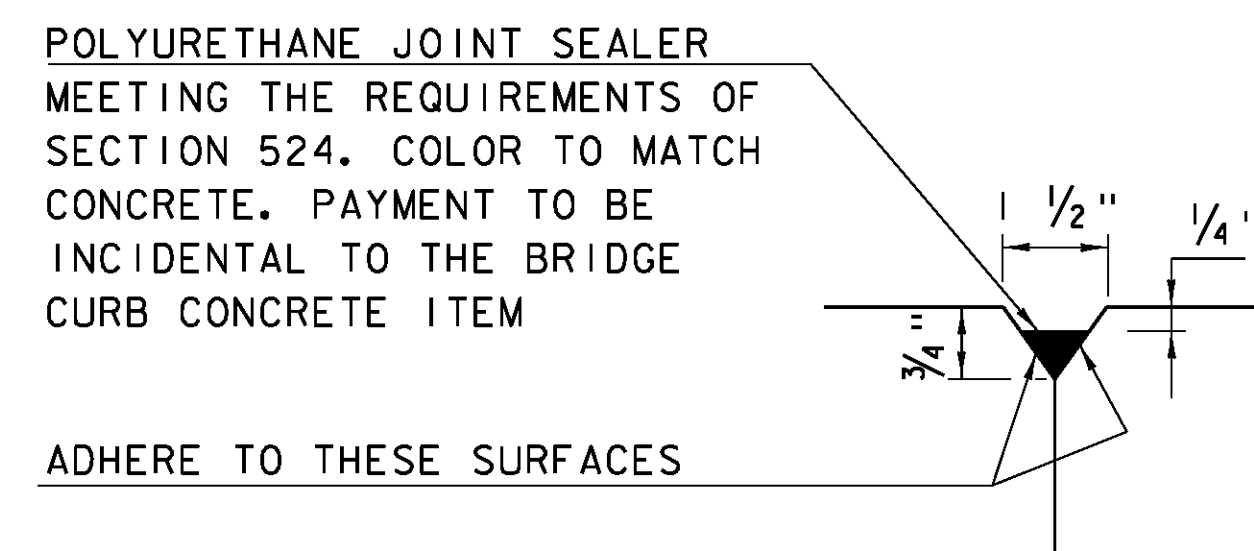

DETAIL "B"  
(NOT TO SCALE)

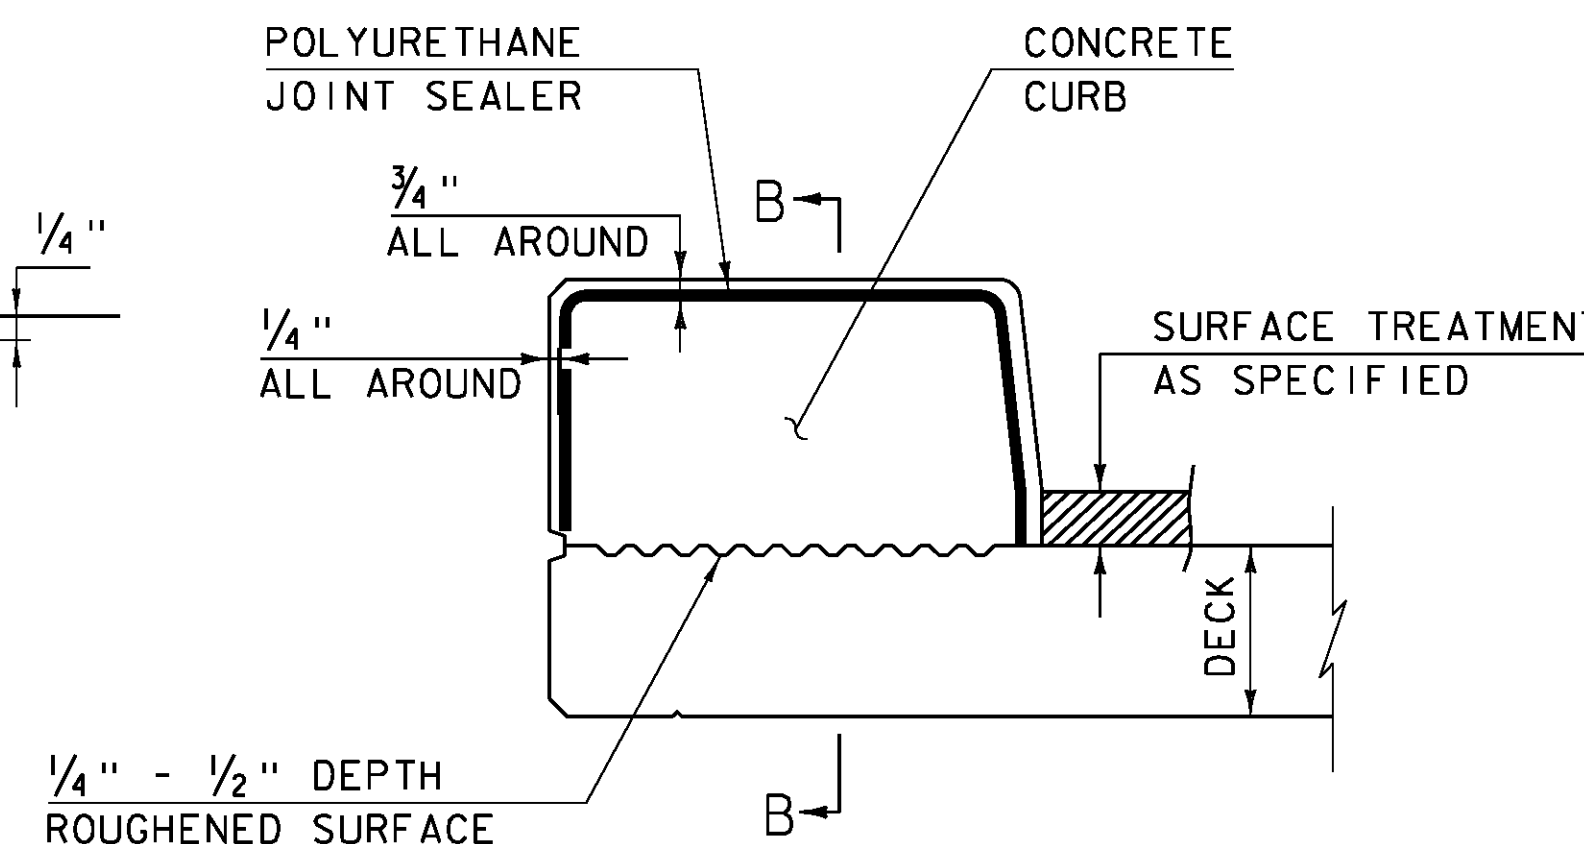


CONCRETE CURB JOINT SECTION  
(NOT TO SCALE)


1. SEE TYPICAL HORIZONTAL CONSTRUCTION JOINT DETAIL FOR ADDITIONAL INFORMATION

### CONCRETE CURB JOINT NOTES



1. CONCRETE CURBS MAY BE PLACED IN ONE CONTINUOUS OPERATION IF AN APPROVED SHRINKAGE REDUCING ADMIXTURE LISTED IN THE SPECIAL PROVISIONS IS USED WITH THE CONCRETE MIX DESIGN. PAYMENT FOR THE SHRINKAGE REDUCING ADMIXTURE WILL BE INCIDENTAL TO THE BRIDGE CURB CONCRETE ITEM.
2. IF THE CONTRACTOR CHOOSES NOT TO USE AN APPROVED SHRINKAGE REDUCING ADMIXTURE, THE CURBS SHALL BE CONSTRUCTED WITH CONSTRUCTION JOINTS SPACED AT A MAXIMUM OF 15'-0" CENTER TO CENTER AND 2'-0" MINIMUM FROM THE CENTER OF NEAREST BRIDGE RAILING POST.
3. ON MULTI-SPAN CONTINUOUS SUPERSTRUCTURES, REGARDLESS OF WHETHER APPROVED SHRINKAGE REDUCING ADMIXTURE IS USED, CURB JOINTS SHALL BE LOCATED OVER THE CENTERLINE OF PIERS AND 7'-0" EACH SIDE OF THE CENTERLINE OF EACH PIER.
4. WHEN CURB JOINTS ARE USED THE CURBS SHALL BE PLACED IN ALTERNATE SECTIONS WITH A MINIMUM OF 48 HOUR DELAY BETWEEN ADJACENT PLACEMENTS.
5. LONGITUDINAL REINFORCING SHALL BE CONTINUOUS THROUGH CURB CONSTRUCTION JOINTS. CURB STIRRUP BARS SHALL BE TURNED AS NECESSARY TO MAINTAIN COVER IN THE FLARED CURB ENDS.
6. THE JOINT SPACING AND DETAILS SHOWN SHALL APPLY TO SIDEWALKS WHEN SHOWN IN THE PLANS.

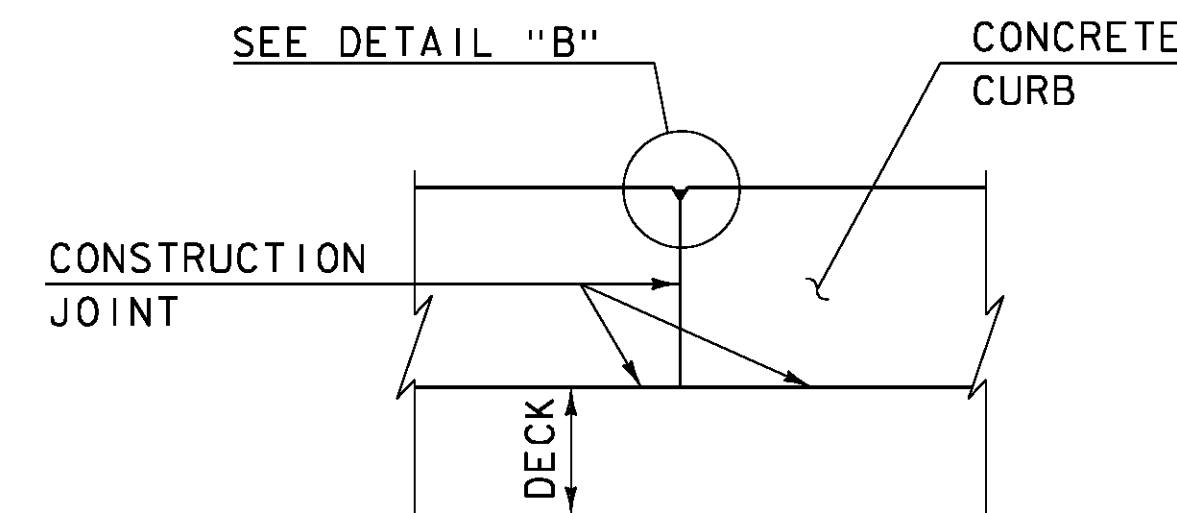

SECTION B - B  
(NOT TO SCALE)

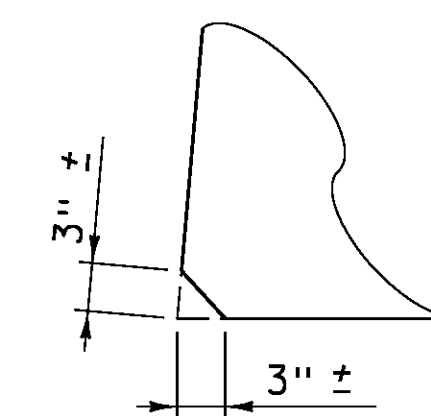


ACUTE ANGLE  
CLIP DETAIL  
(NOT TO SCALE)

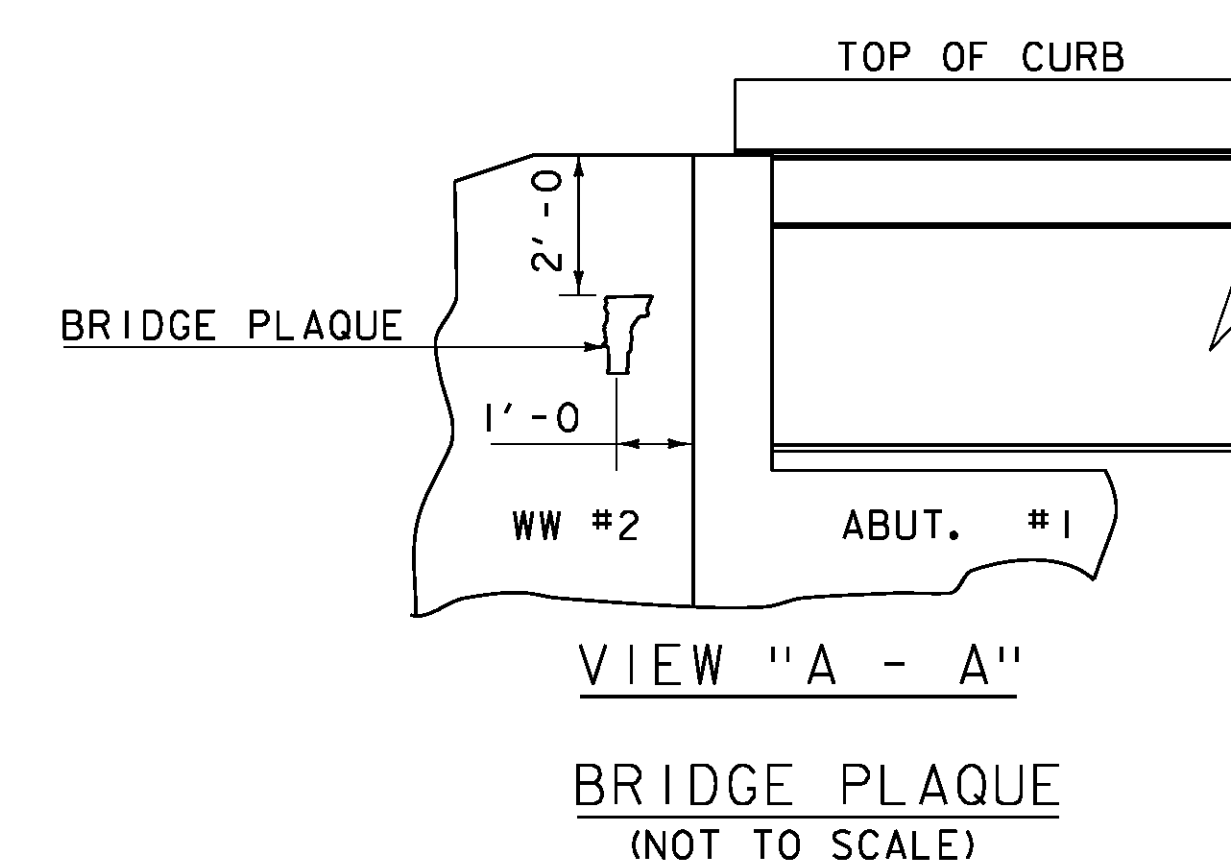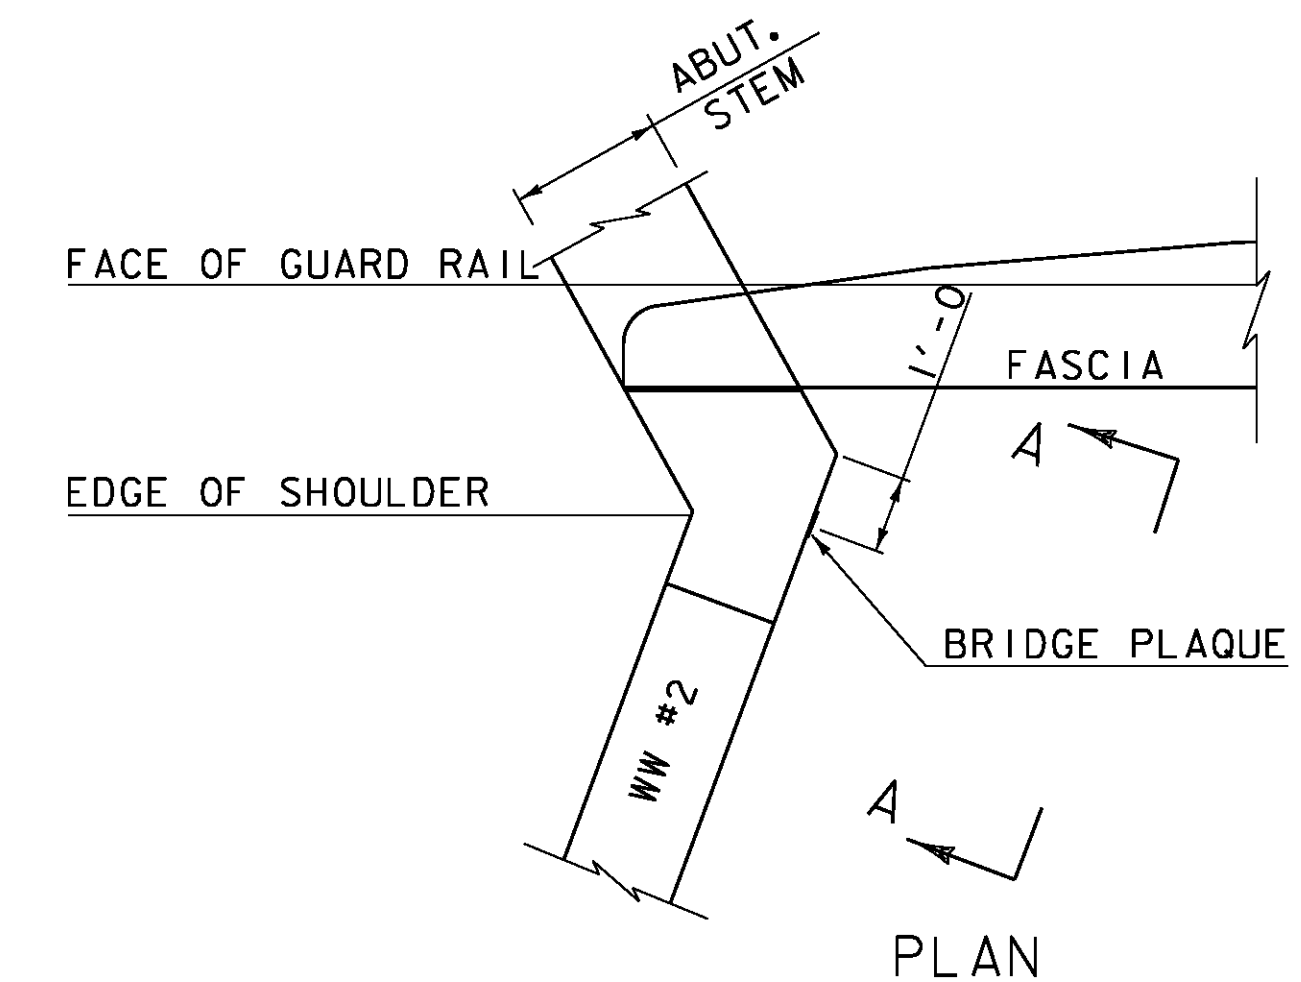


THE BRIDGE PLAQUE WILL BE SUPPLIED BY THE AGENCY OF TRANSPORTATION AND SHALL BE INSTALLED BY THE CONTRACTOR AT ABUTMENT #1 ON THE RIGHT SIDE AS SHOWN OR AS DIRECTED BY THE ENGINEER.

PAYMENT FOR INSTALLATION OF THE BRIDGE PLAQUE SHALL BE INCIDENTAL TO THE ADJACENT CONCRETE.

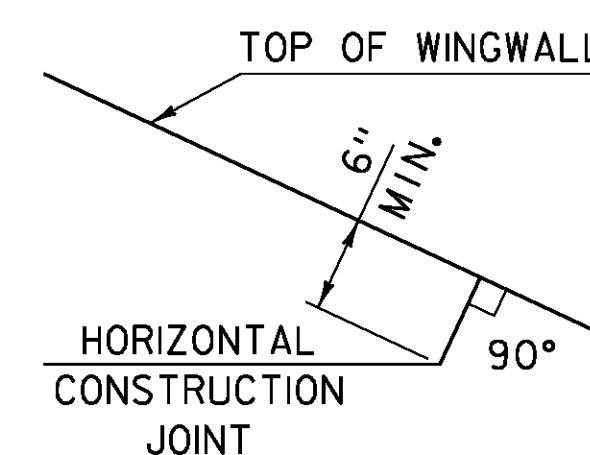


HORIZONTAL WINGWALL  
CONSTRUCTION JOINT  
(NOT TO SCALE)

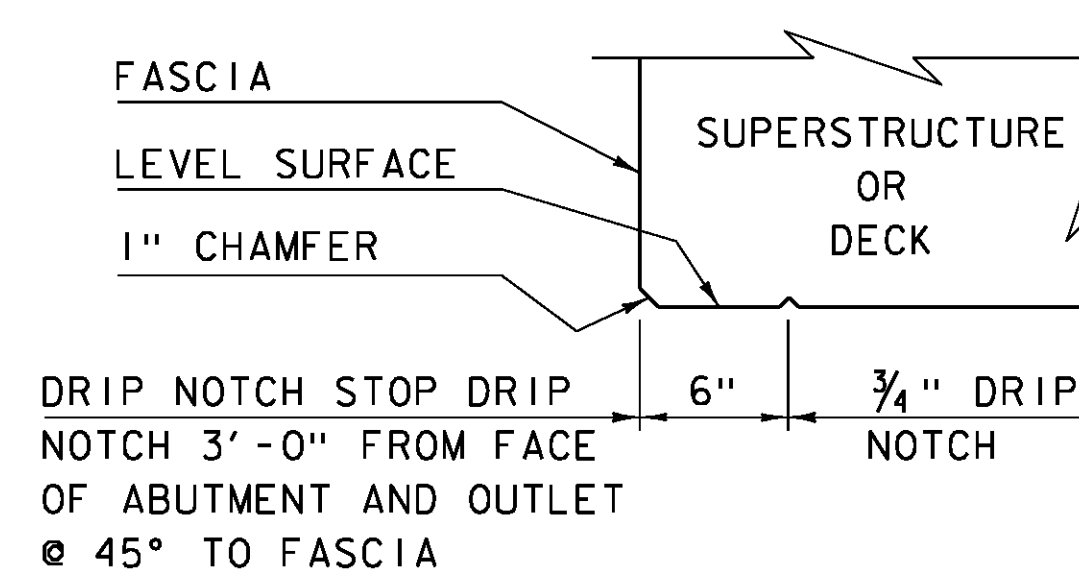

DRIP NOTCH DETAIL  
(NOT TO SCALE)


REVISIONS	
MAY 7, 2010	APPROVED FOR USE BY VAOT STRUCTURES SECTION
JUNE 4, 2010	MODIFIED AND ADDED TWO DETAILS
OCTOBER 10, 2012	MODIFIED HORZ. JOINT WINGWALL ADD 6" MIN. DIMENSION

## CONCRETE DETAILS AND NOTES

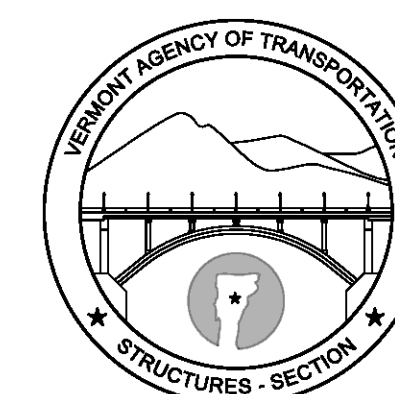

STRUCTURES  
DETAIL  
SD-502.00




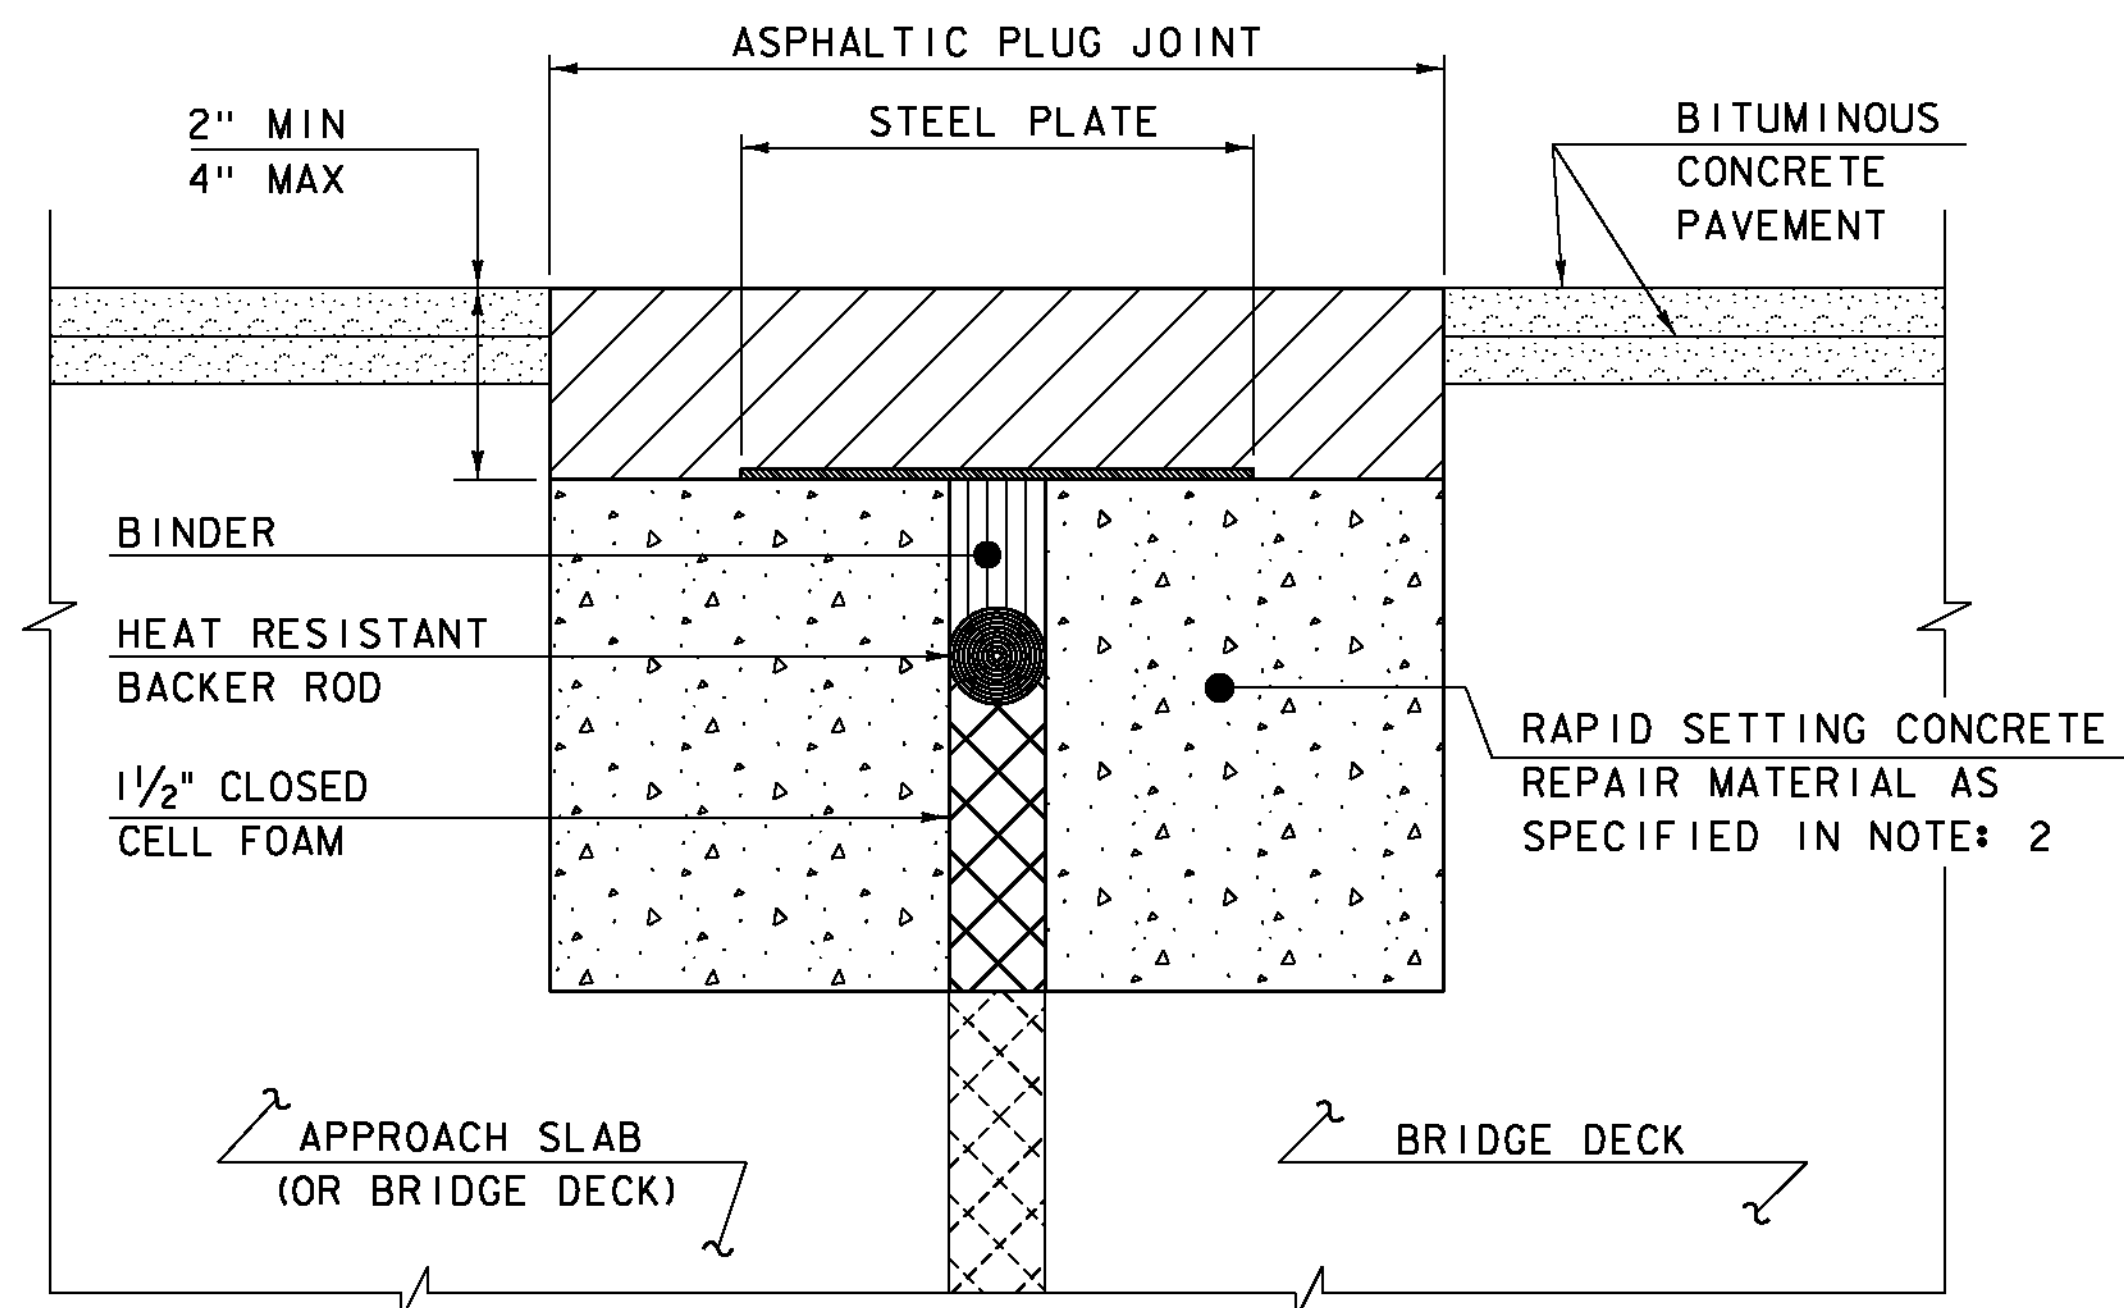

**ASPHALTIC PLUG JOINT DETAIL - REHAB**

**NOTES:**


1. THE CONTRACTOR SHALL REMOVE ALL ASPHALTIC PLUG JOINT MATERIAL AND DETERIORATED CONCRETE AS DIRECTED BY THE ENGINEER. REMOVAL OF THE FIRST 4 INCHES OF MATERIAL SHALL BE INCLUDED IN THE BID PRICE FOR ITEM 516.10 BRIDGE EXPANSION JOINT, ASPHALTIC PLUG. ANY REMOVAL OF MATERIAL GREATER THAN 4 INCHES SHALL BE INCLUDED IN THE BID PRICE OF ITEM 580.20 RAPID SETTING CONCRETE REPAIR MATERIAL WITH COARSE AGGREGATE.
2. THE CONTRACTOR SHALL REPLACE REMOVED MATERIAL THAT IS LESS THAN 4" FROM FINISHED GRADE WITH ASPHALTIC PLUG JOINT MATERIAL MEETING THE REQUIREMENTS OF SUBSECTION 707.15. ALL REMOVED MATERIAL THAT IS GREATER THAN 4 INCHES FROM FINISHED GRADE SHALL BE REPLACED WITH RAPID SETTING CONCRETE REPAIR MATERIAL WITH COARSE AGGREGATE MEETING THE REQUIREMENTS OF SUBSECTION 780.04.
3. REINFORCING STEEL NOT SHOWN FOR CLARITY.
4. PLACE 1/4" THICK BY 8" WIDE SECTIONS OF STEEL PLATE OVER THE CENTER OF THE MOVEMENT GAP. SECURE THE PLATES FROM MOVING BY INSERTING LOCATING PINS THROUGH THE PRE-STAMPED HOLES INTO BACKER ROD AND COVER WITH HOT BINDER. THE STEEL PLATES MAY BE OMITTED WHERE THE ENGINEER DETERMINES THAT THE APPROACH SLAB OR BRIDGE DECK WILL PROVIDE INADEQUATE SUPPORT AND WHERE VERTICAL MOVEMENT OF THE PLATES MIGHT OCCUR.

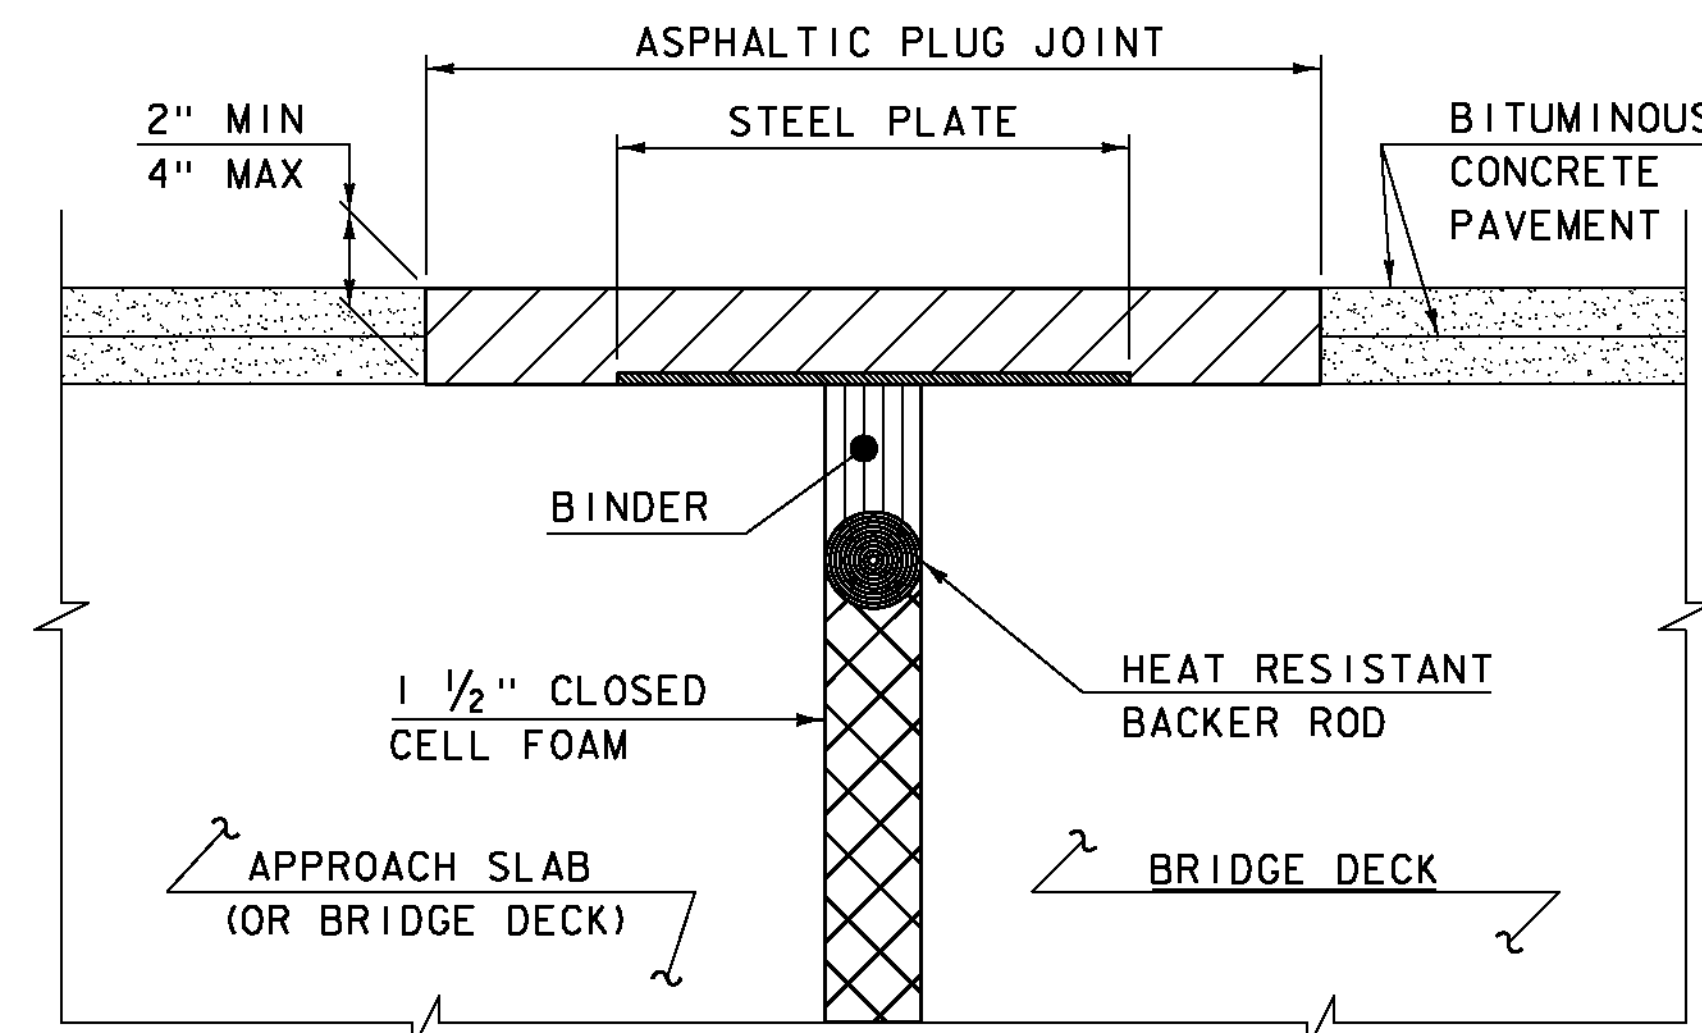

**ASPHALTIC PLUG JOINT DETAIL "A" - NEW**

**NOTE:**

PLACE 1/4" THICK BY 8" WIDE SECTIONS OF STEEL PLATE OVER THE CENTER OF THE MOVEMENT GAP. SECURE THE PLATES FROM MOVING BY INSERTING LOCATING PINS THROUGH THE PRE-STAMPED HOLES INTO BACKER ROD AND COVER WITH HOT BINDER.

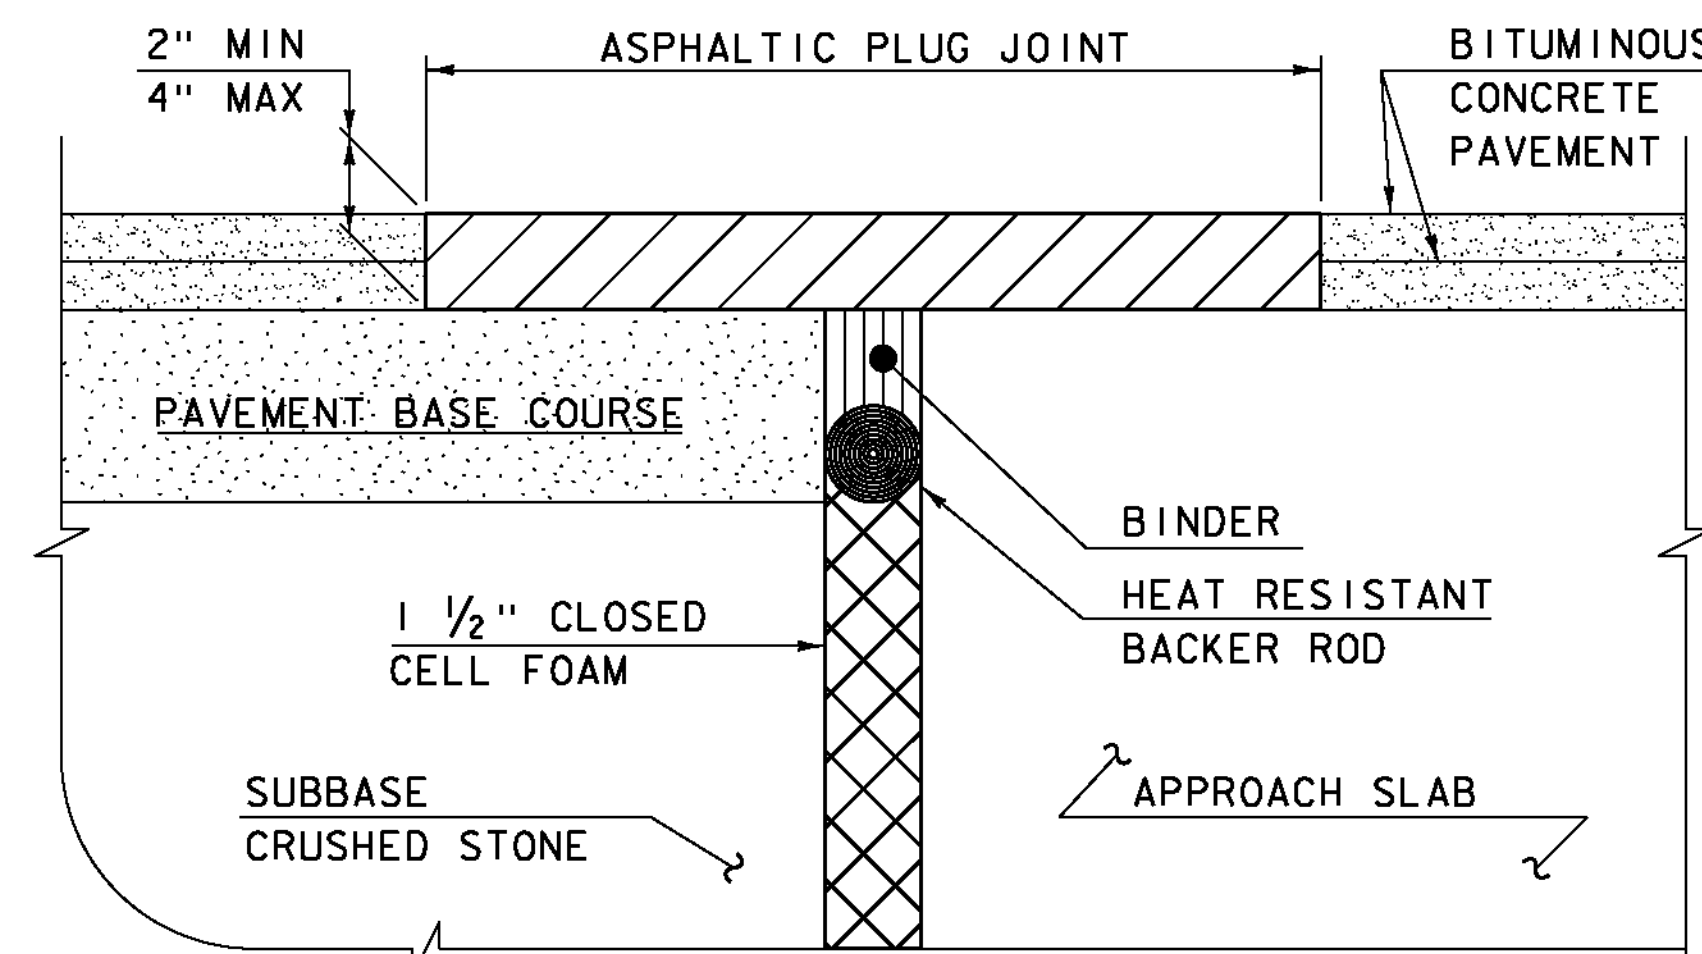

**ASPHALTIC PLUG JOINT DETAIL "B" - NEW**

**ASPHALTIC PLUG JOINT NOTES**

**INSTALLATION:**

1. LOCATE THE JOINT CENTRALLY OVER THE DECK OVERLAY EXPANSION GAP OR FIXED JOINT, MARKED OUT TO THE MANUFACTURER'S RECOMMENDED WIDTH.
2. REMOVE THE BITUMINOUS CONCRETE PAVEMENT FULL DEPTH AS SHOWN ON THE PLANS. THE PAVEMENT SHALL BE DRY AND SAW CUT TO THE LIMITS REQUIRED TO PLACE THE JOINT. A PNEUMATIC HAMMER AND CHISEL MAY BE USED ADJACENT TO THE CURB ONLY WHEN SAW CUTTING IS NOT POSSIBLE.
3. BLAST CLEAN THE JOINT AREA OF DEBRIS, ASPHALT AND SHEET MEMBRANE. THOROUGHLY DRY THE JOINT AREA WITH COMPRESSED AIR PRIOR TO APPLYING BINDER MATERIAL.
4. PLACE PROPERLY SIZED HEAT RESISTANT BACKER ROD IN THE MOVEMENT GAP ALLOWING FOR 1" +/- OF BINDER ABOVE THE ROD.
5. HEAT AND PLACE THE BINDER MATERIAL AS RECOMMENDED BY THE MANUFACTURER.
6. IMMEDIATELY AFTER TOP COATING, CAST AN ANTI-SKID MATERIAL OVER THE JOINT TO REDUCE THE RISK OF TRACKING.

**WEATHER LIMITATIONS**


APPLY BINDER MATERIAL ONLY WHEN THE FOLLOWING CONDITIONS PREVAIL OR AS RECOMMENDED BY THE MANUFACTURER:

1. THE AMBIENT AIR TEMPERATURE IS AT LEAST 10 DEG C (50 DEG F) AND RISING.
2. THE ROAD SURFACE IS DRY.
3. WEATHER CONDITIONS OR OTHER CONDITIONS ARE FAVORABLE AND ARE EXPECTED TO REMAIN SO FOR THE PERFORMANCE OF SATISFACTORY WORK.

DETAILS ON THIS SHEET ARE NOT TO SCALE.

REVISIONS	
MAY 7, 2010	APPROVED FOR USE BY VAOT STRUCTURES SECTION
AUGUST 29, 2011	ADD DETAIL "B" AND REV. NOTES

**BRIDGE JOINT  
ASPHALTIC PLUG**

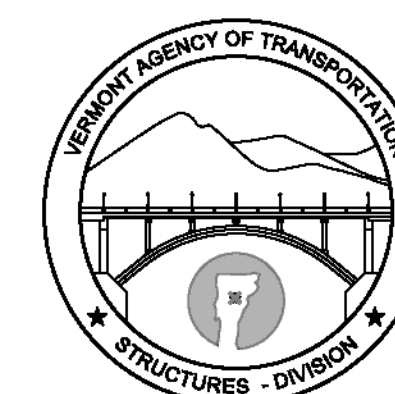


**STRUCTURES  
DETAIL  
SD-516.10**



STRUCTURAL STEEL GENERAL NOTES:


- 1. ALL FIELD CONNECTIONS SHALL BE MADE WITH 7/8" DIAMETER HIGH-STRENGTH BOLTS IN 15/16" DIAMETER HOLES, PER SUBSECTION 506.I9, UNLESS OTHERWISE SPECIFIED.
- 2. ALL HOLES IN THE WEBS OF THE FASCIA GIRDERS THAT ARE NOT OTHERWISE FILLED, SHALL BE FILLED WITH EITHER BUTTON HEAD OR HEX HEAD BOLTS. THESE BOLTS SHALL BE TIGHTENED IN ACCORDANCE WITH SUBSECTION 506.I9.
- 3. ALL WELDING SHALL CONFORM TO THE PROVISIONS OF SUBSECTION 506.I0.
- 4. ANY CONNECTIONS THAT ARE NOT DETAILED ON THE PLANS SHALL BE DETAILED BY THE FABRICATOR AND SUBMITTED TO THE STRUCTURES ENGINEER FOR APPROVAL.
- 5. STRUCTURAL STEEL MEMBERS DESIGNATED "CVN" IN THE PLANS SHALL BE CHARPY V-NOTCH TESTED IN ACCORDANCE WITH SUBSECTION 714.01 OF THE STANDARD SPECIFICATIONS.
- 6. ENDS OF GIRDERS ARE TO BE VERTICAL IN THEIR FINAL POSITION.
- 7. AFTER SUPERSTRUCTURE STEEL HAS BEEN ERECTED, ELEVATIONS ALONG THE TOP OF THE GIRDERS SHALL BE TAKEN AS DIRECTED BY THE RESIDENT ENGINEER FOR USE IN DETERMINING FINISHED GRADES.

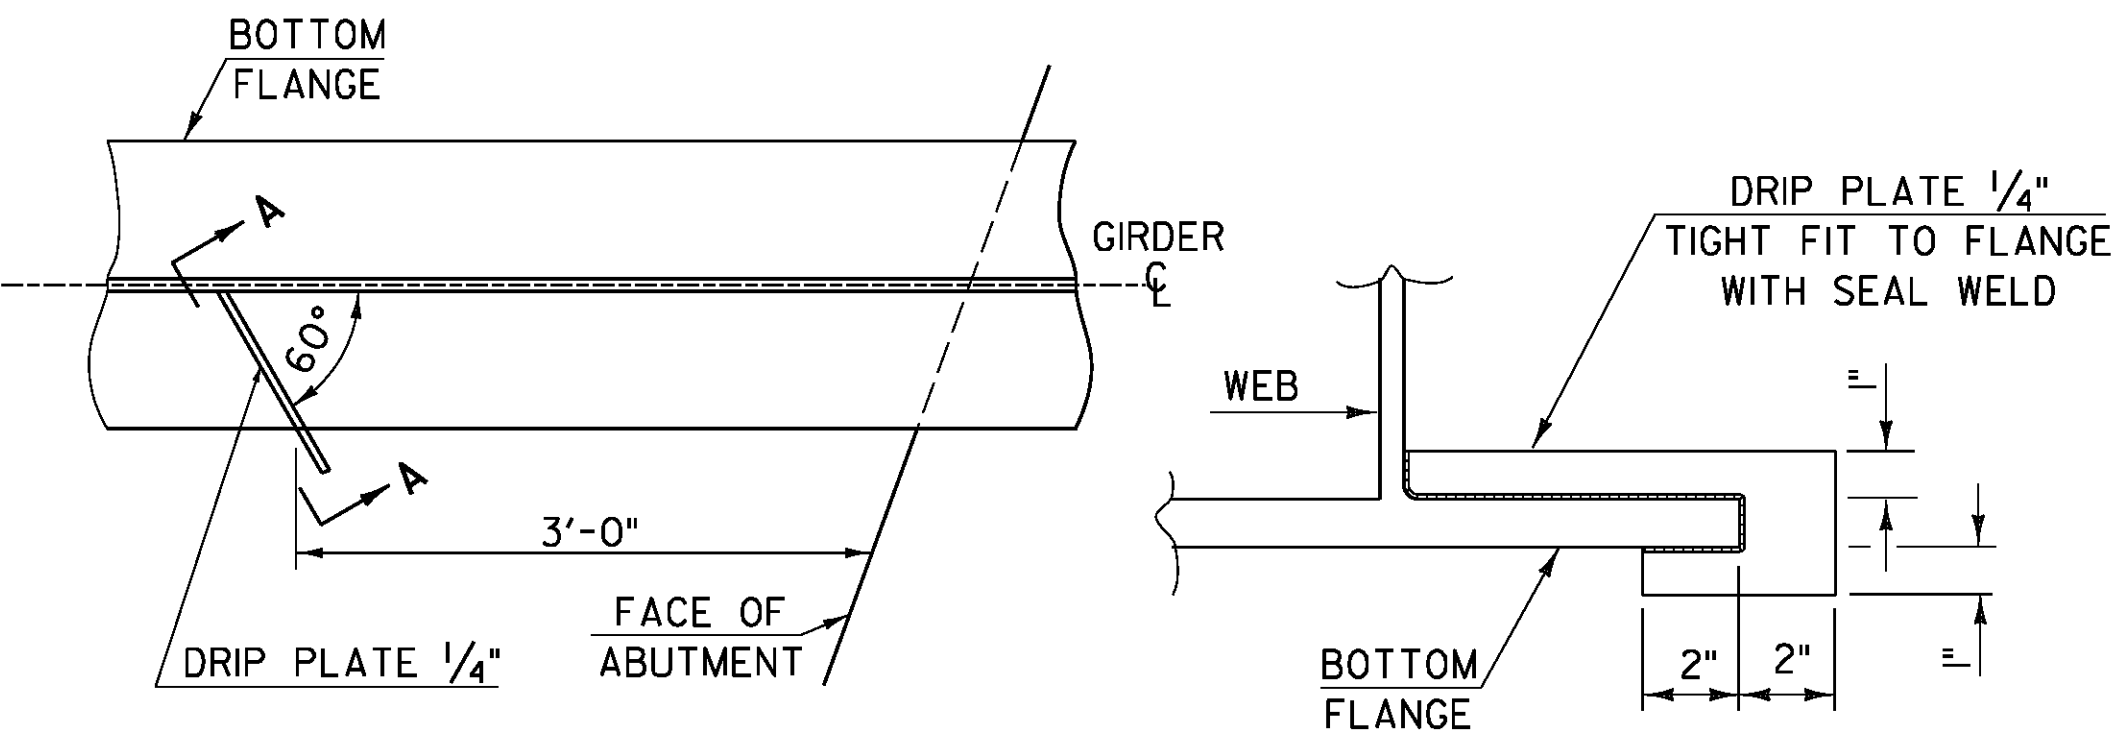

PLAN DRIP PLATE


SECTION A - A

NOTE: DRIP PLATES SHALL BE PLACED ON OUTSIDE EDGE OF FASCIA GIRDERS ON THE HIGH SIDE OF ALL PIERS AND ABUTMENTS OR AS INDICATED ON PROJECT PLANS.

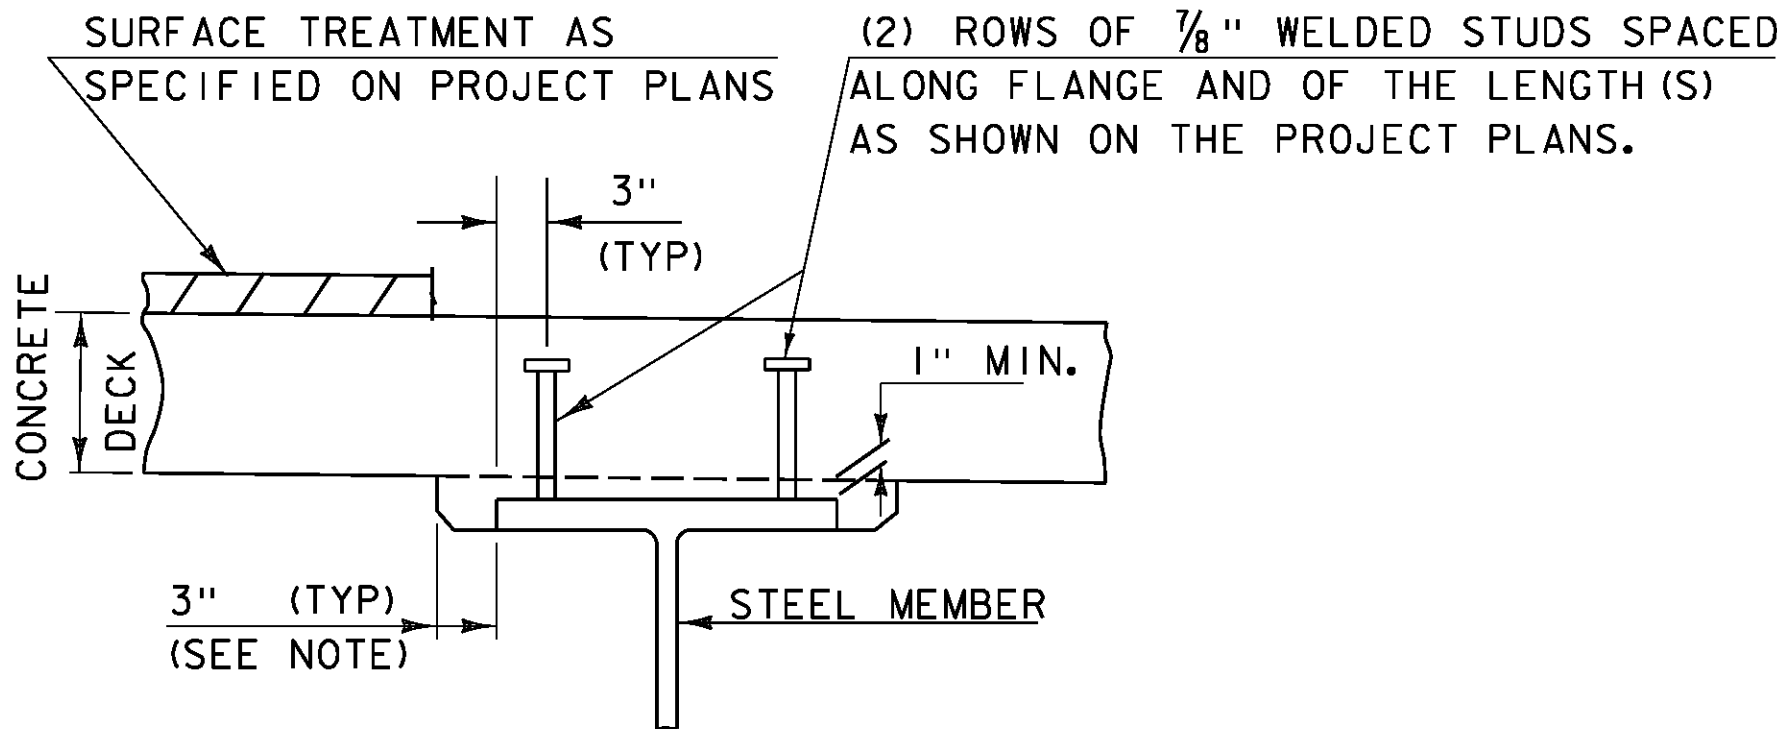

NOTE:  
THE 3" HORIZONTAL SECTION MAY BE ELIMINATED FOR FORMING SYSTEMS DESIGNED FOR THE CONSTRUCTION OF VERTICAL HAUNCHES. ANY VOIDS RESULTING FROM FORMING SYSTEM ELEMENTS SHALL BE FILLED WITH JOINT SEALER, POLYURETHANE MEETING THE REQUIREMENTS OF SECTION 524. THE COST OF THE JOINT SEALER, POLYURETHANE SHALL BE INCIDENTAL TO THE ADJACENT CONCRETE.

HAUNCH AND SHEAR CONNECTOR DETAIL

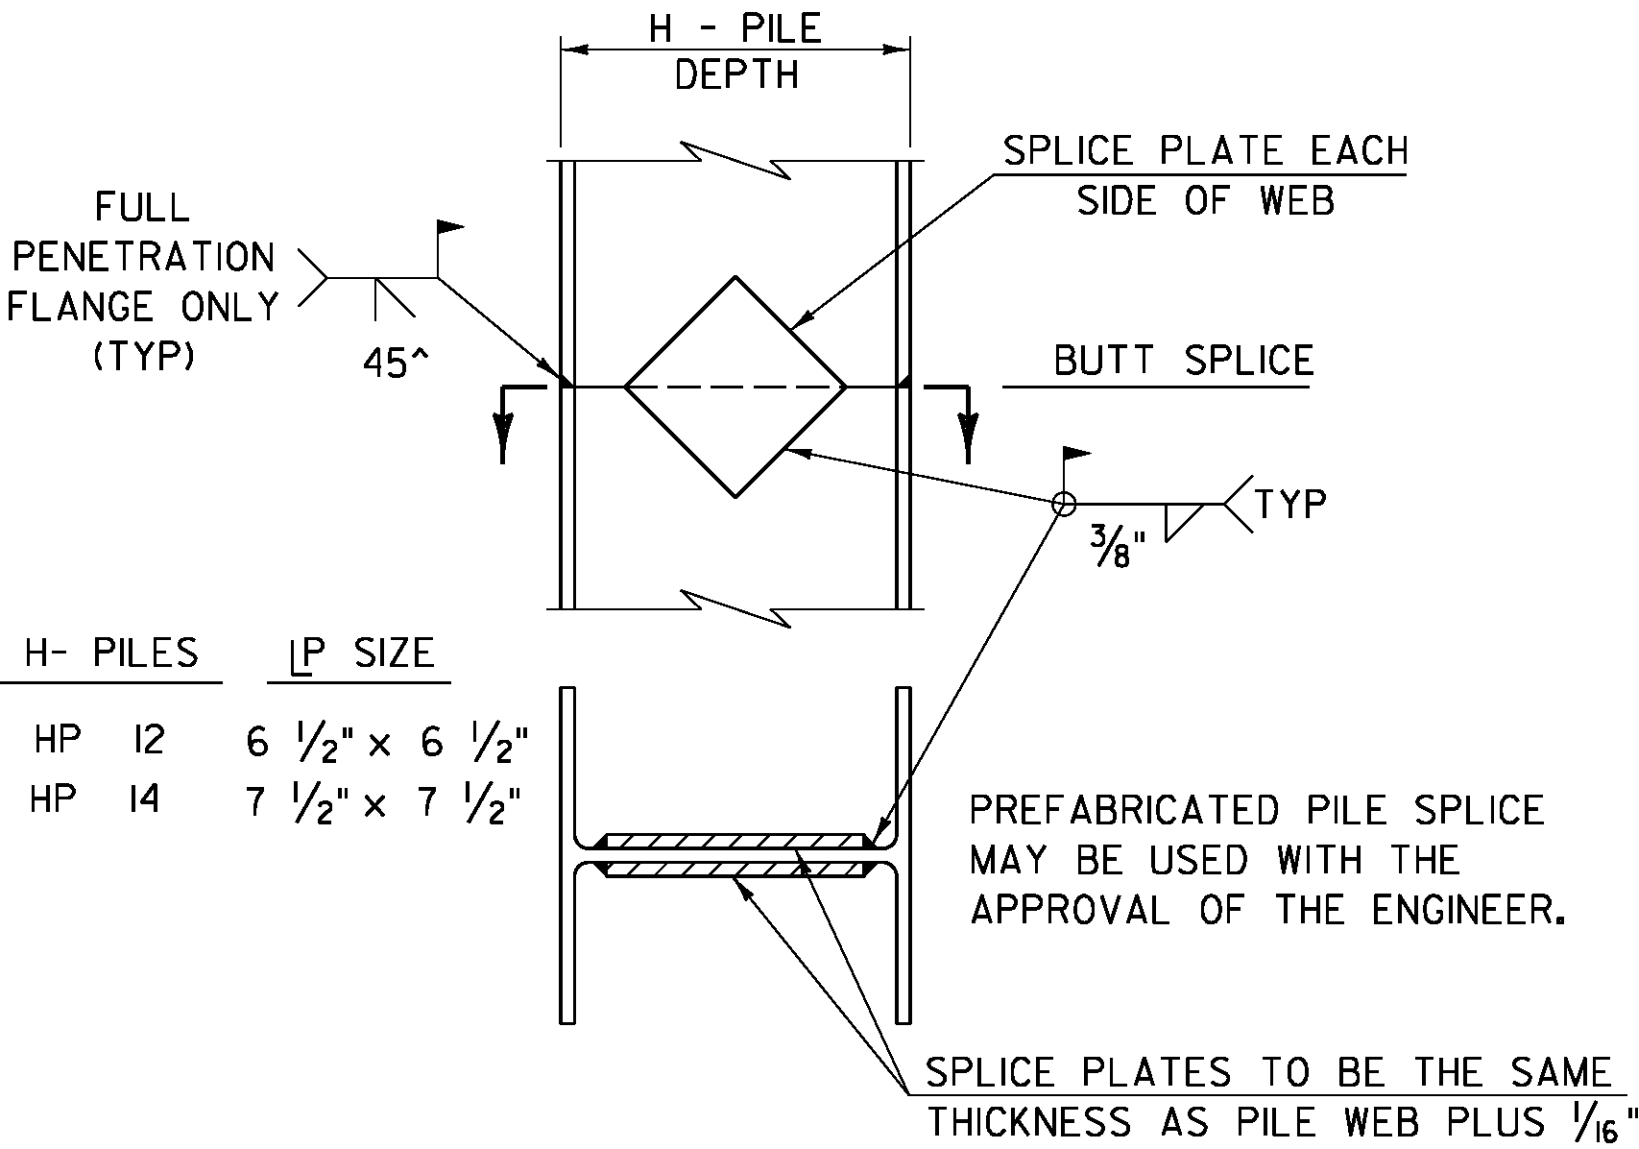


H- PILES	IP SIZE
HP 12	6 1/2" x 6 1/2"
HP 14	7 1/2" x 7 1/2"

DETAIL OF PILE SPLICE

DETAILS ON THIS SHEET ARE "NOT TO SCALE" UNLESS NOTED OTHERWISE.

REVISIONS	
MAY 7, 2010	APPROVED FOR USE BY VAOT STRUCTURES SECTION
JUNE 4, 2010	MODIFIED NOTES

STRUCTURAL STEEL  
DETAILS & NOTES






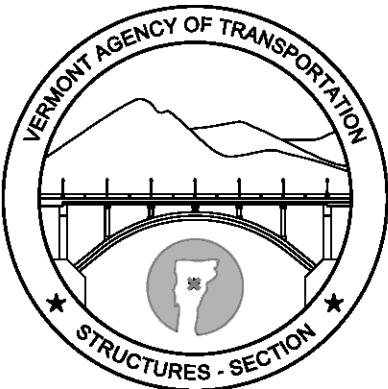


STRUCTURES  
DETAIL  
SD-601.00








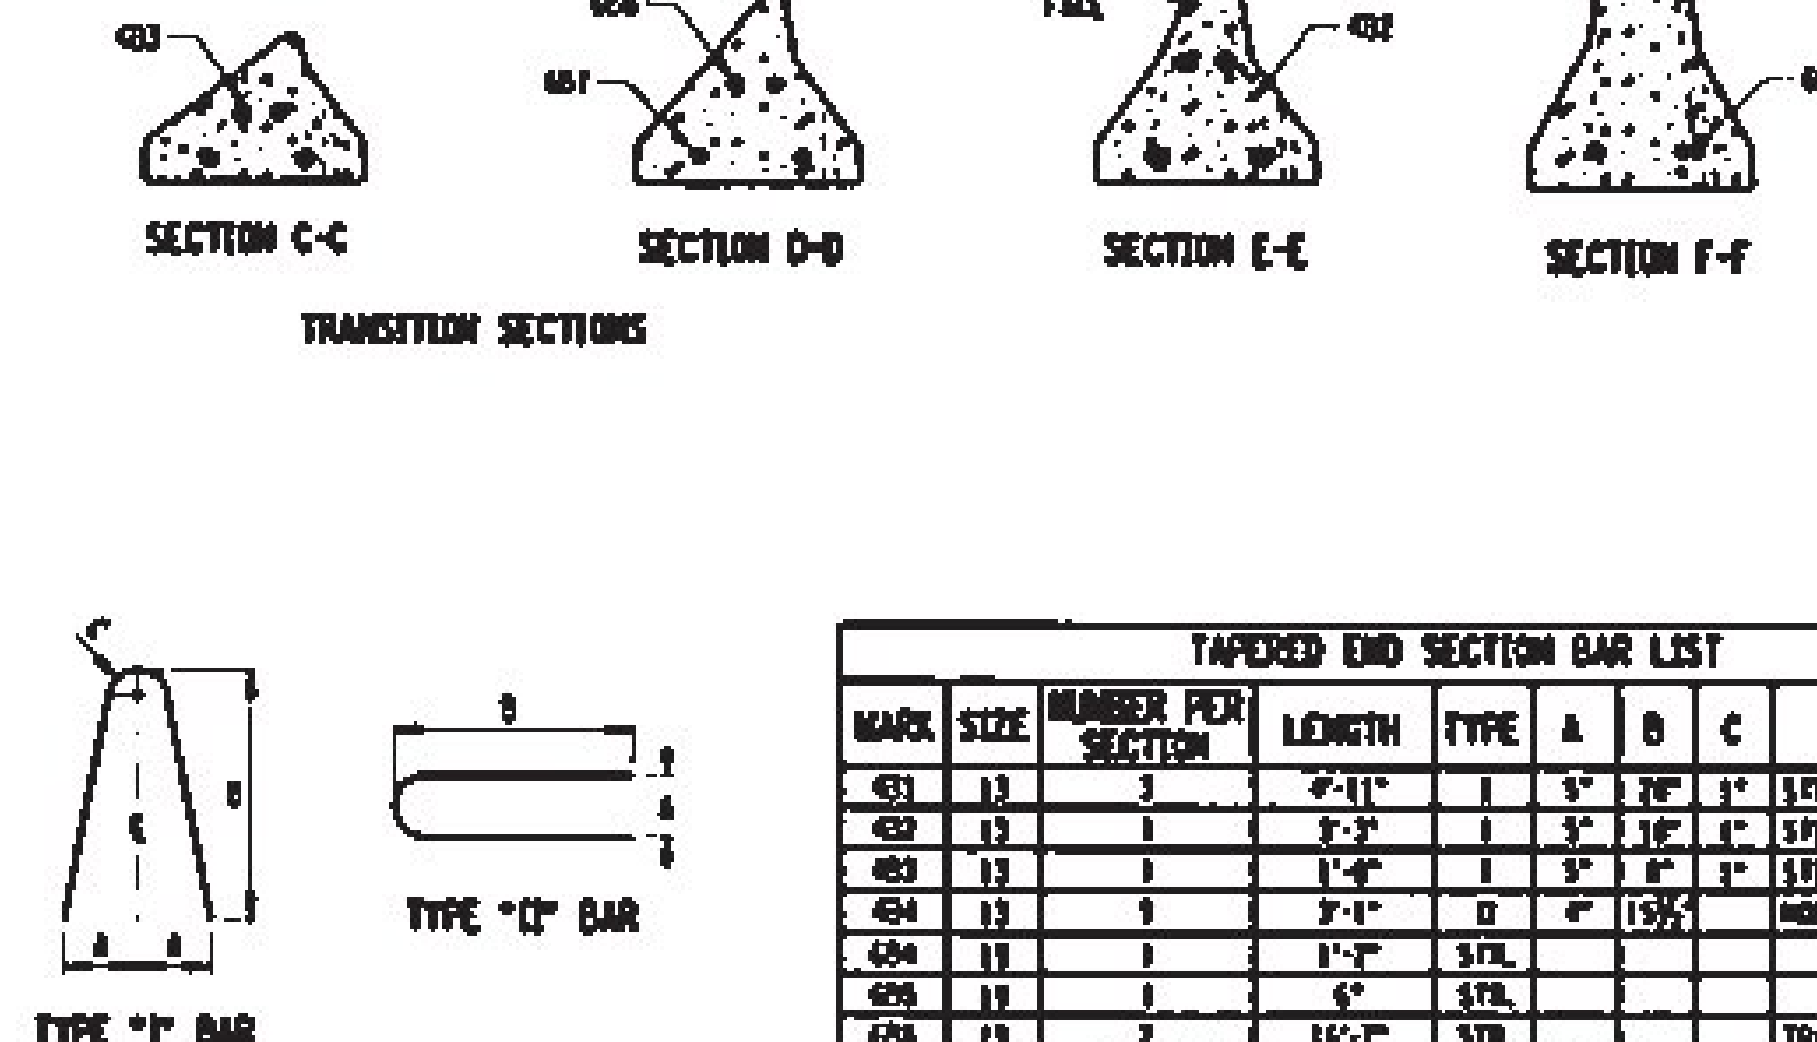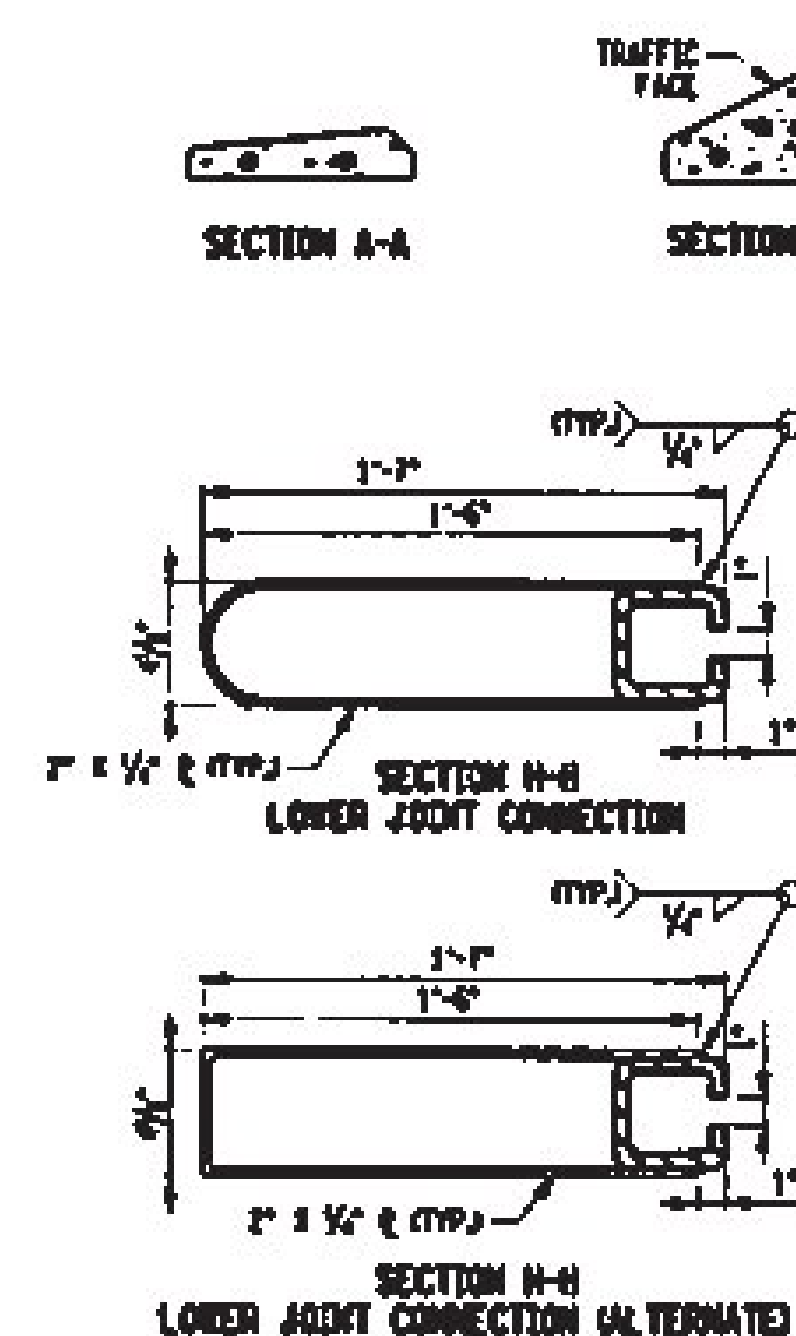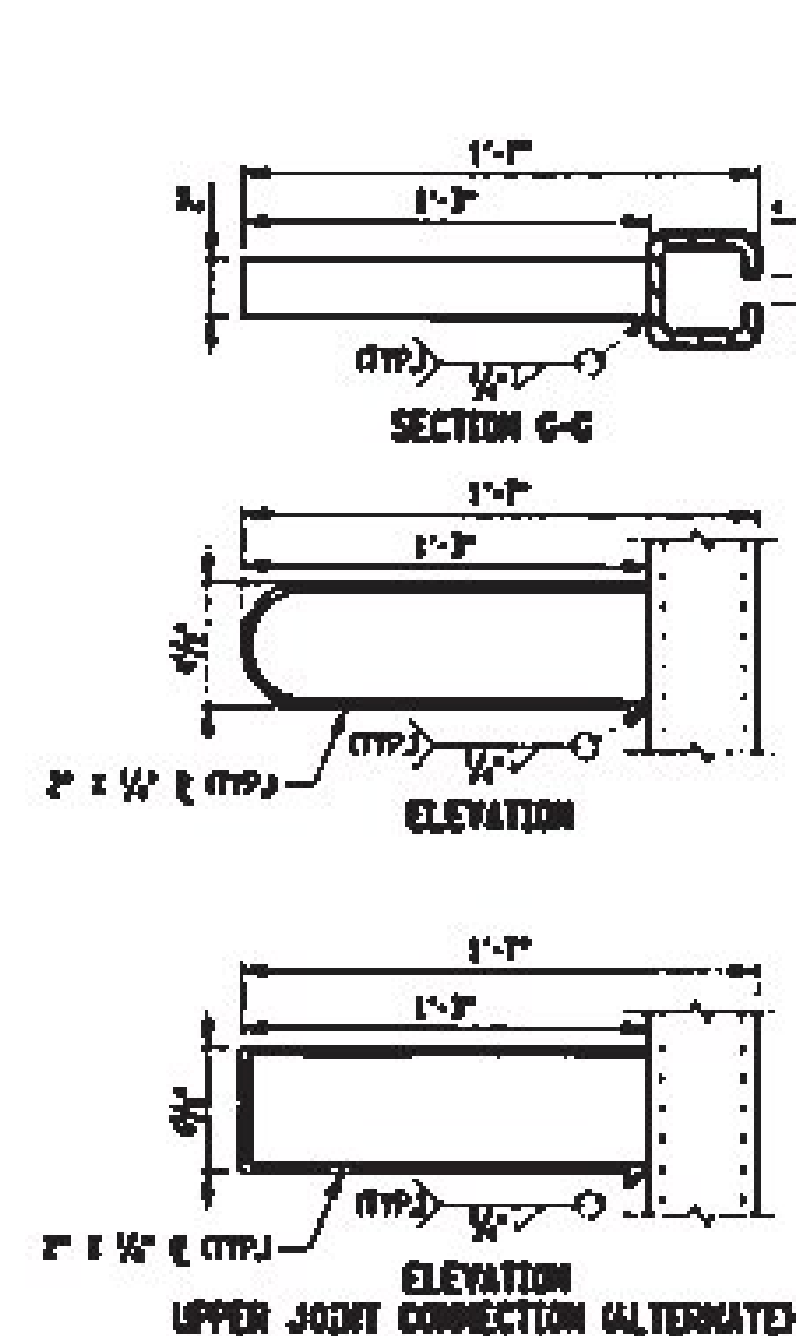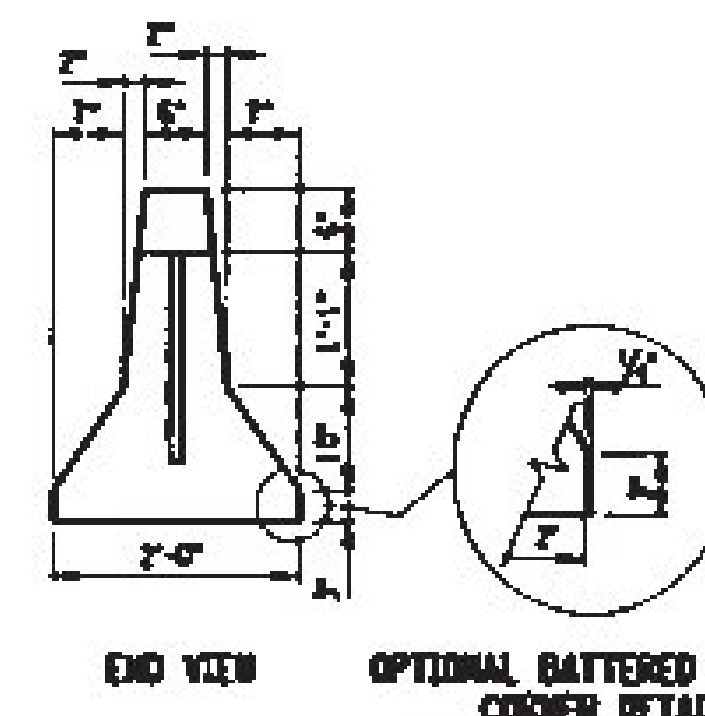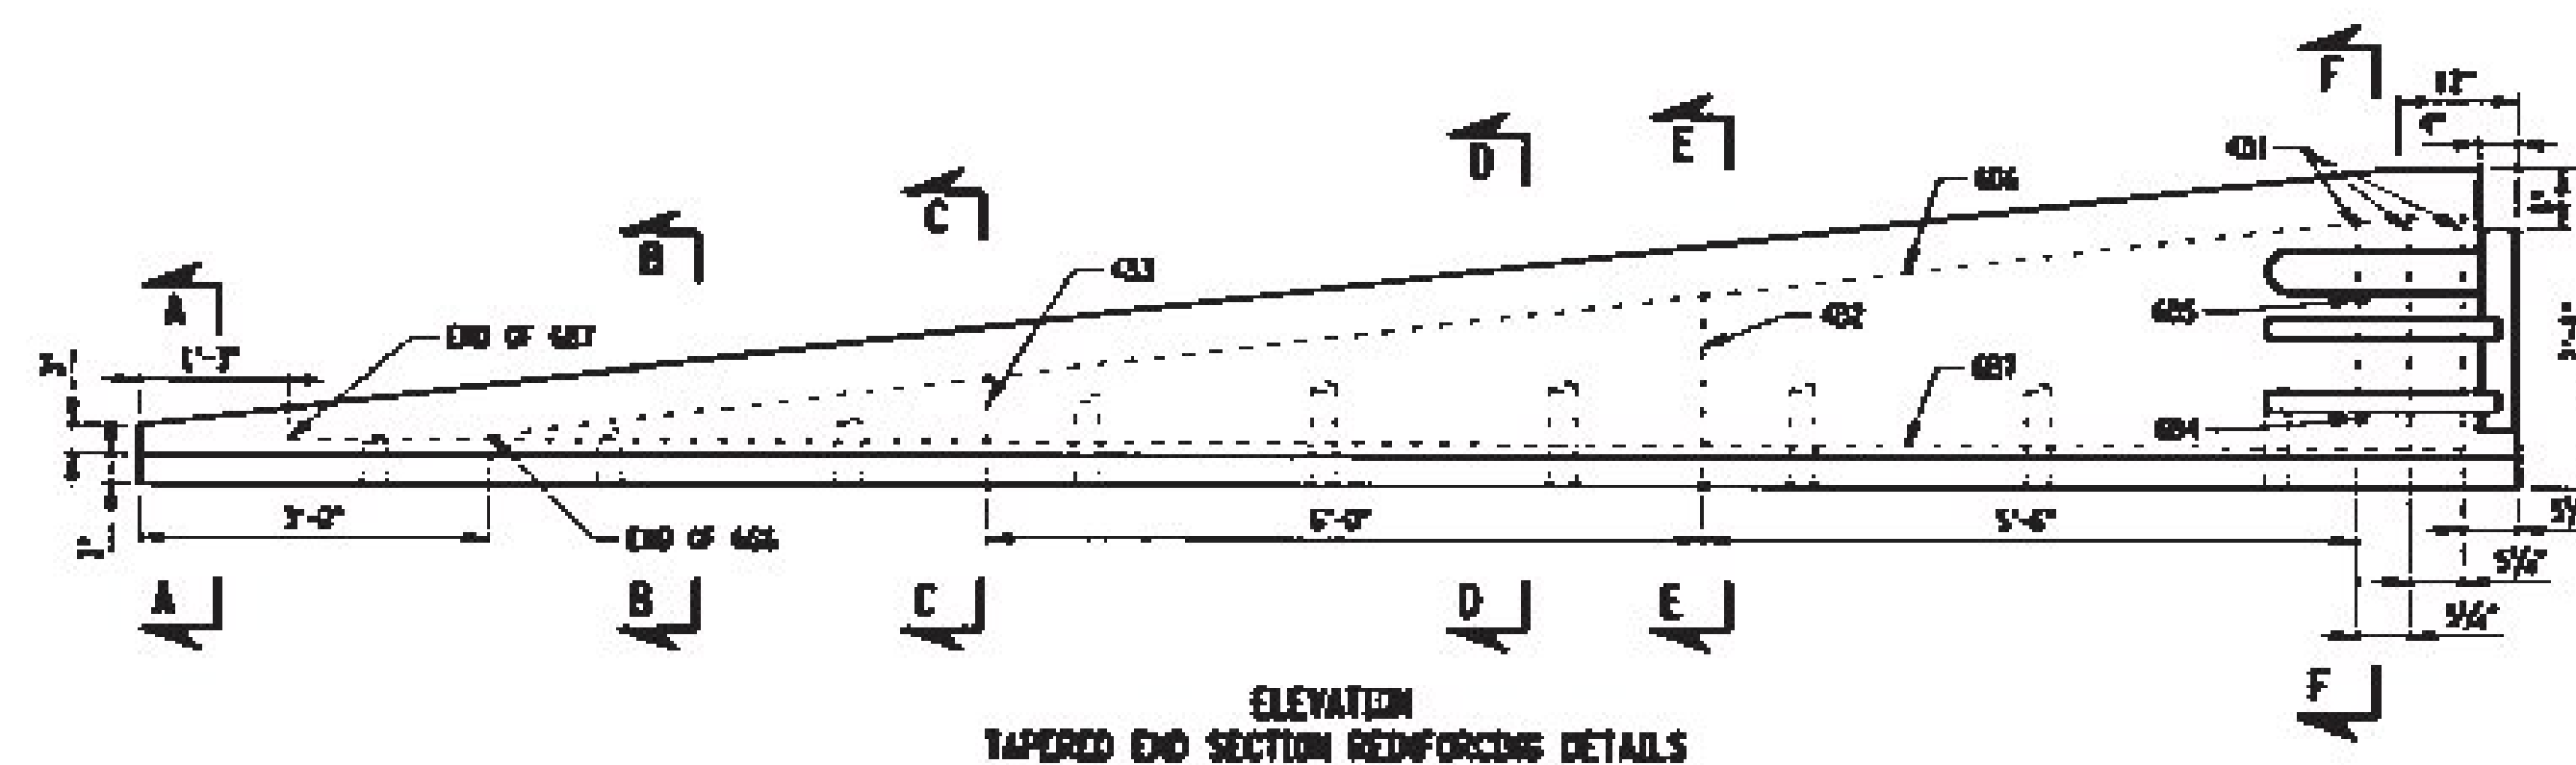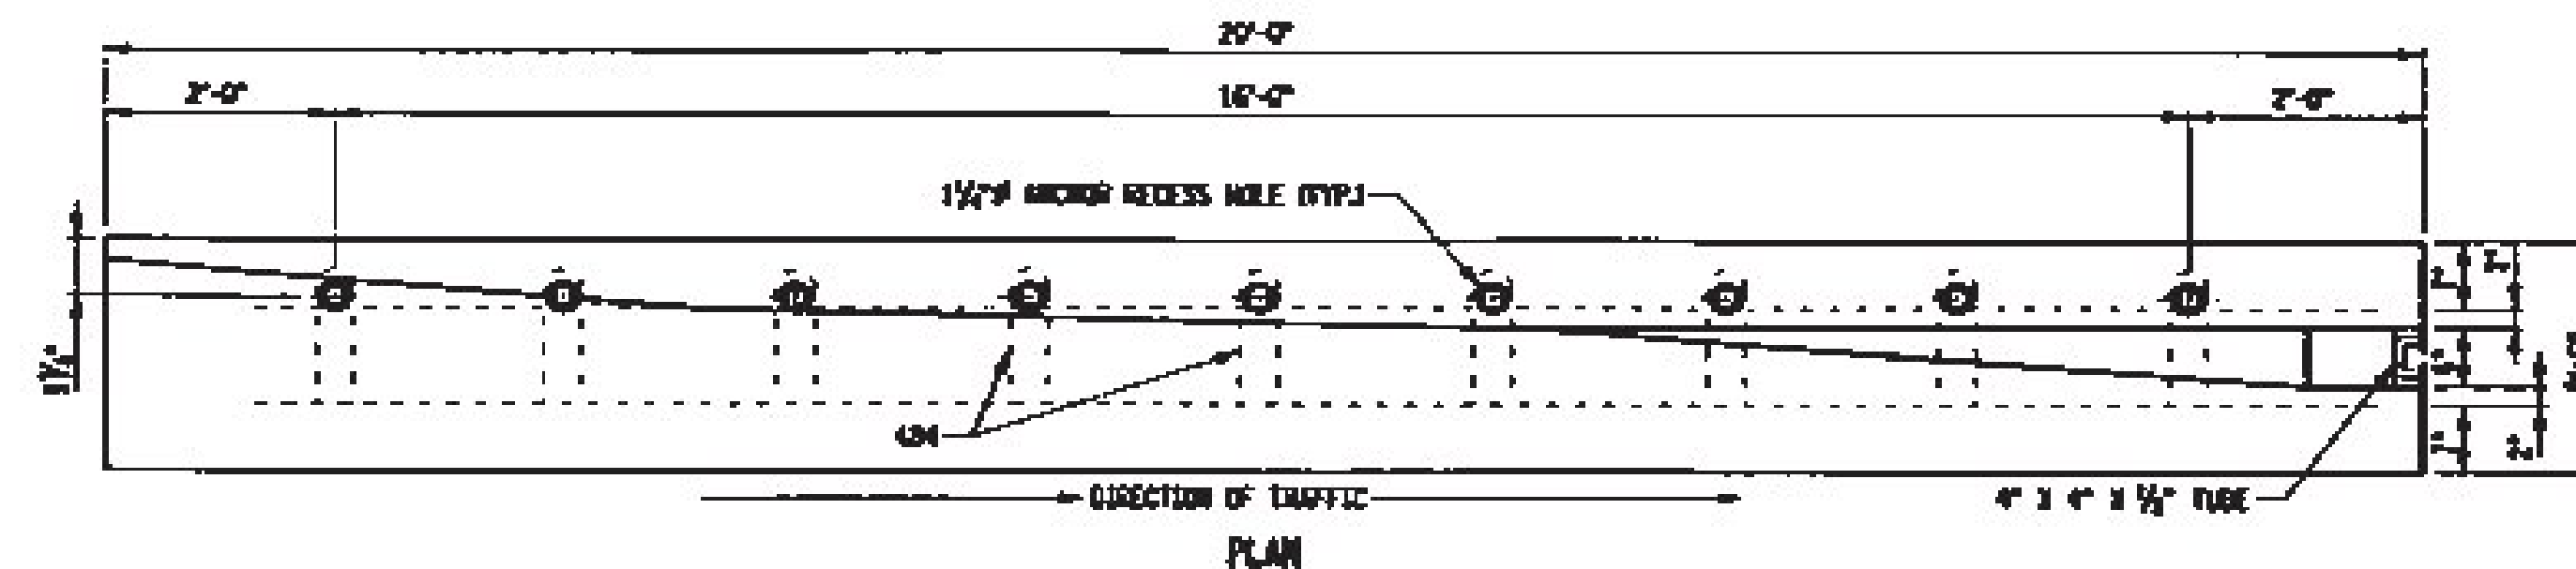

TAPERED END SECTION BAR LIST							
MARK	SIZE	NUMBER PER SECTION	LENGTH	TYPE	A	B	C
431	12	3	4'-11"	I	3"	20"	3"
432	12	1	3'-3"	I	3"	16"	4"
433	12	1	1'-4"	I	3"	8"	3"
434	12	1	2'-1"	I	4"	15"	100%
435	12	1	1'-3"	STL			
436	12	1	5"	STL			
437	12	2	16'-2"	STL			TRANSVERSE (TOP)
438	12	2	16'-2"	STL			TRANSVERSE (BOTTOM)

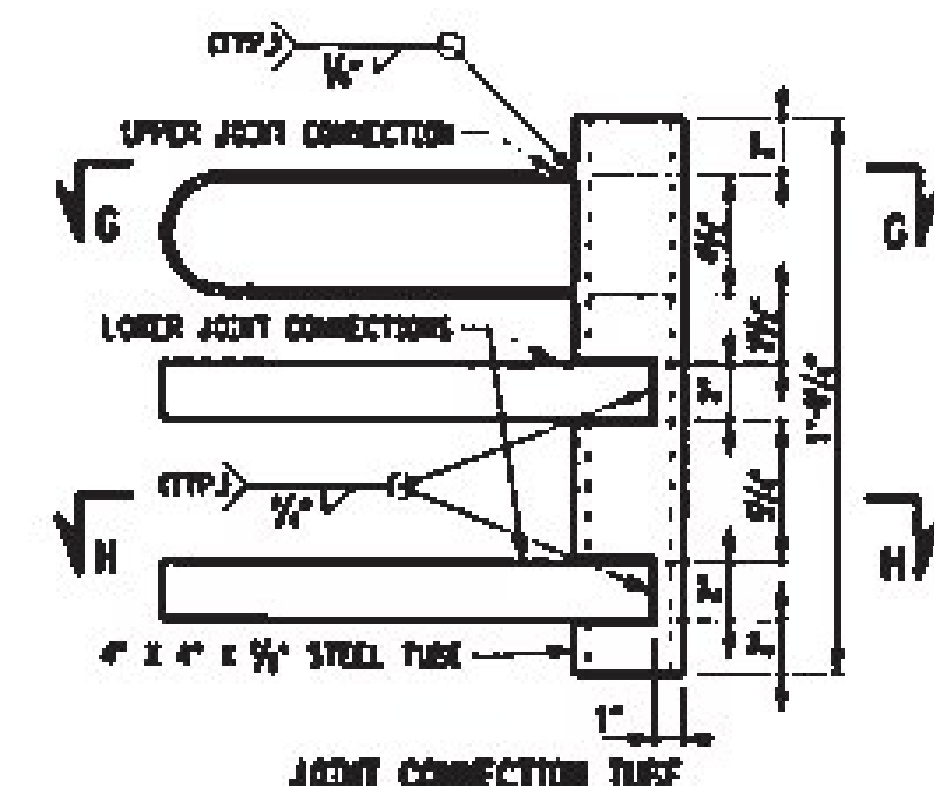

- NOTES:
1. TEMPORARY CONCRETE BARRIER SHALL BE PRECAST IN ACCORDANCE WITH THE REQUIREMENTS OF SP-4-02, PRECAST CONCRETE BARRIER.
  2. STEEL PLATE SHALL BE ASTM A36, ASTM GRADE 36S, TUBE STEEL SHALL BE ASTM A500 GRADE B OR C, AND REINFORCING BARS SHALL BE ASTM GRADE 432.
  3. ALL WELDING SHALL BE PERFORMED BY A QUALIFIED WELDER IN ACCORDANCE WITH SECTION 6 OF THE NYS STEEL CONSTRUCTION MANUAL.
  4. SURFACES TO BE WELDED SHALL BE FREE OF SLAG, RUST, MOISTURE, GREASE OR ANY OTHER MATERIAL THAT WILL PREVENT PROPER WELDING OR PRODUCE OBJECTIONABLE FUMES.
  5. WELDING SHALL BE SHIELDED METAL ARC WELDING USING PROPERLY DRIED  $\frac{1}{8}$ " (TIG) ELECTRODES CONFORMING TO THE REQUIREMENTS OF SECTION 7 OF THE NYS STEEL CONSTRUCTION MANUAL.
  6. CONCRETE CLEAR COVER FOR REINFORCING BARS SHALL BE  $\frac{1}{2}$ " MIN. EXCEPT WHERE OTHERWISE SPECIFIED.
  7. A MINIMUM OF TWO RECESSED LIFTING DEVICES, WITH THE CAPACITY TO LIFT A MASS OF 6 TONS EACH, SHALL BE INSTALLED ON EACH SEGMENT.
  8.  $\frac{1}{4}$ " ASTM A36 ANCHOR PINS SHALL BE PLACED IN FOUR RECESSES OF EACH SEGMENT TO BE PINNED.
  9. CONNECTION KEY COVER PLATE SHALL BE INSTALLED FLUSH WITH THE BACKER TOP.
  10. THE DETAILS SHOWN FOR THE END SECTIONS ON THIS SHEET ARE FOR APPROACH ENDS WHICH ARE TO BE LOCATED TO THE LEFT OF THE TRAFFIC FLOW ON ONE-WAY OPERATIONS OR BETWEEN OPPOSING FLOWS OF TRAFFIC ON TWO-WAY OPERATIONS. WHEN AN APPROACH END IS TO BE LOCATED TO THE RIGHT OF THE TRAFFIC FLOW, THE END SEGMENT SHALL BE CONSTRUCTED SO THAT IT IS OPPOSITE-SIDE RECESSED IN ALL CONFIGURATIONS, ANCHOR HOLE LOCATIONS AND REINFORCEMENT.
  11. ALL CORNERS ON THE TOP OF THE SEGMENT SHALL BE ROUNDED TO A 1" RADIUS. THE SEGMENT SHALL HAVE A SMOOTH TRANSITION TO A 6" END-OF-SECTION HEIGHT. ALL END SECTIONS SHALL BE PINNED UNLESS OTHERWISE NOTED.

STATE OF NEW YORK DEPARTMENT OF TRANSPORTATION	
U.S. CUSTOMARY STANDARD SHEET	
TEMPORARY CONCRETE BARRIER (SHEET 2 OF 3)	
APPROVED SEPTEMBER 30, 2009	ISSUED UNDER CD 09-015
PER J. F. MYRA, P.E. DEPUTY CHIEF ENGINEER CONSTRUCTION	619-01

EFFECTIVE DATE: 01/07/10

FILE NAME: C:\NYS-002-00000000  
CONNECTIONS: 10-SEP-2009 14:51  
USER: J. F. MYRA





EFFECTIVE DATE: 01/05/11



To:		New York State Department of Transportation <b>ENGINEERING BULLETIN</b>	<b>EB 10-034</b>
Expires one year after issue unless replaced sooner			
Title: <b>BOX BEAM STIFFENING OF TEMPORARY CONCRETE BARRIER</b>			
Distribution: <input checked="" type="checkbox"/> Manufacturers (18) <input type="checkbox"/> Surveyors (33) <input checked="" type="checkbox"/> Local Govt. (31) <input checked="" type="checkbox"/> Consultants (34) <input checked="" type="checkbox"/> Agencies (32) <input checked="" type="checkbox"/> Contractors (39) <input type="checkbox"/> _____ ( )		Approved: /s/J.F. Tynan James F. Tynan, P.E. Deputy Chief Engineer (Construction)	
		8-31-10 Date	

#### ADMINISTRATIVE INFORMATION:

- This Engineering Bulletin (EB) is effective beginning with projects submitted for the letting of 01/06/11.
- This EB does not supersede any previous issuances.
- This standard sheet will be incorporated into the next complete printing of the Standard Sheets.

#### PURPOSE:

The purpose of this EB is to issue Standard Sheets *619-01 Temporary Concrete Barrier (Sheet 3 of 3)* and *M619-72 Box Beam Stiffening of Temporary Concrete Barrier*.

#### TECHNICAL INFORMATION:

- Box Beam Stiffening of Temporary Concrete Barrier is an option to limit the deflection of temporary concrete barrier to 2.2 feet for standard impact conditions (5000# pickup impacting at 62 mph and a 25° angle). Without box beam stiffening, the deflection was 3.3 feet. With all segments pinned and no box beam stiffening, the deflection was 0.7 feet.
- Standard Specification Section 619 will subsequently be modified to include construction details and separate payment items for Box Beam Stiffened Temporary Concrete Barrier. In the interim, if a designer plans to use this detail, he/she must submit a special specification to the Design Quality Assurance Bureau, Specification and Standards Section for approval. Contact Terry Hale at [terry.hale@dot.state.ny.us](mailto:terry.hale@dot.state.ny.us) or (518) 485-7009 for assistance.
- Standard Sheets 619-01, 1 of 2 and 2 of 2 will be renumbered to 1 of 3 and 2 of 3 on the website, but will not be reissued.

#### TRANSMITTED MATERIALS:

Standard Sheets *619-01 Temporary Concrete Barrier (Sheet 3 of 3)* and *M619-72 Box Beam Stiffening of Temporary Concrete Barrier* are available on the IntraDOT and the Department's website at: <https://www.nysdot.gov/main/business-center/engineering/cadd-info/drawings>


#### BACKGROUND:

In 2007, research was conducted on a concept to reduce the deflection of TCB without the need to pin units into the pavement or a bridge deck. The concept involved bolting 12 foot lengths of 6" x 6" box beam on the back side of the TCB, spanning across the joints.

#### CONTACT:











For additional information contact Terry Hale of the Design Quality Assurance Bureau at (518) 485-7009, [thale@dot.state.ny.us](mailto:thale@dot.state.ny.us) or Tom Melander of the Office of Construction at (518) 457-6472, [tmelander@dot.state.ny.us](mailto:tmelander@dot.state.ny.us).



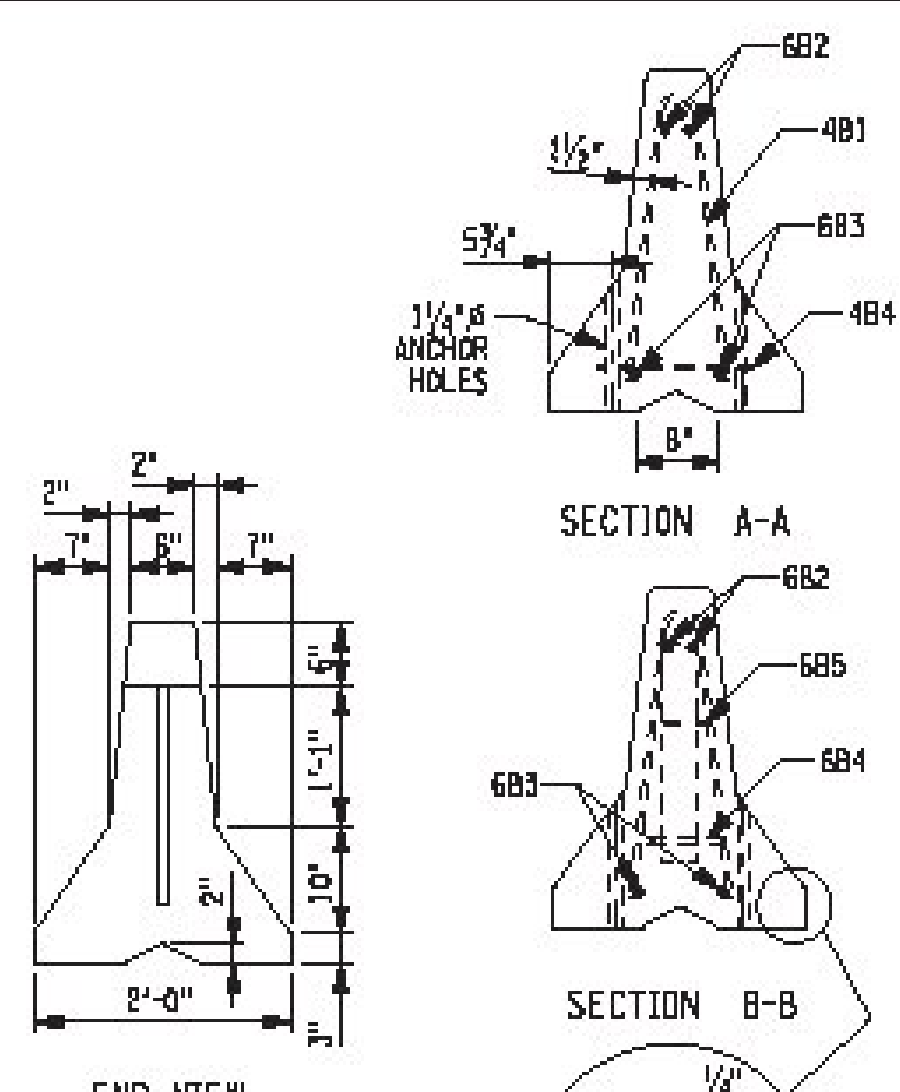

NOMINAL LENGTH OF BARRIER UNIT	X	NO. EACH SECTION
20'	5'-11"	2
18'	6'-5"	2
16'	5'-3 1/4"	2
14'	7'	1
12'	8'	1
10'	5'	1
8'	N/A	0

"X" DISTANCE FROM END OF BARRIER TO 4BS BAR

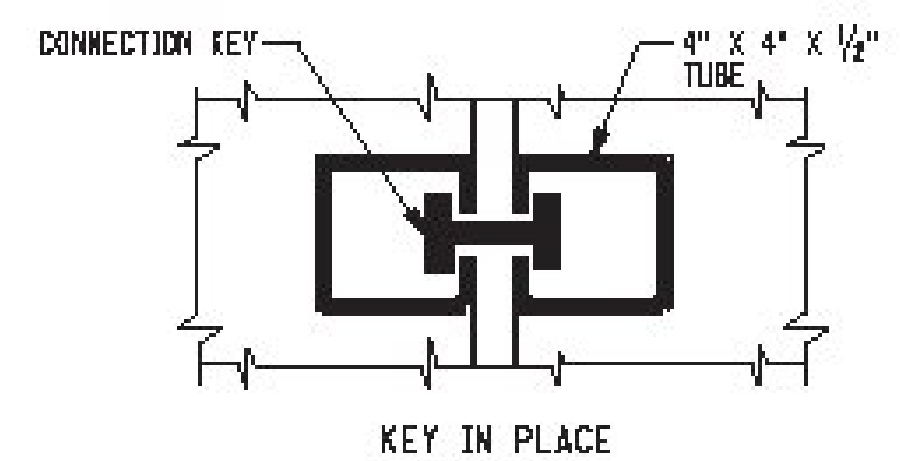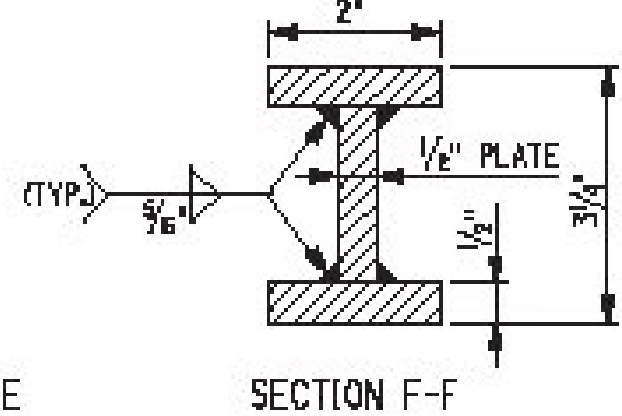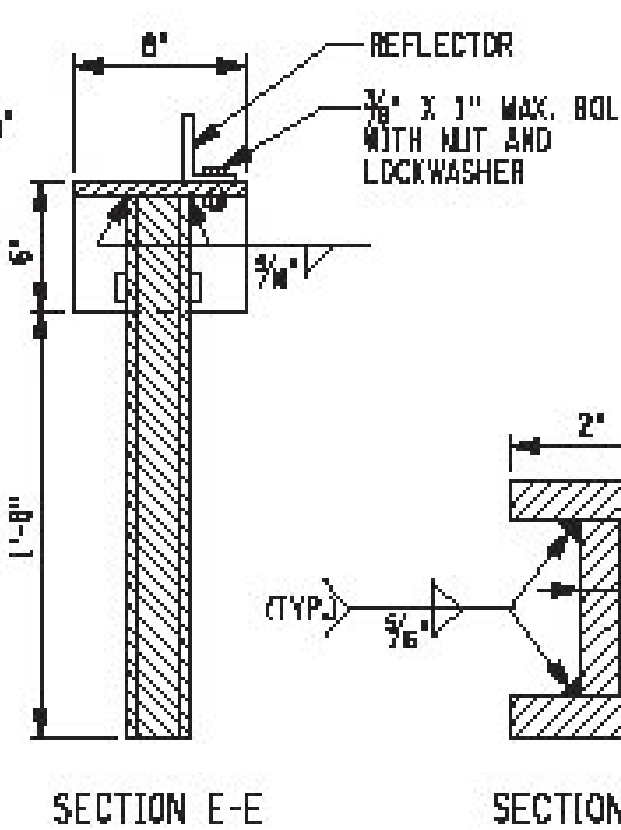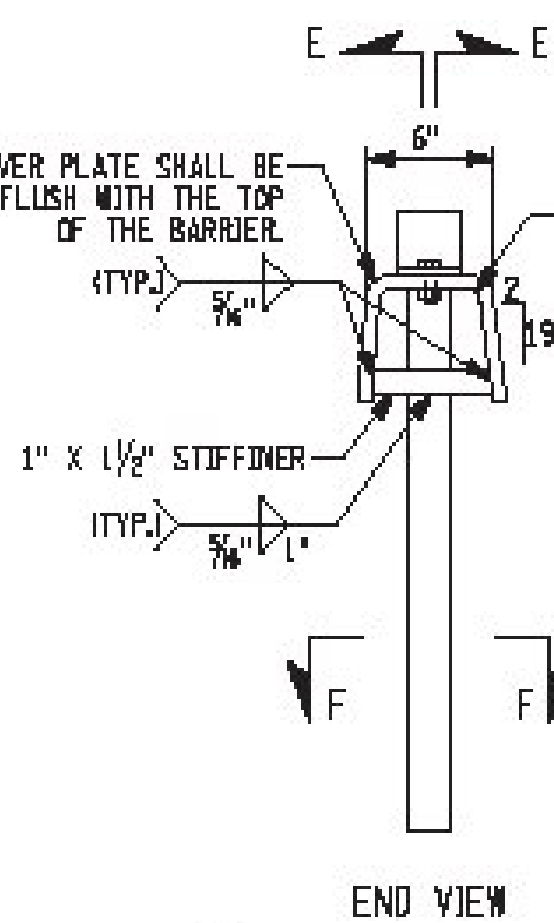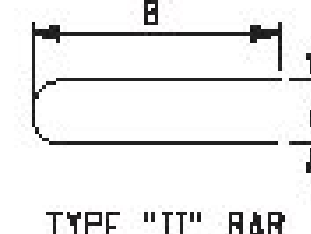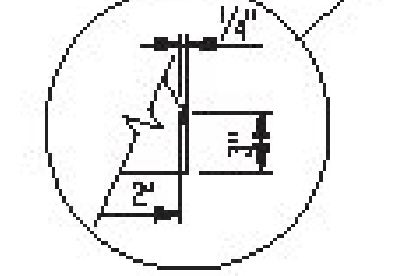
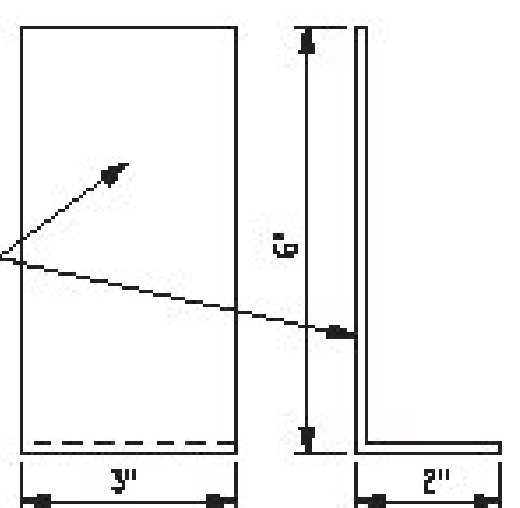
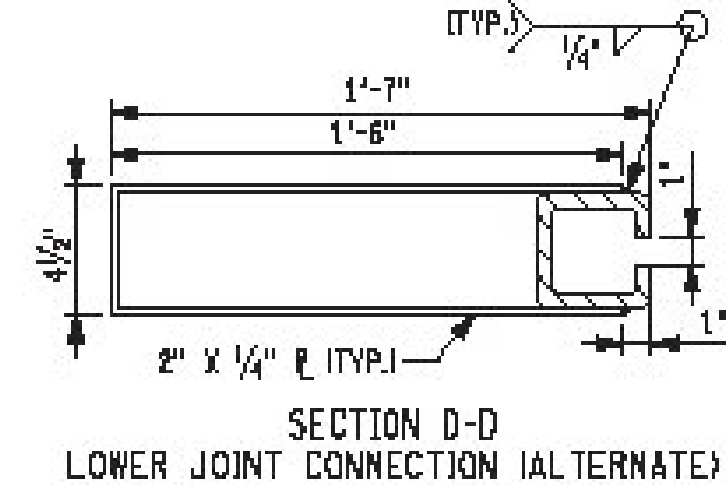
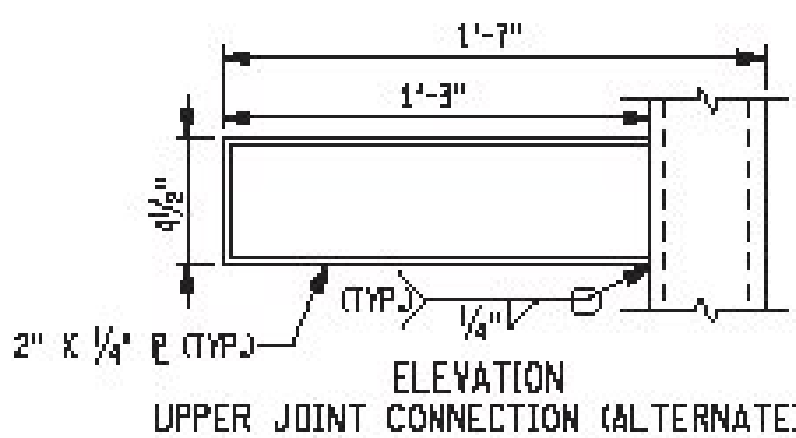
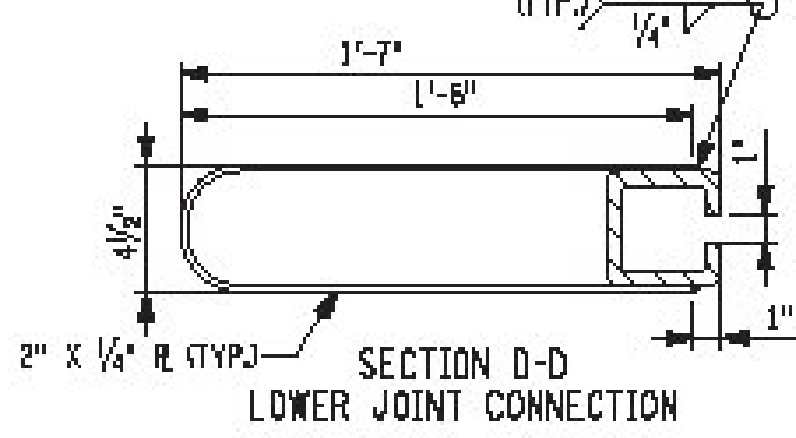


ERRATA 2 EFF. 09/04/2014 ISSUED WITH EB 14-025
ERRATA 1 EFF. 01/09/2014 ISSUED WITH EB 13-042
EFFECTIVE DATE: 01/07/10

		STATE OF NEW YORK DEPARTMENT OF TRANSPORTATION	
U.S. CUSTOMARY STANDARD SHEET			
TEMPORARY CONCRETE BARRIER (SHEET 1 OF 3)			
APPROVED JULY 10, 2014  /s/ J. F. TYMAN, P.E. DEPUTY CHIEF ENGINEER RECONSTRUCTION		ISSUED UNDER EB 09-025  619-01	

```
FILE NAME = G19-0101_010710s2.dgn
DATE/TIME = 06-AUG-2014 14:06
USER = jburley
```




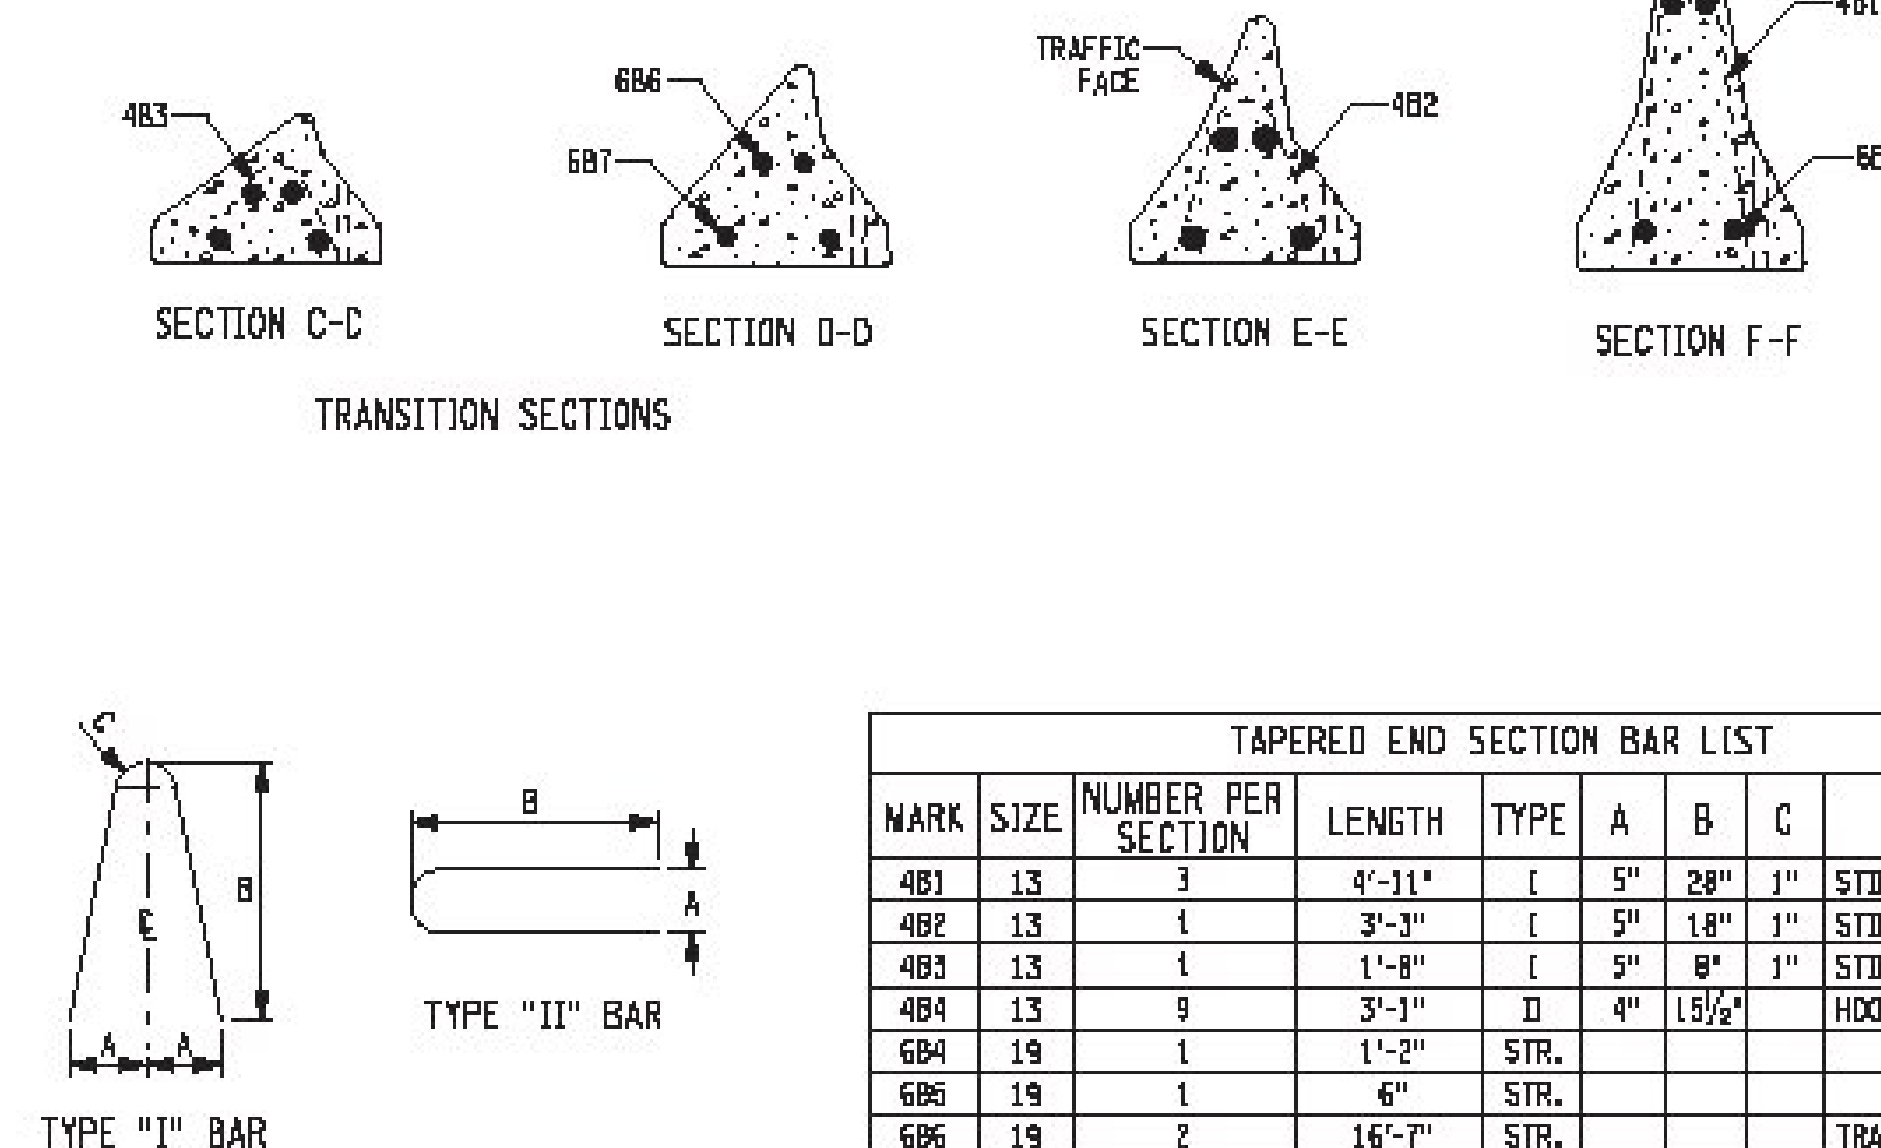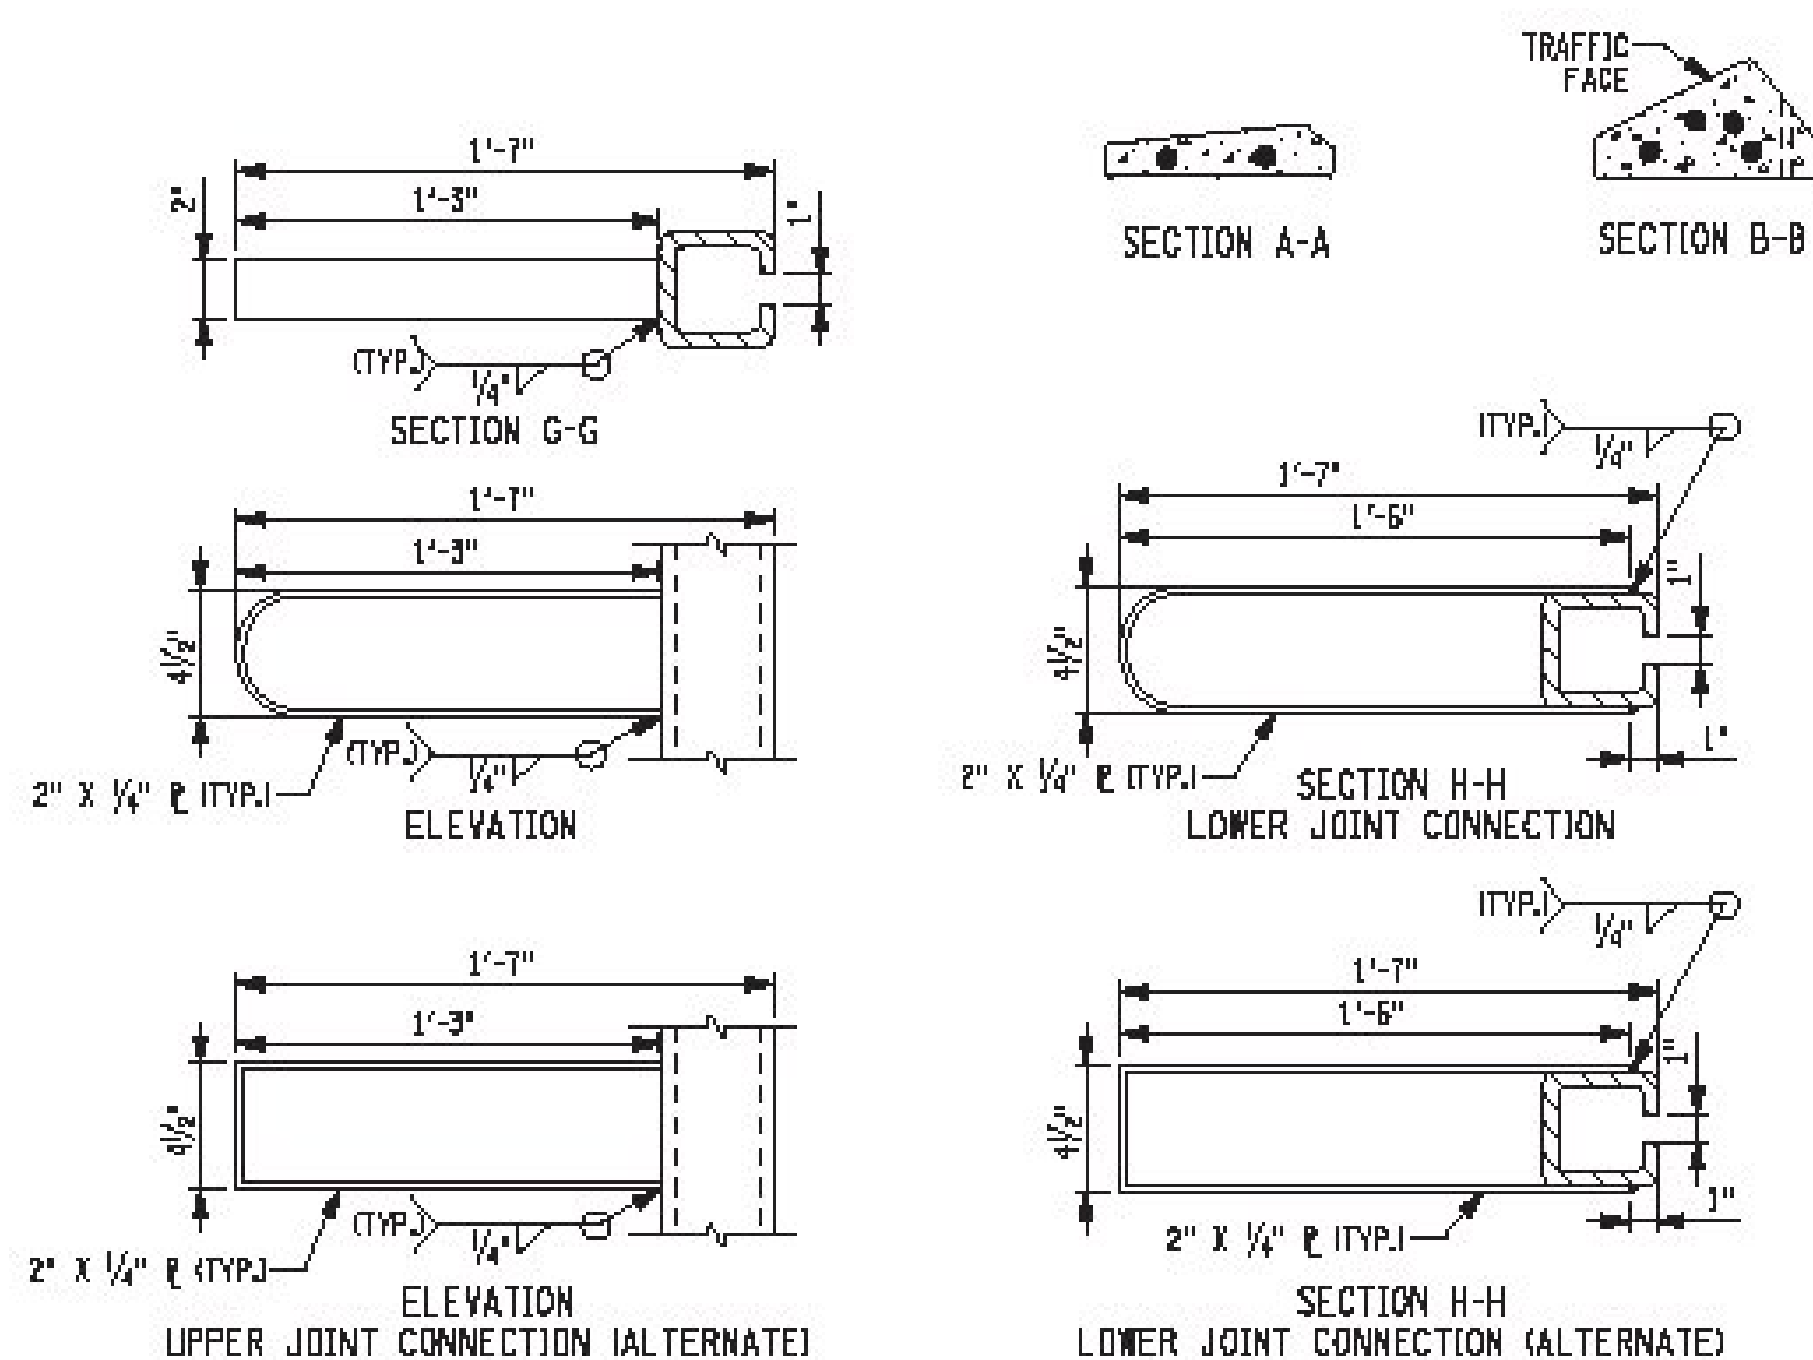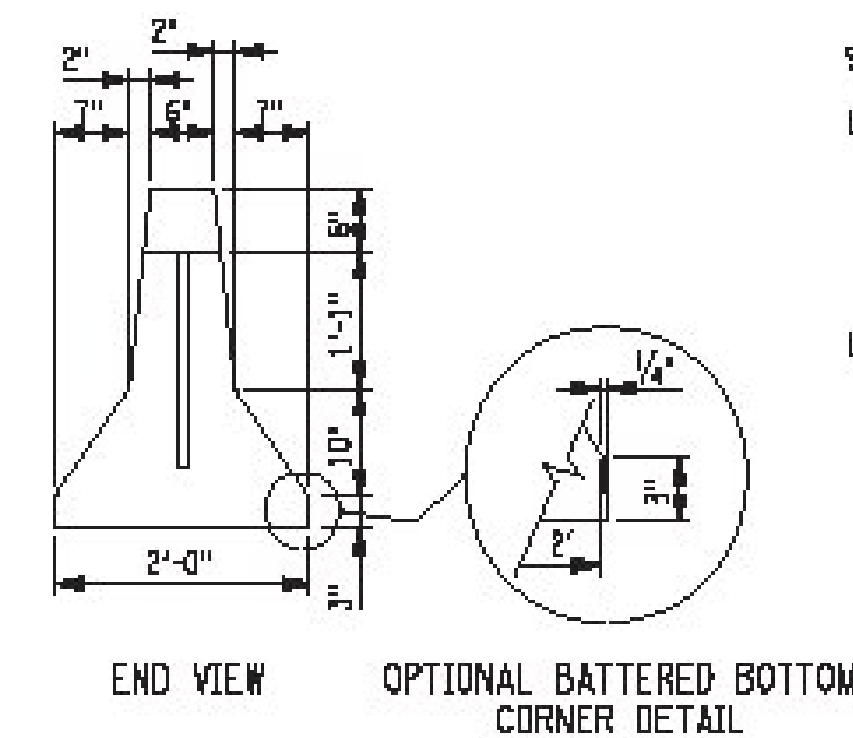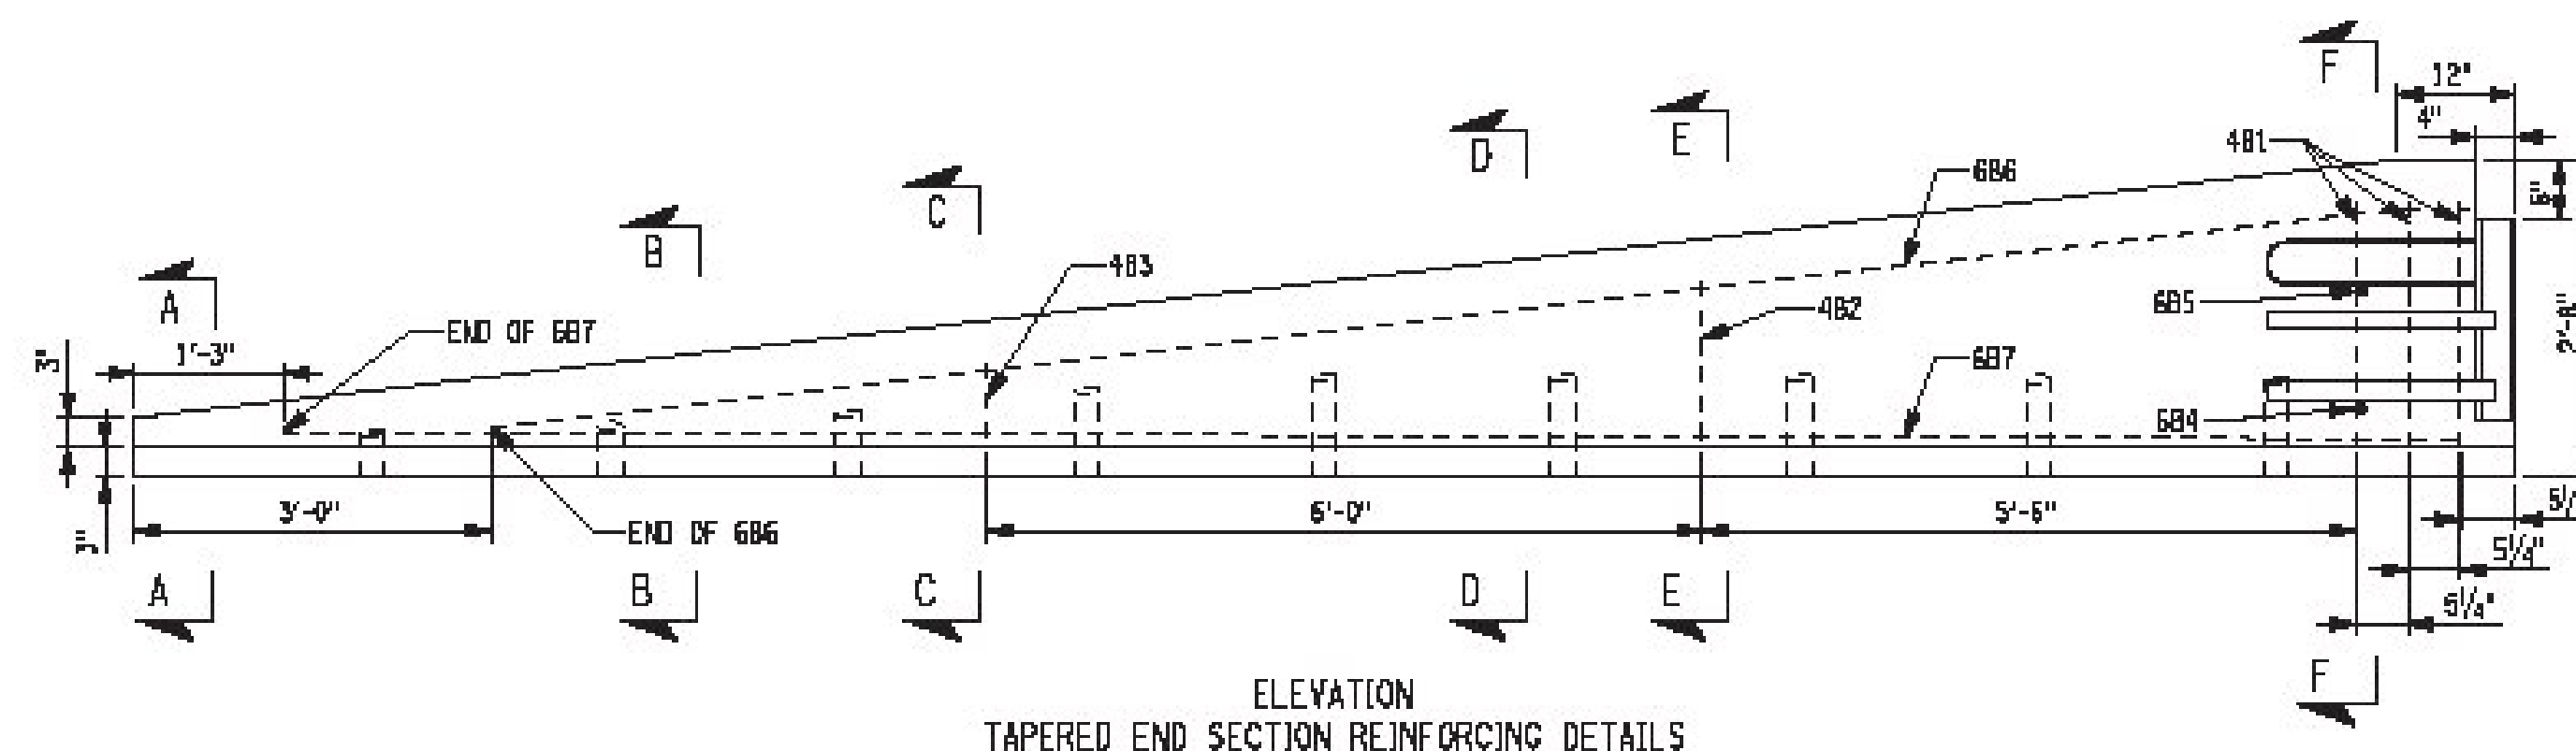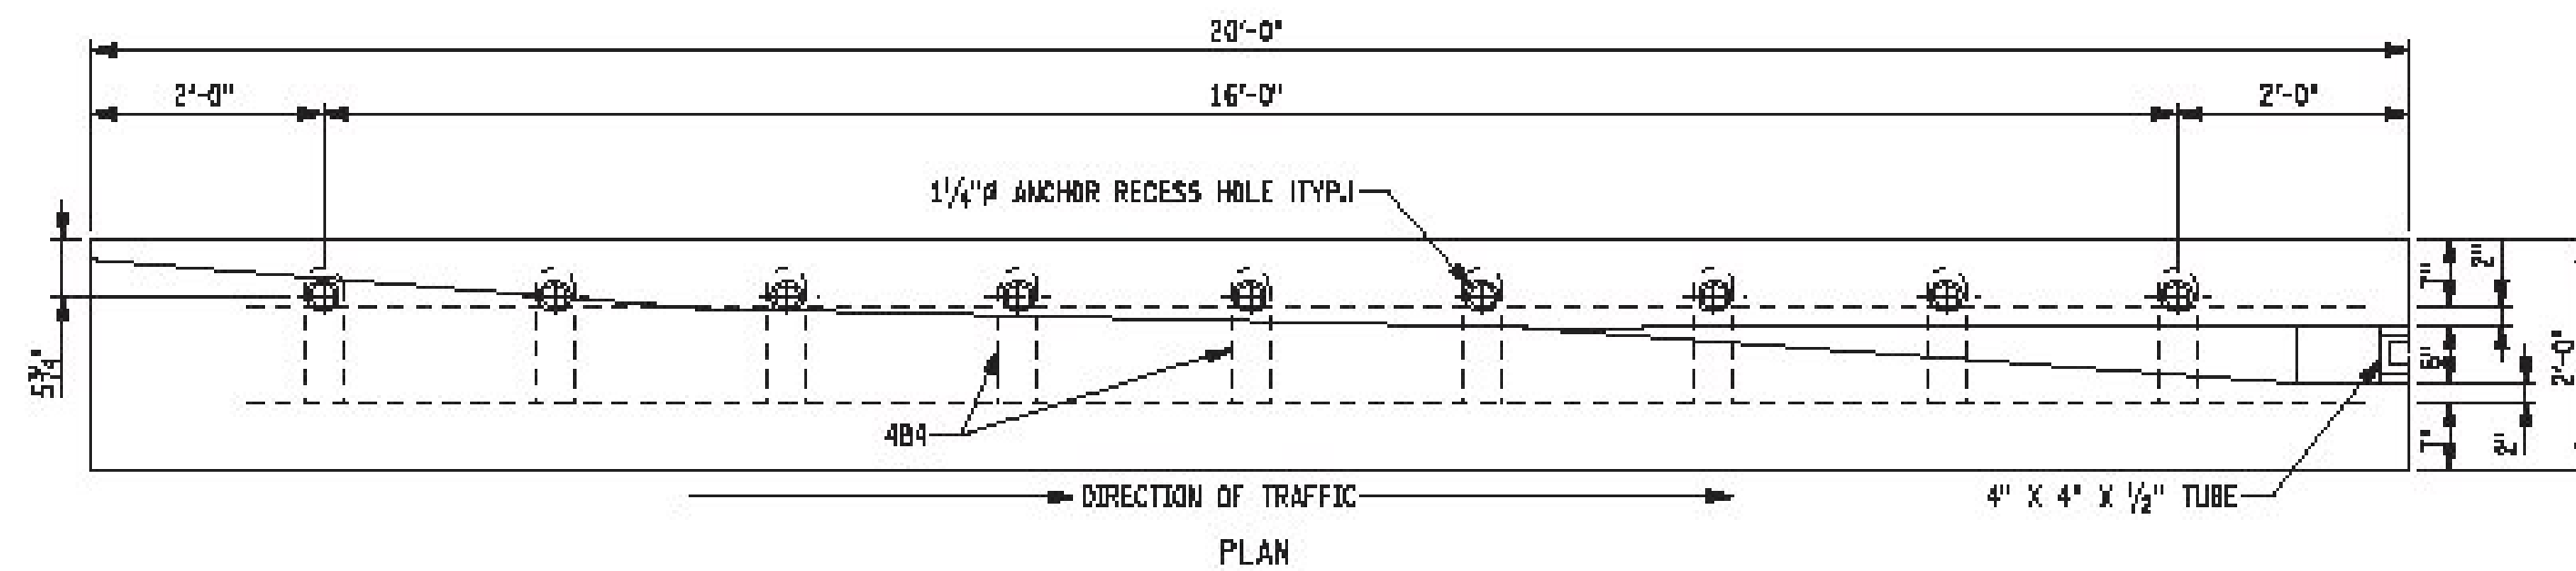

TAPERED END SECTION BAR LIST							
MARK	SIZE	NUMBER PER SECTION	LENGTH	TYPE	A	B	C
4B1	13	3	4'-11"	I	5"	28"	1"
4B2	13	1	3'-3"	I	5"	18"	1"
4B3	13	1	1'-8"	I	5"	8"	1"
4B4	13	9	3'-1"	II	4"	18 1/2"	
6B4	19	1	1'-2"	STR.			
6B5	19	1	6"	STR.			
6B6	19	2	16'-7"	STR.			TRANSVERSE (TOP)
6B7	19	2	18'-2"	STR.			TRANSVERSE (BOTTOM)

# NOTES:


- TEMPORARY CONCRETE BARRIER SHALL BE PRECAST IN ACCORDANCE WITH THE REQUIREMENTS OF §704-05, PRECAST CONCRETE BARRIER.
- STEEL PLATE SHALL BE ASTM A36N, A572N, GRADE 345, TUBE STEEL SHALL BE ASTM A500 GRADE B OR C, AND REINFORCING BARS SHALL BE A615 GRADE 420.
- ALL WELDING SHALL BE PERFORMED BY A QUALIFIED WELDER IN ACCORDANCE WITH SECTION 8 OF THE NYS STEEL CONSTRUCTION MANUAL.
- SURFACES TO BE WELDED SHALL BE FREE OF SLAG, RUST, MOISTURE, GREASE OR ANY OTHER MATERIAL THAT WILL PREVENT PROPER WELDING OR PRODUCE OBJECTIONABLE FUMES.
- WELDING SHALL BE SHIELDED METAL ARC WELDING USING PROPERLY DRIED 3/32" E7018 ELECTRODES CONFORMING TO THE REQUIREMENTS OF SECTION 7 OF THE NYS STEEL CONSTRUCTION MANUAL.
- CONCRETE CLEAR COVER FOR REINFORCING BARS SHALL BE 1/2" (MIN.) EXCEPT WHERE OTHERWISE SPECIFIED.
- A MINIMUM OF TWO RECESSED LIFTING DEVICES, WITH THE CAPACITY TO LIFT A MASS OF 5 TONS (MINIMUM) SHALL BE INSTALLED ON EACH SEGMENT.
- 1/8" ASTM A36N ANCHOR PINS SHALL BE PLACED IN FOUR RECESSES OF EACH SEGMENT TO BE PINNED.
- CONNECTION KEY COVER PLATE SHALL BE INSTALLED FLUSH WITH THE BARRIER TOP.
- THE DETAILS SHOWN FOR THE END SECTIONS ON THIS SHEET ARE FOR APPROACH ENDS WHICH ARE TO BE LOCATED TO THE LEFT OF THE TRAFFIC FLOW ON ONE-WAY OPERATIONS OR BETWEEN OPPOSING FLOWS OF TRAFFIC ON TWO-WAY OPERATIONS. WHEN AN APPROACH END IS TO BE LOCATED TO THE RIGHT OF THE TRAFFIC FLOW, THE END SEGMENT SHALL BE CONSTRUCTED SO THAT IT IS OPPOSITE-HAND (REVERSED IN ALL CONFIGURATIONS, ANCHOR HOLE LOCATIONS AND REINFORCEMENT).
- ALL CORNERS ON THE TOP OF THE SEGMENT SHALL BE ROUNDED TO A 1" RADIUS. THE SEGMENT SHALL HAVE A SMOOTH TRANSITION TO A 6" END-OF-SECTION HEIGHT. ALL END SECTIONS SHALL BE PINNED UNLESS OTHERWISE NOTED.

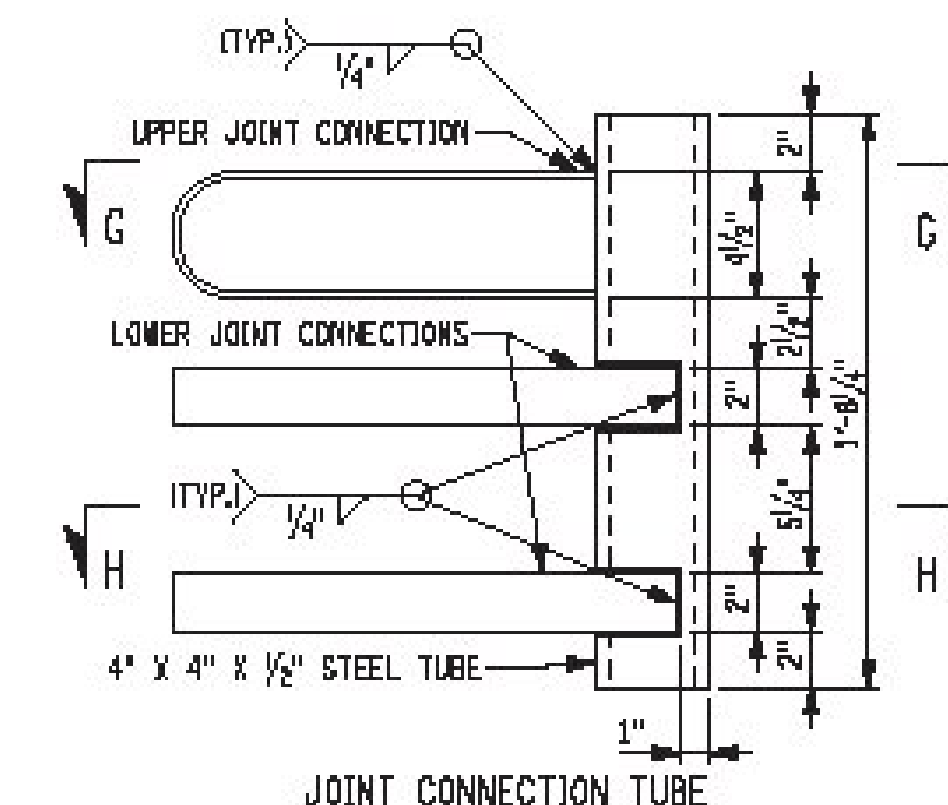

	STATE OF NEW YORK DEPARTMENT OF TRANSPORTATION	
	U.S. CUSTOMARY STANDARD SHEET	
	TEMPORARY CONCRETE BARRIER (SHEET 2 OF 3)	
APPROVED SEPTEMBER 30, 2009	ISSUED UNDER EB 05-025	
/S/ J. F. TYNAN, P.E. DEPUTY CHIEF ENGINEER (CONSTRUCTION)		619-01

EFFECTIVE DATE: 01/07/10



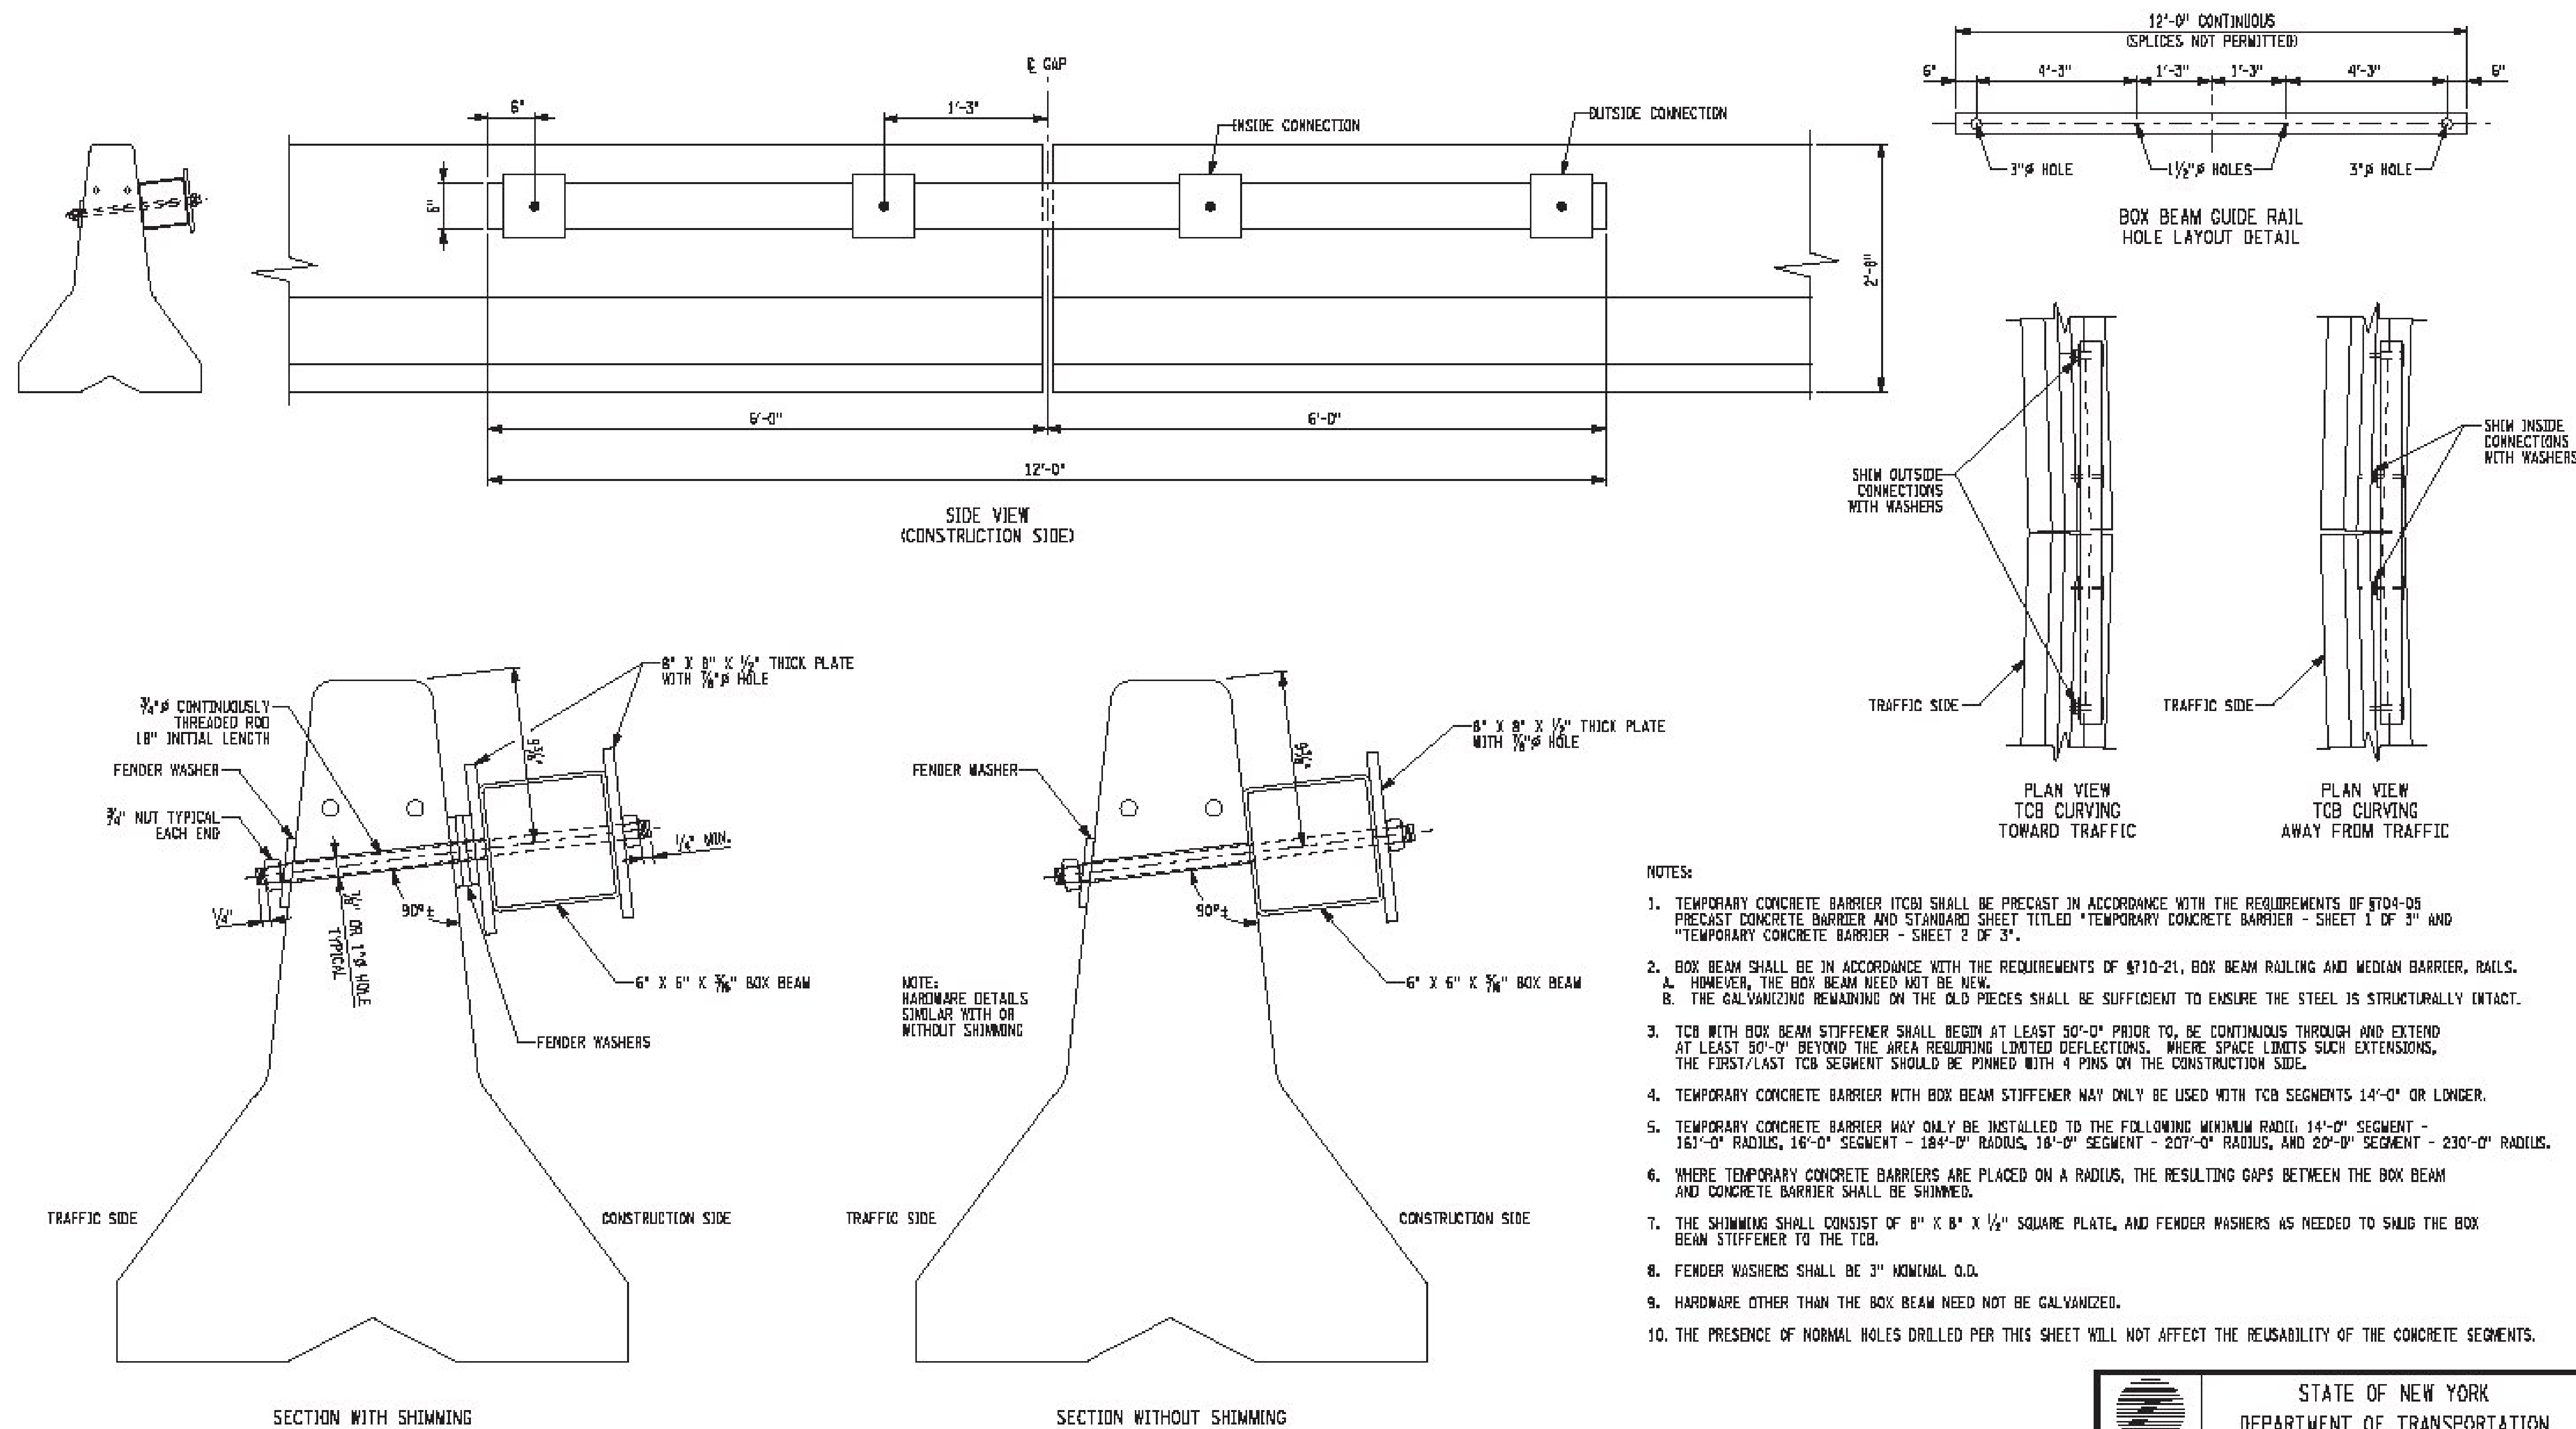

FILE NAME = 619-01 EB 13-042.dgn  
DATE/TIME = 14-NOV-2013 09:50  
USER = rlobas

ERRATA 1 EFF. 01/09/2014 ISSUED WITH EB 13-042		APPROVED: NOVEMBER 4, 2013 /S/ J.F. TYMAN, P.E. DEPUTY CHIEF ENGINEER (CONSTRUCTION)	
EFFECTIVE DATE: 01/06/11		ISSUED UNDER EB 10-034  619-01	

STATE OF NEW YORK DEPARTMENT OF TRANSPORTATION	
U.S. CUSTOMARY STANDARD SHEET	
TEMPORARY CONCRETE BARRIER (SHEET 3 OF 3)	



300.36  
ISSUED 1/10/12

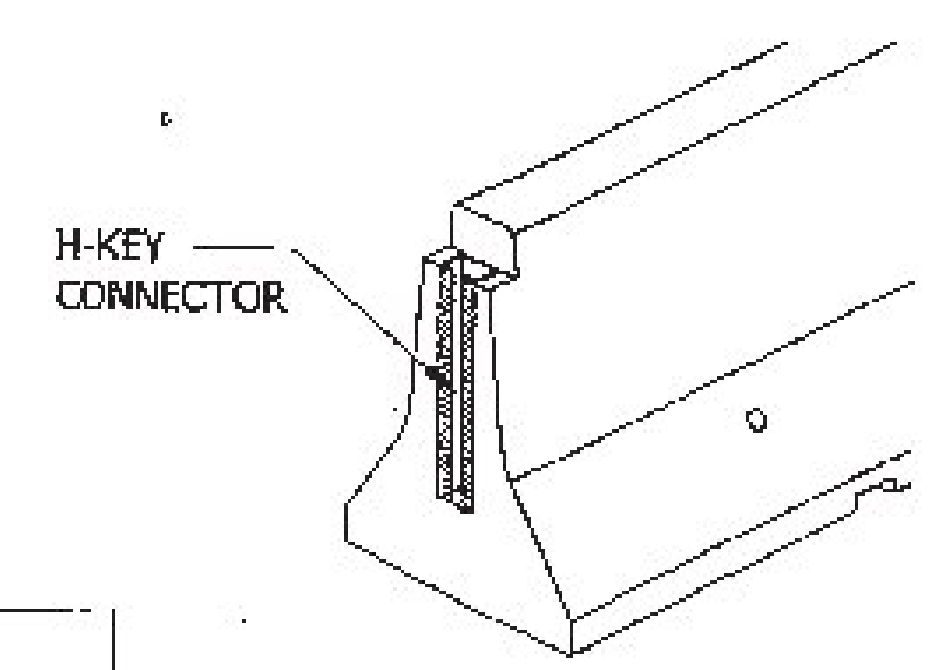
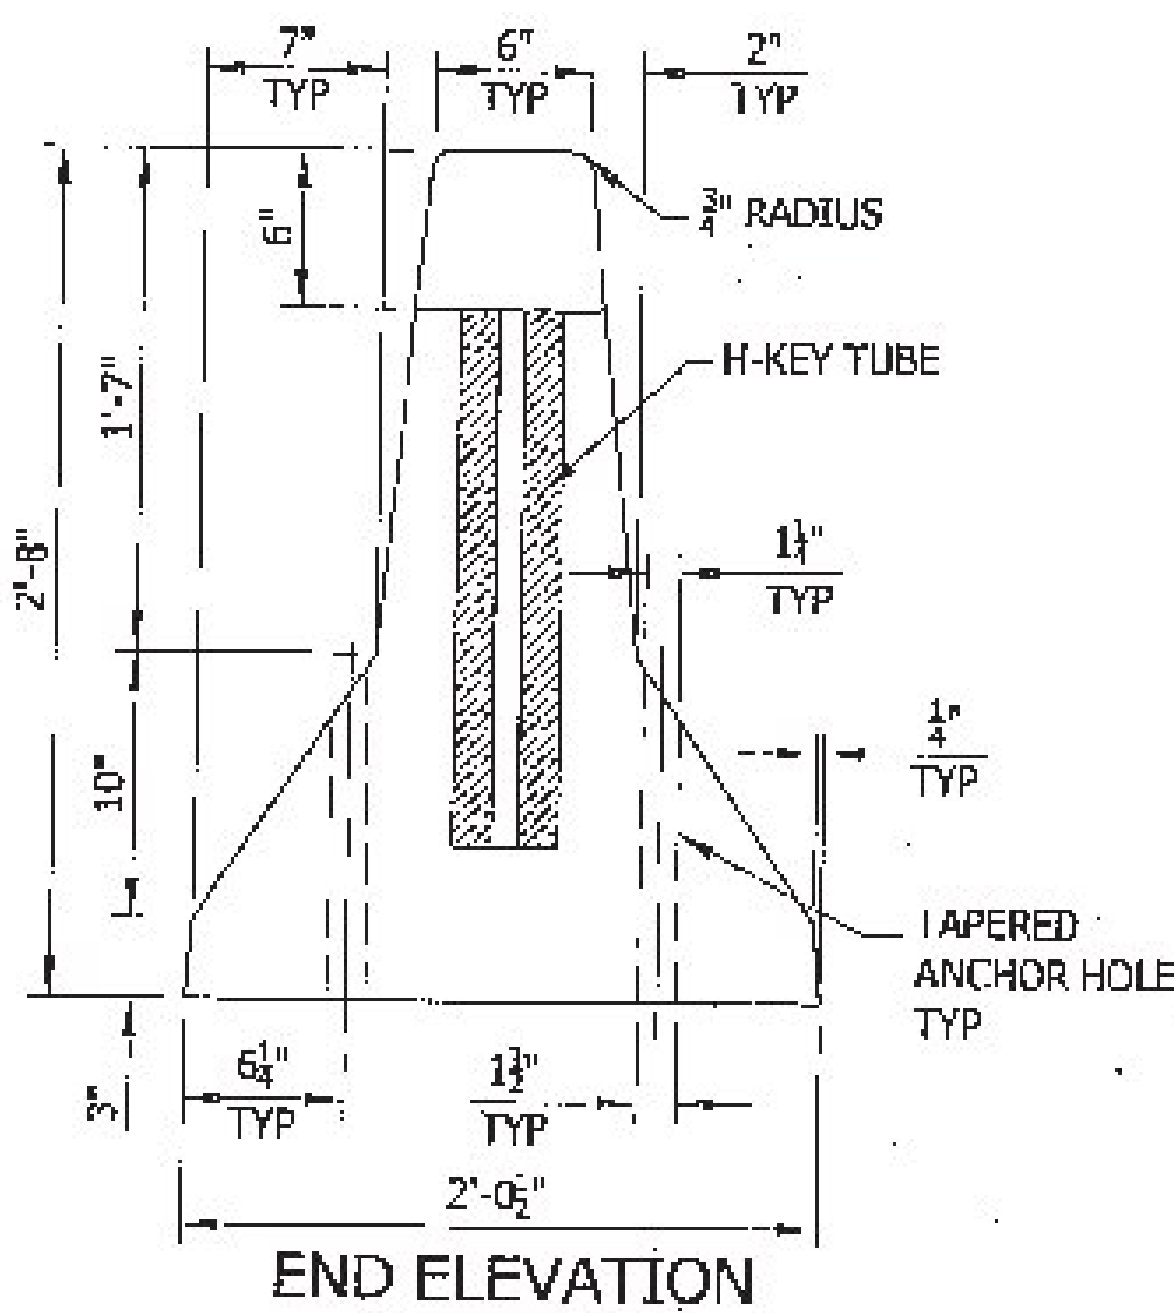
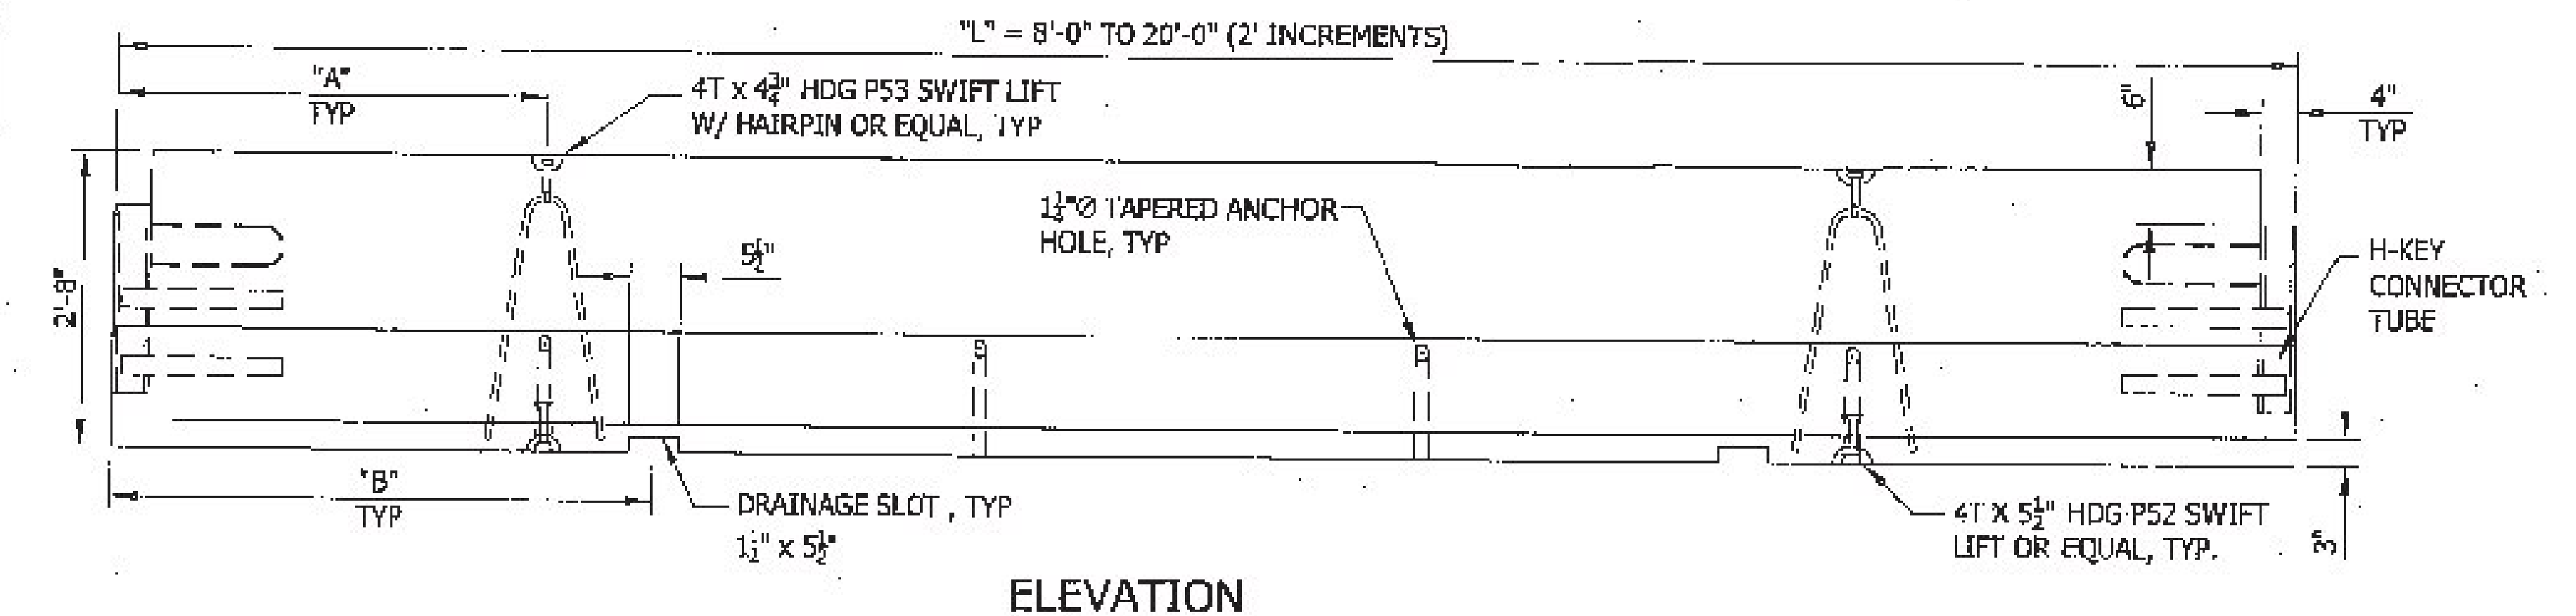
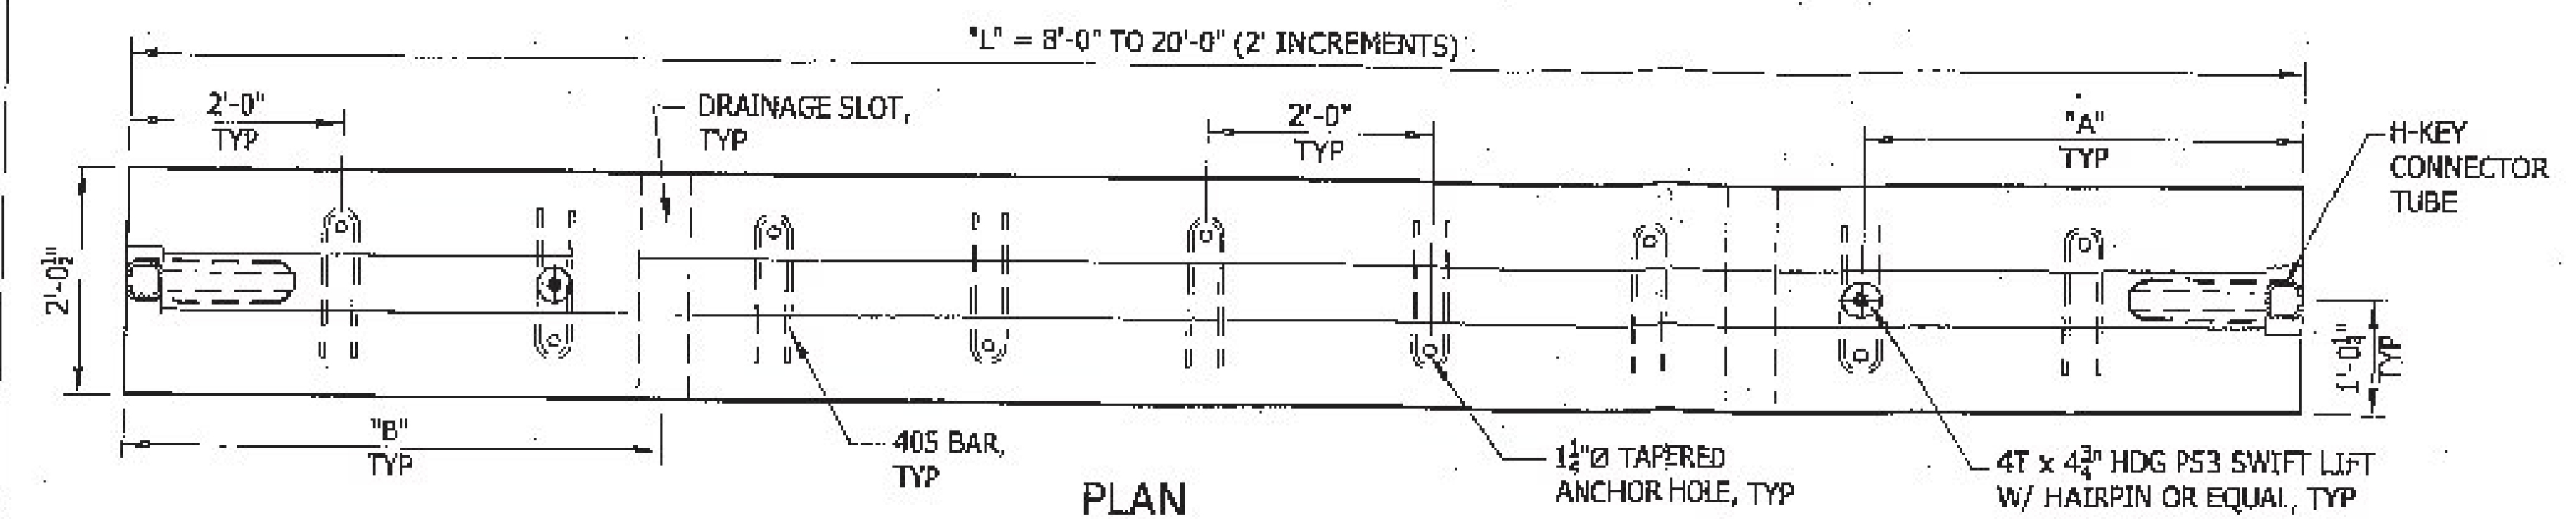


TABLE						
MK#	LENGTH (FT)	VOLUME (C.Y.)	WEIGHT (TONS)	LIFTING "A"	SLOT "B"	HOLES (QTY)
H8	8'-0"	0.80	1.61	2'-0"	5'-0" *	3
H10	10'-0"	0.99	2.01	2'-0"	5'-0" *	4
H12	12'-0"	1.19	2.42	2'-0"	3'-0"	5
H14	14'-0"	1.39	2.82	4'-0"	5'-0"	6
H16	16'-0"	1.59	3.22	4'-0"	5'-0"	7
H18	18'-0"	1.79	3.62	4'-0"	5'-0"	8
H20	20'-0"	1.99	4.03	4'-0"	5'-0"	9

* 8'-0" & 10'-0" UNITS HAVE ONLY (1) DRAINAGE SLOT. SLOT IN 8'-0" UNIT IS 5'-0" IN FROM ONE END & 3'-0" IN FROM THE OTHER.

# NOTES:

1. ALL MATERIAL SHALL CONFORM TO SECTION 704-05, PRECAST CONCRETE BARRIER, OF THE NYS DOT STANDARD SPECIFICATIONS AND THE FORT MILLER CO., INC. QUALITY CONTROL PLAN FOR MANUFACTURING PRECAST CONCRETE.
2. REINFORCING BARS SHALL BE ASTM A615, GRADE 60.
3. CONCRETE TO BE 3,000 PSI @ 28 DAYS.
4. AIR CONTENT SHALL BE 5.0 - 9.0%.
5. MINIMUM STRIPPING STRENGTH: 2,000 PSI.
6. POSITION OF REINFORCEMENT TO BE MAINTAINED WITH THERMOPLASTIC CHAIRS OR PLASTIC TIPPED SLAB BOLSTERS.
7. CURING WITH MEMBRANE CURING COMPOUND SHALL CONFORM TO NYS DOT SPECIFICATION 704-D3.
8. ALL H-KEY & TUBE DETAILS, MATERIALS AND WELDING REQUIREMENTS SHALL CONFORM TO NYS DOT STANDARD SHEET 619-01.
9. CONCRETE CLEAR COVER FOR REINFORCING BARS SHALL BE 1 1/2", UNLESS OTHERWISE SPECIFIED.

## DIMENSIONAL TOLERANCES:

1. H-KEY CONNECTOR LOCATION:  $\pm 1/4"$
2. CROSS-SECTIONAL DIMENSIONS:  $\pm 1/4"$
3. PLUMBNESS:  $\pm 1/4"$
4. LONGITUDINAL DIMENSIONS (LAY LENGTH):  $\pm 1/4"$  PER 10'-0"
5. WHEN CHECKED WITH A 10'-0" STRAIGHT EDGE, IRREGULARITIES SHALL NOT EXCEED  $\pm 1/4"$
6. REINFORCING COVER: 1 1/2" (-1", +3/8")
7. REINFORCING SPACING:  $\pm 2"$  NON-CUMULATIVE

## TESTING/INSPECTION:

FMC QCP/NYS DOT

## UNIT MARKING:

EACH UNIT SHALL BE PERMANENTLY MARKED WITH THE FOLLOWING:

FMC MM/YY

EACH UNIT SHALL ALSO BE LABELED OR PAINTED WITH THE FOLLOWING INFORMATION FOR FIELD INSPECTION PURPOSES:

FMC  
D.O.M.  
MK#/PIECE I.D.  
NYS DOT

## NYS DOT

☒ Approved  
☐ Approved As Noted

ORIGINAL SIGNED BY: J. P. REIDY

By _____ Date _____

For: Director Materials Bureau

Drawing Verified In English Units Only

NO	DATE	BY	REVISIONS

THE FORT MILLER CO., Inc.  
P.O. BOX 98  
SCHUYLERVILLE, NY 12871  
(518) 695-1000/(518) 695-4970 FAX  
www.fortmiller.com

F.M. JOB NO. NA  
SHEET NO. 1 OF 2  
DATE: 12-19-11  
DRN. BY: TDS  
CHK. BY: SDH  
SCALE: NONE

CONTRACT NO.:  
PROJECT:  
LOCATION:  
SUBJECT: H-KEY TEMPORARY BARRIER 8' TO 20'

CONTRACTOR:  
ENGINEER/ARCHITECT: NYS DOT

CWS. NO. TB5-1





PO Box 508  
Barton, VT 05822  
Phone: (802)525-9506  
Fax: (802)525-4616  
[www.jpsicard.com](http://www.jpsicard.com)

Submittal Data Sheet

Submittal #: 8

Submission #: 2

Date: 5/6/2016

Project Name: Irasburg IM Deck (46)

Owner: Vermont Agency of Transportation

Engineer: VTrans

Contractor: J.P. Sicard, Inc.

Item Number: 507.11

Supplier: Dimension Fabricators, Inc.

Description of Item: 507.11 Reinforcing Steel, Placement Drawings: Page 1: Span 1/Page 2: Span 2-4 REV1

Substitution: NO

Engineers Review Comments:

Submitted By: Brad Drake  
Title: Project Manager  
Company: JP Sicard, Inc.













PO Box 508  
Barton, VT 05822  
Phone: (802)525-9506  
Fax: (802)525-4616  
[www.jpsicard.com](http://www.jpsicard.com)

Submittal Data Sheet

Submittal #: 1

Submission #: 1

Date: 4/19/2016

Project Name: Irasburg IM Deck (46)

Owner: Vermont Agency of Transportation

Engineer: VTrans

Contractor: J.P. Sicard, Inc.

Item Number: Special Provision 900.620 (Bridge Scupper)

Supplier: NEENAH Foundry Company

Description of Item: Bridge Scupper




Substitution: NO

Engineers Review Comments:

Submitted By: Brad Drake  
Title: Project Manager  
Company: JP Sicard, Inc.



# 39360001 - 4 B8

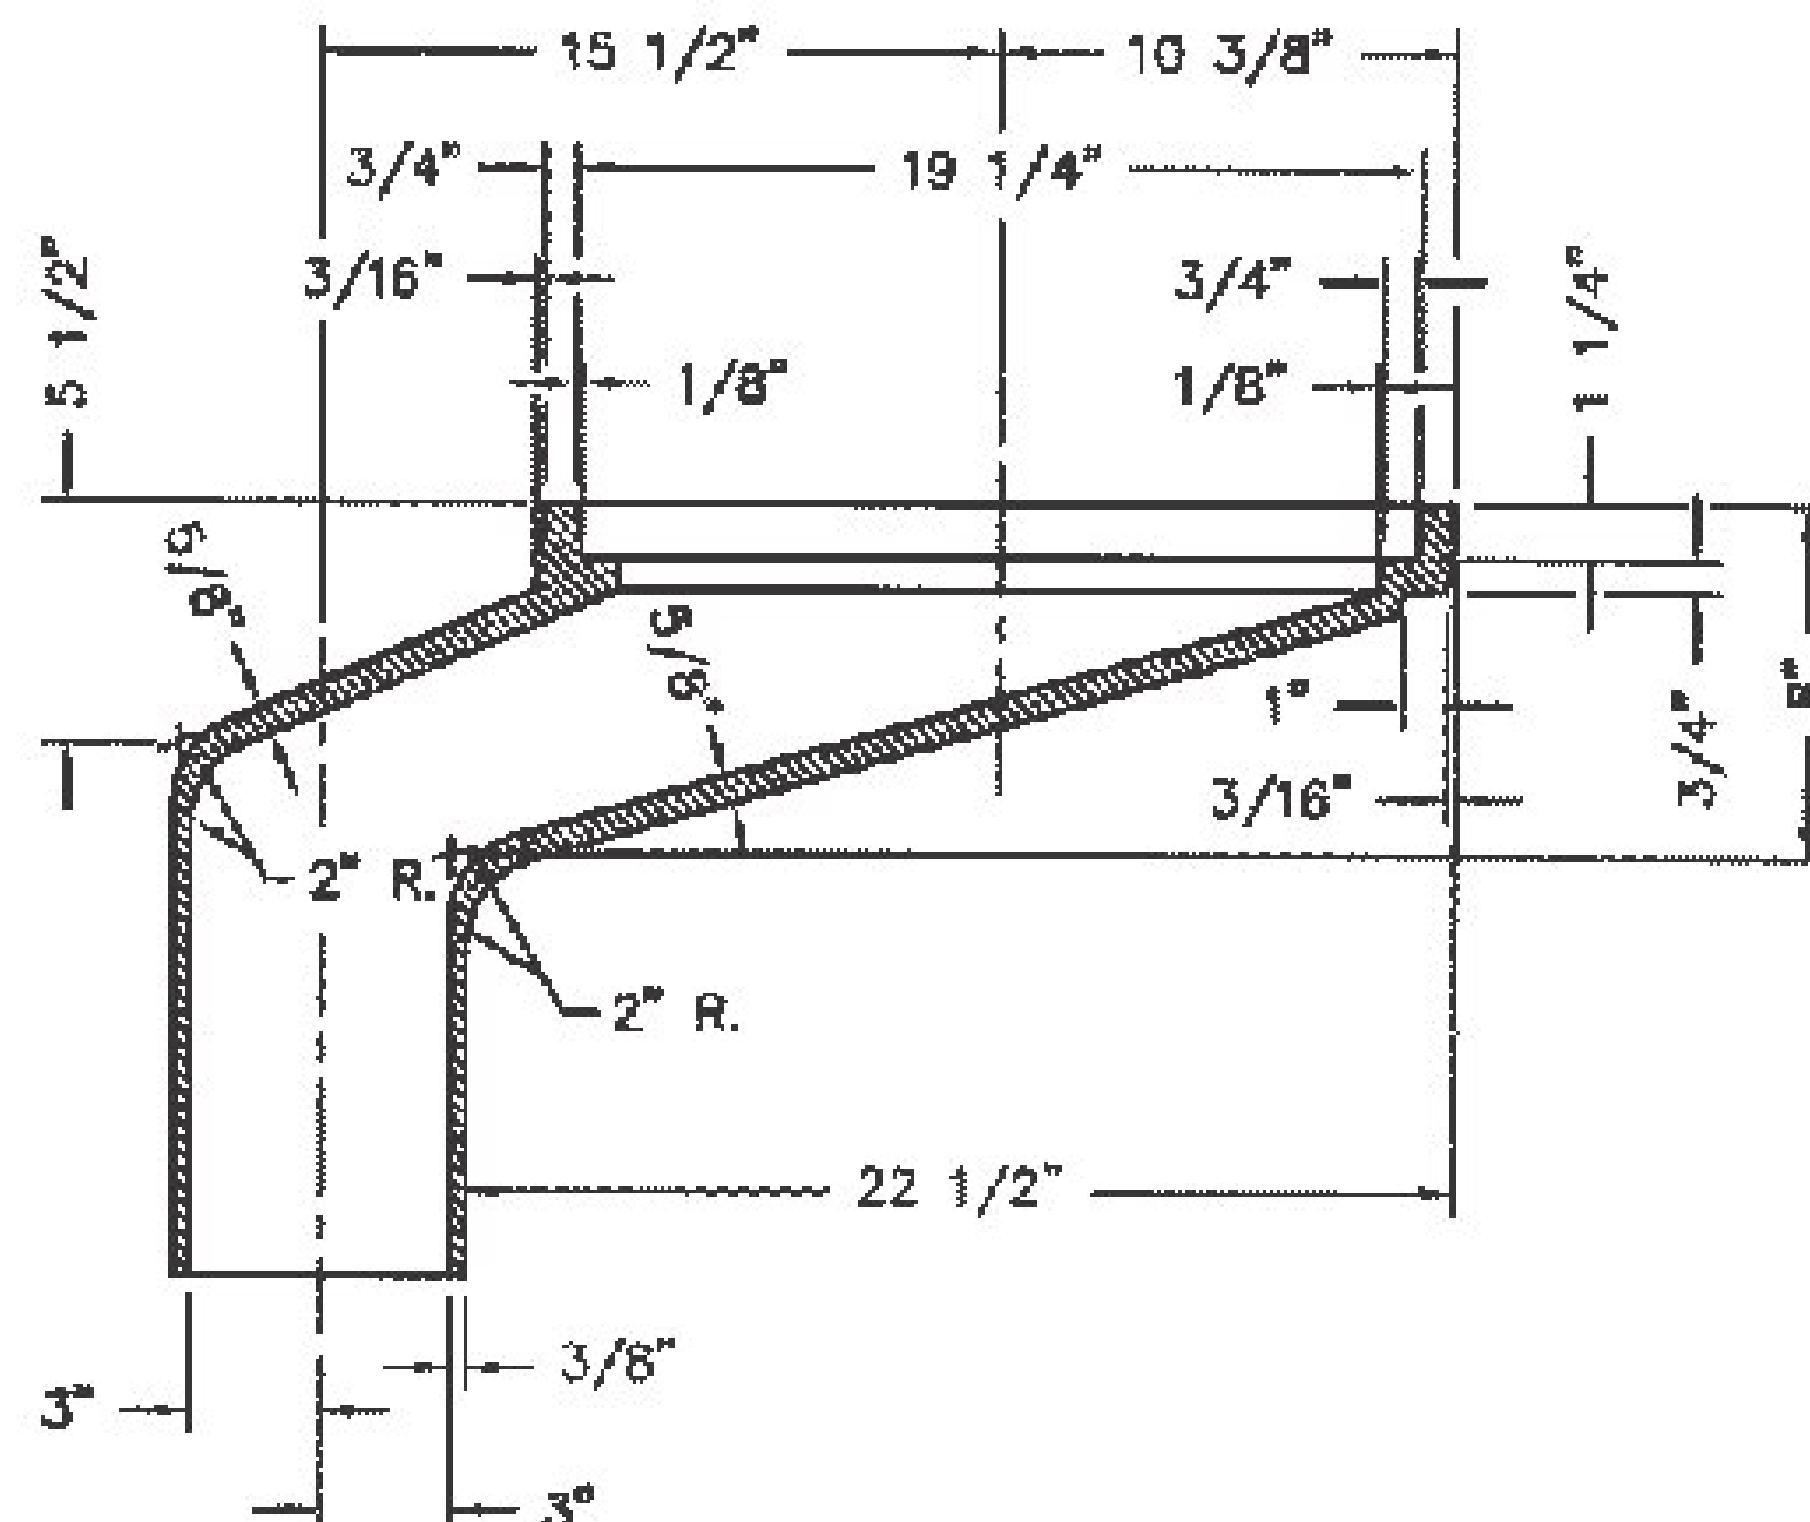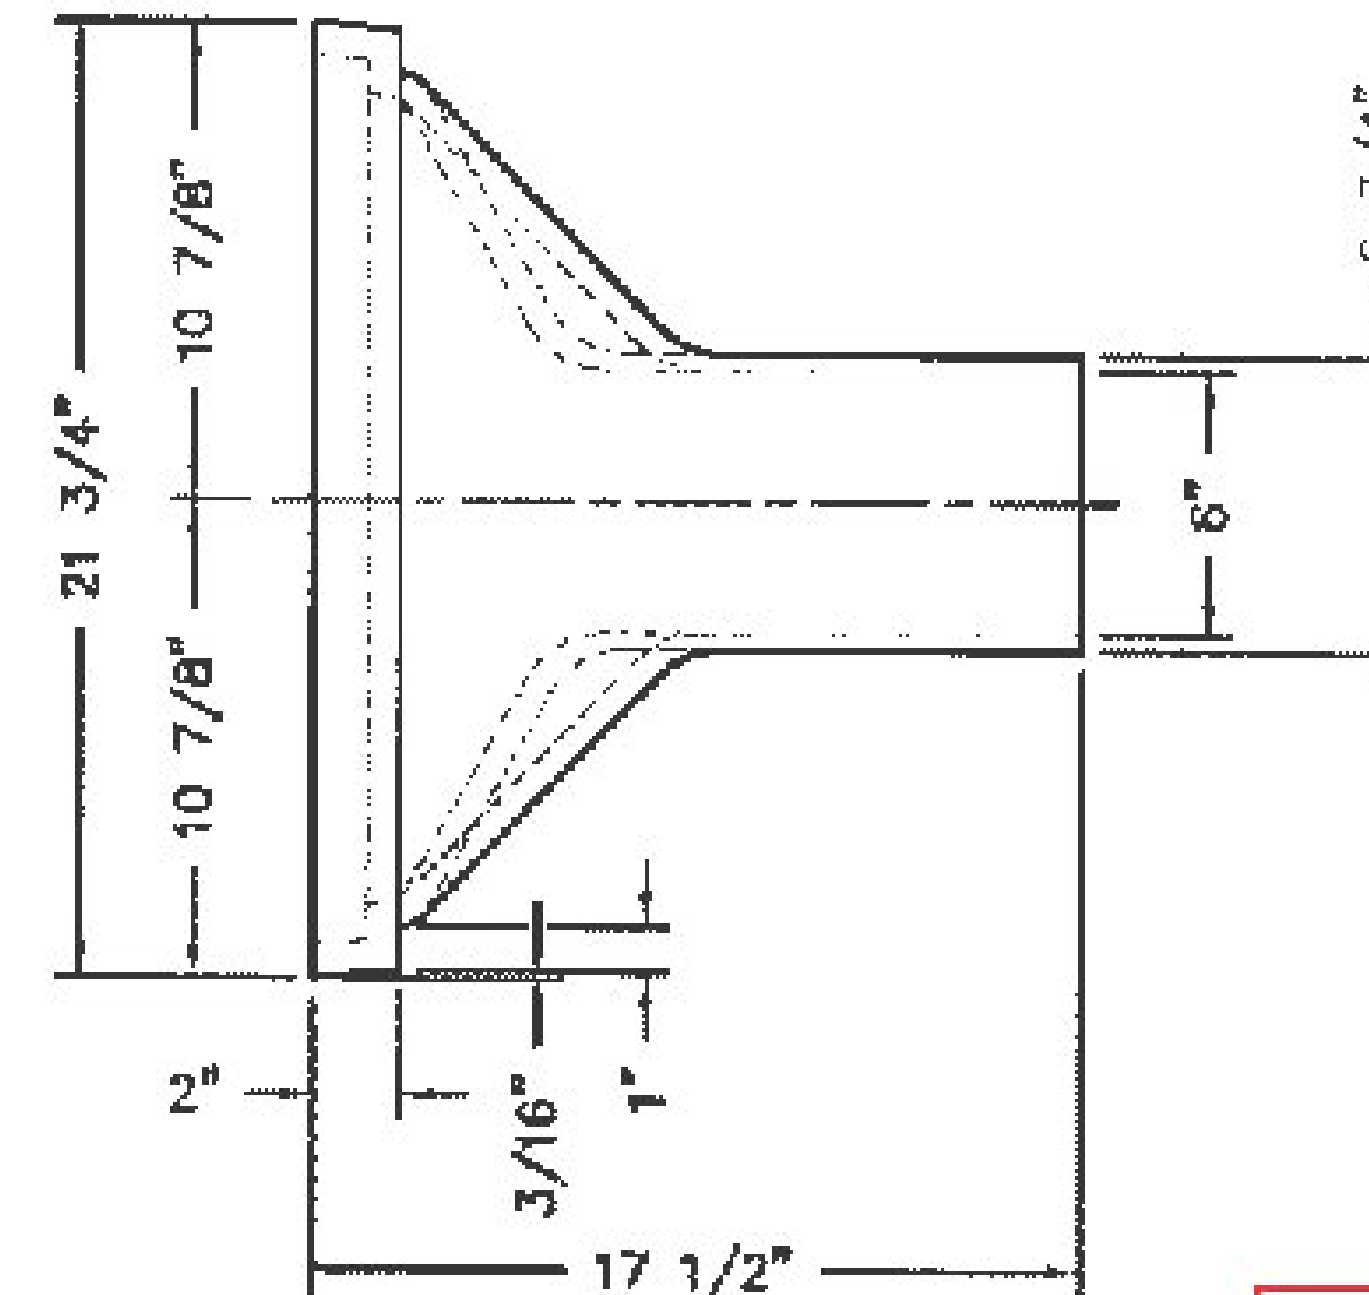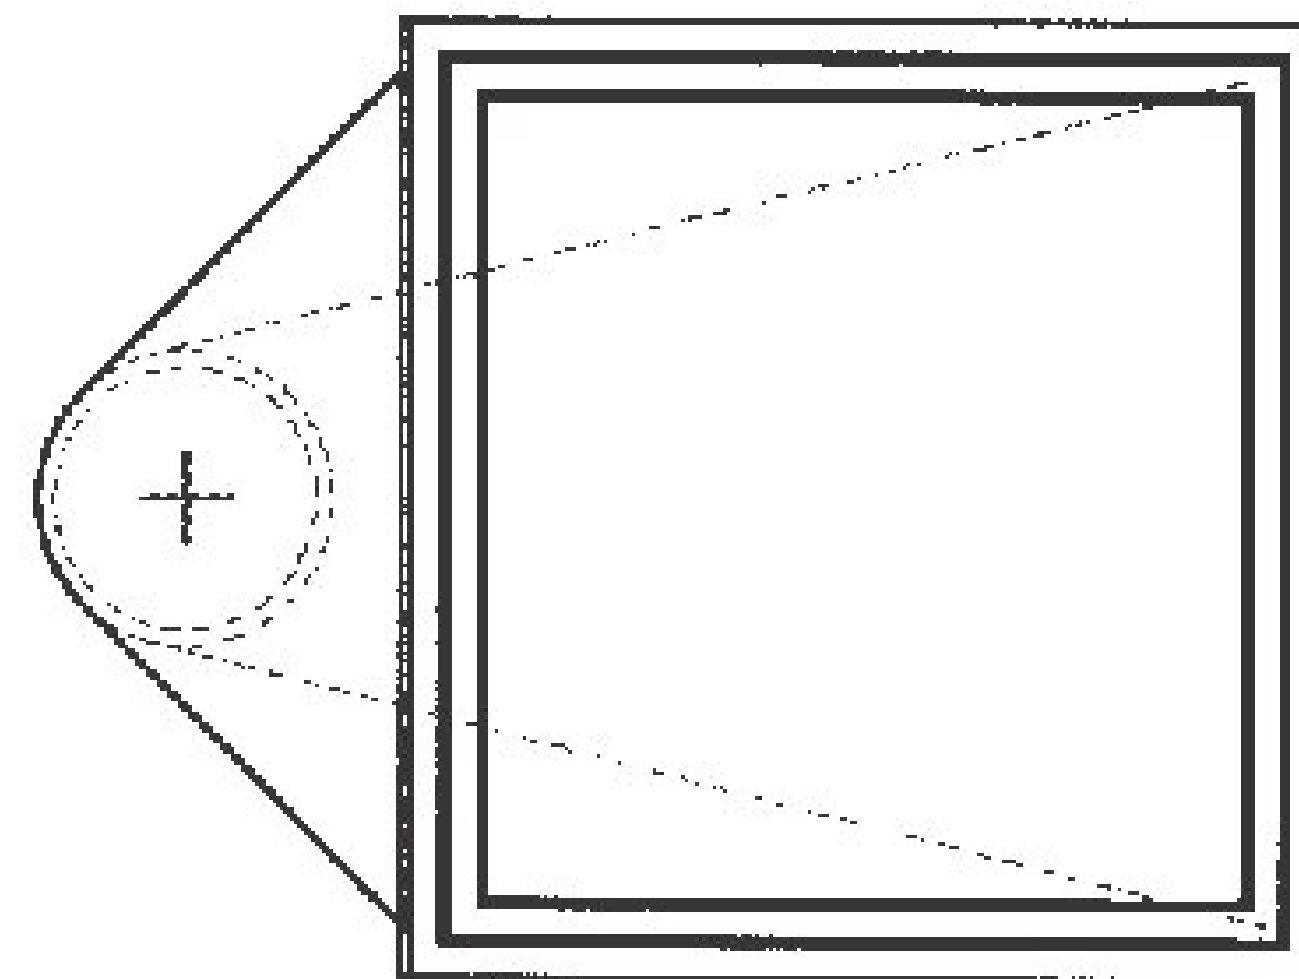

Vermont Agency of Transportation

**RECEIVED**

ON: April 20, 2016

and Checked for

**CONFORMANCE**

BY: Jennifer Fitch DATE: 04/26/16

## SHOP DRAWING REVIEW

☒ REVIEWED AS REQUIRED BY THE CONSTRUCTION CONTRACT DOCUMENTS AND APPROVED, BUT ONLY FOR CONFORMANCE TO THE DESIGN CONCEPT OF THE WORK, AND SUBJECT TO FURTHER LIMITATIONS AND REQUIREMENTS CONTAINED IN THE CONSTRUCTION CONTRACT DOCUMENTS.

☐ REJECTED ☐ REVISE AND RESUBMIT ☐ APPROVED AS NOTED

CORRECTIONS OR COMMENTS MADE ON THE SHOP DRAWINGS DURING THIS REVIEW DID NOT RELIEVE CONTRACTOR FROM COMPLIANCE WITH REQUIREMENTS OF THE DRAWINGS AND SPECIFICATIONS. THIS CHECK IS ONLY FOR REVIEW OF GENERAL CONFORMANCE WITH THE DESIGN CONCEPT OF THE PROJECT AND GENERAL COMPLIANCE WITH THE INFORMATION GIVEN IN THE CONTRACT DOCUMENTS. THE CONTRACTOR IS RESPONSIBLE FOR: CONFIRMING AND CORRELATING ALL QUANTITIES AND DIMENSIONS; SELECTING FABRICATION PROCESSES AND TECHNIQUES OF CONSTRUCTION; COORDINATING THEIR WORK WITH THAT OF ALL OTHER TRADES; AND PERFORMING THEIR WORK IN A SAFE AND SATISFACTORY MANNER.

**CED** Consulting Engineers  
590 Commercial Street  
Manchester, NH 03101  
603-888-0223

Job Number: 150223  
Reviewed by: SRB  
Date: 04/26/2016

MATERIAL: CAST GRAY IRON ASTM A-48, CLASS 35B

FINISH: NO PAINT

WEIGHT: 250#

11-00-0000	REVIEWED AND MATCH DRAWING SPEC-0 3/4"	DR
08-11-0000	REVIEWED SPEC. Q.D. FROM 0 1/2"	DR
08-24-0000	REVIEWED SPEC. Q.D. FROM 0 3/4"	DR
DATE	REVISION	BY

DR. E. REMME	SCALE	TITLE
CH.	1/8"=1"	R-3936-A
APP.	DRM CHK.	SCUPPER
DATE 05/10/90		



**NEENAH**  
FOUNDRY COMPANY  
NEENAH WISCONSIN 54906



NF- 39360001 B



# 3936 0004-1 B4

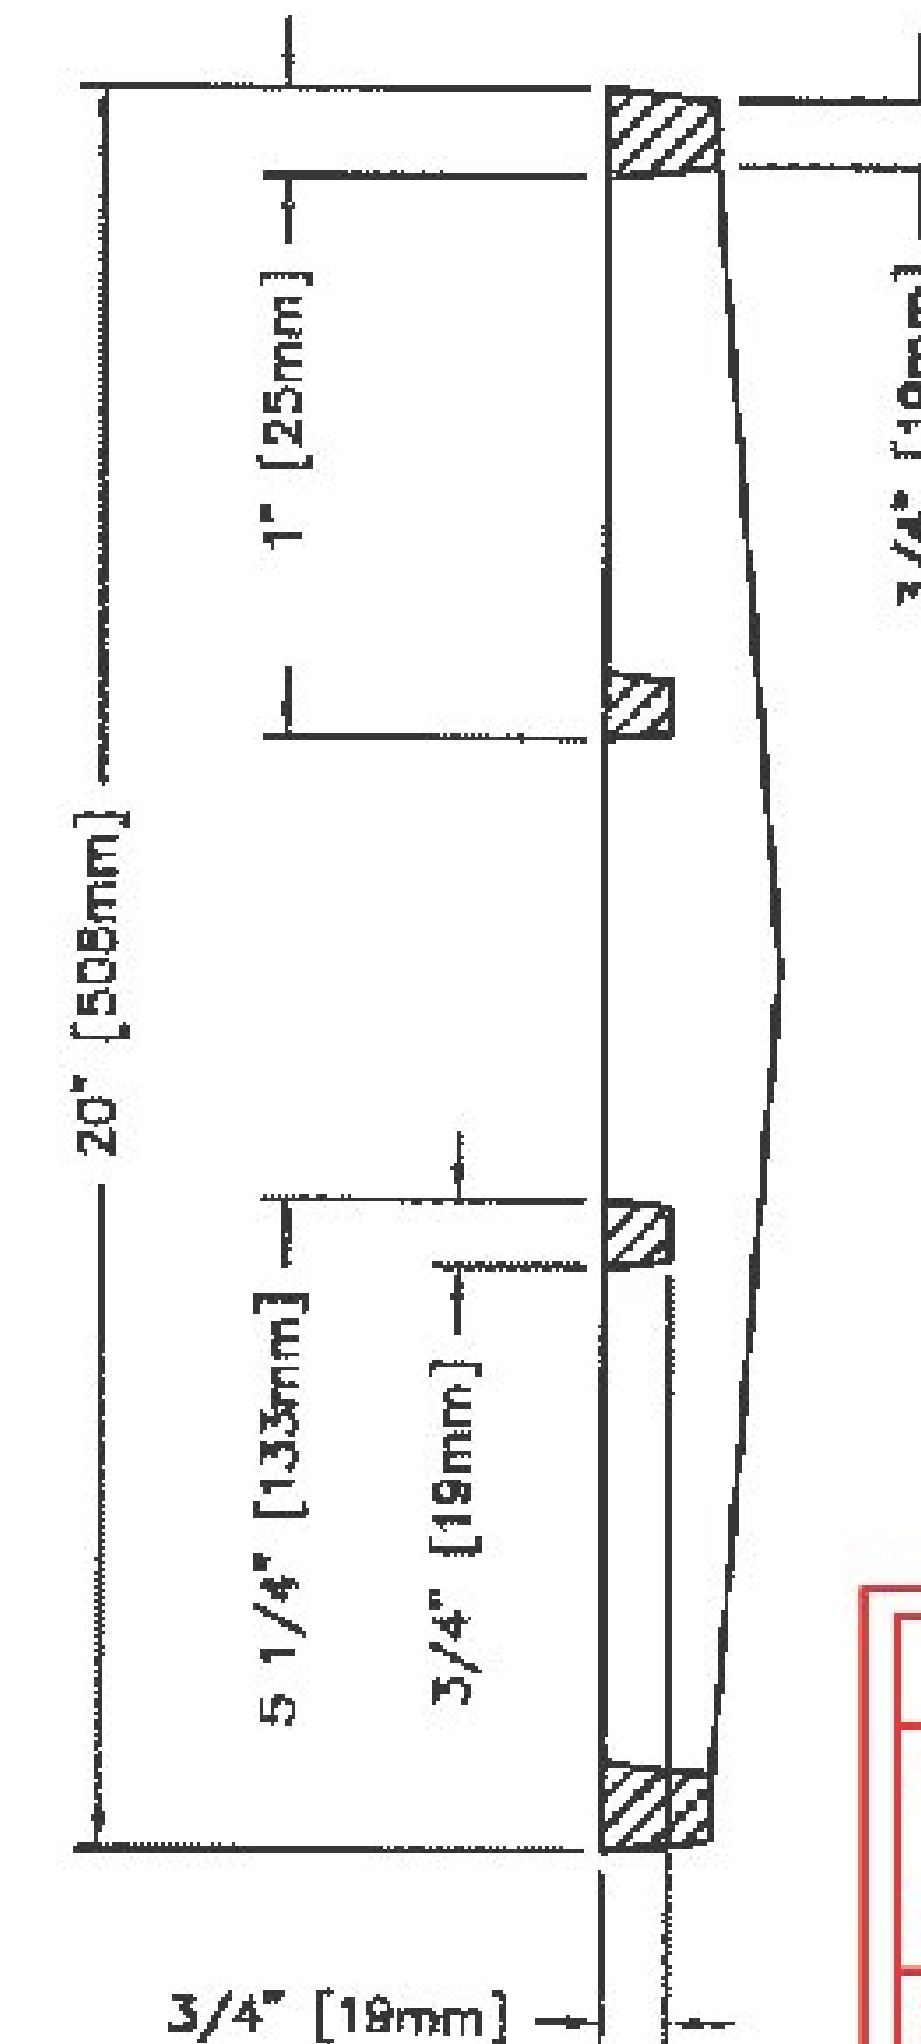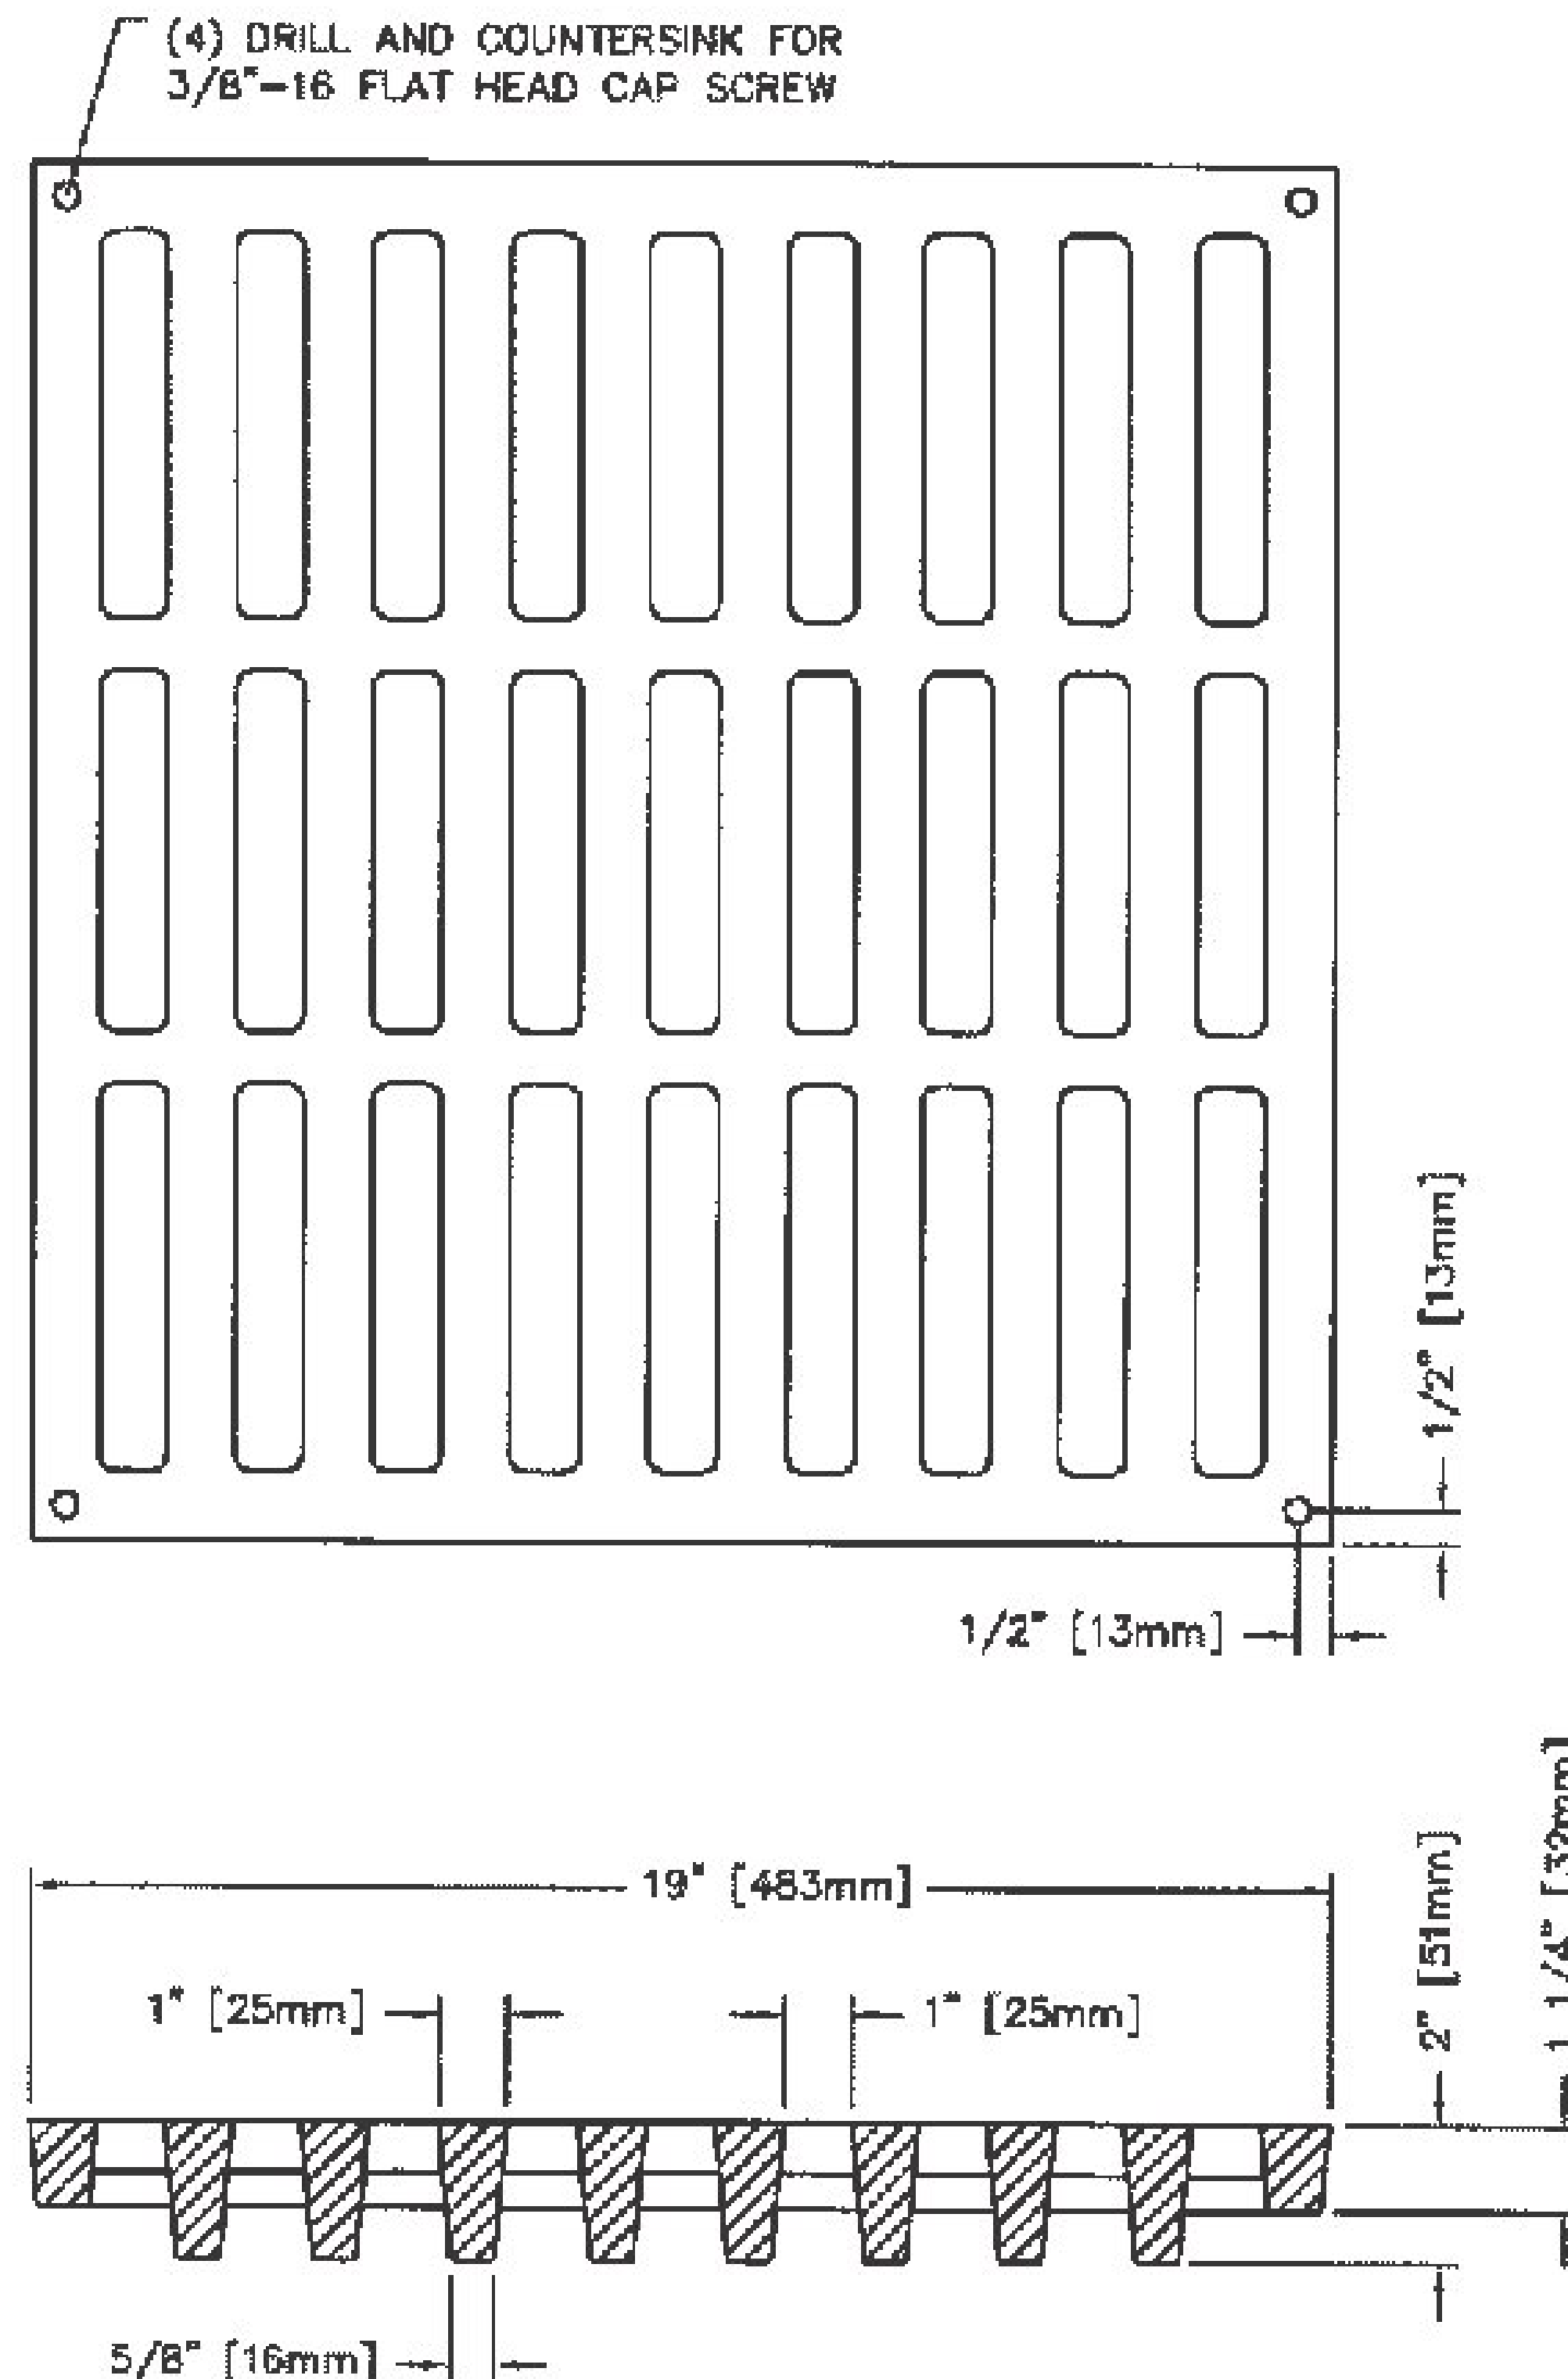

SHOP DRAWING REVIEW	
<input checked="" type="checkbox"/>	REVIEWED AS REQUIRED BY THE CONSTRUCTION CONTRACT DOCUMENTS AND APPROVED, BUT ONLY FOR CONFORMANCE TO THE DESIGN CONCEPT OF THE WORK, AND SUBJECT TO FURTHER LIMITATIONS AND REQUIREMENTS CONTAINED IN THE CONSTRUCTION CONTRACT DOCUMENTS.
<input type="checkbox"/>	REJECTED
<input type="checkbox"/>	REVISE AND RESUBMIT
<input type="checkbox"/>	APPROVED AS NOTED
CORRECTIONS OR COMMENTS MADE ON THE SHOP DRAWINGS DURING THIS REVIEW DID NOT RELIEVE CONTRACTOR FROM COMPLIANCE WITH REQUIREMENTS OF THE DRAWINGS AND SPECIFICATIONS. THIS CHECK IS ONLY FOR REVIEW OF GENERAL CONFORMANCE WITH THE DESIGN CONCEPT OF THE PROJECT AND GENERAL COMPLIANCE WITH THE INFORMATION GIVEN IN THE CONTRACT DOCUMENTS. THE CONTRACTOR IS RESPONSIBLE FOR: CONFIRMING AND CORRELATING ALL QUANTITIES AND DIMENSIONS; SELECTING FABRICATION PROCESSES AND TECHNIQUES OF CONSTRUCTION; COORDINATING THEIR WORK WITH THAT OF ALL OTHER TRADES; AND PERFORMING THEIR WORK IN A SAFE AND SATISFACTORY MANNER.	
G.E.D. Consulting Engineers 540 Commercial Street Manchester, NH 03101 603-868-8222	Job Number: 150223 Reviewed by: SRB Date: 04/26/2016

Vermont Agency of Transportation

**RECEIVED**

ON: April 20, 2016

and Checked for

**CONFORMANCE**

BY: Jennifer Fitch DATE: 04/26/16

NOTE: ALL DIMENSIONS SHOWN ARE IN ENGLISH AND [METRIC]  
 MATERIAL: CAST GRAY IRON ASTM A-48, CLASS 35B  
 FINISH: NO PAINT  
 WEIGHT: 79# WAS NF-12105

DR. KMH	SCALE 1 : 4	TITLE: R-3936-A TYPE "C" GRATE
CHK.	DATE 06-30-2000	NEENAH FOUNDRY COMPANY
APP.		NF- 39360004B





PO Box 508  
Barton, VT 05822  
Phone: (802)525-9506  
Fax: (802)525-4616  
[www.jpsicard.com](http://www.jpsicard.com)

Submittal Data Sheet

Submittal #: 7

Submission #: 1

Date: 4/28/2016

Project Name: Irasburg IM Deck (46)

Owner: Vermont Agency of Transportation

Engineer: VTrans

Contractor: J.P. Sicard, Inc.

Item Number: Bridge Railing 525.33 / Steel Beam Guardrail 621.20 / Guardrail Approach Section 621.72

Supplier: J.P. Sicard, Inc.





Description of Item: Bridge Rail, Approach Rail (Galvanized 2 Rail Box Beam) / Steel Beam Guardrail  
+ Welding Procedure

Substitution: NO

Engineers Review Comments:

Submitted By: Brad Drake  
Title: Project Manager  
Company: JP Sicard, Inc.



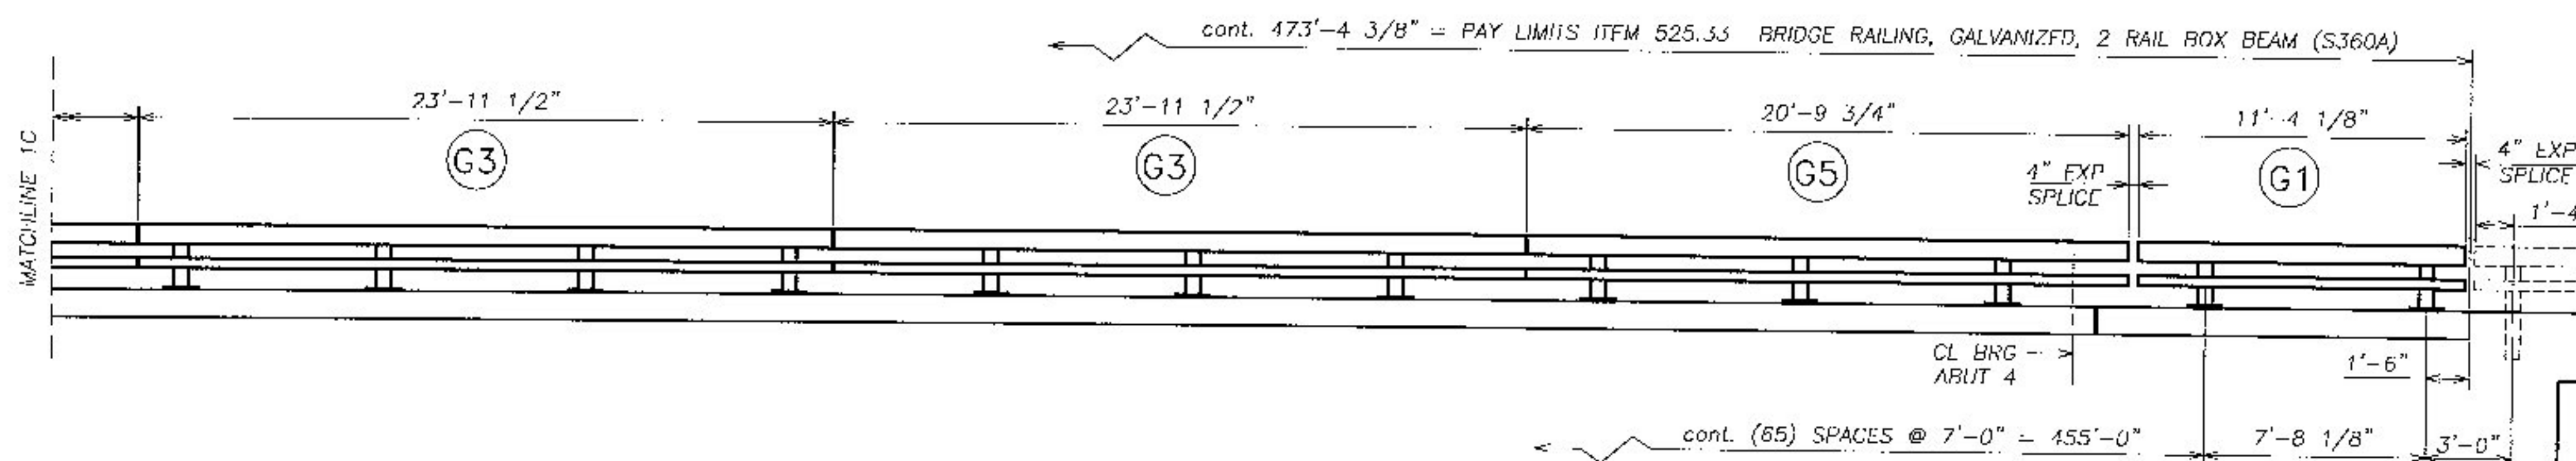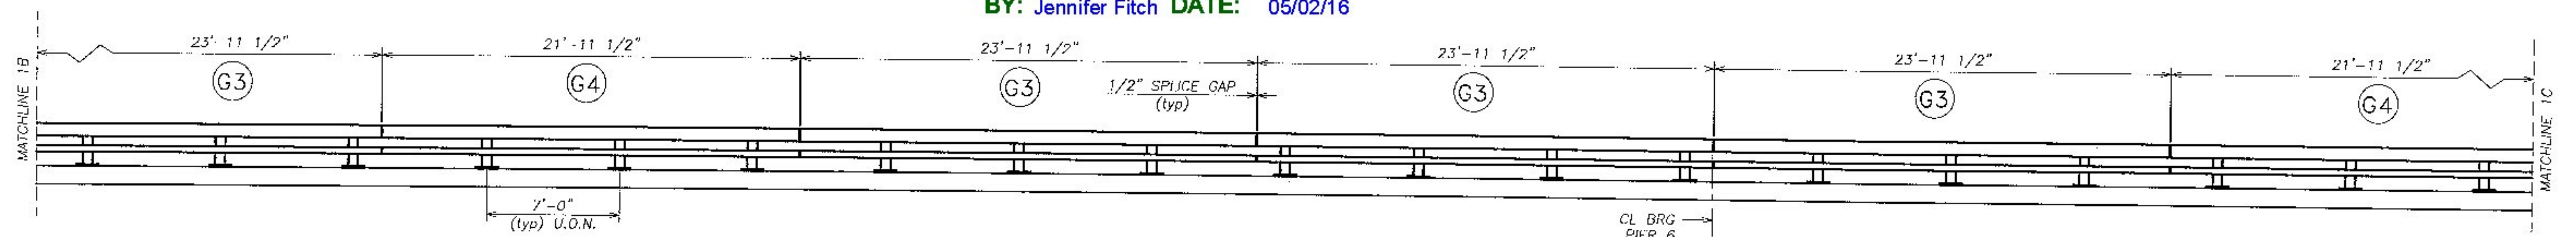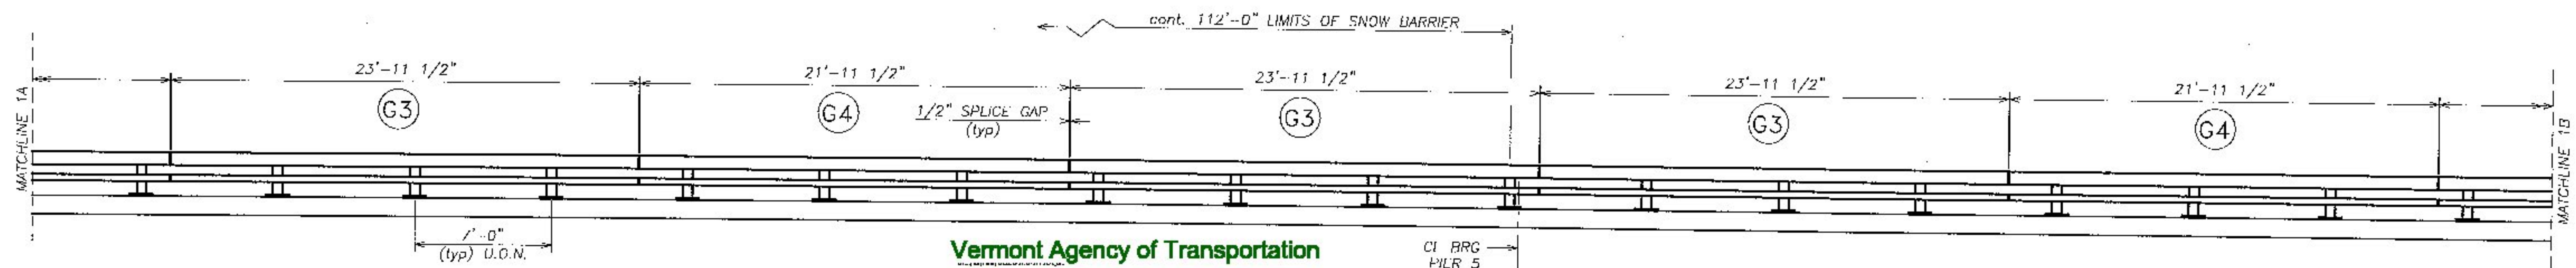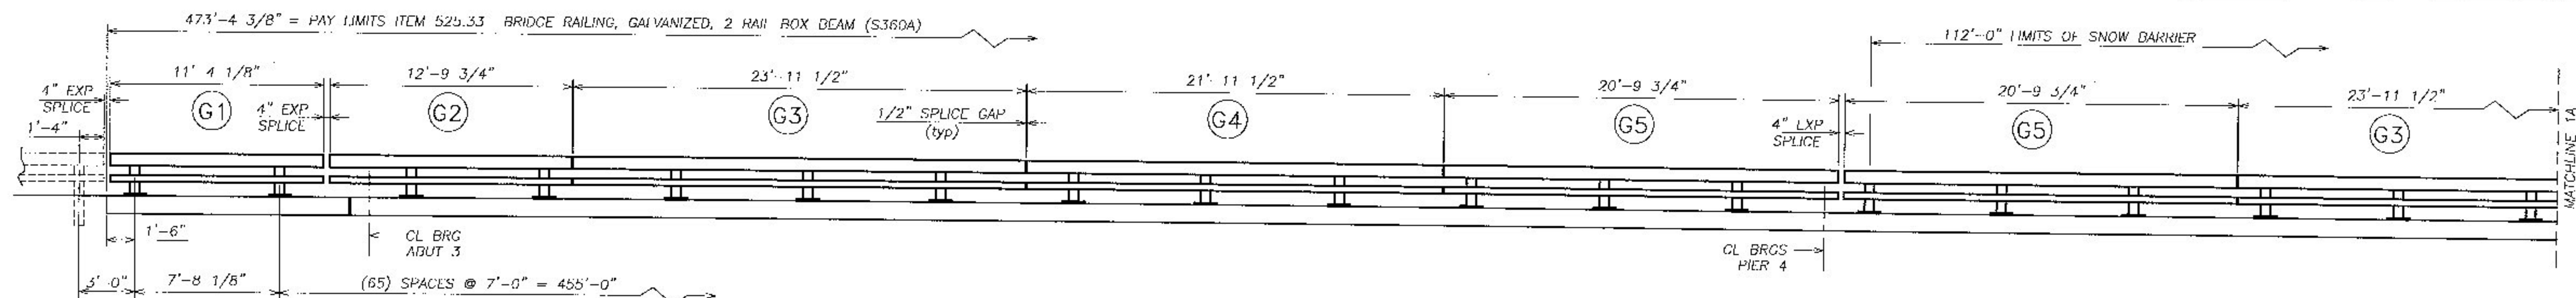

NORTHWEST SIDE RAILING ELEVATION  
LOOKING AT TRAFFIC FACE OF RAILING  
FACING NORTHWEST FROM CENTERLINE OF ROAD

No.	Initial	Remarks	Date
0	Initial	submittal	4/28/16
REVISIONS - APPLIES TO SET			

SHOP DRAWING REVIEW	
<input checked="" type="checkbox"/>	REVIEWED AS REQUIRED BY THE CONSTRUCTION CONTRACT DOCUMENTS AND APPROVED, BUT ONLY FOR CONFORMANCE TO THE DESIGN CONCEPT OF THE WORK, AND SUBJECT TO FURTHER LIMITATIONS AND REQUIREMENTS CONTAINED IN THE CONSTRUCTION CONTRACT DOCUMENTS.
<input type="checkbox"/>	REJECTED
<input type="checkbox"/>	REVISE AND RESUBMIT
<input type="checkbox"/>	APPROVED AS NOTED
CORRECTIONS OR COMMENTS MADE ON THE SHOP DRAWINGS DURING THIS REVIEW DID NOT RELIEVE CONTRACTOR FROM COMPLIANCE WITH REQUIREMENTS OF THE DRAWINGS AND SPECIFICATIONS. THIS CHECK IS ONLY FOR REVIEW OF GENERAL CONFORMANCE WITH THE DESIGN CONCEPT OF THE PROJECT AND GENERAL COMPLIANCE WITH THE INFORMATION GIVEN IN THE CONTRACT DOCUMENTS. THE CONTRACTOR IS RESPONSIBLE FOR CONFIRMING AND CORRELATING ALL QUANTITIES AND DIMENSIONS, SELECTING FABRICATION PROCESSES AND TECHNIQUES OF CONSTRUCTION, COORDINATING THEIR WORK WITH THAT OF ALL OTHER TRADES, AND PERFORMING THEIR WORK IN A SAFE AND SATISFACTORY MANNER.	
 G.D. Consulting Engineers, Inc. 640 Cornwell Drive Manchester, NH 03101 603-488-6225	Job Number: 150223 Reviewed by: SRB Date: 04/29/2015

HIGHWAY SAFETY CORP	
GLASTONBURY, CT 860-633-9445	
ITEM 525.33 BRIDGE RAILING, GALVANIZED 2 RAIL BOX BEAM (S-360A) ITEM 621.72 GUARDRAIL, APPROACH, GALV 2 RAIL BOX BEAM (S-360B)	
TOWN OF IRASHBURG, VERMONT INTERSTATE 91 (PRINCIPAL ARTERIAL) BRIDGE NO. 107 N ORLEANS COUNTY 1M DECK (46)	
GENERAL CONTRACTOR	CERTIFIED FABRICATOR
SUB CONTRACTOR	LAFAYETTE
DATE	04-27-16
SCALE	NONE
SIZE	D







DRAWN	PAR	CHECKED	DATE	SCALE	NONE	SIZE	D
-------	-----	---------	------	-------	------	------	---



BILL OF MATERIAL

Qty	mk	Description	Spec.
952.35 LF		ITEM 525.33 BRIDGE RAILING, GALVANIZED, 2 RAIL BOX BEAM	
137		BRIDGE RAILING POST W6 x 25 x 2'-2.375" OAH WITH 1 x 10 x 14 BASE PLATE (GLV)	A709 gr 50
36		SPLICE TUBE (FOR 8X4 RAIL) HSS 7 x 3 x 3/8 x 1'-8.000" OAL w/ TAPPED HOLES & 2 WELDED NUTS (GLV)	A500 gr B
36		SPLICE TUBE (FOR 4X4 RAIL) HSS 3 x 3 x 5/16 x 1'-8.000" OAL w/ TAPPED HOLES & 2 WELDED NUTS (GLV)	A500 gr B
6		EXP SPLICE (FOR 8X4 RAIL) HSS 7 x 3 x 3/8 x 1'-11.750" OAL w/ TAPPED HOLES & 2 WELDED NUTS (GLV)	A500 gr B
6		EXP SPLICE (FOR 4X4 RAIL) HSS 3 x 3 x 5/16 x 1'-11.750" OAL w/ TAPPED HOLES & 2 WELDED NUTS (GLV)	A500 gr B
3	G1	RAIL TUBE HSS 8 x 4 x 5/16 x 11 ft - 4.125 in OAL - EXP splice both ends (GLV)	A500 gr B
2	G2	RAIL TUBE HSS 8 x 4 x 5/16 x 12 ft - 9.75 in OAL - FIX splice 1 end, EXP splice 1 end (GLV)	A500 gr B
22	G3	RAIL TUBE HSS 8 x 4 x 5/16 x 23 ft - 11.5 in OAL - FIX splice both ends (GLV)	A500 gr B
10	G4	RAIL TUBE HSS 8 x 4 x 5/16 x 21 ft - 11.5 in OAL - FIX splice both ends (GLV)	A500 gr B
5	G5	RAIL TUBE HSS 8 x 4 x 5/16 x 20 ft - 9.75 in OAL - FIX splice 1 end, EXP splice 1 end (GLV)	A500 gr B
1	G6	RAIL TUBE HSS 8 x 4 x 5/16 x 20 ft - 1.625 in OAL - FIX splice 1 end, EXP splice 1 end (GLV)	A500 gr B
1	G7	RAIL TUBE HSS 8 x 4 x 5/16 x 17 ft - 8 in OAL - EXP splice both ends (GLV)	A500 gr B
3	G1	RAIL TUBE HSS 4 x 4 x 1/4 x 11 ft - 4.125 in OAL - EXP splice both ends (GLV)	A500 gr B
2	G2	RAIL TUBE HSS 4 x 4 x 1/4 x 12 ft - 9.75 in OAL - FIX splice 1 end, EXP splice 1 end (GLV)	A500 gr B
22	G3	RAIL TUBE HSS 4 x 4 x 1/4 x 23 ft - 11.5 in OAL - FIX splice both ends (GLV)	A500 gr B
10	G4	RAIL TUBE HSS 4 x 4 x 1/4 x 21 ft - 11.5 in OAL - FIX splice both ends (GLV)	A500 gr B
5	G5	RAIL TUBE HSS 4 x 4 x 1/4 x 20 ft - 9.75 in OAL - FIX splice 1 end, EXP splice 1 end (GLV)	A500 gr B
1	G6	RAIL TUBE HSS 4 x 4 x 1/4 x 20 ft - 1.625 in OAL - FIX splice 1 end, EXP splice 1 end (GLV)	A500 gr B
1	G7	RAIL TUBE HSS 4 x 4 x 1/4 x 17 ft - 8 in OAL - EXP splice both ends (GLV)	A500 gr B
137		ANCHOR SPACER PLATE PL 0.375 x 13.000 x 9.375	A709 gr 36
548		ANCHOR STUD DBL END PART THREAD - 1" DIA x 12.000 w/ 2.250" THD EACH END (GLV)	A449
1096		HEAVY HEX NUT 1" (GLV)	A563 DH
548		ROUND WASHER (SAE) - 1" DIA SMALL (GLV)	F436
548		JAM NUT 1" (GALV)	A563 DH
548		ROUND HEAD POST BOLT slot or wrench head - no shoulder 3/4" DIA x 6" LG. FULL BODY (GLV)	A449 / A325
548		LOCK NUT 3/4" (GLV)	A563 DH
548		ROUND WASHER (SAE) 3/4" (GLV)	F436
336		HEX HEAD BOLT 5/8" DIA x 1.75" LG. (GLV)	A325
336		ROUND WASHER (SAE) 5/8" (GLV)	F436
48		SPACER PIPE - GALVANIZED 3/4" SCH. 40 x 1/2" LONG (GLV)	A53 gr B
137		BEARING PAD 0.125" THICK x 10.000 x 14.000 (NEOPRENE 80 duro +/-10)	aashto M251

Vermont Agency of Transportation

RECEIVED

ON: April 28, 2016

and Checked for

CONFORMANCE

BY: Jennifer Fitch DATE: 05/02/16

NOTES:

- ALL WORK AND MATERIALS SHALL CONFORM TO SECTION 525.
  - PRIOR TO GALVANIZING, ALL EXPOSED CUT OR SHEARED EDGES SHALL BE ROUNDED TO A 1/16" RADIUS AND BE FREE OF BURRS.
  - ALL POSTS SHALL BE SET NORMAL TO GRADE.
  - SECTIONS OF RAIL TUBE SHALL BE ATTACHED TO A MINIMUM OF TWO (2) RAIL POSTS AND PREFERABLY TO AT LEAST FOUR (4) POSTS.
  - RAIL TUBE EXPANSION JOINT SHALL BE PROVIDED IN ANY RAIL BAY SPANNING THE END OF AN INTEGRAL ABUTMENT BRIDGE AND AT ALL SUPERSTRUCTURE EXPANSION JOINTS. EXPANSION JOINT WIDTH SHALL BE 4" AT 45°F AND WILL BE ADJUSTED IN THE FIELD BY THE ENGINEER FOR OTHER TEMPERATURES.
  - HOLES IN RAILS FOR RAIL TUBE ATTACHMENT SHALL BE FIELD-DRILLED. HOLES SHALL BE COATED WITH AN APPROVED ZINC-RICH PAINT PRIOR TO INSTALLATION.
  - RAIL POST ANCHORING NUTS SHALL BE TIGHTENED TO A SNUG FIT AND GIVEN AN ADDITIONAL ONE-EIGHTH TURN.
  - RAIL TUBES SHALL BE ATTACHED USING 3/4" FULL DIAMETER BODY ASTM A449 ROUND HEAD BOLTS INSERTED THROUGH THE FACE OF THE TUBE. HOLES IN POSTS SHALL BE 1/16" LARGER THAN THE BOLT SIZE.
  - ANY BENDING OR CURVING OF RAIL SHALL BE DONE IN A FABRICATION PLANT IN ACCORDANCE WITH SUBMITTED PROCEDURES.
  - THE MINIMUM DISTANCE FROM A POST TO AN EXPANSION JOINT SHALL BE SUCH TO MAINTAIN MINIMUM EDGE DISTANCE OF 5" FROM ANY ANCHOR STUD TO THE END OF THE SLAB, OR TO THE EXPANSION JOINT RECESS POUR, IF ONE IS USED.
  - A DELINEATOR (SEE VAOT STANDARD DRAWING G-1 FOR DETAILS) SHALL BE INSTALLED AT NEAREST POST TO 30 FT SPACING. WHITE IS TO BE INSTALLED ON THE DRIVER'S RIGHT. FOR ONE WAY BRIDGES, YELLOW IS TO BE INSTALLED ON THE DRIVER'S LEFT. PAYMENT SHALL BE INCIDENTAL TO OTHER ITEMS.
  - THIS RAILING MEETS THE REQUIREMENTS FOR A TL-4 SERVICE LEVEL.
- MATERIALS**  
RAIL TUBES.....ASTM A500 GRADE B OR ASTM A501  
RAIL POSTS AND BASE PLATES.....ASTM A709/A709M, GRADE 50  
ALL OTHER SHAPES AND PLATES.....ASTM A709/A709M, GRADE 36  
ANCHOR STUDS.....ASTM A449  
ALL OTHER BOLTS (UNLESS NOTED).....AASHTO M164, TYPE1
- NUTS FOR AASHTO M164 BOLTS AND FOR ANCHOR STUDS SHALL COMPLY WITH AASHTO M291 (ASTM A563).
- WASHERS SHALL COMPLY WITH AASHTO M293 (ASTM F436) SPECIFICATIONS.
- 1/8" PAD SHALL COMPLY WITH STANDARD SPECIFICATION SUBSECTION 731.01 OR 731.02.
- RAIL POSTS AND BASE PLATES SHALL BE TESTED FOR IMPACT PROPERTIES IN ACCORDANCE WITH ASTM A370 CHARPY IMPACT TESTING USING TYPE A SPECIMEN.

SHOP DRAWING REVIEW

☒ REVIEWED AS REQUIRED BY THE CONSTRUCTION CONTRACT DOCUMENTS AND APPROVED, BUT ONLY FOR CONFORMANCE TO THE DESIGN CONCEPT OF THE WORK AND SUBJECT TO FURTHER LIV TATIONS AND REQUIREMENTS CONTAINED IN THE CONSTRUCTION CONTRACT DOCUMENTS.

☐ REJECTED ☐ REVISE AND RESUBMIT ☐ APPROVED AS NOTED

CORRECTIONS OR COMMENTS MADE ON THE SHOP DRAWINGS DURING THE REVIEW DID NOT RELIEVE CONTRACTOR FROM COMPLIANCE WITH REQUIREMENTS OF THE DRAWINGS AND SPECIFICATIONS. THIS CHECK IS ONLY FOR REVIEW OF GENERAL CONFORMANCE WITH THE DESIGN CONCEPT OF THE PROJECT AND GENERAL COMPLIANCE WITH THE INFORMATION GIVEN IN THE CONTRACT DOCUMENTS. THE CONTRACTOR IS RESPONSIBLE FOR CONFIRMING AND CORRECTING ALL QUANTITIES AND DIMENSIONS, SELECTING FABRICATION PROCESSES AND TECHNICALS OF CONSTRUCTION, COORDINATING THEIR WORK WITH THAT OF ALL OTHER TRADES AND PERFORMANCE THEIR WORK IN A SAFE AND SATISFACTORY MANNER.

CLD Consulting Engineers  
440 Commercial Street  
Montpelier, VT 05601  
802.665.1223

Job Number: 150223  
Reviewed by: SRB  
Date: 04/29/2015

HIGHWAY SAFETY CORP  
GLASTONBURY, CT  
860-633-9445

ITEM 525.33 BRIDGE RAILING, GALVANIZED 2 RAIL BOX BEAM (S-360A)

TOWN OF IRASBURG, VERMONT  
INTERSTATE 91 (PRINCIPAL ARTERIAL) BRIDGE NO. 107 N  
ORLEANS COUNTY IM DECK (46)

GENERAL CONTRACTOR

LAFAYETTE

DATE

PAR

CHECKED

DATE

04-27-16

SCALE

NONE

SHEET

D

CERTIFIED FABRICATOR

ISSUE NO.

2103

SHEET NO.

4 of 5







# Highway Safety Corporation

Glastonbury, CT

## Welding Procedure Specification

Material specification	A572 gr 50, A709 Gr 50		
Welding process	Gas Metal Arc Welding (GMAW) Spray Transfer		
Manual, semi-automatic, or automatic	Semi-Automatic		
Position of welding	Flat (1F) or Horizontal (2F)		
Filler metal specification	AWS A5.18		
Filler metal classification	ER70S-6		
Electrode and manufacturer	Lincoln Electric Lincoln Weld L-56		
Flux and manufacturer	N/A		
Shielding gas	86% Argon / 14% CO2	Flow rate	39 - 45 CFH
Single or multiple pass	Single or Multiple		
Single or multiple arc	Single		
Welding current	DCEP		
Polarity	Reverse - electrode positive		
Welding progression	Stringers		
Root treatment	clean base metal		
Preheat and interpass temperature	base metal up to 3/4" (50°F) ; over 3/4 thru 1-1/2" ( 150°F ) ; over 1-1/2" thru 2-1/2" (225°F)		
Postweld heat treatment	None		
Electrode extension	3/4" ± 1/4"		

<b>SHOP DRAWING REVIEW</b>	
<input checked="" type="checkbox"/> REVIEWED AS REQUIRED BY THE CONSTRUCTION CONTRACT DOCUMENTS AND APPROVED FOR CONFORMANCE TO THE DESIGN CONCEPT OF THE WORK, AND SUBJECT TO FURTHER LIMITATIONS AND REQUIREMENTS CONTAINED IN THE CONSTRUCTION CONTRACT DOCUMENTS.	
<input type="checkbox"/> REJECTED <input type="checkbox"/> REVISE AND RESUBMIT <input type="checkbox"/> APPROVED AS NOTED	
CORRECTIONS OR COMMENTS MADE ON THE SHOP DRAWINGS DURING THIS REVIEW DO NOT RELIEVE THE CONTRACTOR OF ANY OBLIGATION WITH RESPECT TO THE DRAWINGS AND SPECIFICATIONS. THIS CHECK IS ONLY FOR REVIEW OF GENERAL COMPLIANCE WITH THE DESIGN CONCEPT OF THE PROJECT AND GENERAL COMPLIANCE WITH THE INFORMATION GIVEN IN THE CONTRACT DOCUMENTS. THE CONTRACTOR IS RESPONSIBLE FOR CONFIRMING AND CORRECTING ALL DIMENSIONS AND DIMENSIONS, INCLUDING, BUT NOT LIMITED TO, PROCESSES AND TECHNIQUES OF CONSTRUCTION, COORDINATING THEIR WORK WITH THAT OF ALL OTHER TRADES, AND PERFORMING THEIR WORK IN A SAFE AND SATISFACTORY MANNER.	
 C.D. Case, Inc. Engineers 540 Commercial Street Middletown, NH 03111 603-436-8222	Job Number: 1511223 Reviewed by: SRB Date: 04/29/2016

Vermont Agency of Transportation

RECEIVED


ON: April 28, 2016

and Checked for

CONFORMANCE

BY: Jennifer Fitch DATE: 05/02/16

### WELDING PROCEDURE

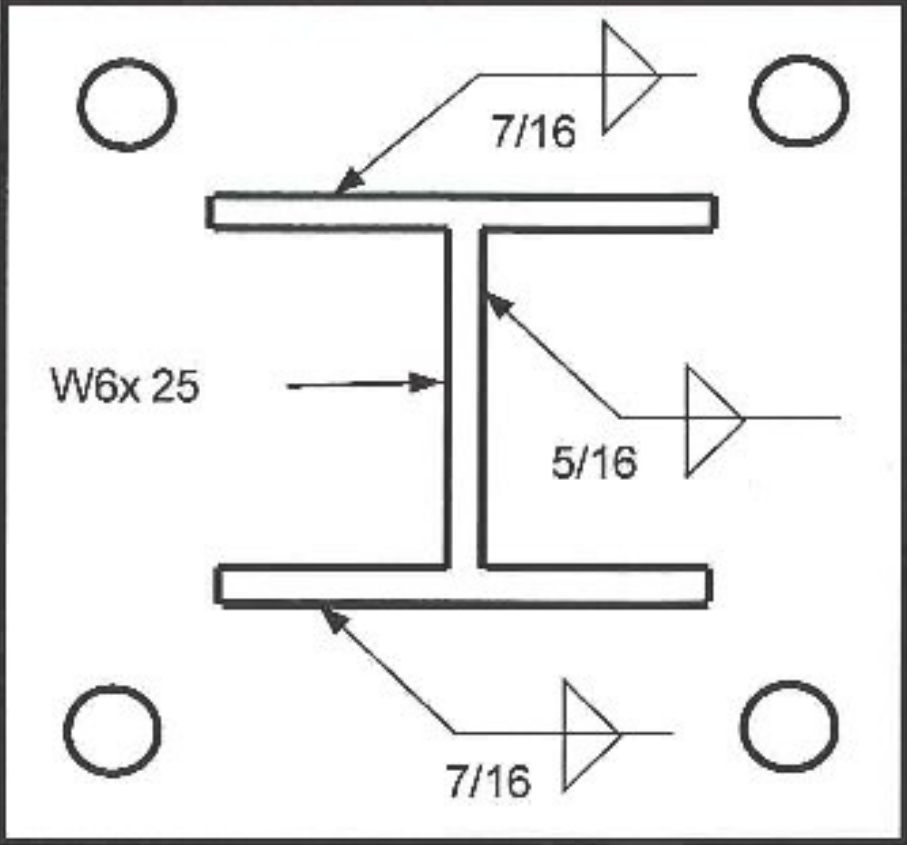Weld size	Pass no.	Electrode size	Welding parameters		Travel speed	Joint detail
			Amperes	Volts		
5/16"	1	0.062"	300 A ± 30	29 V ± 2	15 ipm ± 2	
7/16"	1 & 2	0.062"	↓	↓	15 ipm ± 2	

This procedure may vary due to fabrication sequence, fit-up, pass size, etc. within the limitation of variables given in section 5 of latest edition AWS D1.5

WPS no. **W-VTPEDPOST1**

Revision no. **0**

Supporting PQR no. **W-AWSD1511 (06-22-11)**

Project Name **Irasburg, VT**

Fabricator **Highway Safety Corporation**

Prepared By: **Paul Radice**

Date **04-28-16**

Project Number **IM DECK (46)**

Paul A Radice  
CWI 98070221  
QC-1 EXP. 7/1/2016



# Highway Safety Corporation

Glastonbury, CT

## Welding Procedure Specification

Material specification	ASTM A500 gr B	
Welding process	Gas Metal Arc Welding (GMAW)	
Manual, semi-automatic, or automatic	Semi-Automatic	
Position of welding	Flat (1F)	
Filler metal specification	AWS A5.18	
Filler metal classification	ER70S-6	
Electrode and manufacturer	Lincoln Electric Lincoln Weld L-56	
Flux and manufacturer	N/A	
Shielding gas	86% Argon / 14% CO2	Flow rate 39 - 45 CFH
Single or multiple pass	Single	
Single or multiple arc	Single	
Welding current	DCEP	
Polarity	Reverse - electrode positive	
Welding progression	Stringers	
Root treatment	clean base metal	
Preheat and interpass temperature	base metal up to 3/4" (50°F)	
Postweld heat treatment	None	
Electrode extension	3/4" ± 1/4"	

### SHOP DRAWING REVIEW

REVIEWED AS REQUIRED BY THE CONSTRUCTION CONTRACT DOCUMENTS AND APPROVED, BUT ONLY FOR CONFORMANCE TO THE DESIGN CONCEPT OF THE WORK AND SUBJECT TO FURTHER LIVATIONS AND REQUIREMENTS CONTAINED IN THE CONSTRUCTION CONTRACT DOCUMENTS.


☐ REJECTED ☐ REVISE AND RESUBMIT ☐ APPROVED AS NOTED

CORRECTIONS OR COMMENTS MADE ON THE SHOP DRAWINGS DURING THIS REVIEW DID NOT RELIEVE CONTRACTOR FROM COMPLIANCE WITH REQUIREMENTS OF THE DRAWINGS AND SPECIFICATIONS. THIS CHECK IS ONLY FOR REVIEW OF GENERAL CONFORMANCE WITH THE DESIGN CONCEPT OF THE PROJECT AND GENERAL CONFORMANCE WITH THE INFORMATION GIVEN IN THE CONTRACT DOCUMENTS. THE CONTRACTOR IS RESPONSIBLE FOR CONFIRMING AND CORRELATING ALL QUANTITIES AND DIMENSIONS, SELECTING FABRICATION PROCESSES AND TECHNIQUES OF CONSTRUCTION, COORDINATING THEIR WORK WITH THAT OF ALL OTHER TRADES, AND PERFORMING THEIR WORK IN A SAFE AND SATISFACTORY MANNER.

CLD Consulting Engineers  
540 Commercial Street  
Glastonbury, CT 06033  
0303-893-8223

Job Number: 150223  
Reviewed by: GFB  
Date: 04/29/2015

### WELDING PROCEDURE

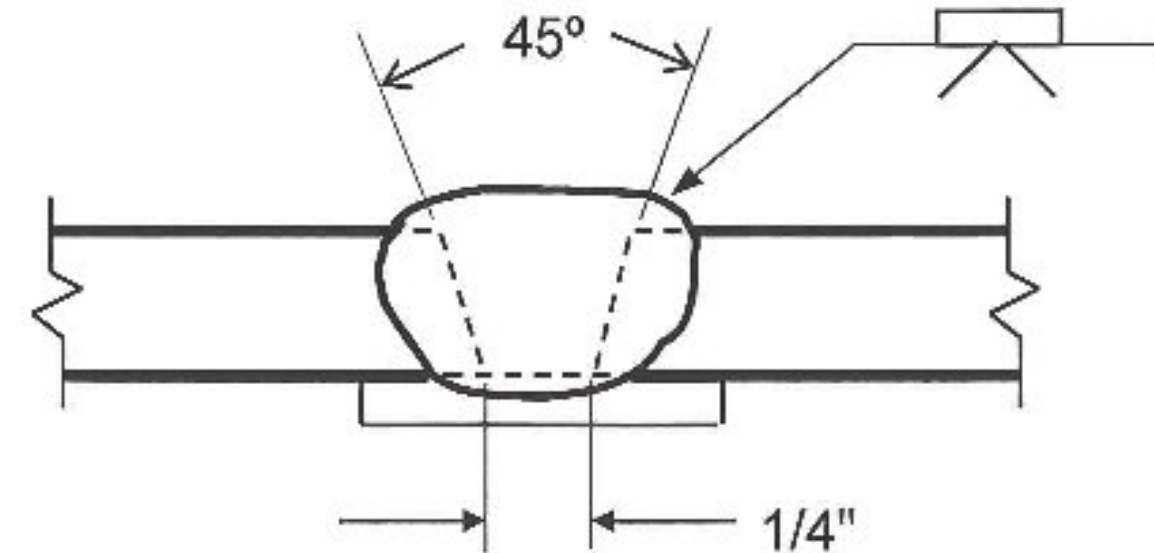Weld size	Pass no.	Electrode size	Welding parameters		Travel speed	Joint detail
			Amperes	Volts		
	1	0.063"	300 A ± 30	29 V ± 2	15 ipm ± 2	B-U2a-GF 

This procedure may vary due to fabrication sequence, fit-up, pass size, etc. within the limitation of variables given in section 5 of latest edition AWS D1.5

WPS no. **W-VGwBCK**  
Revision no. **0**  
Supporting PQR no. **W-AWSD1511 (06-22-11)**  
Project Name **Irasburg, VT**

Fabricator **Highway Safety Corporation**  
Prepared By: **Paul Radice**  
Date **04-28-16**  
Project Number **IM DECK (46)**

Paul A Radice  
CWI 98070221  
QC1 EXP. 7/1/2016