

DURABLE 6 INCH WHITE LINE (OPTION BID ITEM)

RAMP A:
A0+00 - A31+40 RT (EDGE LINE RT)
A19+20 - A31+40 CL (DOTTED LANE LINE)

RAMP B:
B0+00 - B28+70 RT (EDGE LINE RT)
B0+00 - B5+00 CL (DOTTED LANE LINE)

DURABLE 6 INCH YELLOW LINE (OPTION BID ITEM)

RAMP A:
A0+00 - A18+20 LT (EDGE LINE LT)

RAMP B:
B6+55- B28+70 LT (EDGE LINE LT)

TEMPORARY 6 INCH WHITE LINE, PAINT

RAMP A:
A0+00 - A31+40 RT (EDGE LINE RT)
A19+20 - A31+40 CL (DOTTED LANE LINE)

RAMP B:
B0+00 - B28+70 RT (EDGE LINE RT)
B0+00 - B5+00 CL (DOTTED LANE LINE)

TEMPORARY 6 INCH YELLOW LINE, PAINT

RAMP A:
A0+00 - A18+20 LT (EDGE LINE LT)

RAMP B:
B6+55- B28+70 LT (EDGE LINE LT)

DURABLE 12 INCH WHITE LINE (OPTION BID ITEM)

RAMP A:
A18+20 - A19+20 LT (GORE LINES RAMP A)

RAMP B:
B5+00 - A6+55 LT (GORE LINES RAMP A)

DURABLE LETTER OR SYMBOL (OPTION BID ITEM)

RAMP B:
B21+50 CL "S,I,G,N,A,L" (6 EA)
B22+00 CL "A,H,E,A,D" (5 EA)


TEMPORARY 12 INCH WHITE LINE, PAINT

RAMP A:
A18+20 - A19+20 LT (GORE LINES RAMP A)

RAMP B:
B5+00 - A6+55 LT (GORE LINES RAMP A)

TEMPORARY LETTER OR SYMBOL, PAINT

RAMP B:
B21+50 CL "S,I,G,N,A,L" (6 EA)
B22+00 CL "A,H,E,A,D" (5 EA)

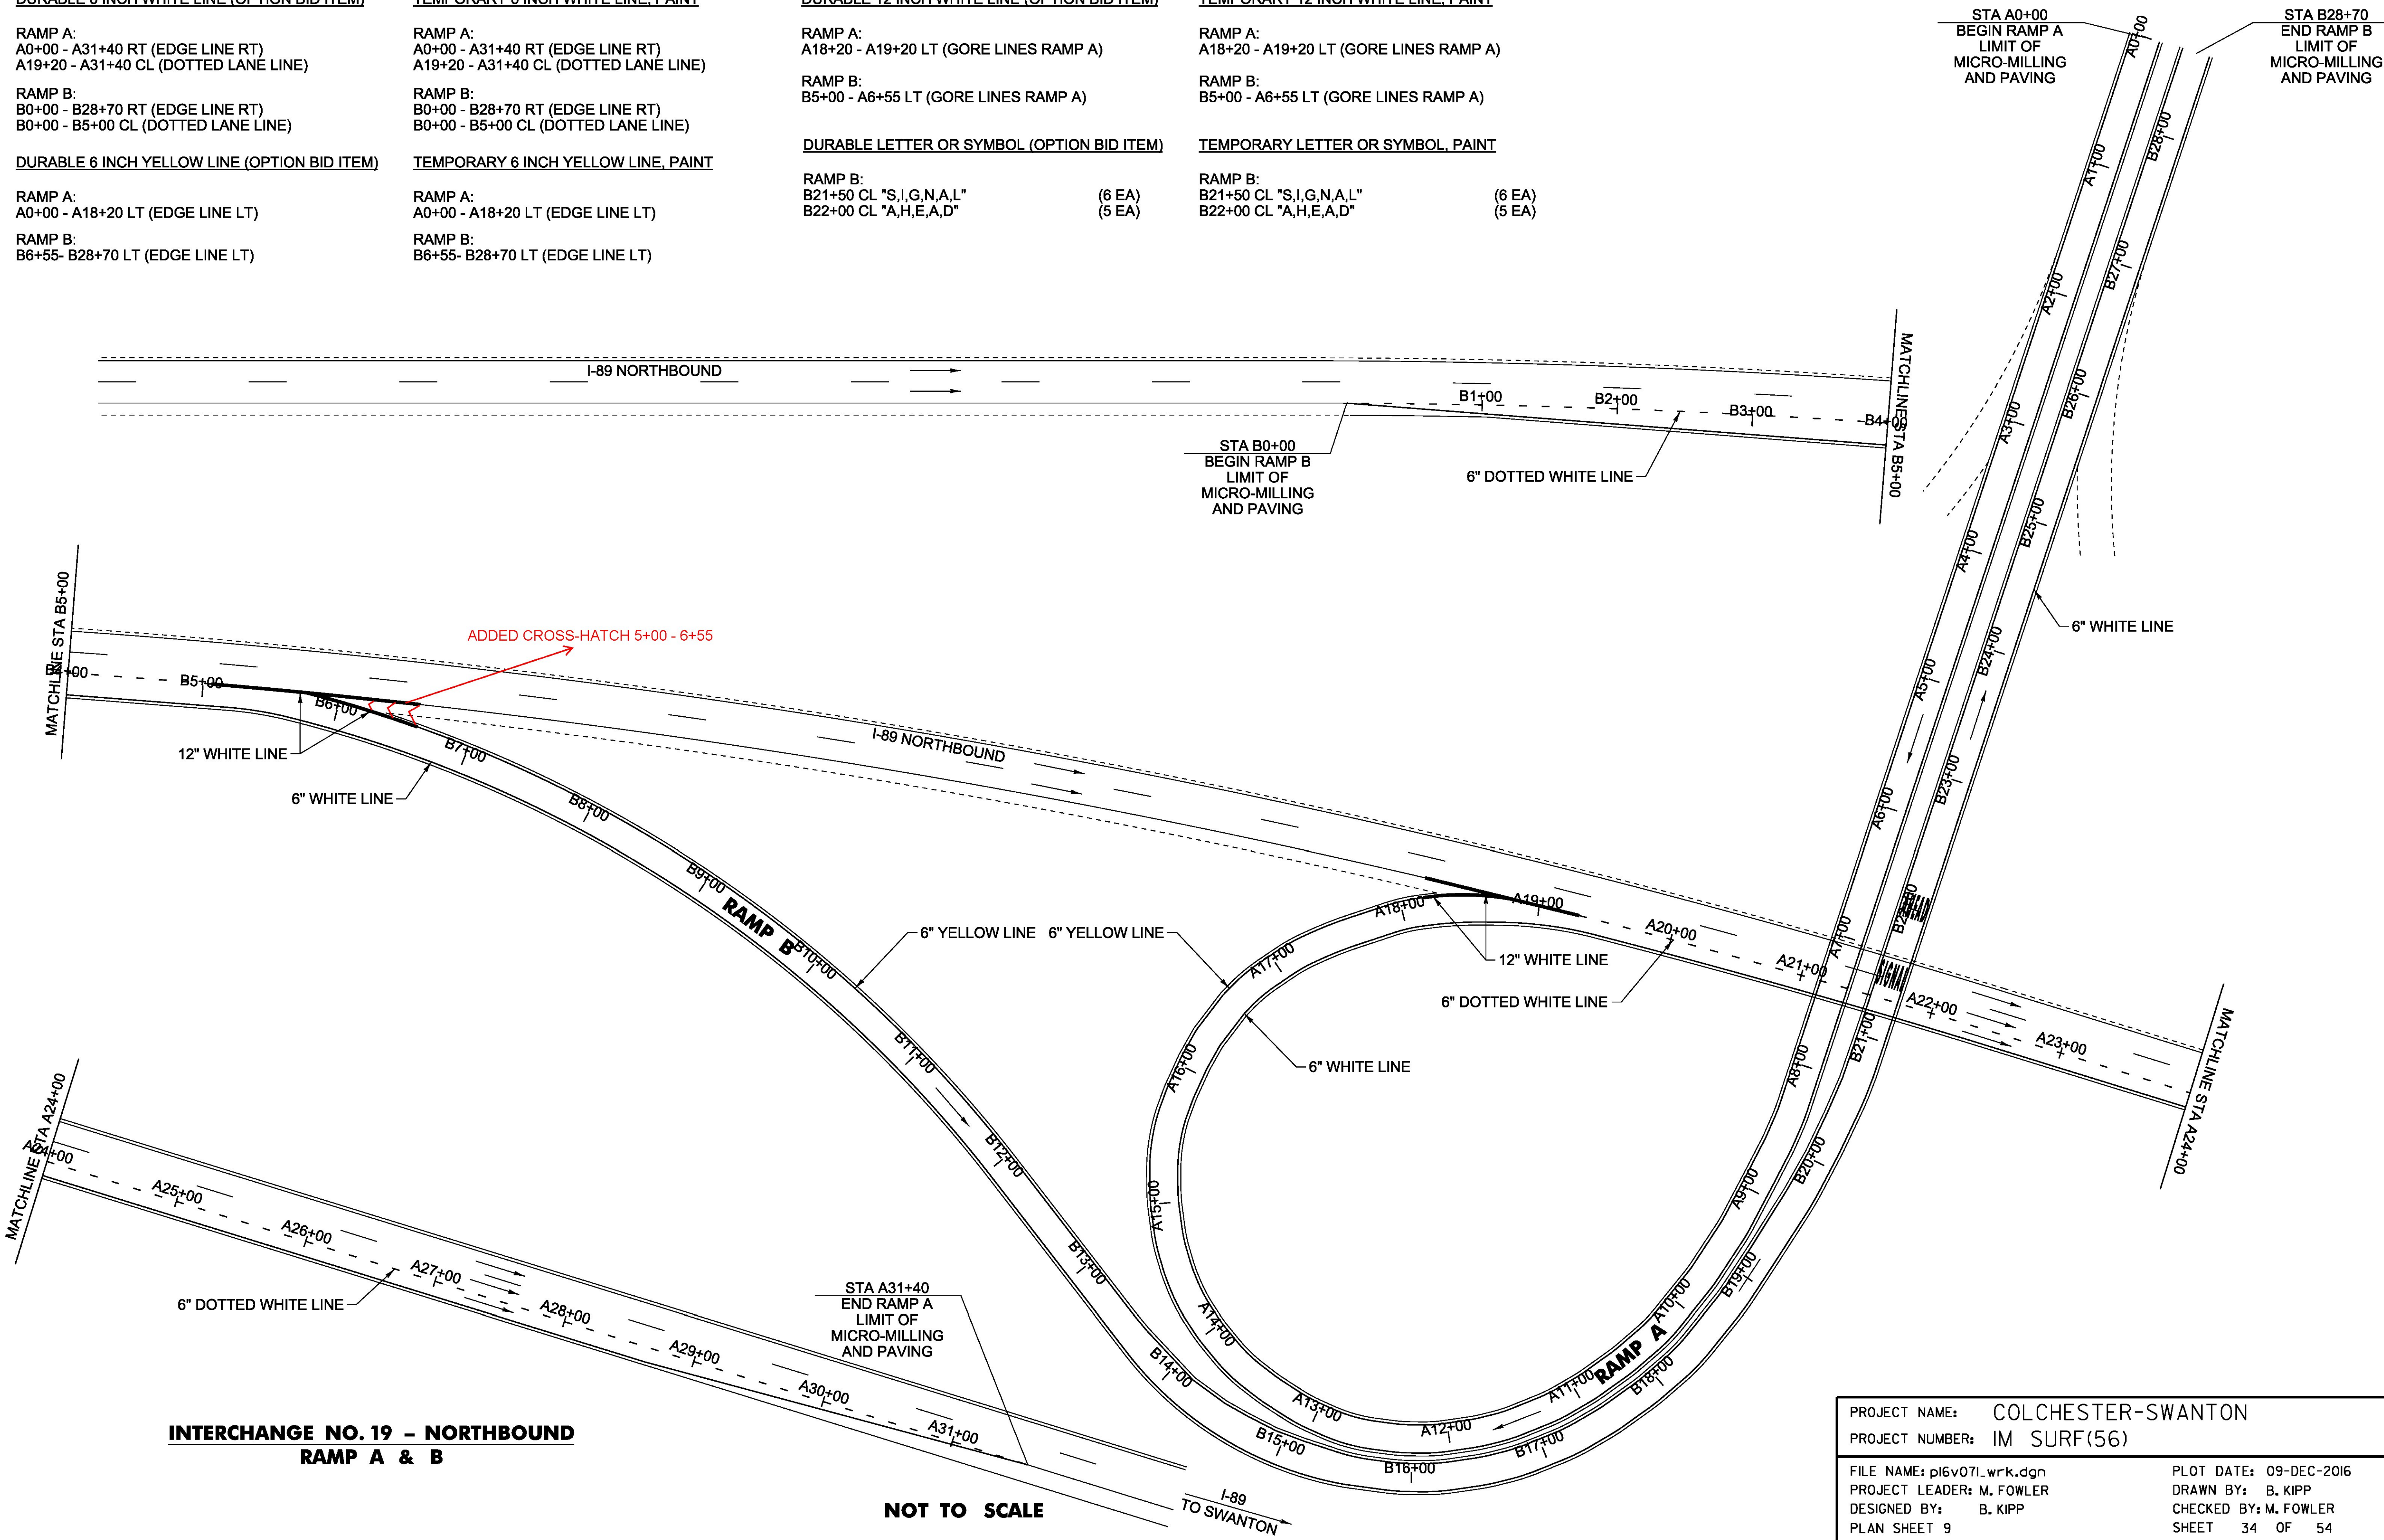

PROJECT NAME: COLCHESTER-SWANTON

PROJECT NUMBER: IM SURF(56)

FILE NAME: pl6v071_wrk.dgn

PROJECT LEADER: M. FOWLER

DESIGNED BY: B. KIPP

PLAN SHEET 9

PLOT DATE: 09-DEC-2016

DRAWN BY: B. KIPP

CHECKED BY: M. FOWLER

SHEET 34 OF 54