



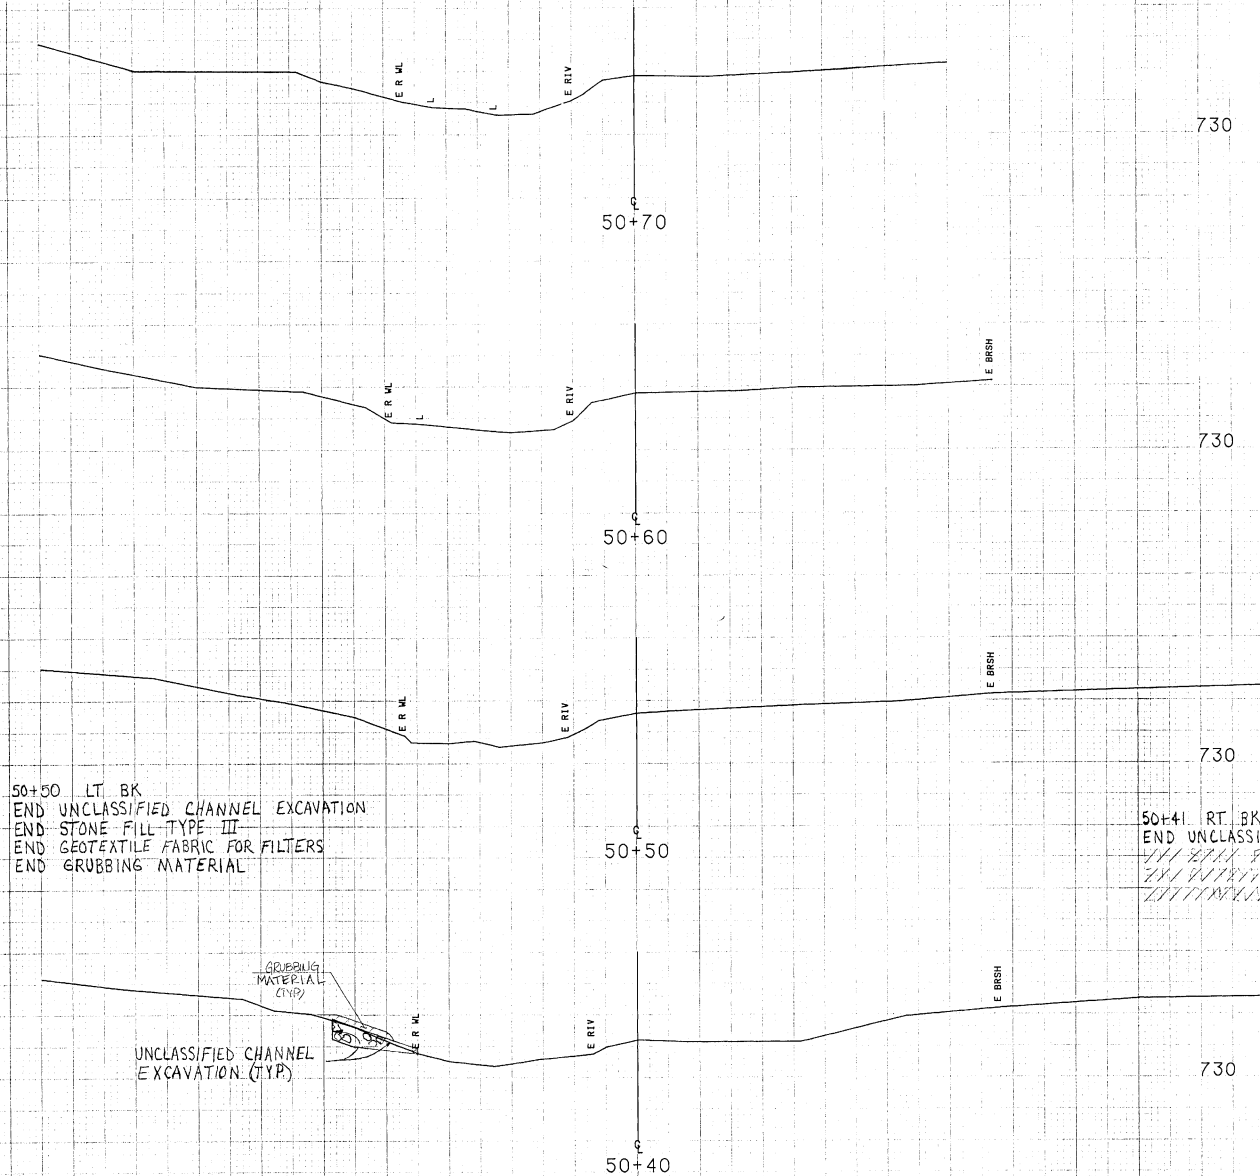


SCALE 10 FEET


FROM STA.	50+40	TO STA.	50+70
PROJECT NAME	MIDDLETOWN SPRINGS CHANNEL		
NO.	BR21443 (26)	PLOTTED	04/24/91
SURVEYED BY	GILMAN		04/91 0342
SHEET	OF	SHEETS	

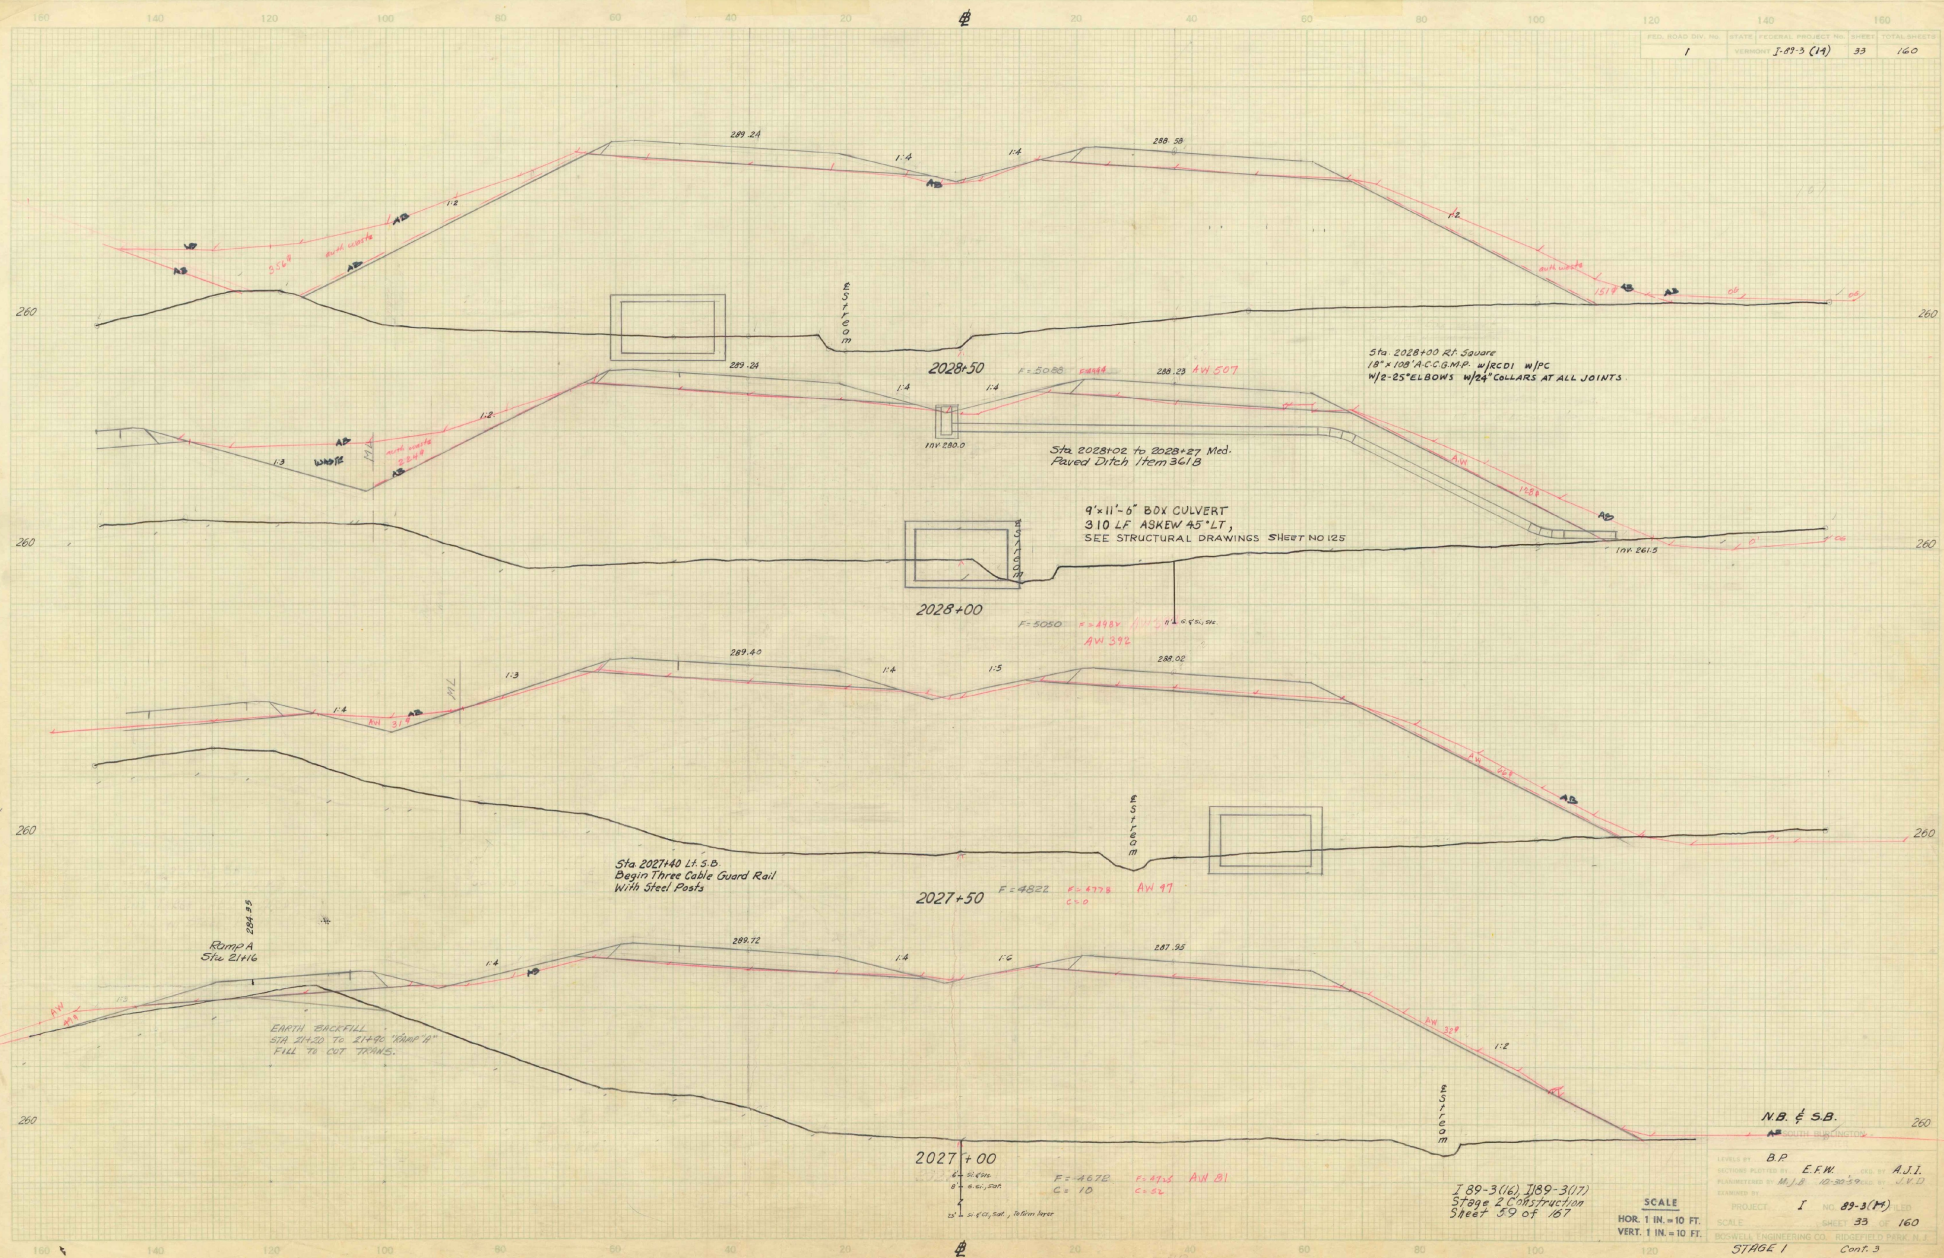


By ERM-UNISO
 CH. 100.00 A-11 (1/4)
 TRUCKS TO 500 YARDS
 ROAD 2142 TO 2140
 ROAD 2142 TO 2140

189-3(16) 189-3(17)
 Stage 2 Construction
 Sheet 33 of 167

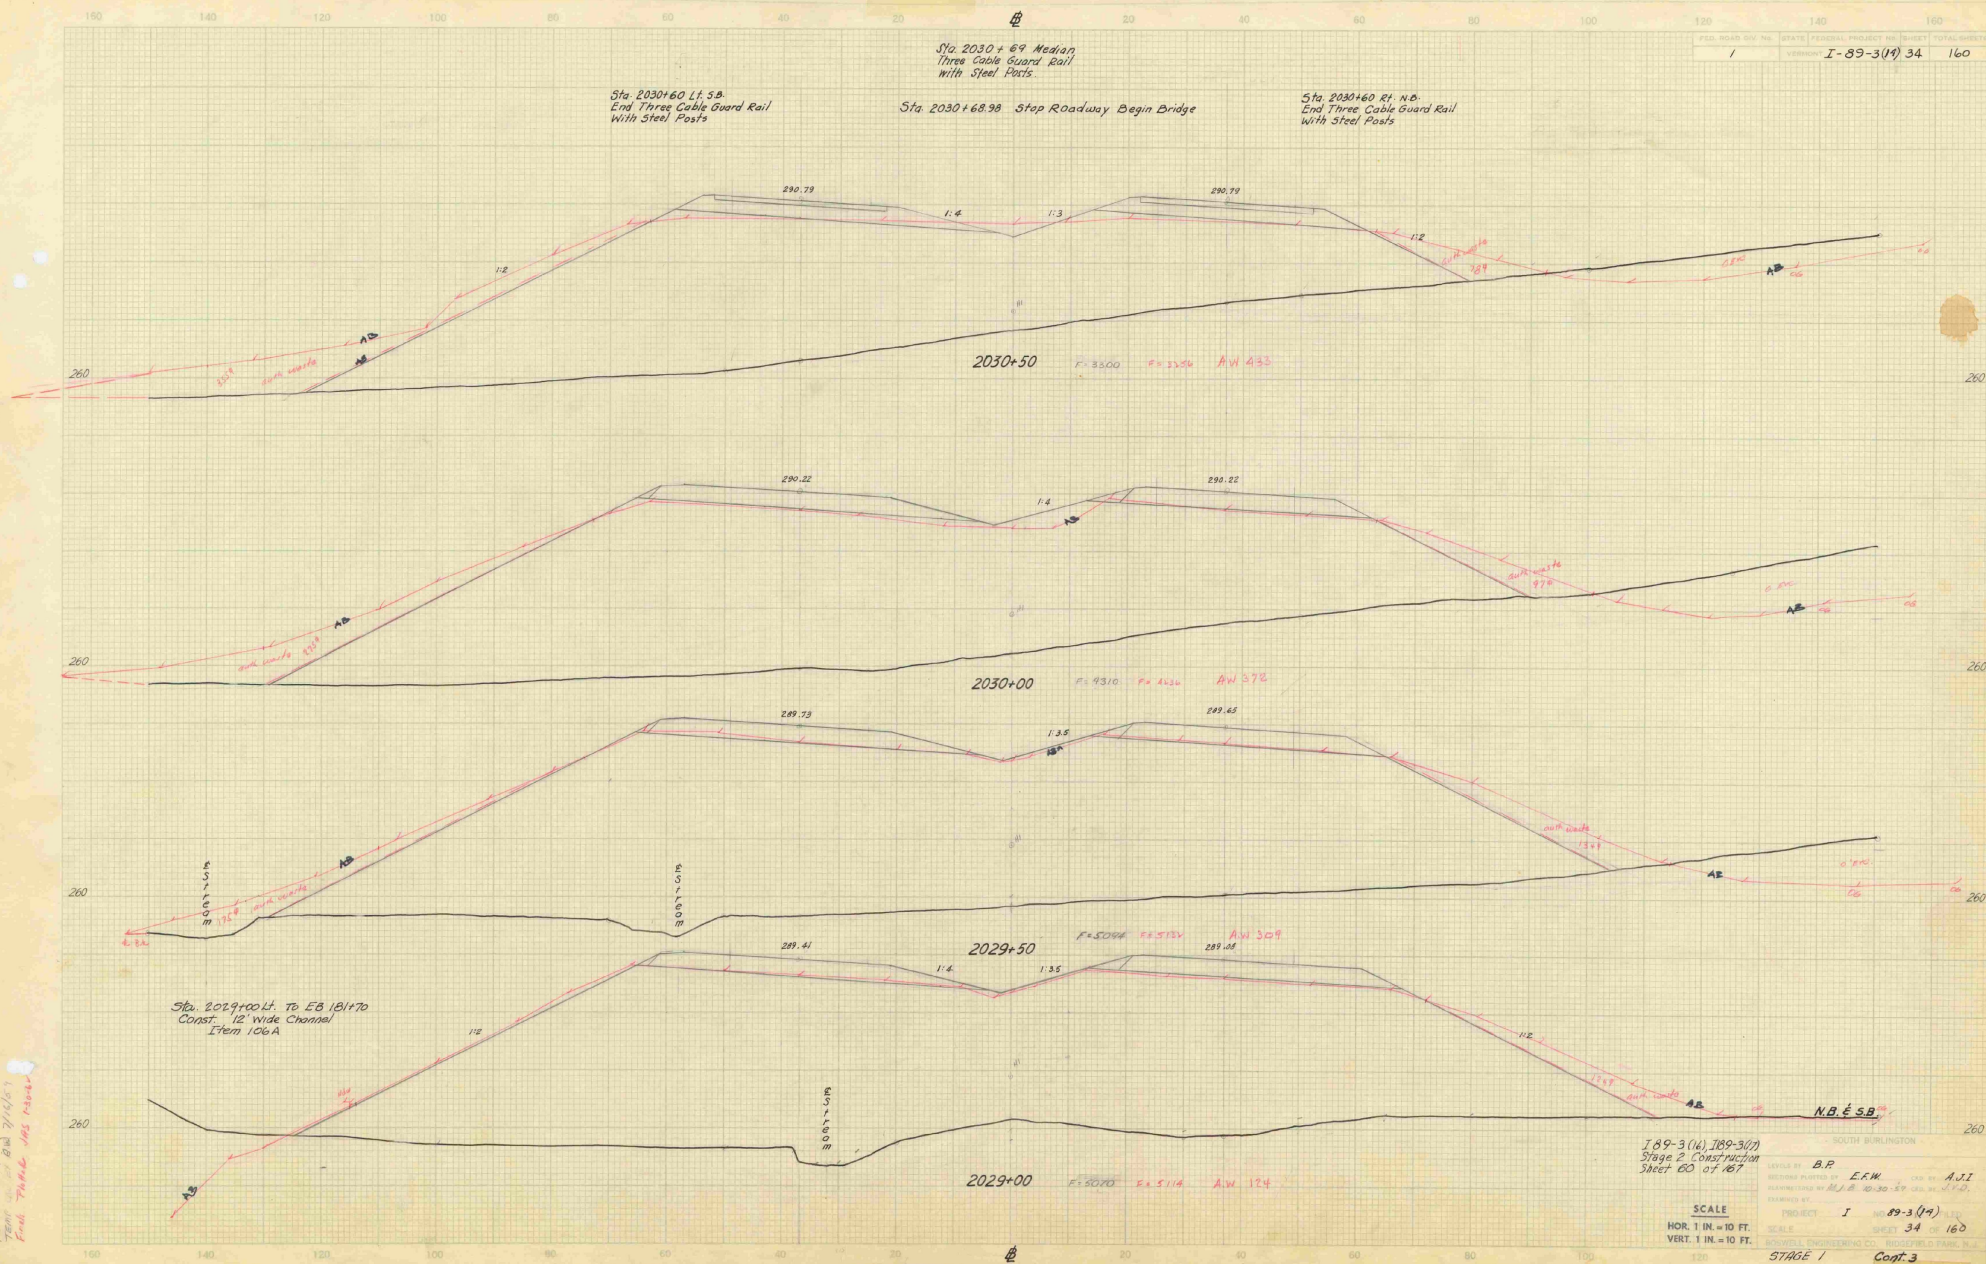

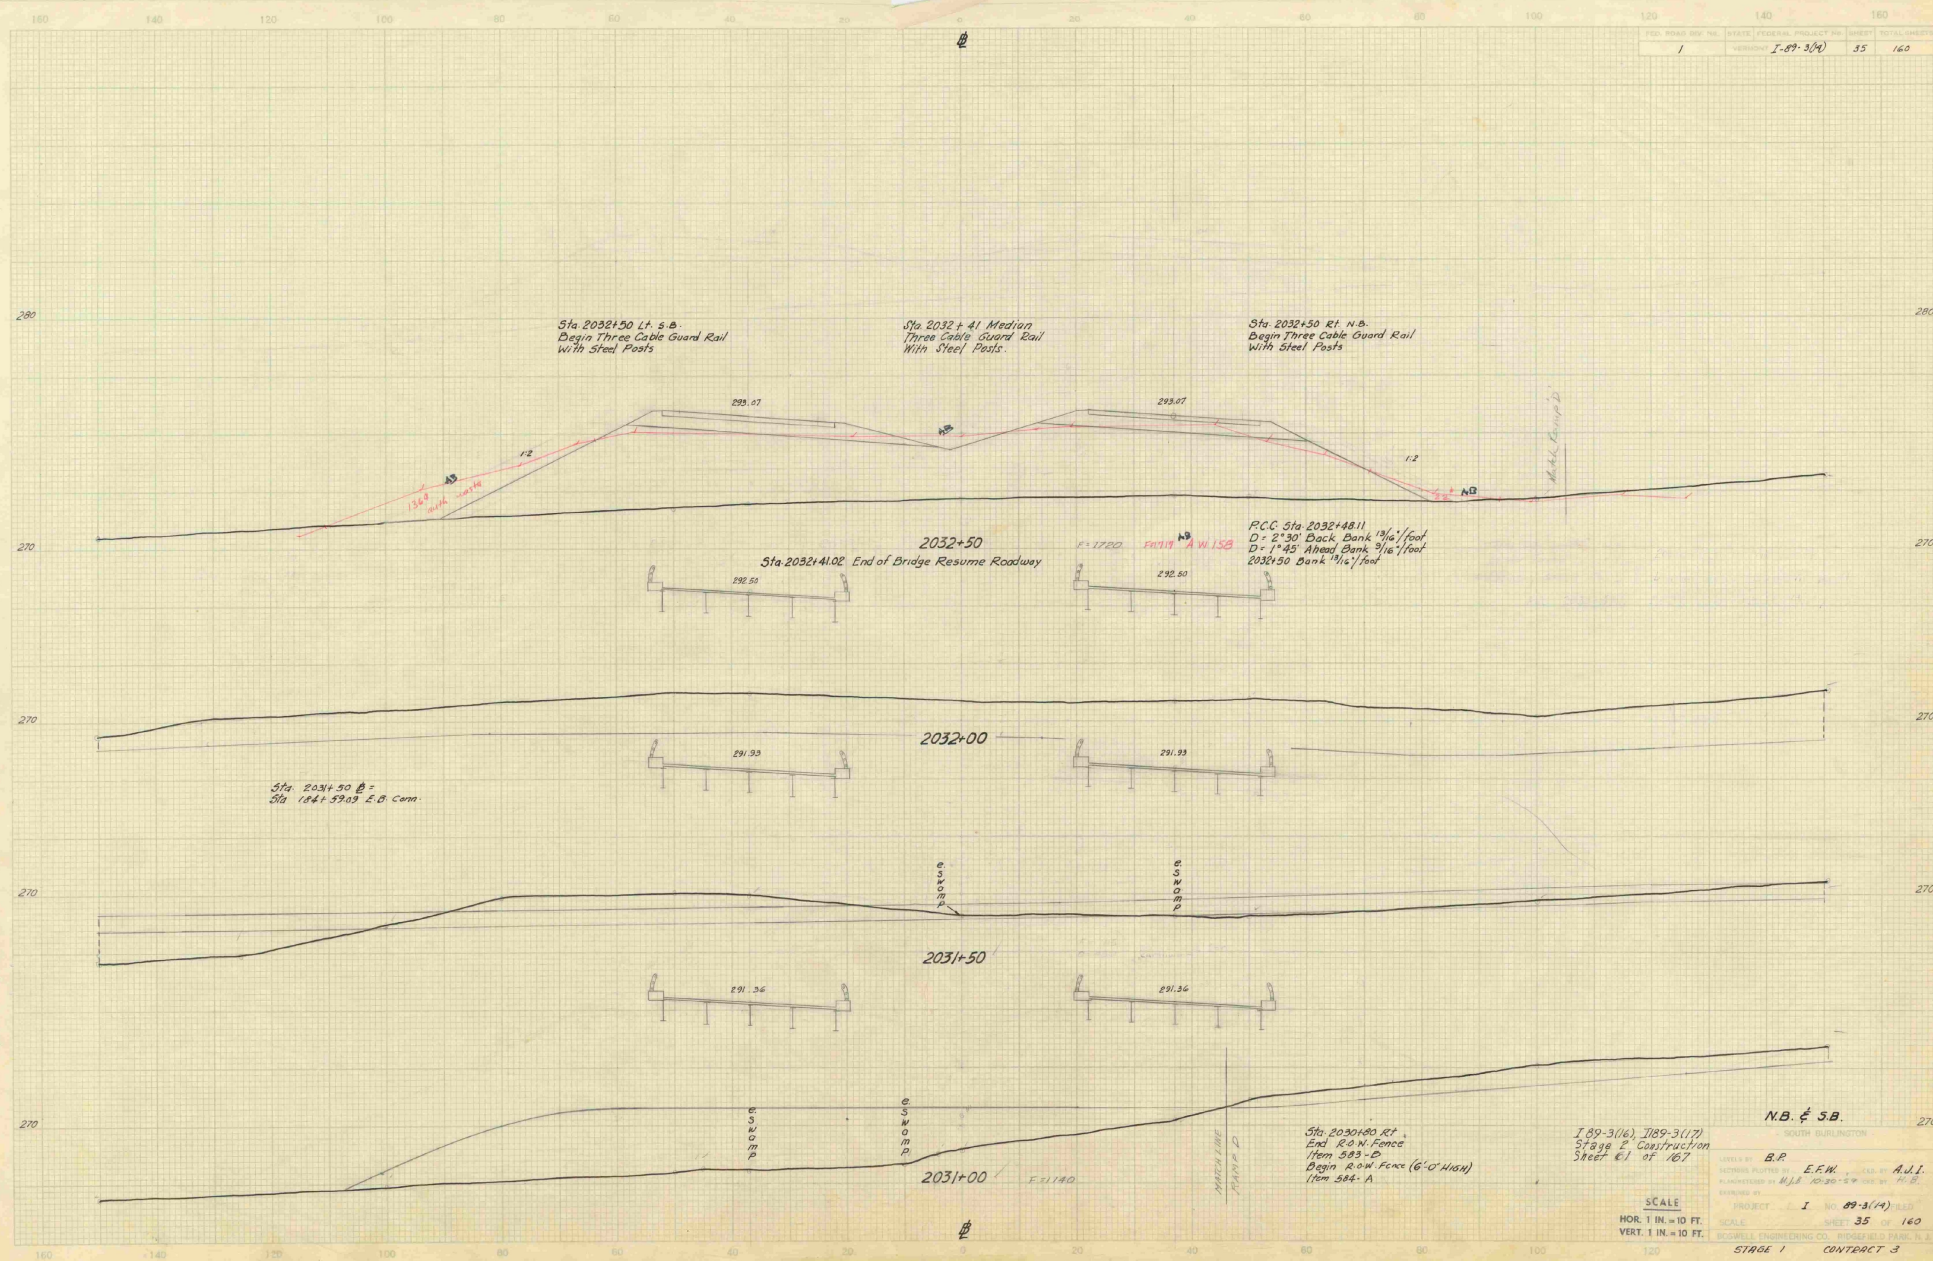

GR Plotted by EFM 6/19/59
AS I 6/1/59 up to 10:22:50
Tense Relax OK GR 7/12/59
Final Plotted MS 1-2-59

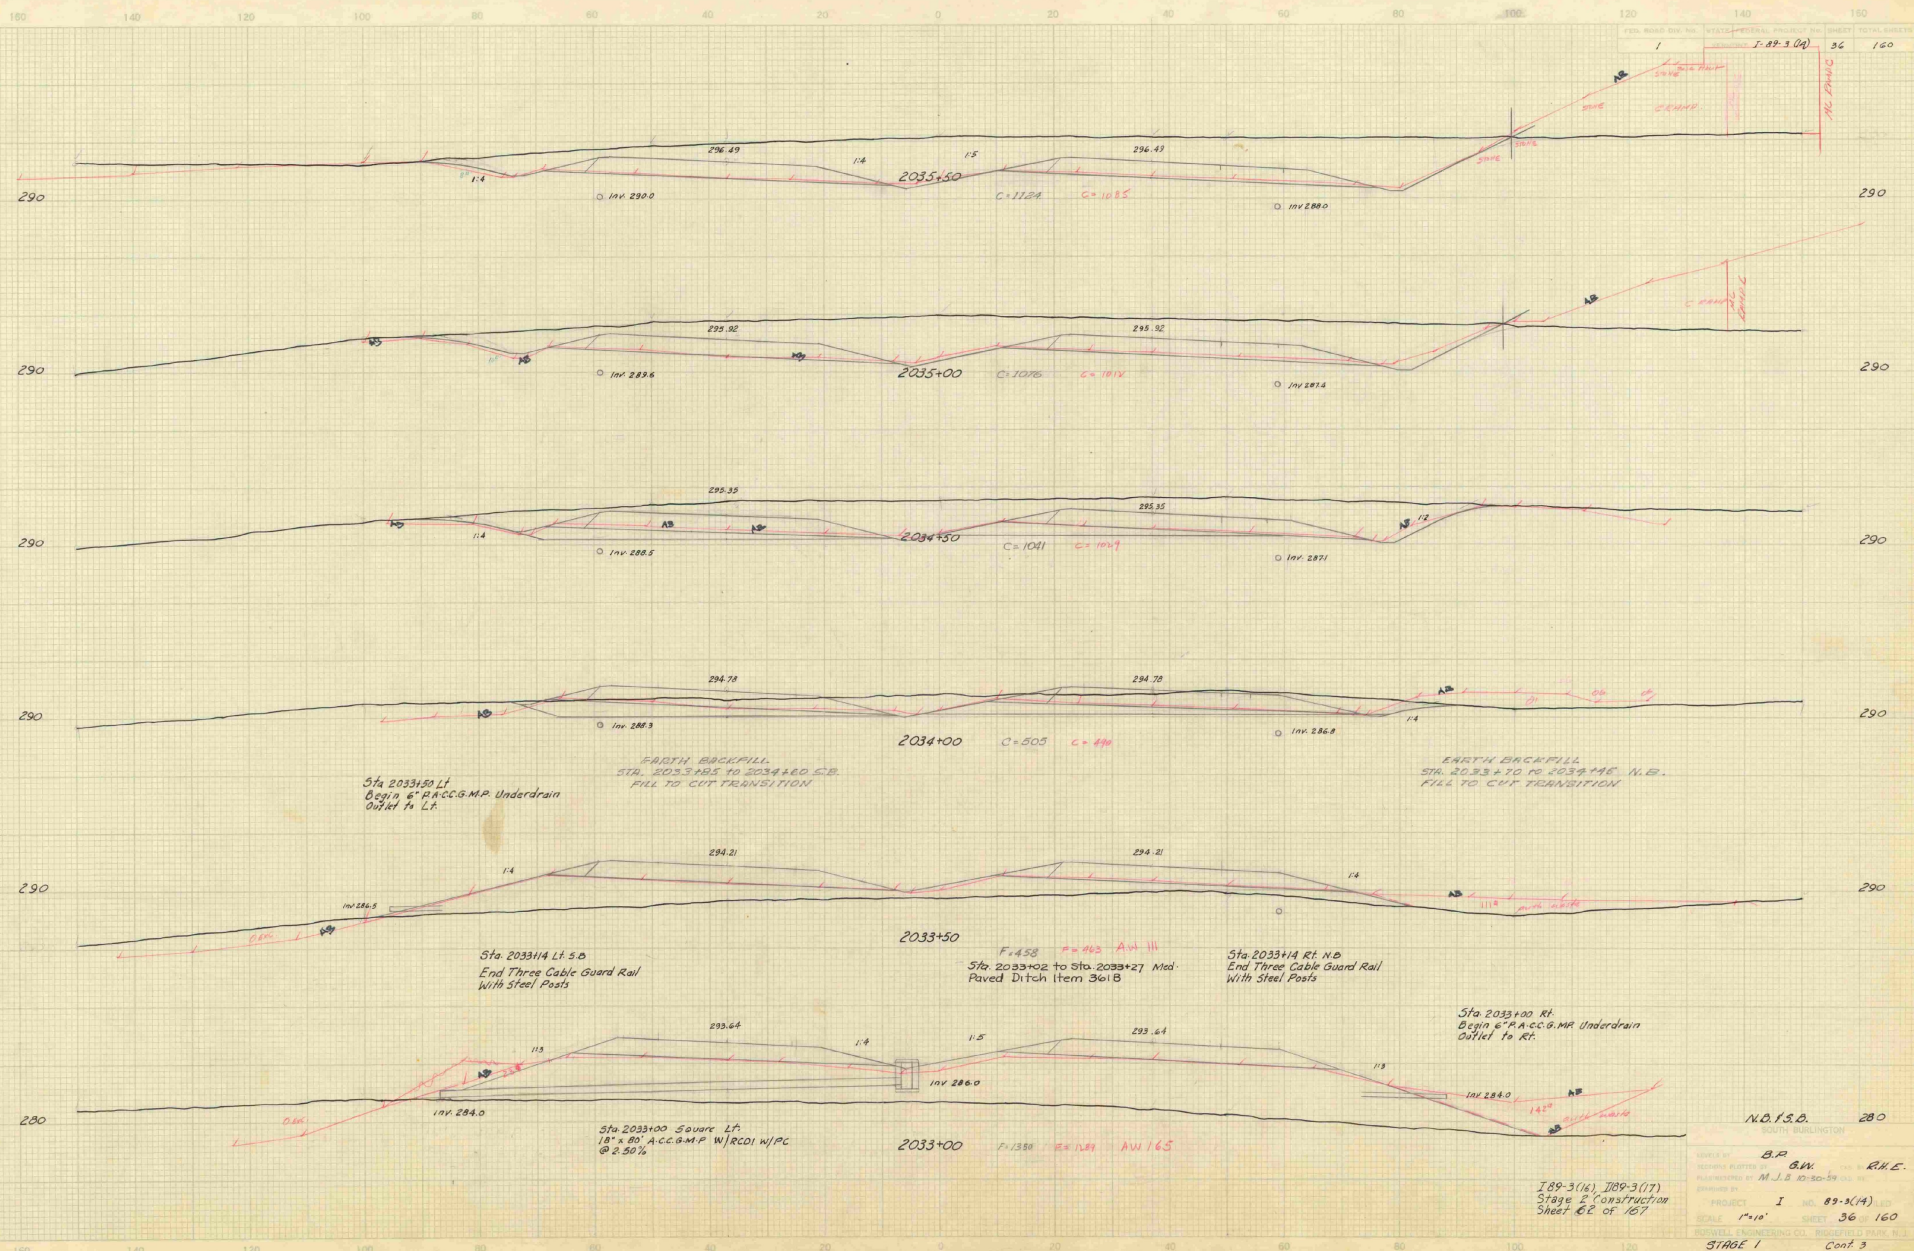


FED. ROAD DIST. NO.	STATE	FED. PROJECT NO.	SHEET	TOTAL SHEETS
1	VT	1-89-3(14)	36	160

N.D.F.S.D. 280
SOUTH BURLINGTON

DATE: 8.1.89
BY: B.W.
CHECKED BY: R.H.C.
PROJECT: 1-89-3(14)
SHEET: 36 OF 160
STAGE 1
CONT. 3


1-89-3(14) 1-89-3(17)
Stage 2 Construction
Sheet 66 of 167

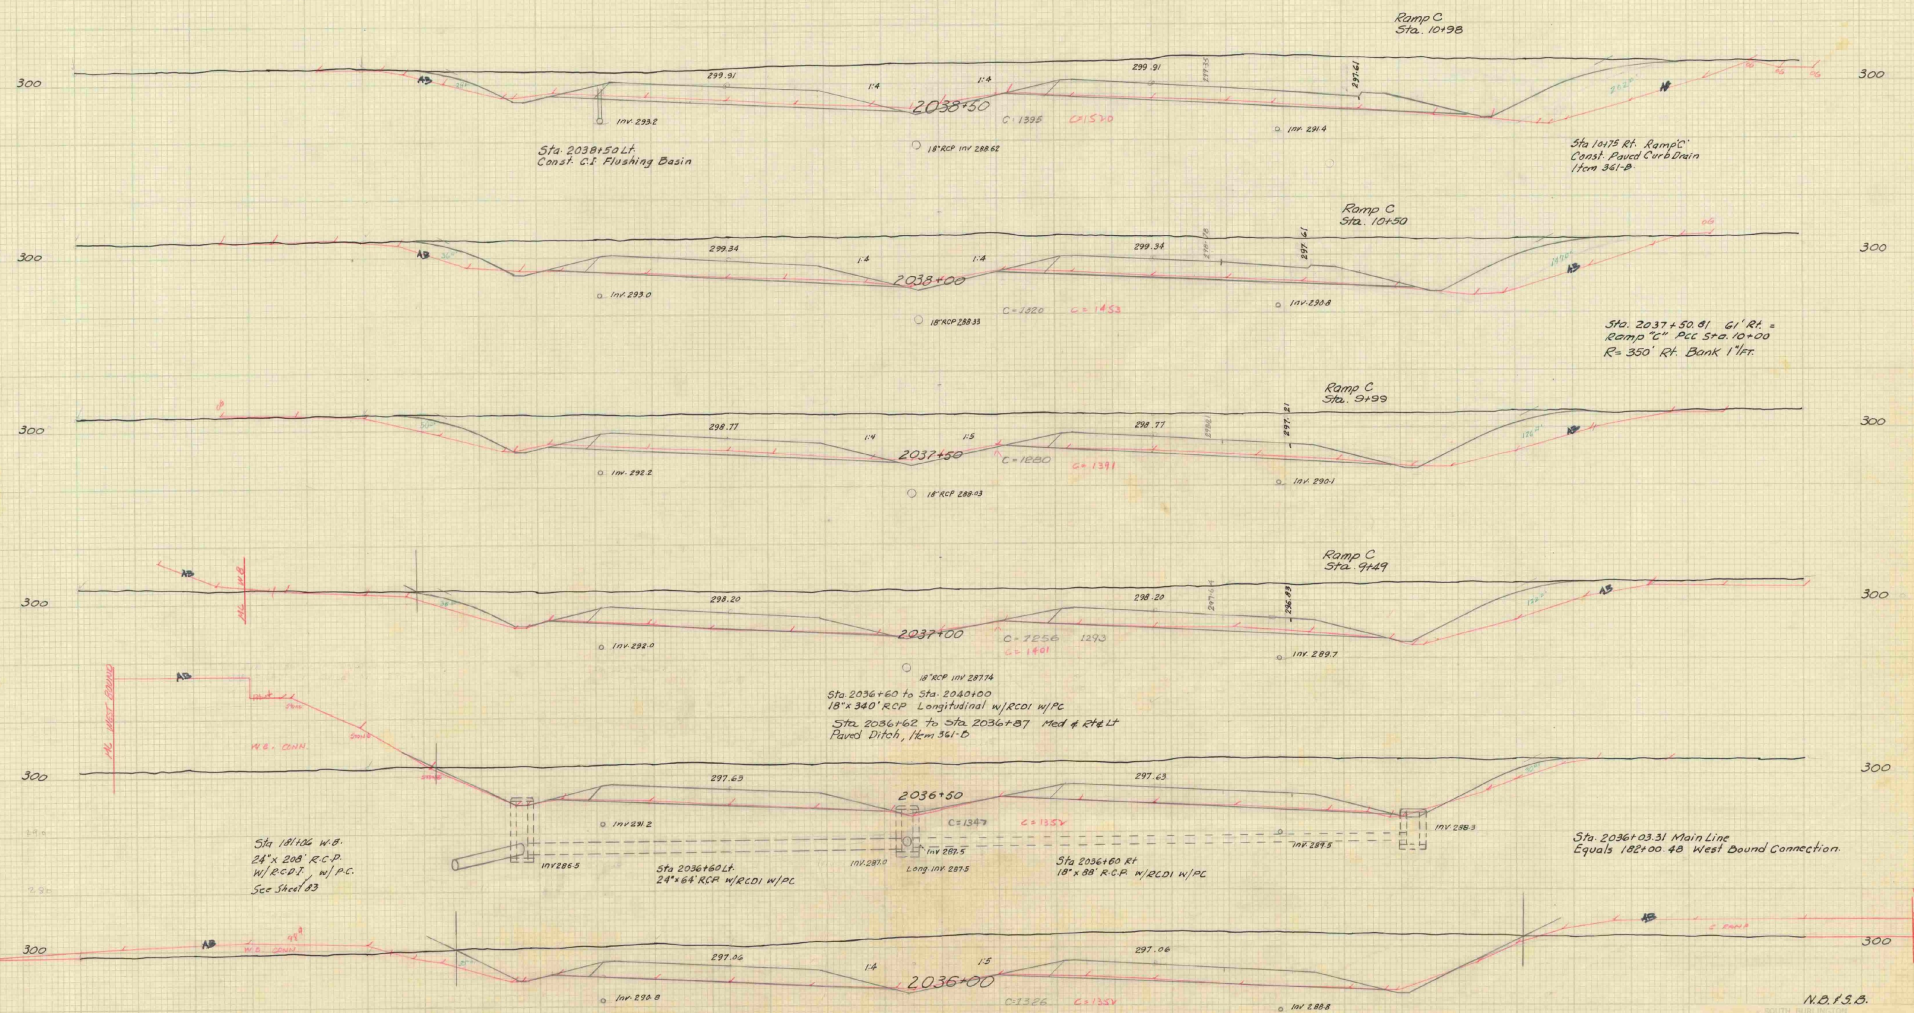

Check notes on sheet 36
Sta. 2036+00 to 2036+50
Time by 2036+50
Pub. note 103
Plan 103
Plan 103


Standard Steel Beam Guard Rail
Sta. 2036+13 to 2037+05 3-0' LT
Sta. 2035+84 to 2036+76 3-0' RT
Sta. 2035+30 to 2036+12 N.B. LT
Sta. 2035+03 to 2035+98 N.D. RT


I-89-3(4) 789-3(7)
Stage 2 Construction
Sheet 33 of 167

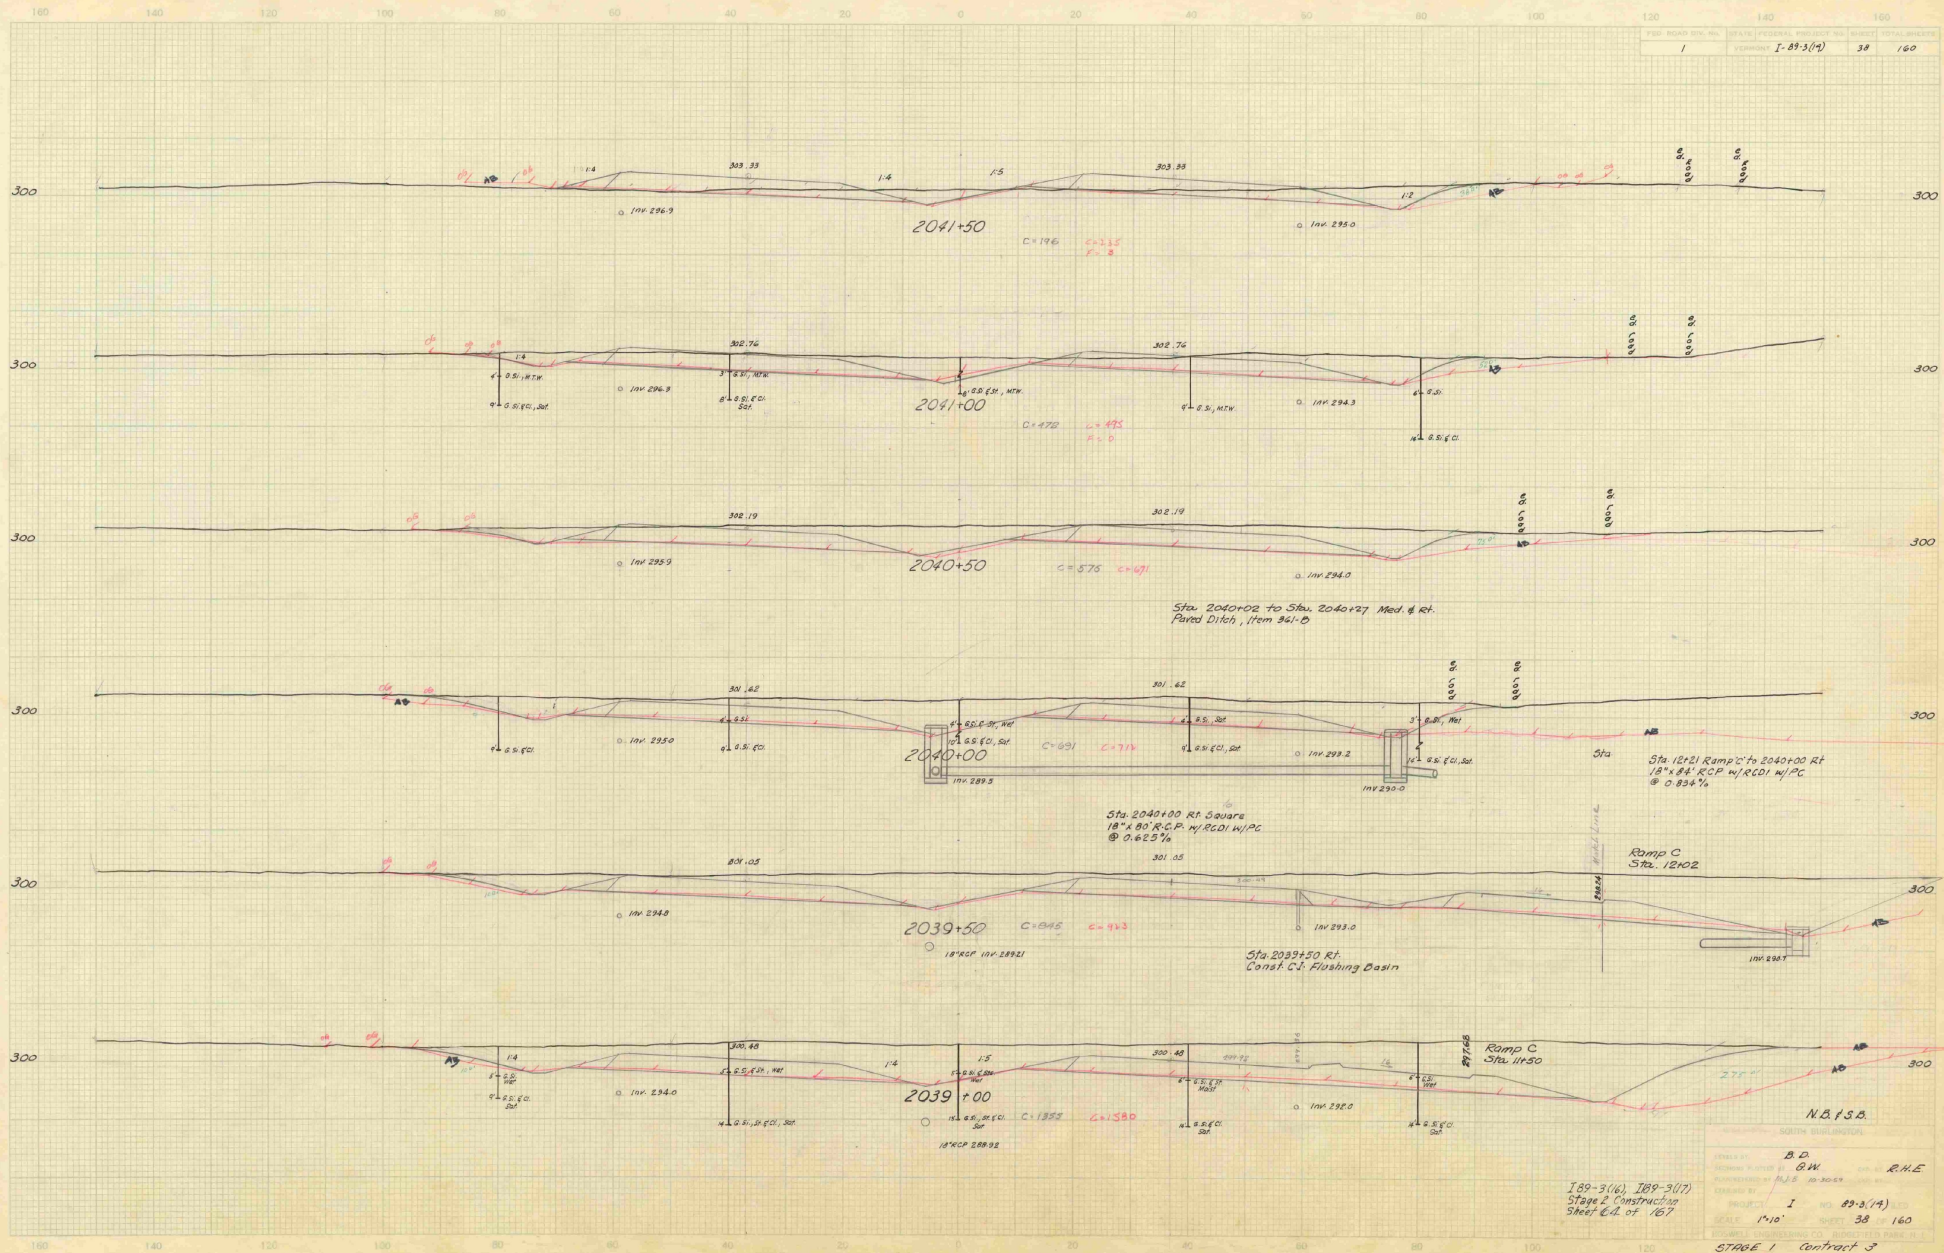


100' 120' 140' 1000'

189-3(14) 189-3(17)
 Stage 2 Construction
 Sheet 38 of 167
 SCALE 1"=10'
 SHEET 38 160
 STAGE 1 Contract 3

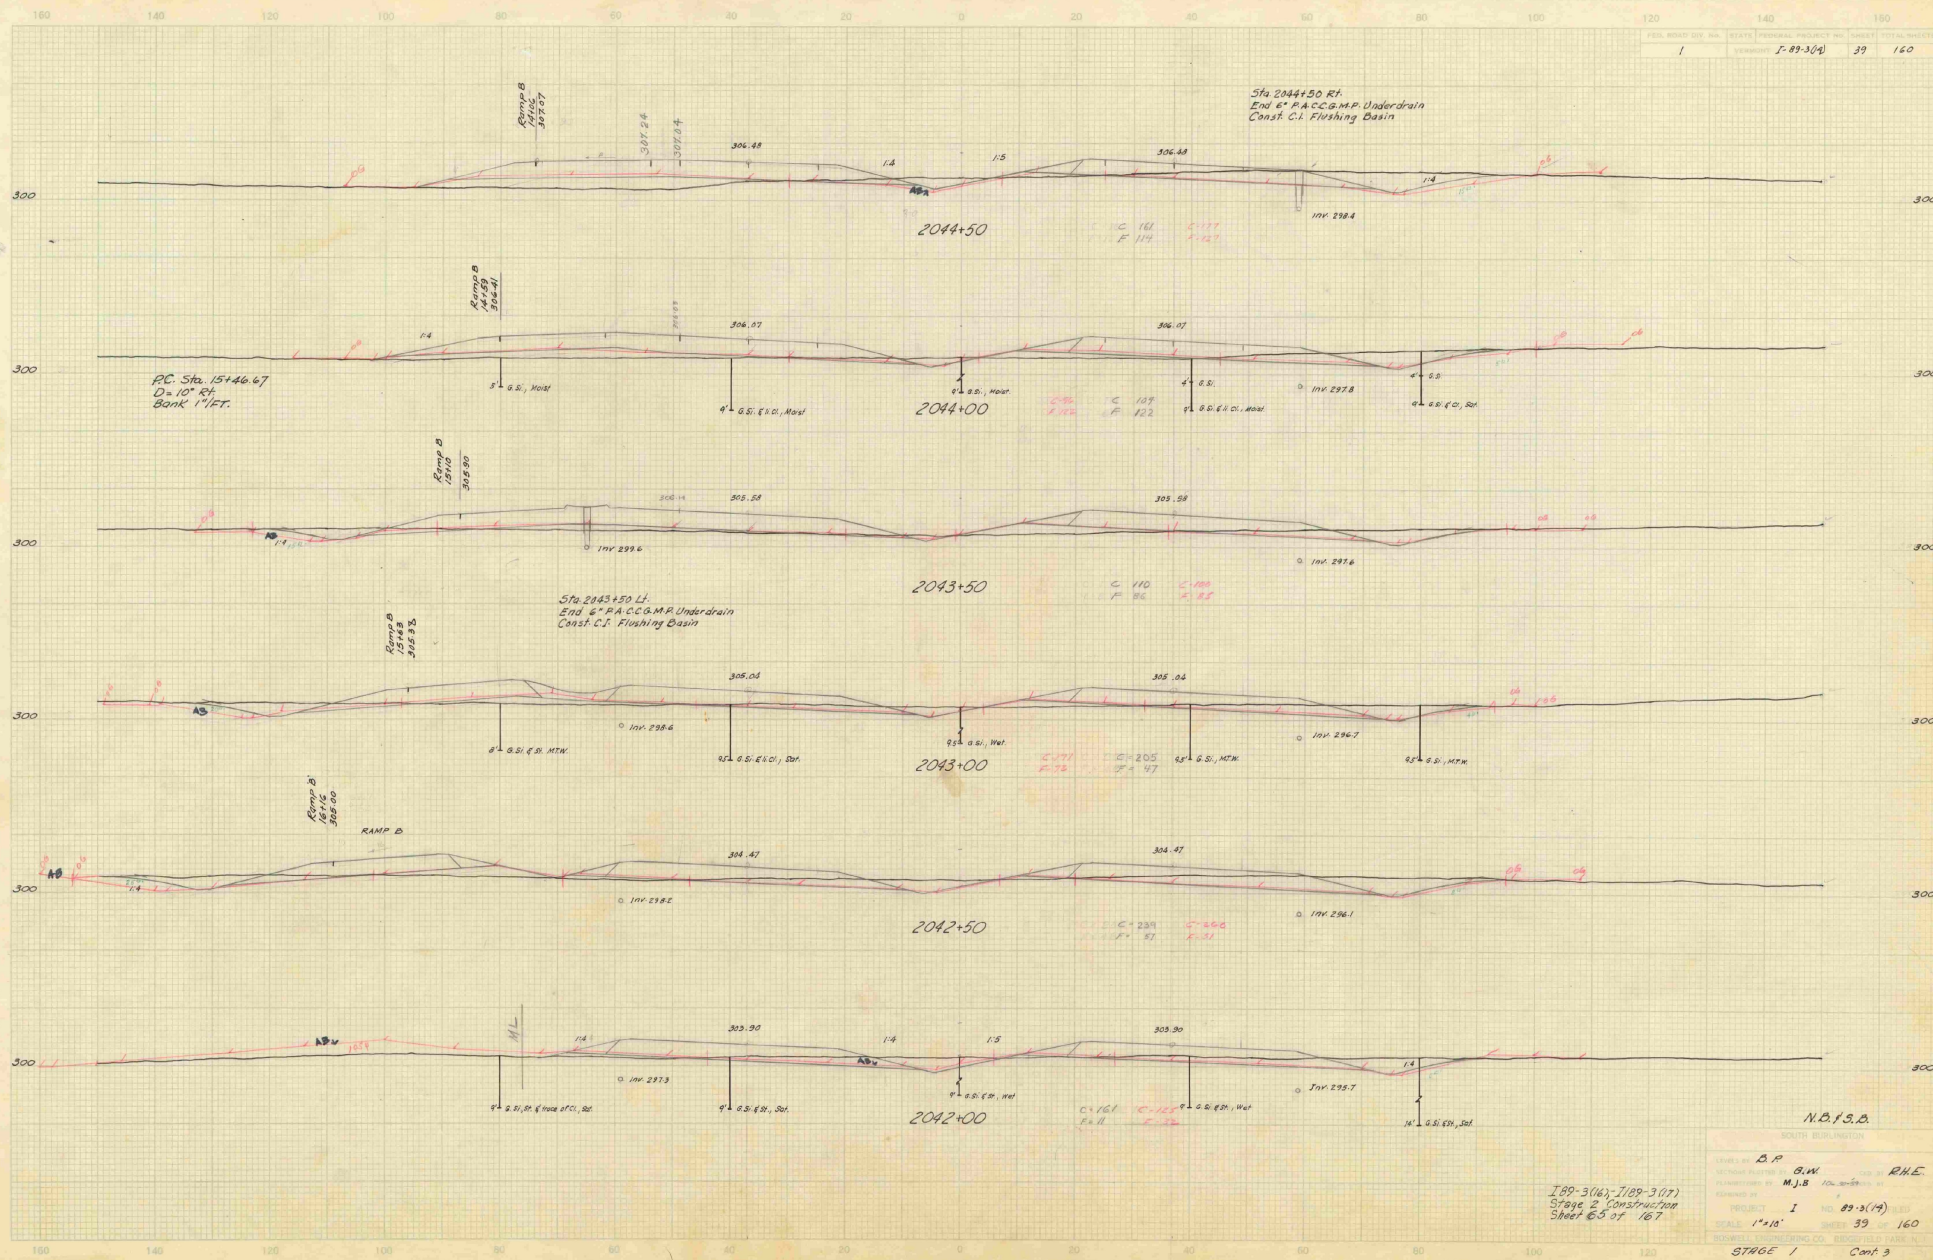

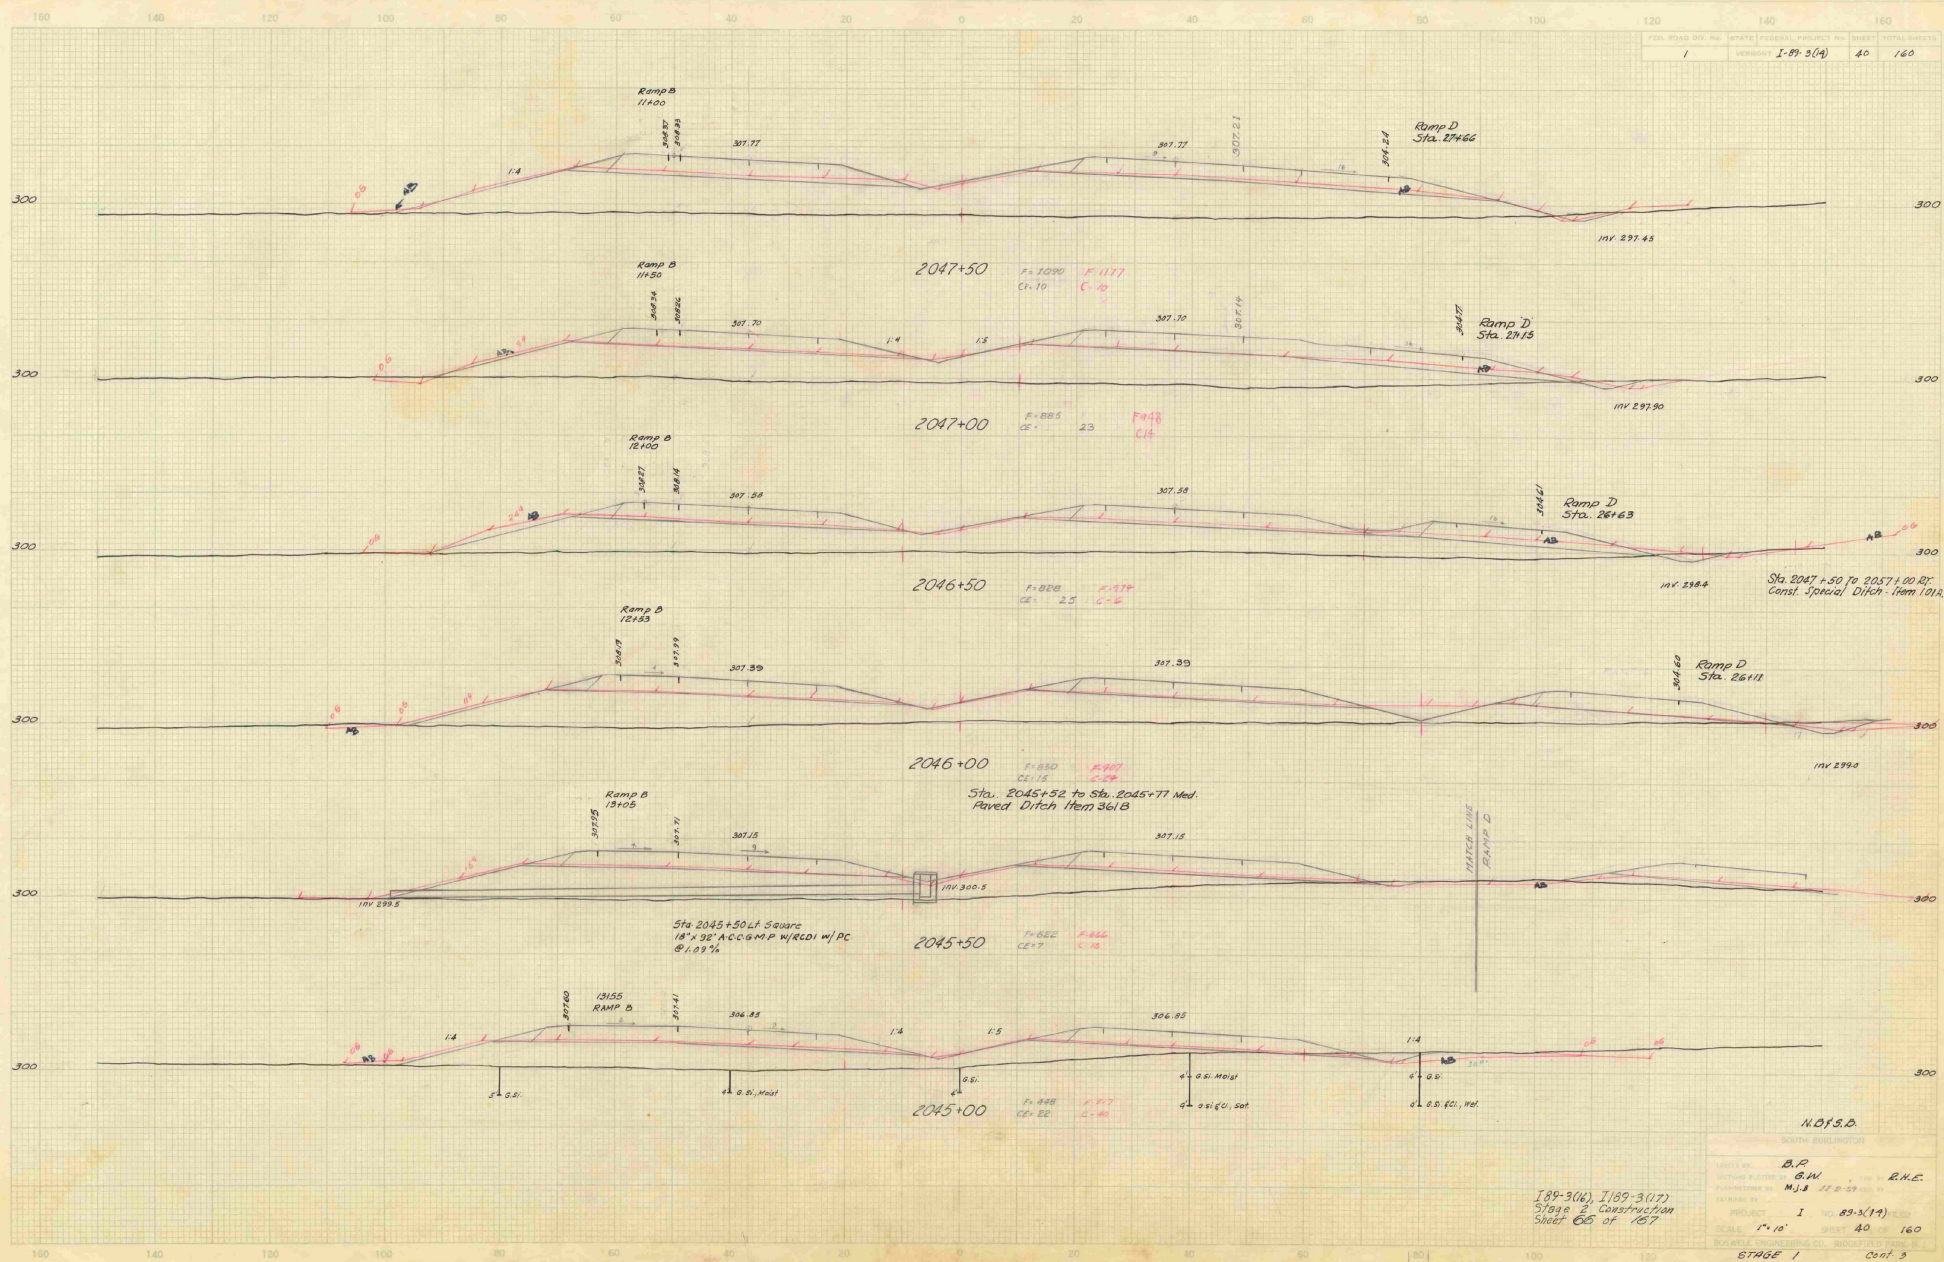

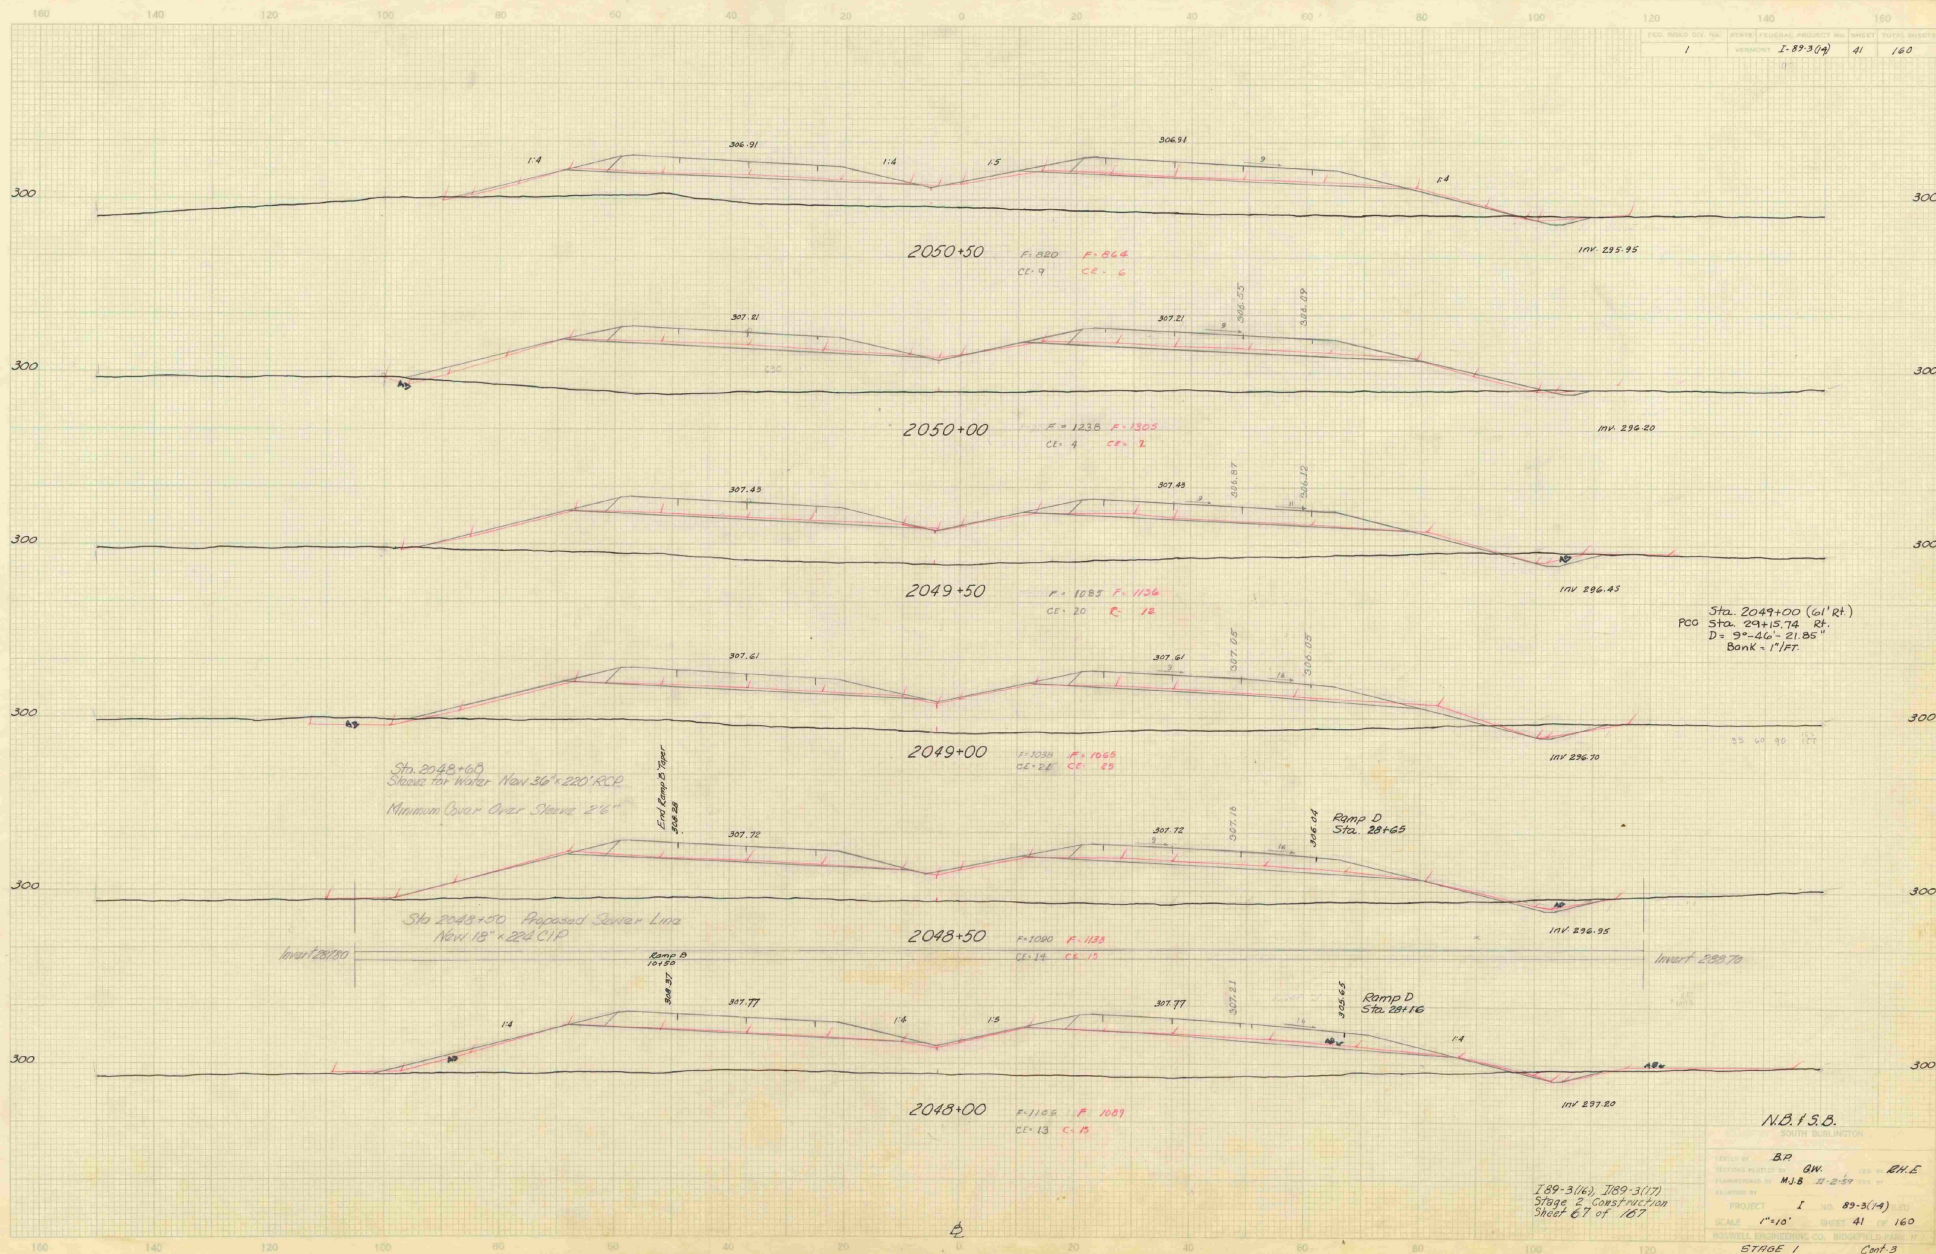


N.B. 15.8.

189-3(1/2), 189-3(1/7)
Stage 2 Construction
Sheet 67 of 167

DESIGNED BY: B.R. OH.
 CHECKED BY: N.J.B. 11-2-59
 PROJECT: I 89-3(1/4)
 SCALE: 1"=10'
 SHEET: 41 OF 160
 STAGE: 1
 Cont-3

OS Profile by G.W. 5-8-53
 CC. Dwyer by G.W. 5-9-53
 Proposed by G.W. 6-17-53

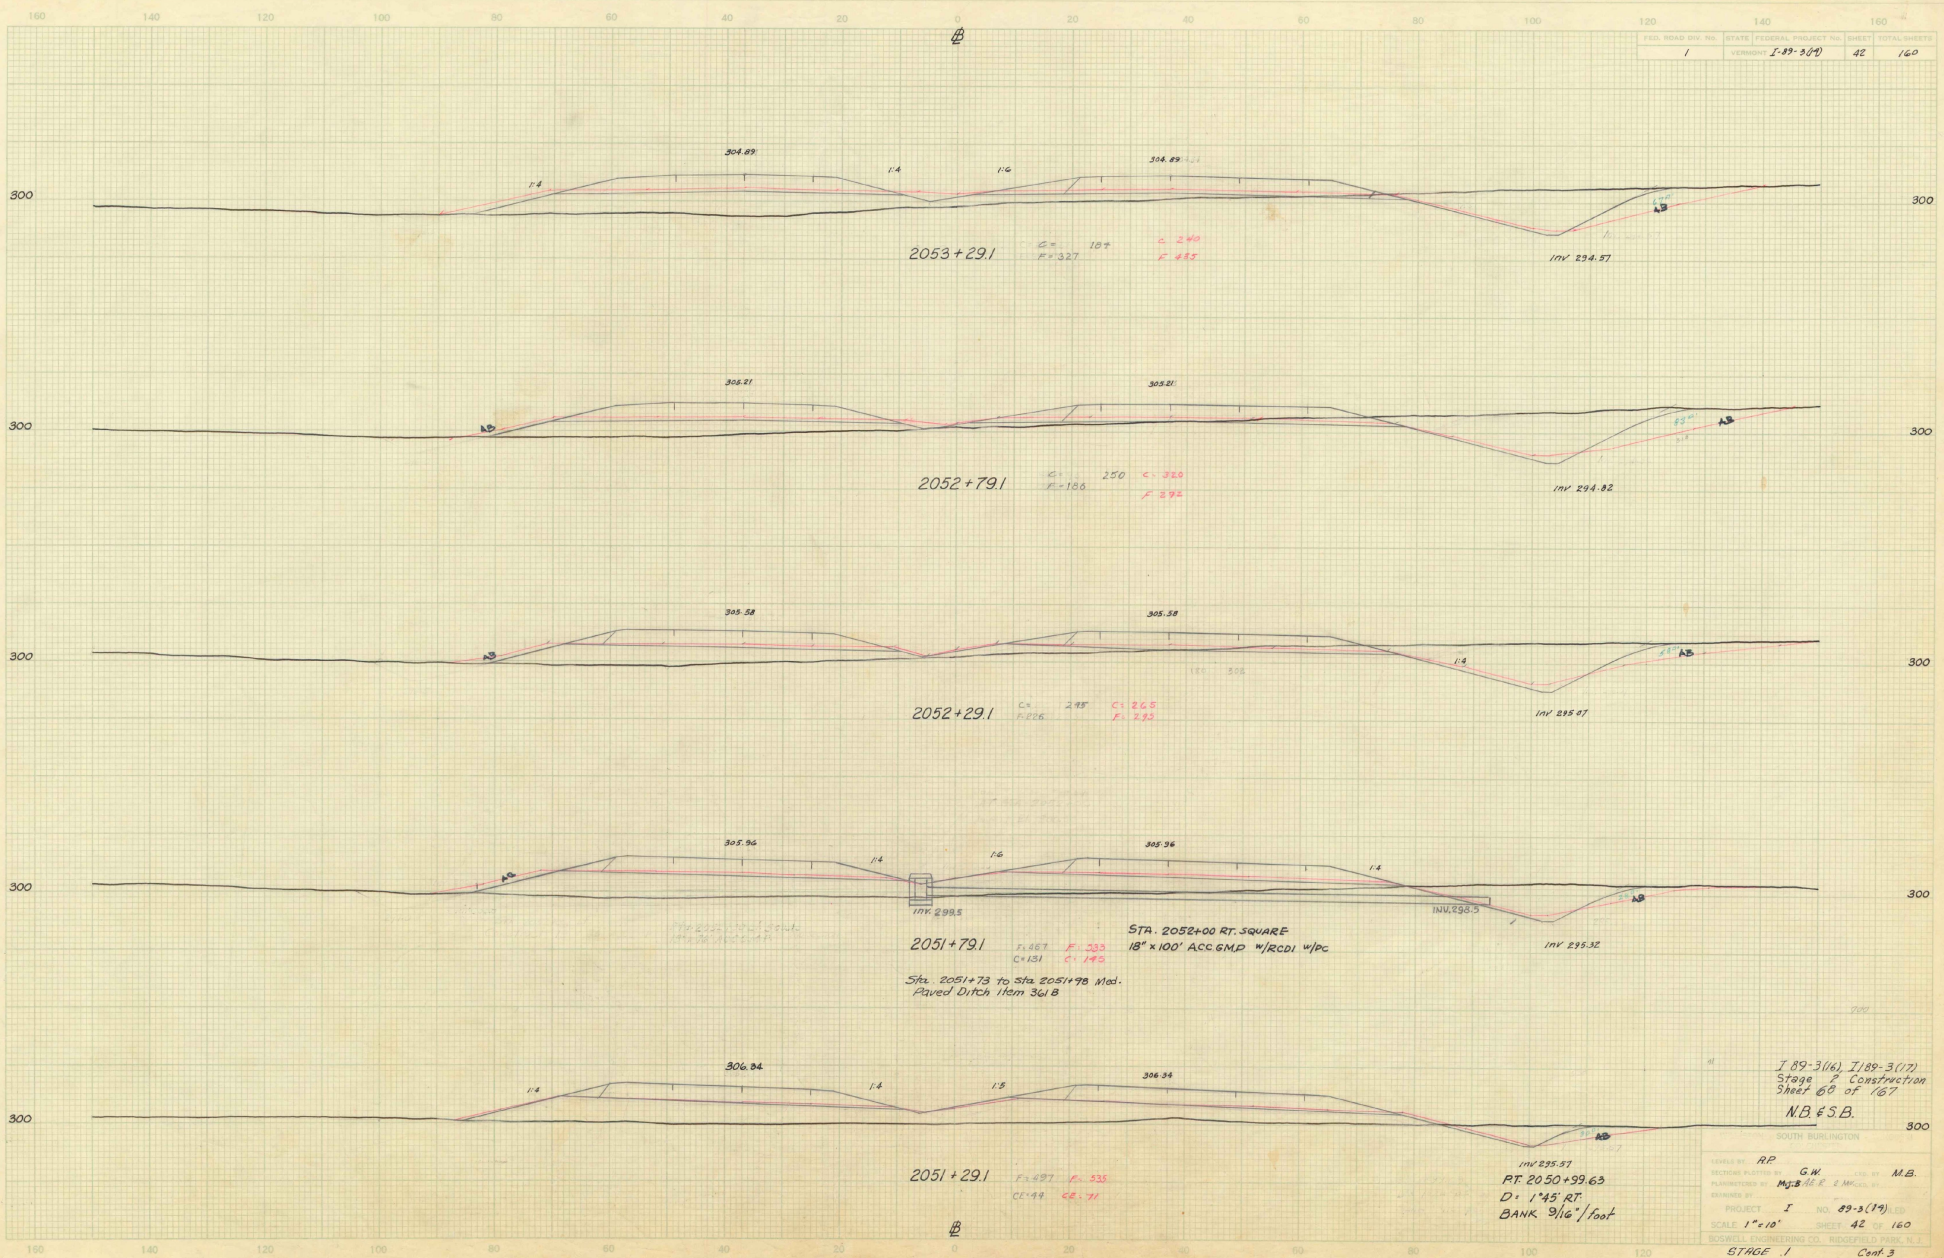


FEED ROAD DIST. NO.	STATE	FEED ROAD DIST. NO.	SHEET	TOTAL SHEETS
1	VERMONT	1-89-3(16)	42	160

I 89-3(16), I 89-3(17)
 Stage 2 Construction
 Sheet 42 of 167
 NB & SB.

DESIGNED BY: RP
 CHECKED BY: G.W.
 DRAWN BY: M.B.
 PROJECT: I 89-3(16)
 SCALE: 1"=10'
 SHEET: 42 of 160
 STAGE: 1
 Conf: 3

C.G. Plotter by G.W. 6/29/53
 O.G. Cont. by M.J.B. 6/29/53

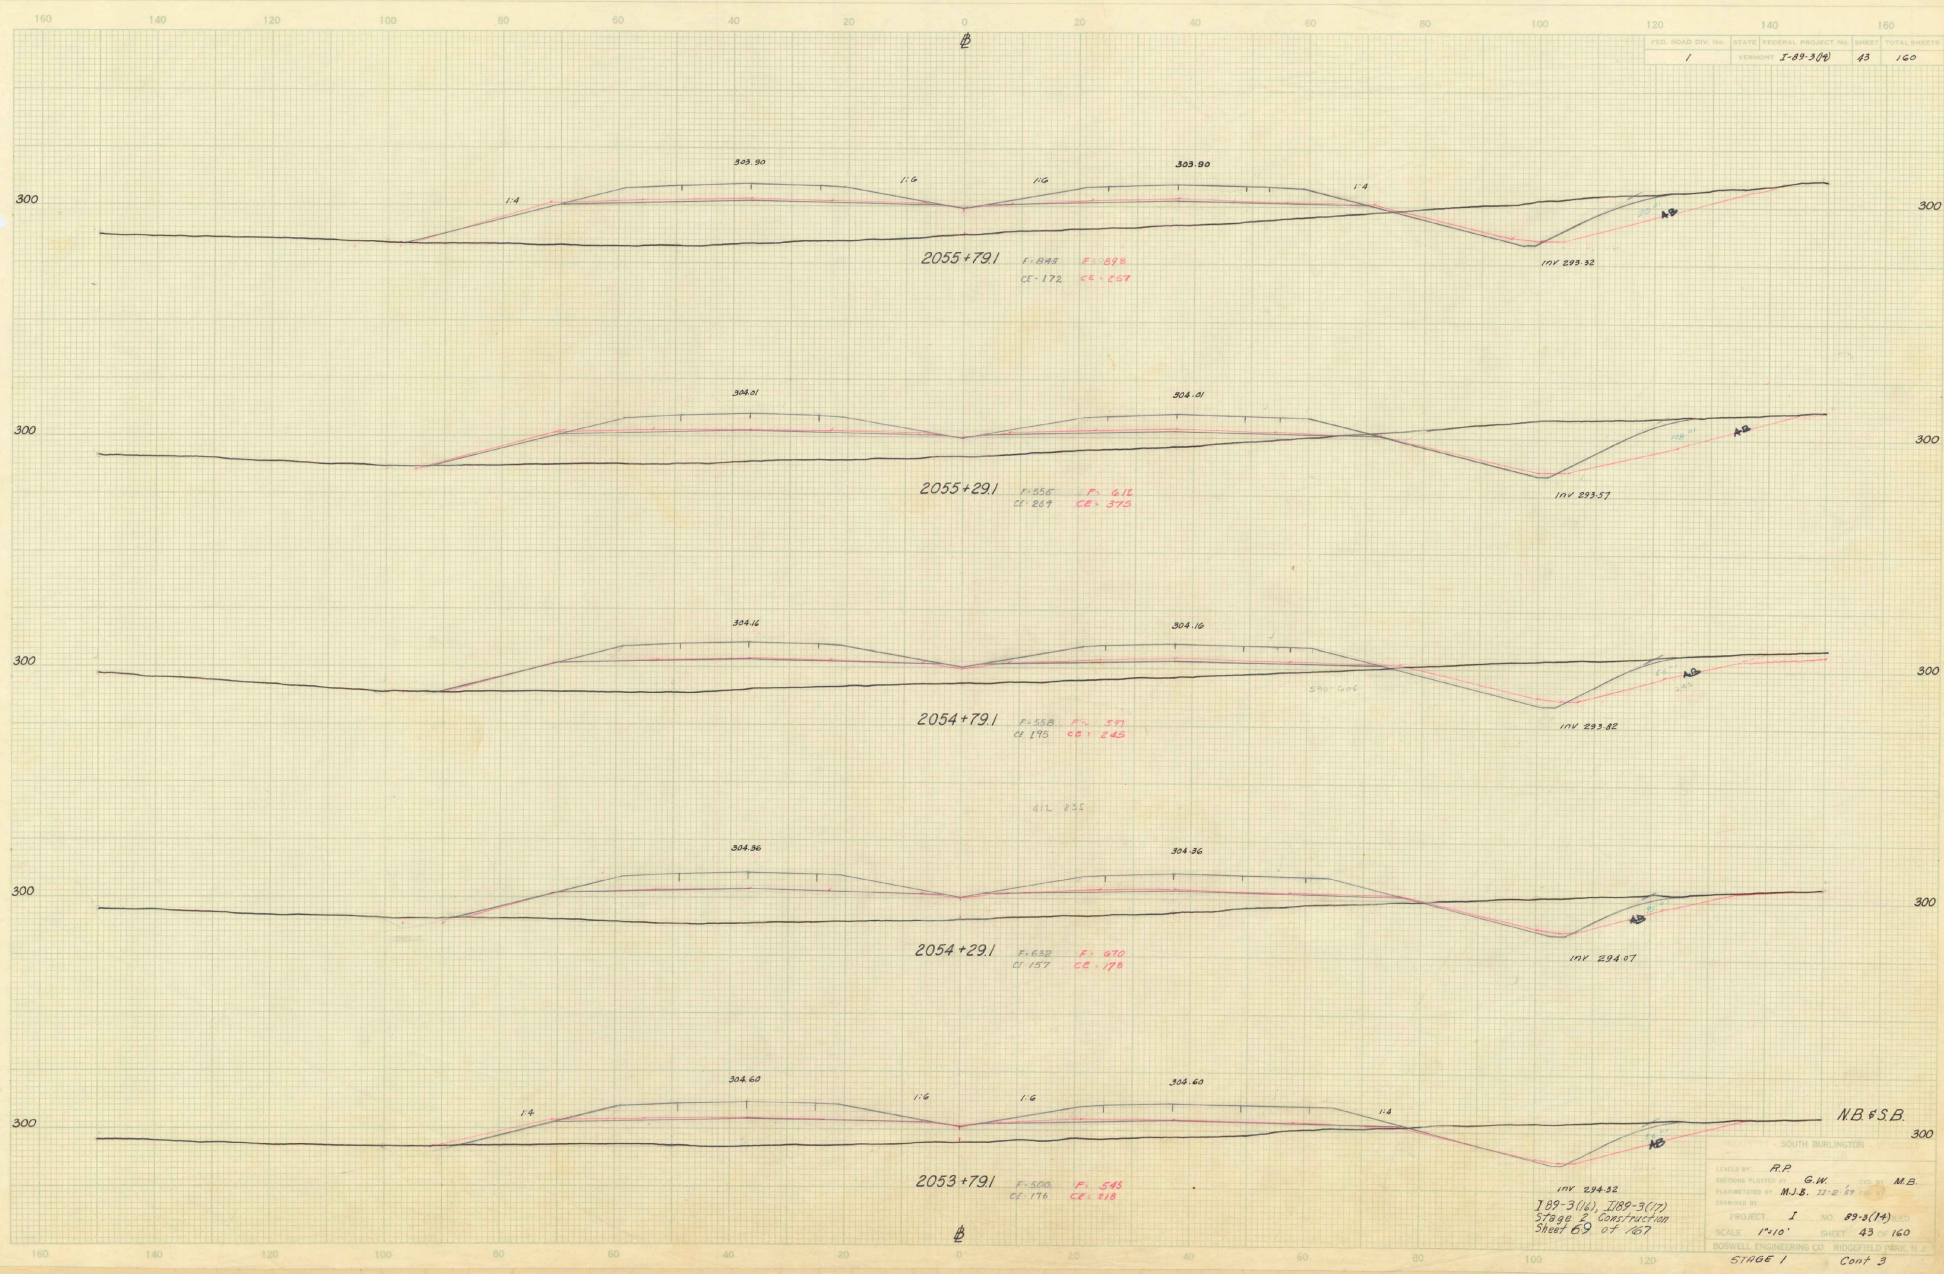

FED. ROAD DIV. NO.	STATE	FEDERAL PROJECT NO.	SHEET	TOTAL SHEETS
1	VERMONT	I-89-3(7)	43	160

STAGE 1 Cont 3


189-3(14), 189-3(7)
 Stage 2 Construction
 Sheet 69 of 167

NO. 29-3(14)

SCALE 1"=10'


BORWELL ENGINEERING CO. BOSTON, MASS.

FED. ROAD DIST. NO.	STATE	FEDERAL PROJECT NO.	SHEET TOTAL SHEETS
1	VERMONT	F-89-3(7)	44 160

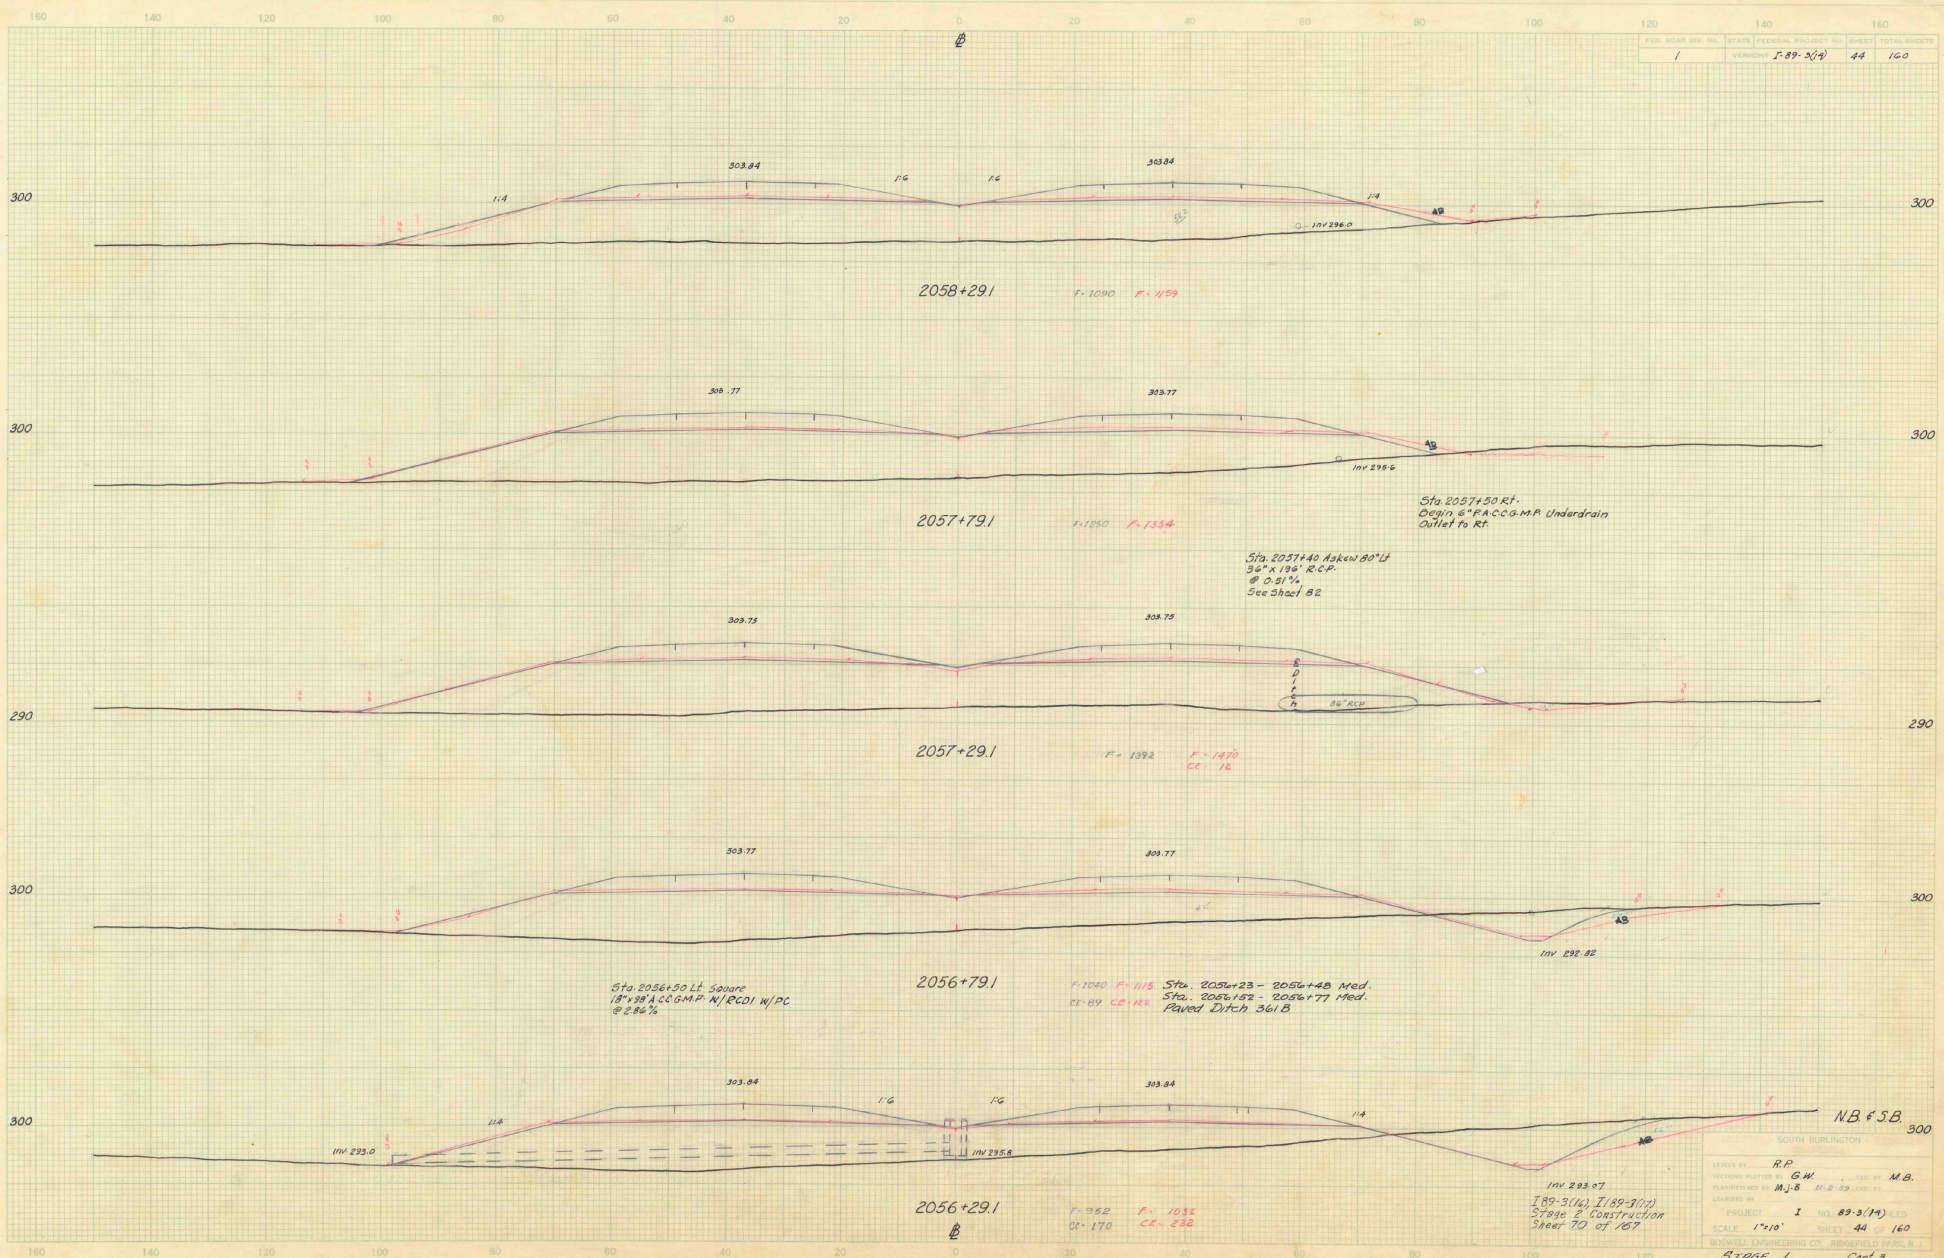

OG Plotted by G.W. 8/9/53
by M.H. 8/9/53
O.G. C-42

SOUTH BURLINGTON
DESIGNED BY: R.P.
CHECKED BY: G.H.
DRAWN BY: M.J.B.
PROJECT: I NO. 89-3(7)
SCALE: 1"=10' SHEET: 44 OF 160
BOSWELL ENGINEERING CO. BANGOR, ME
STAGE 1 Cont 3

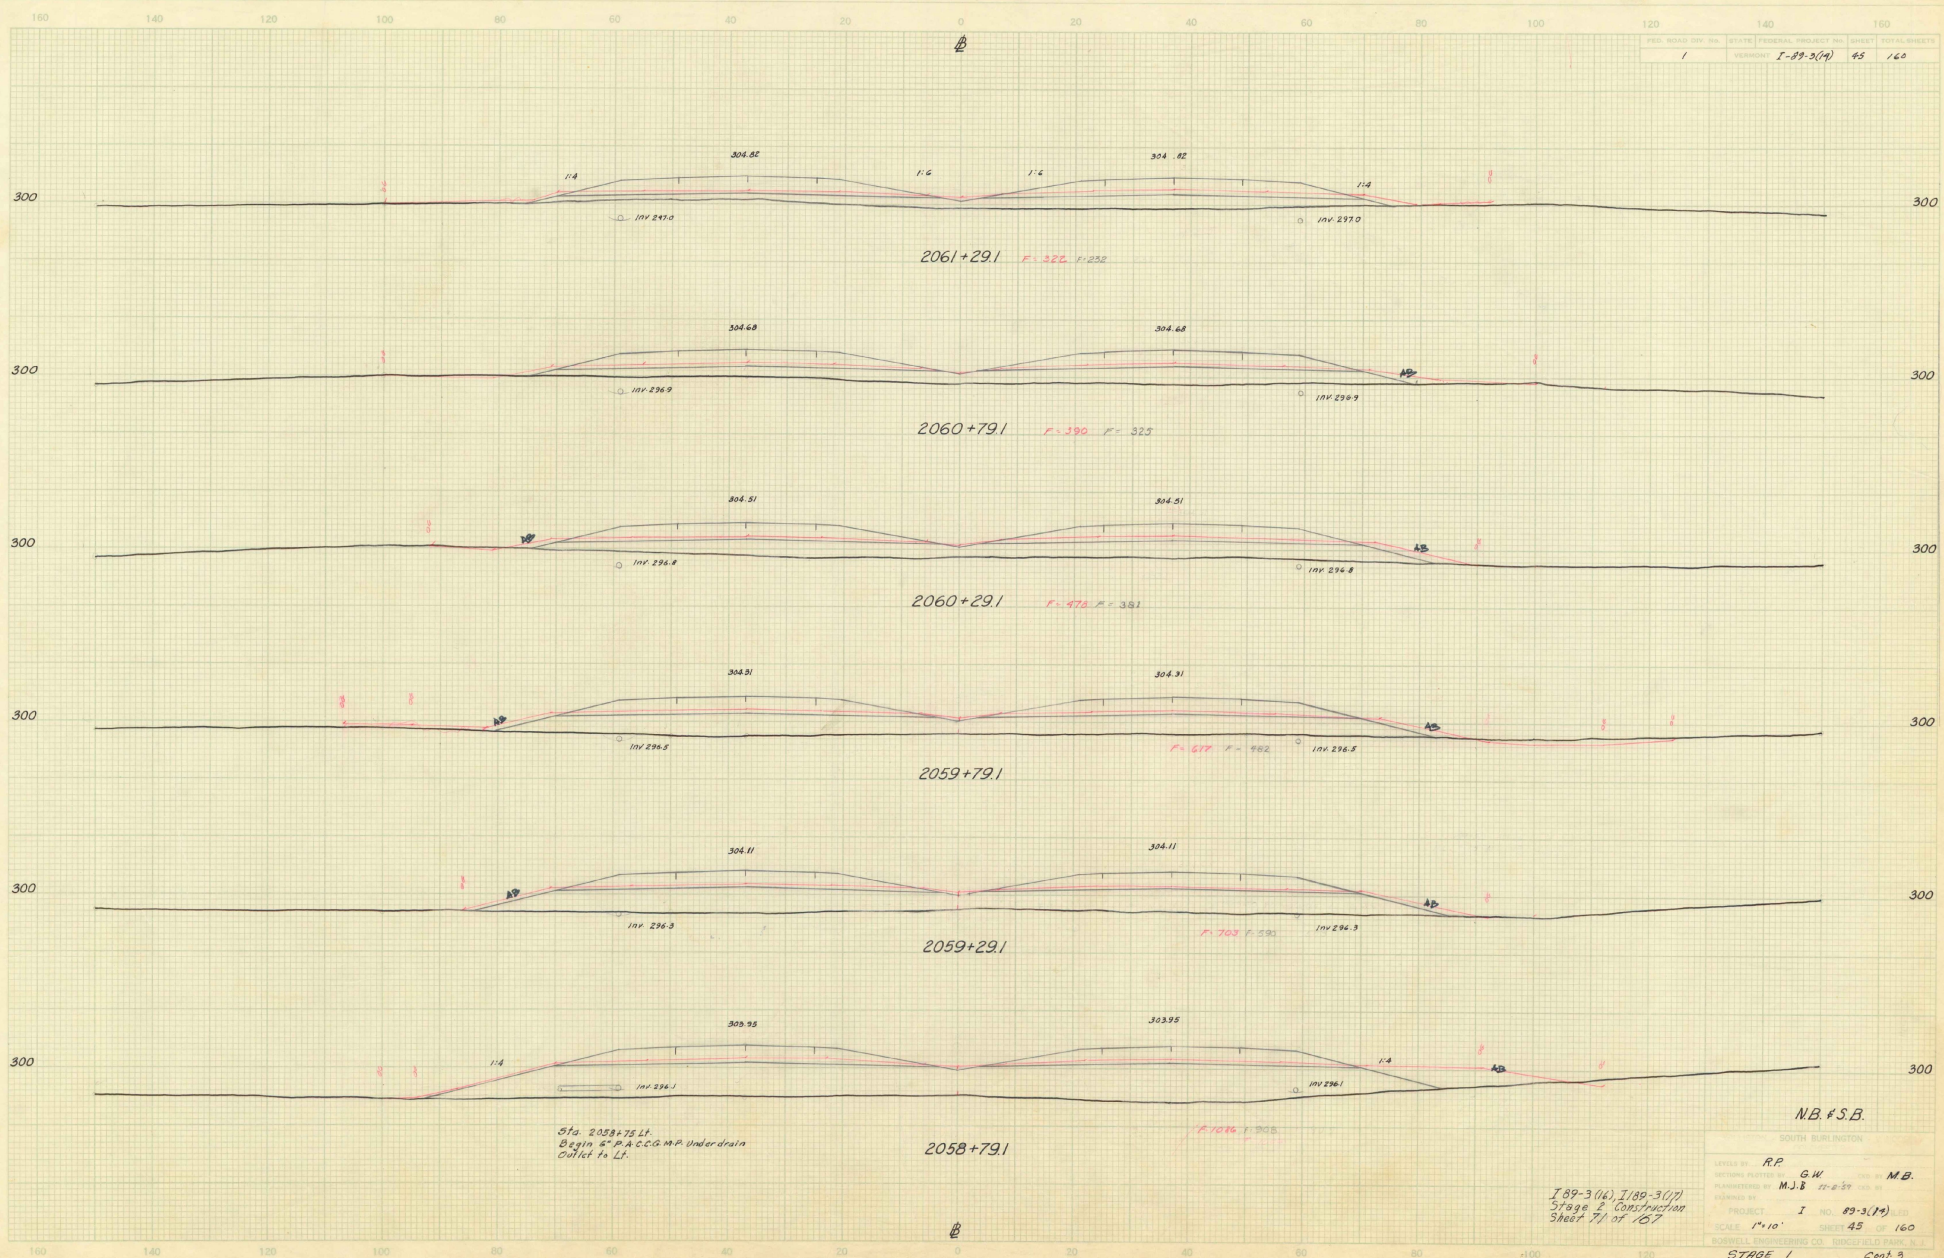

Sta. 2058+75 LT.
Begin 6" P.A.C.C. M.P. Underdrain
Collect to LT.


NB. & S.B.

I 89-3 (14), I 89-3 (17)
Stage 1, Construction
Sheet 71 of 107

OG Plotted by G.W. 6-8-59
OG Cont. by M.J.B. 6-9-59


Sta. 2067+50 A&R 69' LT.
18" x 88' R.C.P. W/RCOI W/PC
@ 114%

Sta. 2067+50 to Sta. 2067+88 Med.
Paved Ditch 17ftm 36/8

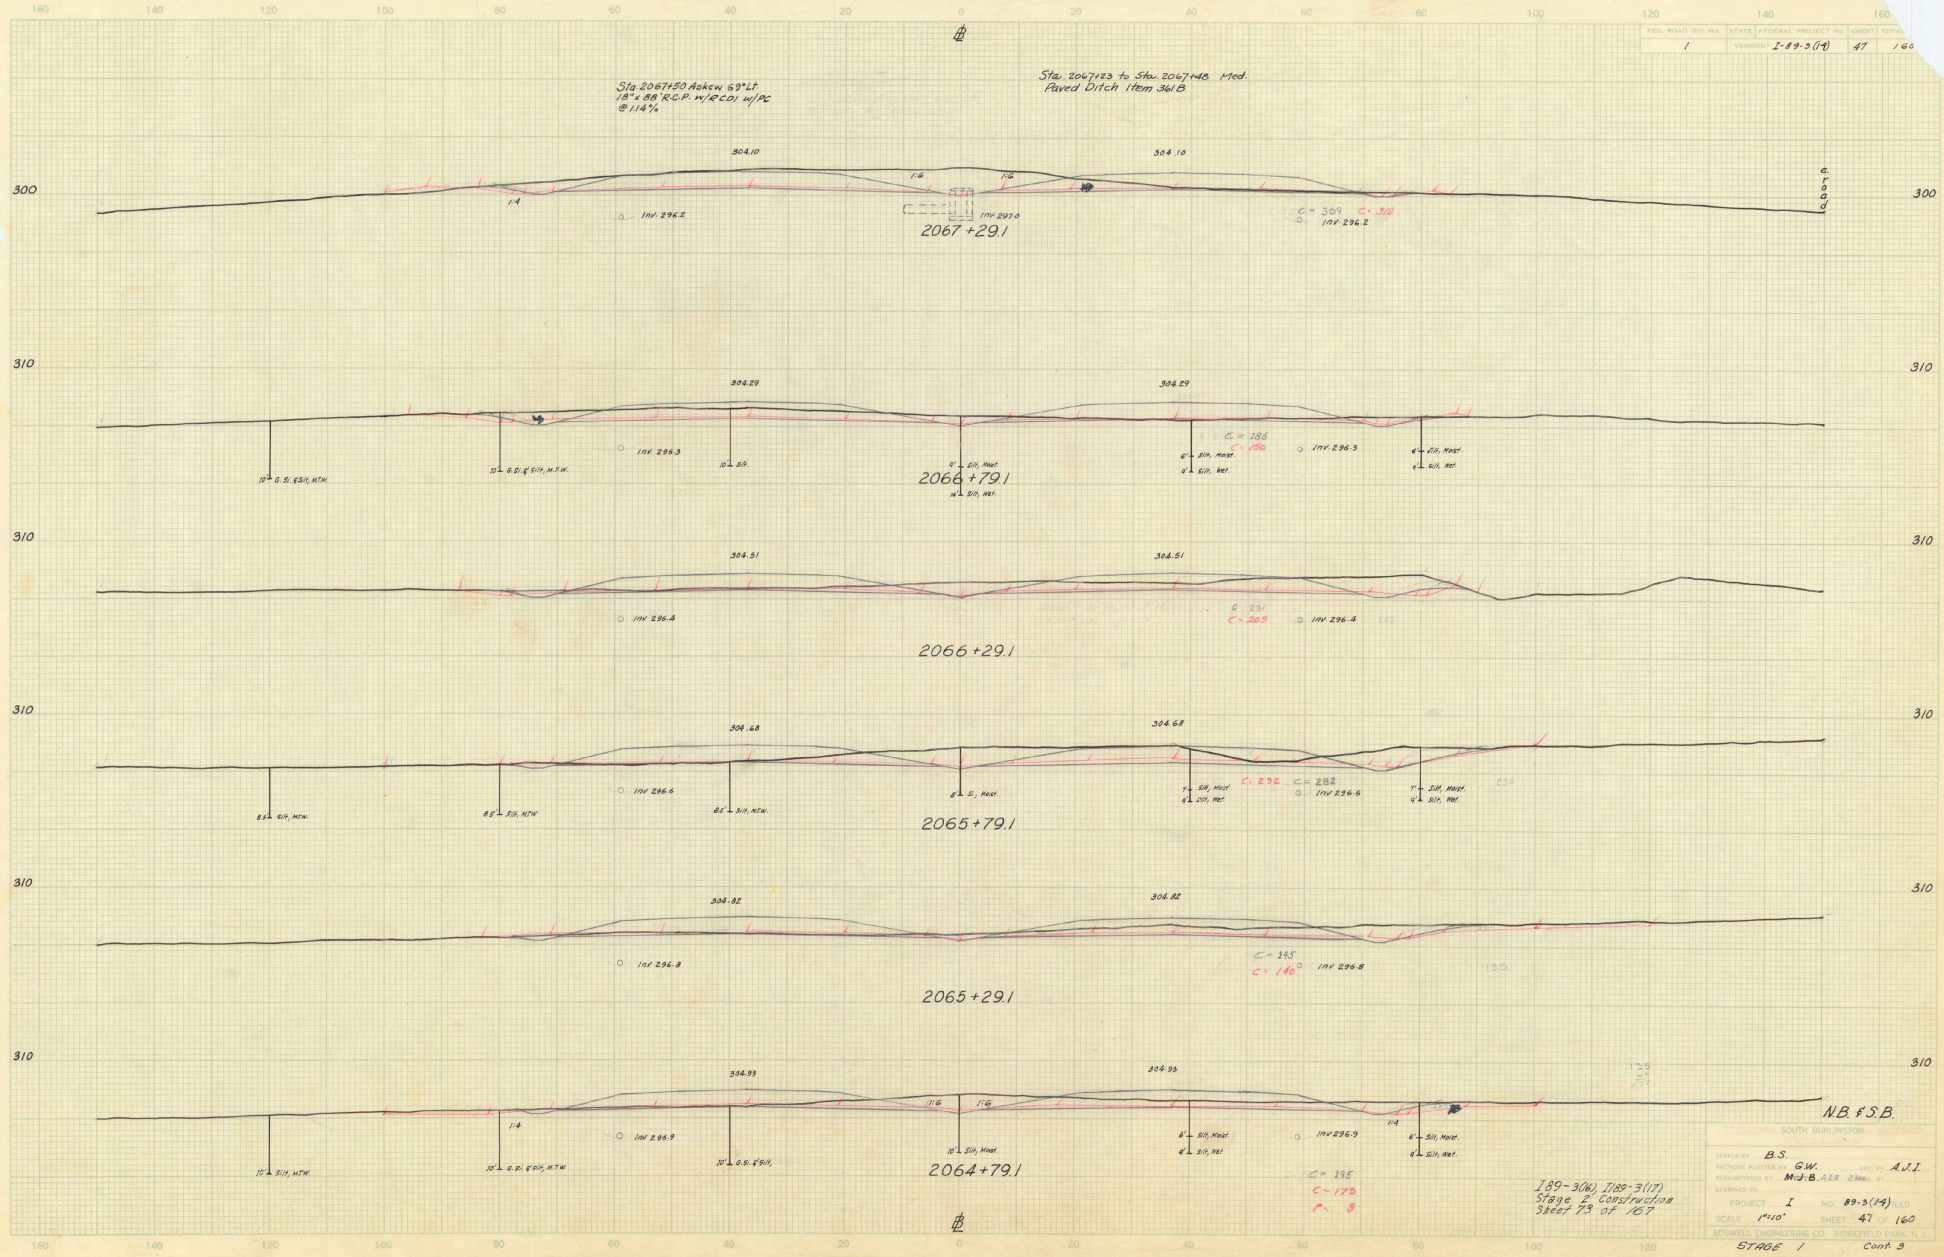

0.6 Plotter by C.W. 4/15/54
0.6 Plotter by A.J. 4/15/54
4/15/54

FED. ROAD DIST. NO.	STATE	FEDERAL PROJECT NO.	SHEET NO.	TOTAL SHEETS
1	VERMONT	I-89-3(14)	71	160

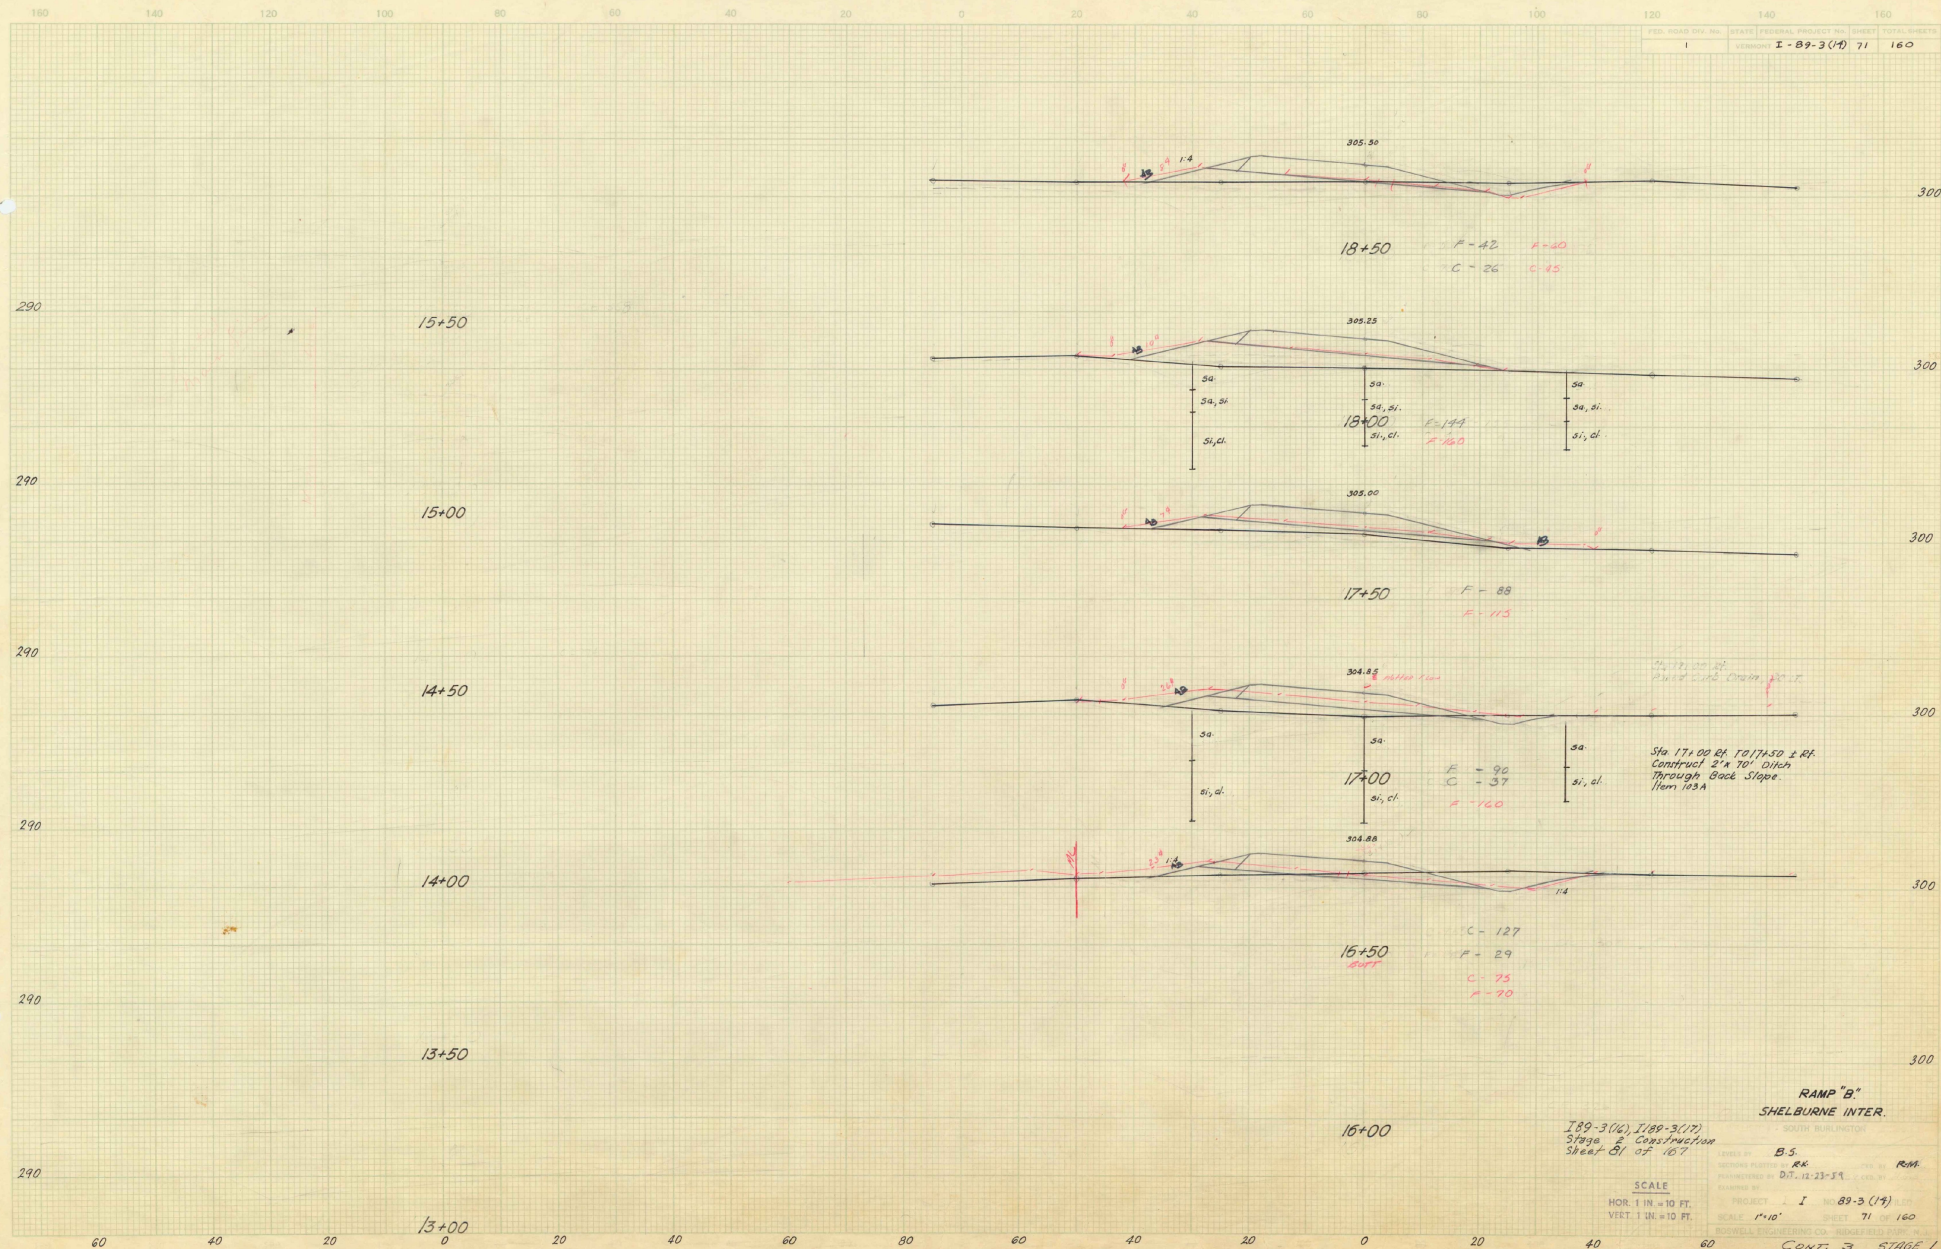


RAMP "B"
 SHELBOURNE INTER.


I-89-3(14), I-89-3(17)
 Stage 2 Construction
 Sheet 81 of 167

DESIGNED BY: B.S.
 DRAWING NO.: 107-12-23-35
 PROJECT: I-89-3(14)
 SCALE: 1" = 10'
 SHEET: 71 OF 160
 CONTRACT: 3 STAGE 1


SCALE
 HOR. 1 IN. = 10 FT.
 VERT. 1 IN. = 10 FT.

Hand-drawn cross-sections of a road on grid paper. The grid has horizontal axes from 160 to 0 and 0 to 160, and vertical axes from 290 to 300. Five cross-sections are shown for stations 13+00, 14+00, 15+00, 16+00, and 17+00. Each section shows a centerline, proposed grade (solid line), and existing ground (dashed line). Slopes are indicated with '1:4' or '1:3'. Station 14+00 includes a note about a ditch. Station 15+00 is marked 'DIFF'.

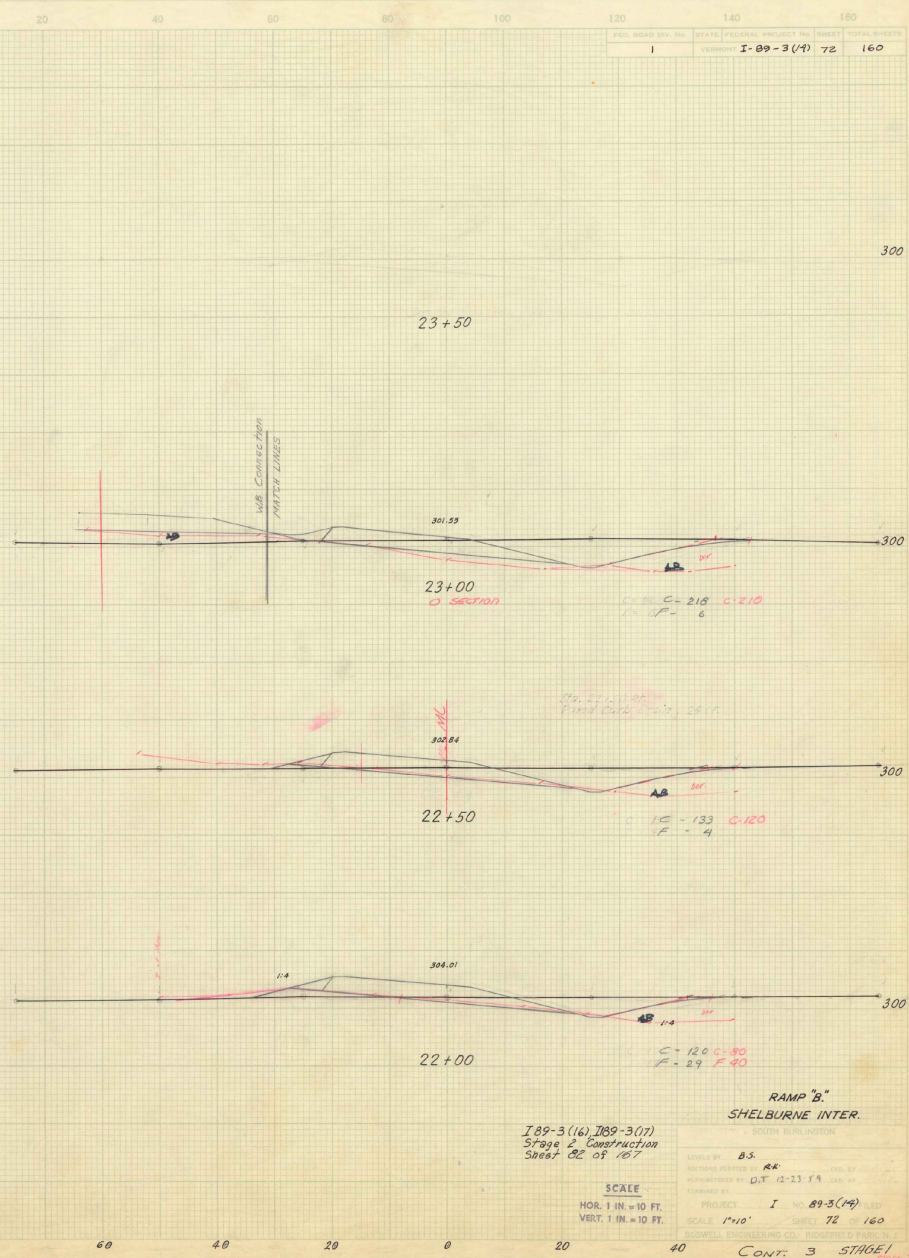

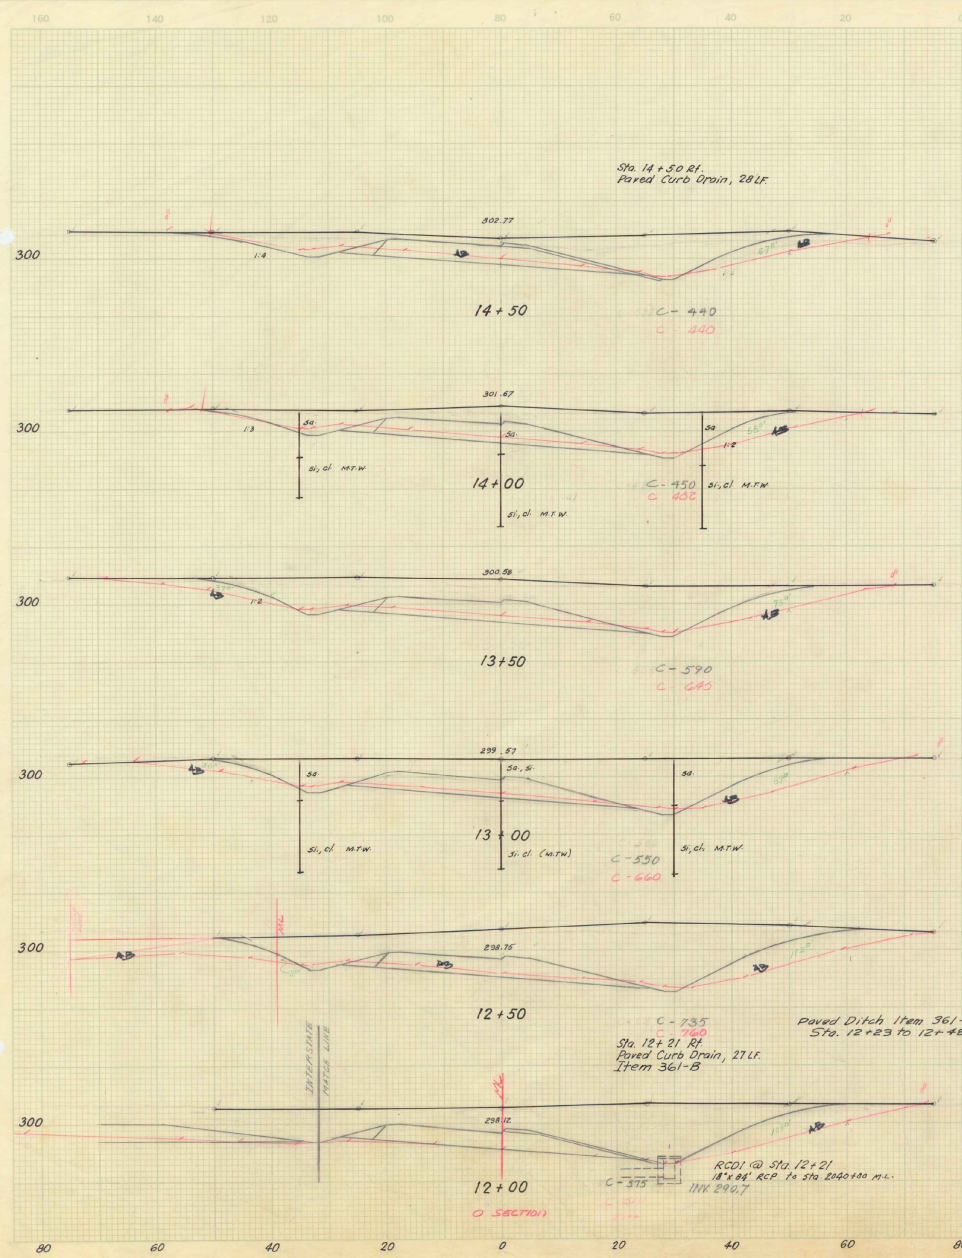


FOR CONTINUATION OF RAMP "C" SECTIONS SEE RAMP "D" & "E" COMBINED
(SHEET No. 77)

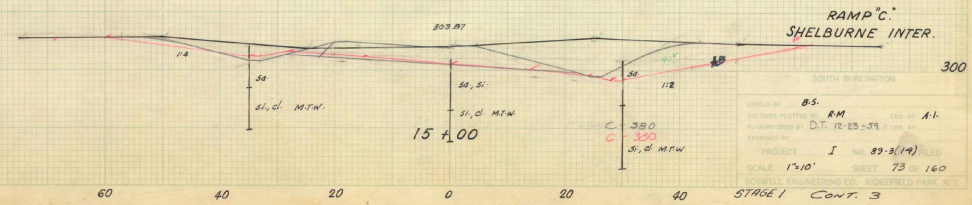



VERMONT
SOUTH BURLINGTON
85. RM
DESIGNED BY D.T. 12-25-59
CHECKED BY
PROJECT
I NO. 89-3 (17)
SHEET 73 OF 160
SCALE 1"=10'
DRAWN BY
DATE


C.B. NOTED BY EMMETT
TEMPORARY HIGHWAY

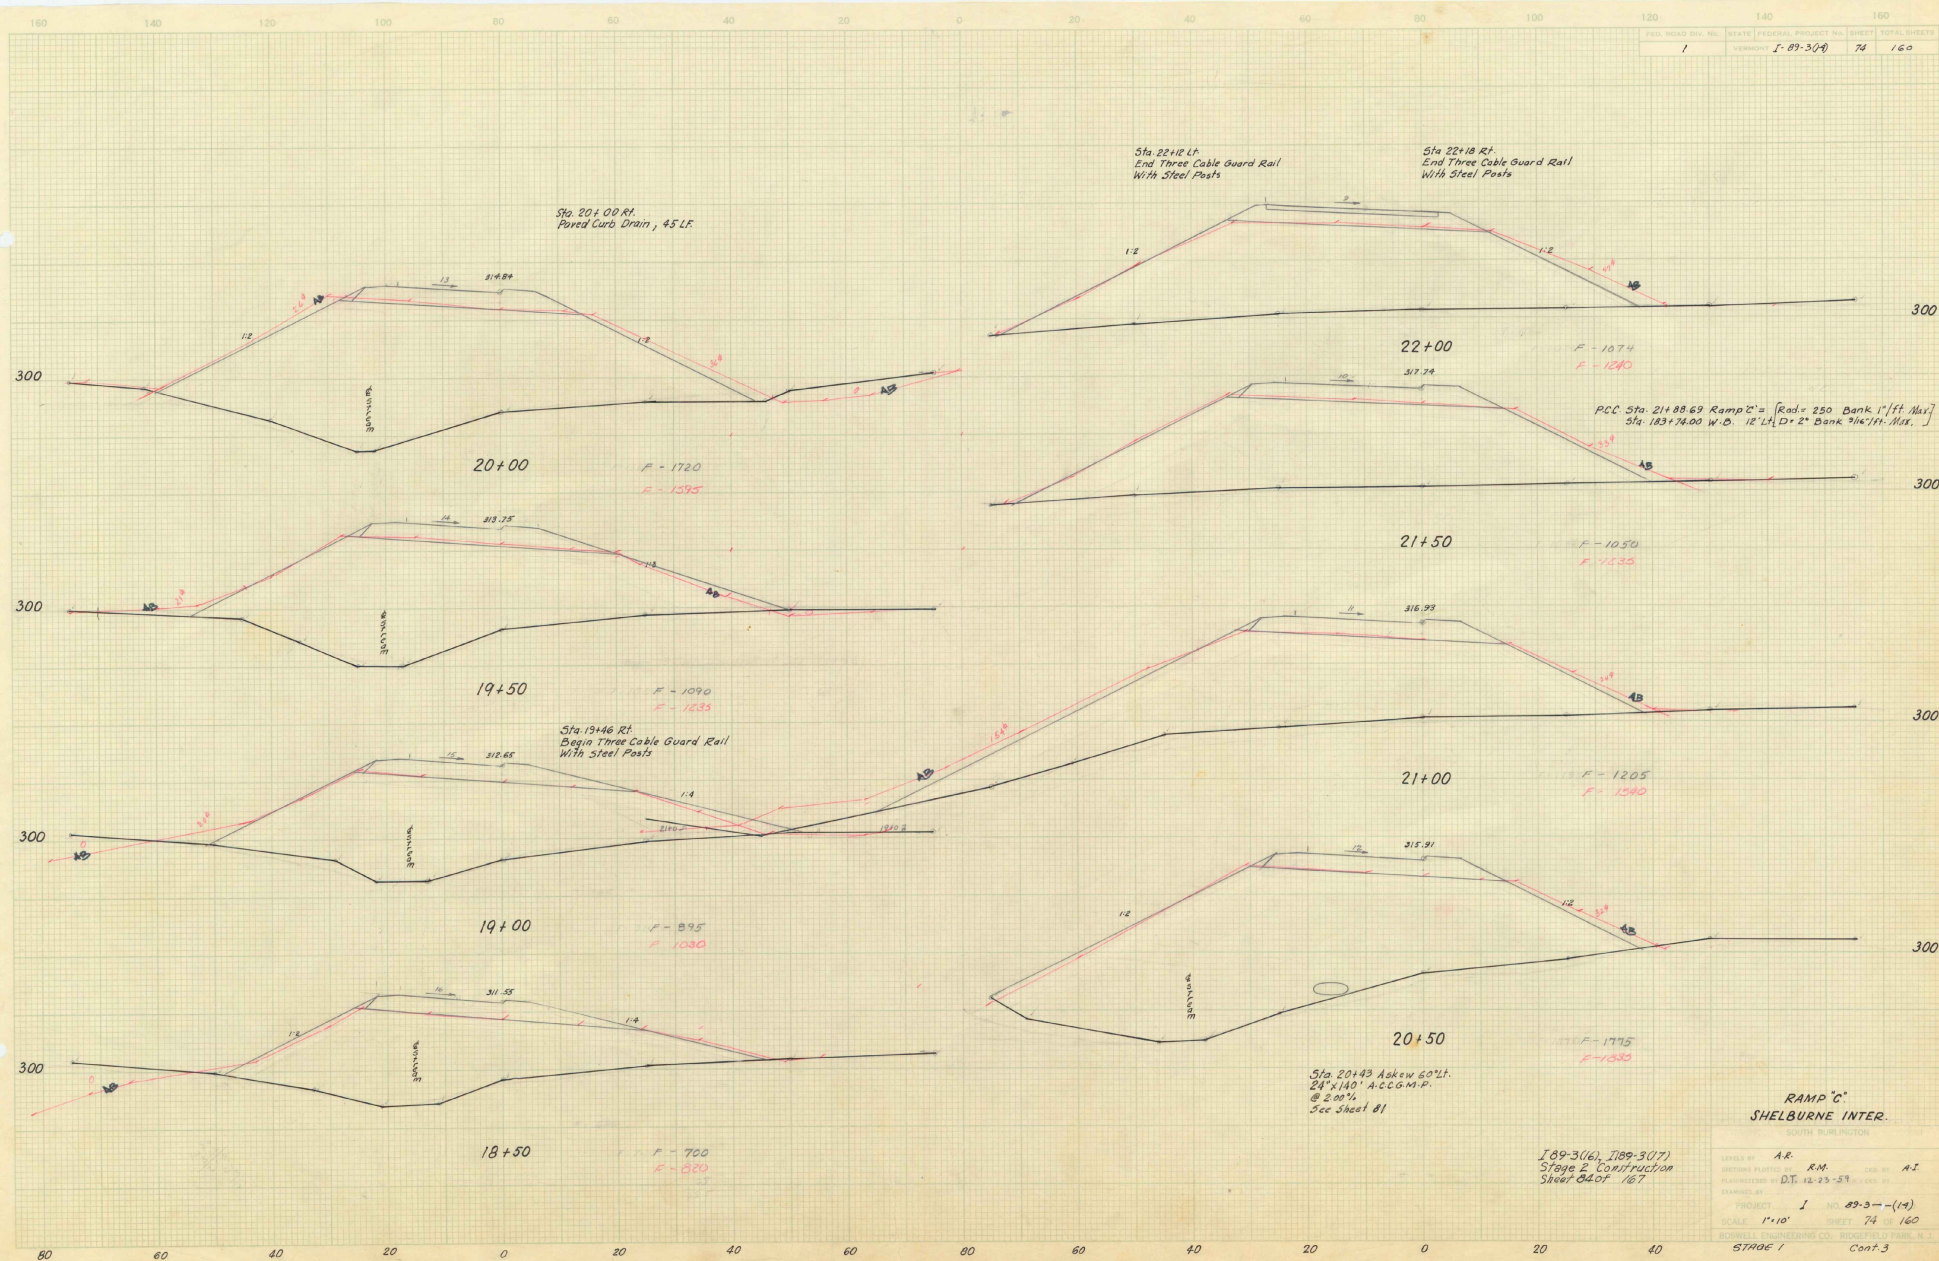

O.C. Plotted by EFW & R.E.
TEMPERATURE REVISED 17A 1/15/59

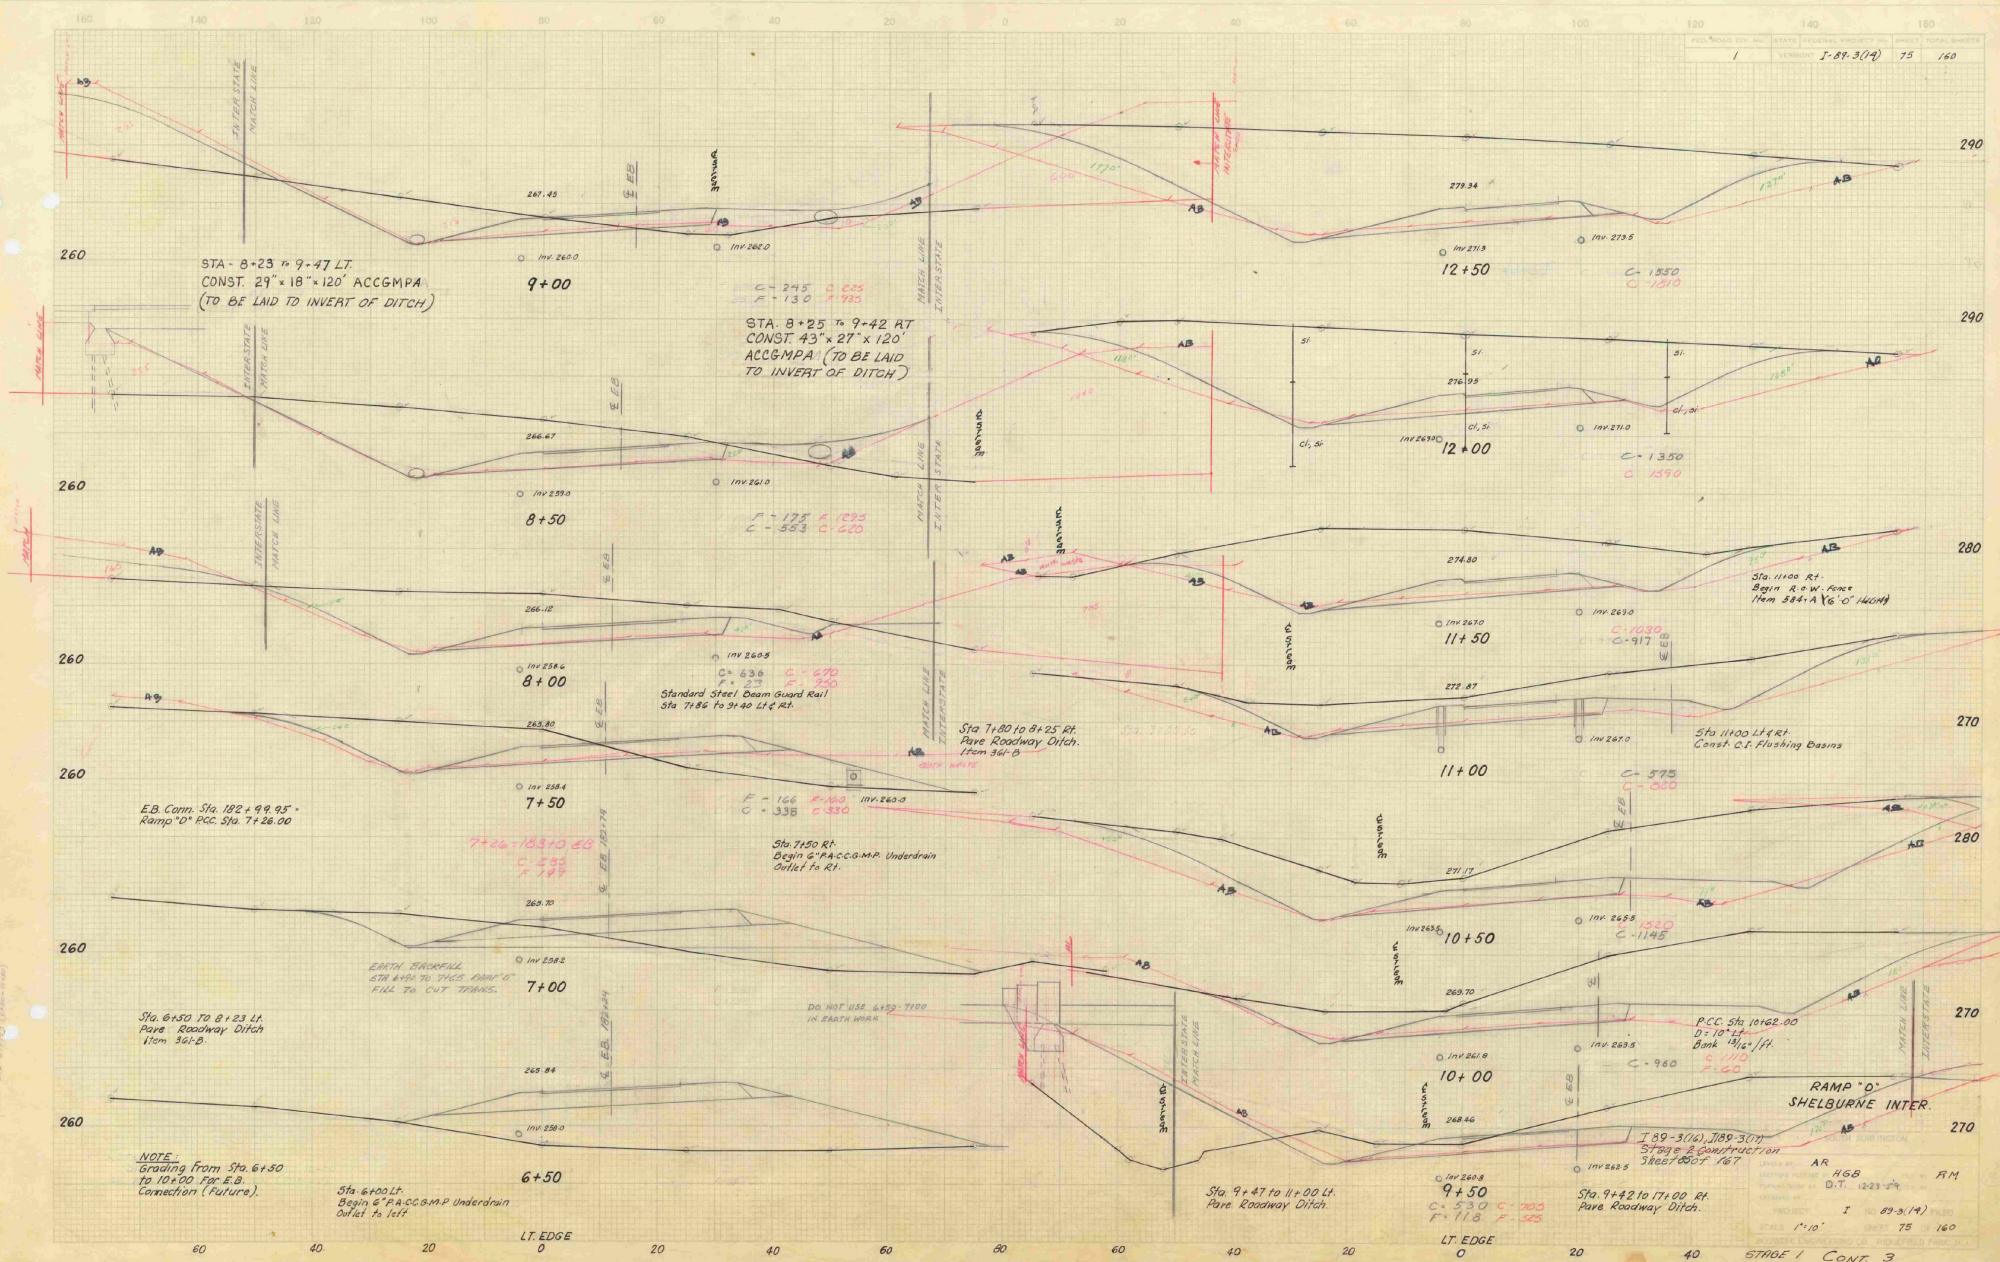


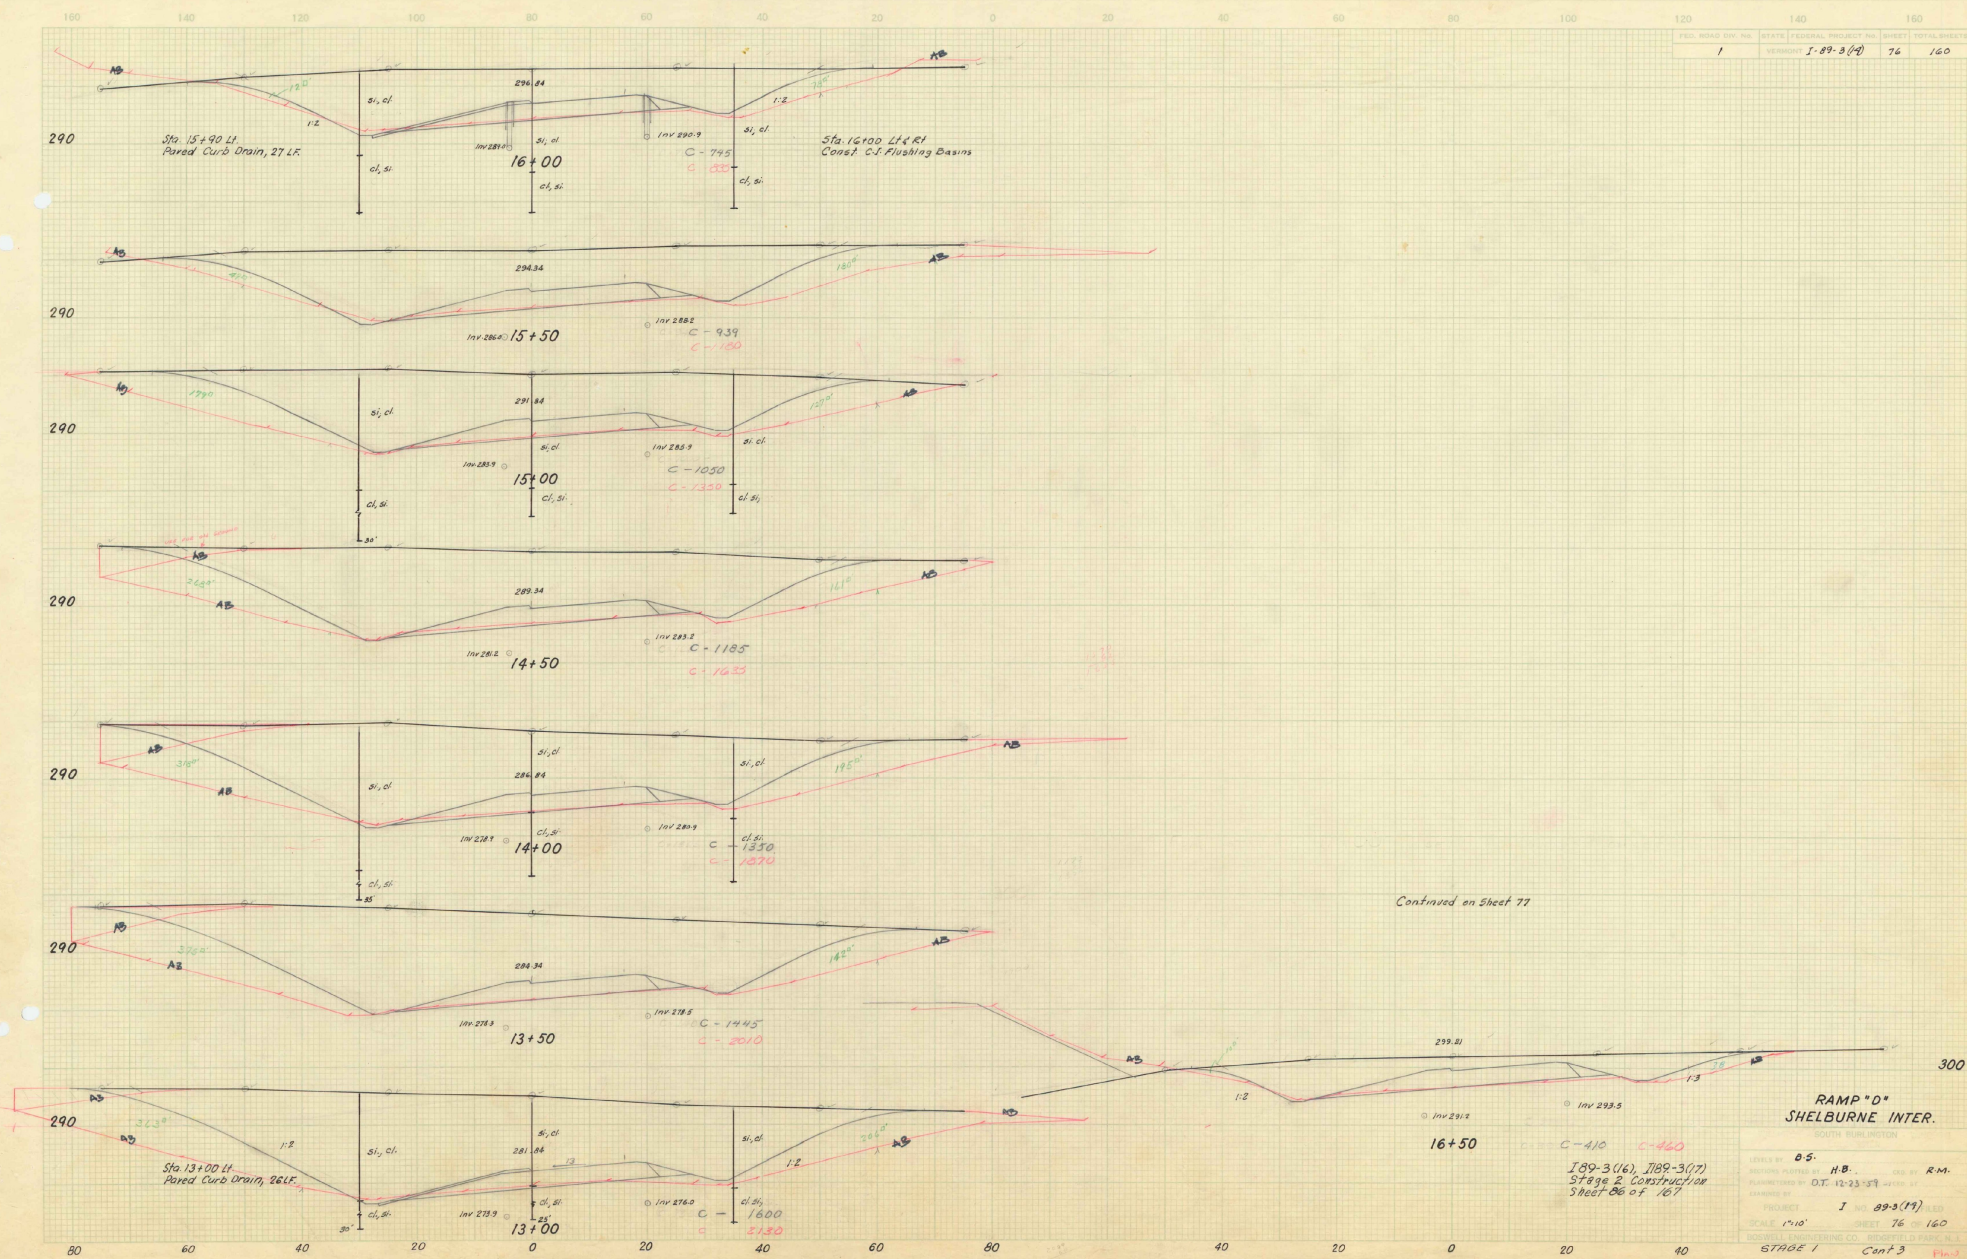

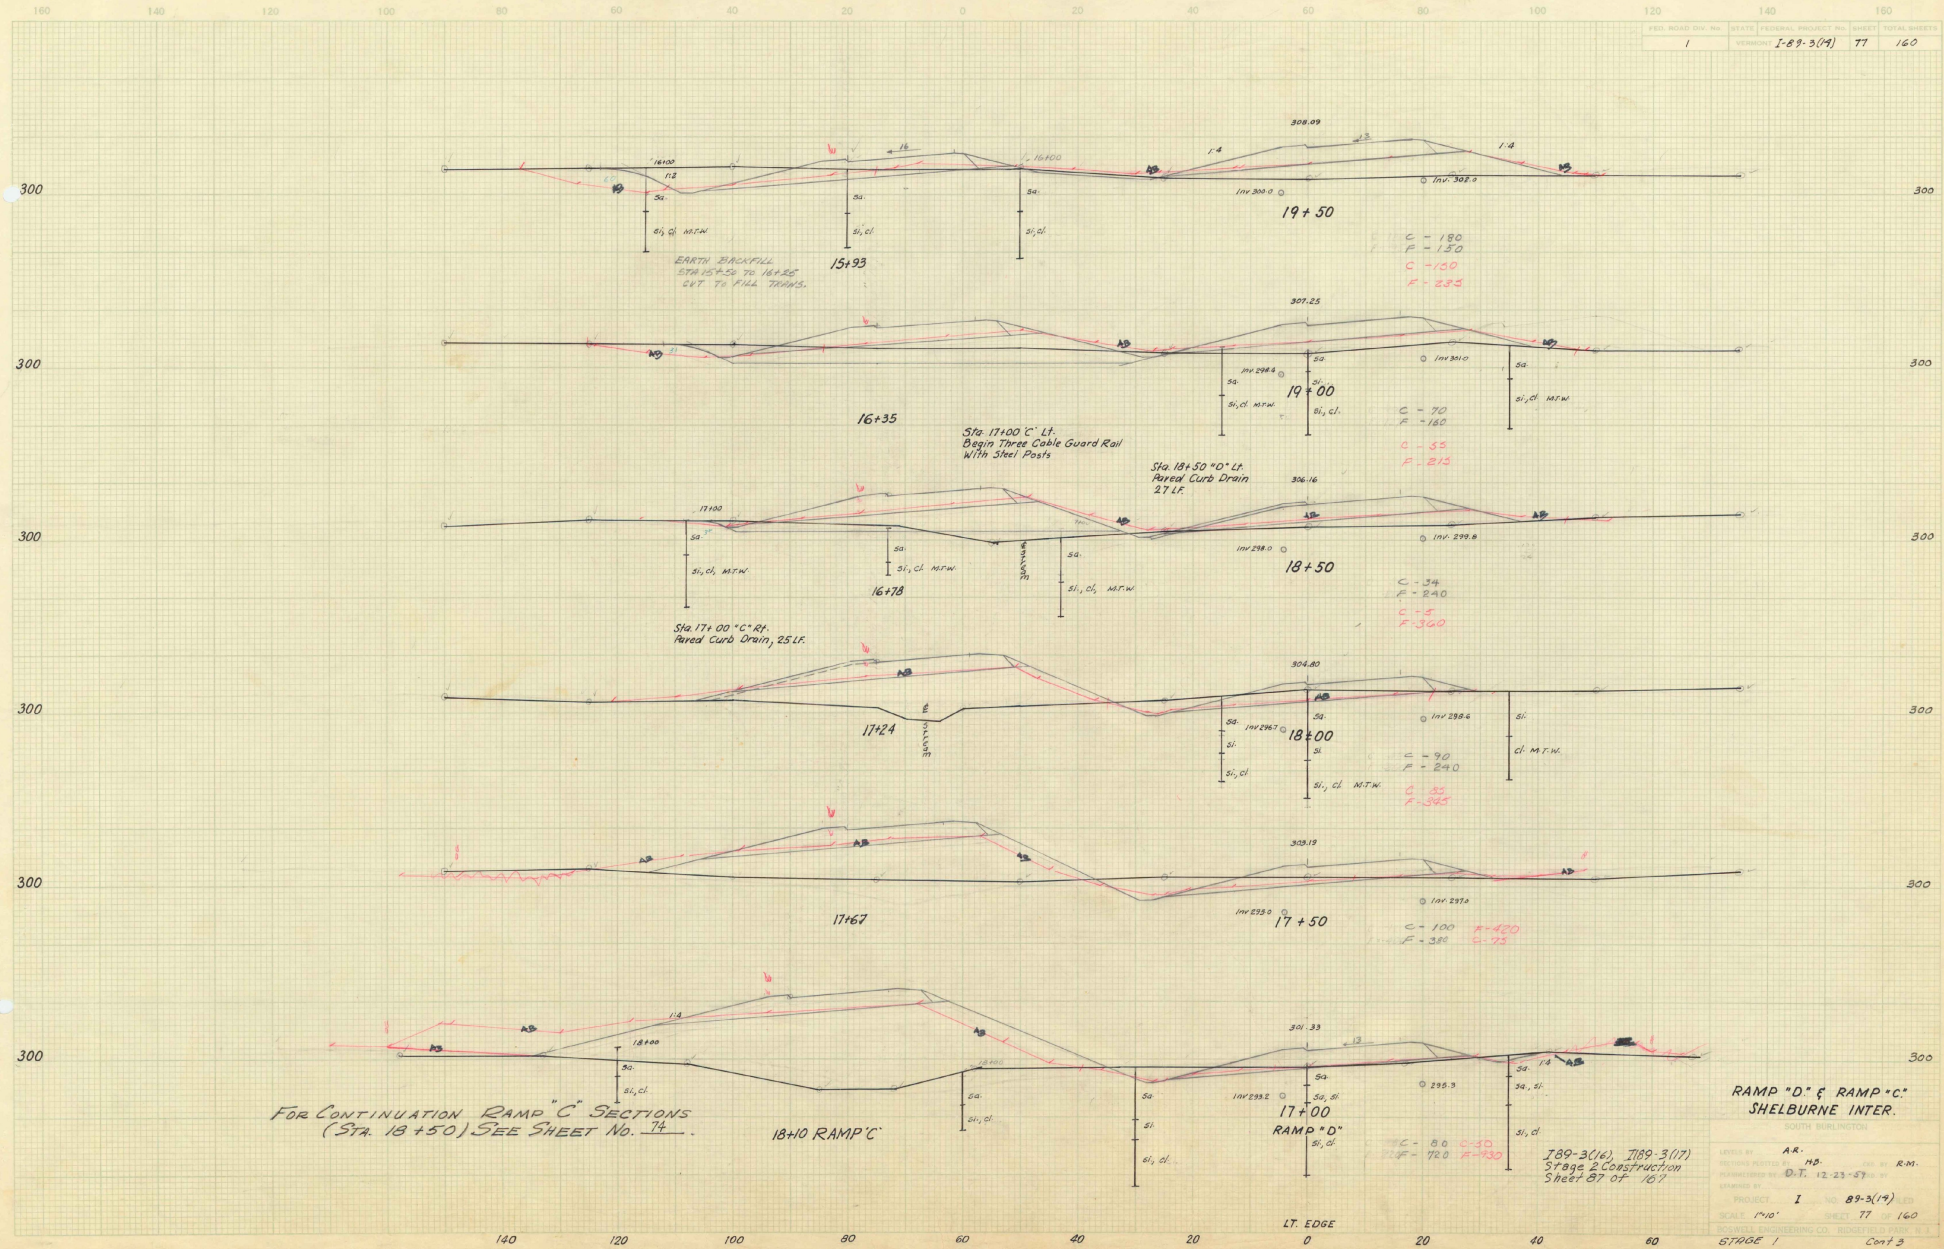


1. 1/2" = 10' HORIZ. SCALE
 2. 1" = 10' VERT. SCALE
 3. 1" = 10' HORIZ. SCALE
 4. 1" = 10' VERT. SCALE
 5. 1" = 10' HORIZ. SCALE
 6. 1" = 10' VERT. SCALE
 7. 1" = 10' HORIZ. SCALE
 8. 1" = 10' VERT. SCALE
 9. 1" = 10' HORIZ. SCALE
 10. 1" = 10' VERT. SCALE

RAMP "D" & RAMP "C"
 SHELBOURNE INTER.
 SOUTH EVAPORATION.
 I-89-3(16), I-89-3(17)
 Stage 2 Construction
 Sheet 87 of 167
 STAGE 1 Cont 3

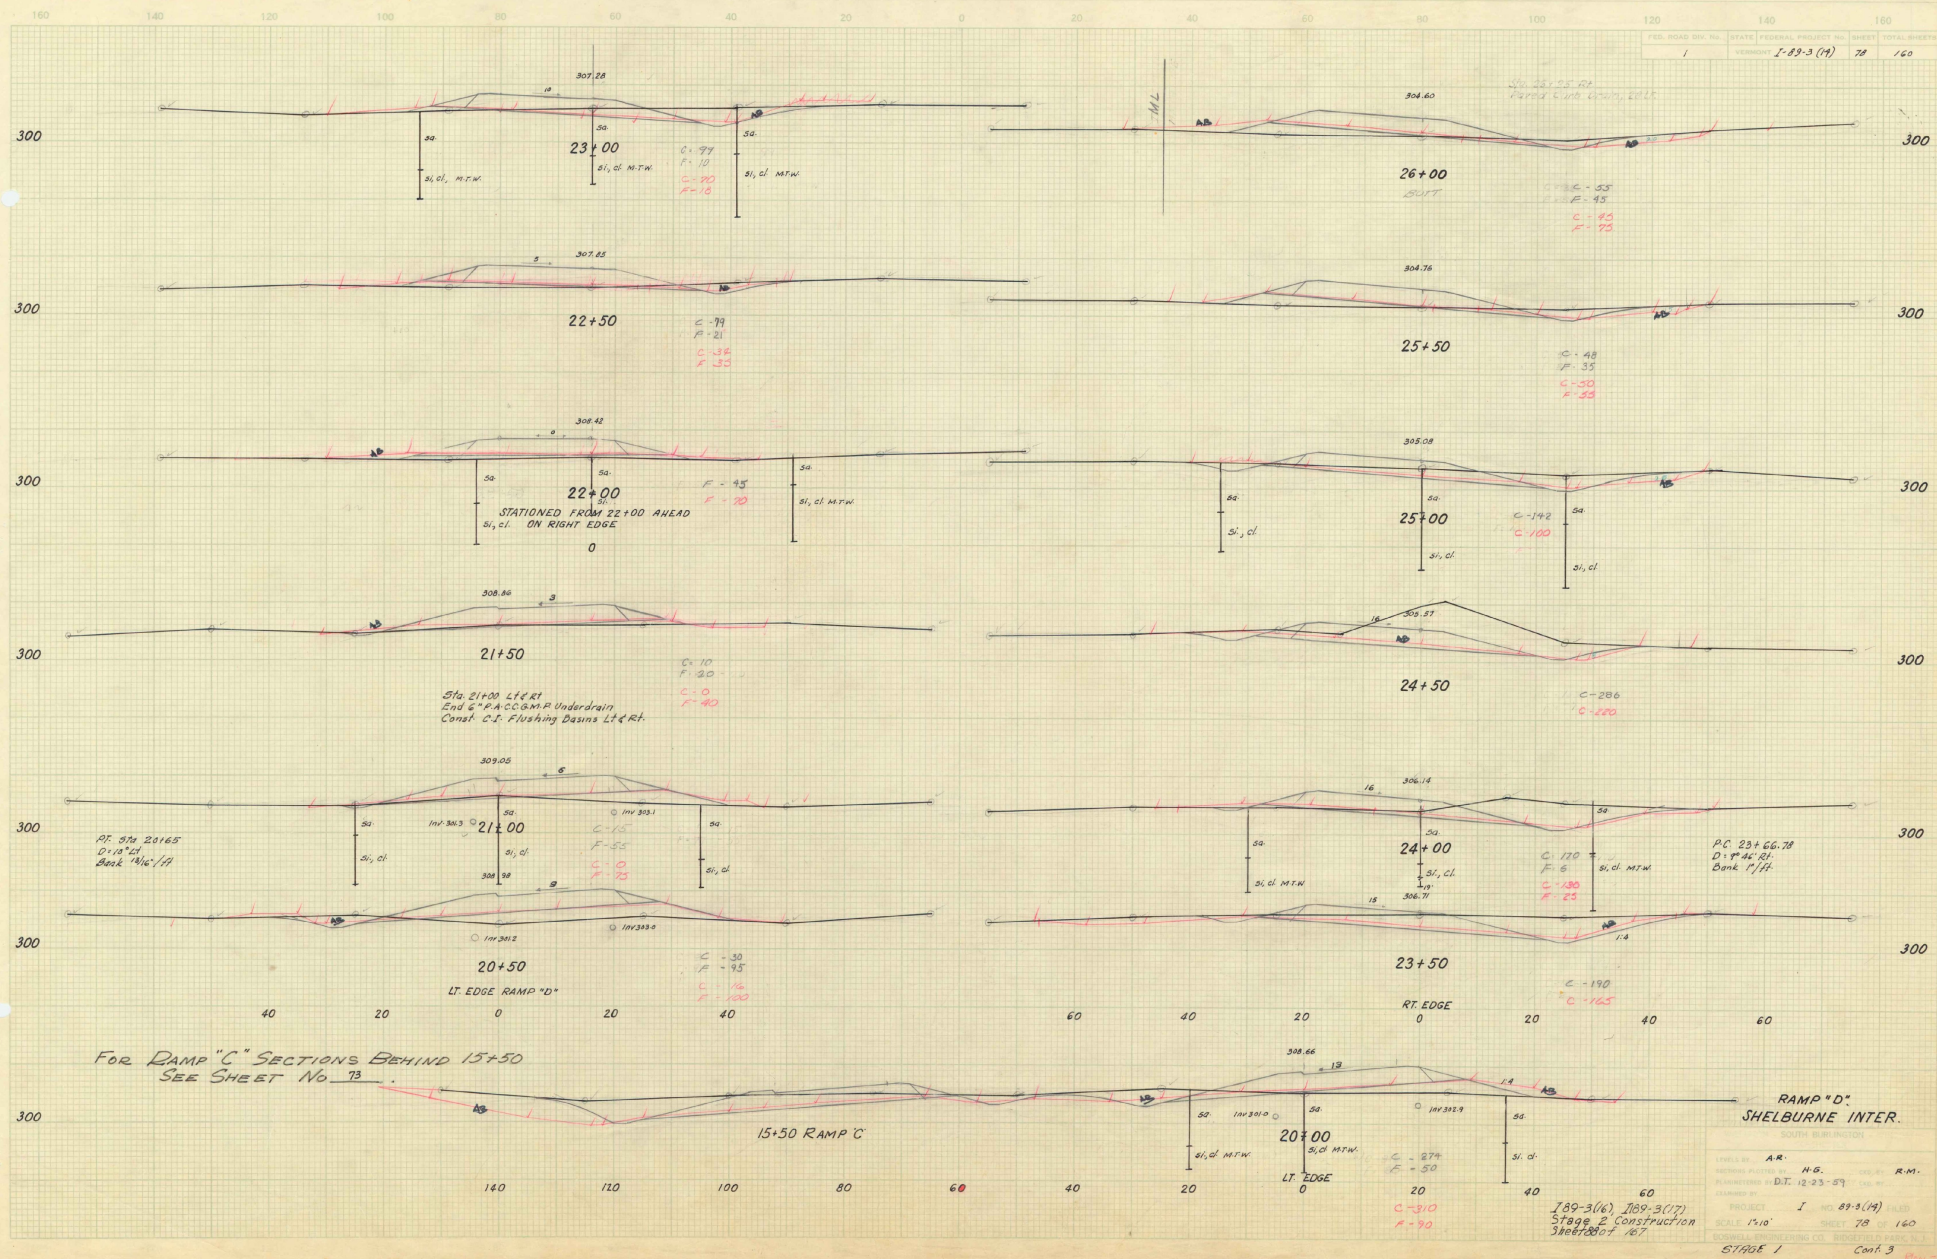

05. BURNED BY FIRE & ETC.
 06. DAMAGED BY BE & ETC.
 07. AND DAMAGE TO OTHERS

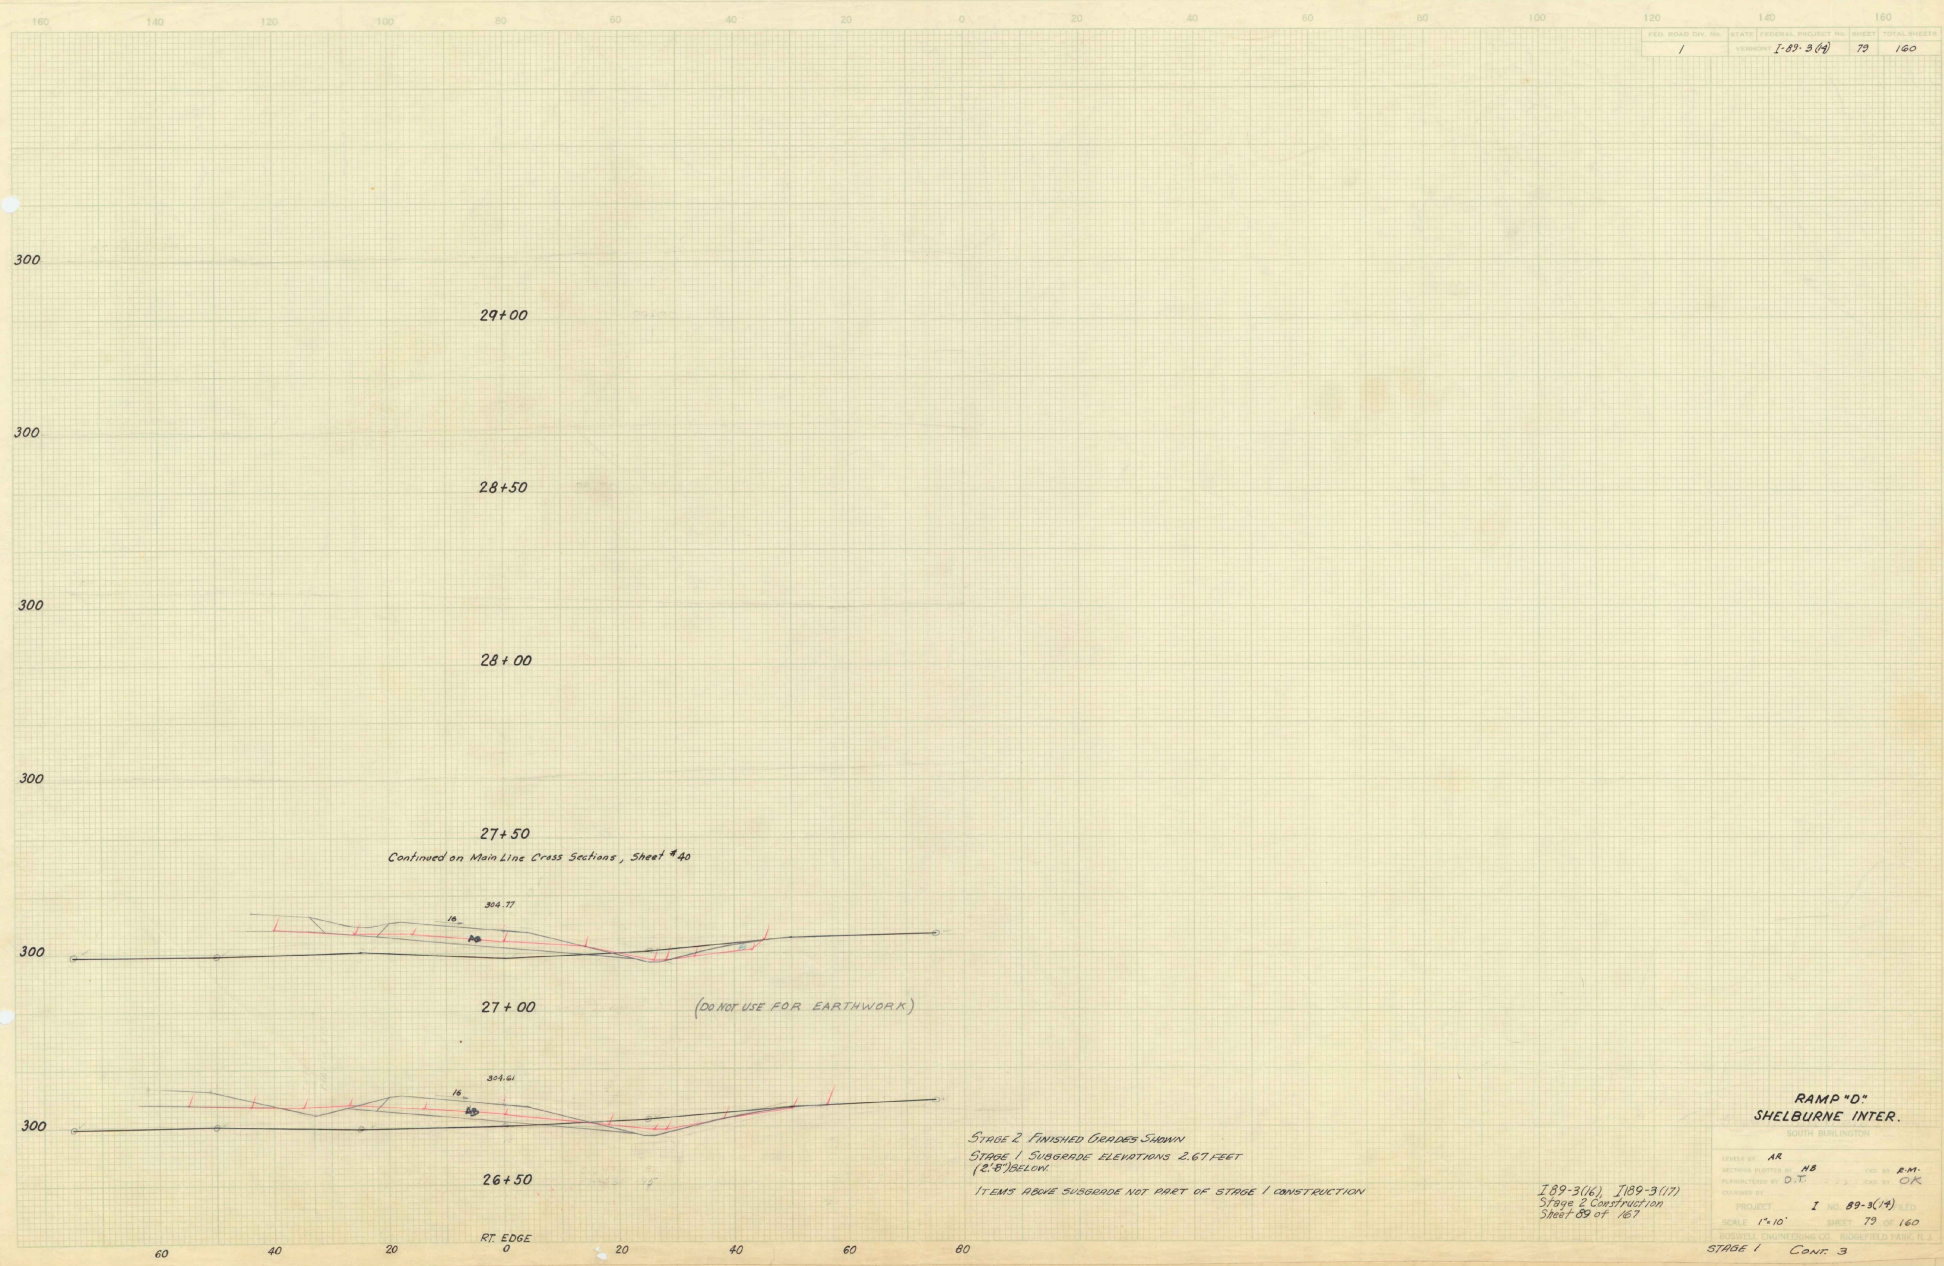


FED. ROAD DIST. NO.	STATE	FEDERAL PROJECT NO.	SHEET	TOTAL SHEETS
1	VERMONT	I-89-3(4)	79	160

RAMP "D"
 SHELburne INTER.


DESIGNED BY AR NB
 CHECKED BY D.T.
 PROJECT I NO. 89-3(4)
 SCALE 1"=10'
 SHEET 79
 STAGE 1 CONT. 3

I 89-3(4), I 89-3(17)
 Stage 2 Construction
 Sheet 89 of 167

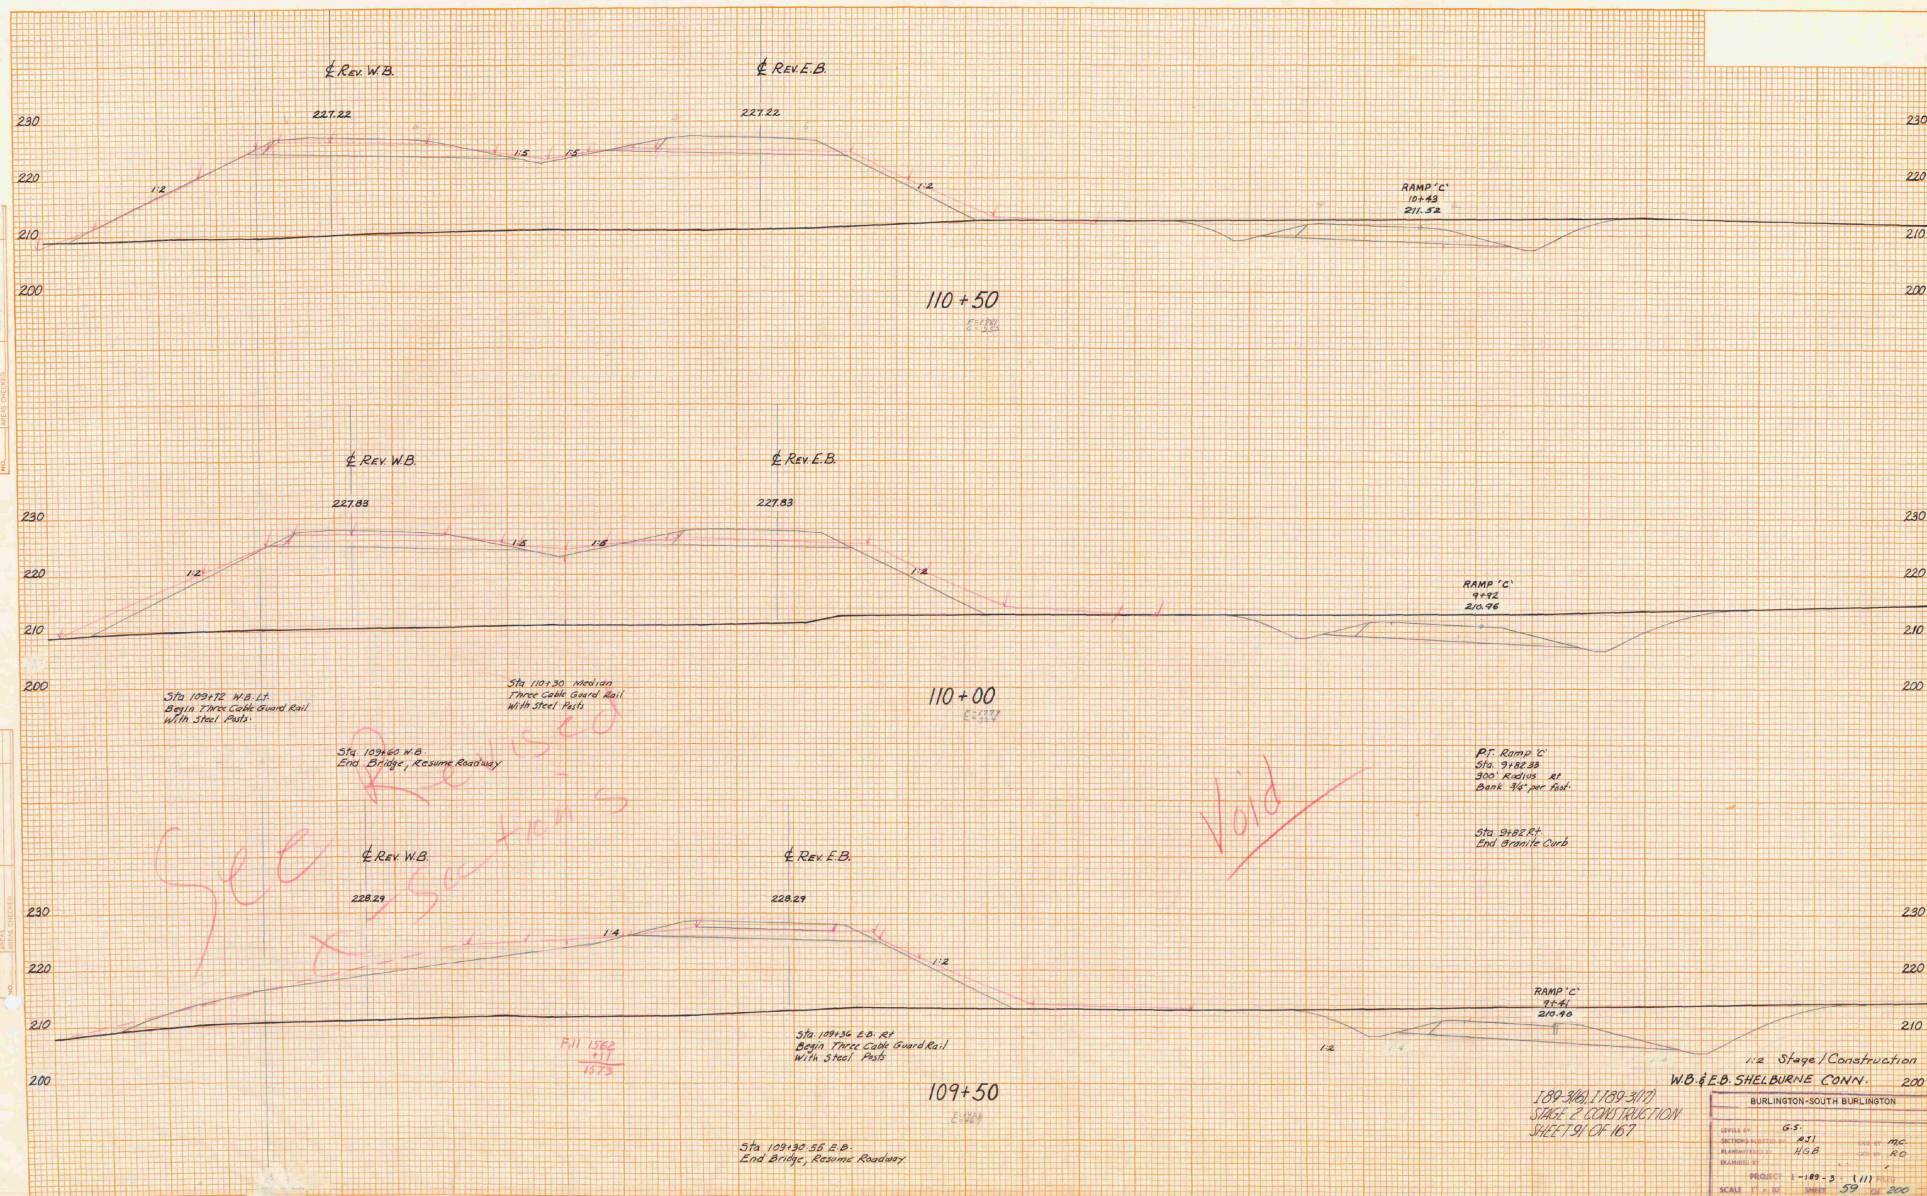

PLAN
 SURVEY
 DATE
 NO.


PLAN
 SURVEY
 DATE
 NO.

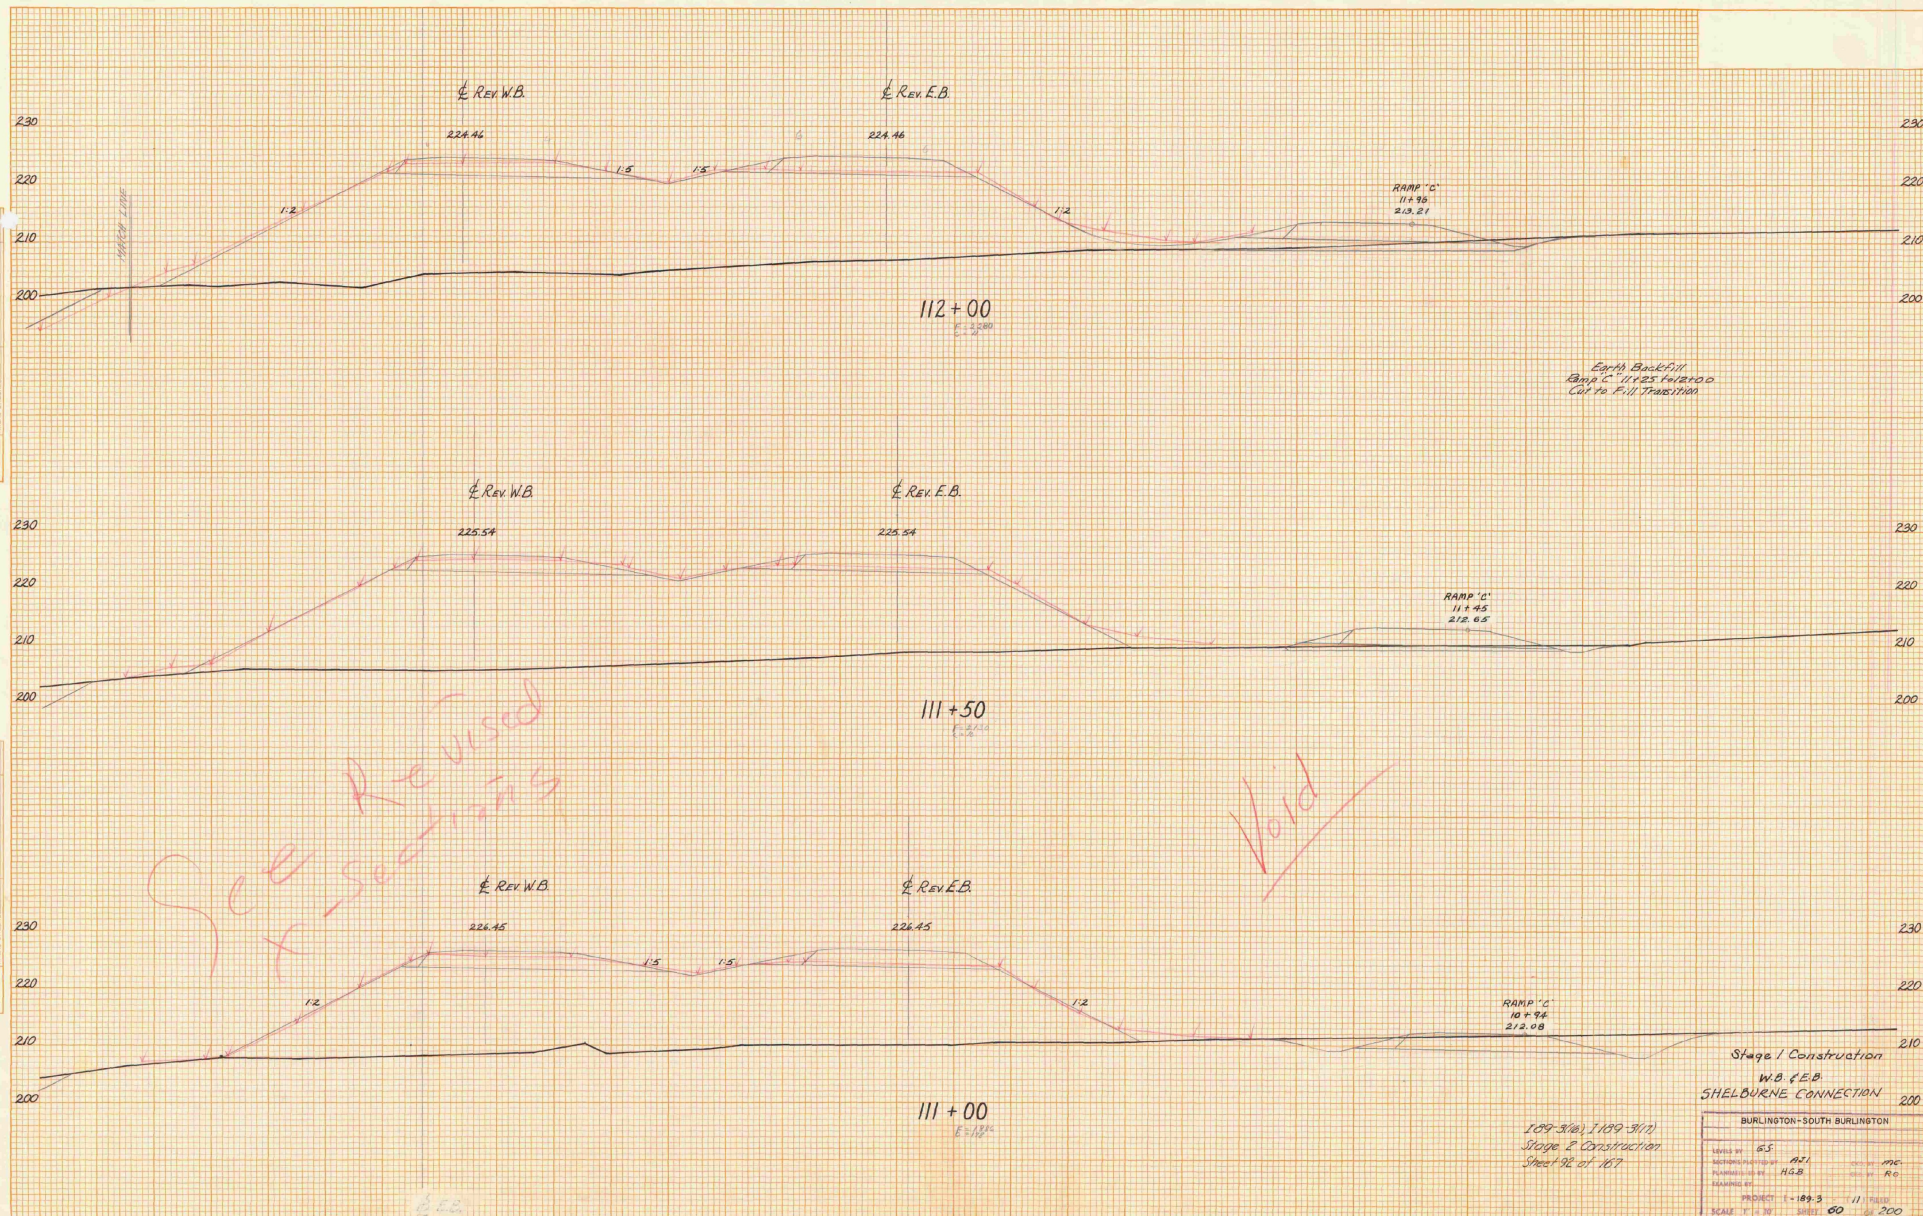

BURLINGTON-SOUTH BURLINGTON			
DESIGNED BY	65	DATE	11/81
APPROVED BY	ASL	DATE	11/81
PLANNED BY	HGB	DATE	11/81
REVISIONS		DATE	
PROJECT	111+00		
SCALE	1" = 10'	DATE	11/81
BIOFILL ENGINEERING CO. BURLINGTON, VT. 05401			

FINAL
SURVEY
NOTES
DATE: 1/10/33
BY: J.E.B.

FINAL
SURVEY
NOTES
DATE: 1/10/33
BY: J.E.B.

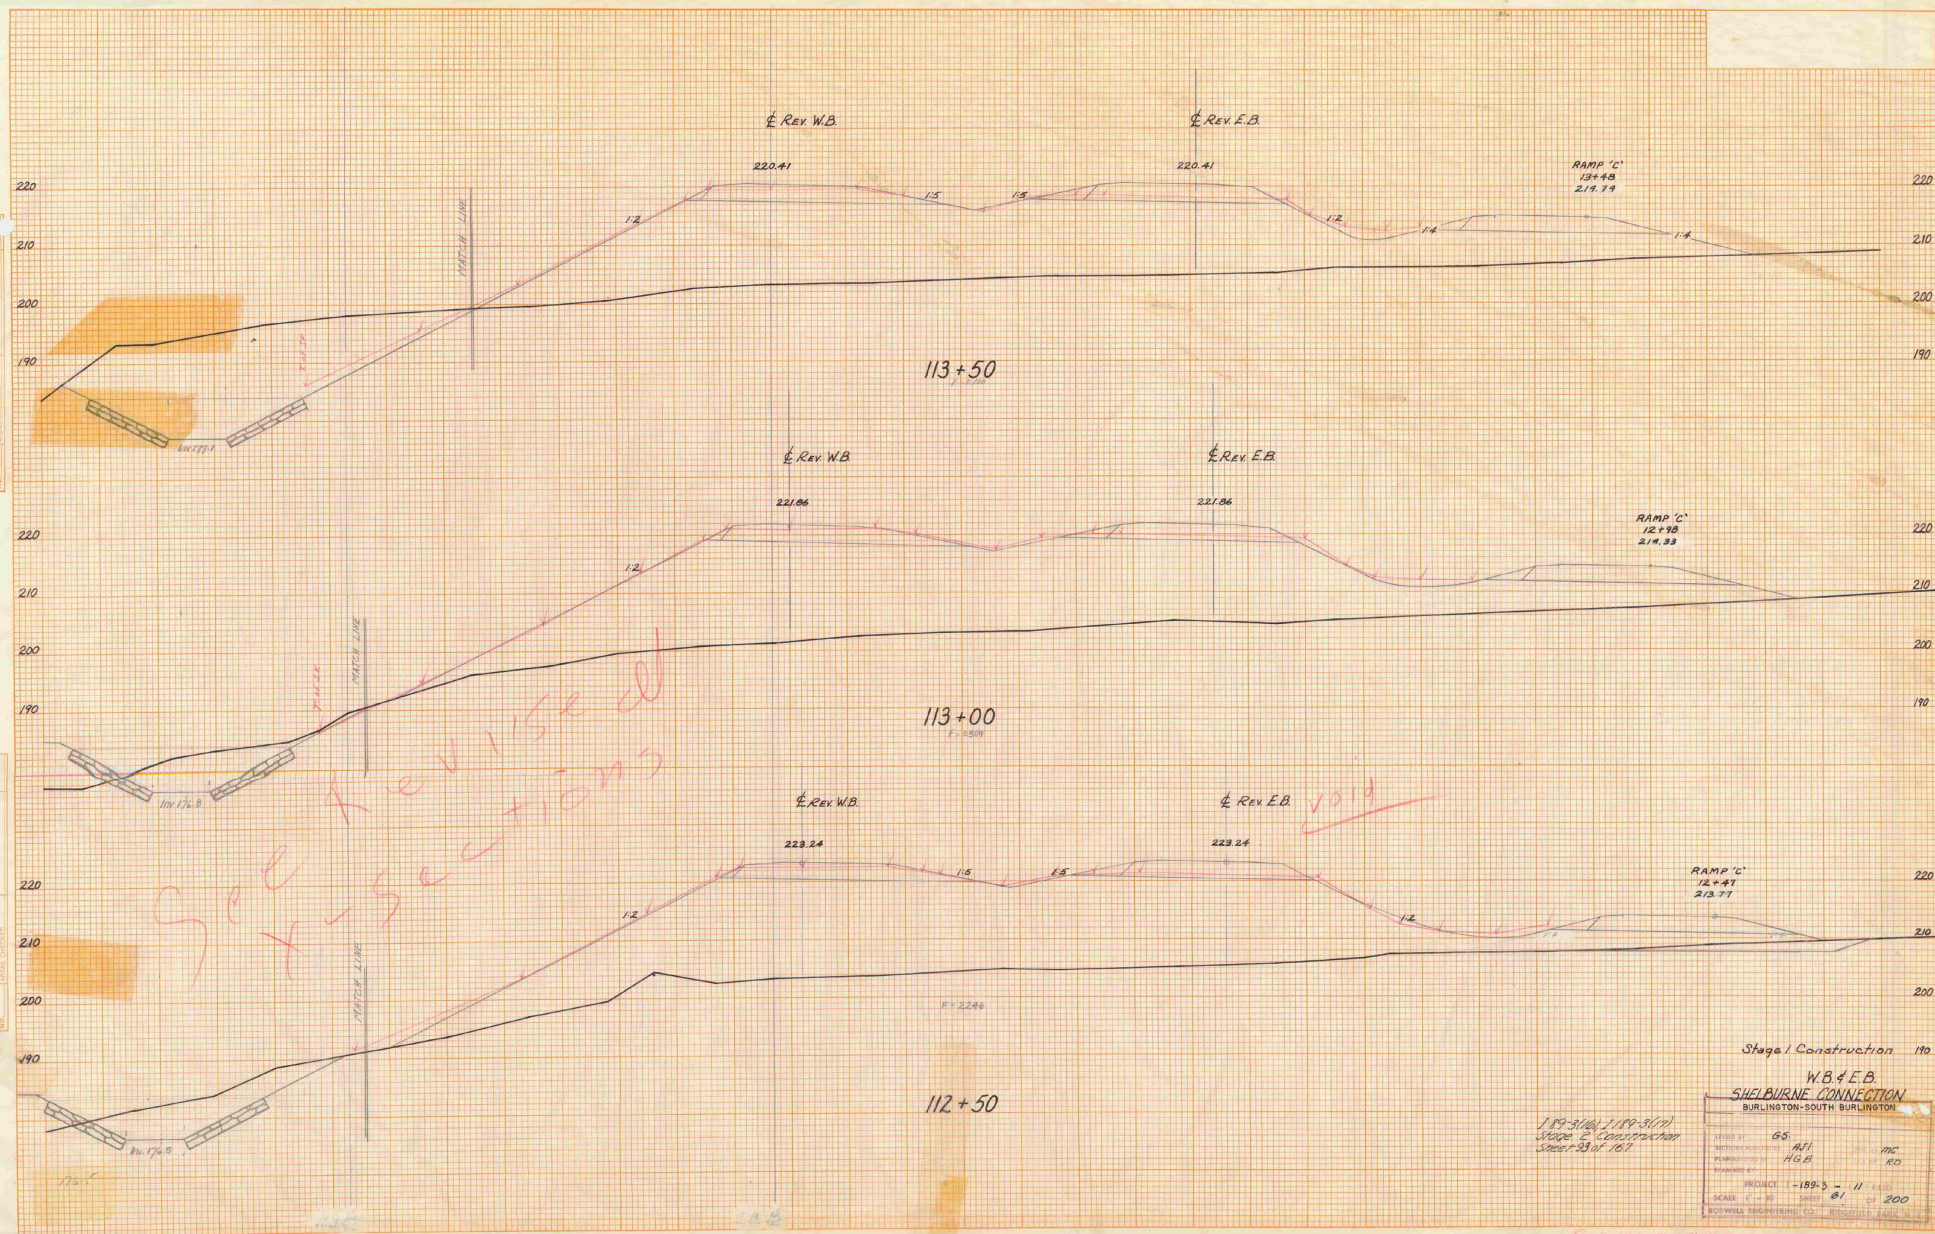


Stage 1 Construction 110
WB & EB
SHELBURNE CONNECTION
BURLINGTON-SOUTH BURLINGTON

DESIGNED BY	65	DATE	1/10/33
REVISIONS	1/10/33	BY	MC
APPROVED BY	W.B.	DATE	1/10/33
PROJECT NO.	109-D-11	BY	RD
SCALE	1" = 20'	DATE	1/10/33
BY	RD	DATE	1/10/33

109-D-11 (10-D-11)
Stage 1 Construction
Sheet 53 of 167


NOTE:

Stage 2 Finished Grades Shown
Stage 1 Subgrade Elevation 2.67 Feet
(2 Ft. 8 in.) Below
Items Above Subgrade Not Part of
Stage 1 Contract

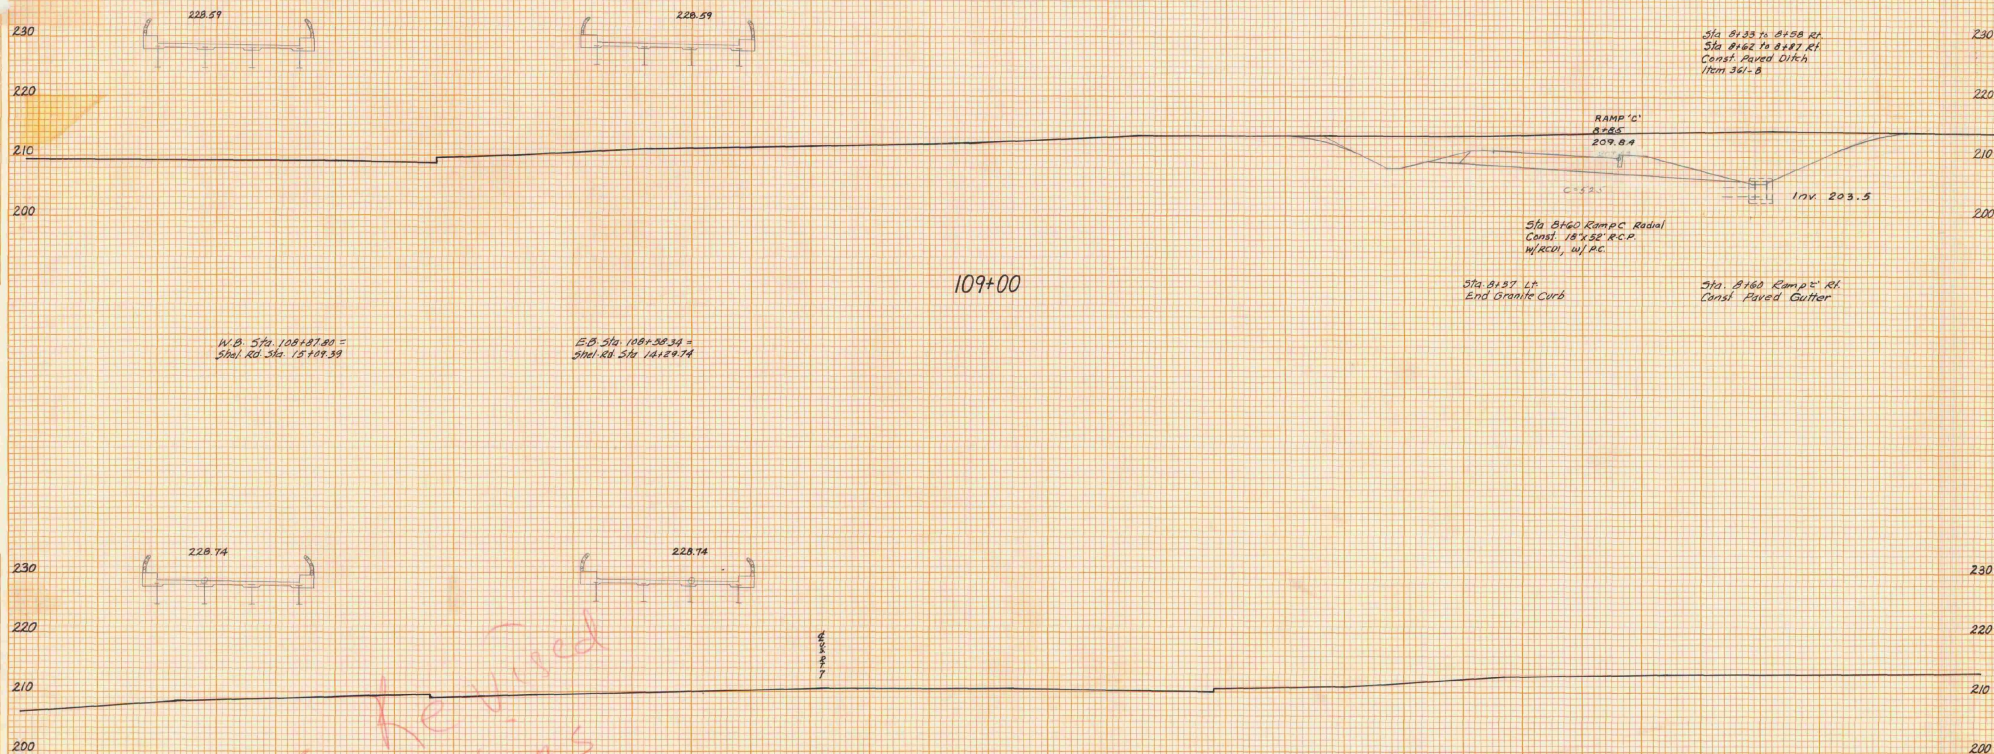

Stage 1 Construction
W.B. & E.B. SHELburne
CONNECTION

BURLINGTON-SOUTH BURLINGTON			
WORK NO.	65	MC	
DESIGN NO.	A-31	R.O.	
DATE	11-18-53		
BY	W.B. REV		
CHECKED	E.B. REV		
APPROVED			
SCALE	1" = 20'		
SHEET	50		
TOTAL SHEETS	50		
PROJECT	189-3		
CONTRACT	189-3		
CONTRACT NO.	189-3		
CONTRACT DATE	11-18-53		
CONTRACT VALUE	\$200		
CONTRACT TYPE	CONSTRUCTION		
CONTRACT DESCRIPTION	CONSTRUCTION		
CONTRACT LOCATION	CONSTRUCTION		
CONTRACT STATUS	CONSTRUCTION		
CONTRACT COMMENTS	CONSTRUCTION		

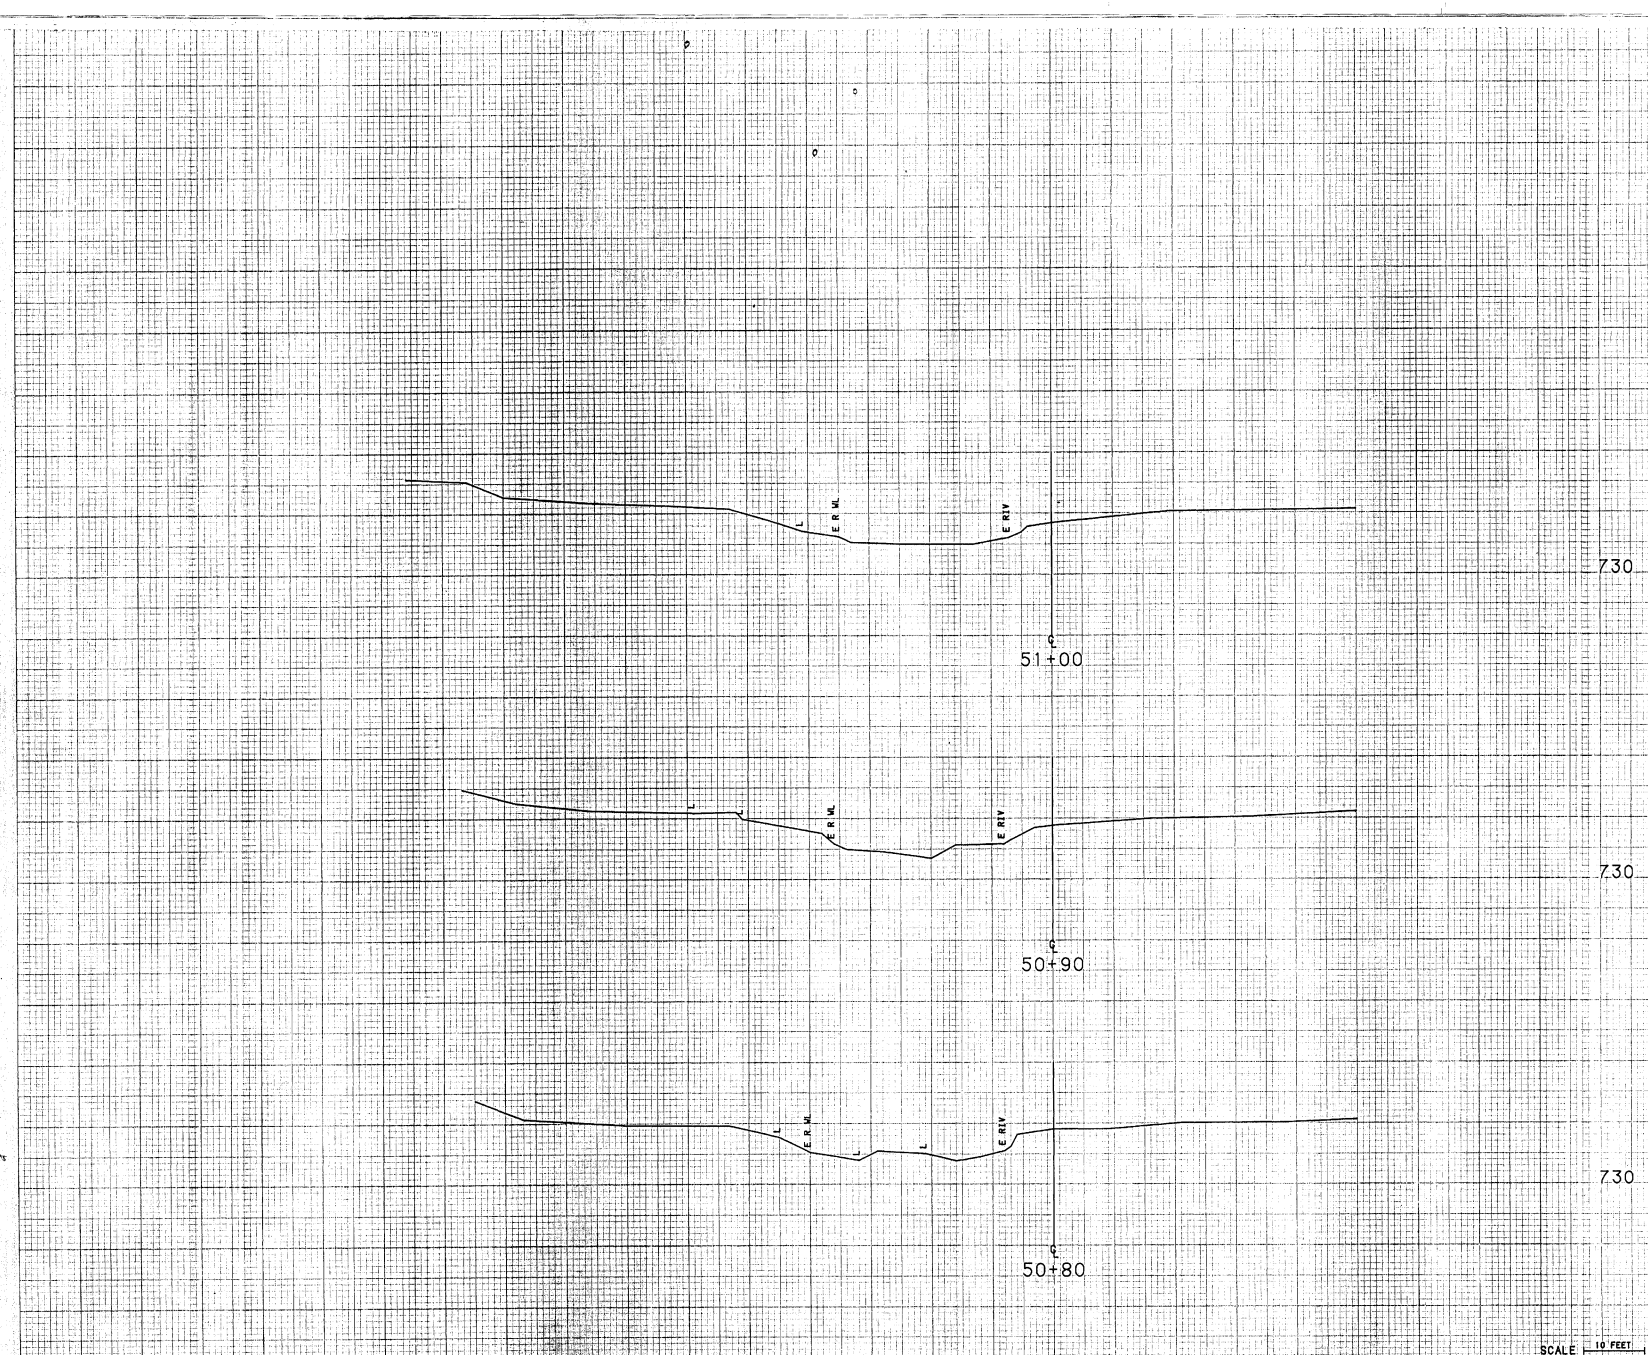

730

51+00

730

50+90

730

50+80

FROM STA. 50+80 TO STA. 51+00
PROJECT NAME MIDDLETOWN SPRINGS CHANNEL
NO. BR21443 (25)
SURVEYED BY GILMAN
SHEET 04/91 0342

SCALE 10 FEET

* C/3
19 61
62

Williston - So. Burlington
I-89-3 (14) C/3

19 61
62