

58A.00 62-61 DETAILS OF 12"x21"-O" TEAM PASS AT STA 2627+50
 62-66 BRIDGE SECTIONS, INDIAN BROOK AT STA.
 77-81 CROSS SECTIONS, CHANNEL AT STA.
 82-86 S.C.B.-C1,D2,D6,D8,D9-D2
 87-88 5.0-50'-62'
 89 BLANK
 90 BLANK
 91 BLANK
 92-107 BLANK
 108-109 CROSS SECTIONS, INTERSTATE
 154-156 CROSS SECTIONS, PRIVATE ROAD AT STA.2527+50
 157-236 BLANK
 116J.17A,118A,B,119A,120A,125A,126A,B,157-159 EXTRA
 CROSS SECTIONS
 10 STEEL BLUE PRINT SHEETS
 SHEETS 66,67,72,73 ARE NOW SHEETS
 37.923.94.8.9,8.6 OF 1.80-32-C-2

PROPOSED IMPROVEMENT

BEGINNING AT A POINT IN COLCHESTER 4.500 MILES NORTH OF THE WINOOSKI —
COLCHESTER TOWN LINE AND EXTENDING NORTHERLY FOR A DISTANCE OF 1.663 MILES

LENGTH OF ROADWAY	1.623 MILES OR	8 570.53 FEET
LENGTH OF BRIDGES	0.040 MILES OR	211.74 FEET
LENGTH OF CONTRACT	1.663 MILES OR	8 782.27 FEET

ADT 1952	3550
ADT 1975	6150
DHV 1975	1200
D	59 %
T	6 %
V	60 M P

SUBBASE OF GRAVEL & GRAVEL BACKFILL- CAMPBELL PIT
- JERICHO, VT.

CONTRACTOR—PERINI CORP.
FRAMINGHAM, MASS.
RESIDENT ENGINEER—R.W. FRASER &
N.W. BITTNER.
RECORD PLANS—N.W. BITTNER.

CONTRACT :
DATED—APRIL 8, 1963.
STARTED—MAY 29, 1963.
COMPLETED—AUGUST 7, 1964.
ACCEPTED—AUGUST 7, 1964.


CONTRACT 3- STAGE

(P)


CURVE "A" RAMP A		CURVE "B" RAMP B		CURVE "C" RAMP C		CURVE "D" RAMP D		CURVE "E" RAMP E	
Δ 30'52" Δ RT	Δ 59'50" Δ RT	Δ 37'23" Δ RT	Δ 59'15" Δ RT	Δ 30'07" Δ LT	Δ 30'50" Δ RT	Δ 40'05" Δ RT	Δ 40'05" Δ RT	Δ 40'05" Δ RT	Δ 40'05" Δ RT
Δ 8°	Δ 8°	Δ 8°	Δ 8°	Δ 8°	Δ 8°	Δ 8°	Δ 8°	Δ 8°	Δ 8°
R 716.83	R 830.00	R 716.83	R 830.00	R 716.83	R 830.00	R 716.83	R 830.00	R 716.83	R 830.00
T 197.48	T 132.78	T 132.78	T 132.78	T 132.78	T 132.78	T 132.78	T 132.78	T 132.78	T 132.78
L 265.70	L 246.44	L 467.38	L 467.38	L 265.70	L 265.70	L 265.70	L 265.70	L 265.70	L 265.70
E 26.77	E 30.59	E 39.90	E 39.90	E 26.77	E 26.77	E 26.77	E 26.77	E 26.77	E 26.77
BANK 75% PER FT	BANK 1% PER FT	BANK 30% PER FT	BANK 30% PER FT	BANK 30% PER FT	BANK 30% PER FT	BANK 30% PER FT	BANK 30% PER FT	BANK 30% PER FT	BANK 30% PER FT
CURVE "F" RAMP F		CURVE "G" RAMP G		CURVE "H" RAMP H		CURVE "I" RAMP I		CURVE "J" RAMP J	
Δ 30'52" Δ RT	Δ 59'50" Δ RT	Δ 37'23" Δ RT	Δ 59'15" Δ RT	Δ 30'07" Δ LT	Δ 30'50" Δ RT	Δ 40'05" Δ RT	Δ 40'05" Δ RT	Δ 40'05" Δ RT	Δ 40'05" Δ RT
Δ 8°	Δ 8°	Δ 8°	Δ 8°	Δ 8°	Δ 8°	Δ 8°	Δ 8°	Δ 8°	Δ 8°
R 716.83	R 830.00	R 716.83	R 830.00	R 716.83	R 830.00	R 716.83	R 830.00	R 716.83	R 830.00
T 197.48	T 132.78	T 132.78	T 132.78	T 132.78	T 132.78	T 132.78	T 132.78	T 132.78	T 132.78
L 265.70	L 246.44	L 467.38	L 467.38	L 265.70	L 265.70	L 265.70	L 265.70	L 265.70	L 265.70
E 26.77	E 30.59	E 39.90	E 39.90	E 26.77	E 26.77	E 26.77	E 26.77	E 26.77	E 26.77
BANK 75% PER FT	BANK 1% PER FT	BANK 30% PER FT	BANK 30% PER FT	BANK 30% PER FT	BANK 30% PER FT	BANK 30% PER FT	BANK 30% PER FT	BANK 30% PER FT	BANK 30% PER FT

FOR DETAILS OF RAMPS A, B, C, D SEE SHEET ____ OF ____

ALSO U.S. ROUTES # 2 & 7

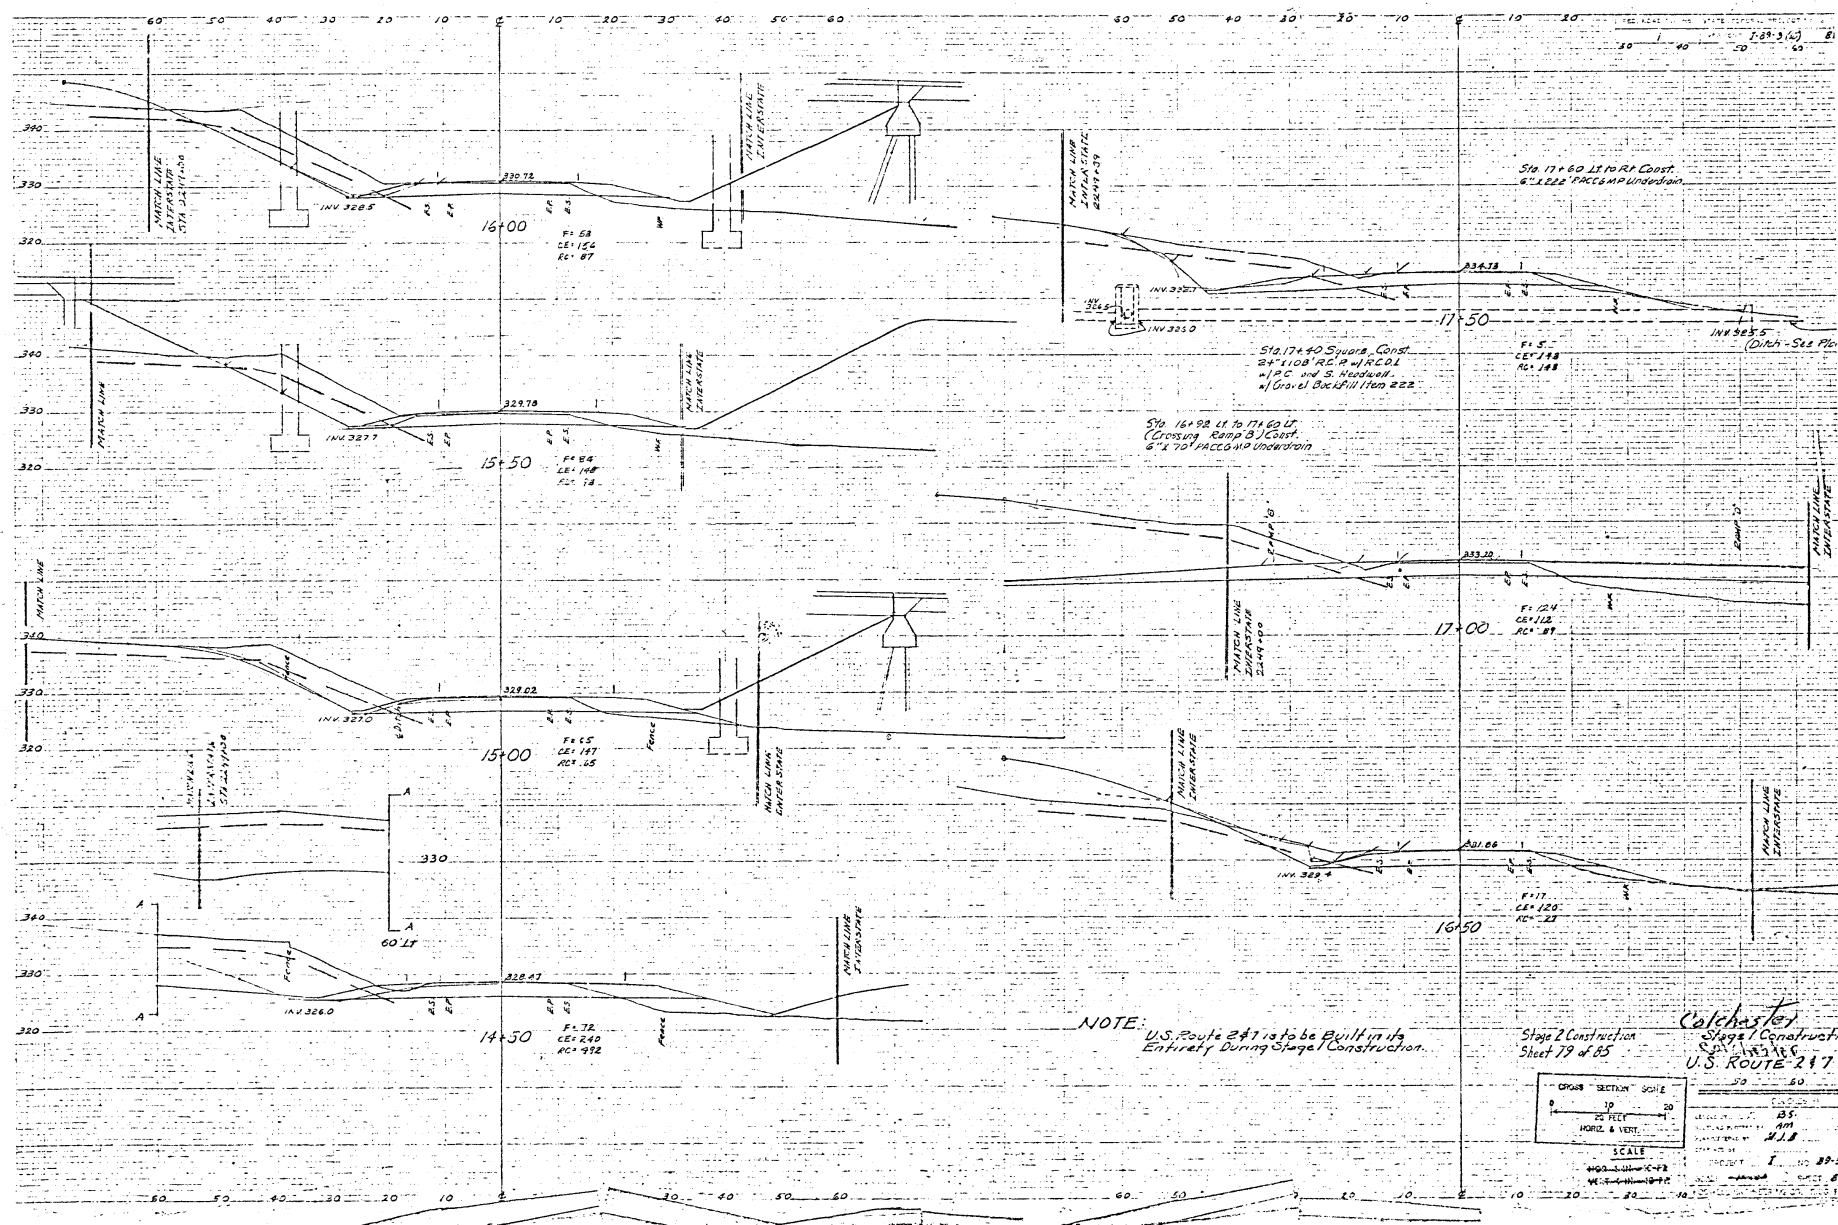

NOTE
U.S. Route 247 is to be Built in its
Entirety During Stage 1 Construction.

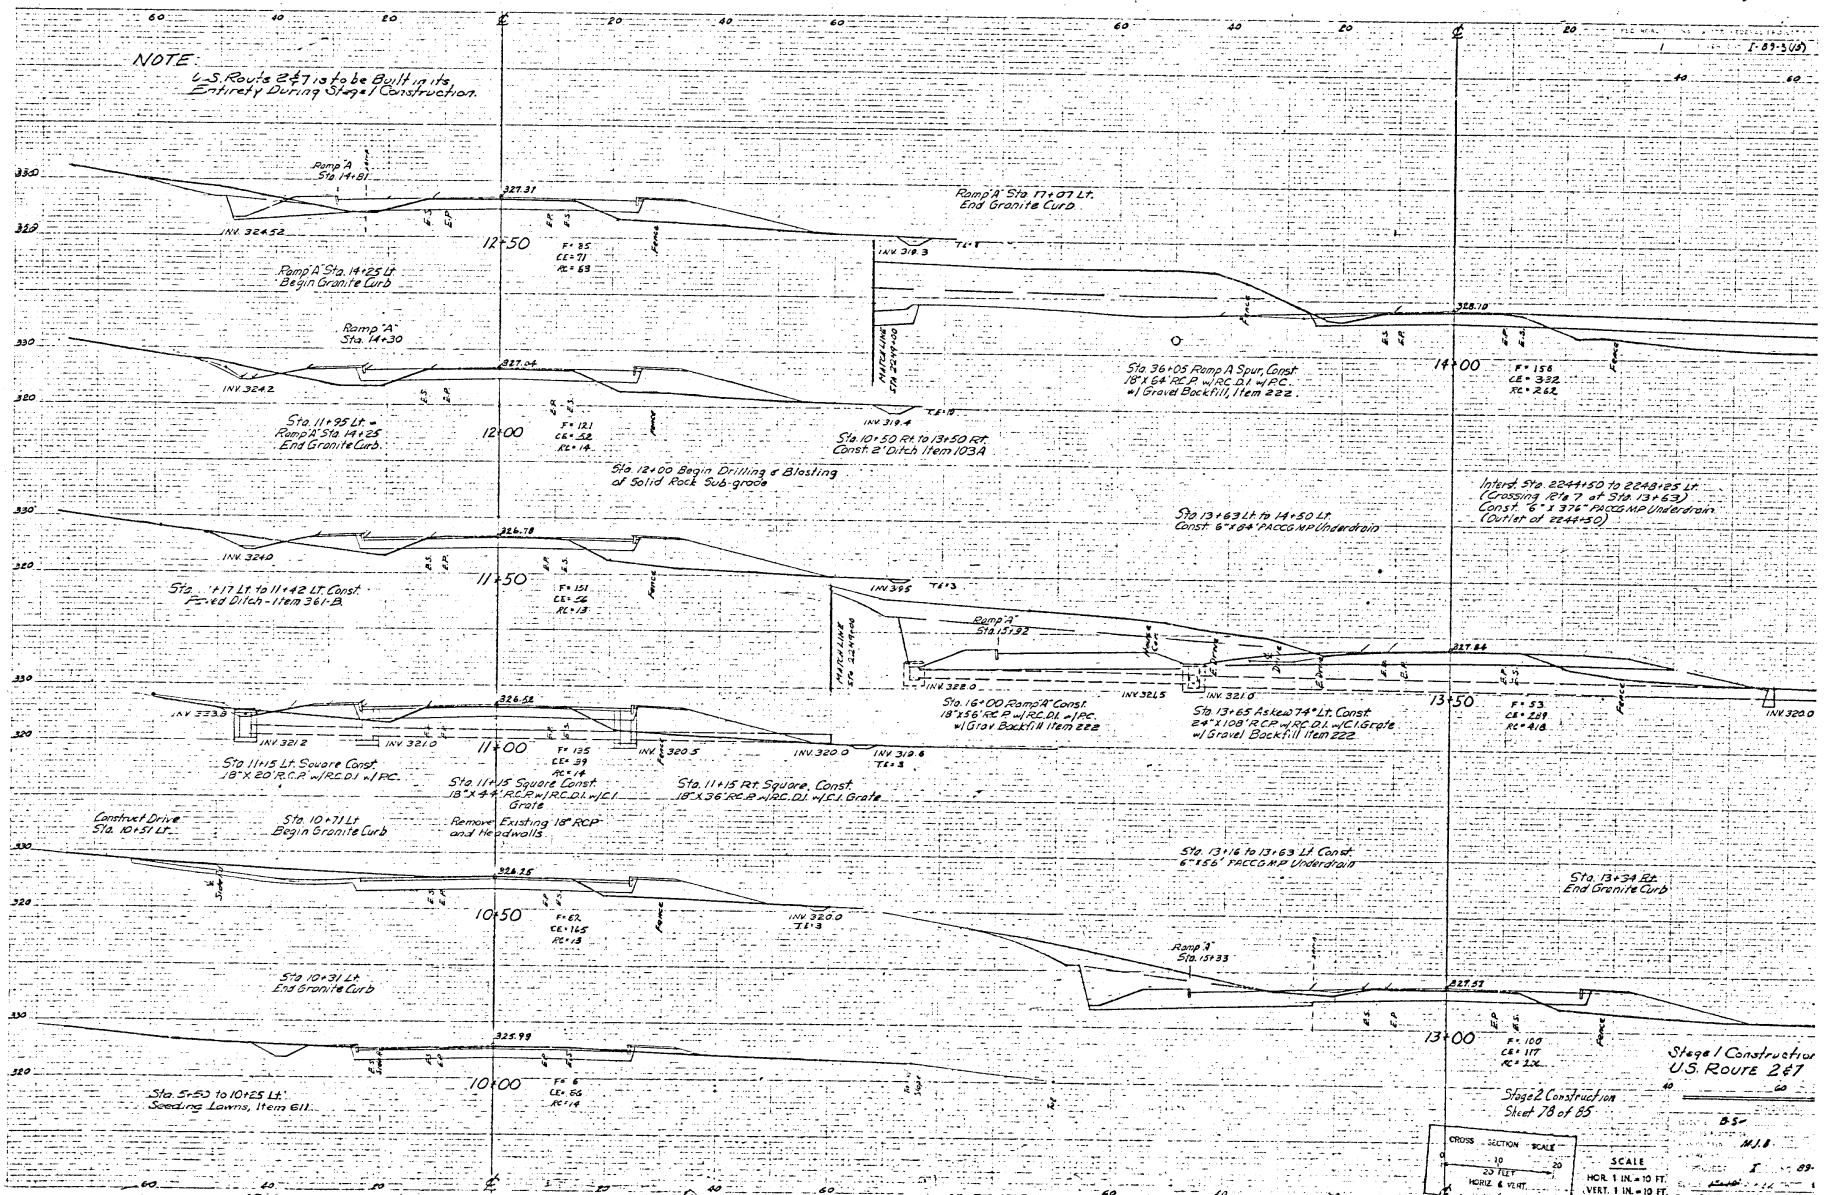

THE FOLLOWING PERCENTAGES, TO BE USED AT ALL TIMES:

PERCENTAGE	RATE OF APPLICATION
100%	800 LBS/ACRE

FERTILIZER SHALL BE DELIVERED IN BAGS OF NOT TO EXCEED 800 LBS EACH

SEEDING FORMULA

SEEDING METHOD	SEEDS PER ACRE	% BT. SEEDS	% PURITY	RATE OF BROADCAST
DRYING AND FERTILIZER	15 LBS/ACRE	27.5	82	55 LBS/ACRE
DRYING AND FERTILIZER	15 LBS/ACRE	27.5	77	40
DRYING AND FERTILIZER	15 LBS/ACRE	27.5	80	46
DRYING AND FERTILIZER	15 LBS/ACRE	27.5	80	46
DRYING AND FERTILIZER	15 LBS/ACRE	27.5	80	46

NO LBS. OF WATER PER ACRE, TO BE ADDED TO THIS MIXTURE, IF DIRECTED BY THE ENGINEER

MULCH, ITEM 822, TO BE PLACED ON ALL EARTH SLOPES (1 LB. TON PER ACRE)

STEEL MARKER POSTS, ITEM 844-D, TO BE PLACED AS DIRECTED BY THE ENGINEER

FOR DRILLING AND BLASTING OF SOLID ROCK SUBGRADE, SEE SHEET A-61

FOR FOUNDATION OF SLOPES, SEE SHEET B-5



INTERSTATE TYPICAL SECTIONS

3" BITUMINOUS CONCRETE PAVEMENT, ITEM 361-B MOD. ($\pm 1/4"$)
 2-2 1/2" PENETRATION MACADAM CRUSHED STONE BASE COURSE, ITEM 215 ($\pm 1/2"$ FOR TOTAL THICKNESS)
 24" SUB-BASE OF CRUSHED ROCK, ITEM 204 MOD ($\pm 1"$)
 3" CRUSHED STONE SHOULDERS, ITEM 303 DOUBLE EACH COAT OF BITUMINOUS MATERIAL WITH PEA STONE AND STONE BRITS SEE.
 PRIME COAT OF REFINED TAR AND DOUBLE SEAL COAT OF CUTBACK ASPHALT, ITEM 318 MOD.
 SUB-BASE OF GRAVEL, ITEM 201-A, MOD.

THESE ITEMS ARE NOT PART OF
 STAGE 1 CONSTRUCTION

PERMISSIBLE TOLERANCES IN PARENTHESIS
 APPLY TO THICKNESS ONLY.

STAGE 1 CONSTRUCTED AS DESIGNED AS

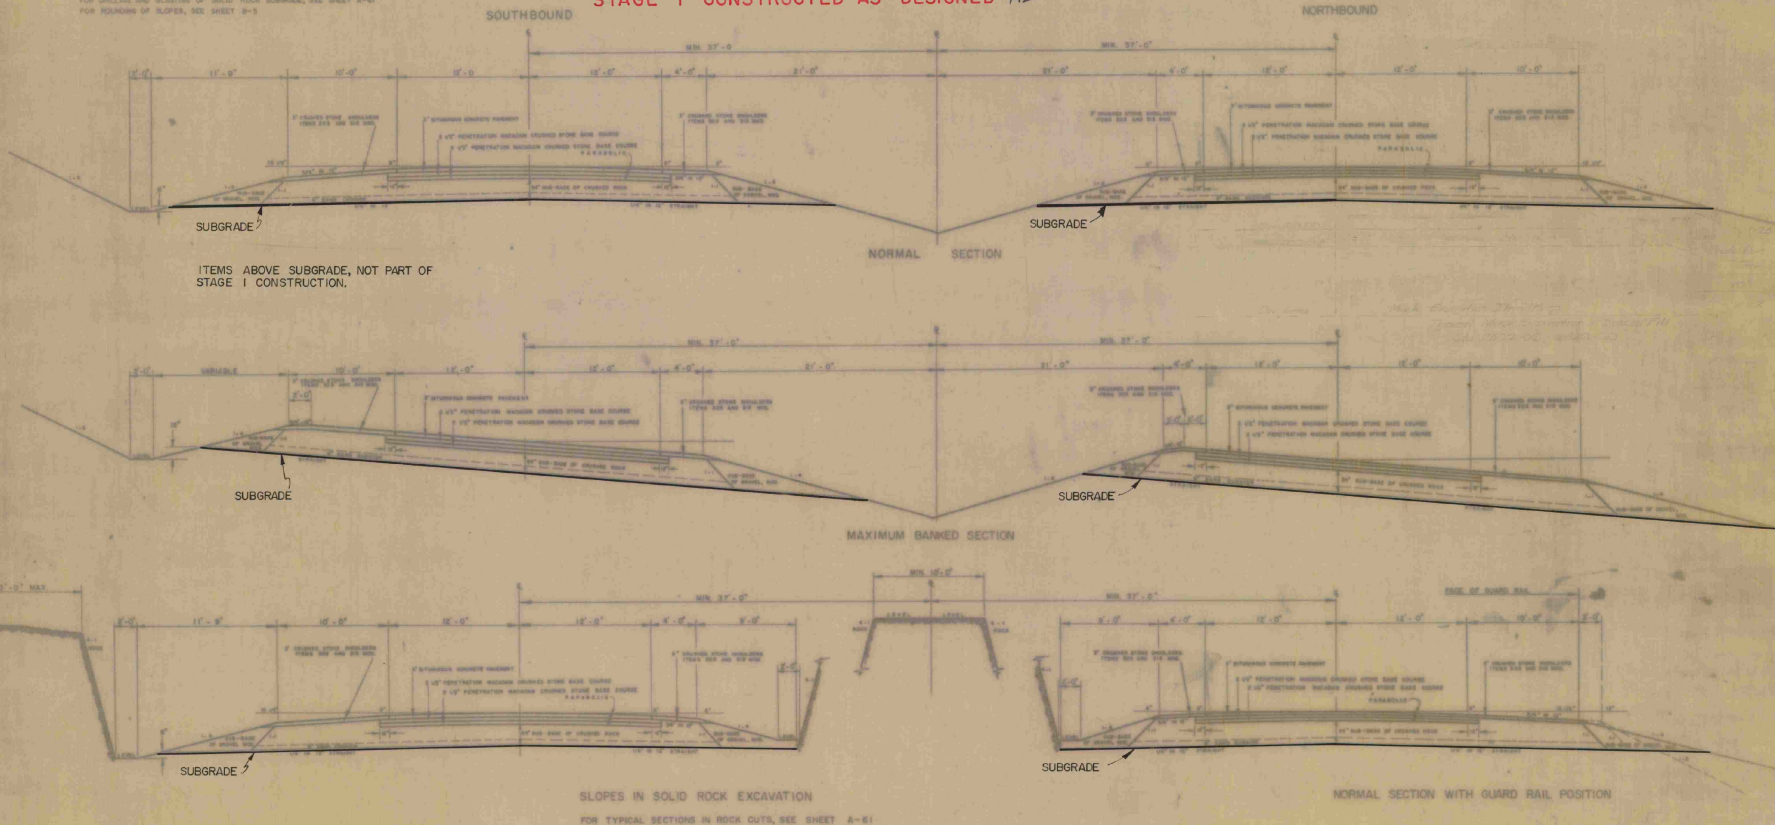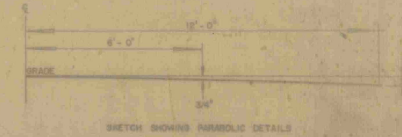

SLOPES IN SOLID ROCK EXCAVATION
 FOR TYPICAL SECTIONS IN ROCK CUTS, SEE SHEET A-61

STAGE 1 CONSTRUCTION
 COLCHESTER


INTERSTATE TYPICAL SECTIONS

THESE ITEMS ARE NOT PART
OF STAGE I CONSTRUCTION


- 3" BITUMINOUS CONCRETE PAVEMENT, ITEM 361-B, MODIFIED ($\pm 1/4"$)
- 2 - 2 1/2" PENETRATION MACADAM CRUSHED STONE BASE COURSE, ITEM 215 ($\pm 1/2"$ FOR TOTAL THICKNESS)
- 24" SUB-BASE OF CRUSHED ROCK, ITEM 204, MODIFIED ($\pm 1"$)
- 3" CRUSHED STONE SHOULDERS, ITEM 303
- SUB-BASE OF GRAVEL, ITEM 201-A, MODIFIED

PERMISSIBLE TOLERANCES IN PARENTHESES
APPLY TO THICKNESS ONLY...

STAGE I CONSTRUCTED AS DESIGNED **AS**

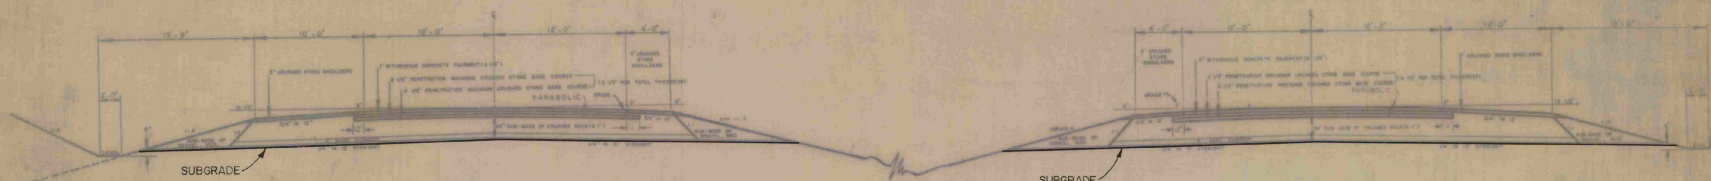

NORMAL SECTION
WITH VARIABLE MEDIAN

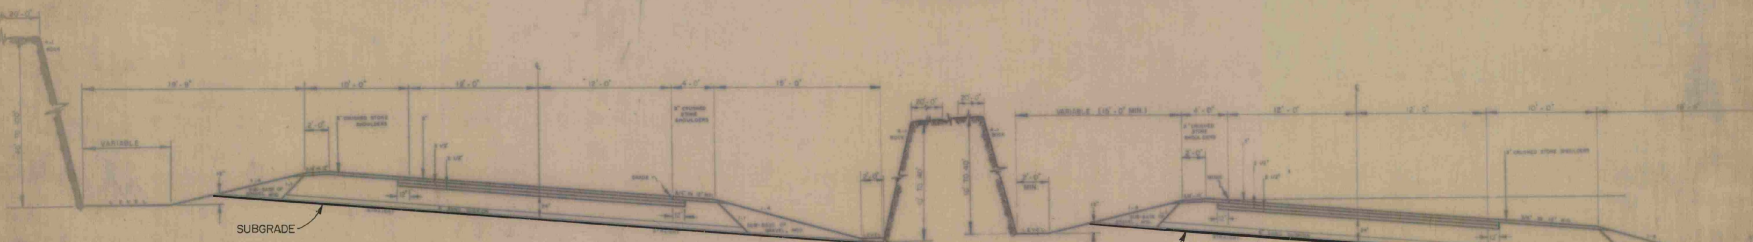


BANKED SECTION
(IN SOLID ROCK)
WITH VARIABLE MEDIAN

FOR SOLID ROCK EXCAVATION
SEE STANDARD SHEET A-81



MAXIMUM BANKED SECTION

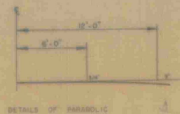

DETAILS OF PARABOLIC


GENERAL NOTES

1. THESE SECTIONS SHALL BE CONSIDERED AS MINIMUM REQUIREMENTS. THE CONTRACTOR SHALL BE RESPONSIBLE FOR THE DESIGN OF THE ROADWAY. THE CONTRACTOR SHALL BE RESPONSIBLE FOR THE DESIGN OF THE ROADWAY. THE CONTRACTOR SHALL BE RESPONSIBLE FOR THE DESIGN OF THE ROADWAY.


STAGE I CONSTRUCTION
COLCHESTER

TYPICAL SECTIONS

STAGE I CONSTRUCTED AS DESIGNED ~~AB~~

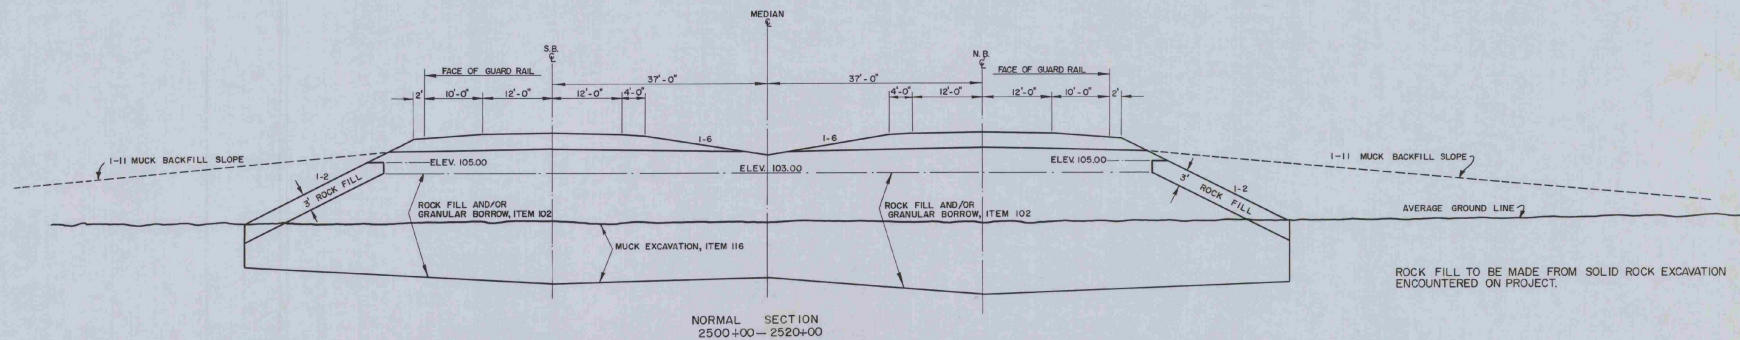

TYPICAL SECTION FOR TOWN ROAD #16
16" SUB-BASE OF GRAVEL, ITEM 201-A

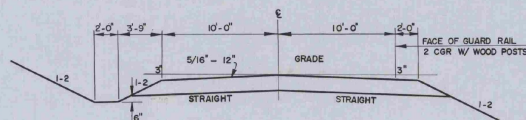

TOWN ROAD #16 TO BE BUILT IN ITS ENTIRETY
DURING STAGE I CONSTRUCTION

COLCHESTER (MUNSONS FLAT)

DRAWN BY: F. EVANS 1/63
TRACED: A.J.A.

PROJ. I NO. 89-1 (19) CONTRACT # 3

SHEET 5 OF 236

DRAINAGE STRUCTURES

STATE OF VERMONT
DEPARTMENT OF HIGHWAYS

FED. ROAD DIVISION NO.	STATE	PROJECT NO.	FISCAL YEAR	SHEET NO.	TOTAL SHEETS
1	VT		POST WAR		

[illegible]

STATE OF VERMONT
DEPARTMENT OF HIGHWAYS

FED. ROAD DIVISION NO.	STATE	PROJECT NO.	FISCAL YEAR	SHEET NO.	TOTAL SHEET
1	VT.		POST WAR		

[illegible]

STATE OF VERMONT
DEPARTMENT OF HIGHWAYS

FED. ROAD DIVISION NO.	STATE	PROJECT NO.	FISCAL YEAR	SHEET NO.	TOTAL SHEETS
1	VT		POST 1969		

		GRADES				EMBANKMENT				ROCK				MUCK						GRADES				EMBANKMENT				ROCK				EMBANKMENT						GRADES				EMBANKMENT				ROCK				EMBANKMENT						GRADES				EMBANKMENT				ROCK	
--	--	--------	--	--	--	------------	--	--	--	------	--	--	--	------	--	--	--	--	--	--------	--	--	--	------------	--	--	--	------	--	--	--	------------	--	--	--	--	--	--------	--	--	--	------------	--	--	--	------	--	--	--	------------	--	--	--	--	--	--------	--	--	--	------------	--	--	--	------	--	--	--	------------	--	--	--	--	--	--------	--	--	--	------------	--	--	--	------	--	--	--	------------	--	--	--	--	--	--------	--	--	--	------------	--	--	--	------	--	--	--	------------	--	--	--	--	--	--------	--	--	--	------------	--	--	--	------	--	--	--	------------	--	--	--	--	--	--------	--	--	--	------------	--	--	--	------	--	--	--	------------	--	--	--	--	--	--------	--	--	--	------------	--	--	--	------	--	--	--	------------	--	--	--	--	--	--------	--	--	--	------------	--	--	--	------	--	--	--	------------	--	--	--	--	--	--------	--	--	--	------------	--	--	--	------	--	--	--	------------	--	--	--	--	--	--------	--	--	--	------------	--	--	--	------	--	--	--	------------	--	--	--	--	--	--------	--	--	--	------------	--	--	--	------	--	--	--	------------	--	--	--	--	--	--------	--	--	--	------------	--	--	--	------	--	--	--	------------	--	--	--	--	--	--------	--	--	--	------------	--	--	--	------	--	--	--	------------	--	--	--	--	--	--------	--	--	--	------------	--	--	--	------	--	--	--	------------	--	--	--	--	--	--------	--	--	--	------------	--	--	--	------	--	--	--	------------	--	--	--	--	--	--------	--	--	--	------------	--	--	--	------	--	--	--	------------	--	--	--	--	--	--------	--	--	--	------------	--	--	--	------	--	--	--	------------	--	--	--	--	--	--------	--	--	--	------------	--	--	--	------	--	--	--	------------	--	--	--	--	--	--------	--	--	--	------------	--	--	--	------	--	--	--	------------	--	--	--	--	--	--------	--	--	--	------------	--	--	--	------	--	--	--	------------	--	--	--	--	--	--------	--	--	--	------------	--	--	--	------	--	--	--	------------	--	--	--	--	--	--------	--	--	--	------------	--	--	--	------	--	--	--	------------	--	--	--	--	--	--------	--	--	--	------------	--	--	--	------	--	--	--	------------	--	--	--	--	--	--------	--	--	--	------------	--	--	--	------	--	--	--	------------	--	--	--	--	--	--------	--	--	--	------------	--	--	--	------	--	--	--	------------	--	--	--	--	--	--------	--	--	--	------------	--	--	--	------	--	--	--	------------	--	--	--	--	--	--------	--	--	--	------------	--	--	--	------	--	--	--	------------	--	--	--	--	--	--------	--	--	--	------------	--	--	--	------	--	--	--	------------	--	--	--	--	--	--------	--	--	--	------------	--	--	--	------	--	--	--	------------	--	--	--	--	--	--------	--	--	--	------------	--	--	--	------	--	--	--	------------	--	--	--	--	--	--------	--	--	--	------------	--	--	--	------	--	--	--	------------	--	--	--	--	--	--------	--	--	--	------------	--	--	--	------	--	--	--	------------	--	--	--	--	--	--------	--	--	--	------------	--	--	--	------	--	--	--	------------	--	--	--	--	--	--------	--	--	--	------------	--	--	--	------	--	--	--	------------	--	--	--	--	--	--------	--	--	--	------------	--	--	--	------	--	--	--	------------	--	--	--	--	--	--------	--	--	--	------------	--	--	--	------	--	--	--	------------	--	--	--	--	--	--------	--	--	--	------------	--	--	--	------	--	--	--	------------	--	--	--	--	--	--------	--	--	--	------------	--	--	--	------	--	--	--	------------	--	--	--	--	--	--------	--	--	--	------------	--	--	--	------	--	--	--	------------	--	--	--	--	--	--------	--	--	--	------------	--	--	--	------	--	--	--	------------	--	--	--	--	--	--------	--	--	--	------------	--	--	--	------	--	--	--	------------	--	--	--	--	--	--------	--	--	--	------------	--	--	--	------	--	--	--	------------	--	--	--	--	--	--------	--	--	--	------------	--	--	--	------	--	--	--	------------	--	--	--	--	--	--------	--	--	--	------------	--	--	--	------	--	--	--	------------	--	--	--	--	--	--------	--	--	--	------------	--	--	--	------	--	--	--	------------	--	--	--	--	--	--------	--	--	--	------------	--	--	--	------	--	--	--	------------	--	--	--	--	--	--------	--	--	--	------------	--	--	--	------	--	--	--	------------	--	--	--	--	--	--------	--	--	--	------------	--	--	--	------	--	--	--	------------	--	--	--	--	--	--------	--	--	--	------------	--	--	--	------	--	--	--	------------	--	--	--	--	--	--------	--	--	--	------------	--	--	--	------	--	--	--	------------	--	--	--	--	--	--------	--	--	--	------------	--	--	--	------	--	--	--	------------	--	--	--	--	--	--------	--	--	--	------------	--	--	--	------	--	--	--	------------	--	--	--	--	--	--------	--	--	--	------------	--	--	--	------	--	--	--	------------	--	--	--	--	--	--------	--	--	--	------------	--	--	--	------	--	--	--	------------	--	--	--	--	--	--------	--	--	--	------------	--	--	--	------	--	--	--	------------	--	--	--	--	--	--------	--	--	--	------------	--	--	--	------	--	--	--	------------	--	--	--	--	--	--------	--	--	--	------------	--	--	--	------	--	--	--	------------	--	--	--	--	--	--------	--	--	--	------------	--	--	--	------	--	--	--	------------	--	--	--	--	--	--------	--	--	--	------------	--	--	--	------	--	--	--	------------	--	--	--	--	--	--------	--	--	--	------------	--	--	--	------	--	--	--	------------	--	--	--	--	--	--------	--	--	--	------------	--	--	--	------	--	--	--	------------	--	--	--	--	--	--------	--	--	--	------------	--	--	--	------	--	--	--	------------	--	--	--	--	--	--------	--	--	--	------------	--	--	--	------	--	--	--	------------	--	--	--	--	--	--------	--	--	--	------------	--	--	--	------	--

SUMMARY BY COLUMNS

VOLUME 11, NUMBER 7, 1997, 709-716

STATE OF VERMONT
DEPARTMENT OF HIGHWAYS

STATE OF VERMONT
DEPARTMENT OF HIGHWAYS

FINAL EARTHWORK SHEET

STATE OF VERMONT
DEPARTMENT OF HIGHWAYS

FINAL EARTHWORK SHEET

STATE OF VERMONT
DEPARTMENT OF HIGHWAYS

PARCEL : 24A STA 2527180-2530170
 GRANTOR : ROGER E. DOROTHY H. CURTIS
 TACKING : WALLETS BAY CAMPERS ASSN
 RIGHTS : 0.3A L.A. REM
 : CAMP ROAD R.O.W.
 TITLE TAKEN : COND 10/26/62
 RECORDED : COLCHESTER BK 12 PG 339-79 DT 11/3/62

PARCEL : 24F STA 2527180-2530170
 GRANTOR : J. SETH & BARBARA EBERHARDT
 TACKING : 0.3A L.A. REM
 RIGHTS : CAMP ROAD R.O.W.
 TITLE TAKEN : COND 10/26/62
 RECORDED : COLCHESTER BK 12 PG 339-79 DT 11/3/62

PARCEL : 24B STA 2527180-2530170
 GRANTOR : JOSEPH A. BEAULIEU
 TACKING : 0.3A L.A. REM
 RIGHTS : CAMP ROAD R.O.W.
 TITLE TAKEN : COND 10/26/62
 RECORDED : COLCHESTER BK 12 PG 339-79 DT 11/3/62

PARCEL : 24G STA 2527180-2530170
 GRANTOR : LA. RICHARD & HELEN E. EVANS
 TACKING : 0.3A L.A. REM
 RIGHTS : CAMP ROAD R.O.W.
 TITLE TAKEN : COND 10/26/62
 RECORDED : COLCHESTER BK 12 PG 339-79 DT 11/3/62

PARCEL : 24K STA 2527180-2530170
 GRANTOR : ERNEST ST. JACQUES
 TACKING : 0.3A L.A. REM
 RIGHTS : CAMP ROAD R.O.W.
 TITLE TAKEN : COND 10/26/62
 RECORDED : COLCHESTER BK 12 PG 339-79 DT 11/3/62

PARCEL : 24C STA 2527180-2530170
 GRANTOR : C. BEGOND - NORA BURNS
 TACKING : 0.3A L.A. REM
 RIGHTS : CAMP ROAD R.O.W.
 TITLE TAKEN : COND 10/26/62
 RECORDED : COLCHESTER BK 12 PG 339-79 DT 11/3/62

PARCEL : 24H STA 2527180-2530170
 GRANTOR : JOHN LA. PLANTE
 TACKING : 0.3A L.A. REM
 RIGHTS : CAMP ROAD R.O.W.
 TITLE TAKEN : COND 10/26/62
 RECORDED : COLCHESTER BK 12 PG 339-79 DT 11/3/62

PARCEL : 24L STA 2527180-2530170
 GRANTOR : FRANK & EDITH L. WENBURG
 TACKING : 0.3A L.A. REM
 RIGHTS : CAMP ROAD R.O.W.
 TITLE TAKEN : COND 10/26/62
 RECORDED : COLCHESTER BK 12 PG 339-79 DT 11/3/62

PARCEL : 24D STA 2527180-2530170
 GRANTOR : LILE G. - VIOLET M. COLBURN
 TACKING : 0.3A L.A. REM
 RIGHTS : CAMP ROAD R.O.W.
 TITLE TAKEN : COND 10/26/62
 RECORDED : COLCHESTER BK 12 PG 339-79 DT 11/3/62

PARCEL : 24I STA 2527180-2530170
 GRANTOR : ALFRED & BEVERLY MURPHY
 TACKING : 0.3A L.A. REM
 RIGHTS : CAMP ROAD R.O.W.
 TITLE TAKEN : COND 10/26/62
 RECORDED : COLCHESTER BK 12 PG 339-79 DT 11/3/62

PARCEL : 24M STA 2527180-2530170
 GRANTOR : FRANK & DORIS WIBERG
 TACKING : 0.3A L.A. REM
 RIGHTS : CAMP ROAD R.O.W.
 TITLE TAKEN : COND 10/26/62
 RECORDED : COLCHESTER BK 12 PG 339-79 DT 11/3/62

PARCEL : 24E STA 2527180-2530170
 GRANTOR : PHILIP J. & ESTHER C. DOHERTY
 TACKING : 0.3A L.A. REM
 RIGHTS : CAMP ROAD R.O.W.
 TITLE TAKEN : COND 10/26/62
 RECORDED : COLCHESTER BK 12 PG 339-79 DT 11/3/62

PARCEL : 24J STA 2527180-2530170
 GRANTOR : GEORGE A. & AGNES E. SPRES
 TACKING : 0.3A L.A. REM
 RIGHTS : CAMP ROAD R.O.W.
 TITLE TAKEN : COND 10/26/62
 RECORDED : COLCHESTER BK 12 PG 339-79 DT 11/3/62

PARCEL : 24N STA 2527180-2530170
 GRANTOR : LINUS H. & RHODA M. WILES
 TACKING : 0.3A L.A. REM
 RIGHTS : CAMP ROAD R.O.W.
 TITLE TAKEN : COND 10/26/62
 RECORDED : COLCHESTER BK 12 PG 339-79 DT 11/3/62

CONTRACT 5

COLCHESTER - ST. ALBANS
 R.O.W. SHEET 29 of 236

1-89-3 (5)

Vermont Agency of
Transportation
PHASE 1-INTERSTATE
#122302-01
INITIALS ☐
HANGER 294

Colchester
I-89-3 (19) C/3

1963
1964

*
1963 C/3
1964