


SETTING TABLE


TEMP.	DIM "A"	DIM "B"
15°F	+3/4"	+3/4"
30°F	+3/8"	+3/8"
45°F	0	0
60°F	-3/8"	-3/8"
75°F	-3/4"	-3/4"
90°F	-1"	-1"

* WORKING POINT STATION
AT 45° F.

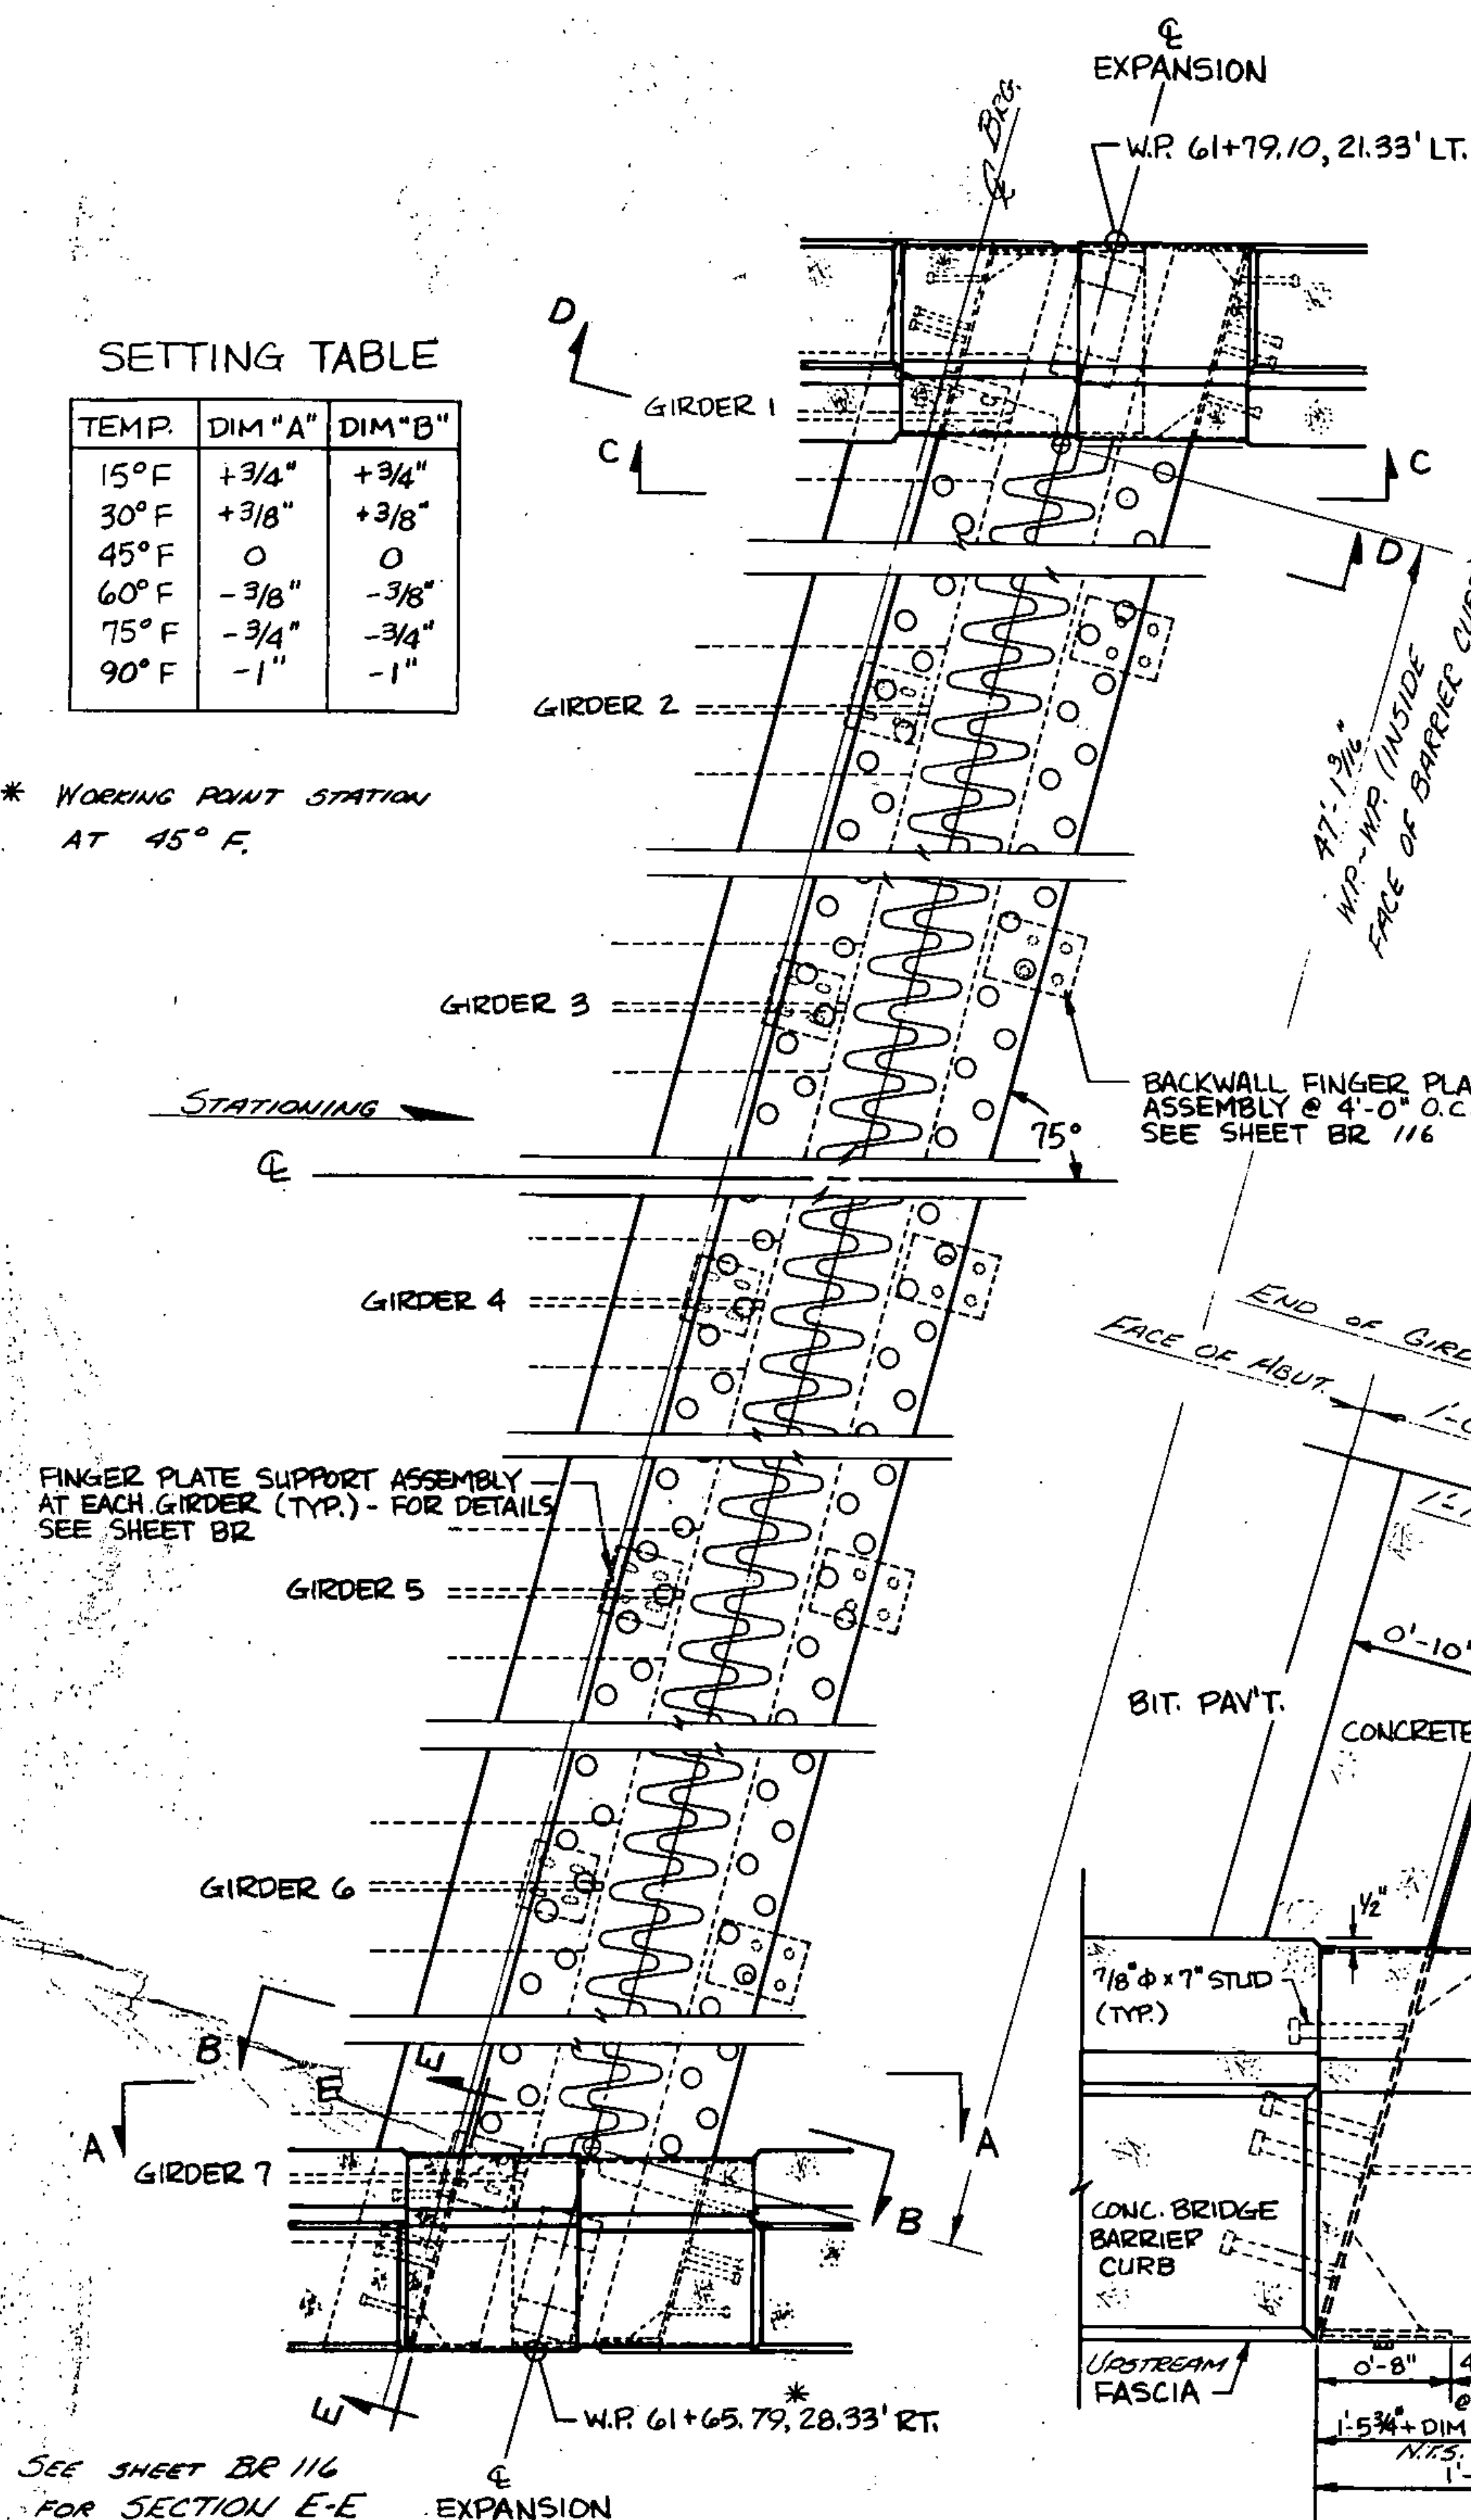


PLAN - NORMAL TO GRADE

SCALE: 3/4" = 1'-0"

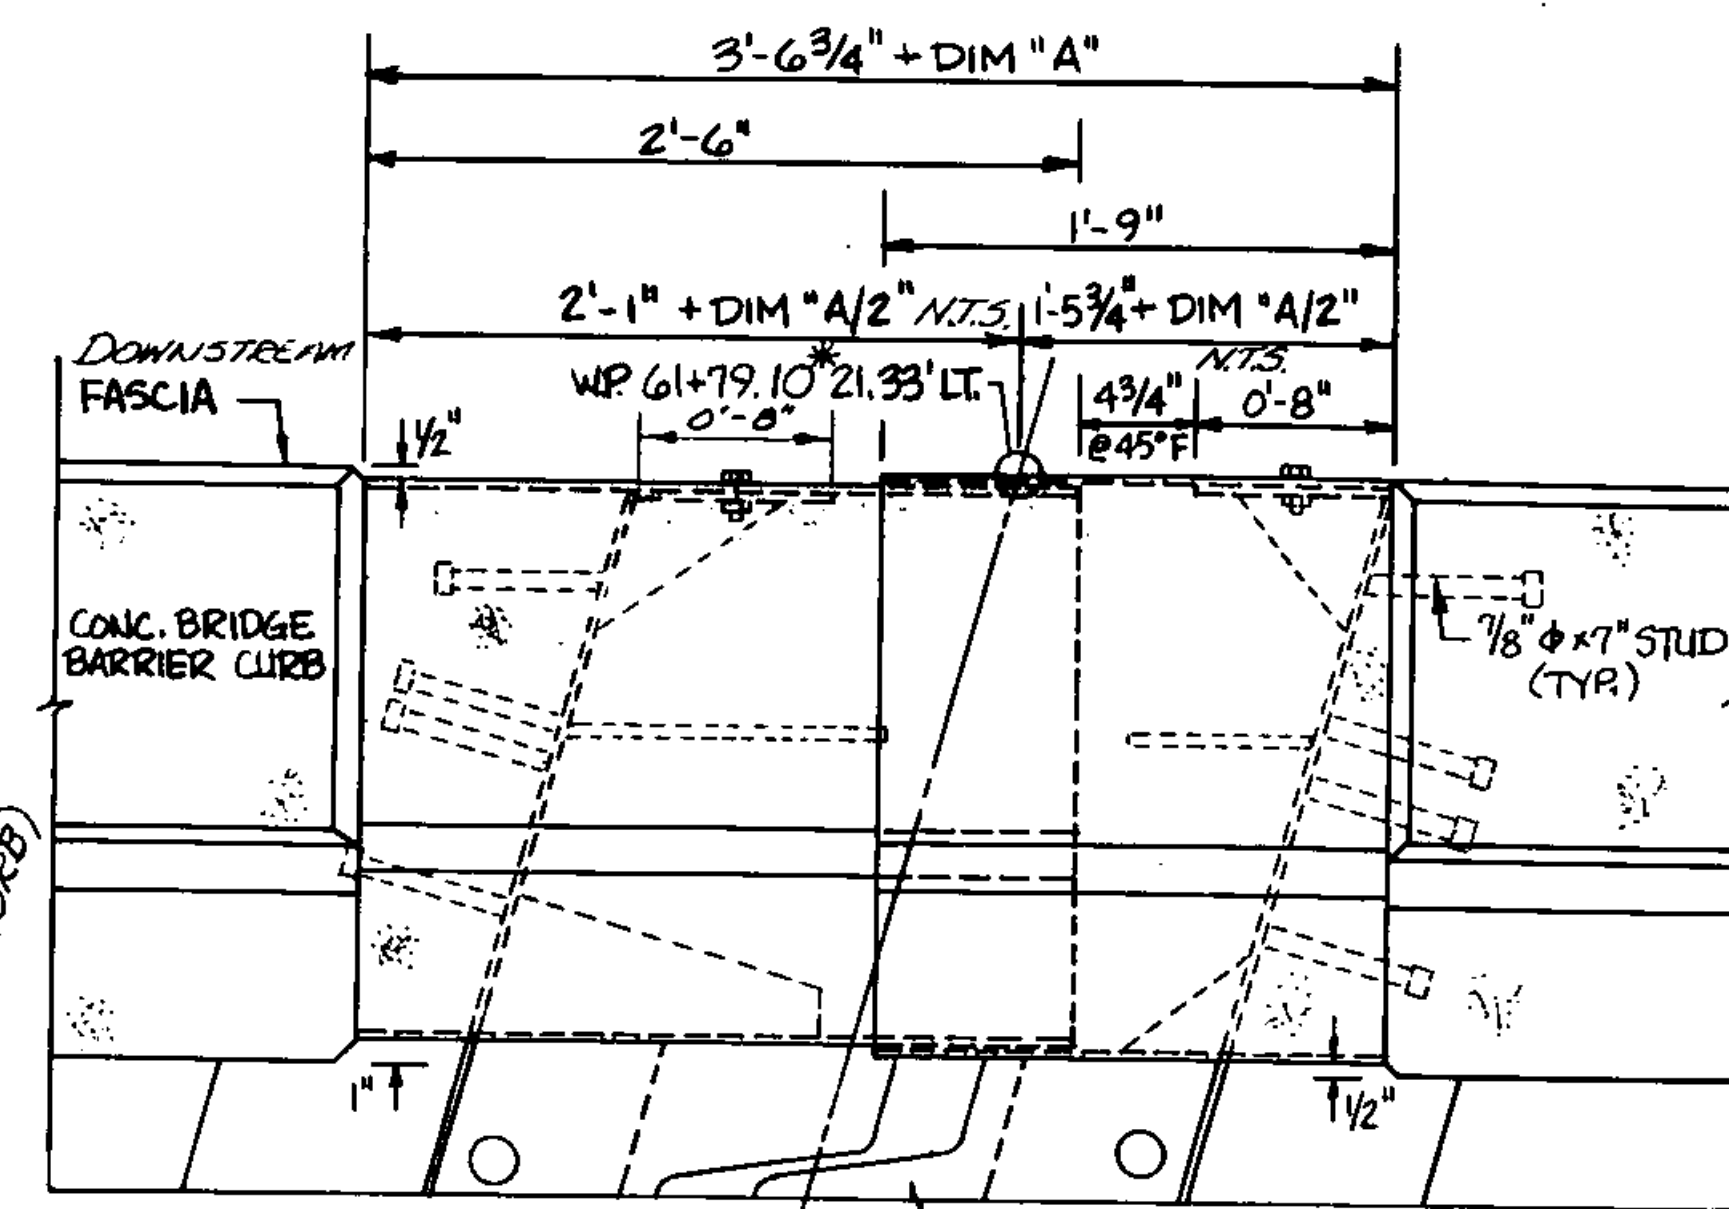


PARTIAL PLAN - NORMAL TO GRADE

SCALE: 1/2" = 1'-0"

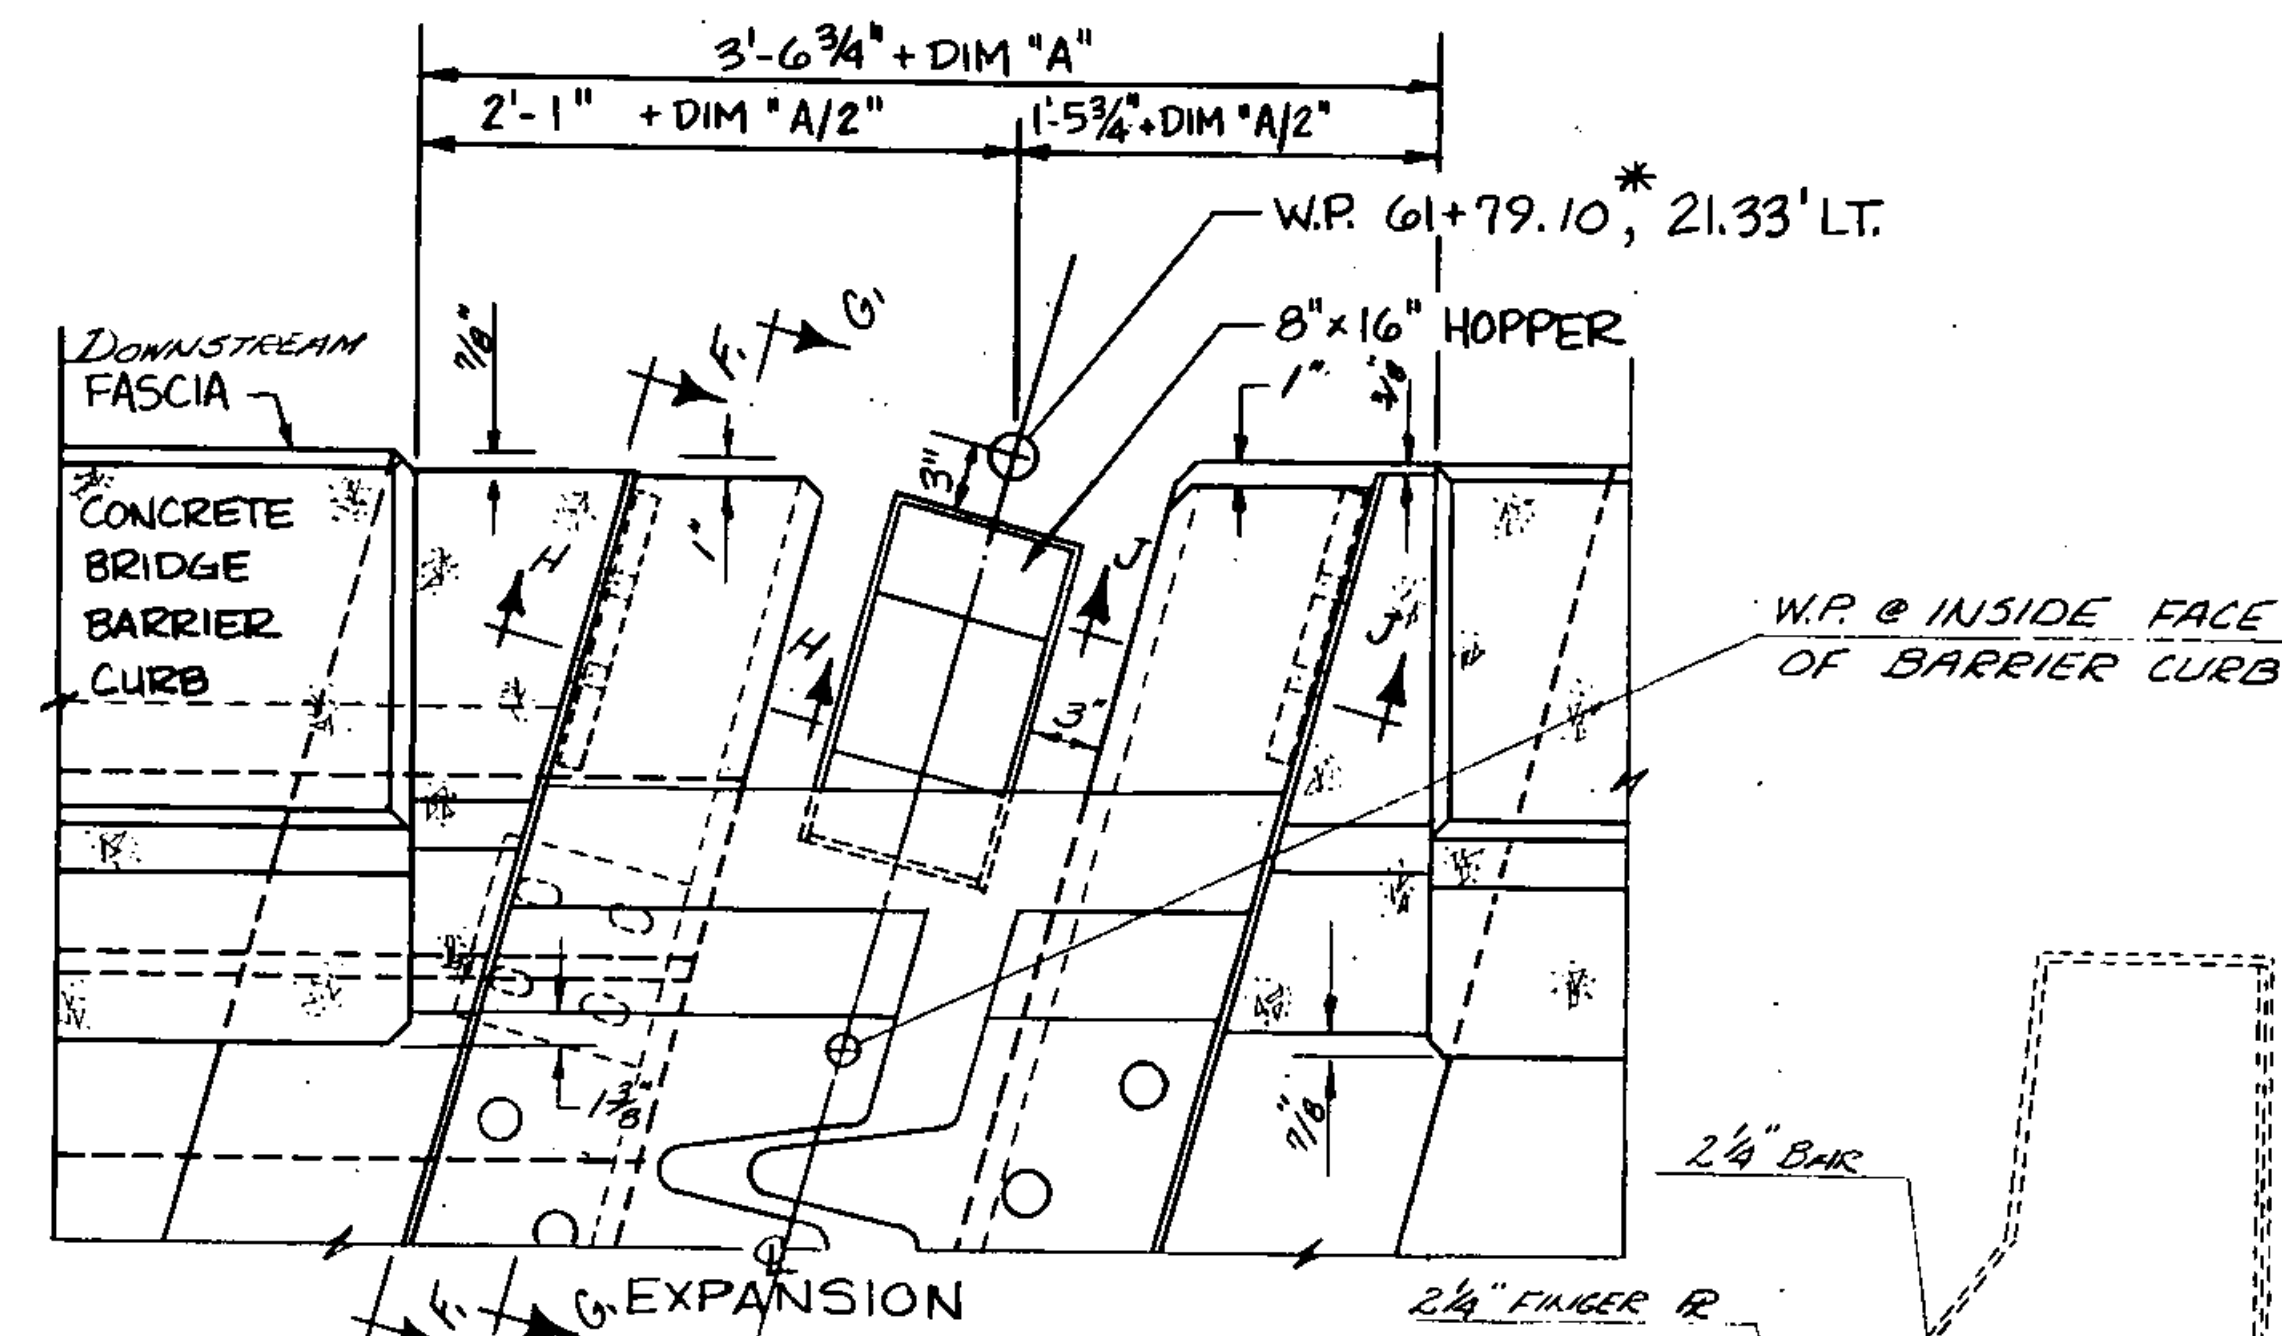


PARTIAL PLAN WITH HOUSING REMOVED

SCALE: 1/2" = 1'-0"

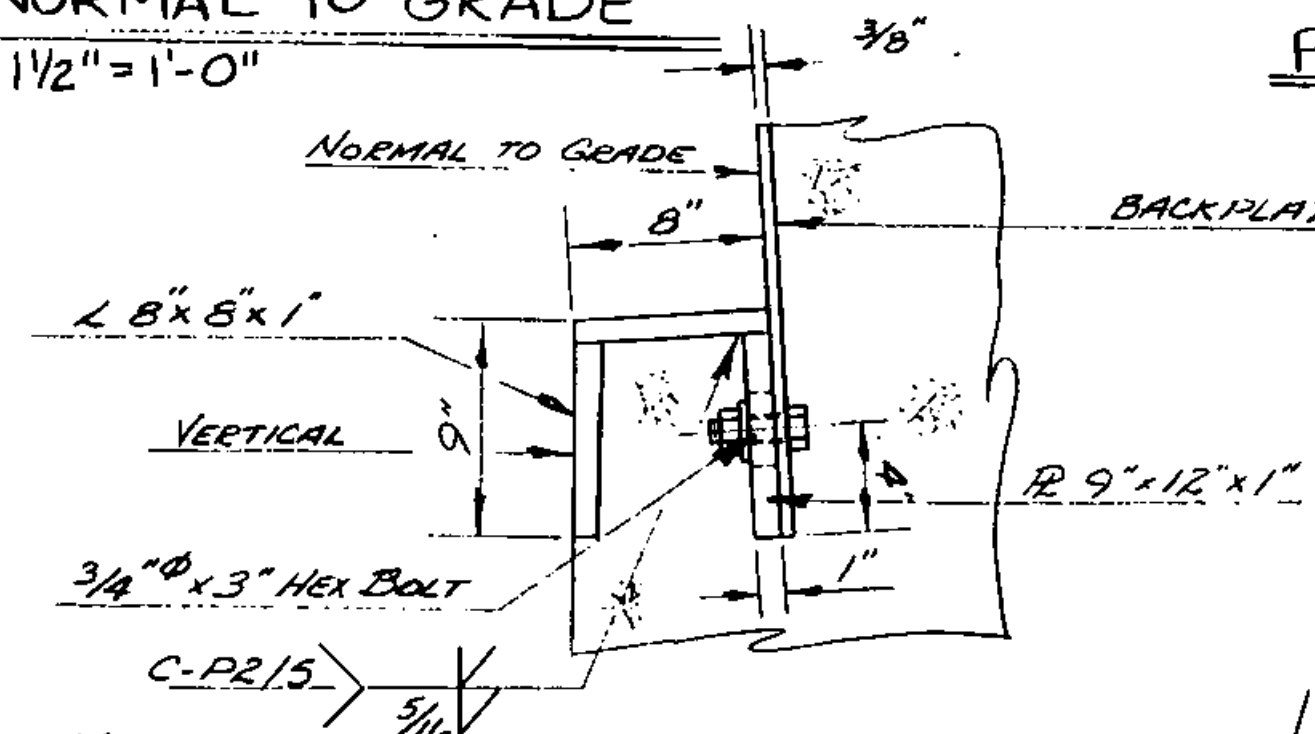


SECTION J-J

SCALE: 1/2" = 1'-0"

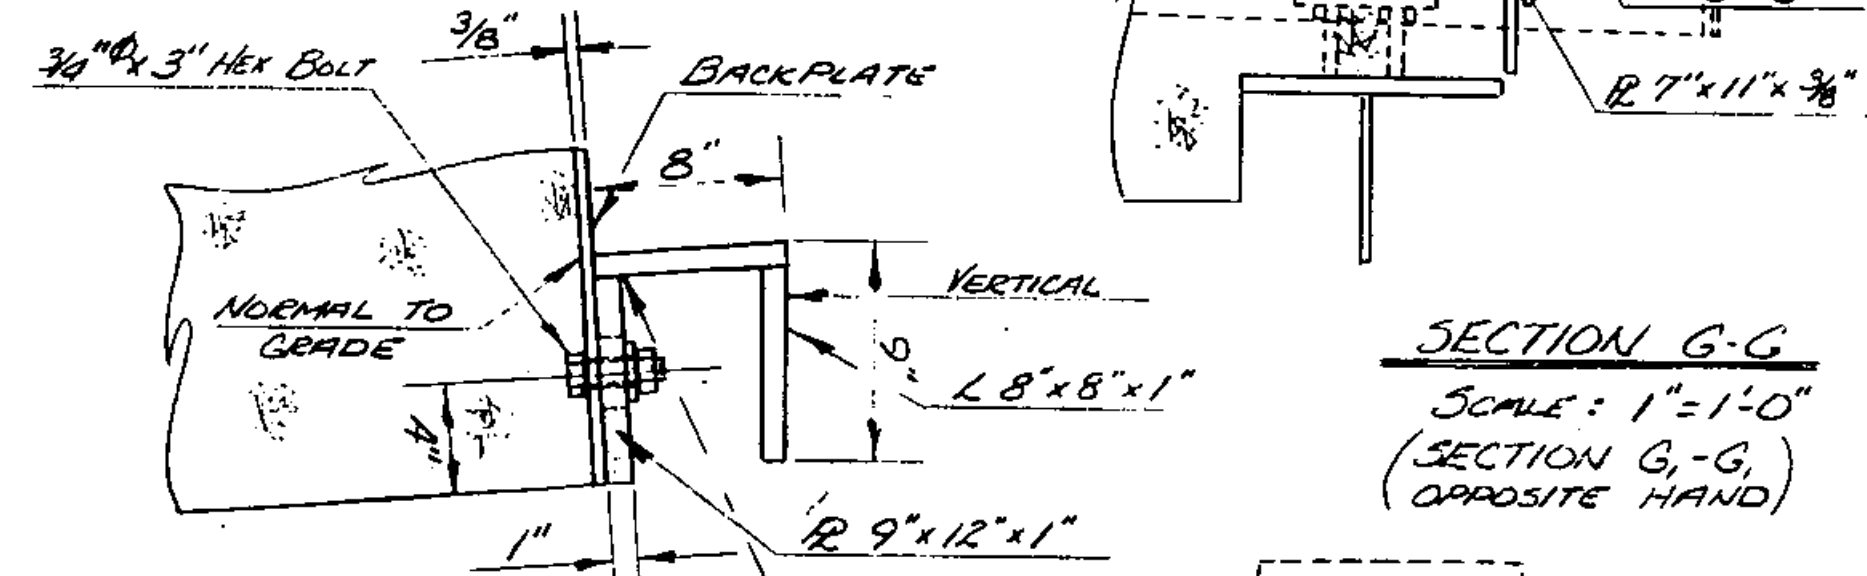


SECTION H-H

SCALE: 1/2" = 1'-0"

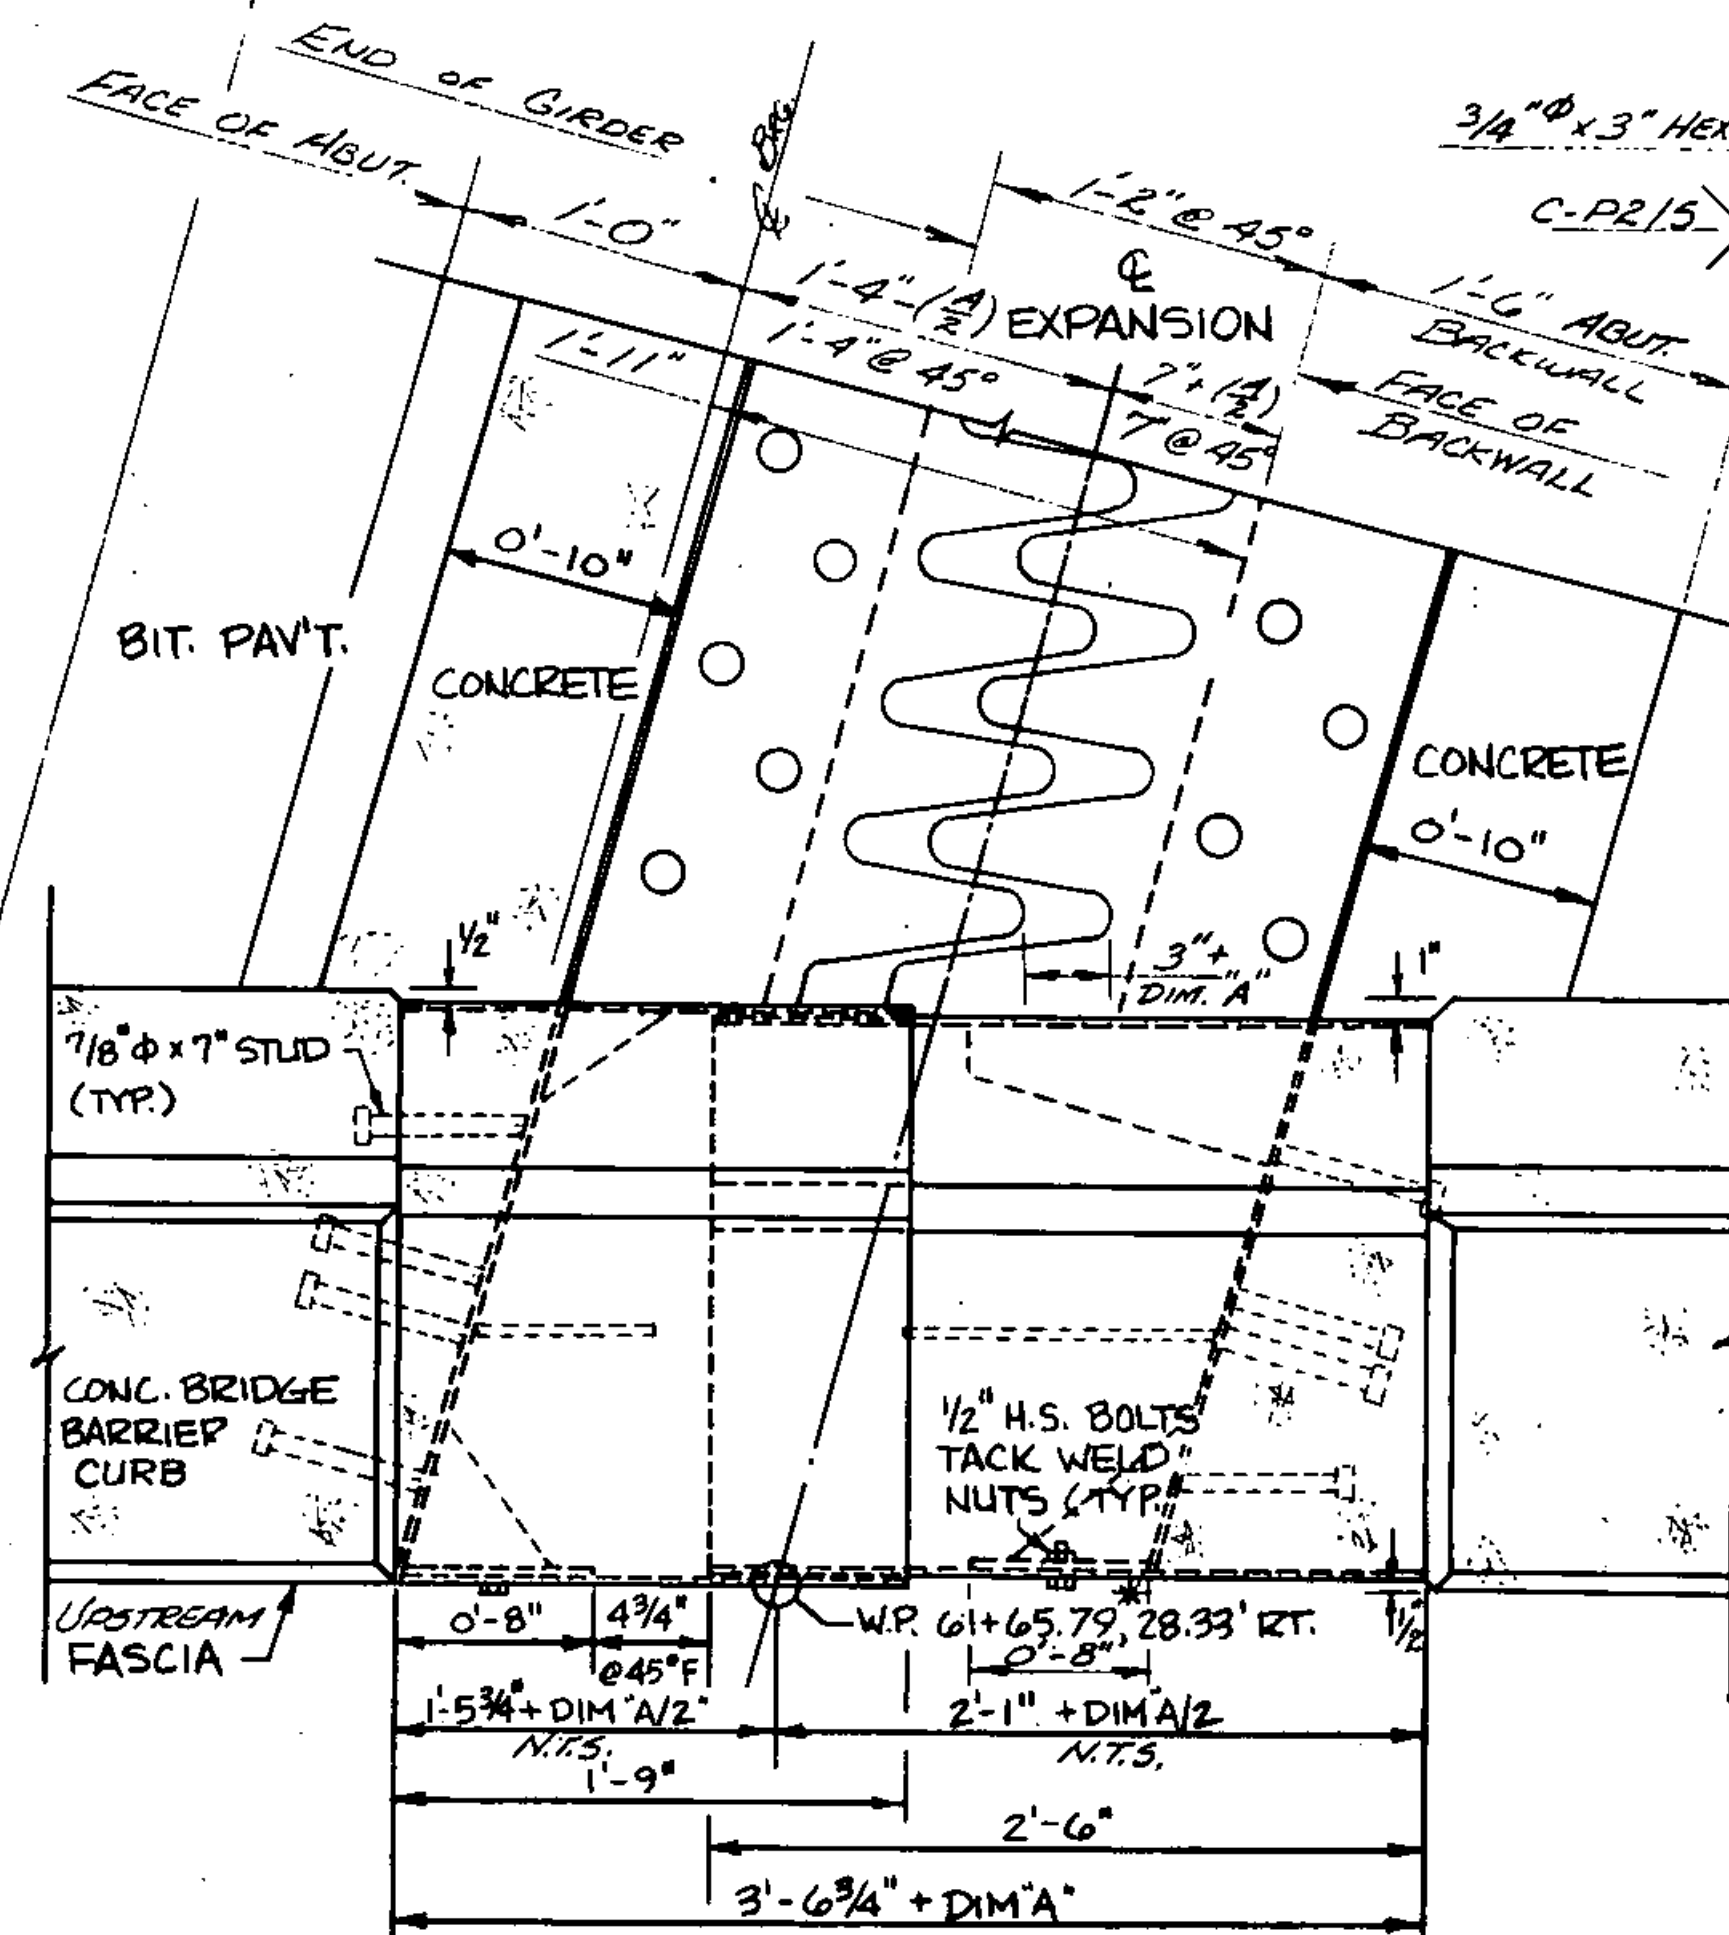


PARTIAL PLAN - NORMAL TO GRADE

SCALE: 1/2" = 1'-0"

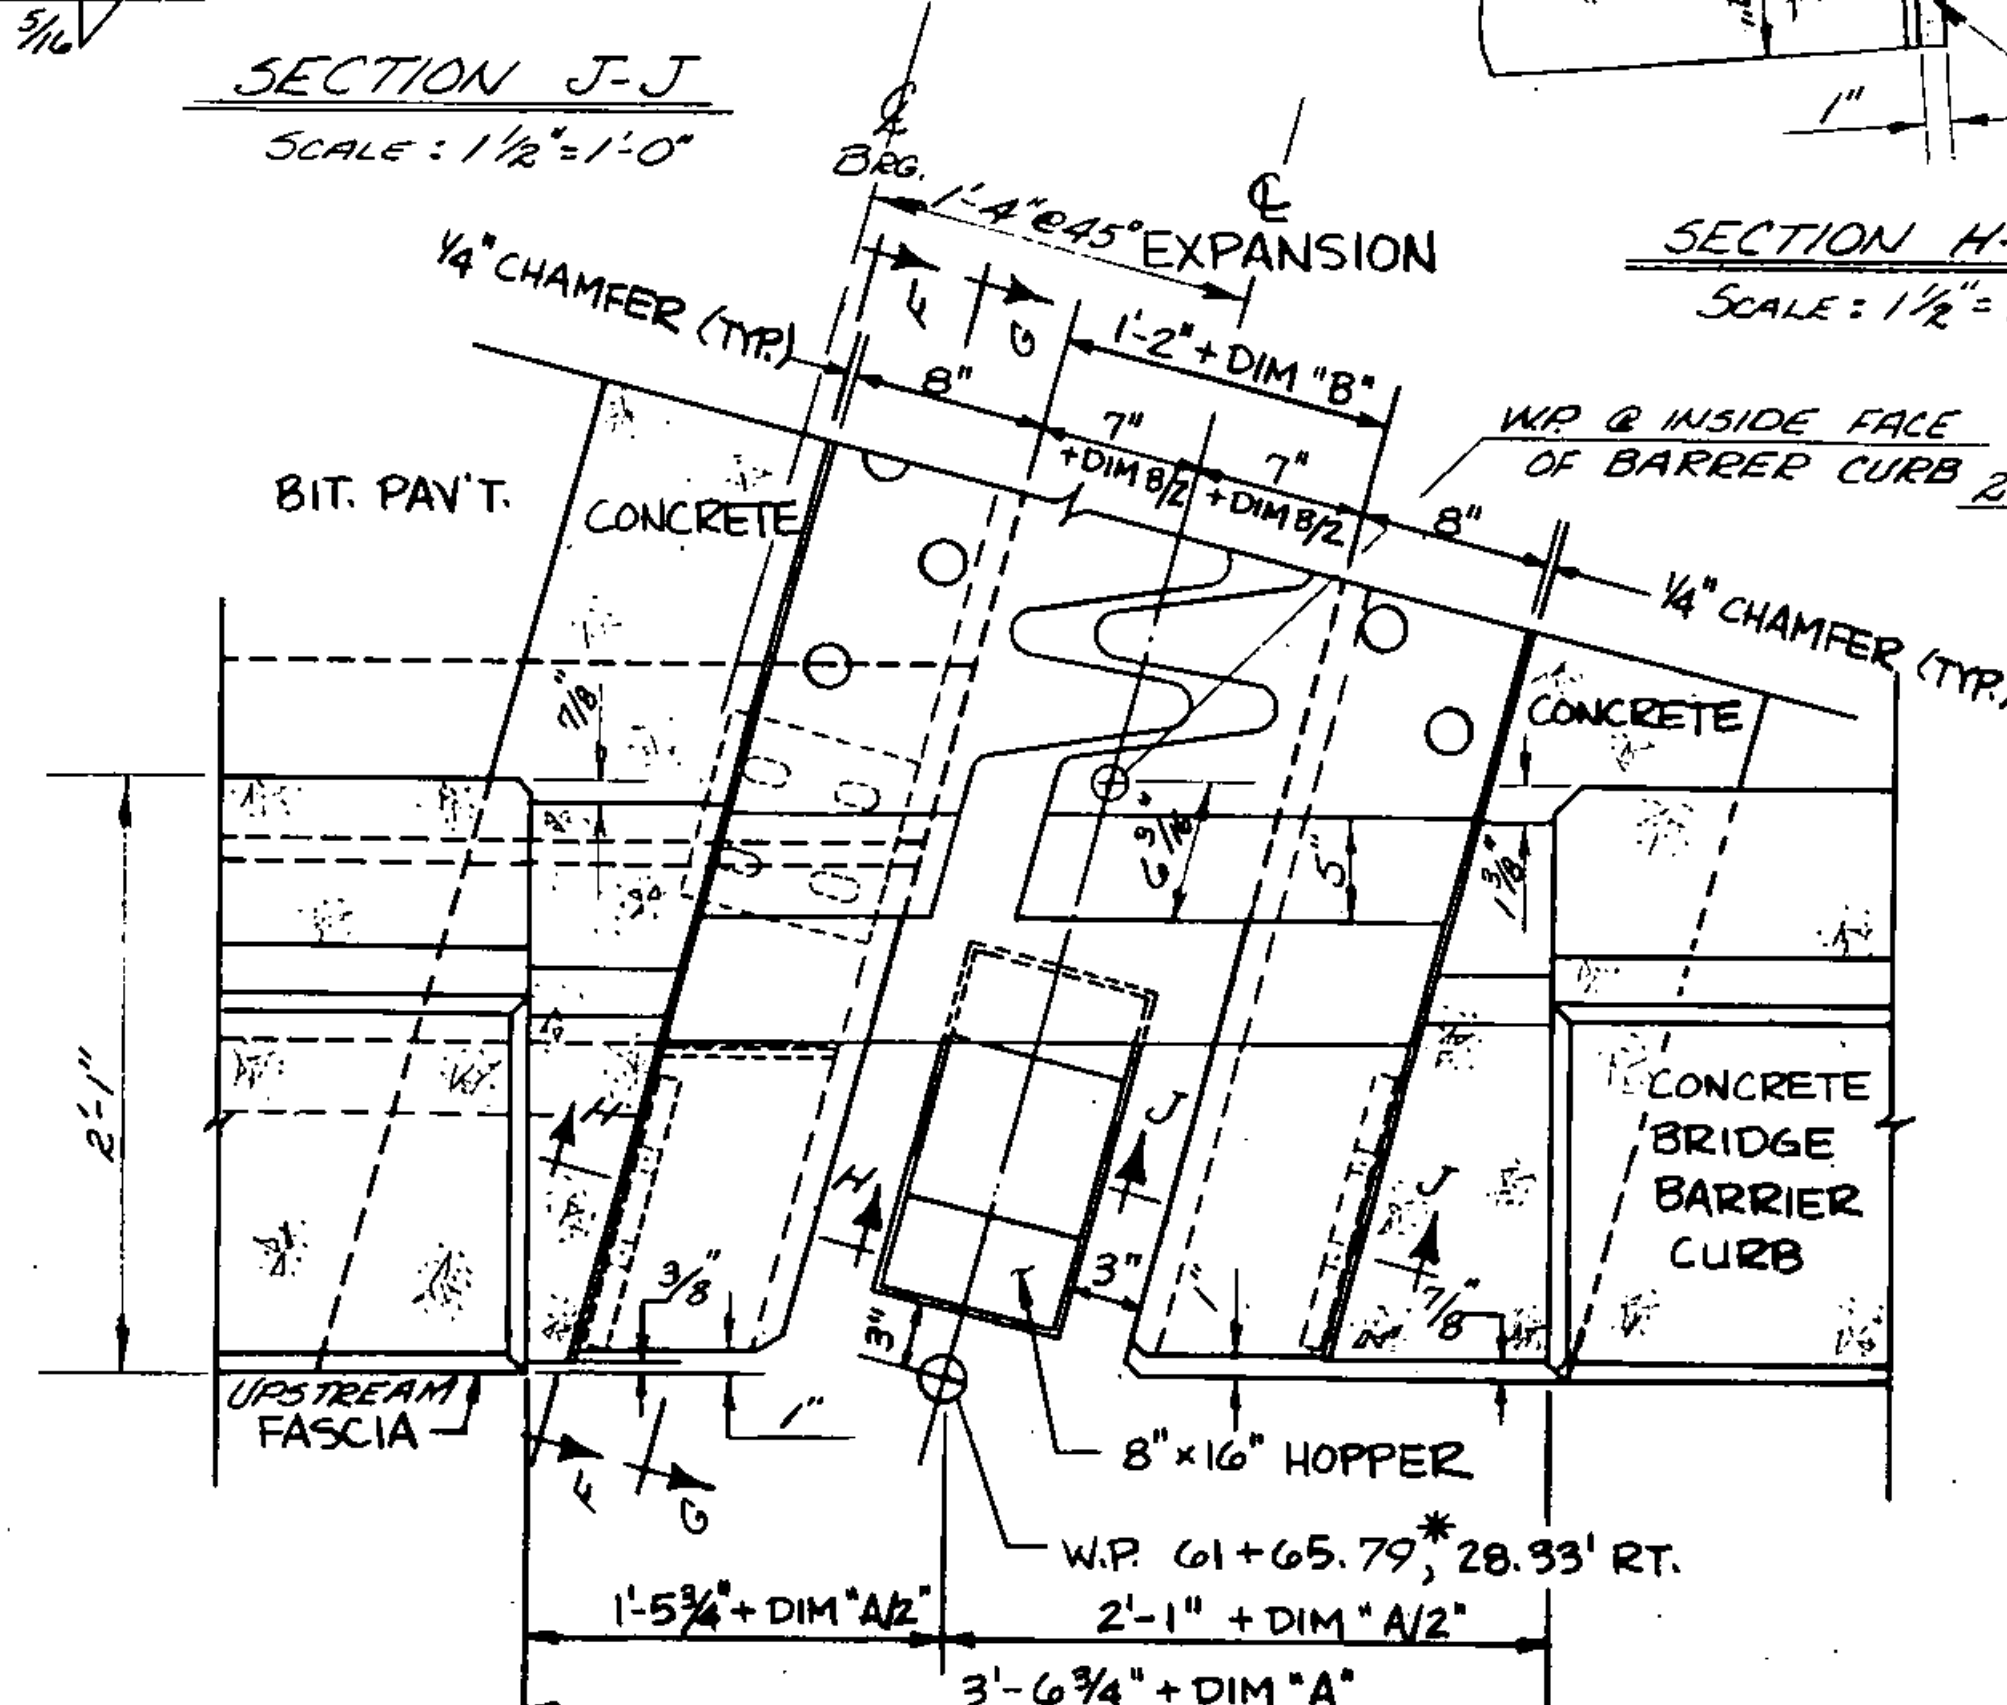

PARTIAL PLAN WITH HOUSING REMOVED

SCALE: 1/2" = 1'-0"

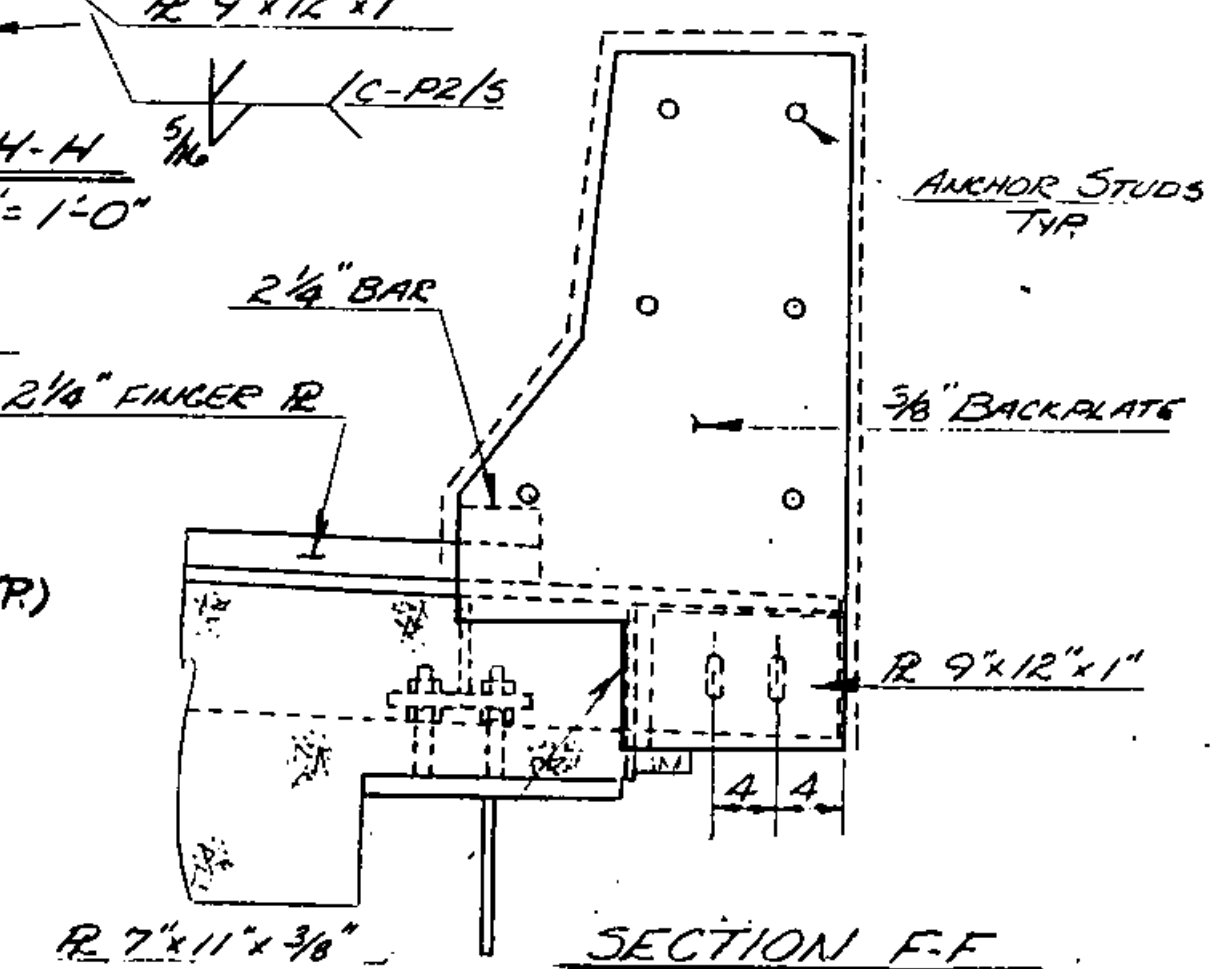

SECTION G-G

SCALE: 1" = 1'-0"

(SECTION G-G, OPPOSITE HAND)



SECTION F-F

SCALE: 1" = 1'-0"

(SECTION F-F, OPPOSITE HAND)

STATE OF VERMONT	
AGENCY OF TRANSPORTATION	
TOWN OF ST. JOHNSBURY	Bridge No. 1
HIGHWAY NO. I-91 NORTH CONNECTOR	Log Sta. 60+0
I-91 NORTH CONNECTOR OVER PASSUMPSIC RIVER	
EXPANSION JOINT DETAILS - ABUT #2	
Designed by G.V. SPILAK	Drawn by G. KLINEFELTER
Checked by M. GARCIA	Bridge Design Supervisor R.S. HAUPT
PROJECT ST. JOHNSBURY	PROJECT NO. DP-FF041-1 (10)
Bridge Sheet No. BR 114	Sheet 72 of 229