
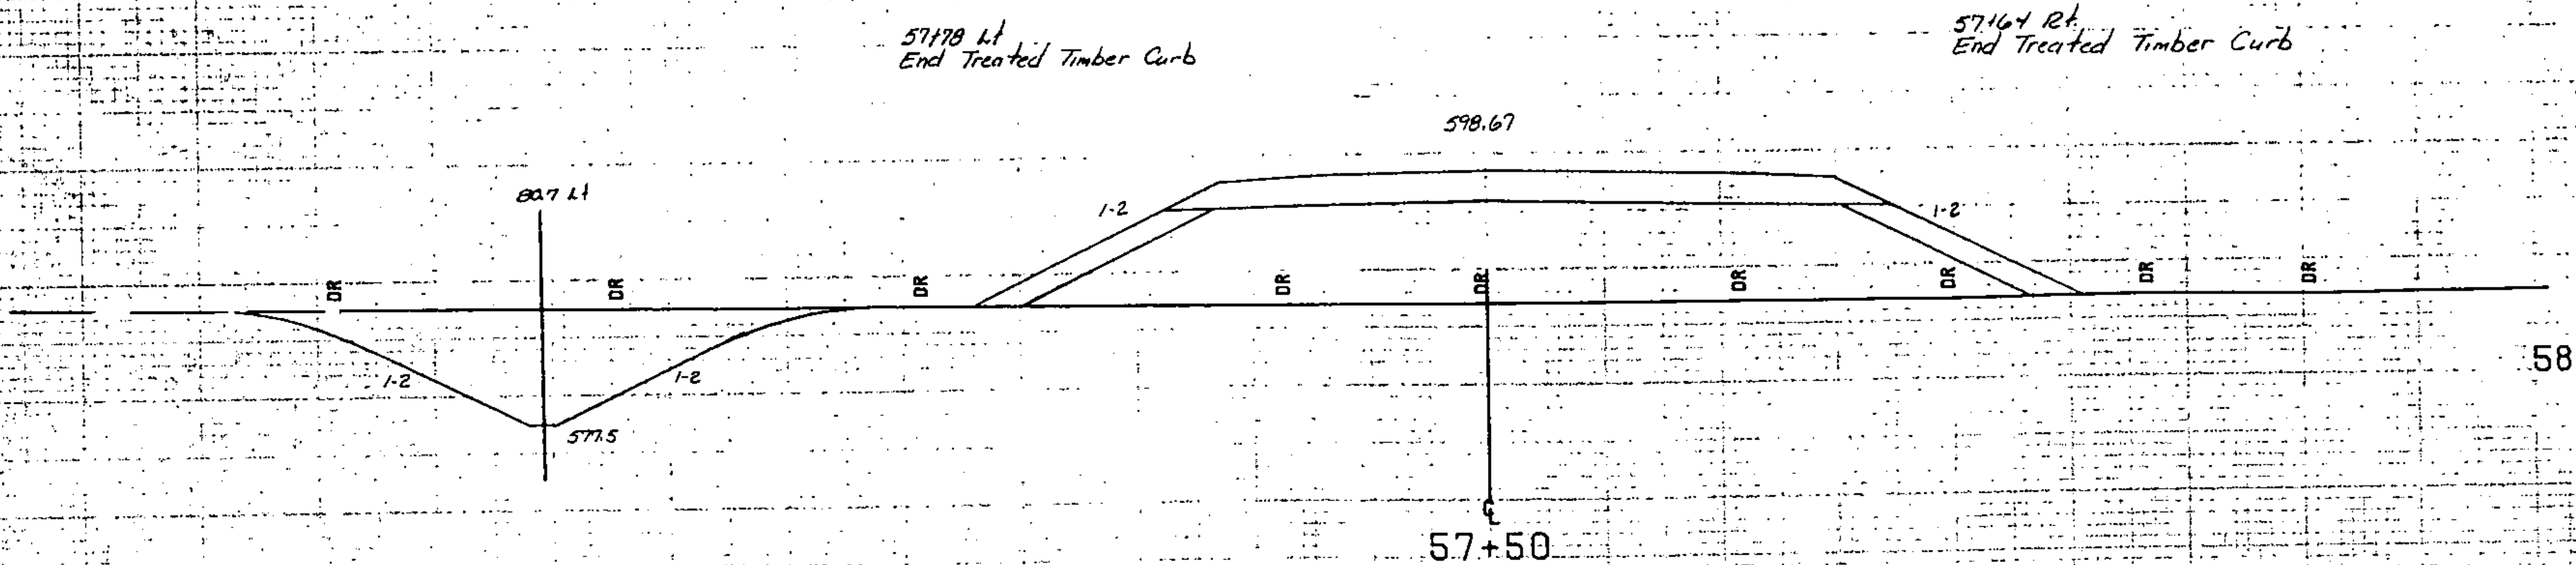
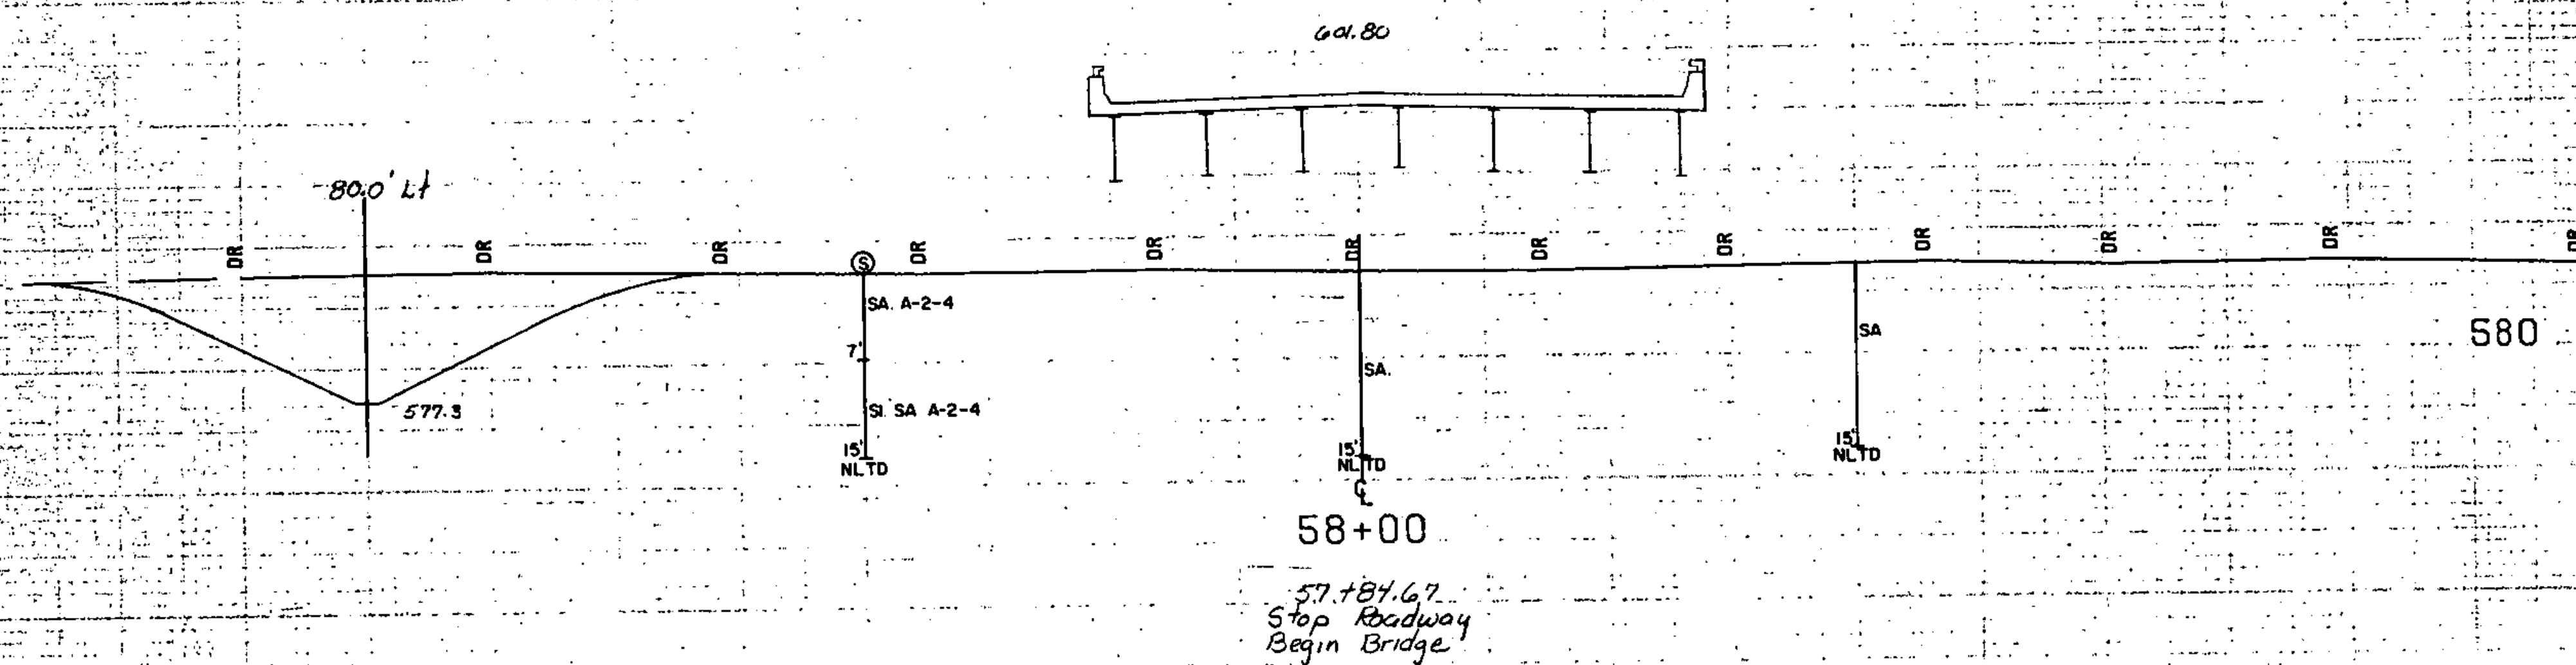


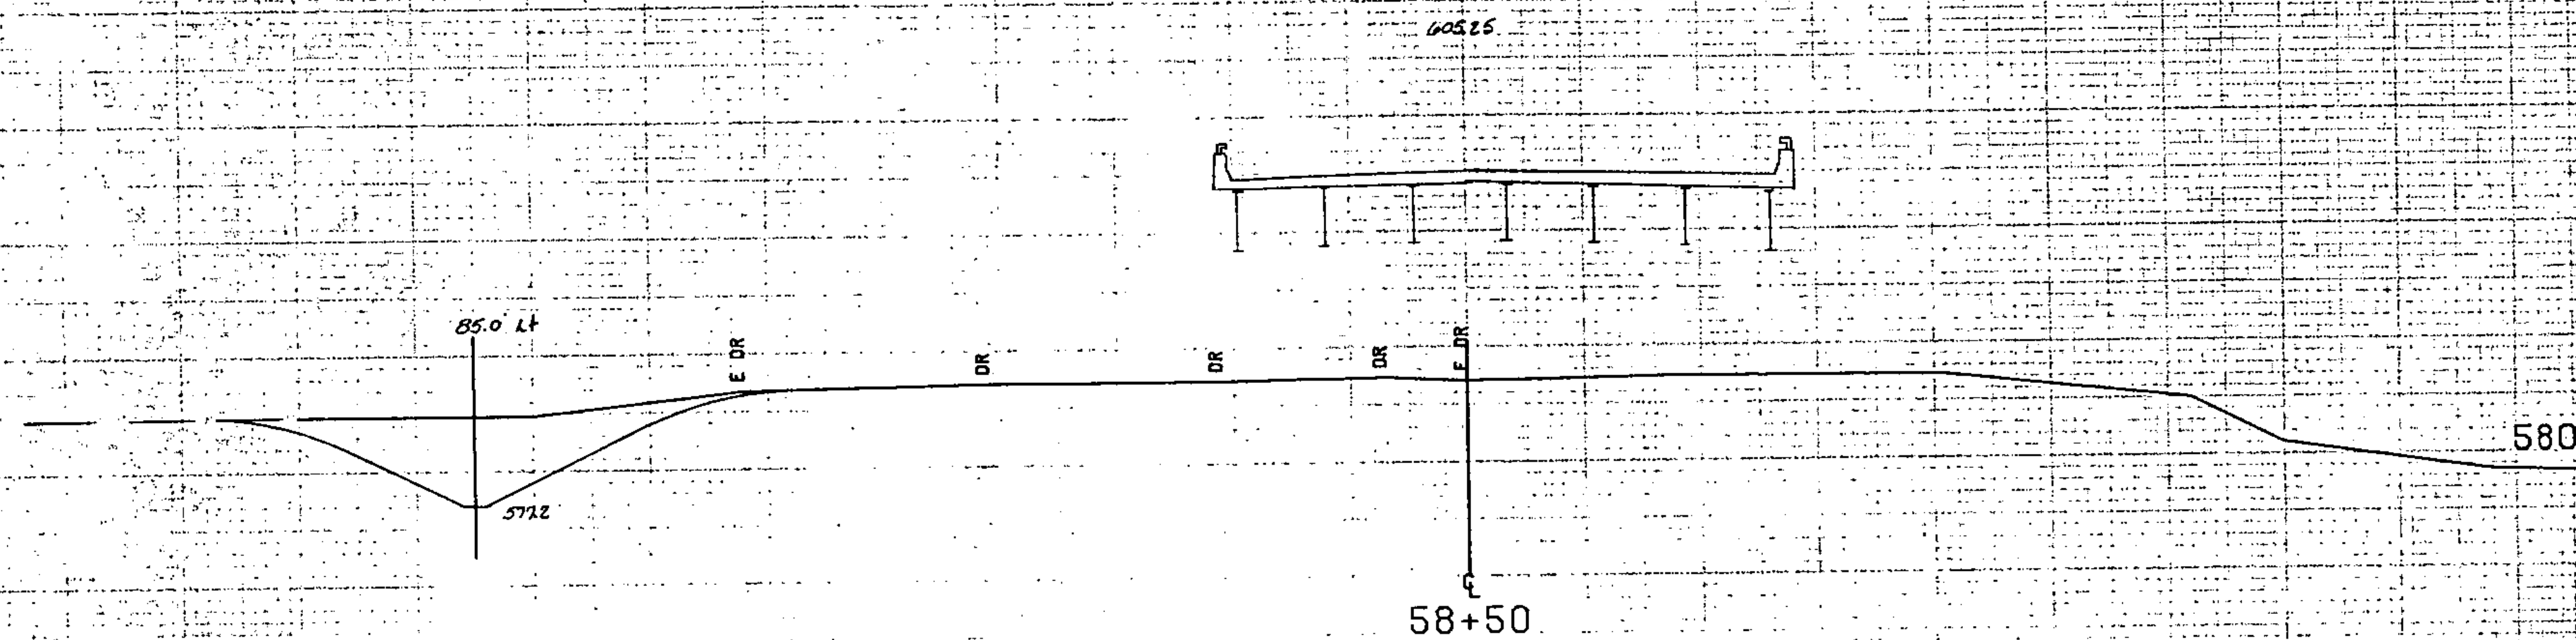

FROM STA. 57+50 TO STA. 58+50
PROJECT NAME ST. JOHNSBURY MAIN
NO. DP-FF041-11(10) PLOTTED 12/11/84
SURVEYED BY FANTONI 11778
SHEET 06 OF 229 SHEETS

SCALE 1" = 10 FEET