


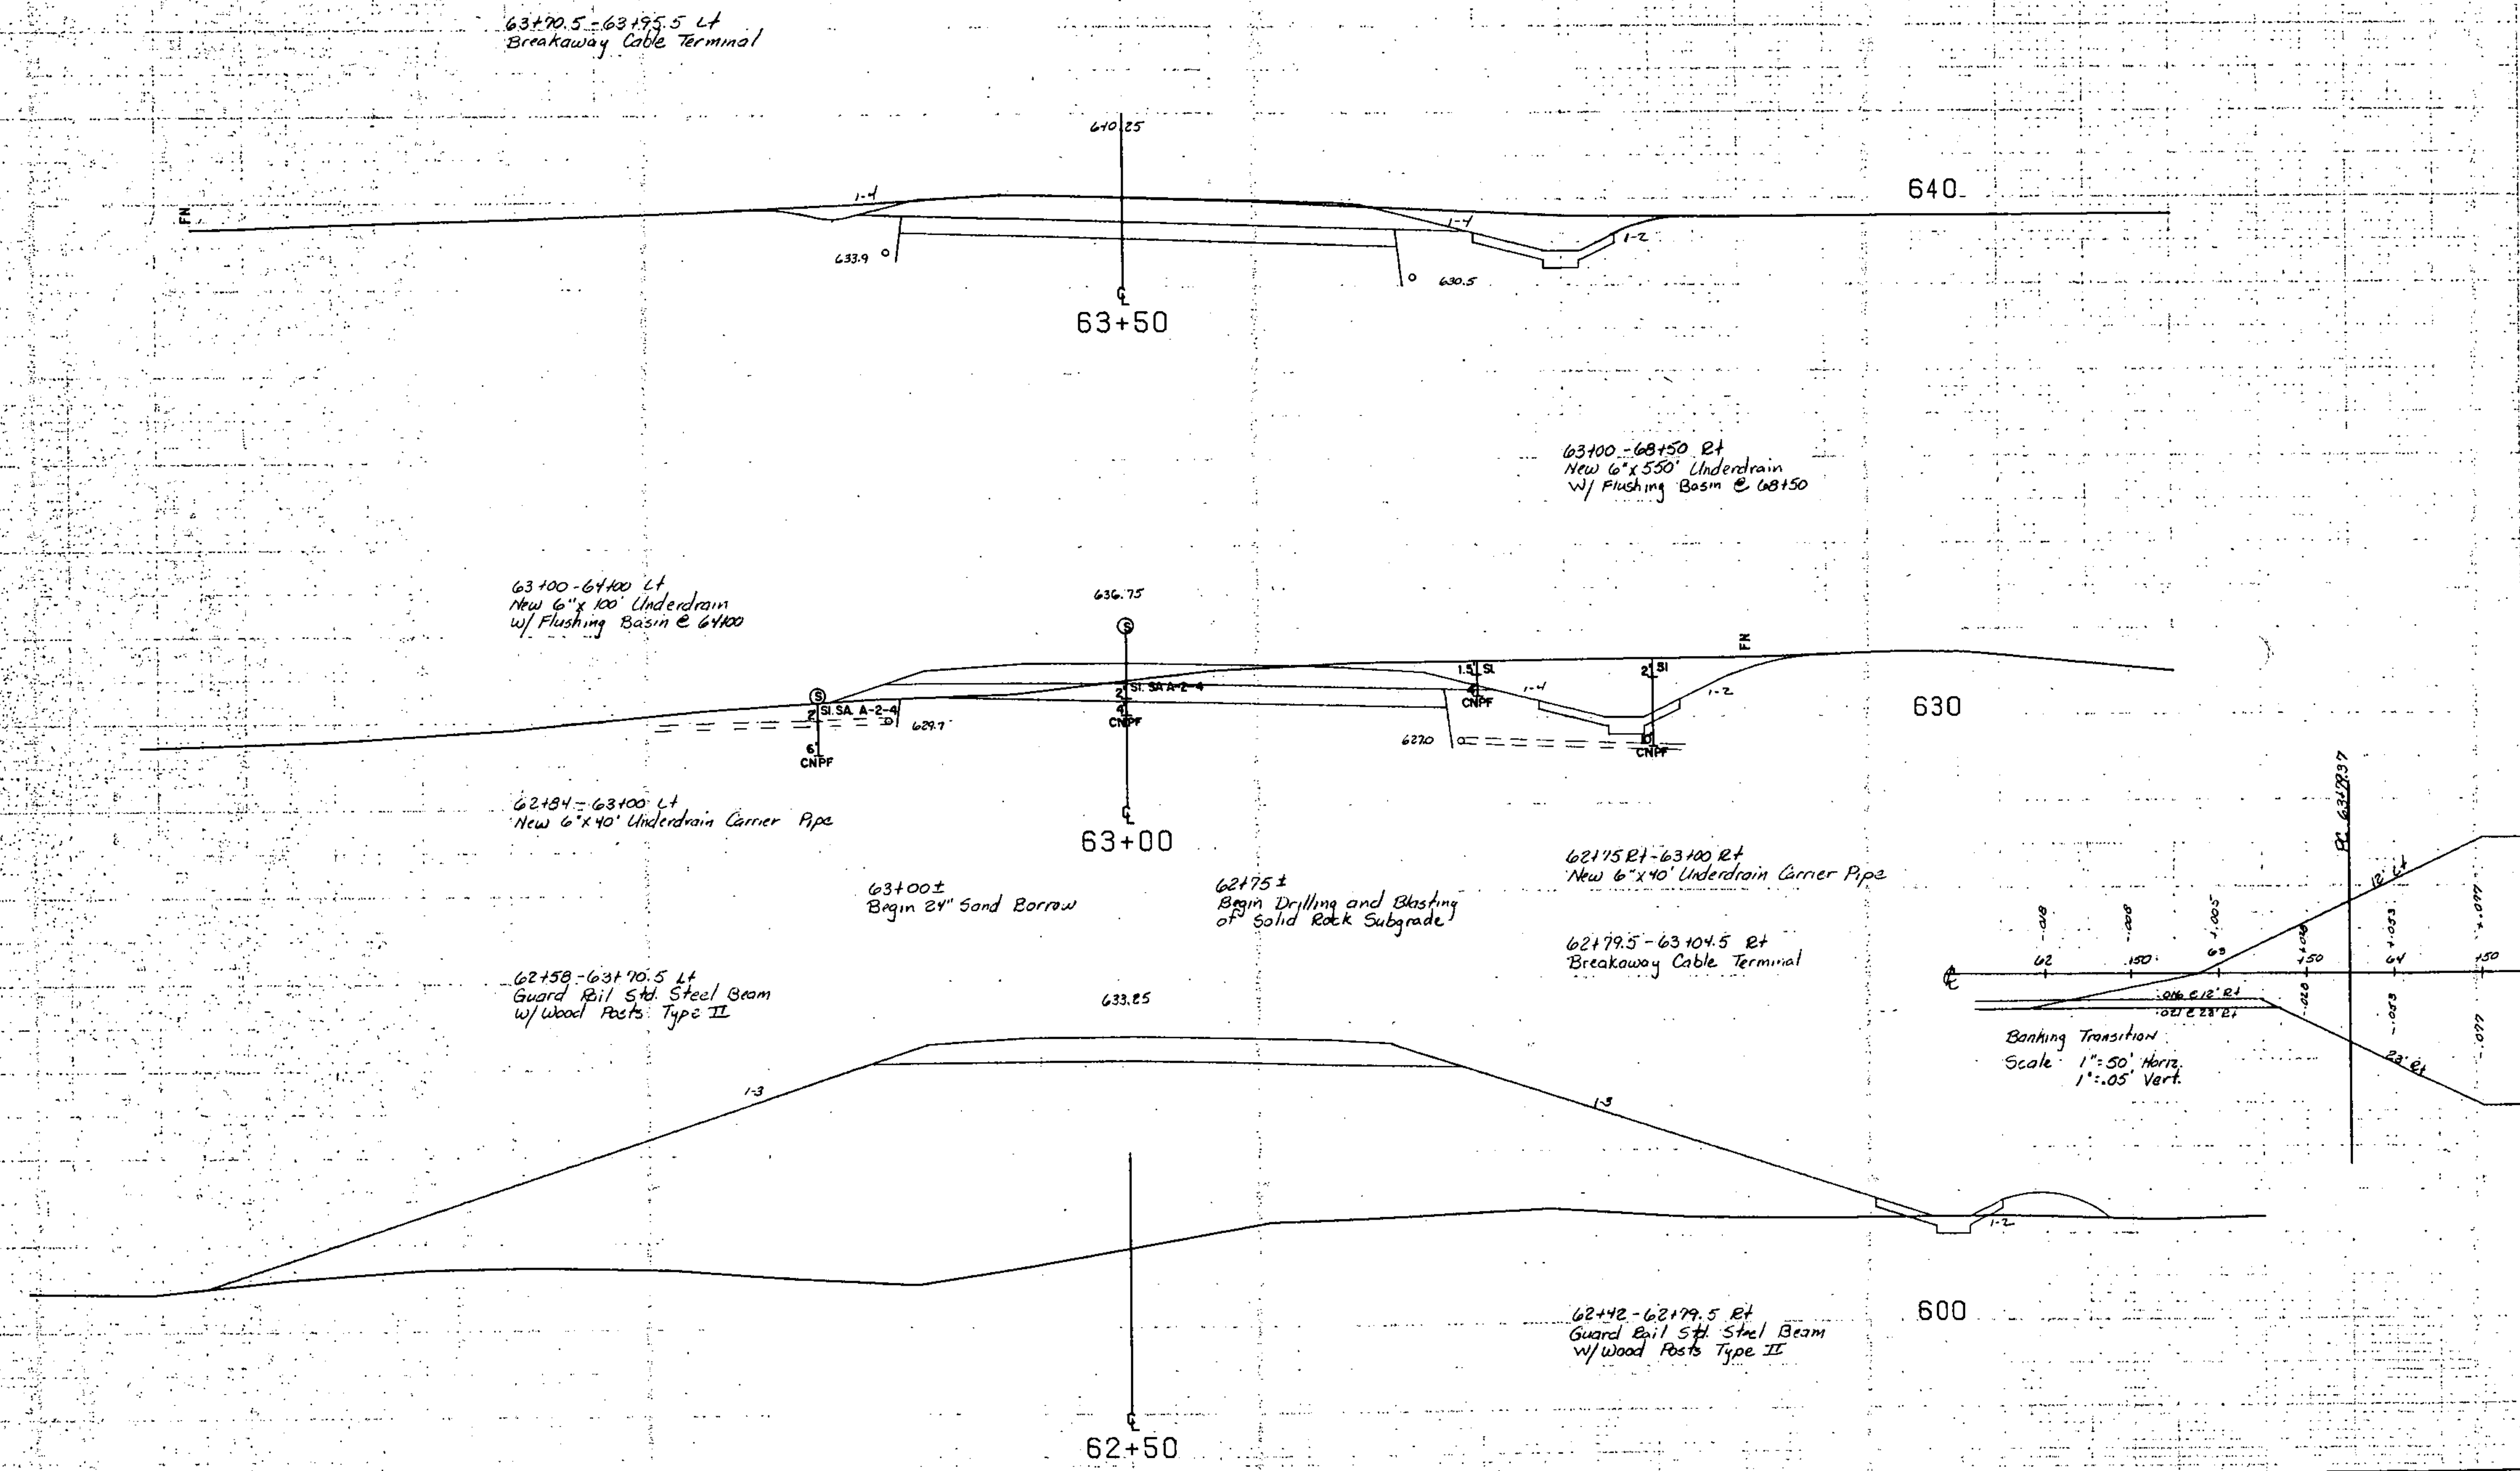

FROM STA.	62+50	TO STA.	63+50
PROJECT NAME	ST. JOHNSBURY MAIN		
NO.	DP-FF041-1(10)	PLOTTED	12/11/84
SURVEYED BY	FANTONI		
SHEET	11	OF	SHEETS 229

SCALE 10 FEET