



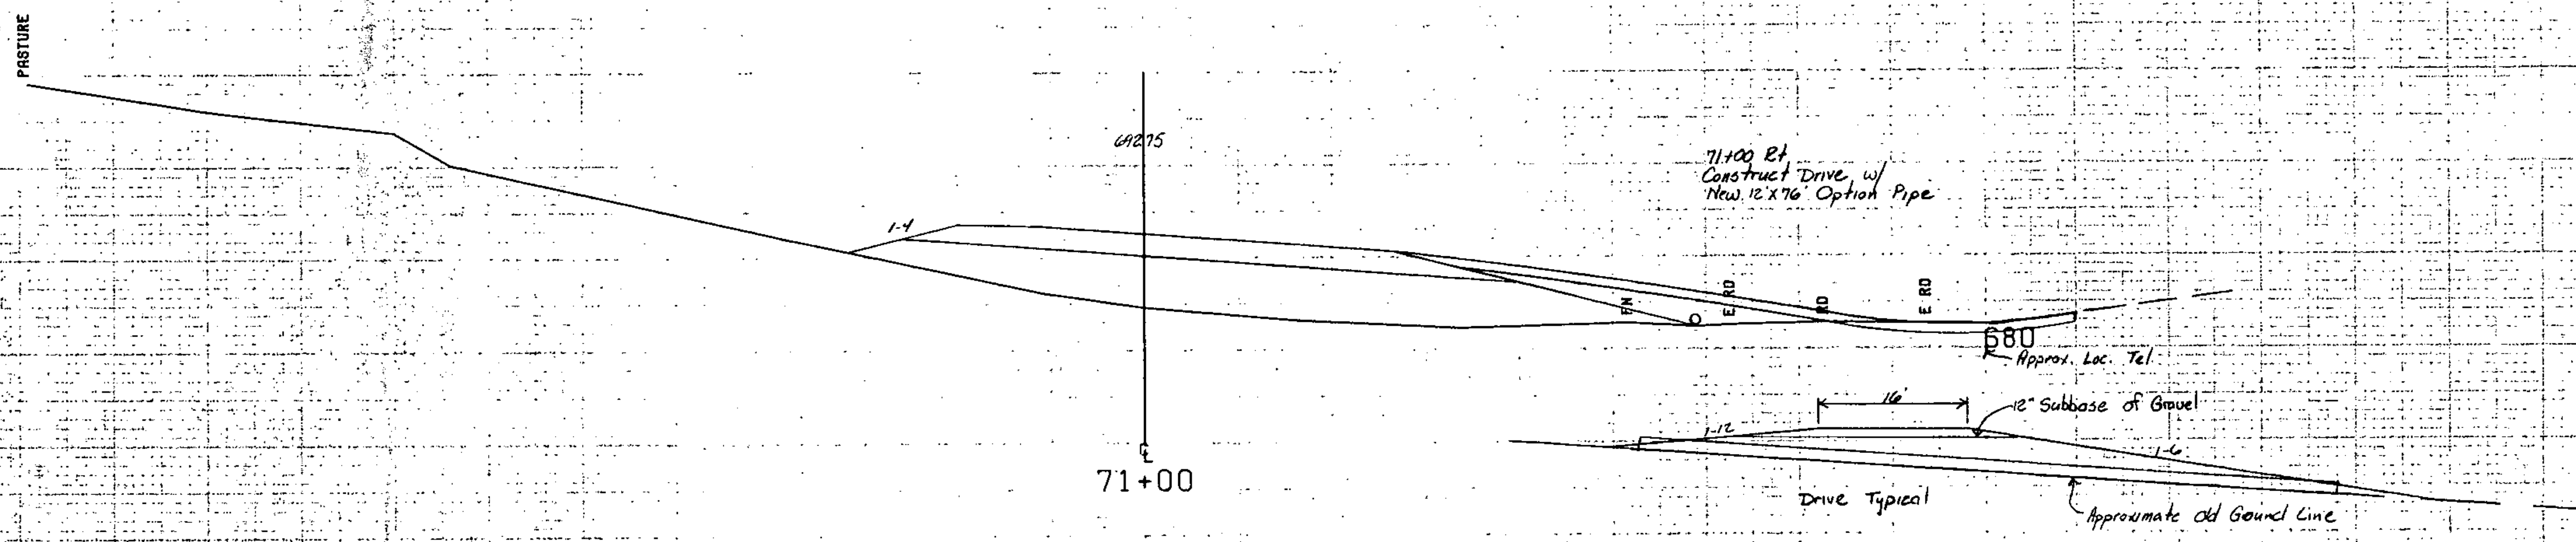

70+00 - 73+50. LT
Erosion Matting (8' wide)

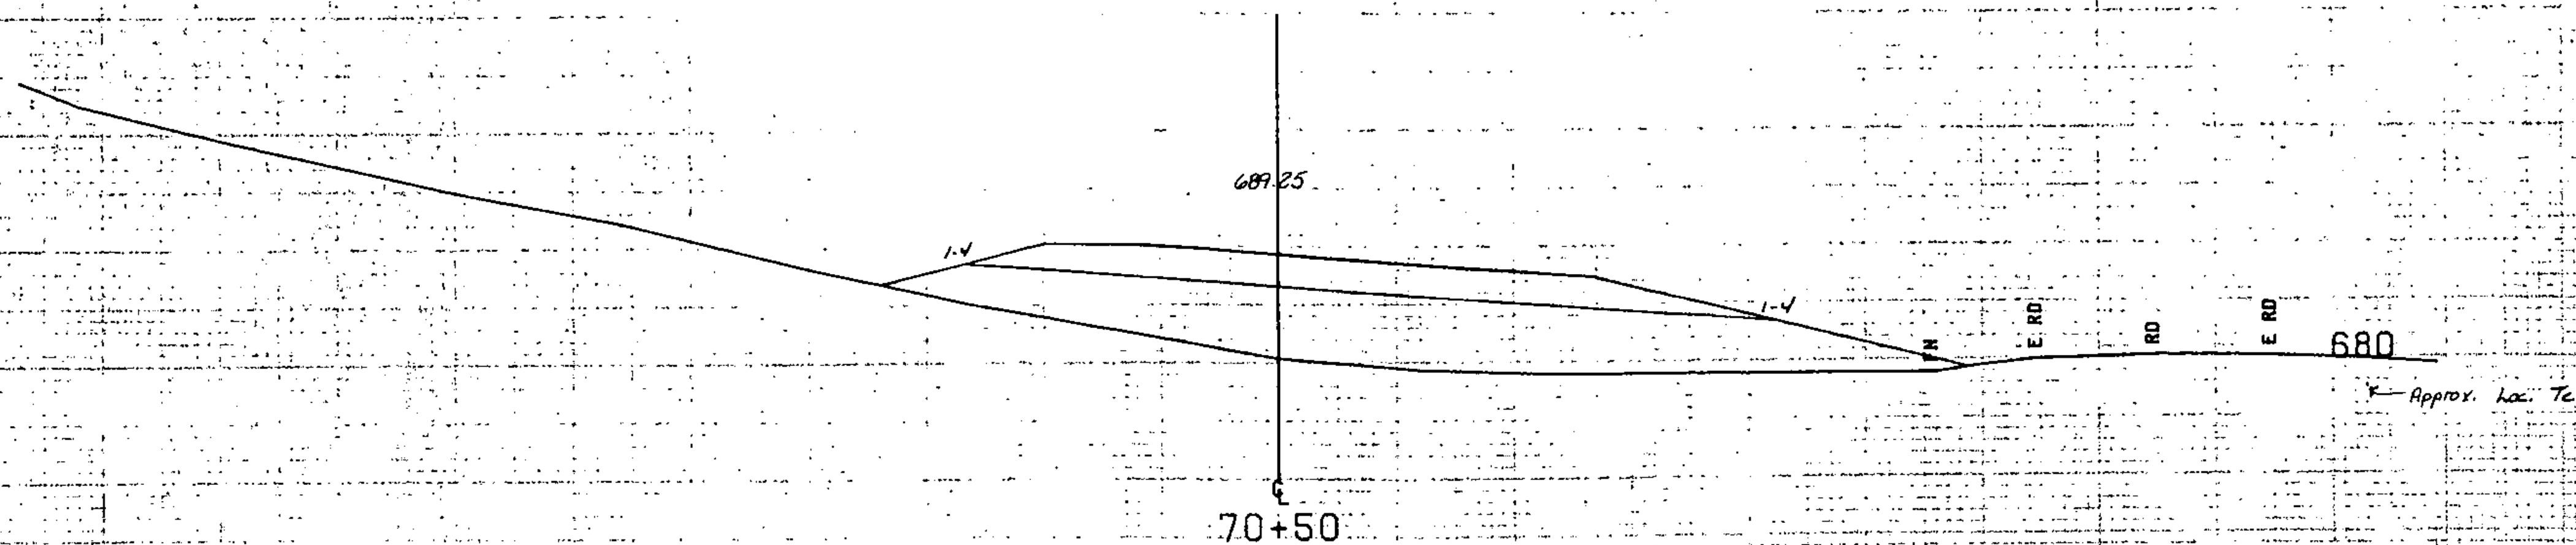

FROM STA.	70+50	TO STA.	71+00
PROJECT NAME	ST. JOHNSBURY MAIN		
NO.	DP-F041-1(10)	PLOTTED	12/11/84
SURVEYED BY	FANTONI	DATE	11/78
SHEET	17	OF	229

SCALE 10 FEET