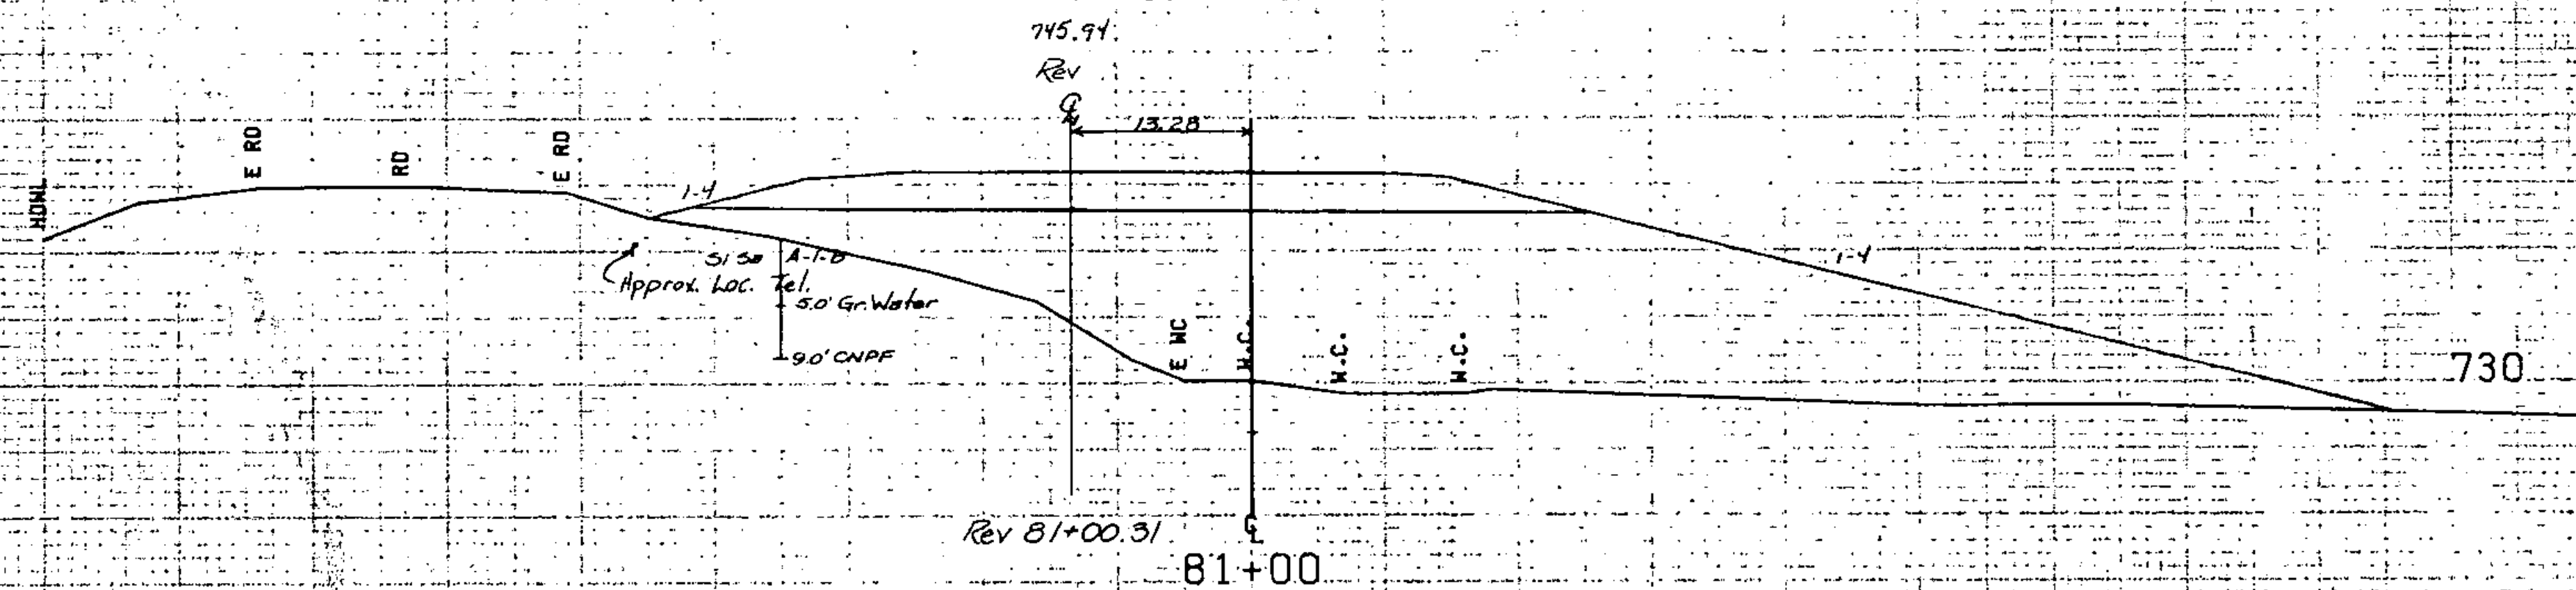
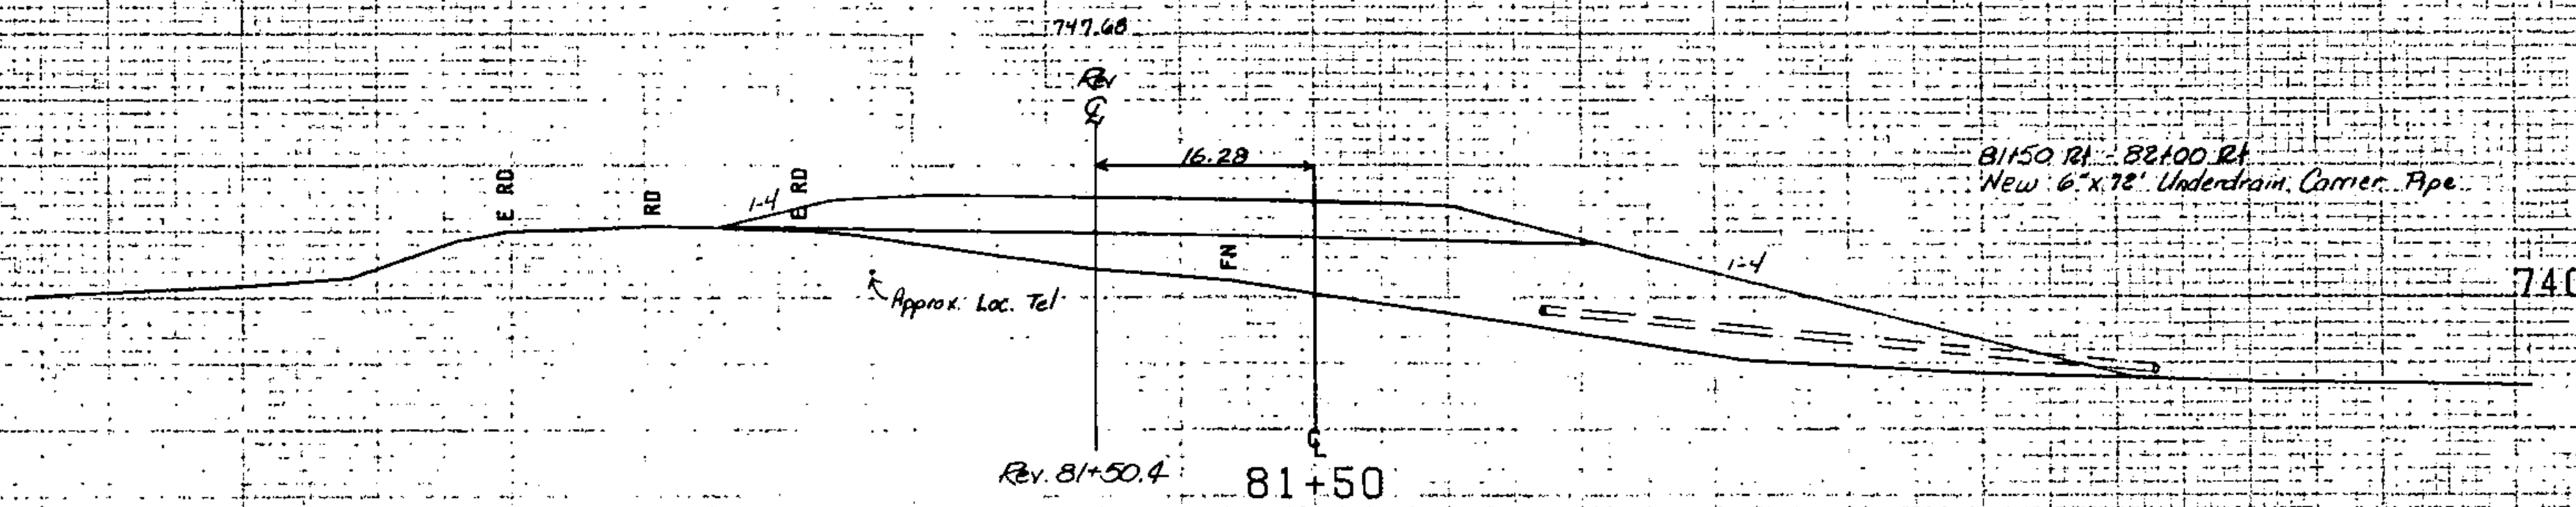


FROM STA.	80+88	TO STA.	81+50
PROJECT NAME	ST. JOHNSBURY MAIN		
NO.	DP-FF041-1(10)	PLOTTED	12/11/84
SURVEYED BY	FANTONI		
SHEET 127 OF 128	SHEET 229		

SCALE 1"=100'