

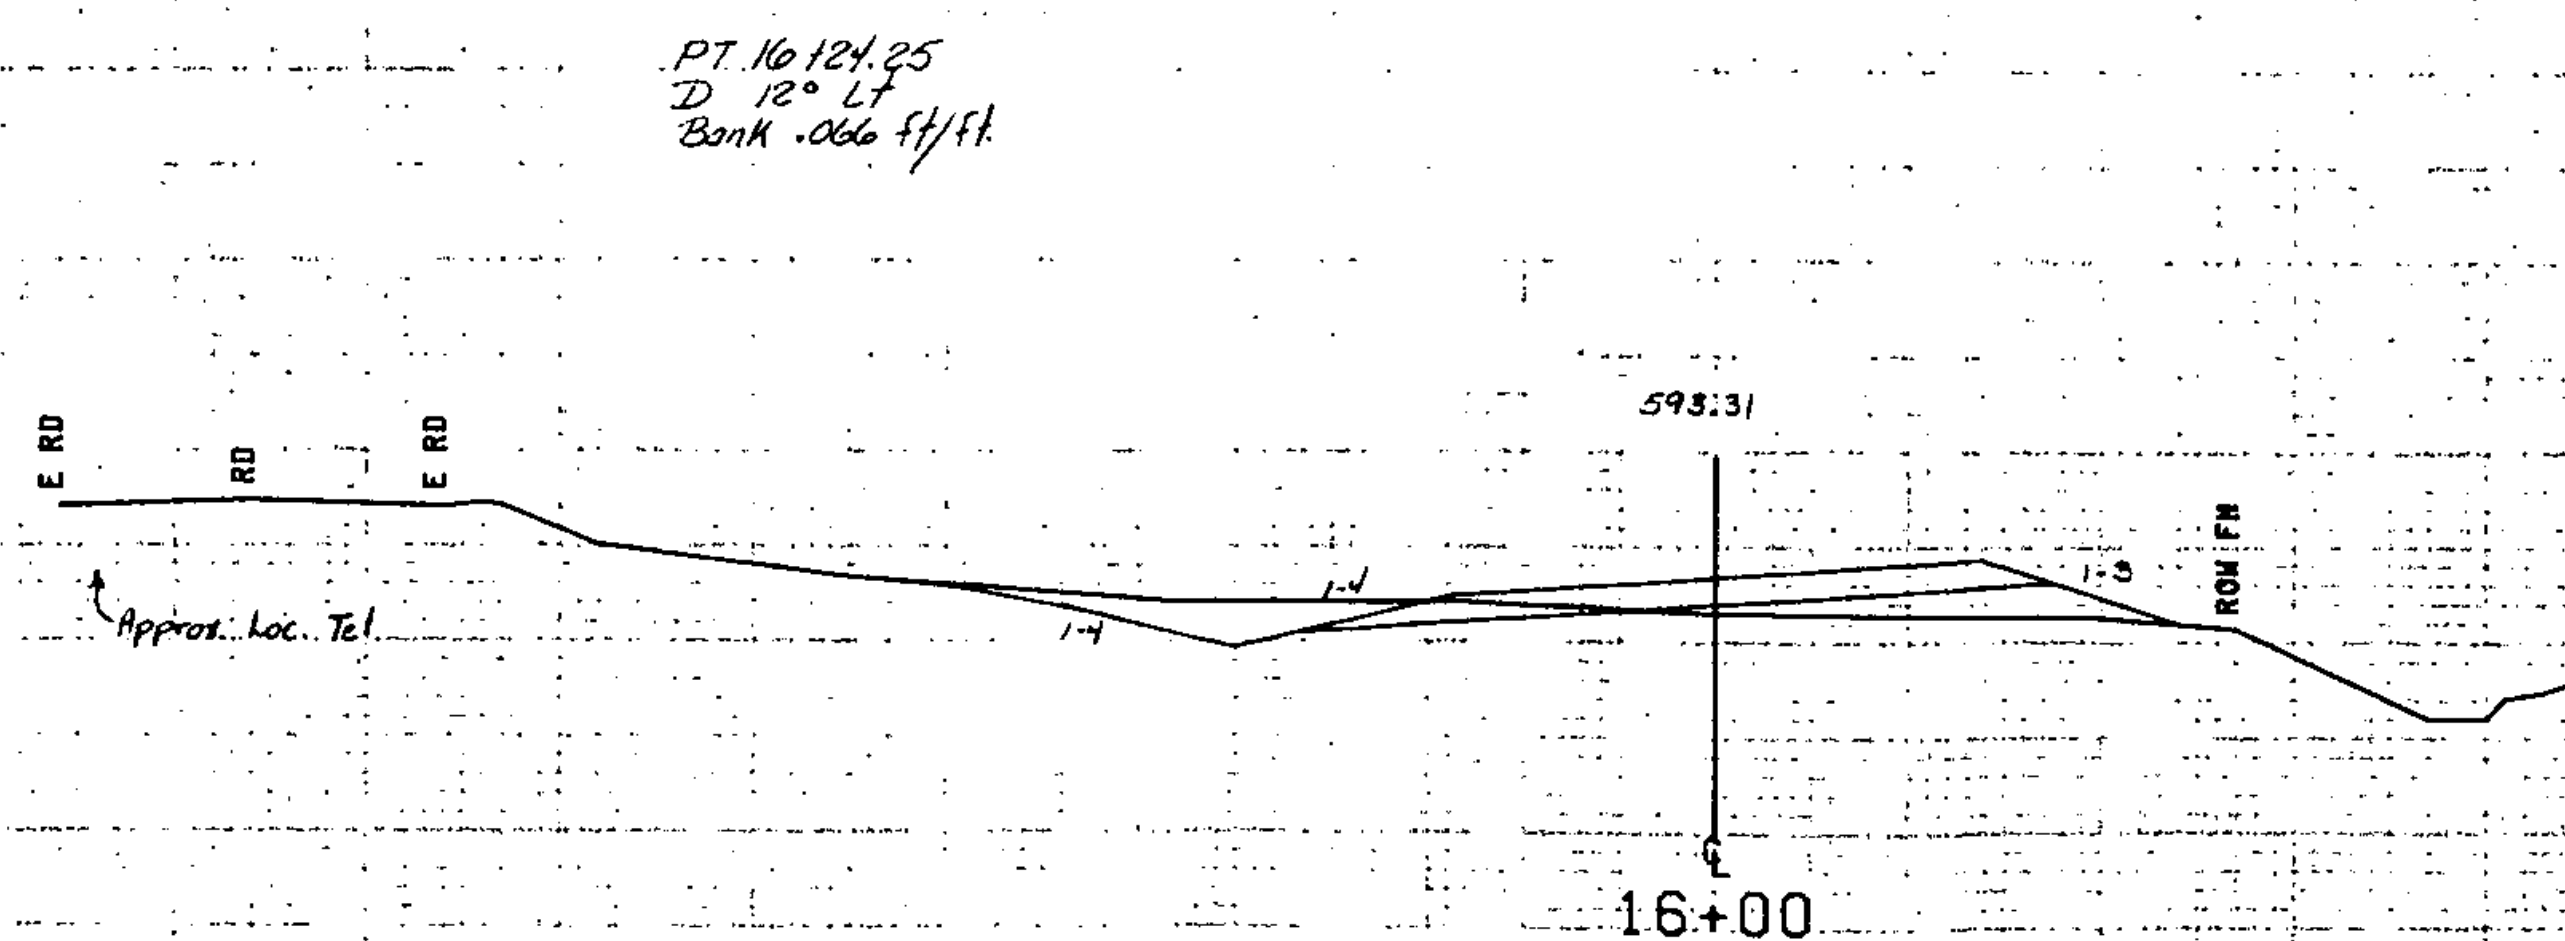
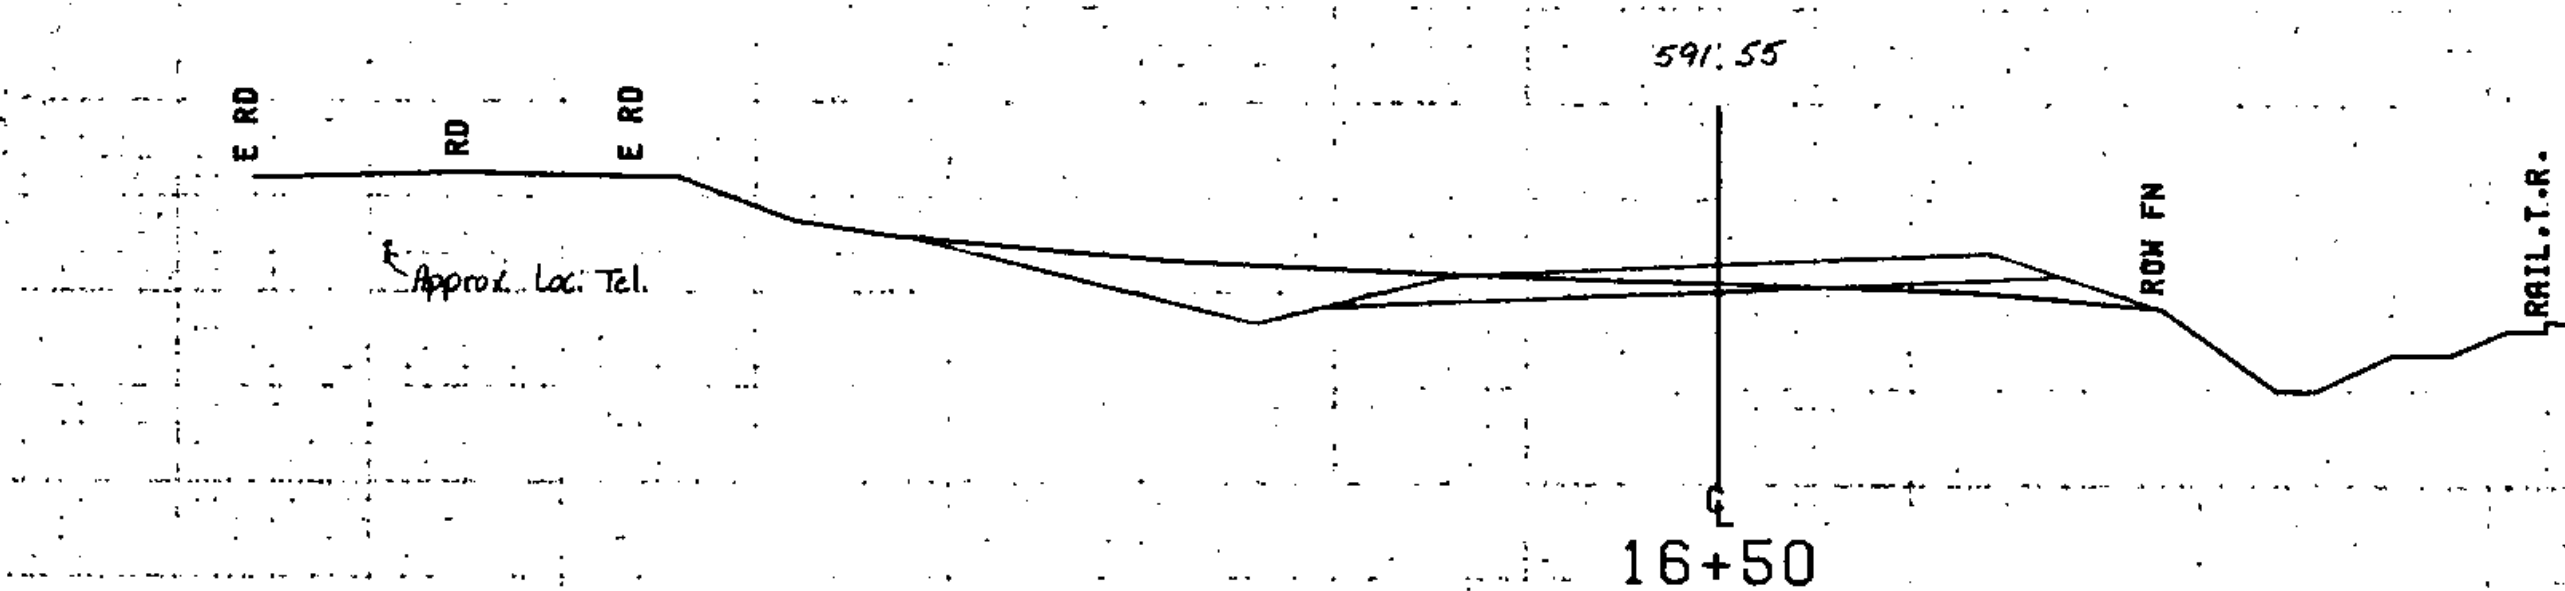


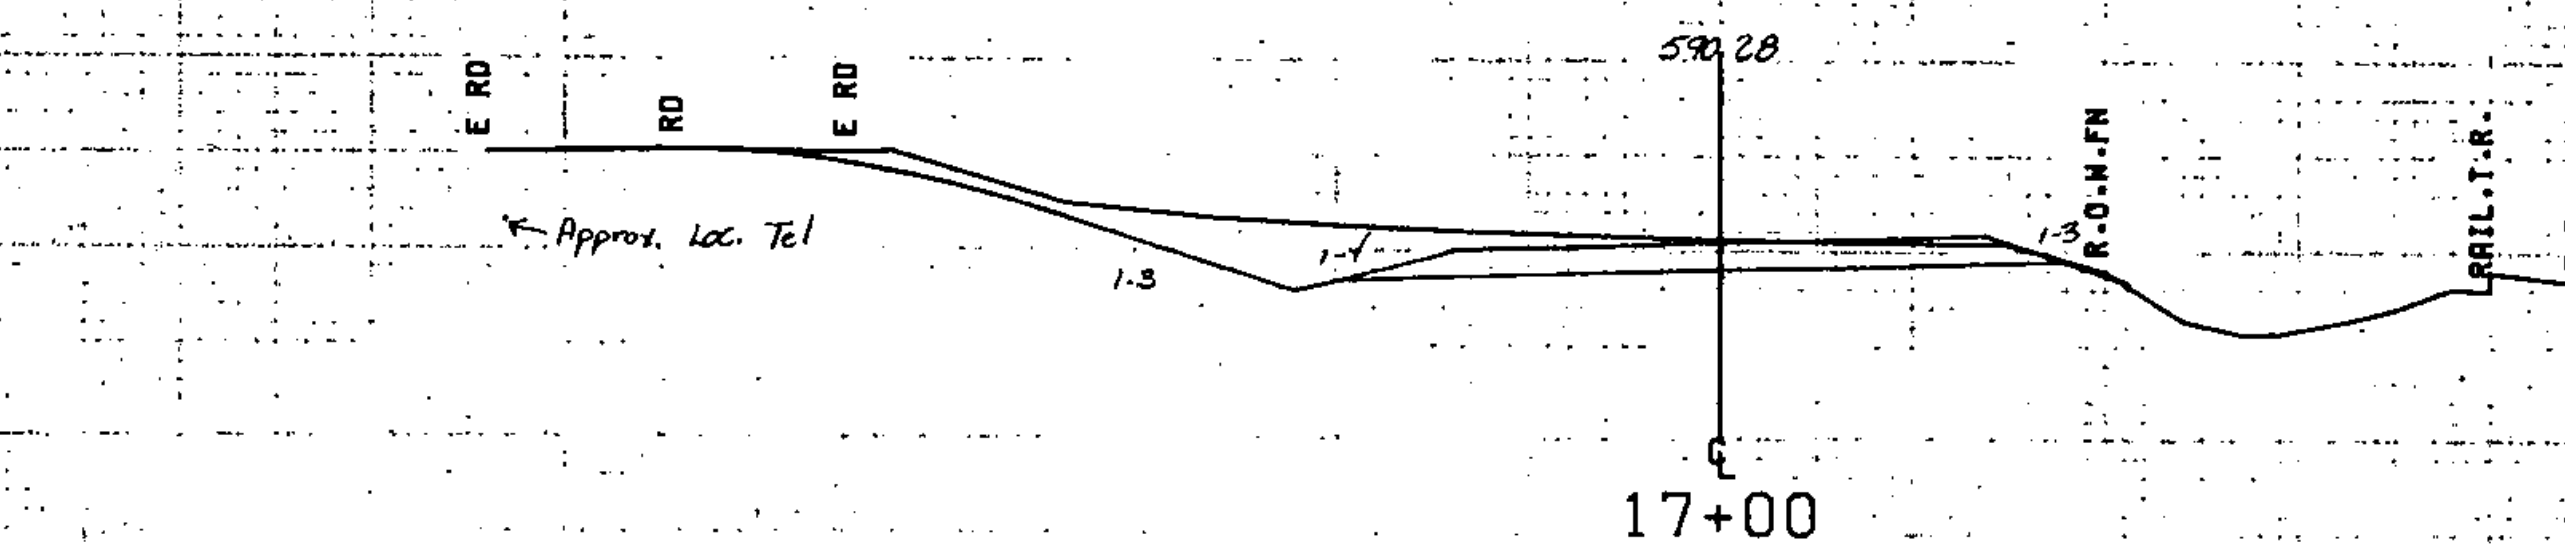

PT. 16+24.25
D 12° LT
Bank .066 ft/ft

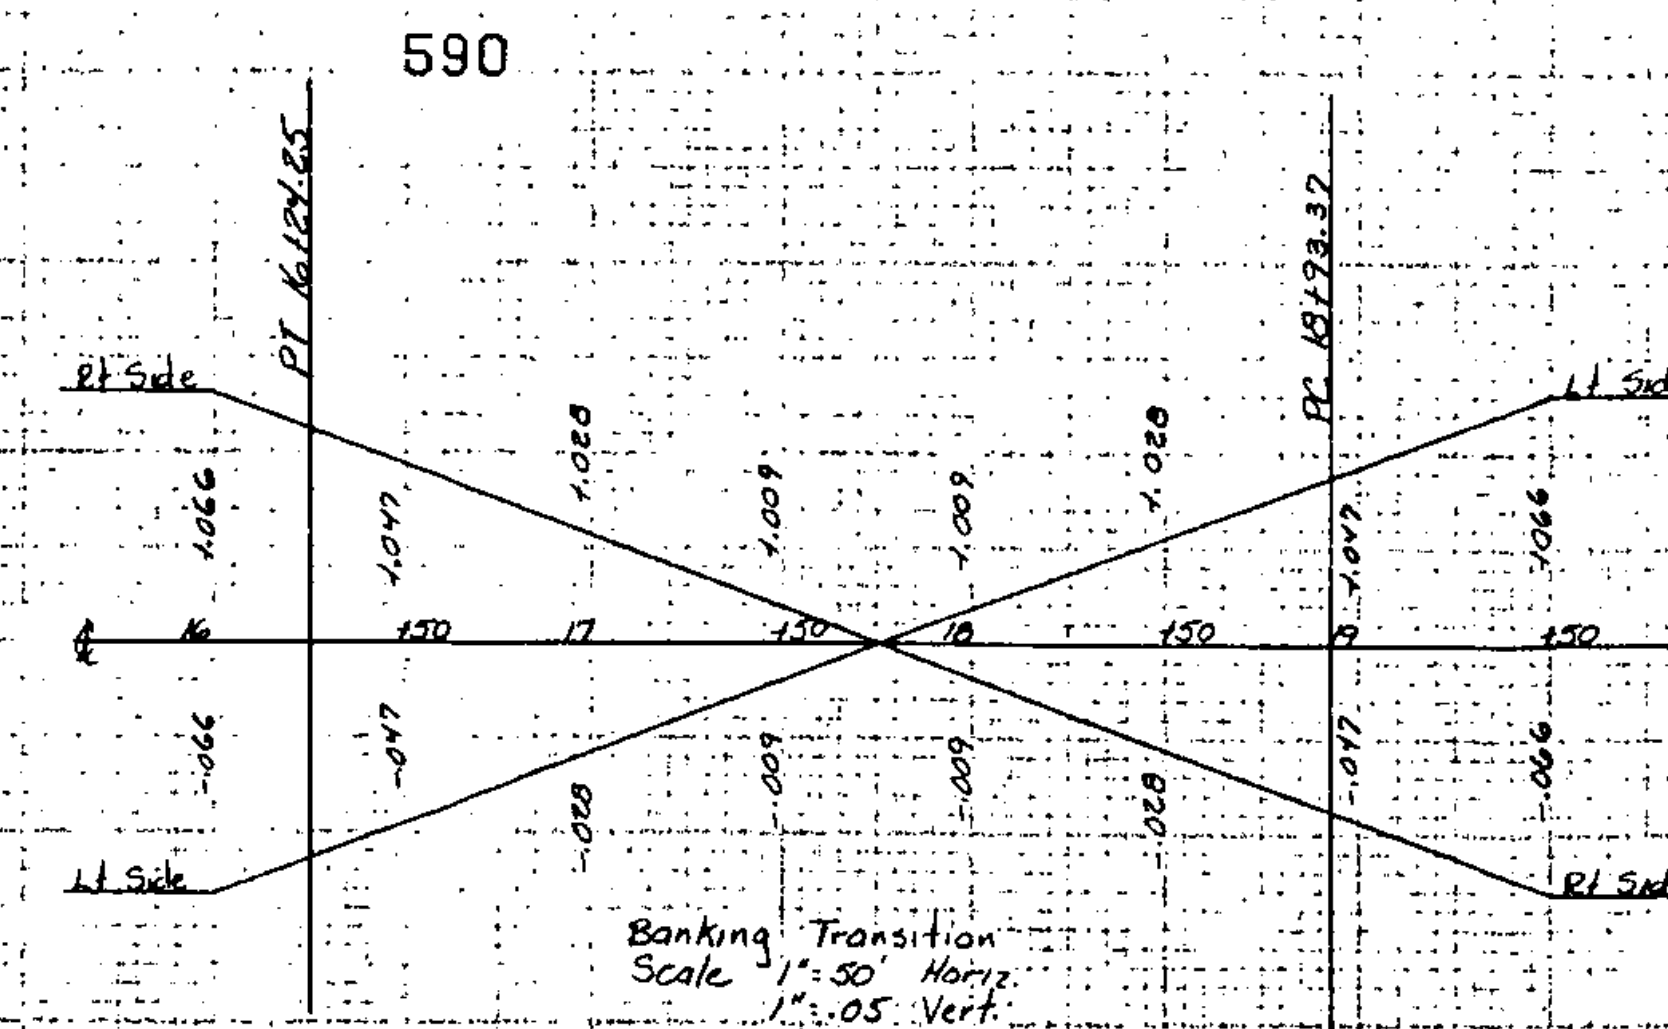

FROM STA. 16+00 TO STA. 17+00
PROJECT NAME ST. JOHNSBURY T.H. 27
NO. OP-FF041-1(10) PLOTTED 12/11/84
SURVEYED BY FANTONI 11778
SHEET 142 OF SHEETS 223

SCALE 1" = 10 FEET