


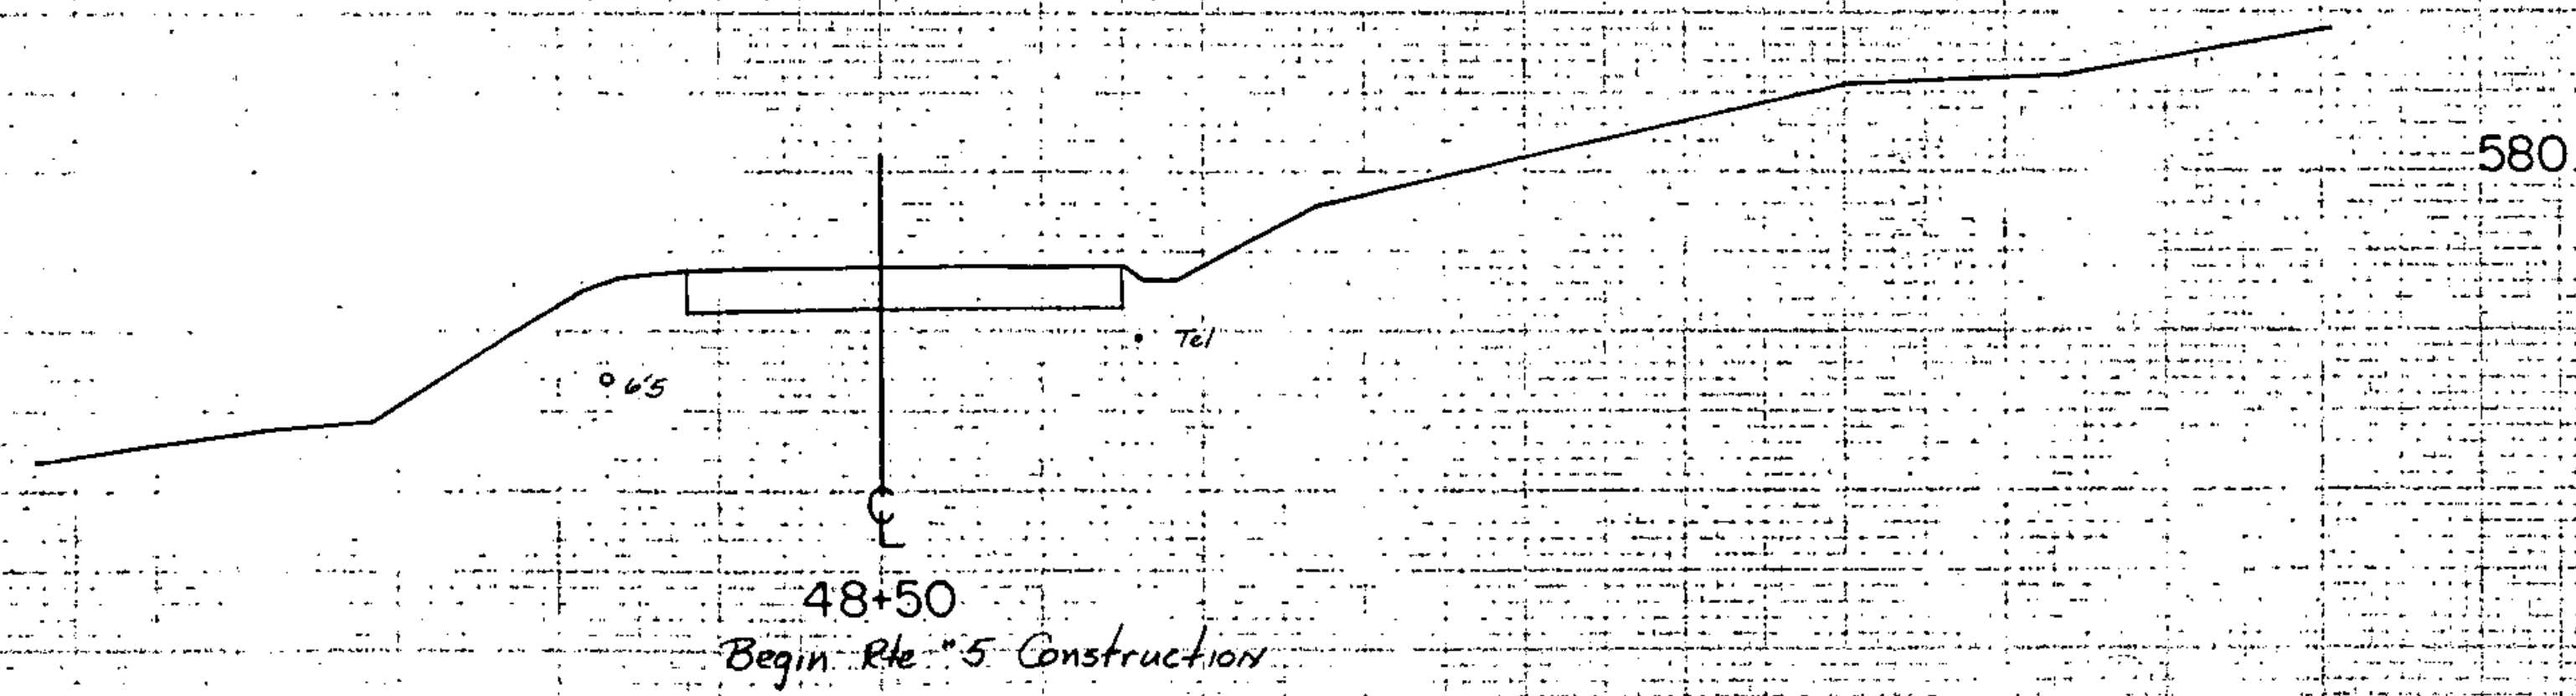

FROM STA. 48+50 TO STA. 48+50
PROJECT NAME ST. JOHNSBURY U.S. RTE. 5
NO. DP. FF.041-11101
SHEET 143 OF 1 SHEETS 225