


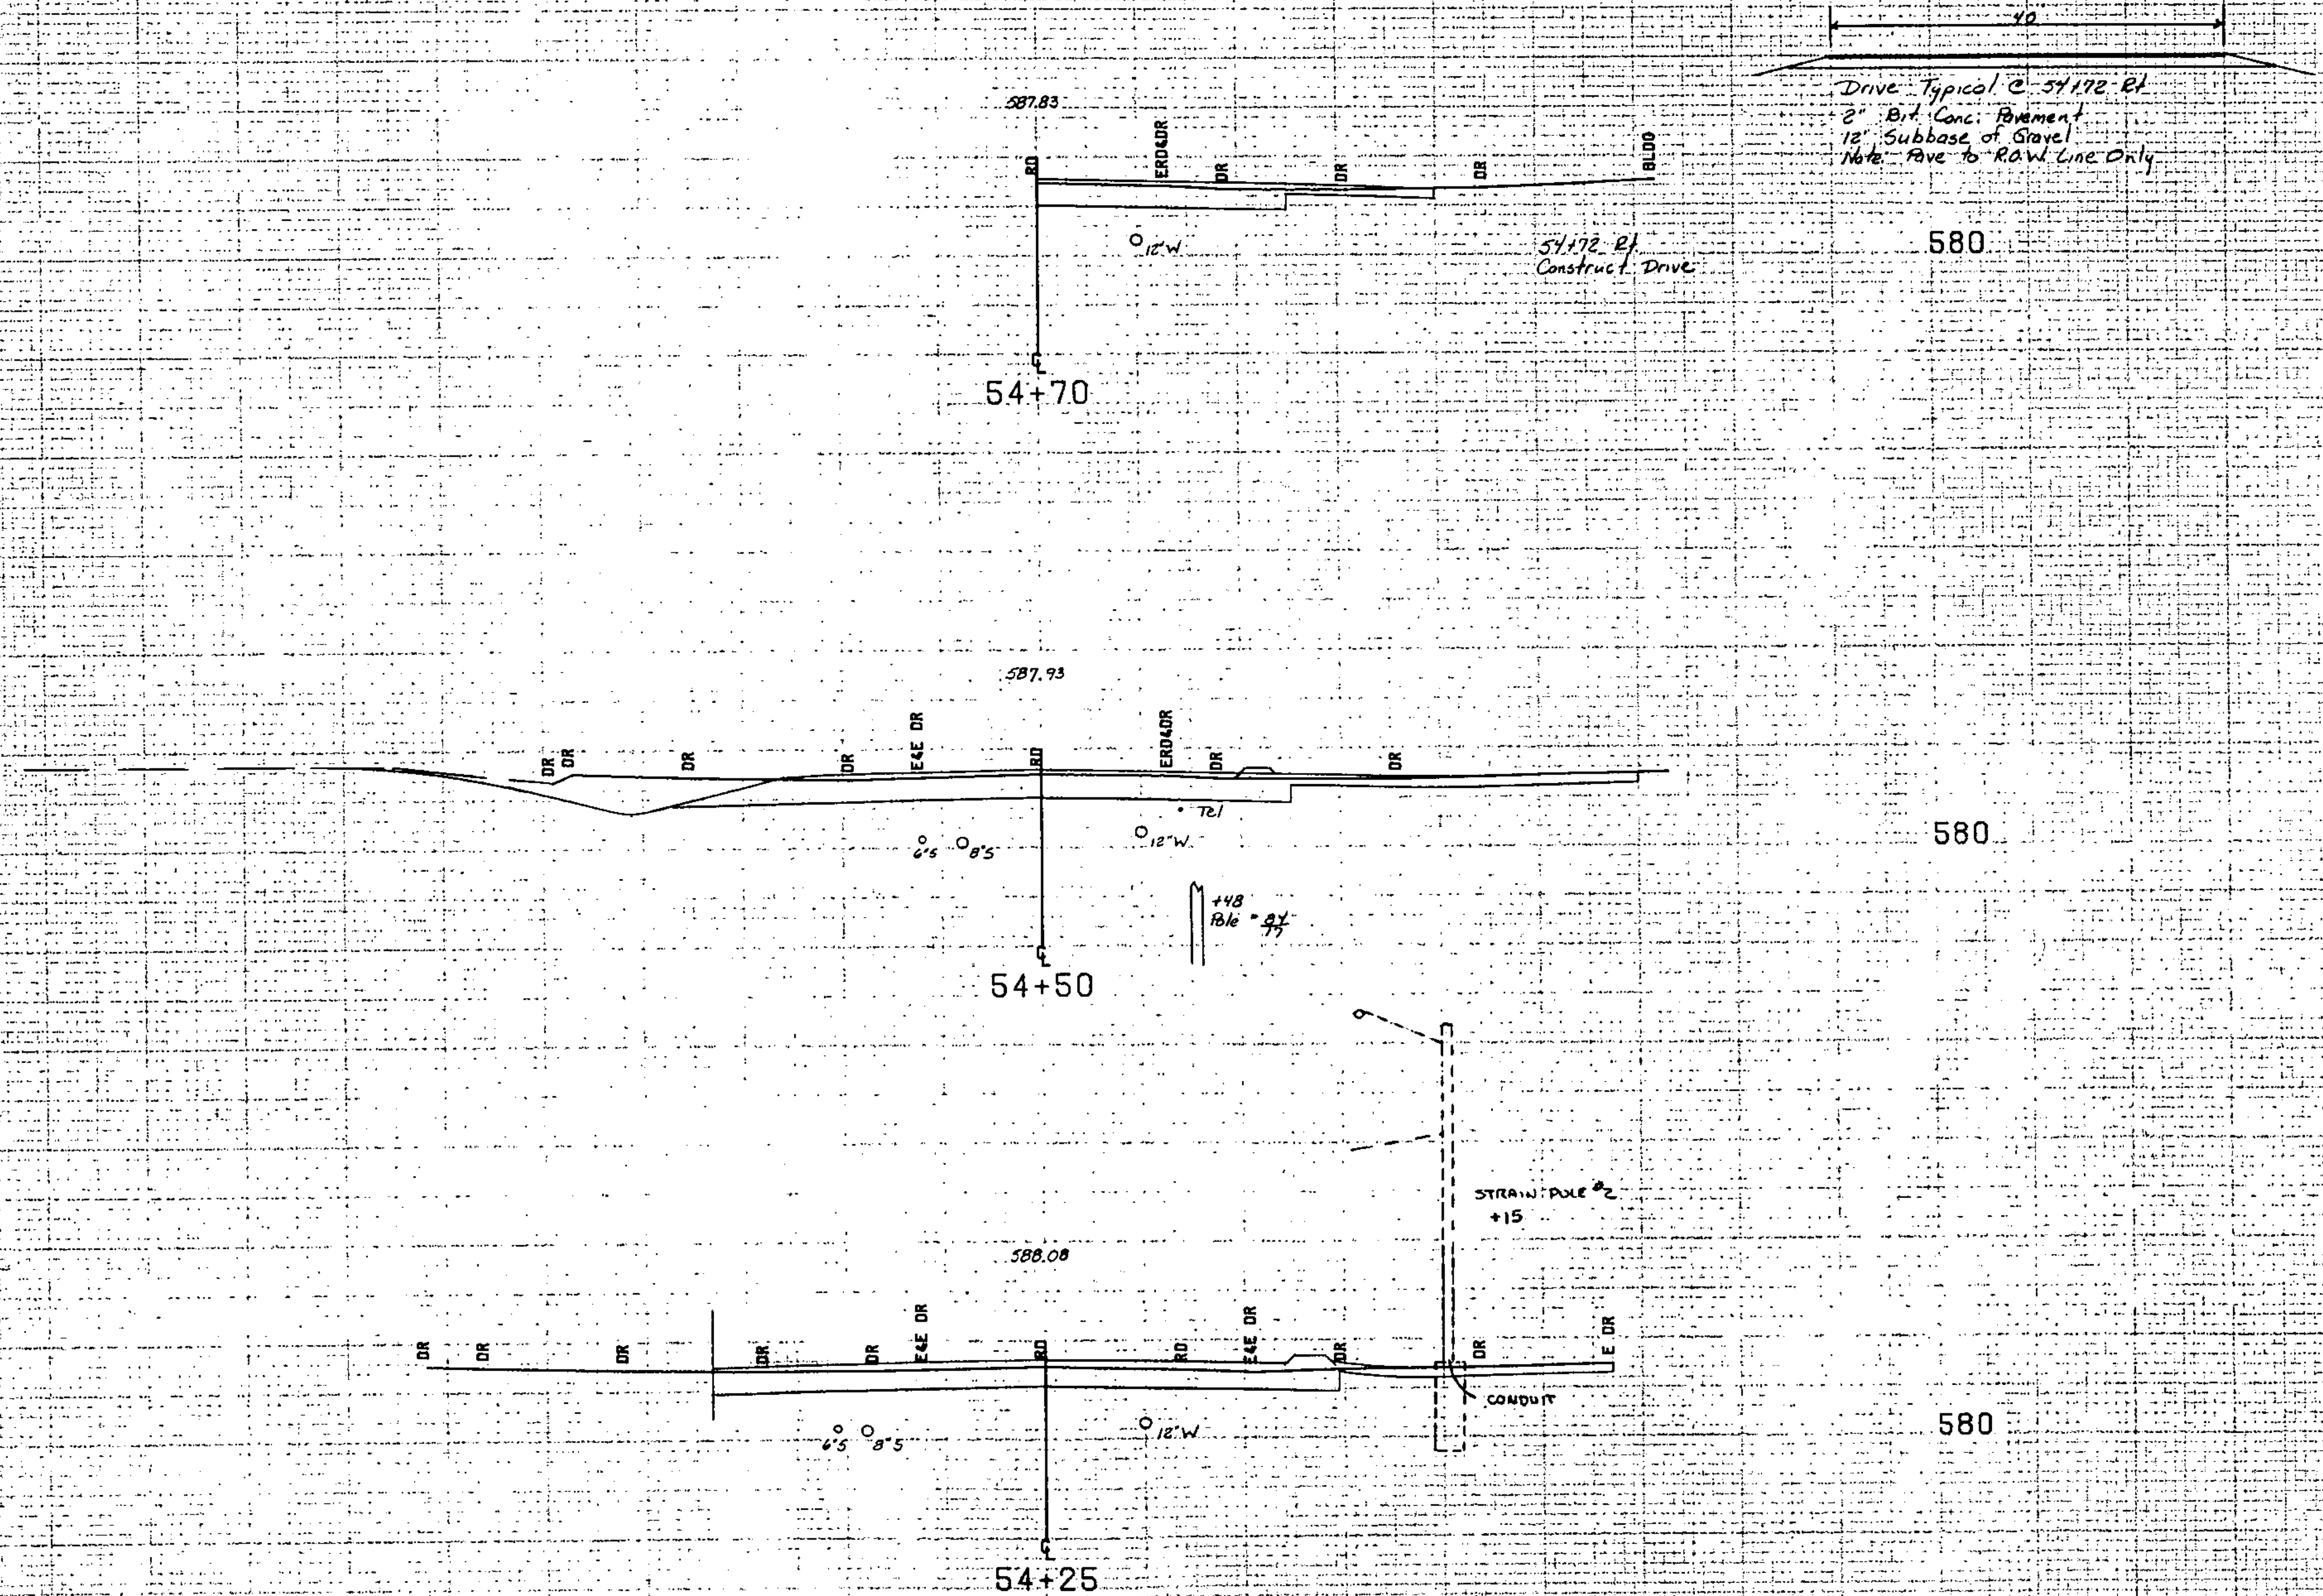

Drive: Typical C 54+70 R.O.
2\"/>

580

580

580

FROM STA. 54+25 TO STA. 54+70
PROJECT NAME ST. JOHNSBURY U.S. RTE. 5
NO. DP-FD041-1(10) PLOTTED 12/11/84
SURVEYED BY FANTONI 11779
SHEET 25 OF 25 SHEETS 229

SCALE 1\"/>