
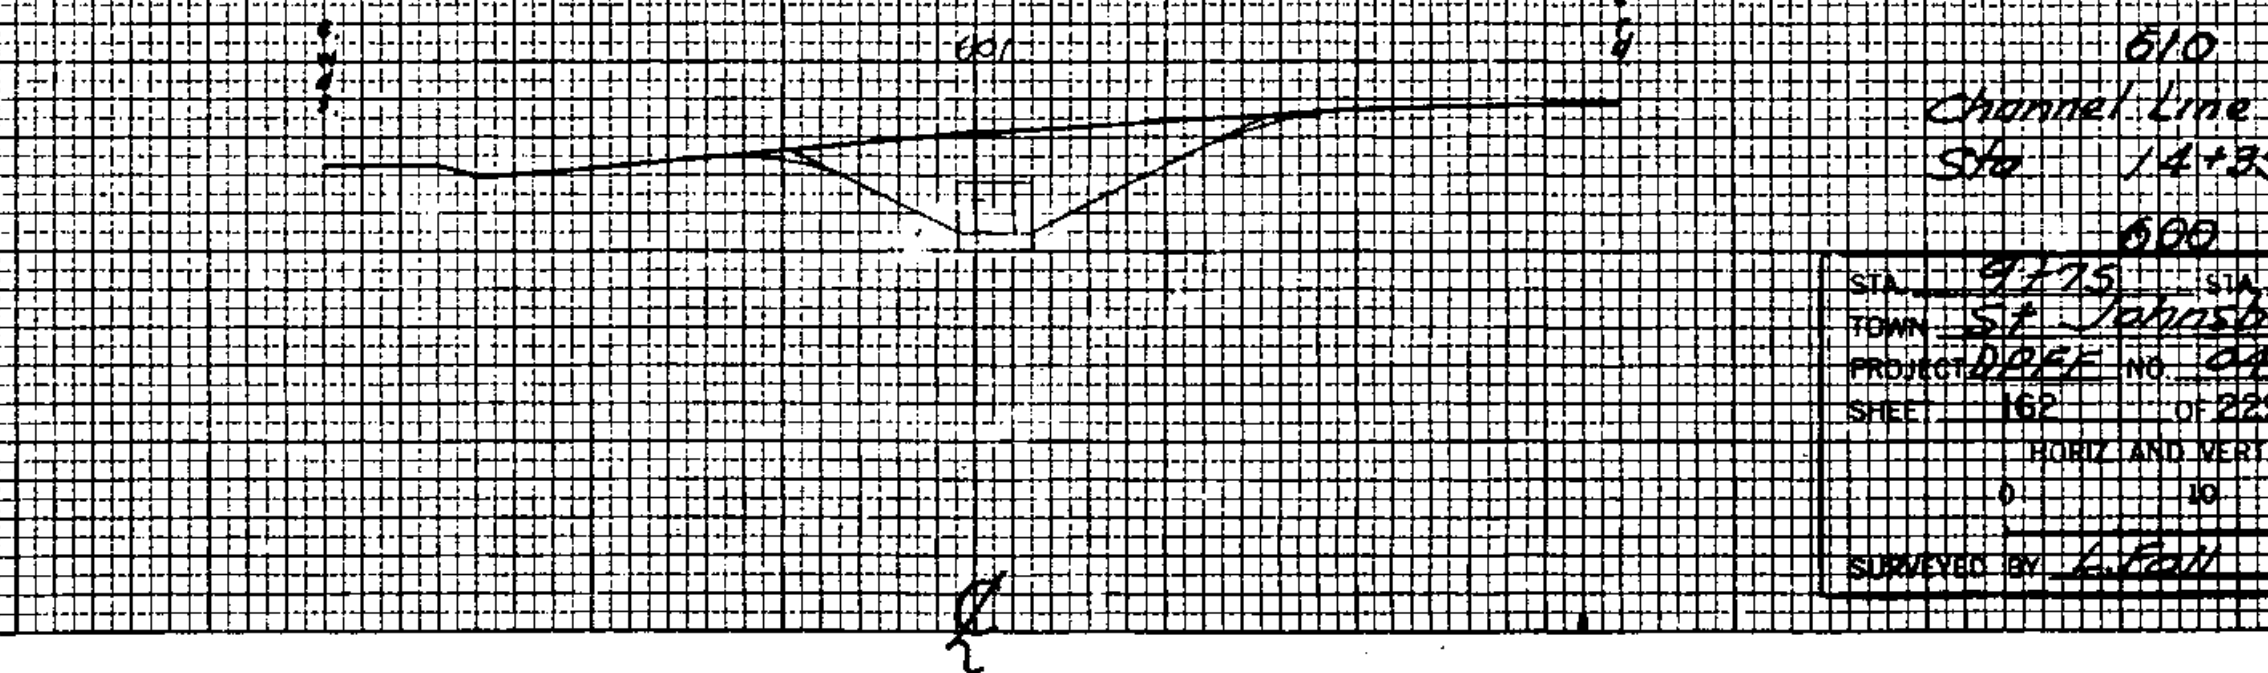
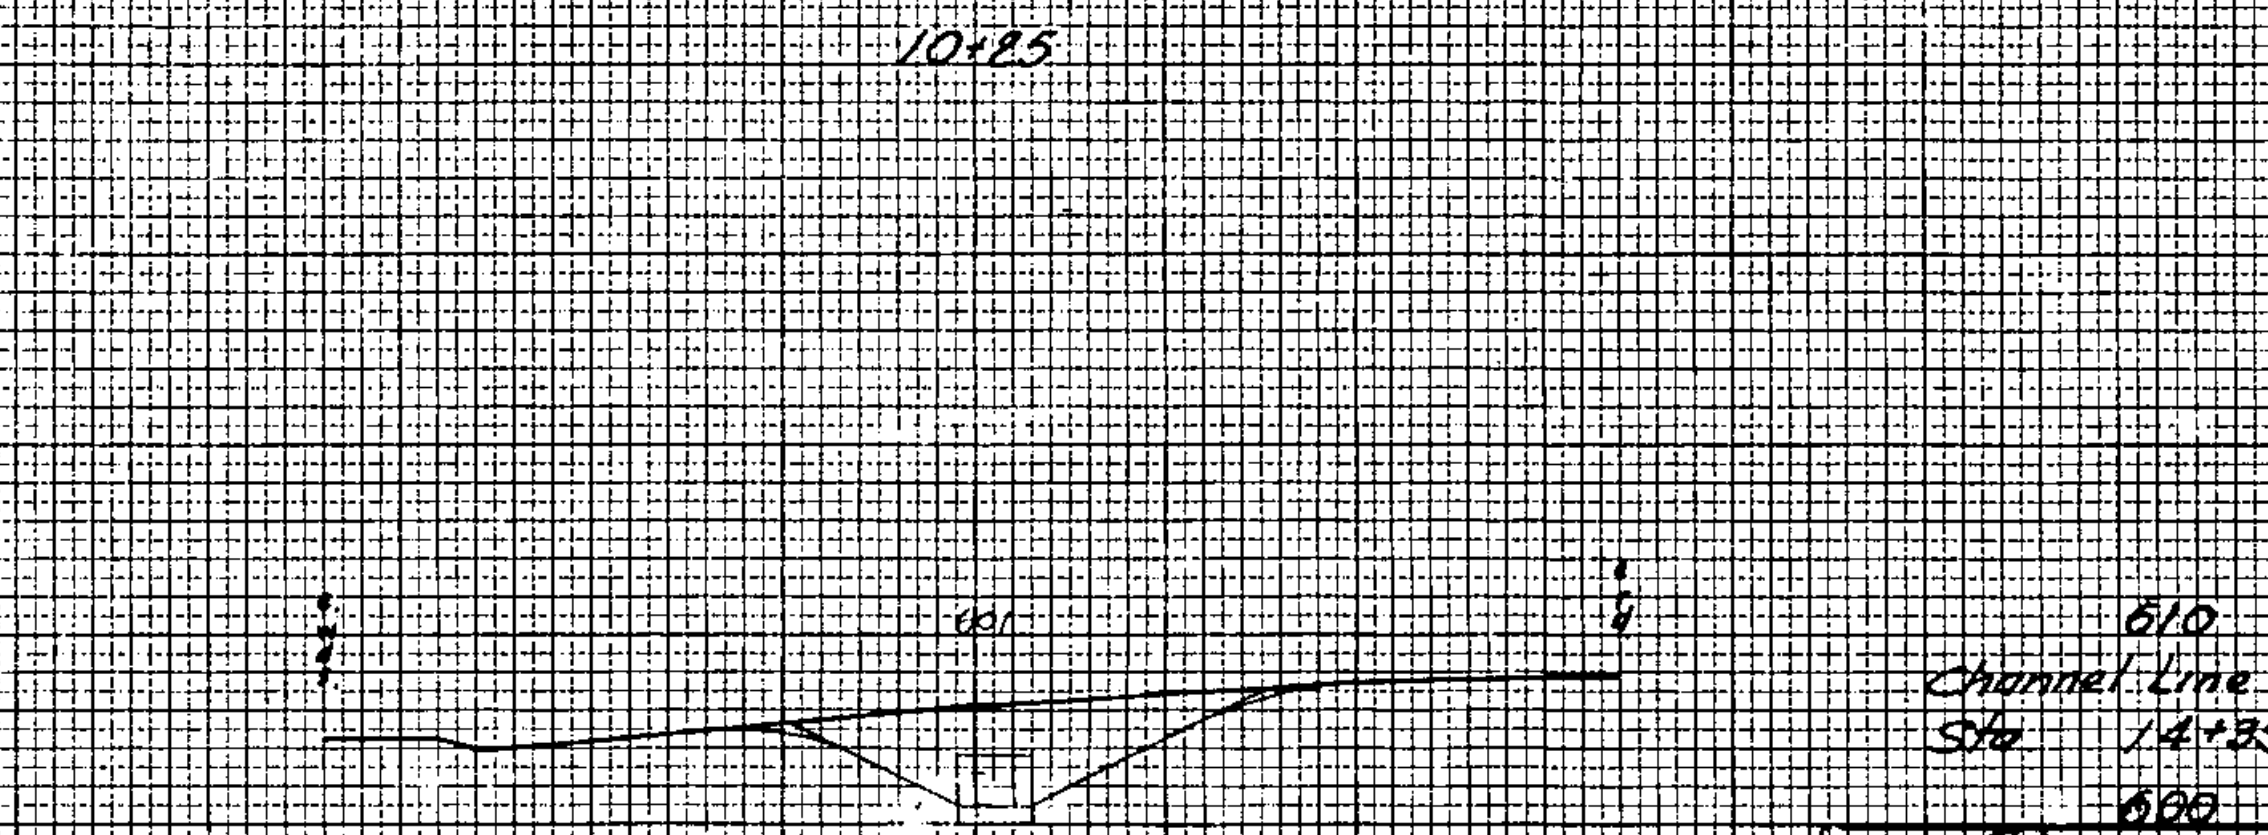
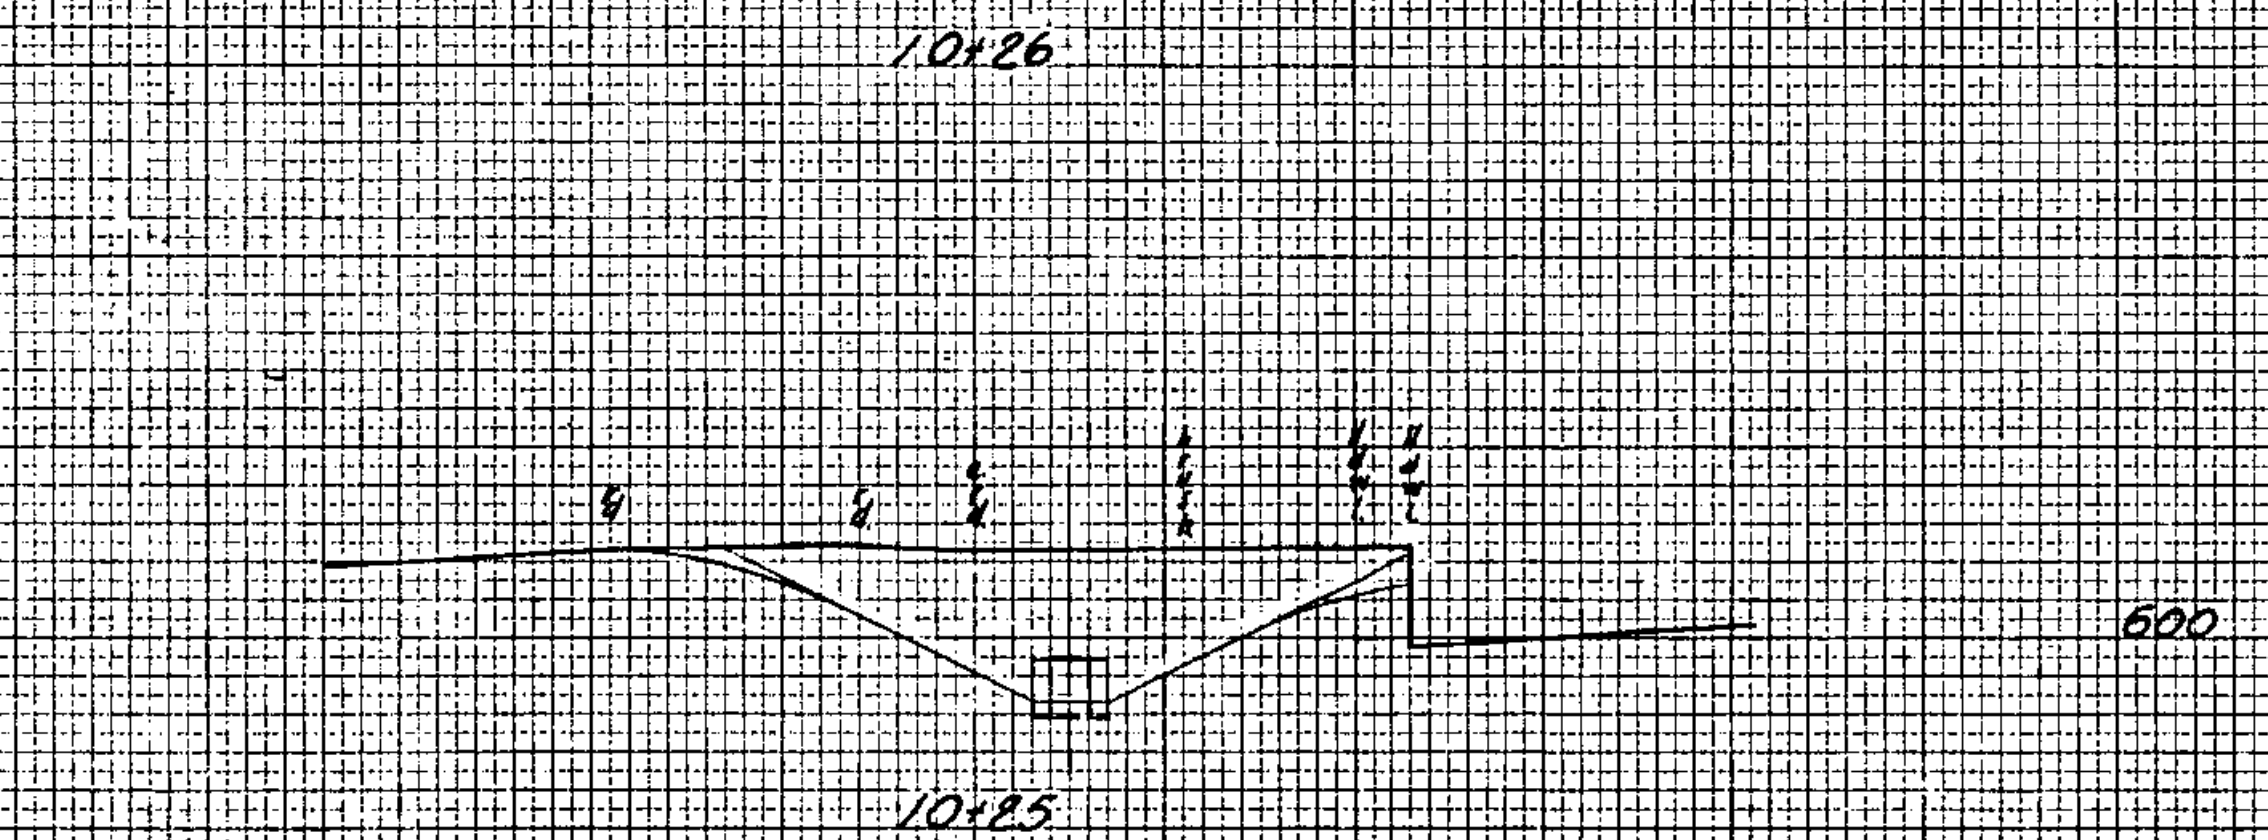
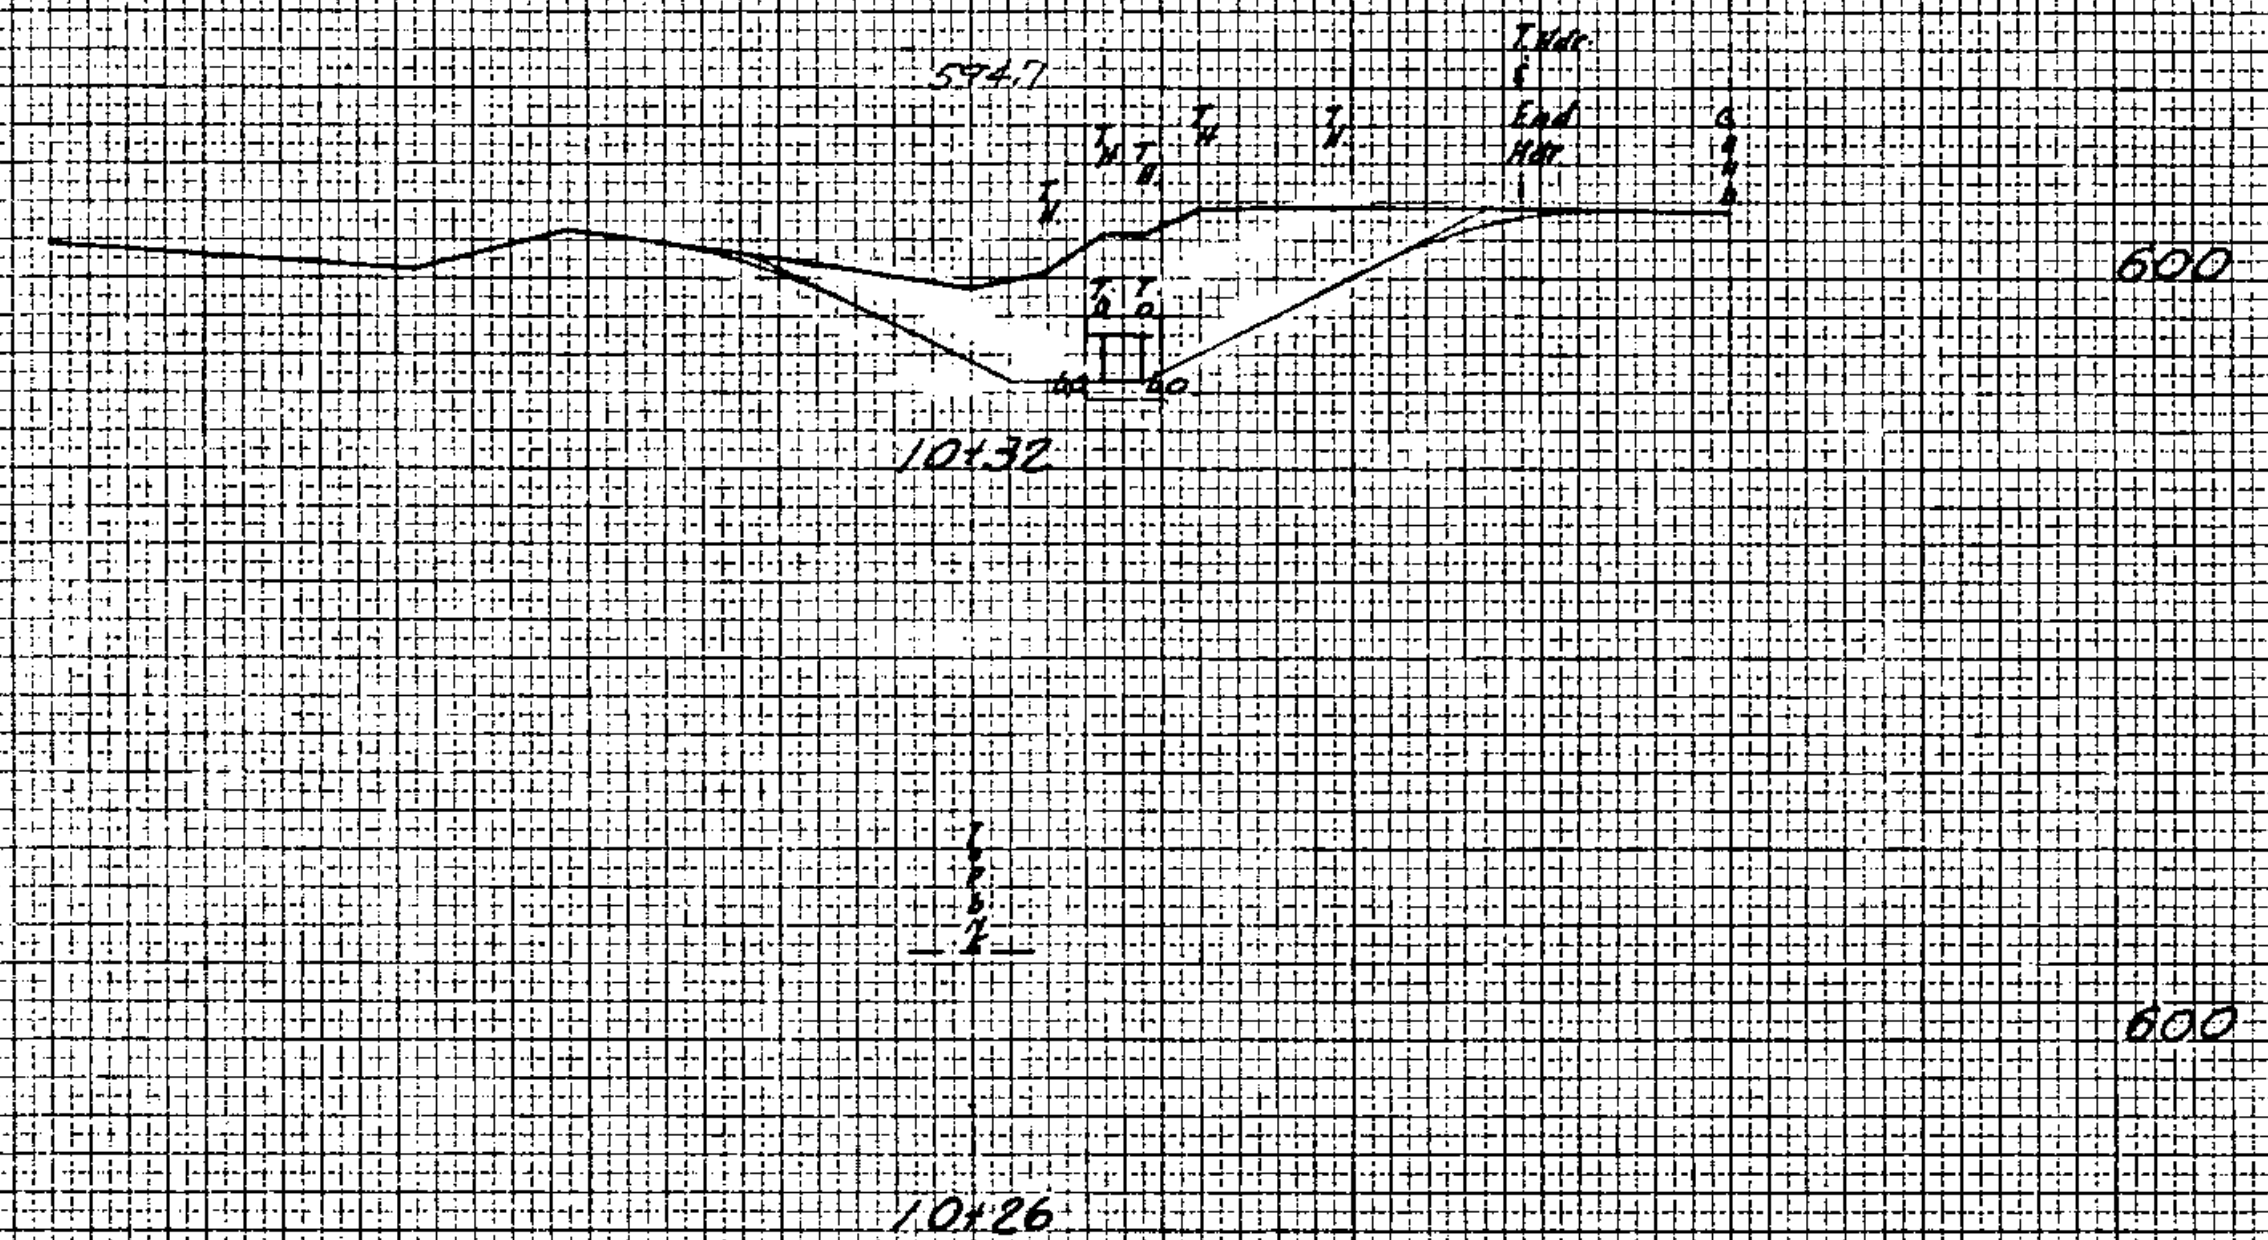
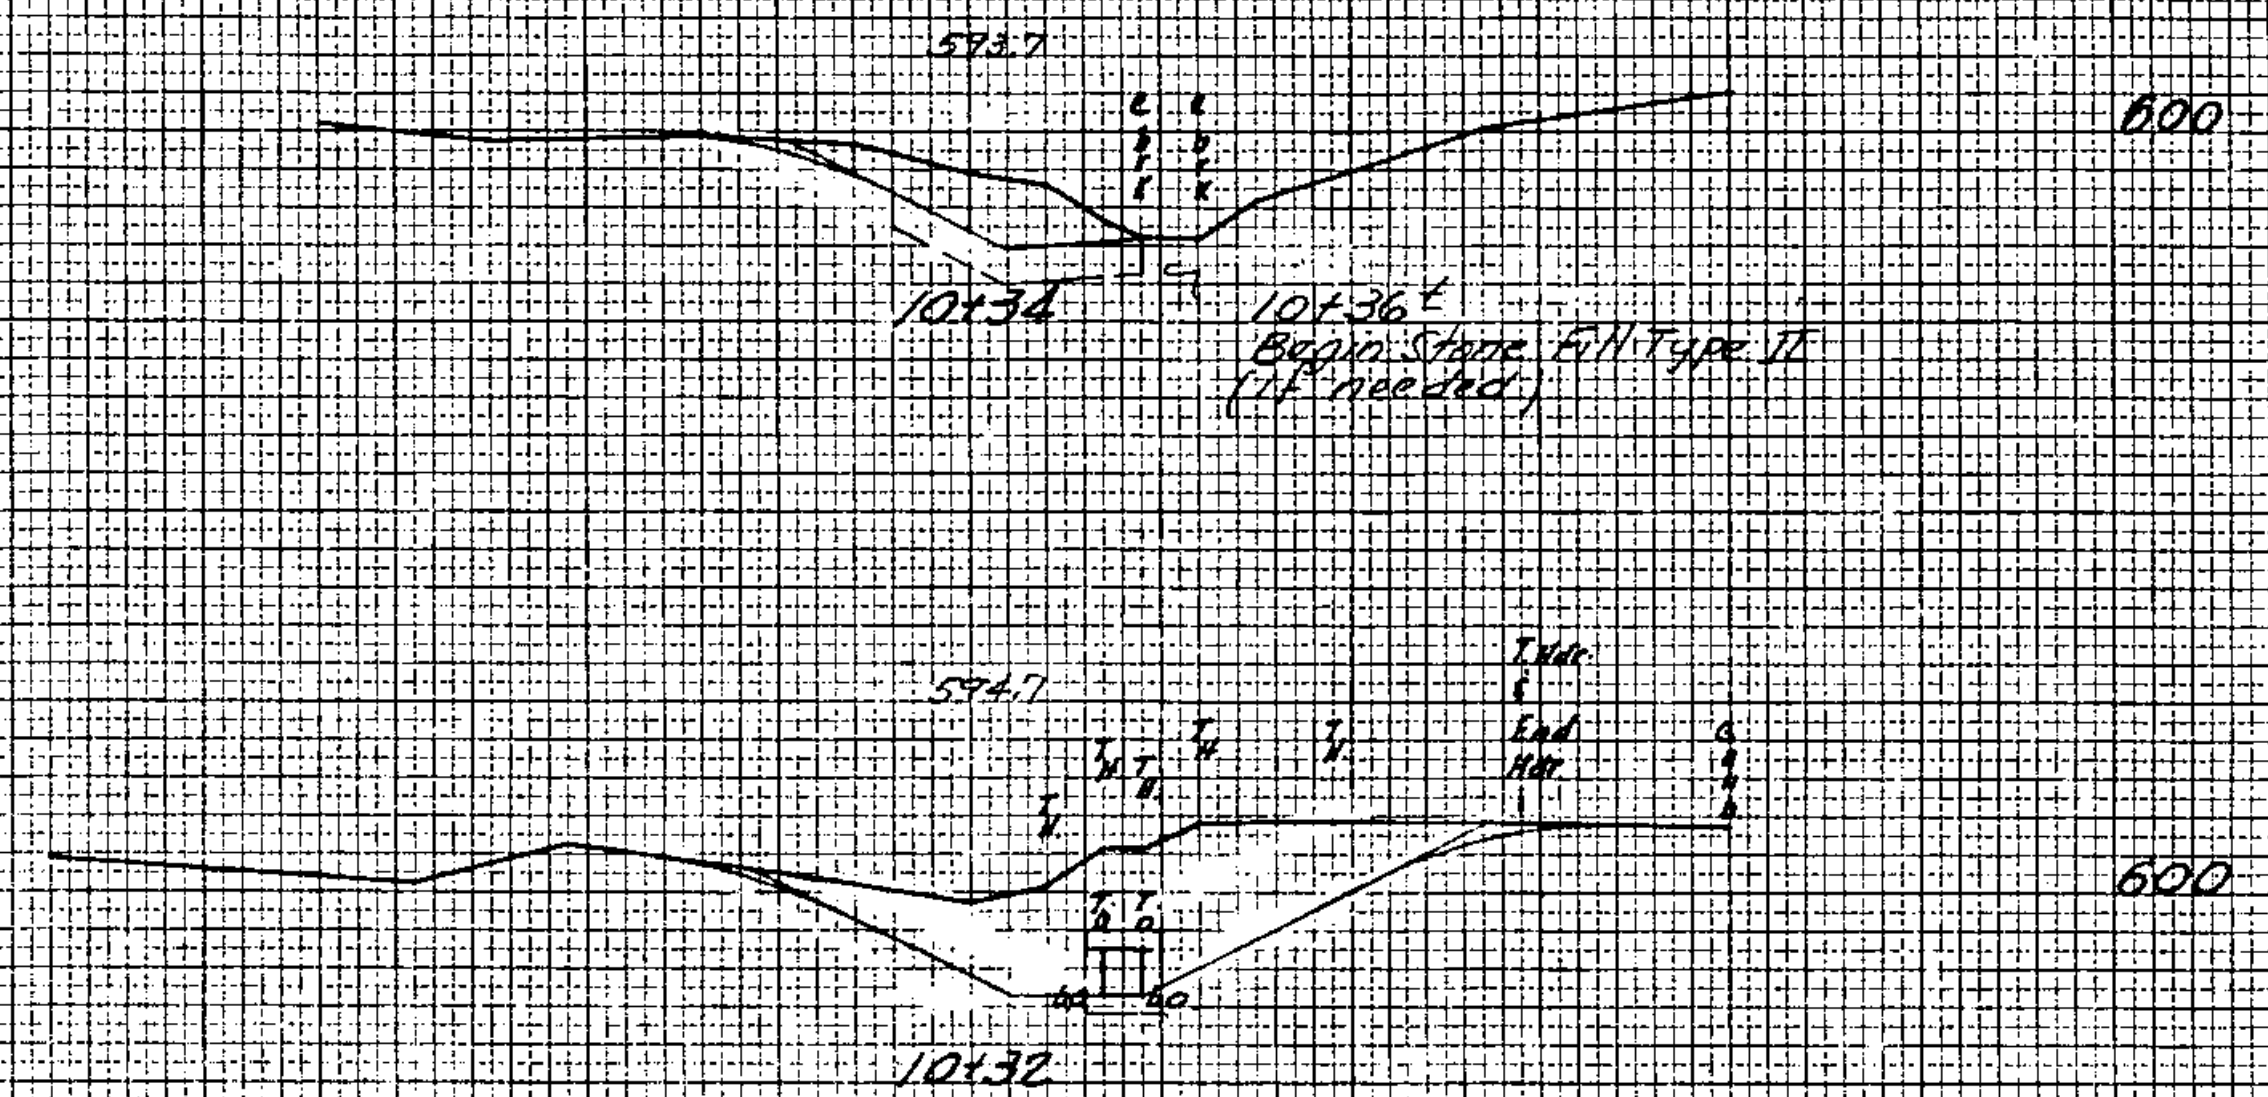
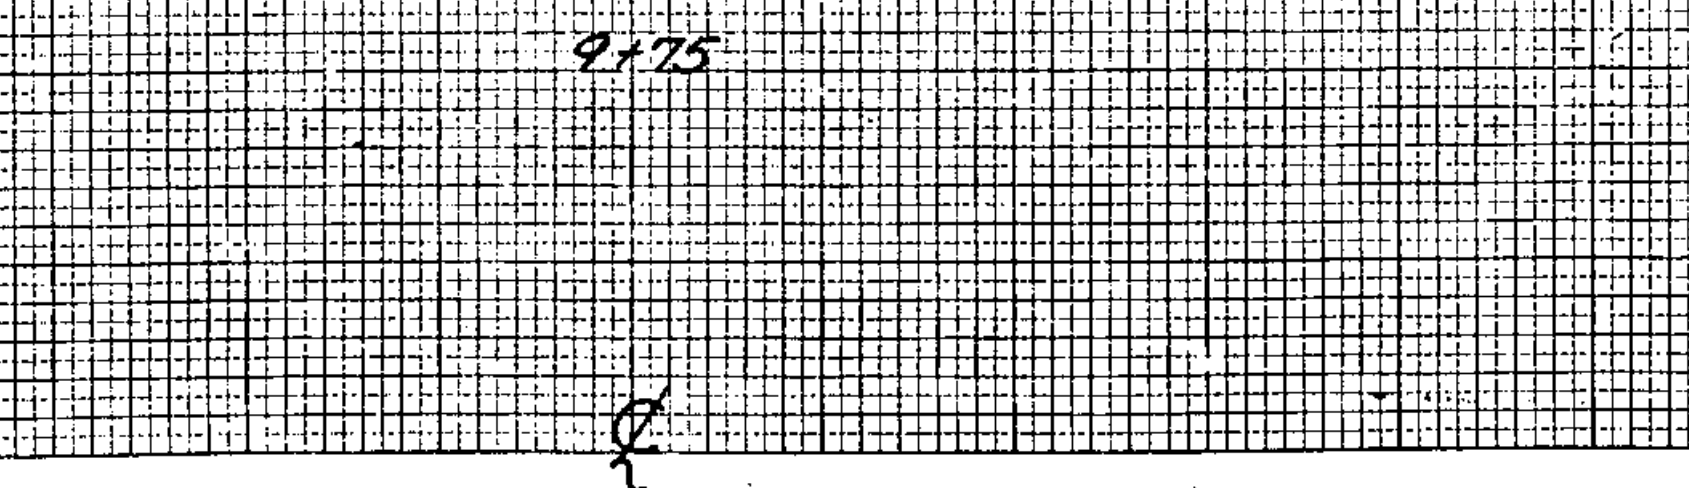
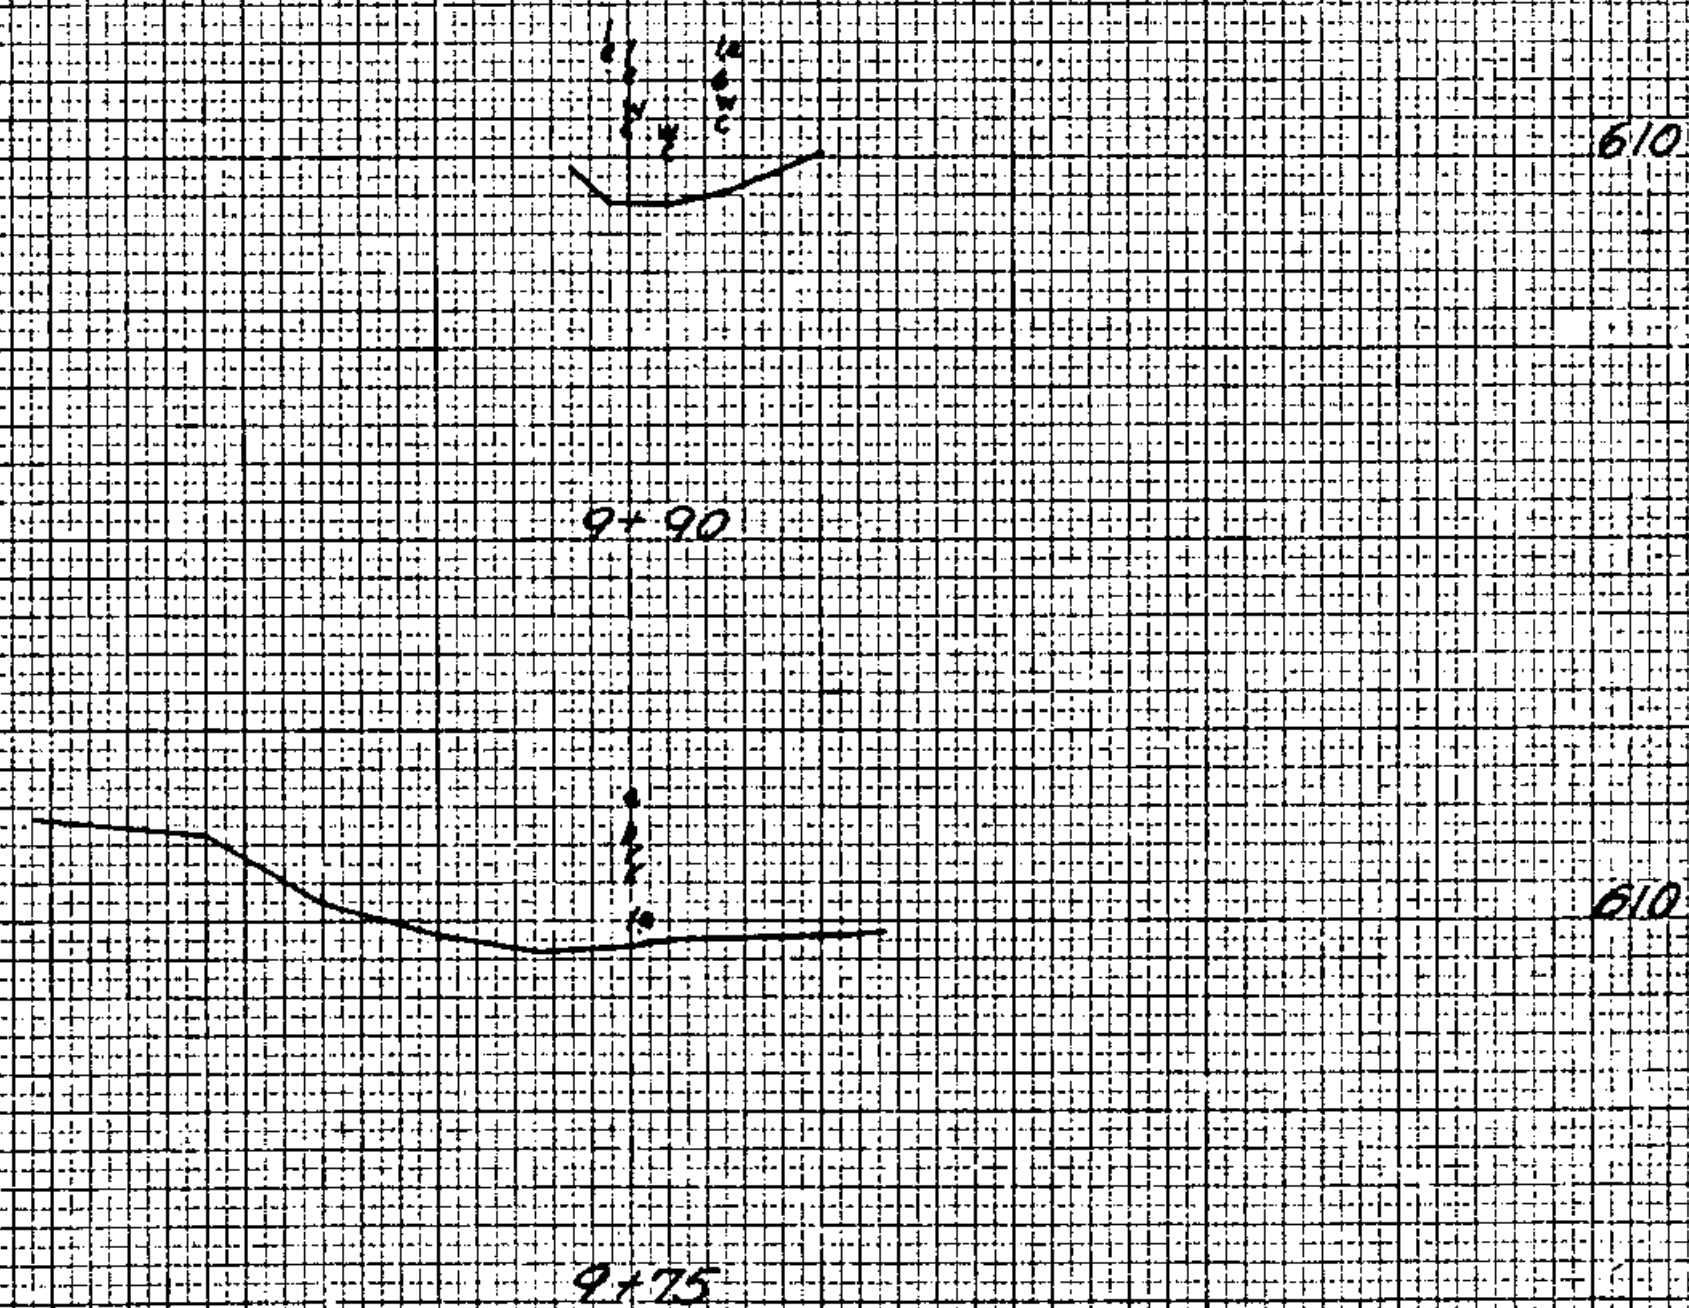
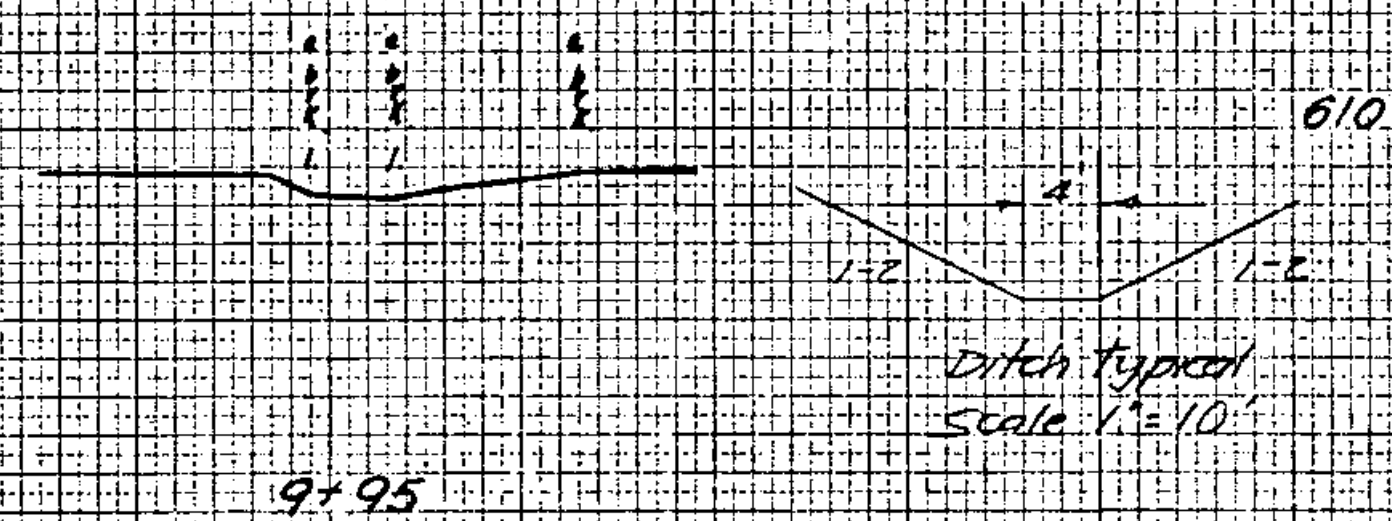


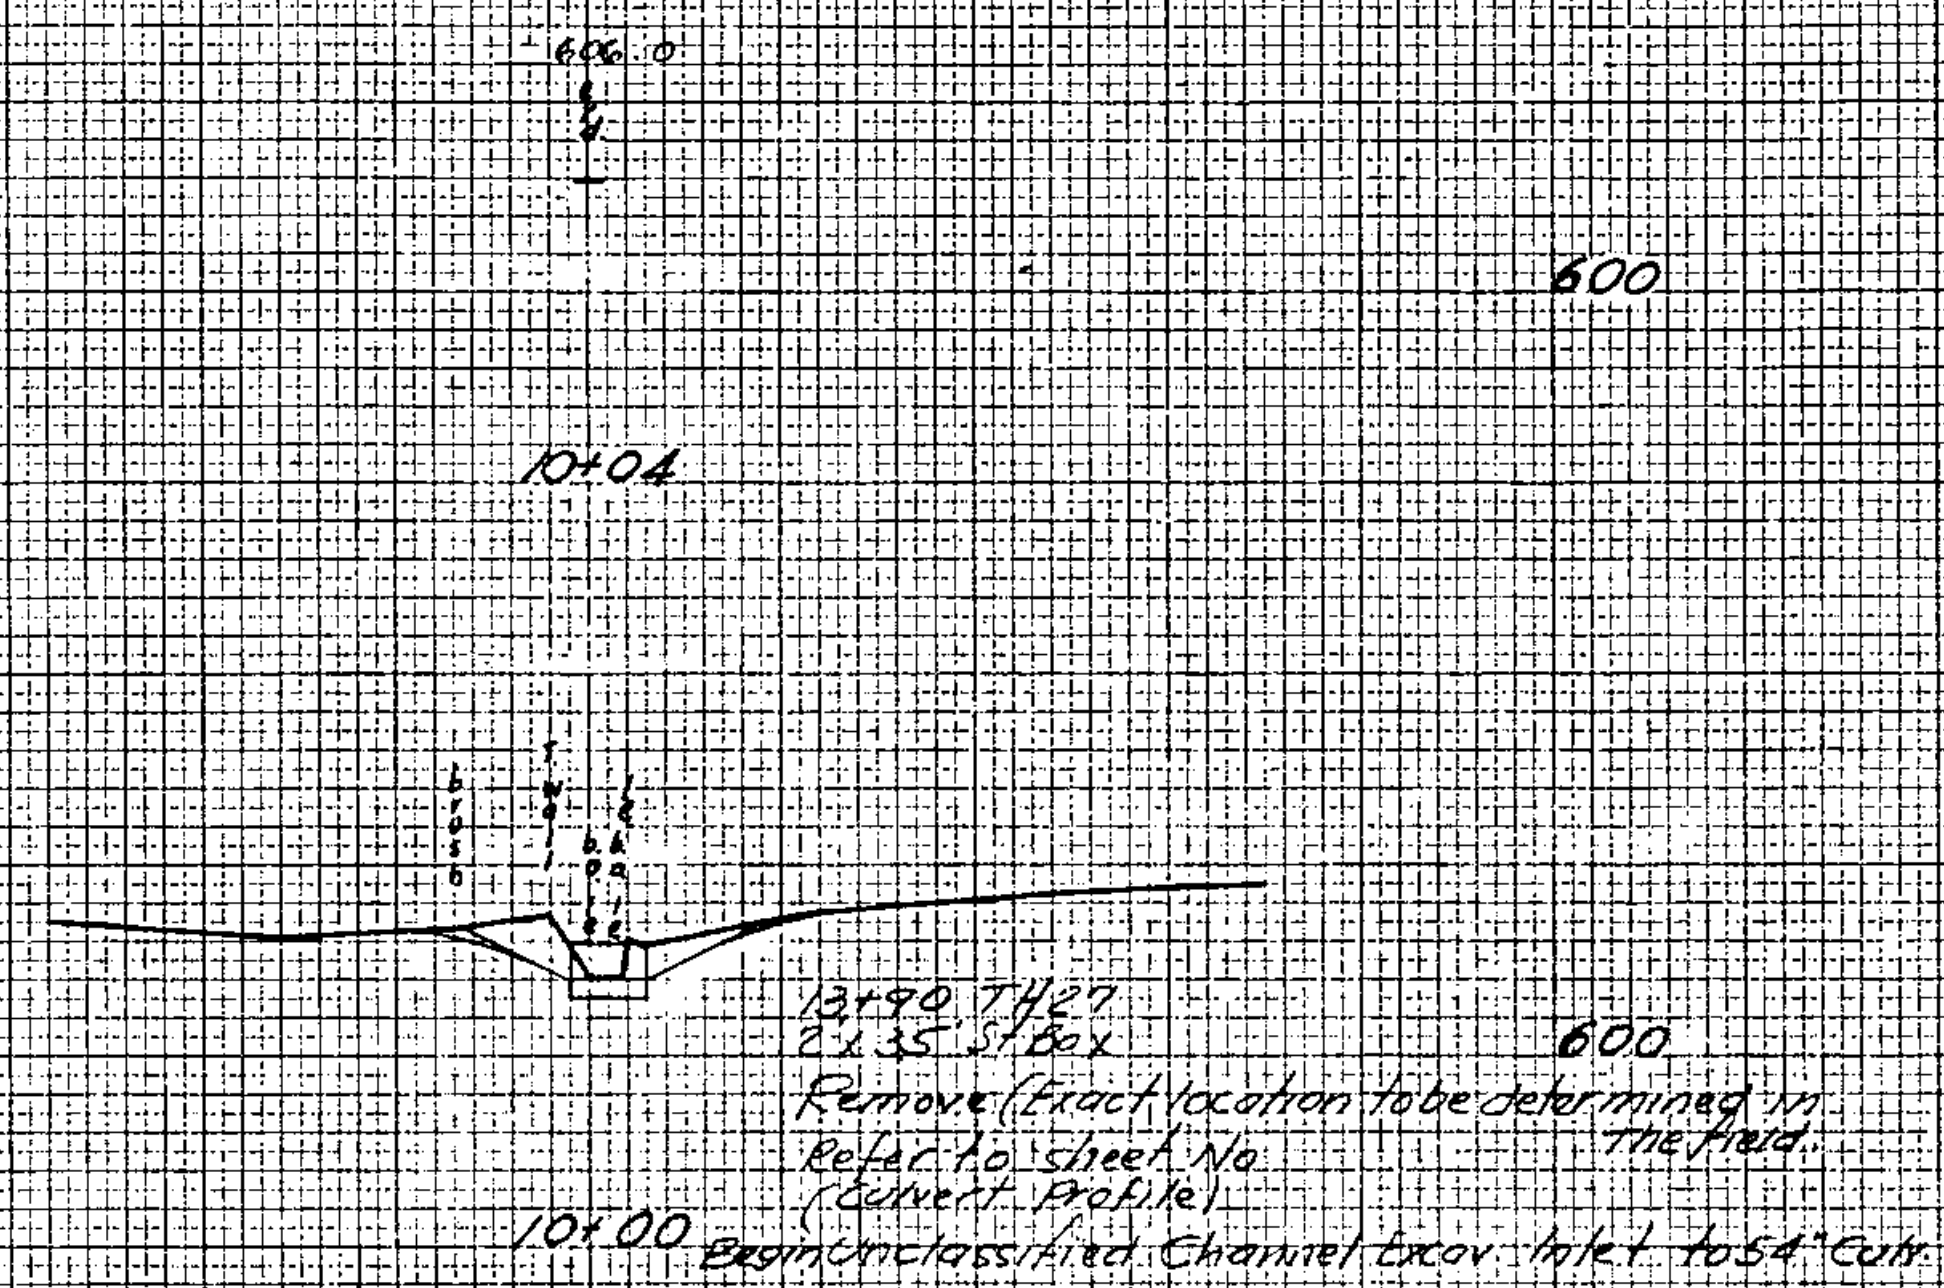

STA	9+75	STA	10+24
TOWN	St. Johnsbury	TOWN	St. Johnsbury
PROJECT	16P	PROJECT	16P
SHEET	16P	SHEET	16P
HORIZ. AND VERT. SCALE		HORIZ. AND VERT. SCALE	
0 10 20		0 10 20	
SURVEYED BY		DATE	
L. B. B.		4/12/22	