


TYPICAL SECTIONS & DESIGN DATA

ITEM 406.25 BITUMINOUS CONCRETE PAVEMENT
LEVELING COURSE TYPE III or IV, (LEVEL COURSE 2")
AS DIRECTED BY THE ENGINEER
1" WEARING COURSE TYPE III

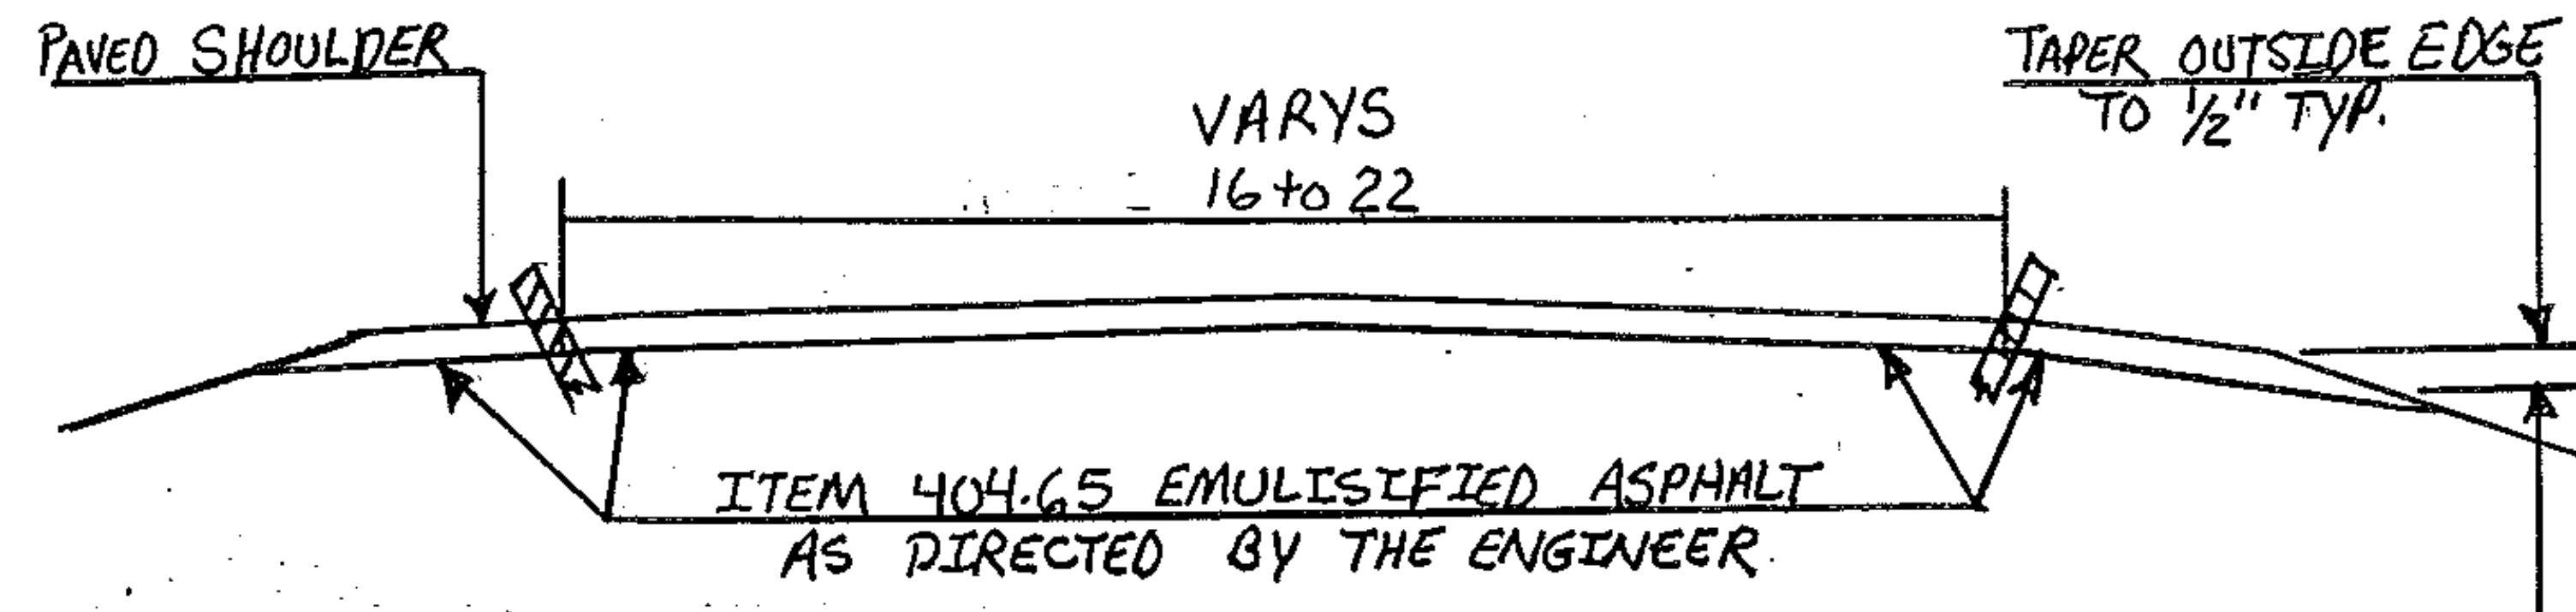

RAMP	LENGTH IN FEET	ADT (1982)	CURB RIGHT	CURB TO CURB	CURB LEFT	SHOULDER WIDTH	TRAVELWAY WIDTH	TOWN
C	100	220			0.00 TO 0.019	4	22	MIDDLESEX
C	50	220	0.00 TO 0.009			4	22	MIDDLESEX
C	428	220				4	16	MIDDLESEX
C	158	220	0.100 TO 0.130			4	16	MIDDLESEX
C	149	220				4	16	MIDDLESEX
D	762	215				4	16	MIDDLESEX
D	80	215		0.144 TO 0.159			22	MIDDLESEX
D	70	215		0.144 TO 0.157			22	MIDDLESEX