


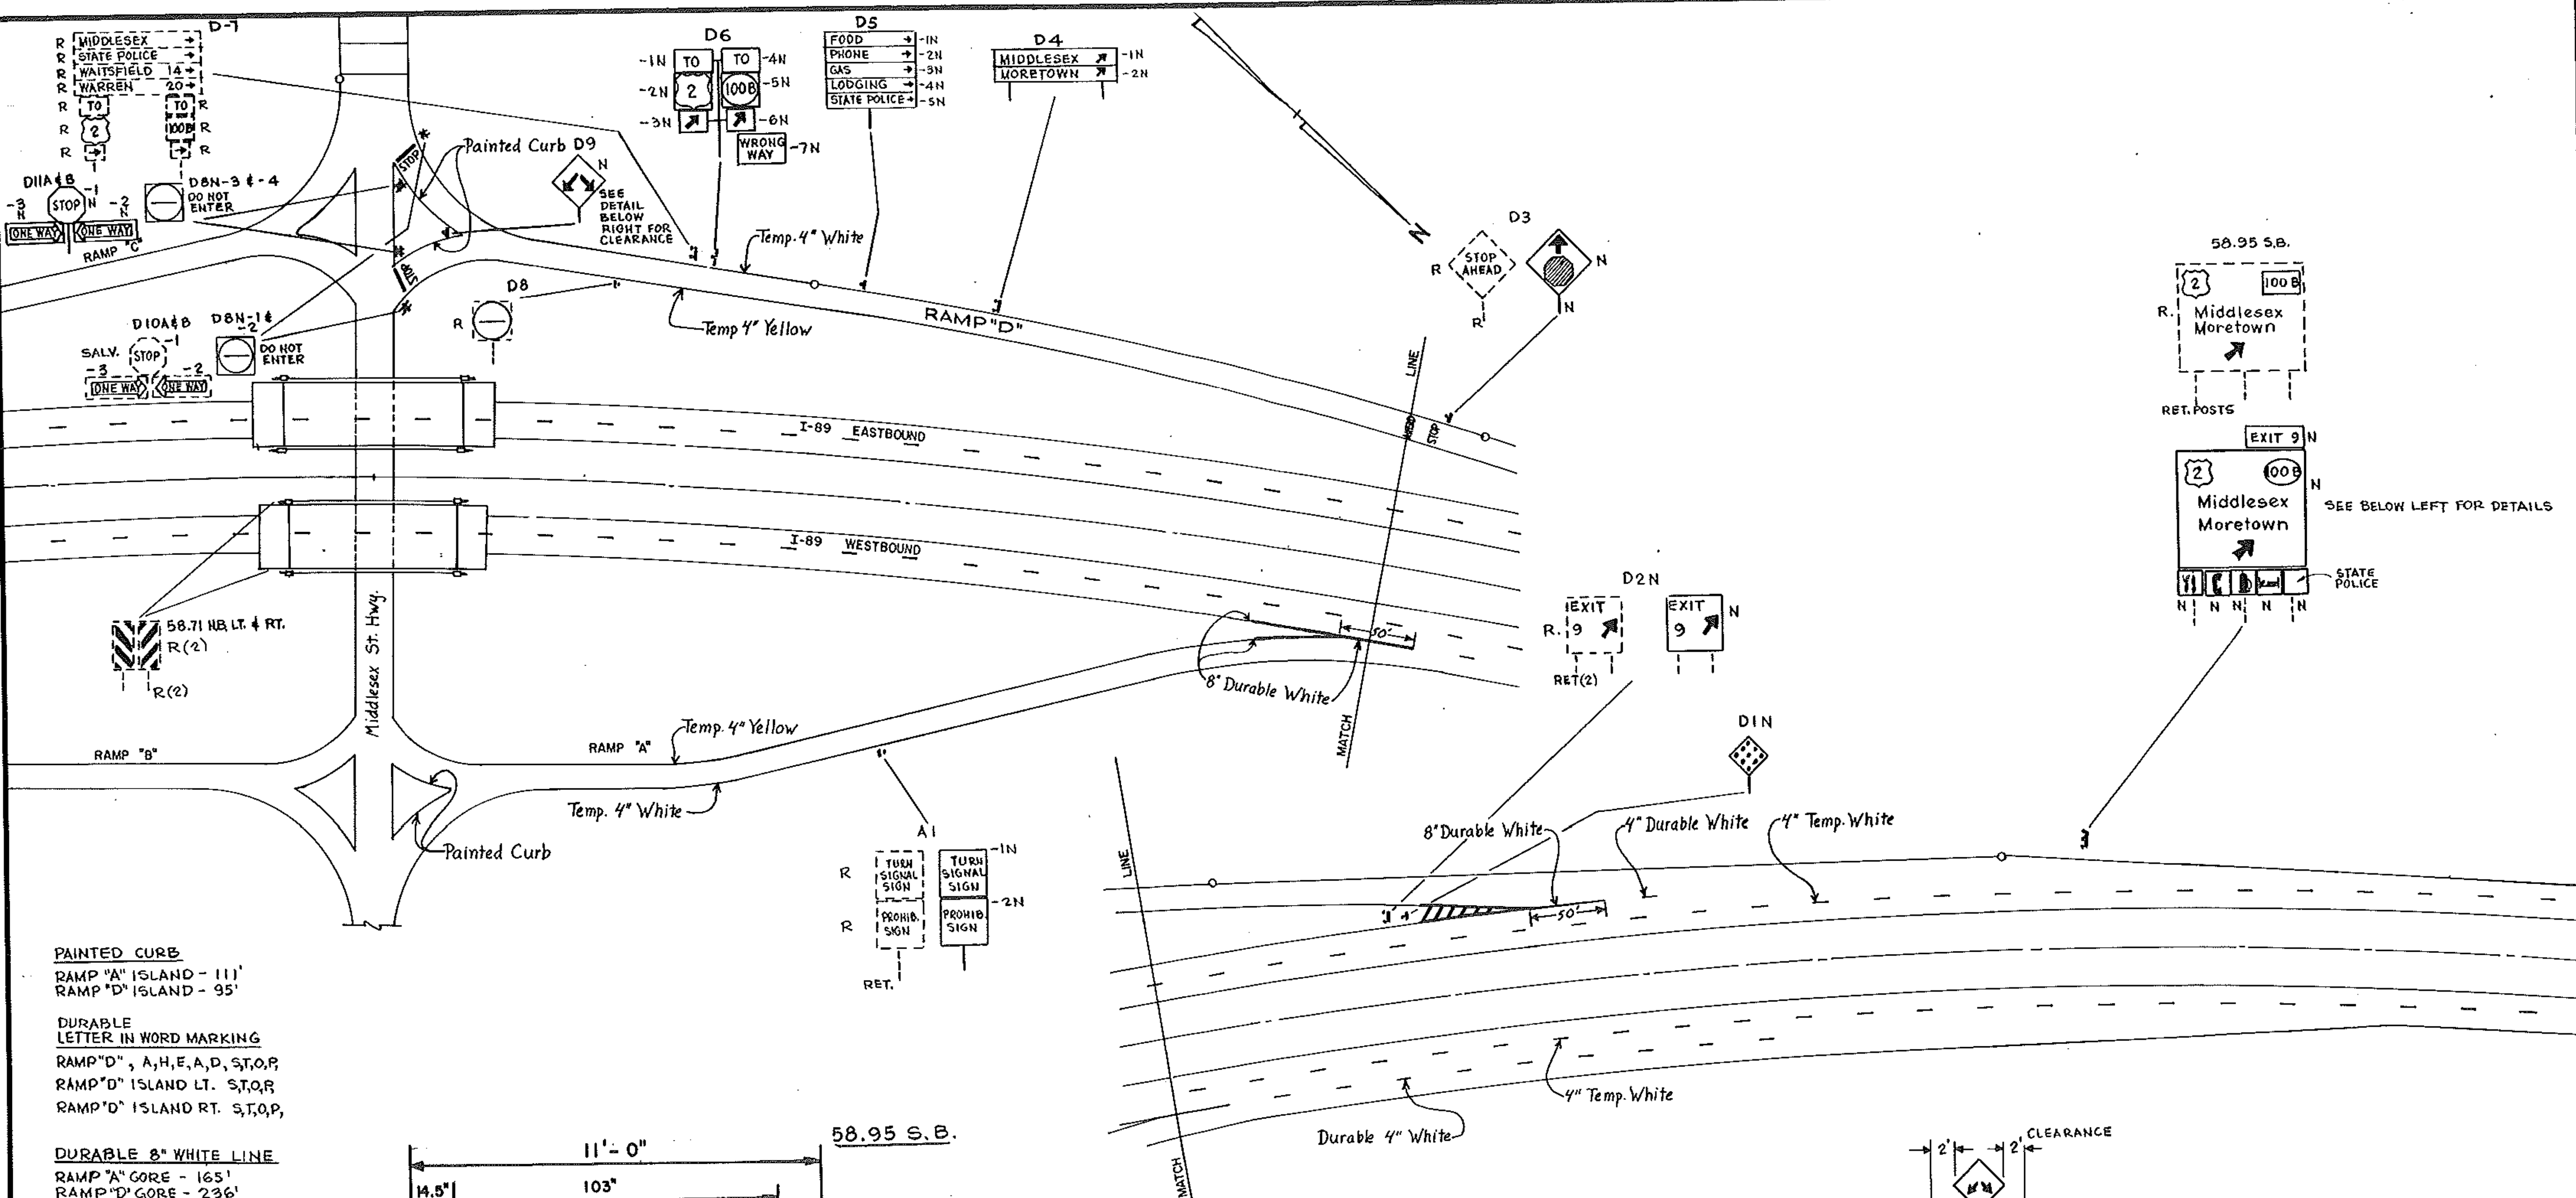


PAINTED CURB
 RAMP "A" ISLAND - 111'
 RAMP "D" ISLAND - 95'

DURABLE LETTER IN WORD MARKING
 RAMP "D", A, H, E, A, D, S, T, O, R
 RAMP "D" ISLAND LT. S, T, O, R
 RAMP "D" ISLAND RT. S, T, O, R

DURABLE 8" WHITE LINE
 RAMP "A" GORE - 165'
 RAMP "D" GORE - 236'

DURABLE 24" STOP BAR
 RAMP "D" ISLAND LT. - 16'
 RAMP "D" ISLAND RT. - 18'


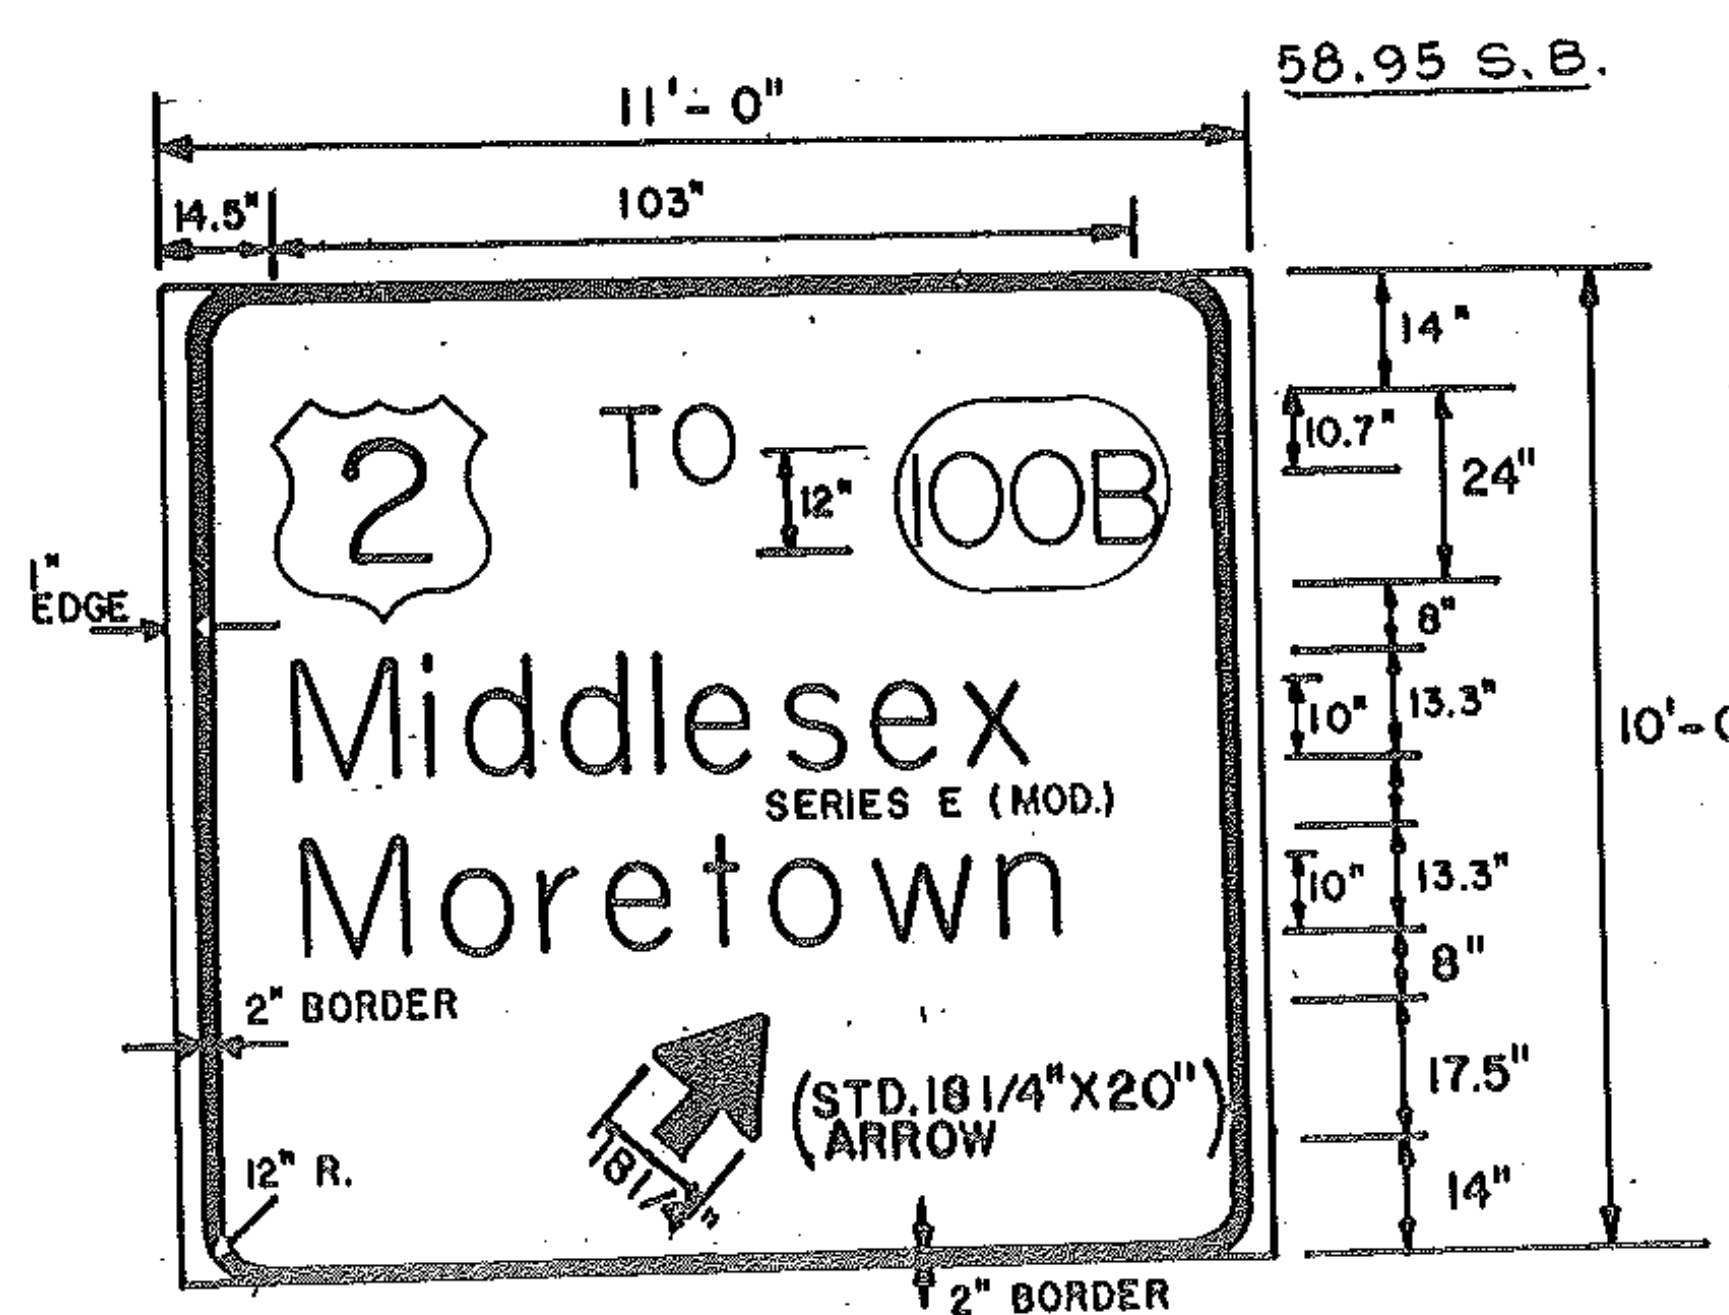


COLORS:
 TEXT, SYMBOLS, ARROW AND BORDER - WHITE, HIGH INTENSITY
 BACKGROUND - GREEN, REFLECT.
 SHIELD NUMERALS - BLACK

NOTE: MODIFICATION OF STANDARD E-14
 PLYWOOD AND ACRYLIC PLASTIC REFLECTORS WILL NOT BE ALLOWED FOR USE ON TYPE "B" SIGNS.

LEGEND

[]	EXISTING SIGN & POST
RET.	RETAIN
R.	REMOVE
SALV.	SALVAGE
[] N	NEW SIGN & POST

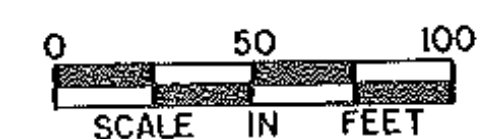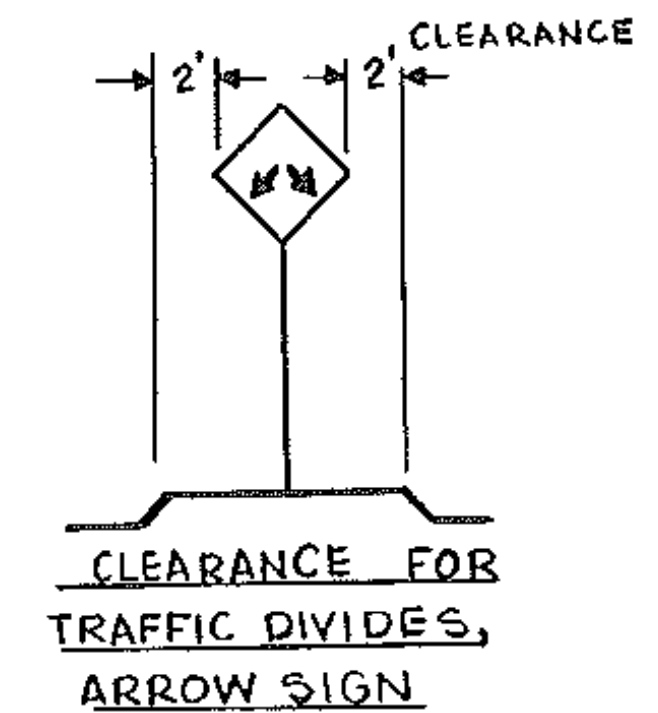

INTERCHANGE #9

SURVEYED BY _____ DATE _____
 DRAWN BY _____ DATE _____
 TRACED BY C. MURDOCK DATE 7-85
MIDDLESEX - WATERBURY
 PROJ. 1R NO 089-2(6)
 SHEET 9 OF 34