


COMPOSITE SHEET - TRAFFIC ITEM SUMMARY - TRAFFIC SIGN SUMMARY SHEET - NOTES AND DETAILS

MILEMARKER, STATION, OR SIGN NUMBER	LEGEND	TYPE	SIGN DIMENSIONS	EXISTING SIGNS TO BE SALVAGED		NEW AND SALVAGED SIGNS (S.F.)				EXISTING POSTS			NEW POSTS										REMARKS	FOR SIGN DETAIL SEE:																																																																																																																																																																																																																																																																																																																																																																																																																																																																																																																																																																																																																																																																																																																																																																																																																																																																																																																																																																																																																																																																																																																																																																																																																																																														
				REMOVE (EA.)	RETAIN (EA.)	NEW "A"	SALVAGED "A"	NEW "B"	SALV. "B"	RETAIN	DRILL	SALV.	NUMBER OF POSTS	TYPE "A" (FLANGED CHANNEL)		TYPE "C" (ALUMINUM)				TYPE "B" (BREAKAWAY)				PLAN SHEET NUMBER	STD. SHEET NUMBER																																																																																																																																																																																																																																																																																																																																																																																																																																																																																																																																																																																																																																																																																																																																																																																																																																																																																																																																																																																																																																																																																																																																																																																																																																																													
														2.0 LB/FT	25 LB/FT	30 LB/FT	3" Ø	3" □	4" Ø	4" Ø MOD	POST SIZE	WEIGHT				FIG. SIZE 24" 30"																																																																																																																																																																																																																																																																																																																																																																																																																																																																																																																																																																																																																																																																																																																																																																																																																																																																																																																																																																																																																																																																																																																																																																																																																																																												
D7-3	WAITSFIELD →	A		X																																																																																																																																																																																																																																																																																																																																																																																																																																																																																																																																																																																																																																																																																																																																																																																																																																																																																																																																																																																																																																																																																																																																																																																																																																																																																		




TRAFFIC ITEM SUMMARY						
ITEM NUMBER	ITEM	QUANTITY	ROUNDING	UNIT	TOTAL	
646.21	PAINTED CURBS	206	4	L.F.	210	
646.64	DURABLE 24" STOP BAR	34		L.F.	34	
646.66	DURABLE LETTER IN WORD MARKING	17		EA.	17	
675.20	TRAFFIC SIGNS, TYPE "A"	352.4	2.6	S.F.	355	
675.25	TRAFFIC SIGNS, TYPE "B"	836	4	S.F.	840	
675.35	TRAFFIC SIGN POSTS, TYPE "A"	242	8	LBS.	250	
675.37	TRAFFIC SIGN POSTS, TYPE "C"	133.8	1.2	LBS.	135	
675.58	REMOVING SIGNS	42		EA.	42	
675.60	ERECTING SALVAGED SIGNS TYPE A	24.6	.4	EA.	25	

SERIES "C" NUMERALS
SERIES "B" LETTER
3" SPACING

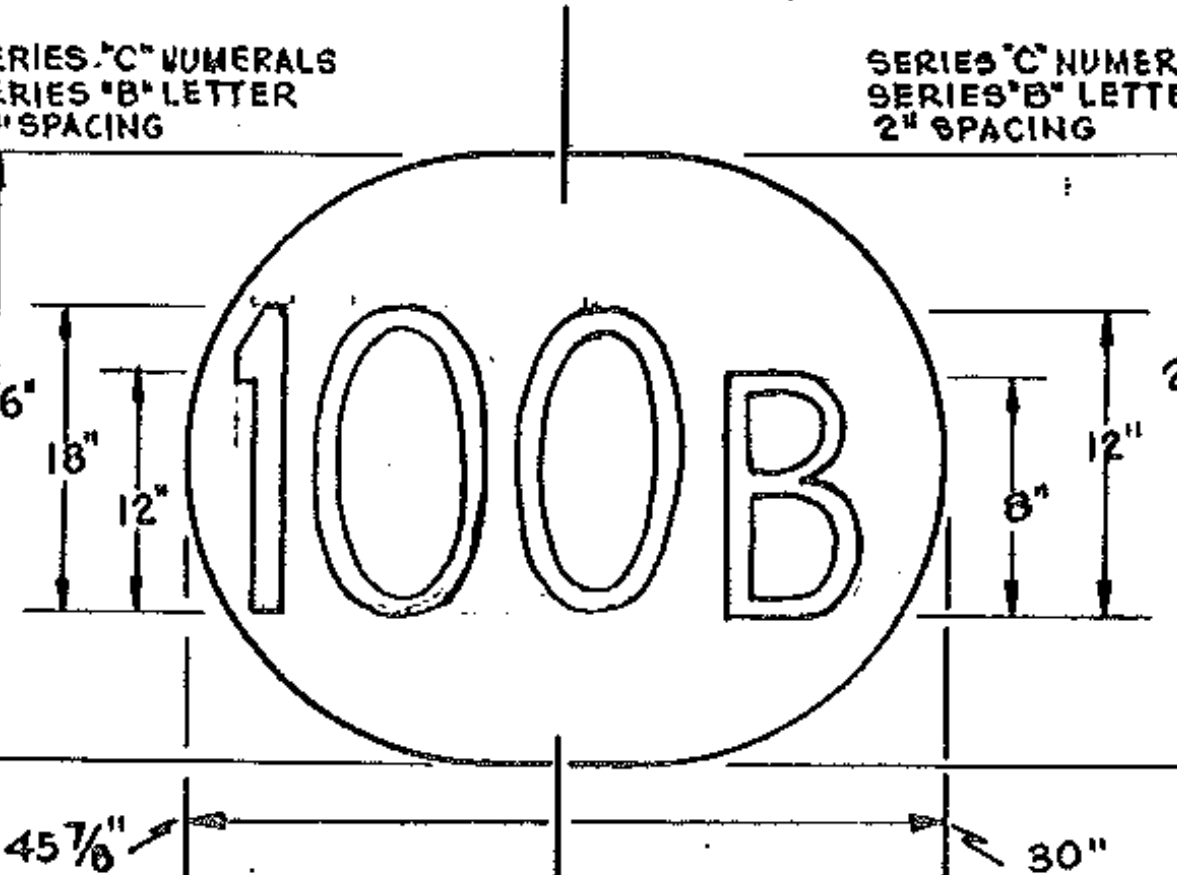

STATE ROUTE
SHIELD DETAIL
FOR SIGNS
S858.95 LT.
S859.95 LT.

NOTES AND DETAILS

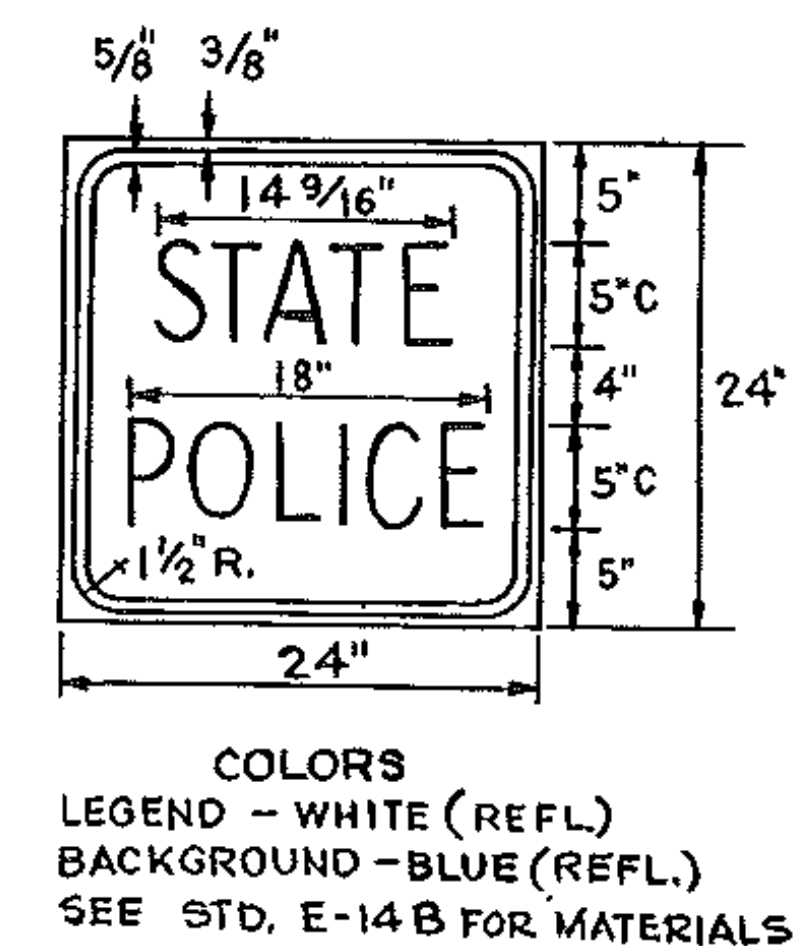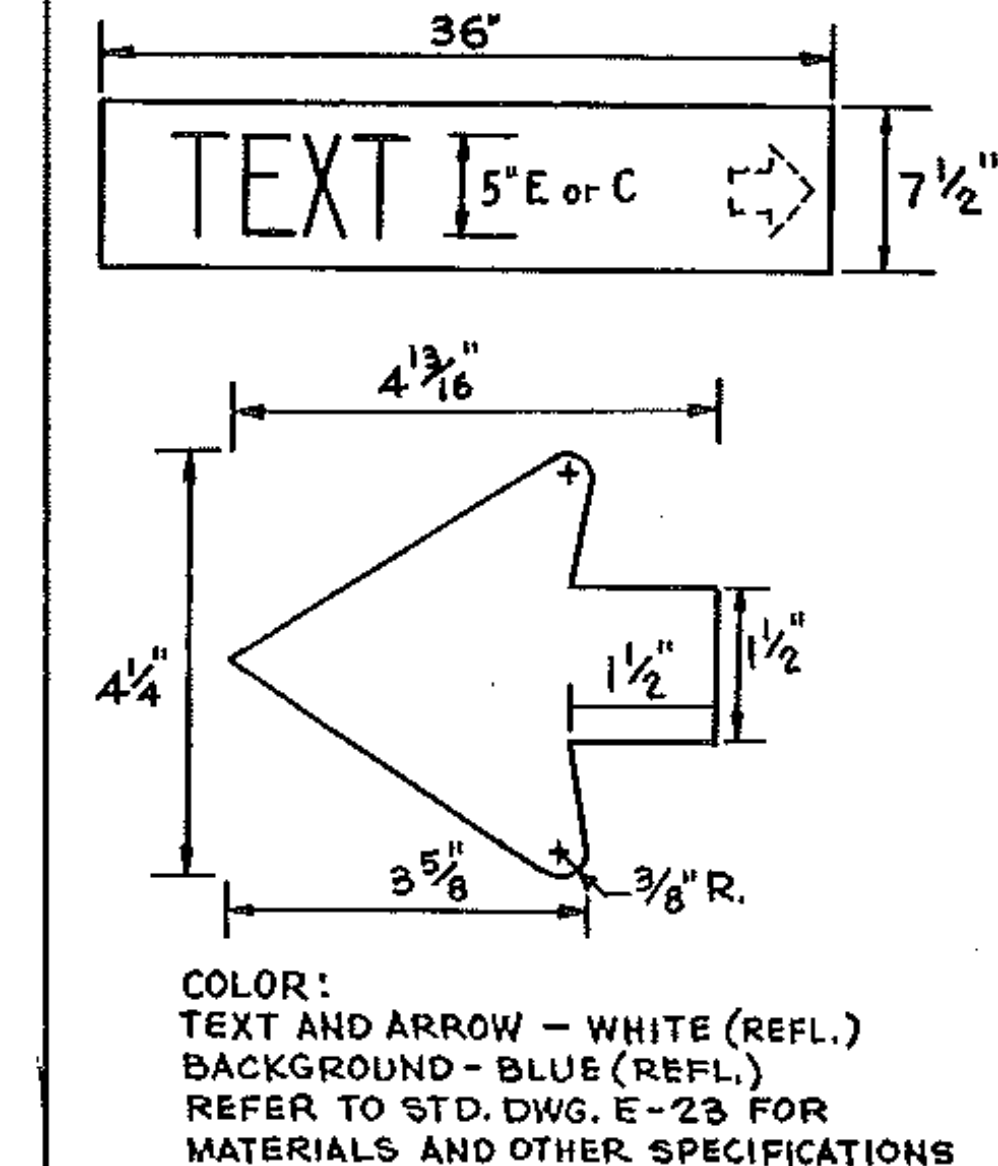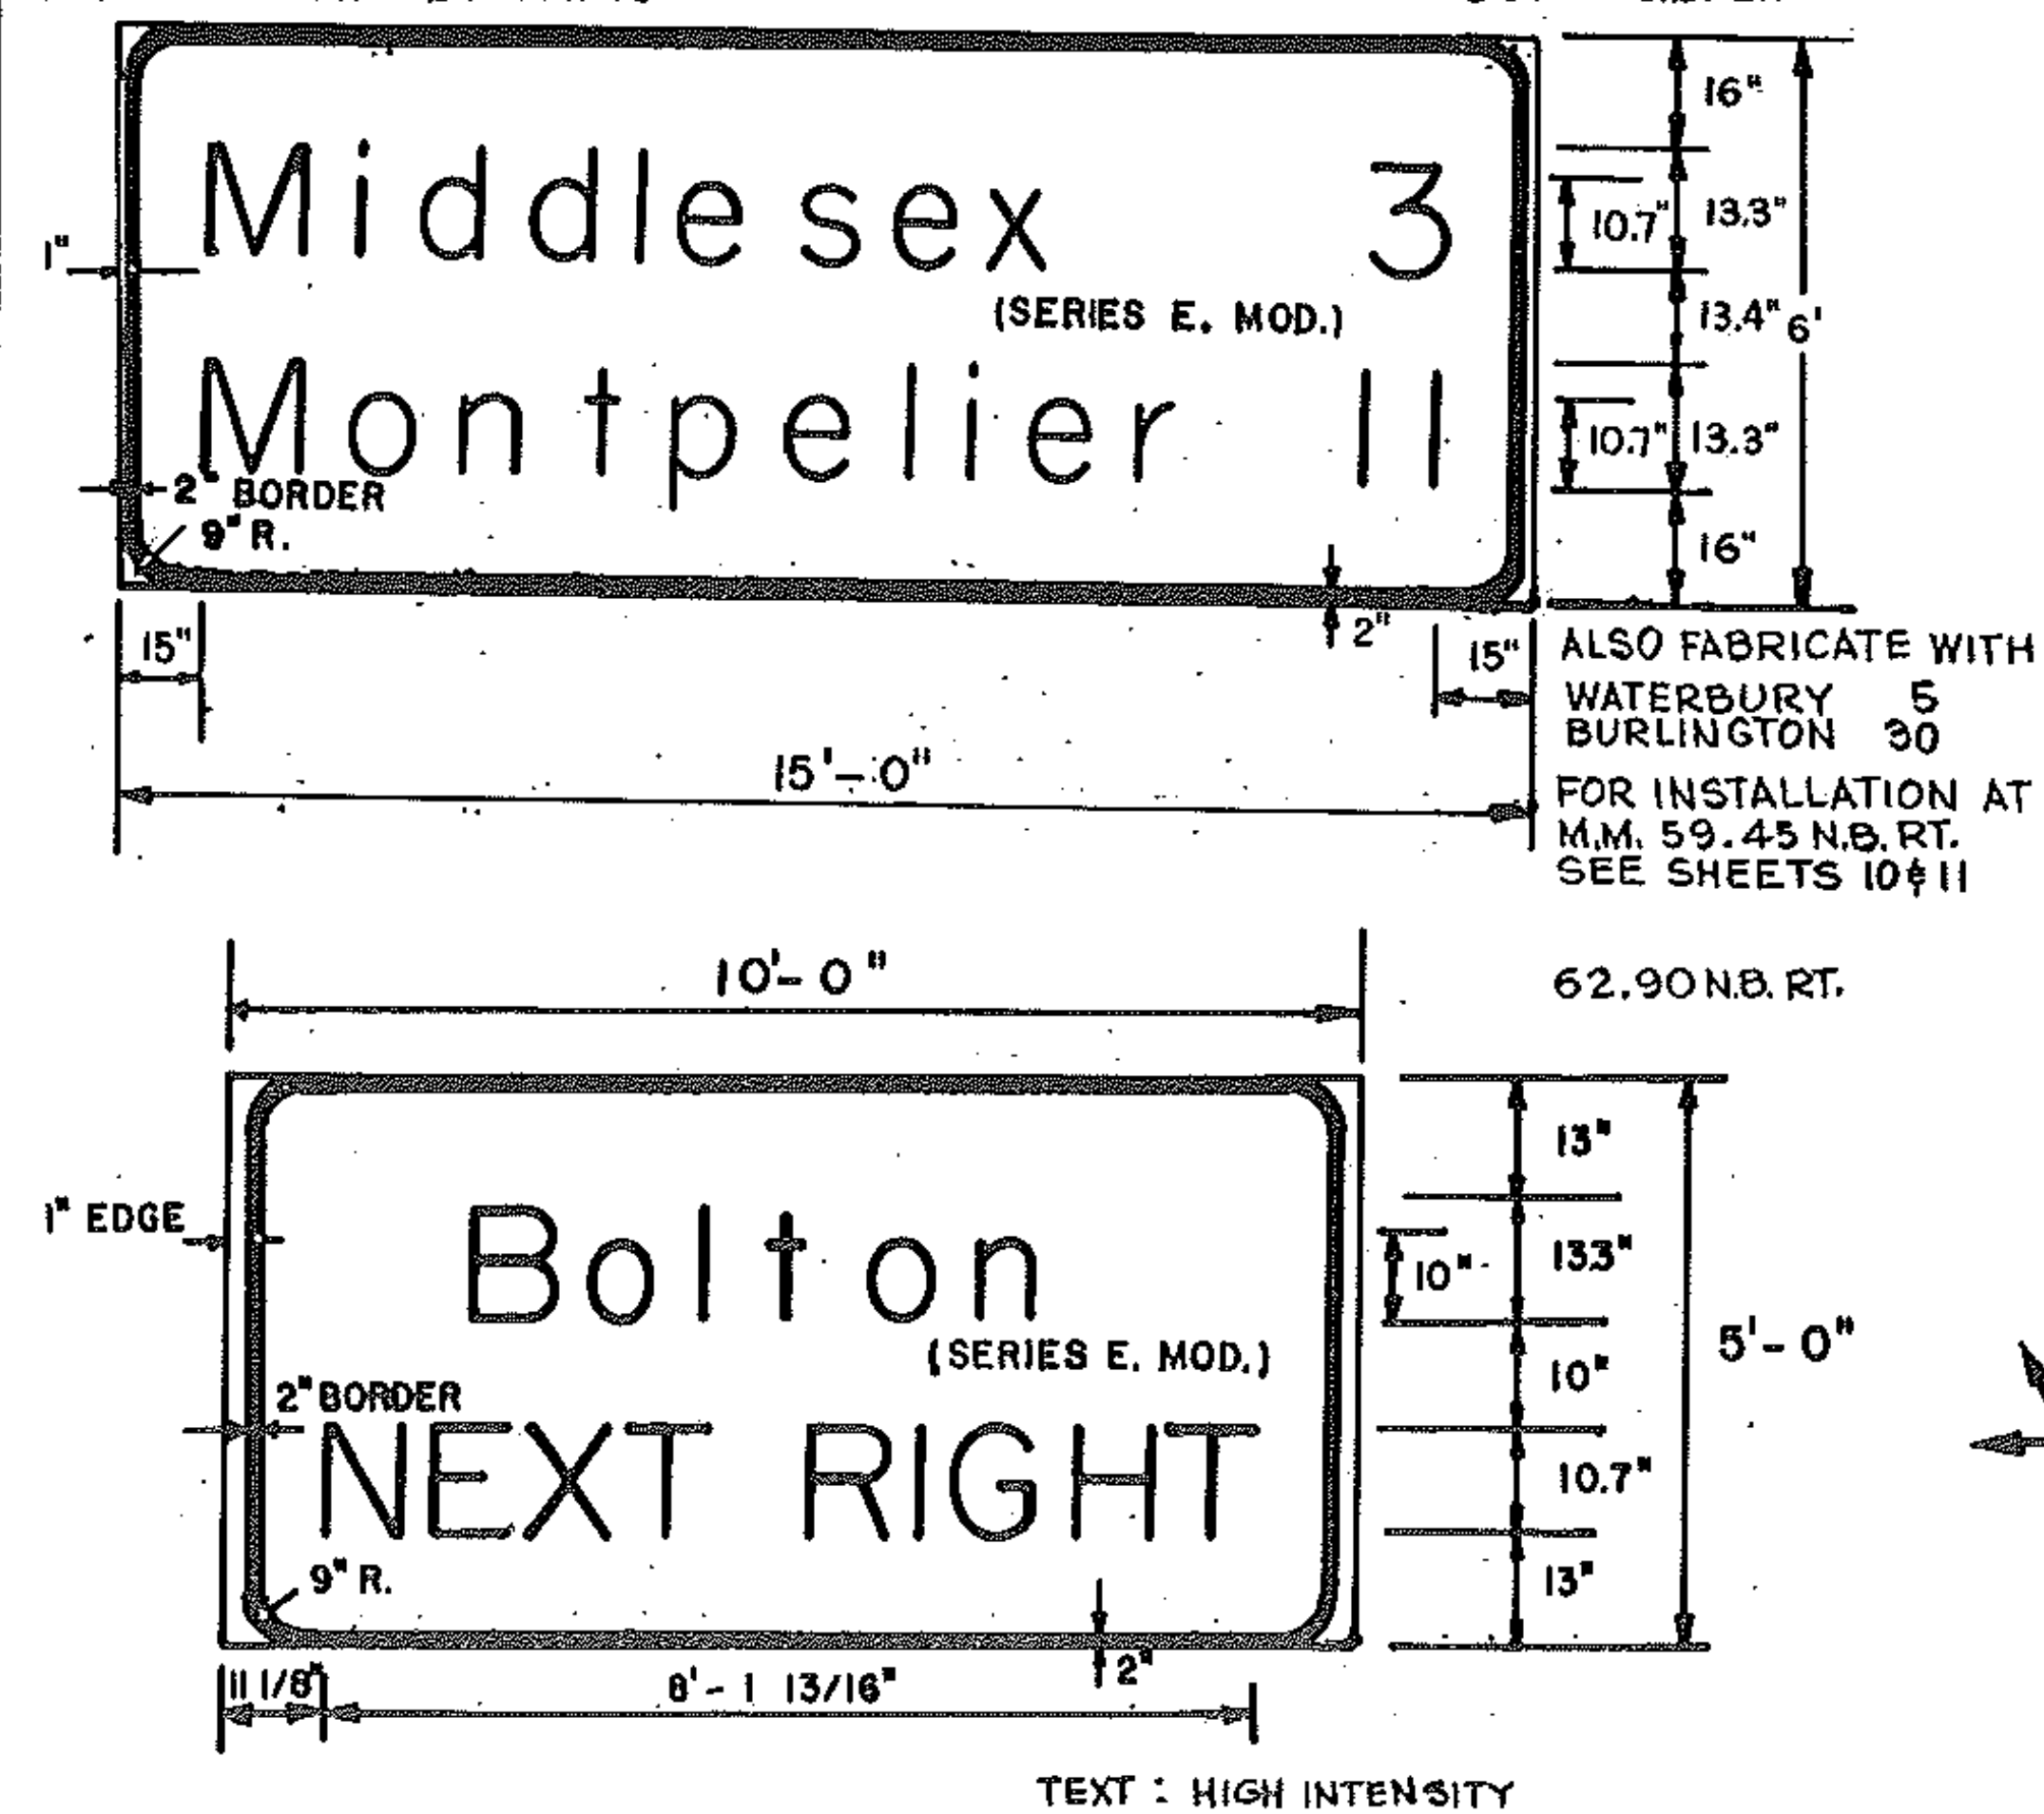

NOTE:
FOR SIGNS FABRICATED UNDER A
CATEGORY II WORKPLAN SEE SHEETS
10, 11 AND THE SPECIAL PROVISIONS.

COLORS:
TEXT AND BORDER - WHITE
BACKGROUND - GREEN

FOR MATERIALS SEE STD. E-14 EXCEPT THAT
PLYWOOD AND ACRYLIC PLASTIC REFLECTORS
WILL NOT BE ALLOWED FOR TYPE "B" SIGNS

SIGN AND ITEM
SUMMARY AND DETAILS

SURVEYED BY _____ DATE _____
DRAWN BY _____ DATE _____
TRACED BY _____ DATE _____
MIDDLESEX -
WATERBURY
PROJ. 1R NO. 089-2(6)
SHEET 13 OF 34