


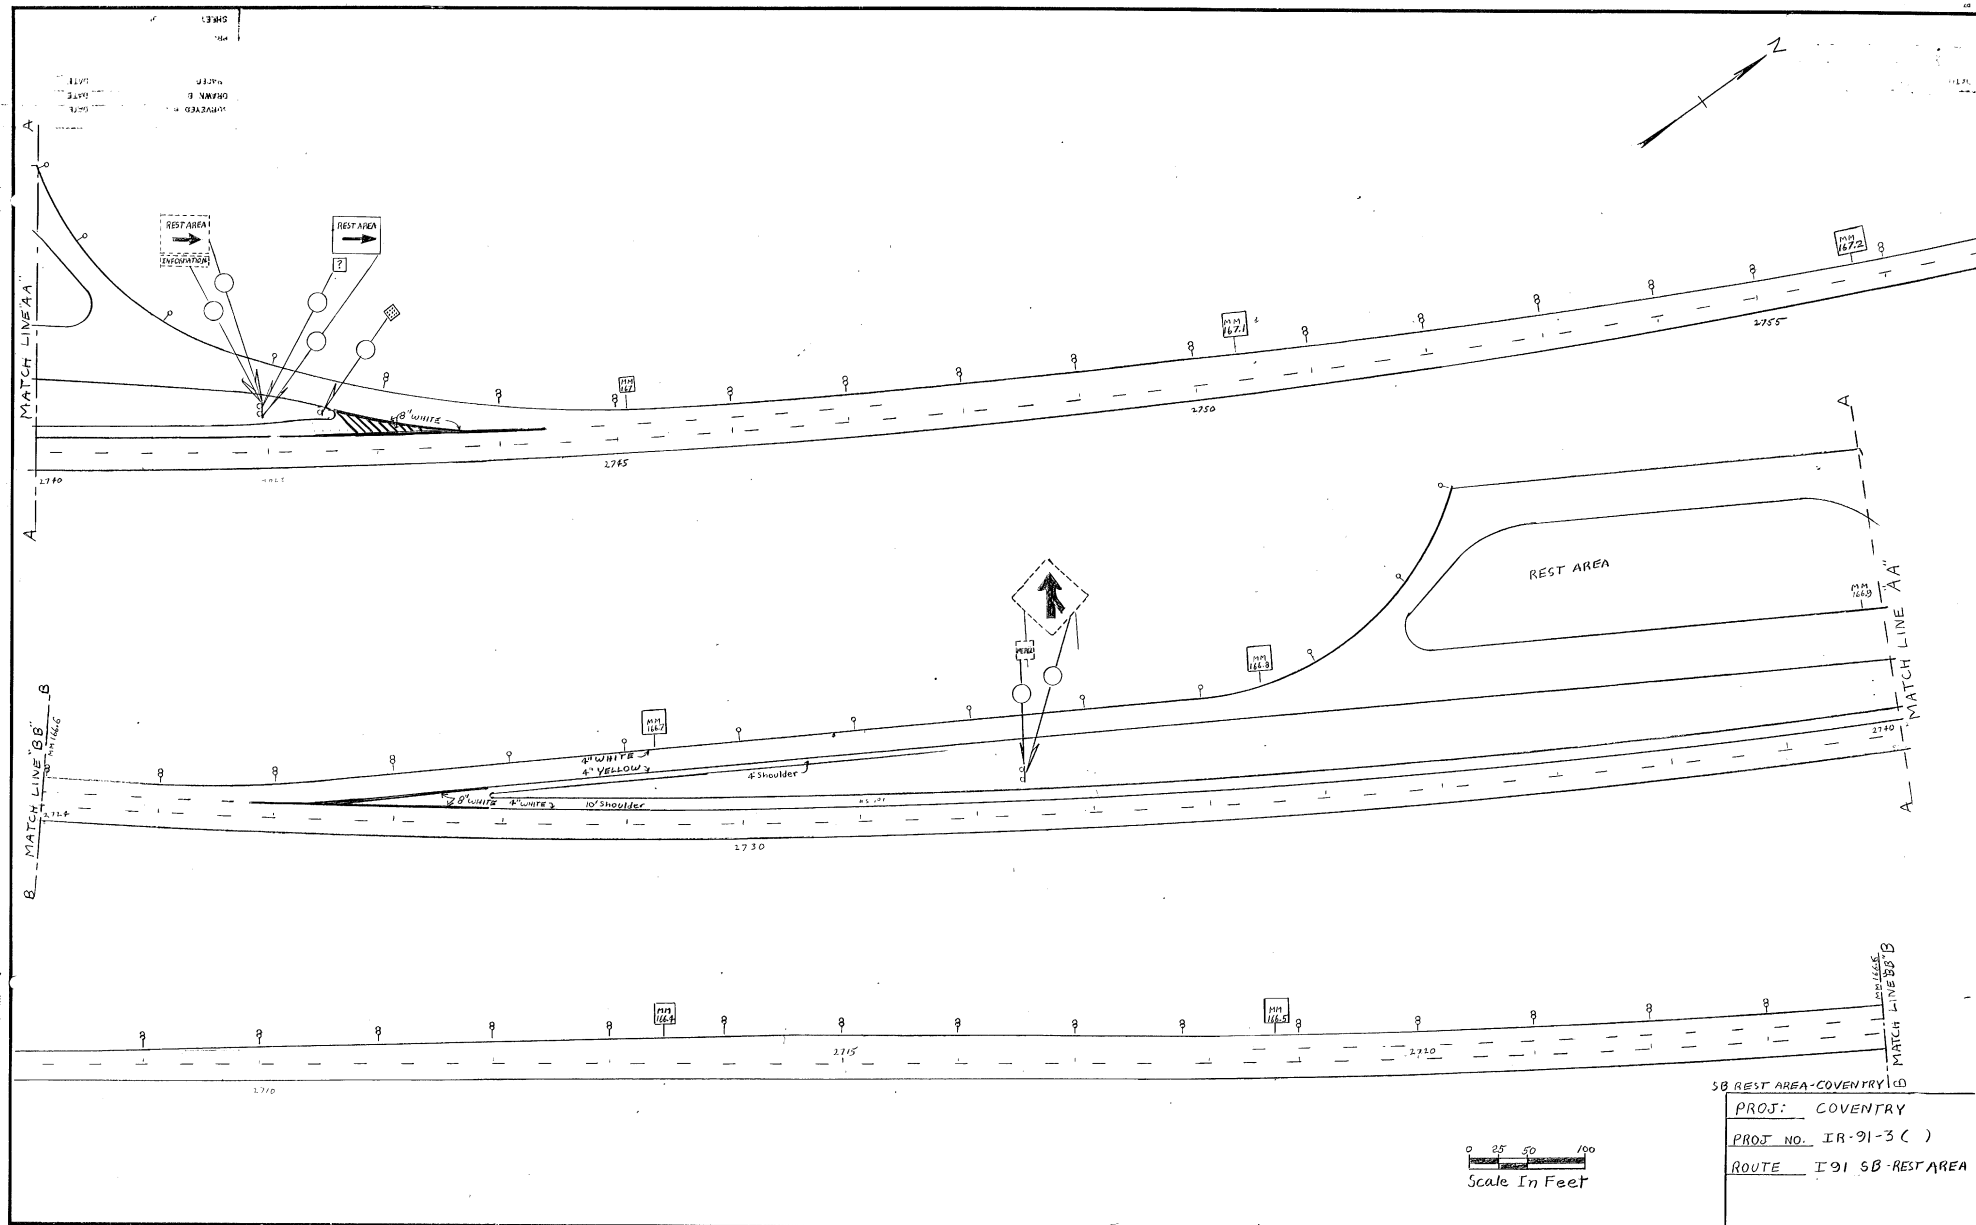

SB REST AREA-COVENTRY (C)
PROJ: COVENTRY
PROJ NO. IR-91-3 ()
ROUTE 191 SB-REST AREA

Vermont Agency of
Transportation
PHASE 1-INTERSTATE
#122302-01
INITIALS ☐
HANGER 679

IR - 91-3() Coventry

I 91 SB Rest Area