


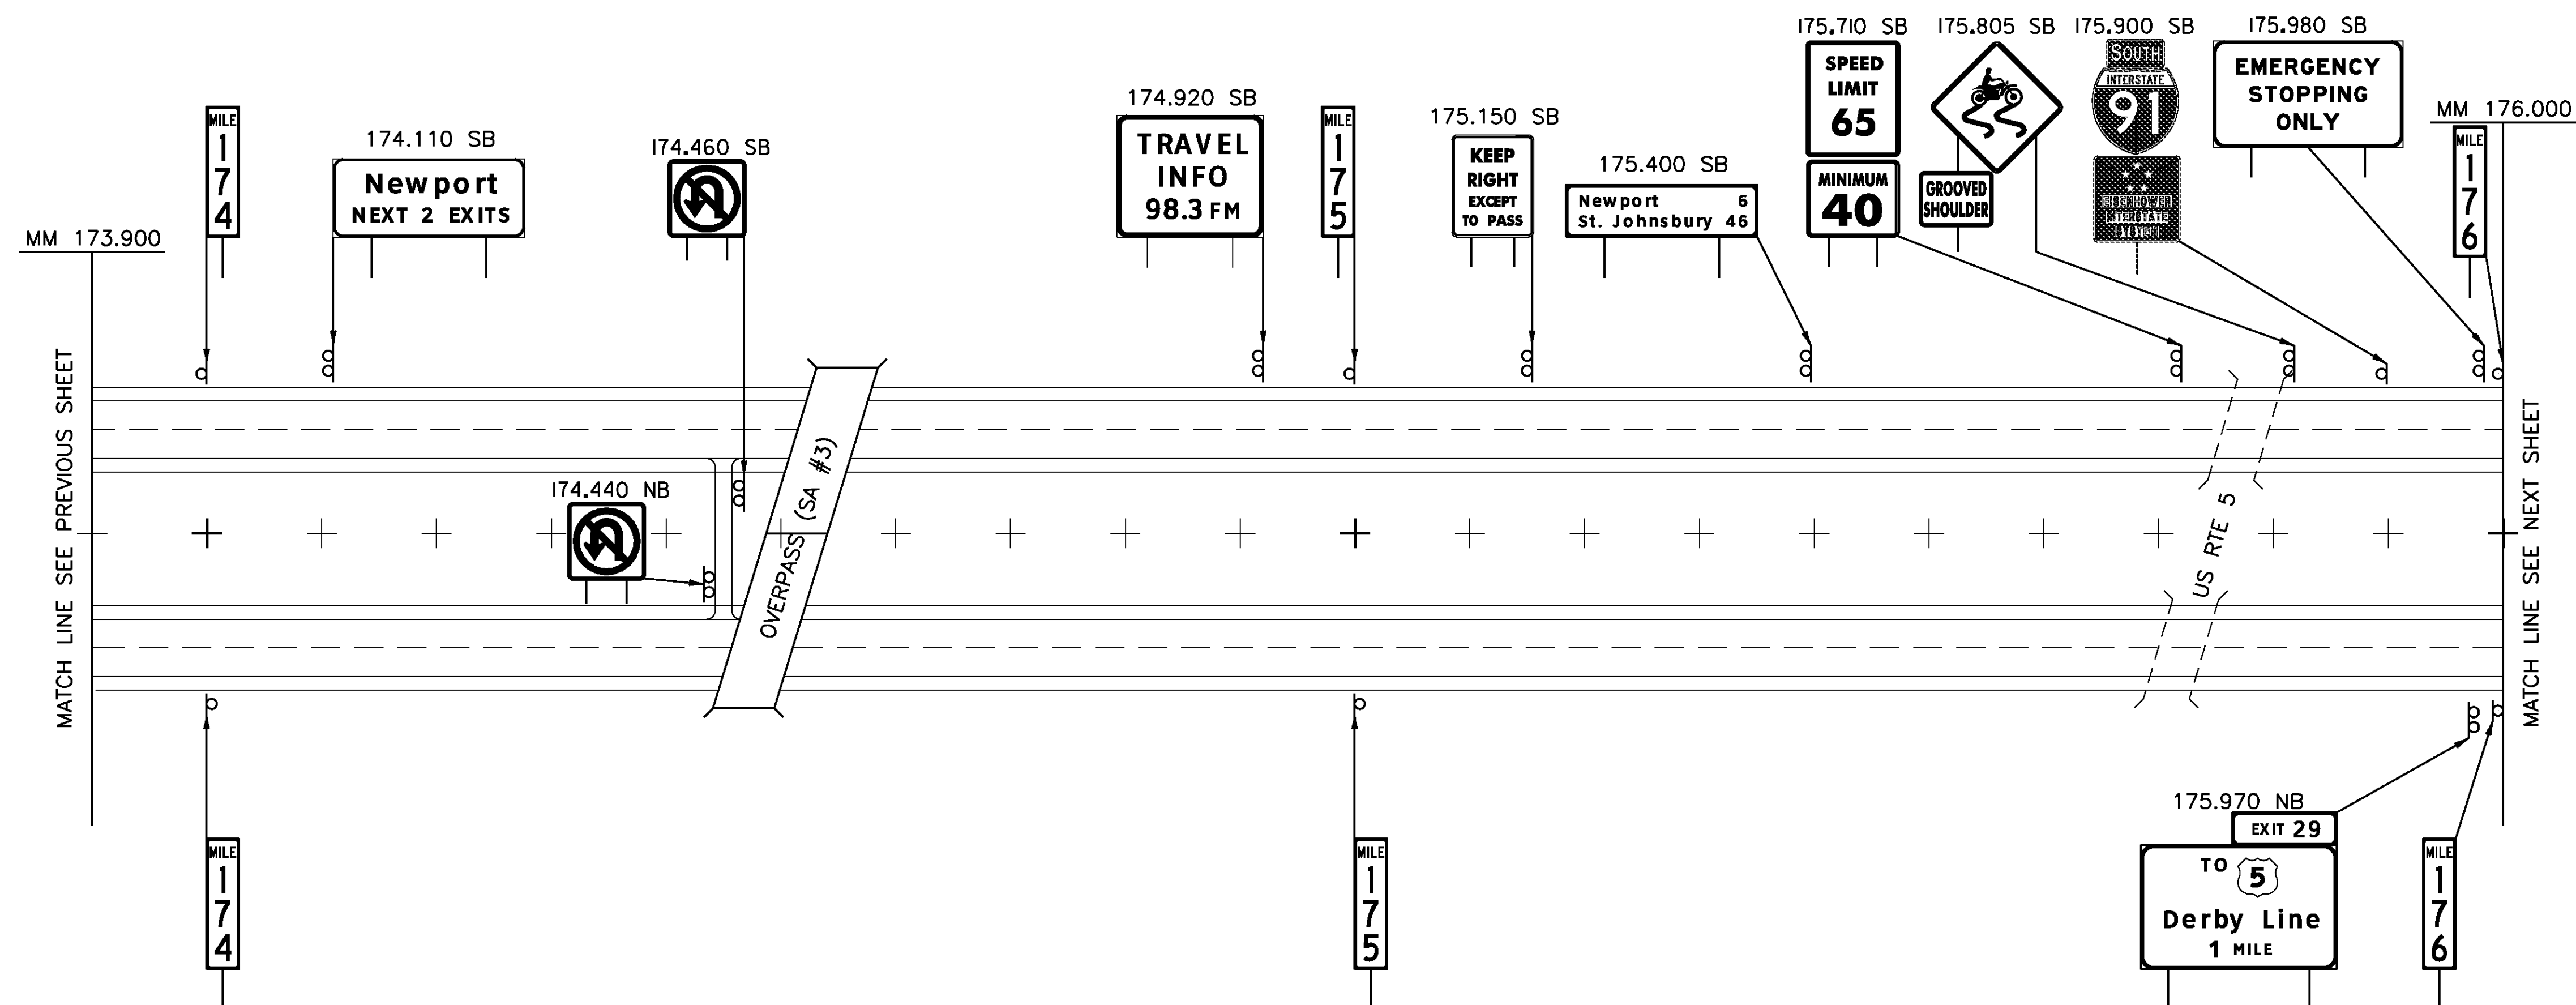

LEGEND
[RET] - RETAINED
[SALV] - SALVAGED

ALL SIGNS AND POSTS ARE NEW UNLESS OTHERWISE NOTED

**NEW SIGNS
MAINLINE (8)
173.900-176.000**

PROJECT NAME: LYNDON - DERBY

PROJECT NUMBER: IM IR 091-3(6)

FILE NAME: z87a022mainline.dgn

PROJECT LEADER: CRB

DESIGNED BY: DAM

CLD REF. NO.: 08-0159

PLOT DATE: 5/7/2009

DRAWN BY: MRS

CHECKED BY: PTS

SHEET 34 OF 160