


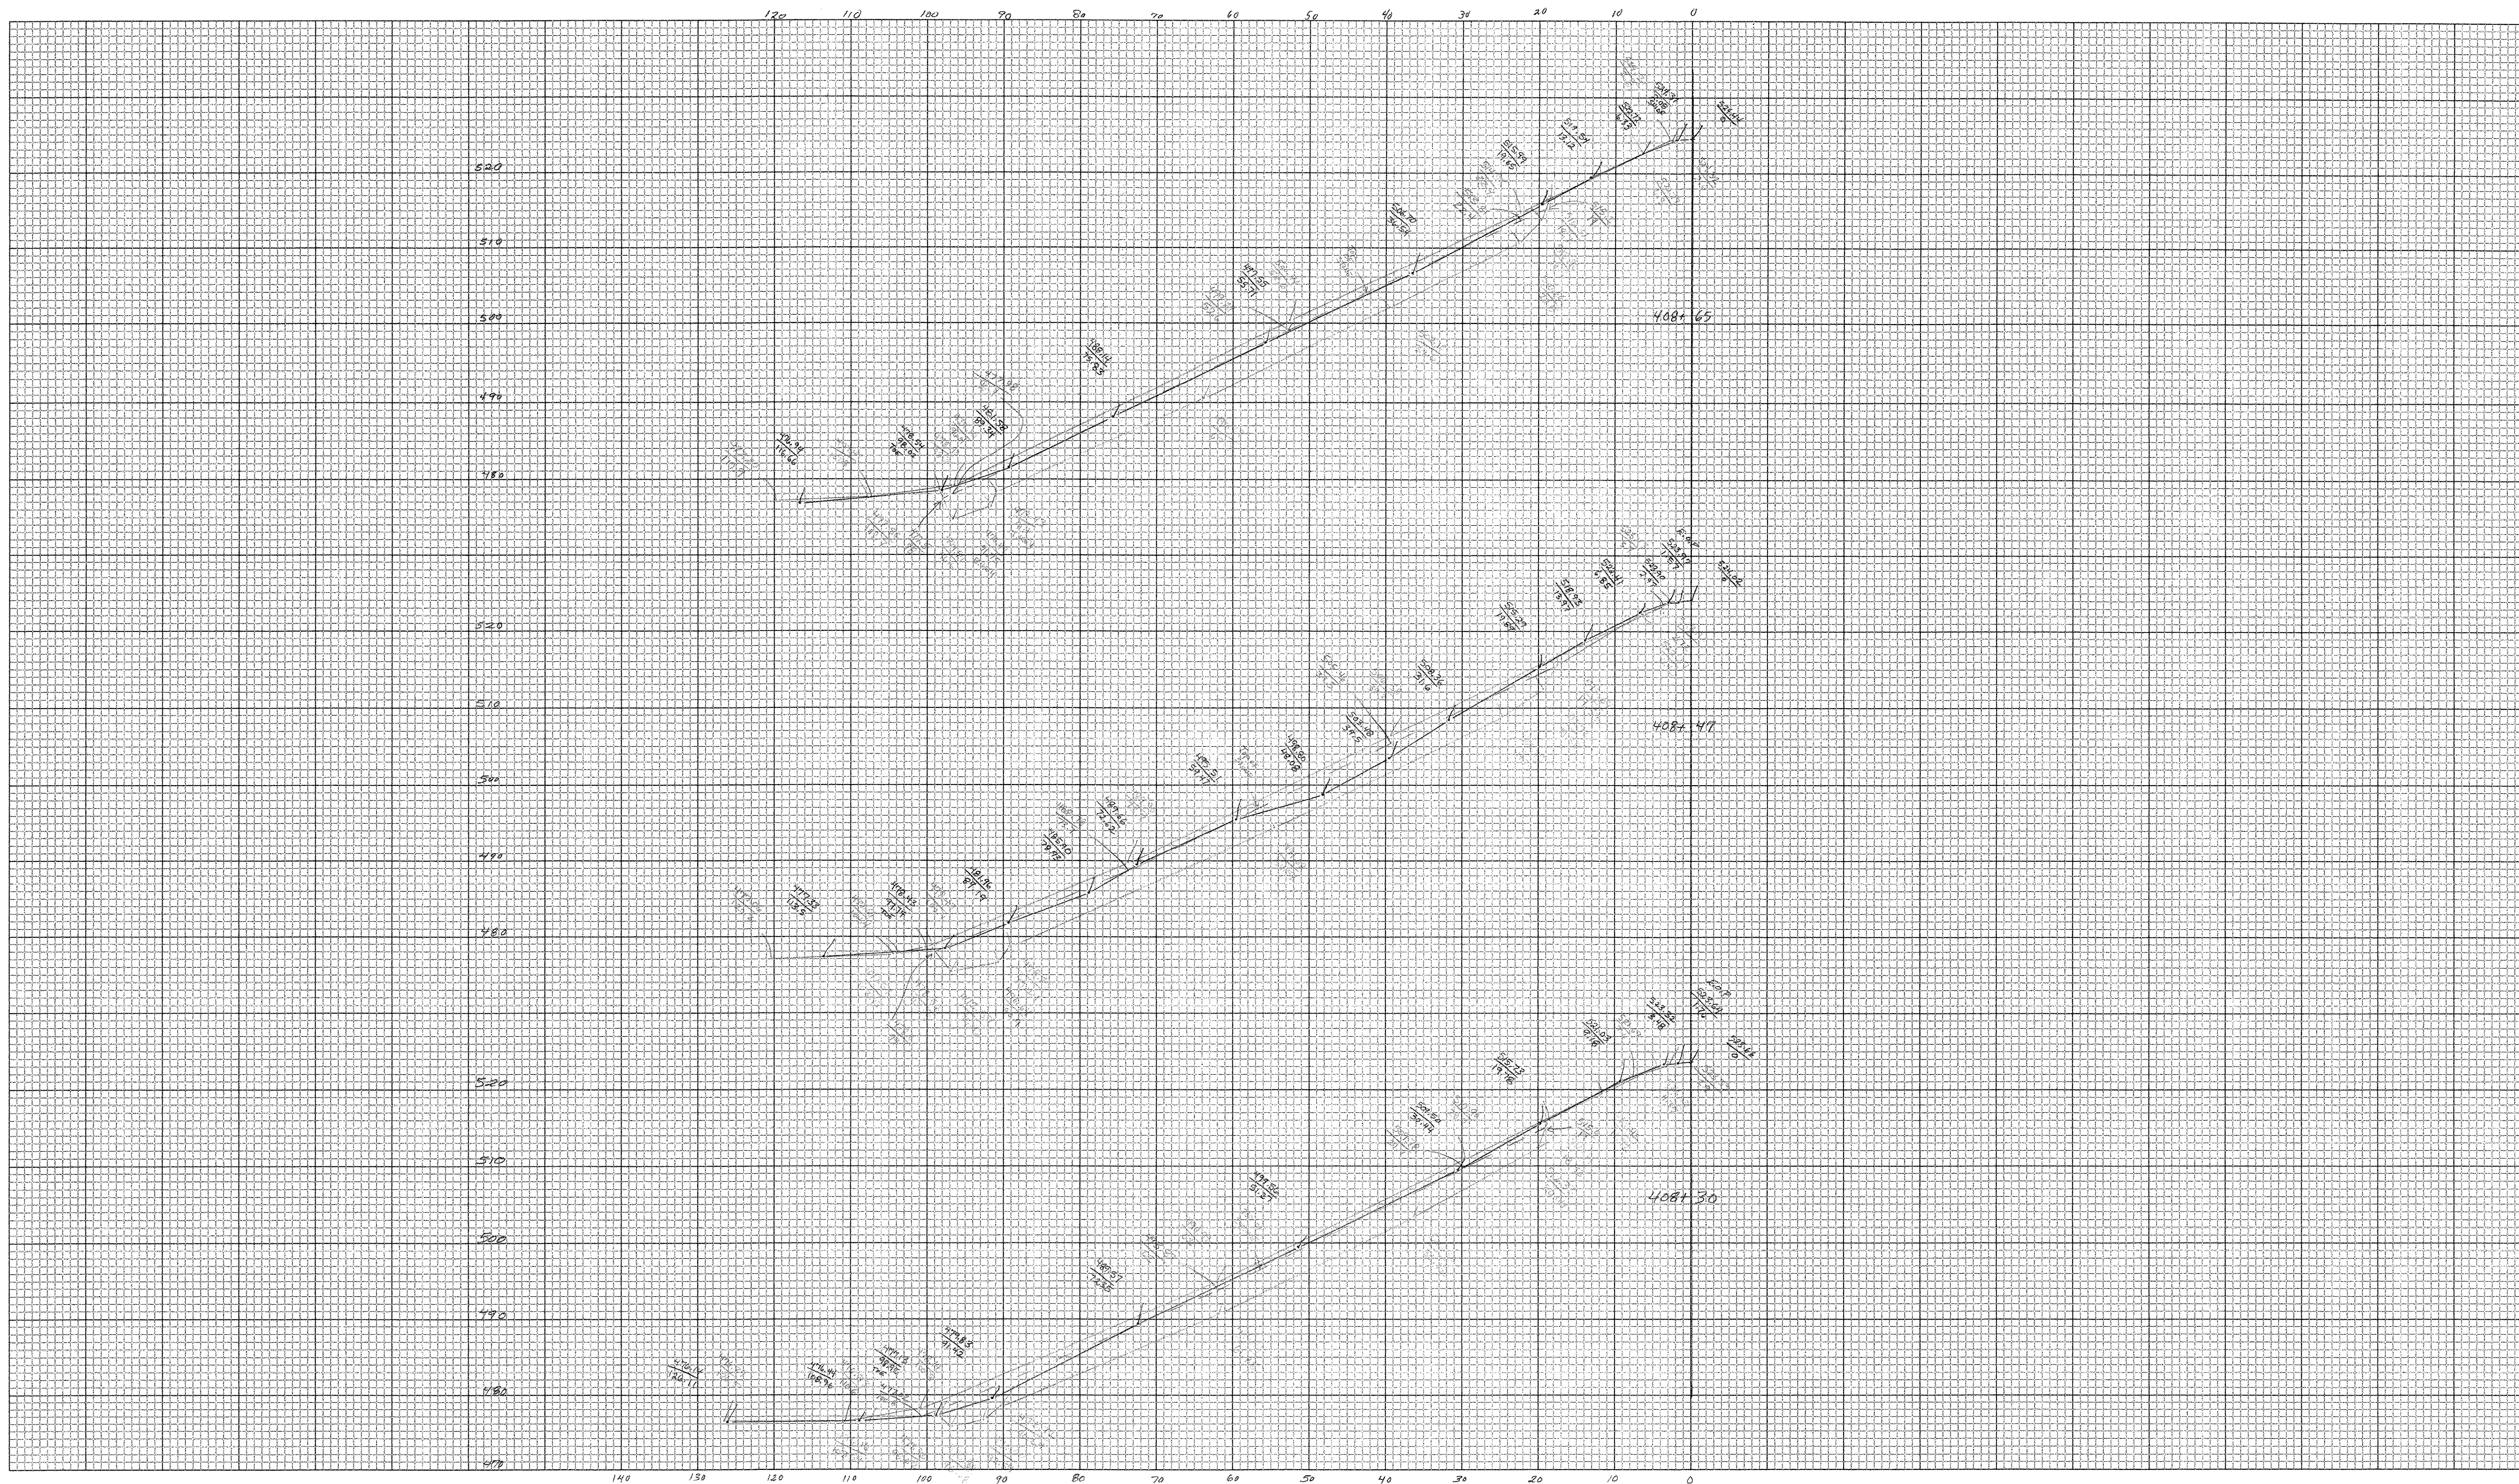

CROSS SECTION SHEET

PROJECT NAME:	HARTFORD-SHARON ROYALTON		
PROJECT NUMBER:	IMFR 089-1(B)		
FILE NAME:	SLIDE AREA 7.2B SB LT	PLOT DATE:	05-JUN-2000 09
PROJECT LEADER:		DRAWN BY:	
DESIGNED BY:		CHECKED BY:	
const: g:/common/cadd/e-xsection.dgn		SHEET	102 OF 100