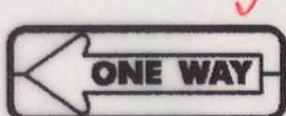
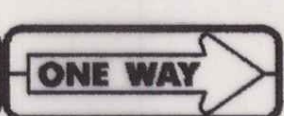
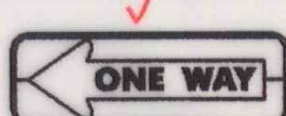
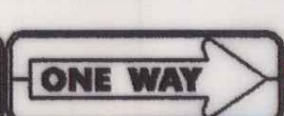


TRAFFIC SIGN SUMMARY SHEET										TRAFFIC SIGN SUMMARY SHEET																		SIGN DETAIL					
MILEMARKER, STATION, OR SIGN NUMBER	SIGN LEGEND	SIGN DIMENSIONS	NEW AND SALVAGED SIGNS				EXISTING POSTS				NEW SIGN POSTS														REMARKS	PLAN SHEET NUMBER	STD. SHEET NUMBER						
			"A"	"B"	SALV. SIGN	SALV. T.I.S.	RET.	DRILL	REM.	SALV.	NUMBER OF POSTS	FLANGED CHANNEL LB./FT.				TUBULAR ALUMINUM		TUBULAR STEEL				W SHAPED STEEL		FTG. SIZE				SIGN FRAME					
											1.12	2.0	2.5	3.0	3.0"Ø	4.0"Ø	FOUND-ATION	3"Ø	3.5"Ø	4.0"Ø	5.0"Ø	POST SIZE	WEIGHT	24"	30"								
SOUTHBOUND MM 60.40 ON RAMP RT		36' X 36'	9.0		1			1																				RETAIN EXISTING POST AND "SIGNAL REQUIRED BEFORE LANE CHANGE" SIGN. ADD NEW "PROHIBITED ..." SIGN.		E-142			
SOUTHBOUND MM 60.21 OUTSIDE					1			2		2					X													EXISTING "MERGE" SIGN IN GORE.					
SOUTHBOUND MM 59.68 OUTSIDE	 				2			2		2							2	X										EXISTING "SPEED LIMIT 65" AND "MINIMUM SPEED 40" SIGNS.					
SOUTHBOUND MM 55.60 OUTSIDE					1			2		2					X													EXISTING "CURVE LEFT" SYMBOL SIGN.					
SOUTHBOUND MM 51.45 OFFRAMP GORE					1			2		2							2	X										EXISTING "EXIT 8" SIGN IN GORE.					
SOUTHBOUND MM 51.36 OFF RAMP LT	 	REPLACED W NEW SIGNS IN 1994			4			1		1					X													EXISTING "STOP", "DO NOT ENTER", AND (2) "ONE WAY" SIGNS. RIGHT SIDE OF OFFRAMP @ VT. RTE. 131					
	 	REPLACED W NEW SIGNS IN 1994																															
SOUTHBOUND MM 51.36 OFF RAMP RT	 	REPLACED W NEW SIGNS IN 1994			4			1		1					X													EXISTING "STOP", "DO NOT ENTER", AND (2) "ONE WAY" SIGNS. RIGHT SIDE OF OFFRAMP @ VT. RTE. 131					
	 																																
FINAL POST LENGTHS ARE TO BE DETERMINED IN THE FIELD. POST SIZES ARE COMPUTED BASED ON INFORMATION FURNISHED ON THE STANDARD SHEETS AND THE DESIGN DIVISION'S "SIGN POST DESIGN MANUAL".			SF.	SF.	EA.	SF.					216				EA.				517								LBS.	EA.	EA.			PREPARED BY SHANGRAW DATE 12' 91 CHECKED BY J. DOE DATE 12' 91 DESIGN SUPERVISOR HALE DATE PROJ. SPRINGFIELD-HARTFORD IR 091-1(20) TRAFFIC SHEET NO. OF SHEET 44 OF 133 SHEETS	
TOTALS			9		14						216.0				4				517													87A025TS2	