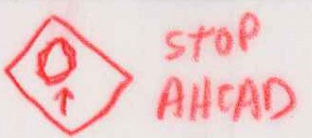


TRAFFIC SIGN SUMMARY SHEET		
MILEMARKER, STATION, OR SIGN NUMBER	SIGN LEGEND	SIGN DIMENSIONS
SOUTHBOUND MM 51.30 ✓ ONRAMP GORE		
SOUTHBOUND MM 50.80 ✓ OUTSIDE		
		
SOUTH BOUND MEDIAN 51.13		24" X 24"
SOUTHBOUND MM 41.78 ✓ OFFRAMP GORE		
SOUTHBOUND MM 41.67 OFF RAMP LT	 	REPLACED W NEW SIGNS
		REPLACED W NEW SIGNS 1994
SB OFFRAMP 41.67		36" X 36"
SOUTHBOUND MM 41.67 ✓ OFF RAMP RT	 	36' X 36' ✓ 36' X 36' ✓
		36' X 12' ✓ 36' X 12' ✓
SB EXIT 10N		18" X 18"
SOUTH BOUND REST AREA		18" X 18"
SOUTH BOUND EXIT 9		18" X 18"
SOUTH BOUND EXIT 7		18" X 18"
FINAL POST LENGTHS ARE TO BE DETERMINED IN THE FIELD. POST SIZES ARE COMPUTED BASED ON INFORMATION FURNISHED ON THE STANDARD SHEETS AND THE DESIGN DIVISION'S "SIGN POST DESIGN MANUAL".		
		TOTALS