


DATE	NO.
REVISION	BY
REVISION	BY
REVISION	BY
REVISION	BY

DATE	NO.
REVISION	BY
REVISION	BY
REVISION	BY
REVISION	BY

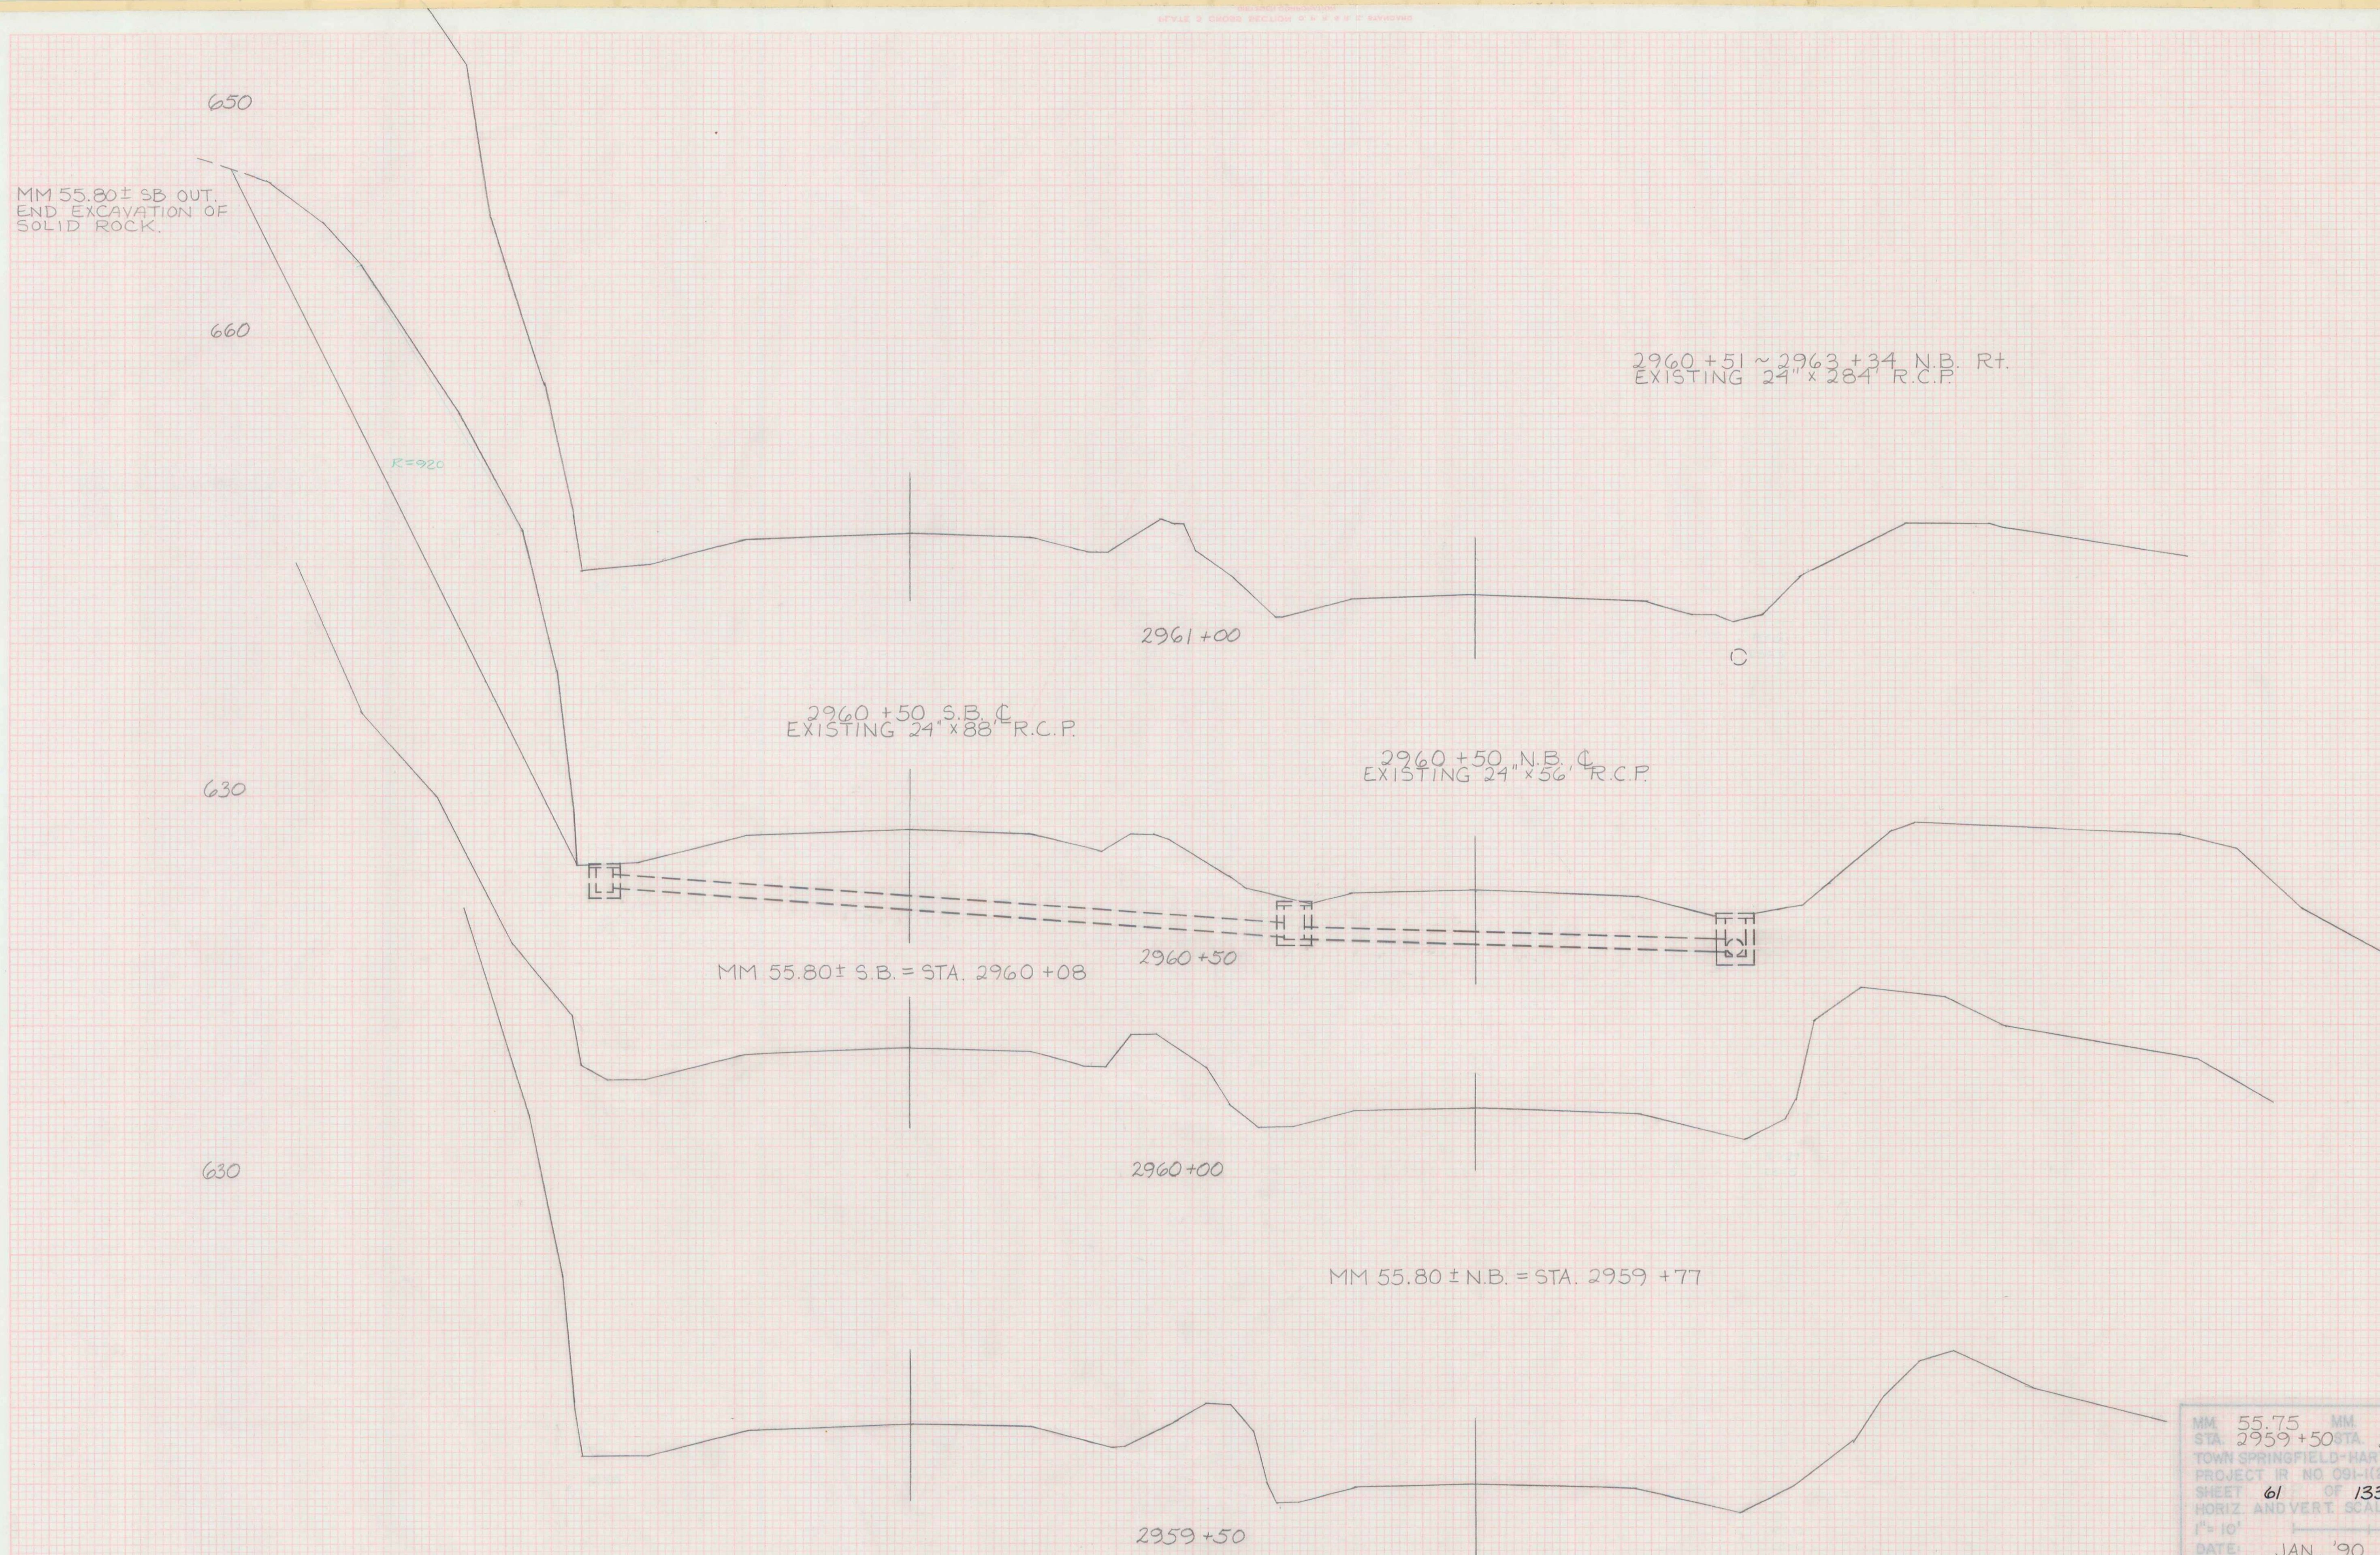

MM 55.75 MM 55.80
 STA. 2959 + 50 STA. 2961 + 0
 TOWN SPRINGFIELD-HARTFORD
 PROJECT R. NO. 091-1(20)
 SHEET 61 OF 133 SHEETS
 HORIZ. AND VERT. SCALE
 1" = 10'
 DATE: JAN. '90