


DATE	BY	REVIEWED	DATE
		APPROVED	
		NOTED	
		REMARKS	

DATE	BY	REVIEWED	DATE
		APPROVED	
		NOTED	
		REMARKS	

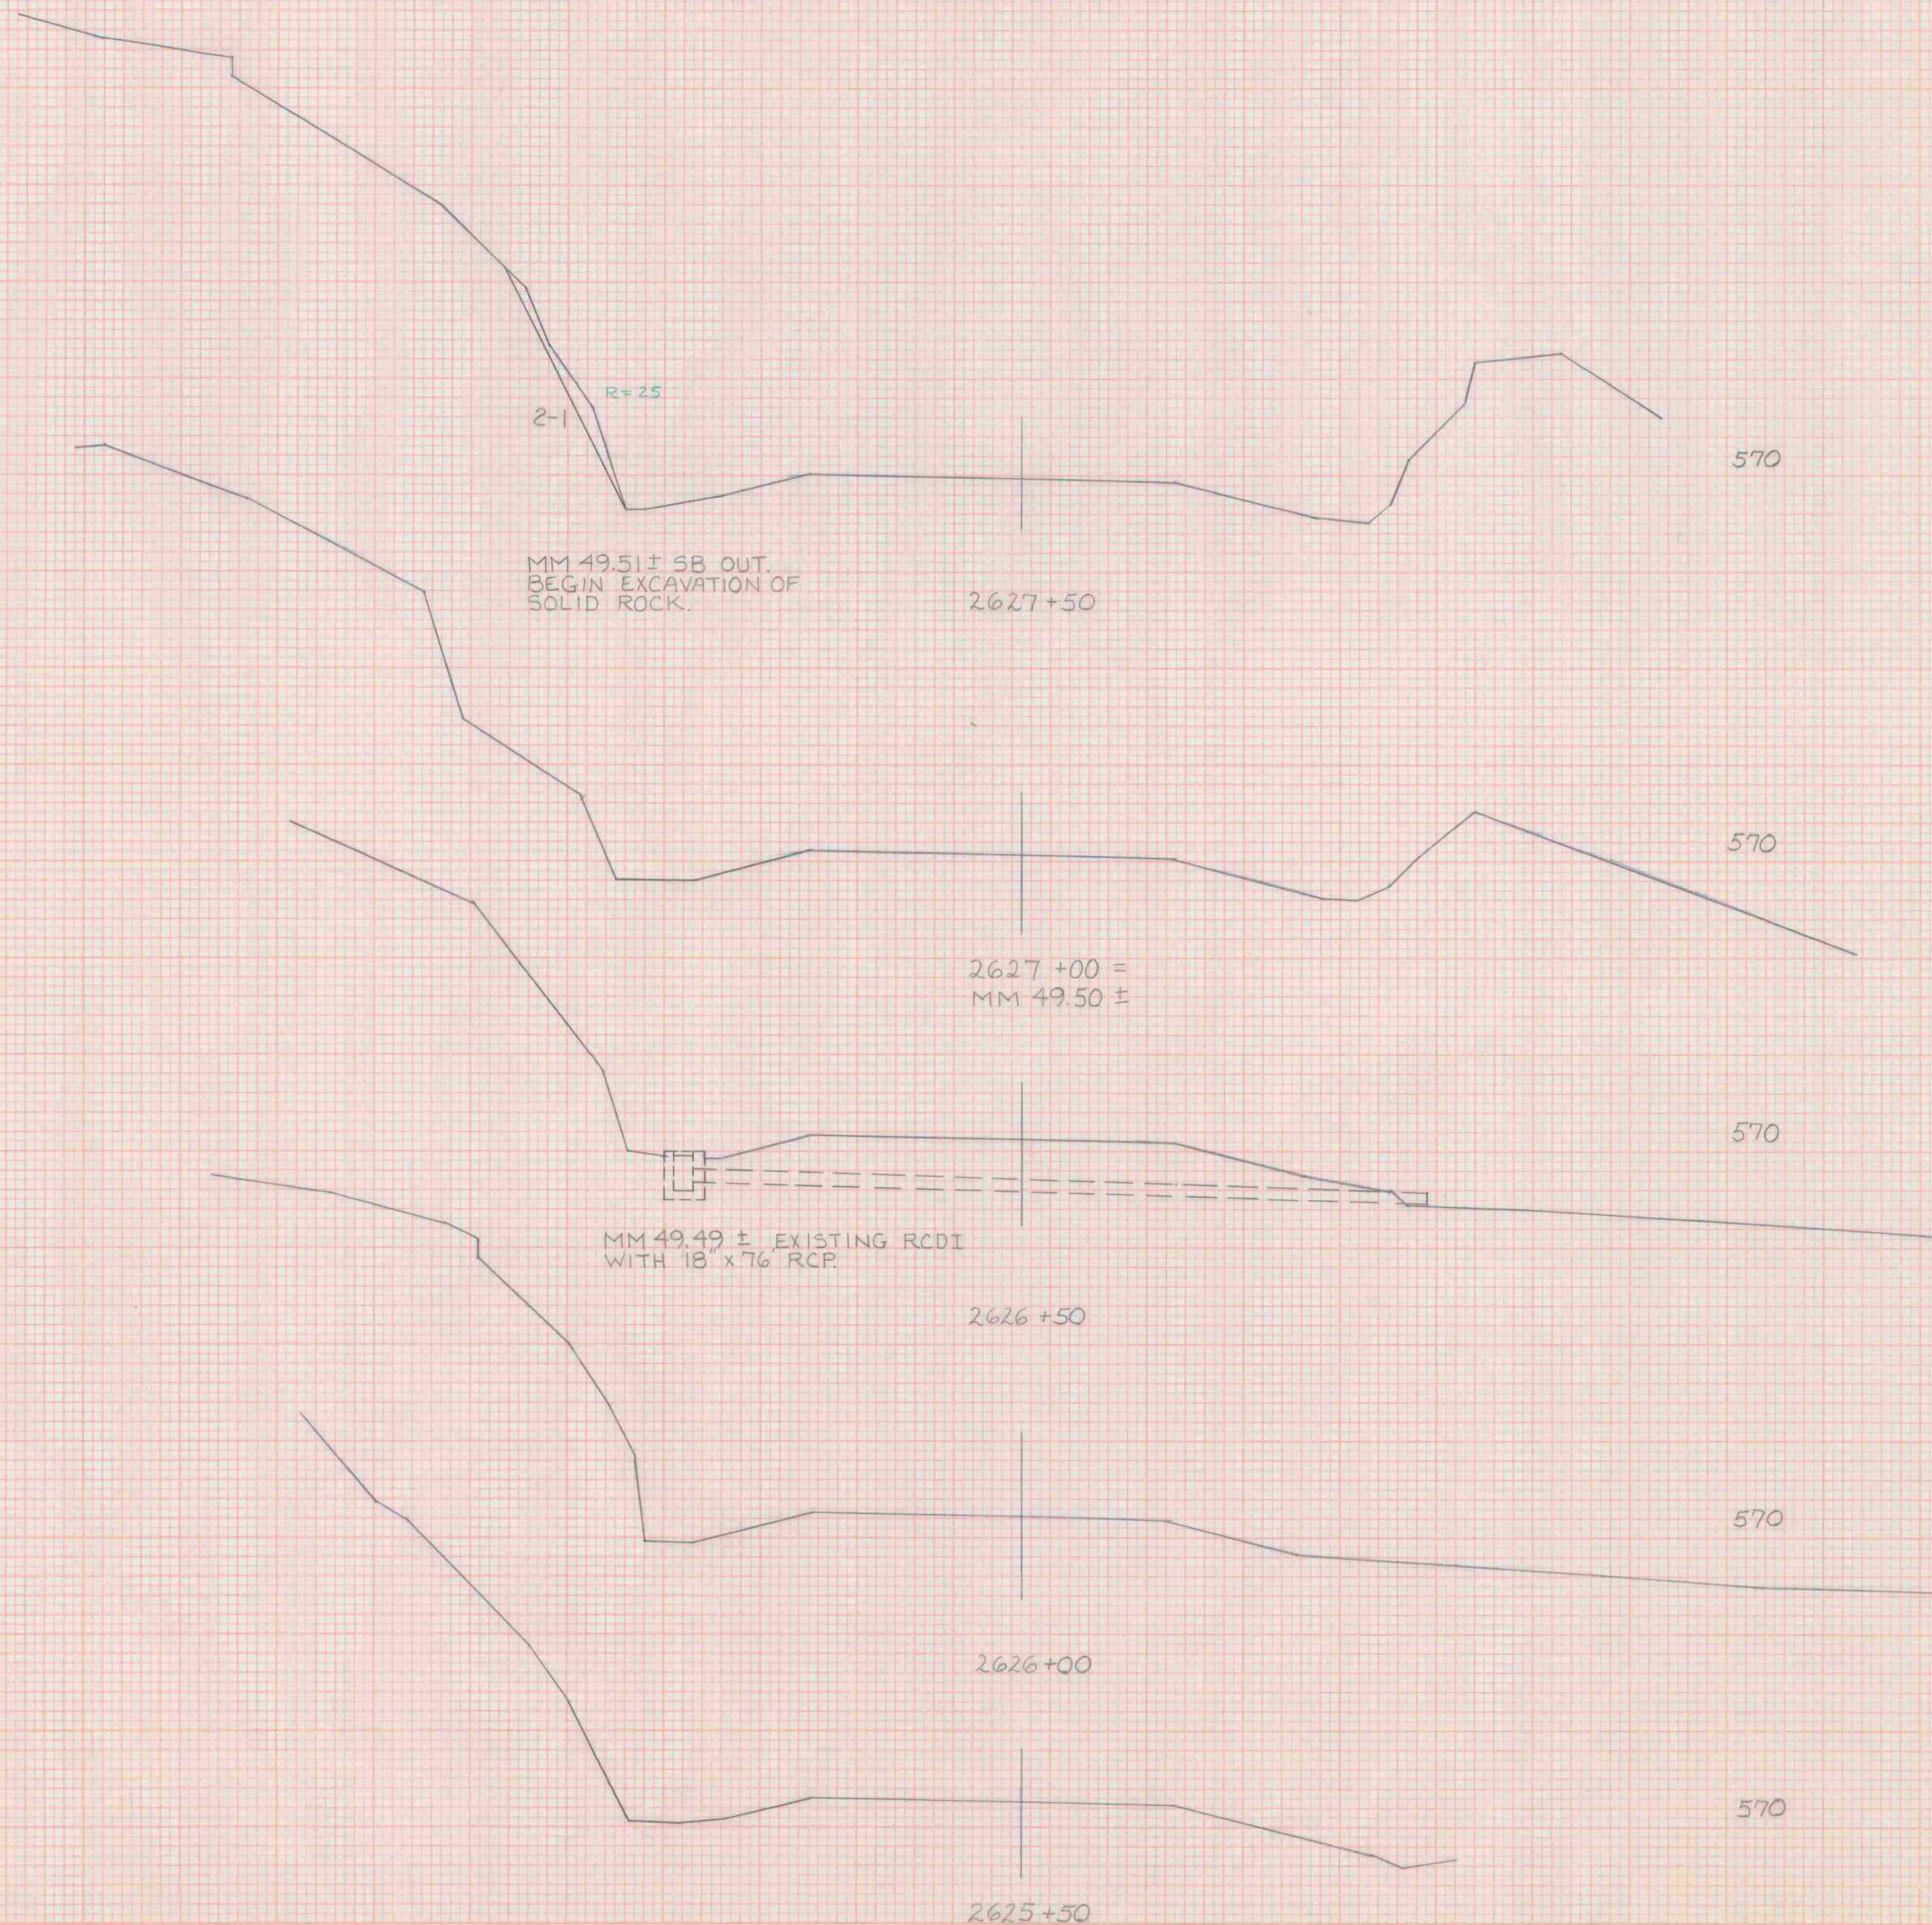

MM 49.51 MM 49.59
STA 2625+50 STA 2627+50
TOWN SPRINGFIELD-HARTFORD
PROJECT IR NO 091-1(20)
SHEET 82 OF 133 SHEETS
HORIZ. AND VERT. SCALE
1"=10'
DATE JAN. '90