


FINAL	DATE
SURVEY	BY
NOTE BOOK	
NO.	

ORIGINAL	DATE
SURVEY	BY
NOTE BOOK	
NO.	

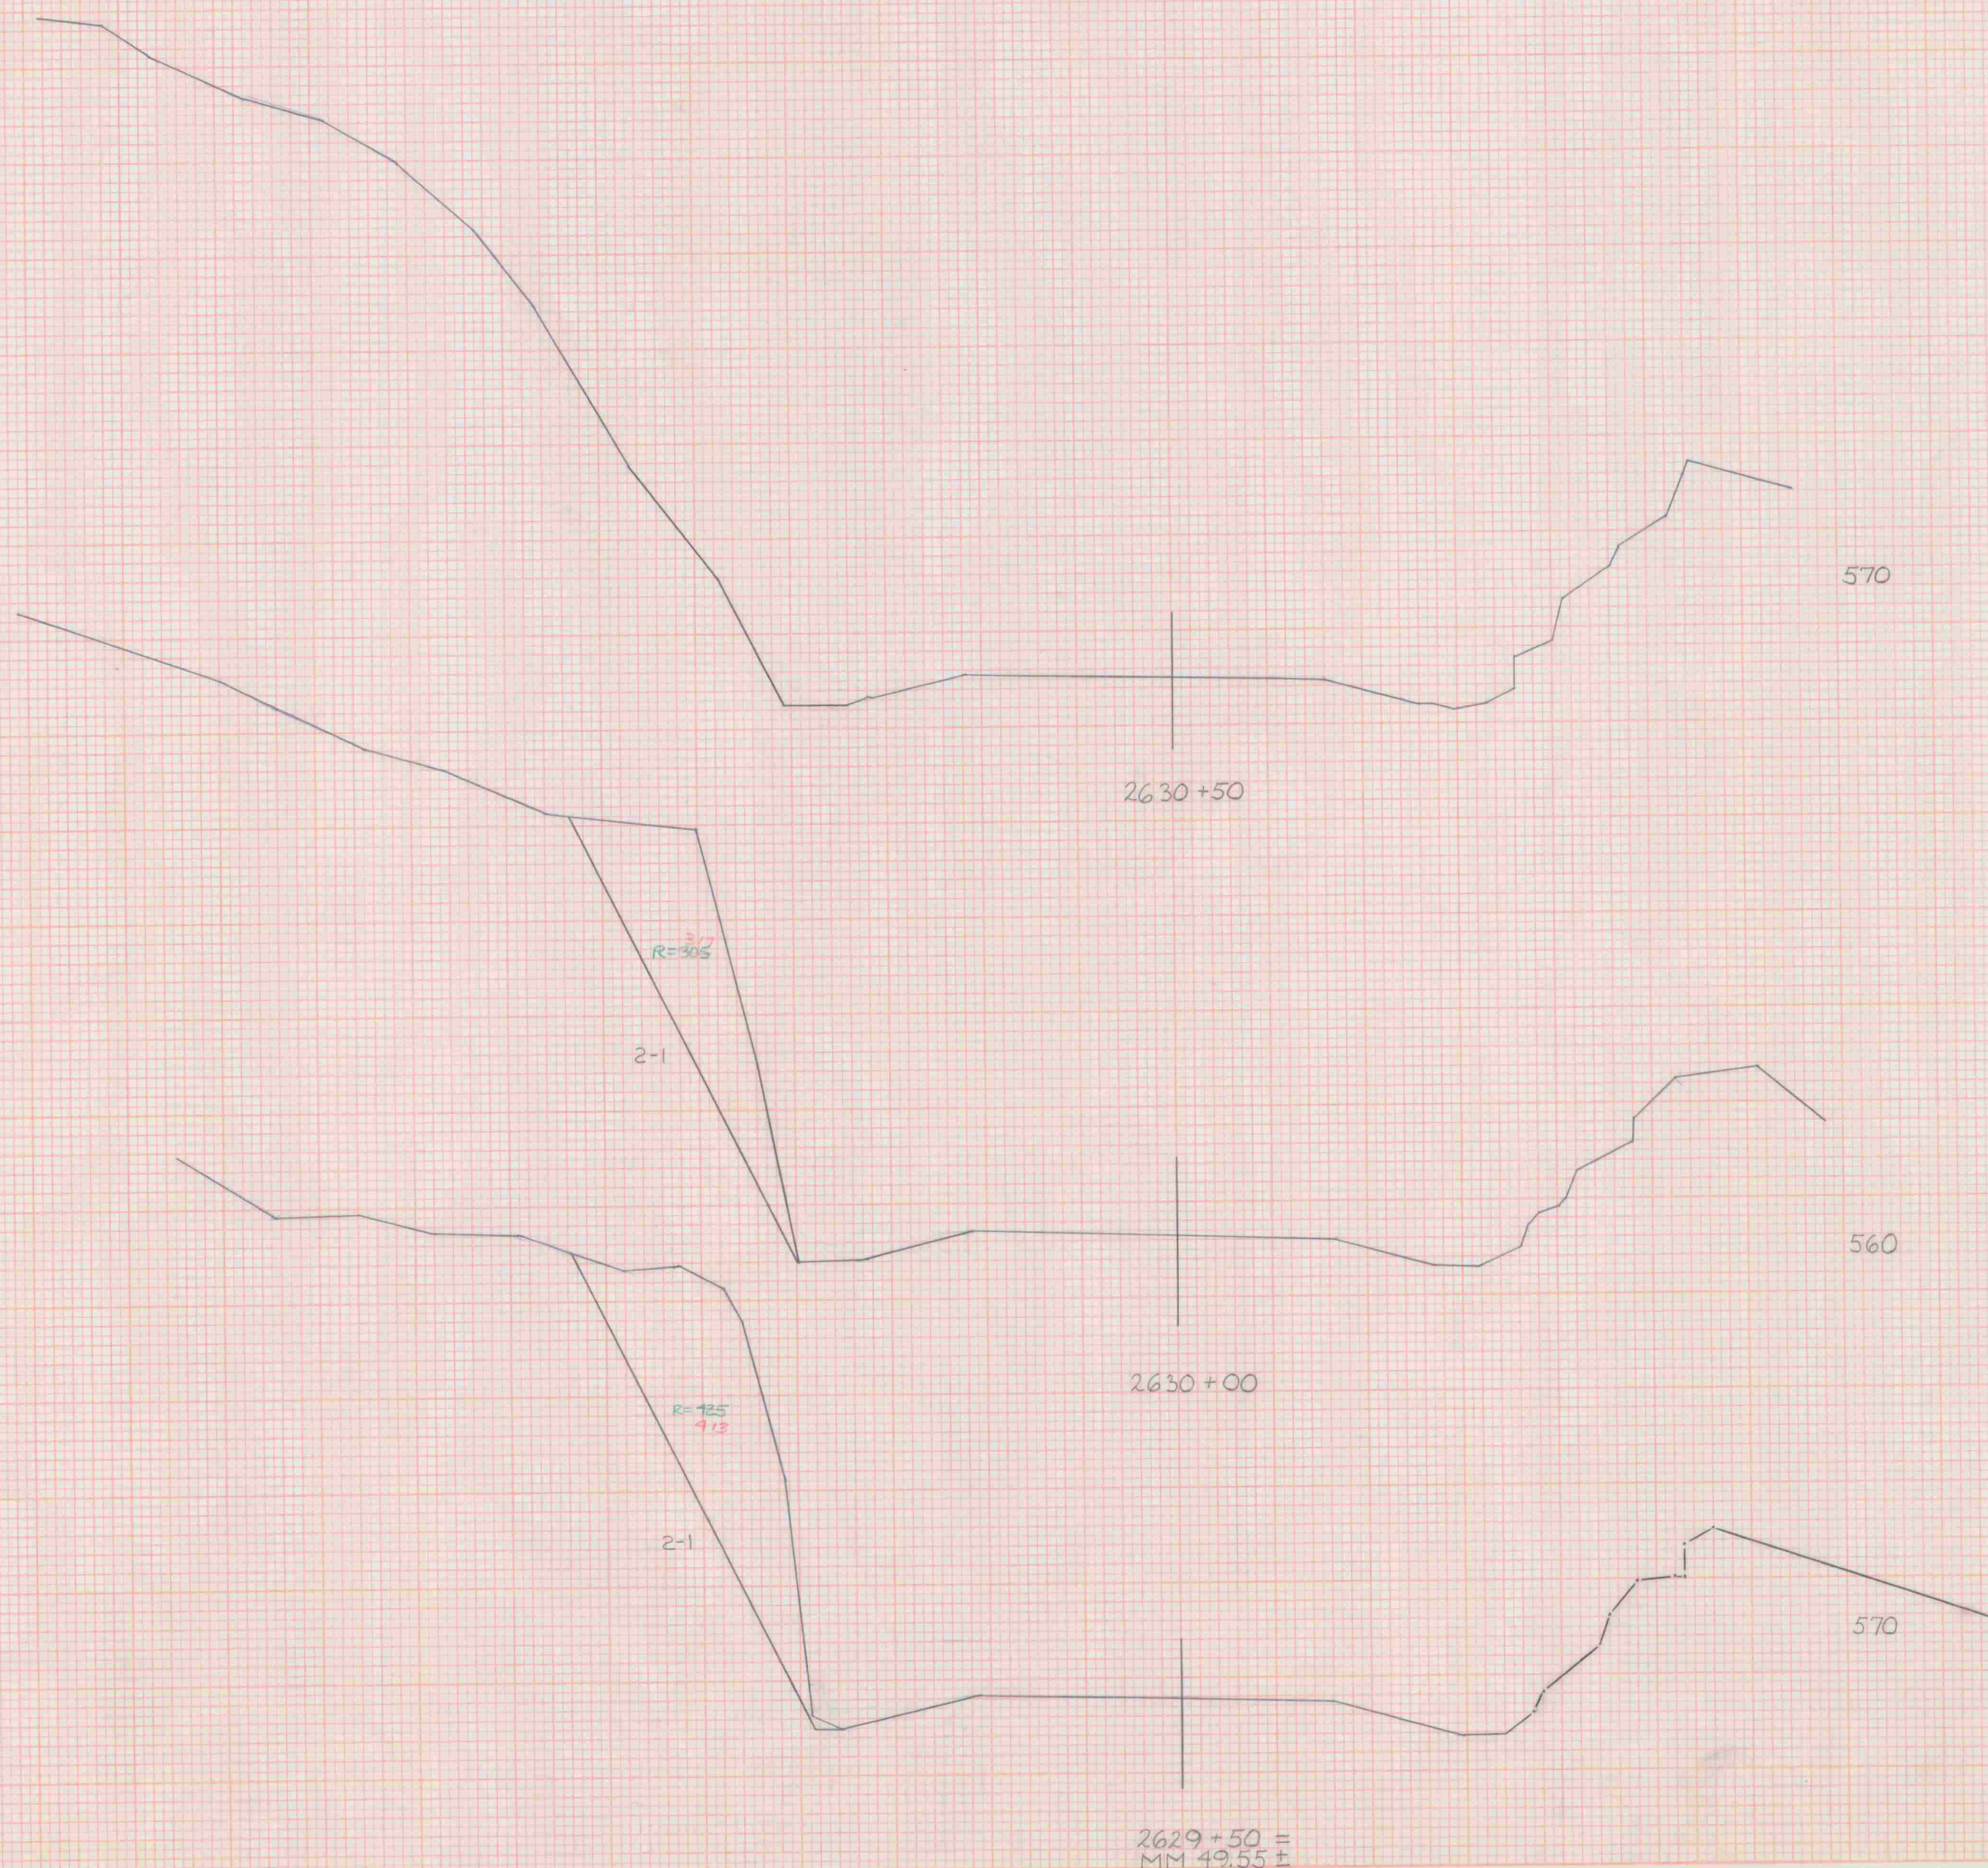

MM. 49.51 MM. 49.59
 STA. 2629+50 STA. 2630+50
 TOWN SPRINGFIELD-HARTFORD
 PROJECT R. NO. 091-1(20)
 SHEET 84 OF 133 SHEETS
 HORIZ. AND VERT. SCALE
 1" = 10'
 DATE: JAN. '90