


FINAL SURVEY	BY	DATE
NOTE BOOK		
NO.		

ORIGINAL SURVEY	BY	DATE
NOTE BOOK		
NO.		

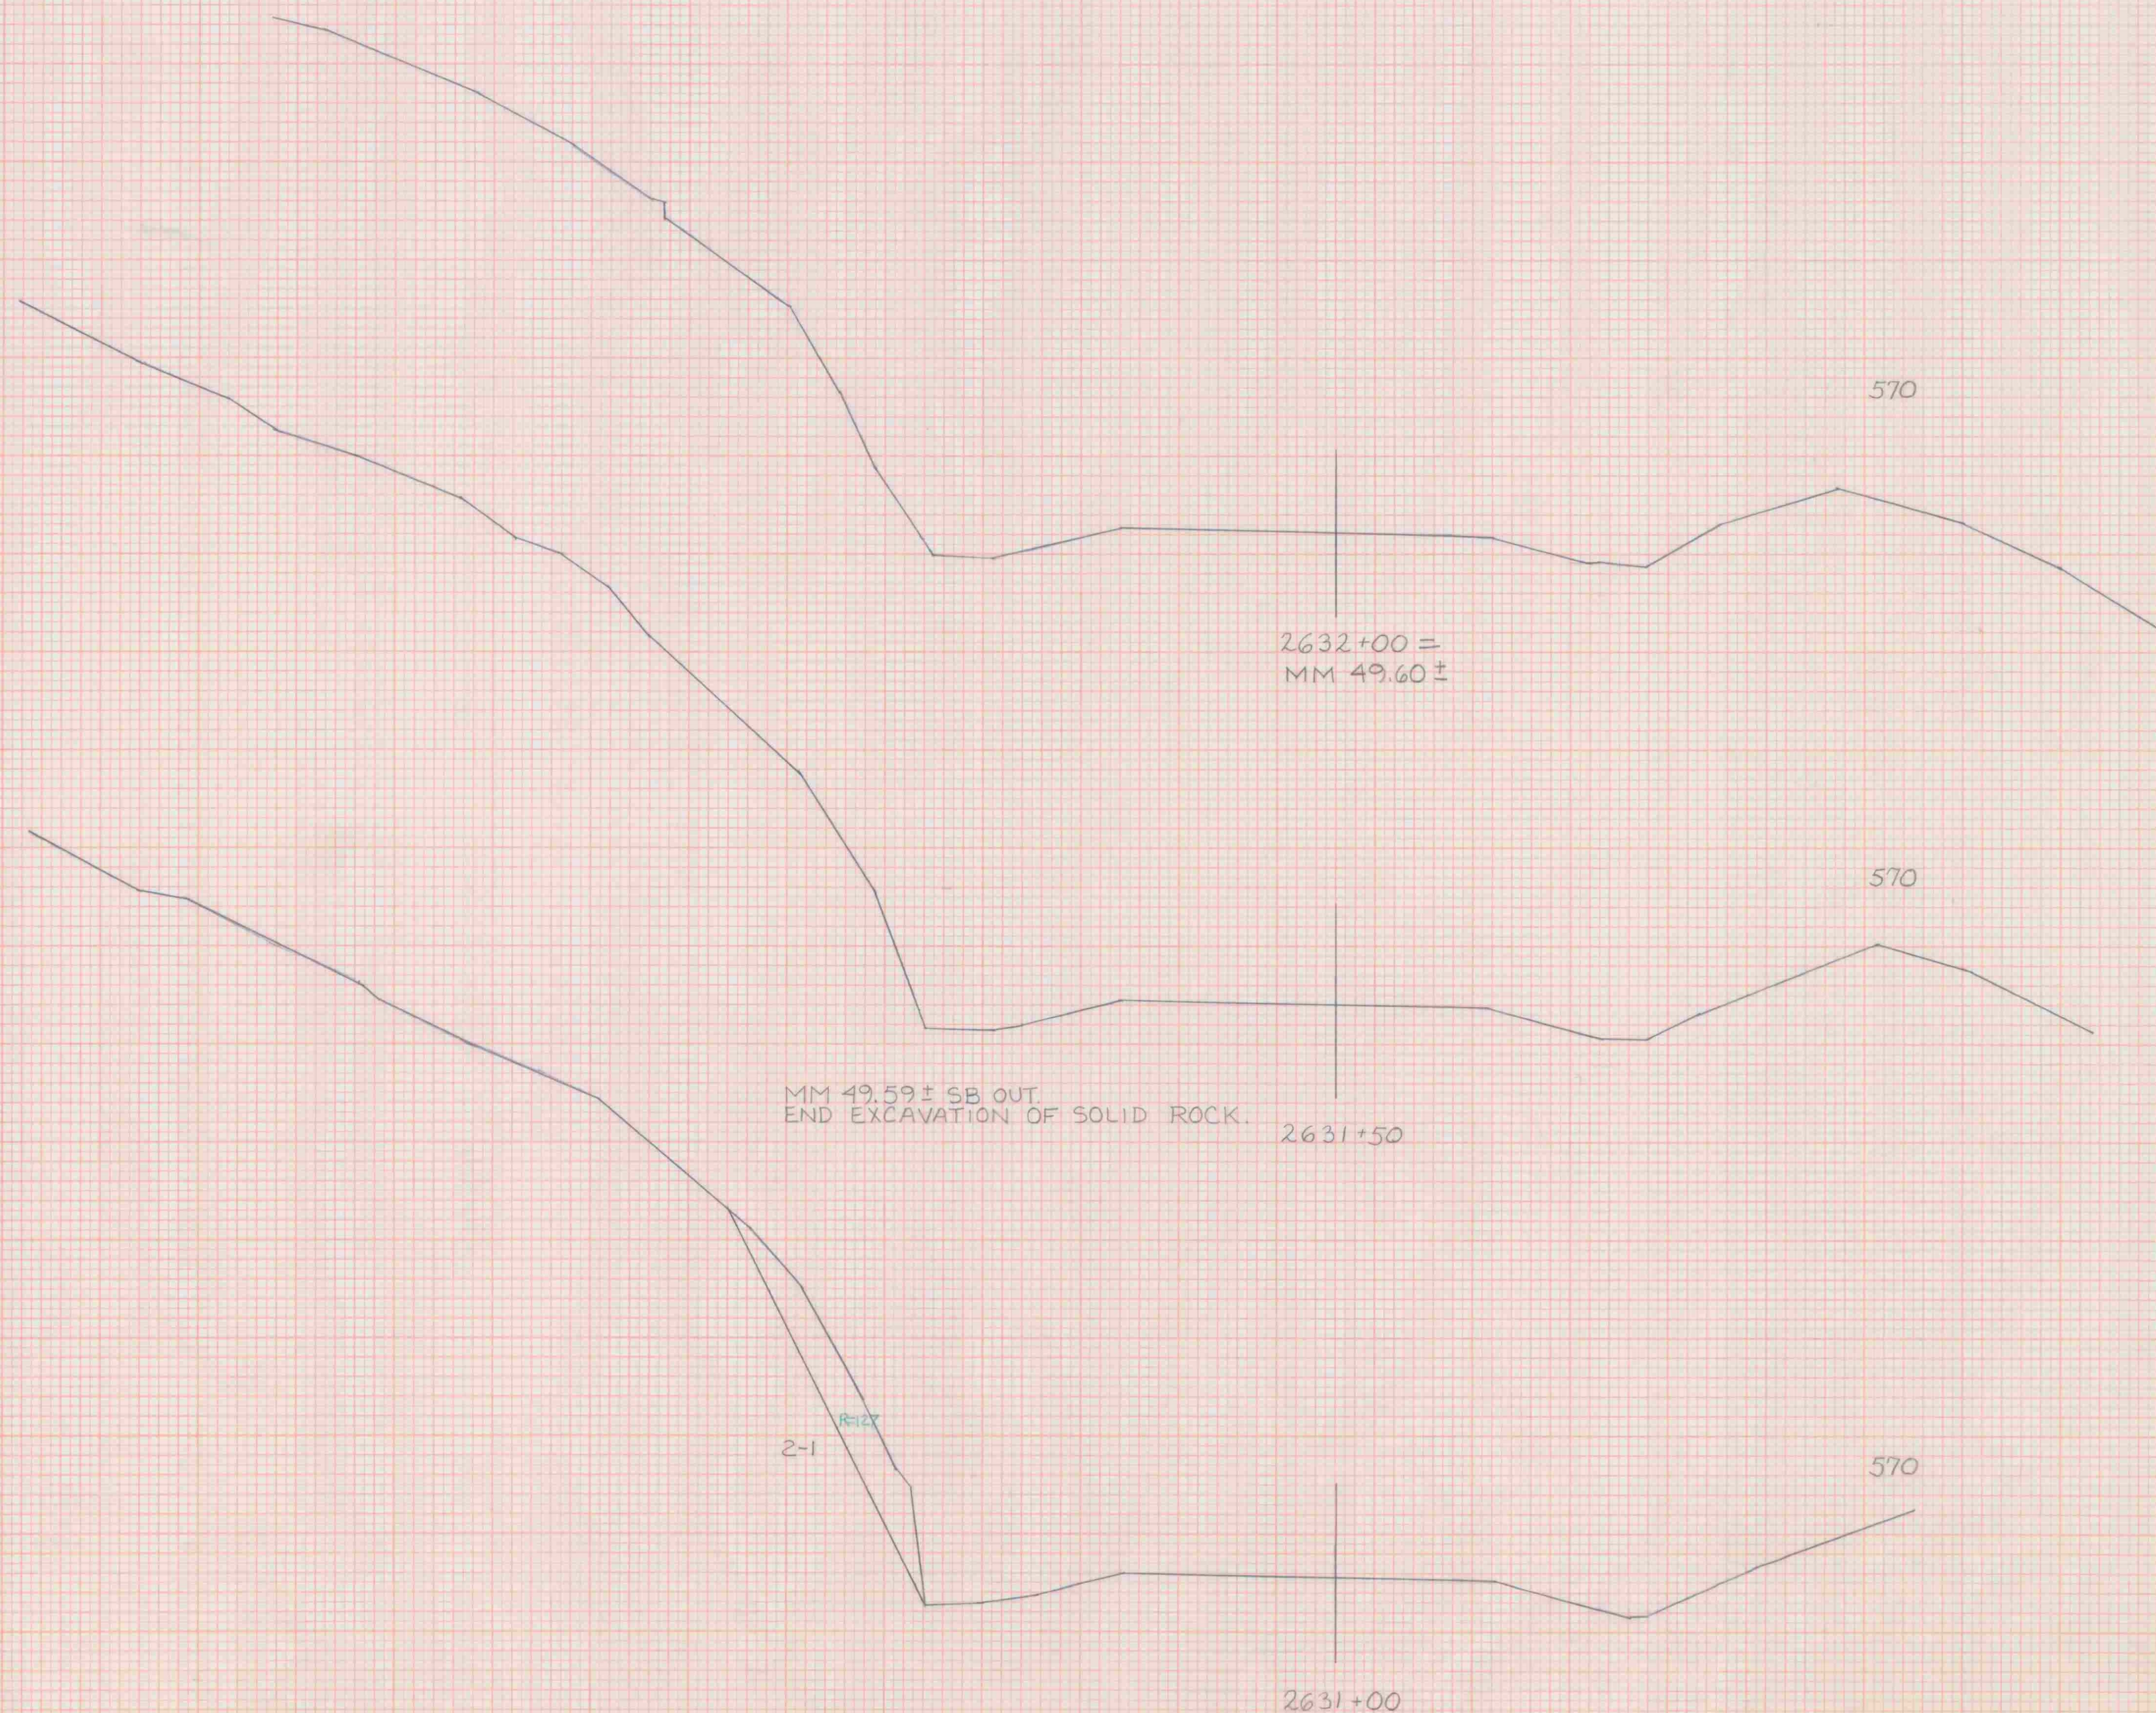

MM. 49.51 MM. 49.59
 STA. 2631+0 STA. 2632+0
 TOWN SPRINGFIELD-HARTFORD
 PROJECT IR NO 091-1(20)
 SHEET 85 OF 133 SHEETS
 HORIZ. AND VERT. SCALE
 1" = 10'
 DATE JAN. '90