


DATE	
BY	
REVIEWED	
DESIGNED	
PLANNED	
TEMP. DATE	
NO. 1	
NO. 2	
NO. 3	
NO. 4	
NO. 5	
NO. 6	
NO. 7	
NO. 8	
NO. 9	
NO. 10	

DATE	
BY	
REVIEWED	
DESIGNED	
PLANNED	
TEMP. DATE	
NO. 1	
NO. 2	
NO. 3	
NO. 4	
NO. 5	
NO. 6	
NO. 7	
NO. 8	
NO. 9	
NO. 10	

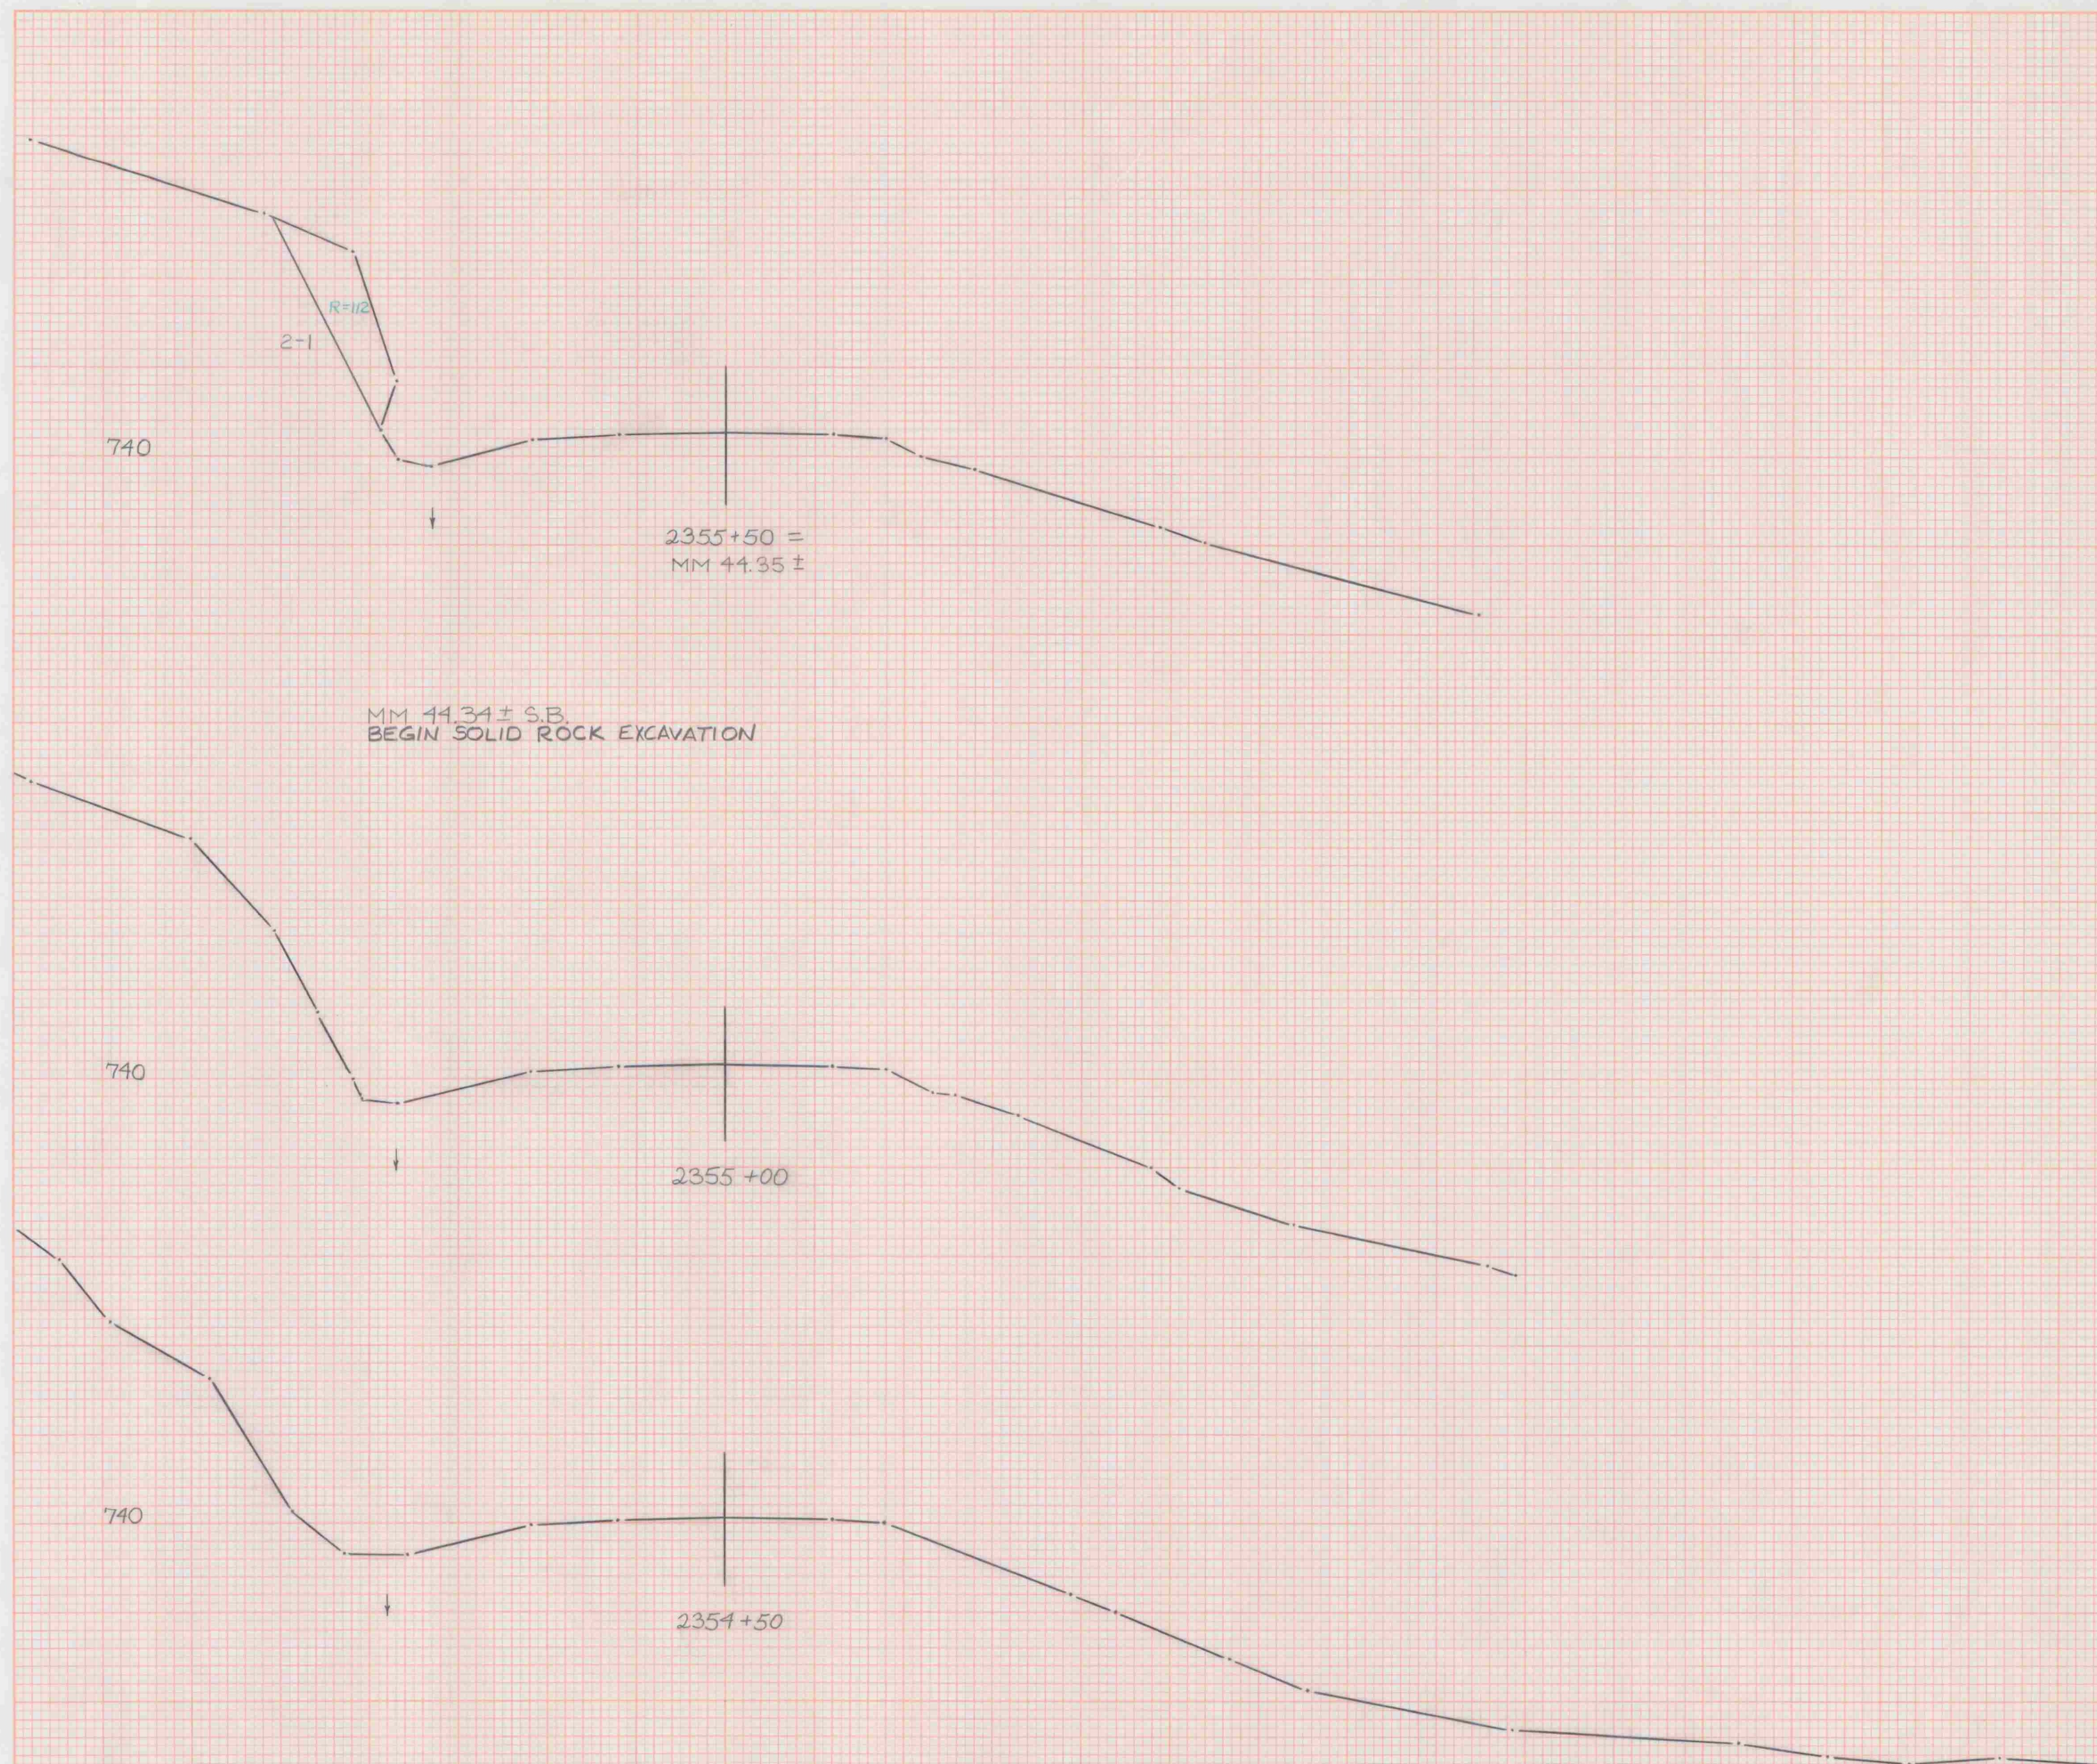

MM 44.34 ± S.B.
BEGIN SOLID ROCK EXCAVATION

SOUTHBOUND

MM 44.34	MM 44.45
STA 2354+50	STA 2355+50
TOWN SPRINGFIELD-HARTFORD	
PROJECT IR 091-K20	
HORIZ. & VERT. SCALES	
1"=10'	
DATE : JAN. '90	
SHEET 89 OF 133 SHEETS	