


|                 |              |
|-----------------|--------------|
| FINAL<br>SURVEY | DATE         |
|                 | BY           |
| NOTE BOOK       | SURVEYED     |
|                 | TEMP. DATE   |
| NO.             | AREA         |
|                 | AREA CHECKED |

|                    |              |
|--------------------|--------------|
| ORIGINAL<br>SURVEY | DATE         |
|                    | BY           |
| NOTE BOOK          | SURVEYED     |
|                    | TEMP. DATE   |
| NO.                | AREA         |
|                    | AREA CHECKED |



MM 44.36 ± EXISTING  
RCDI W/24" x 80" RCP

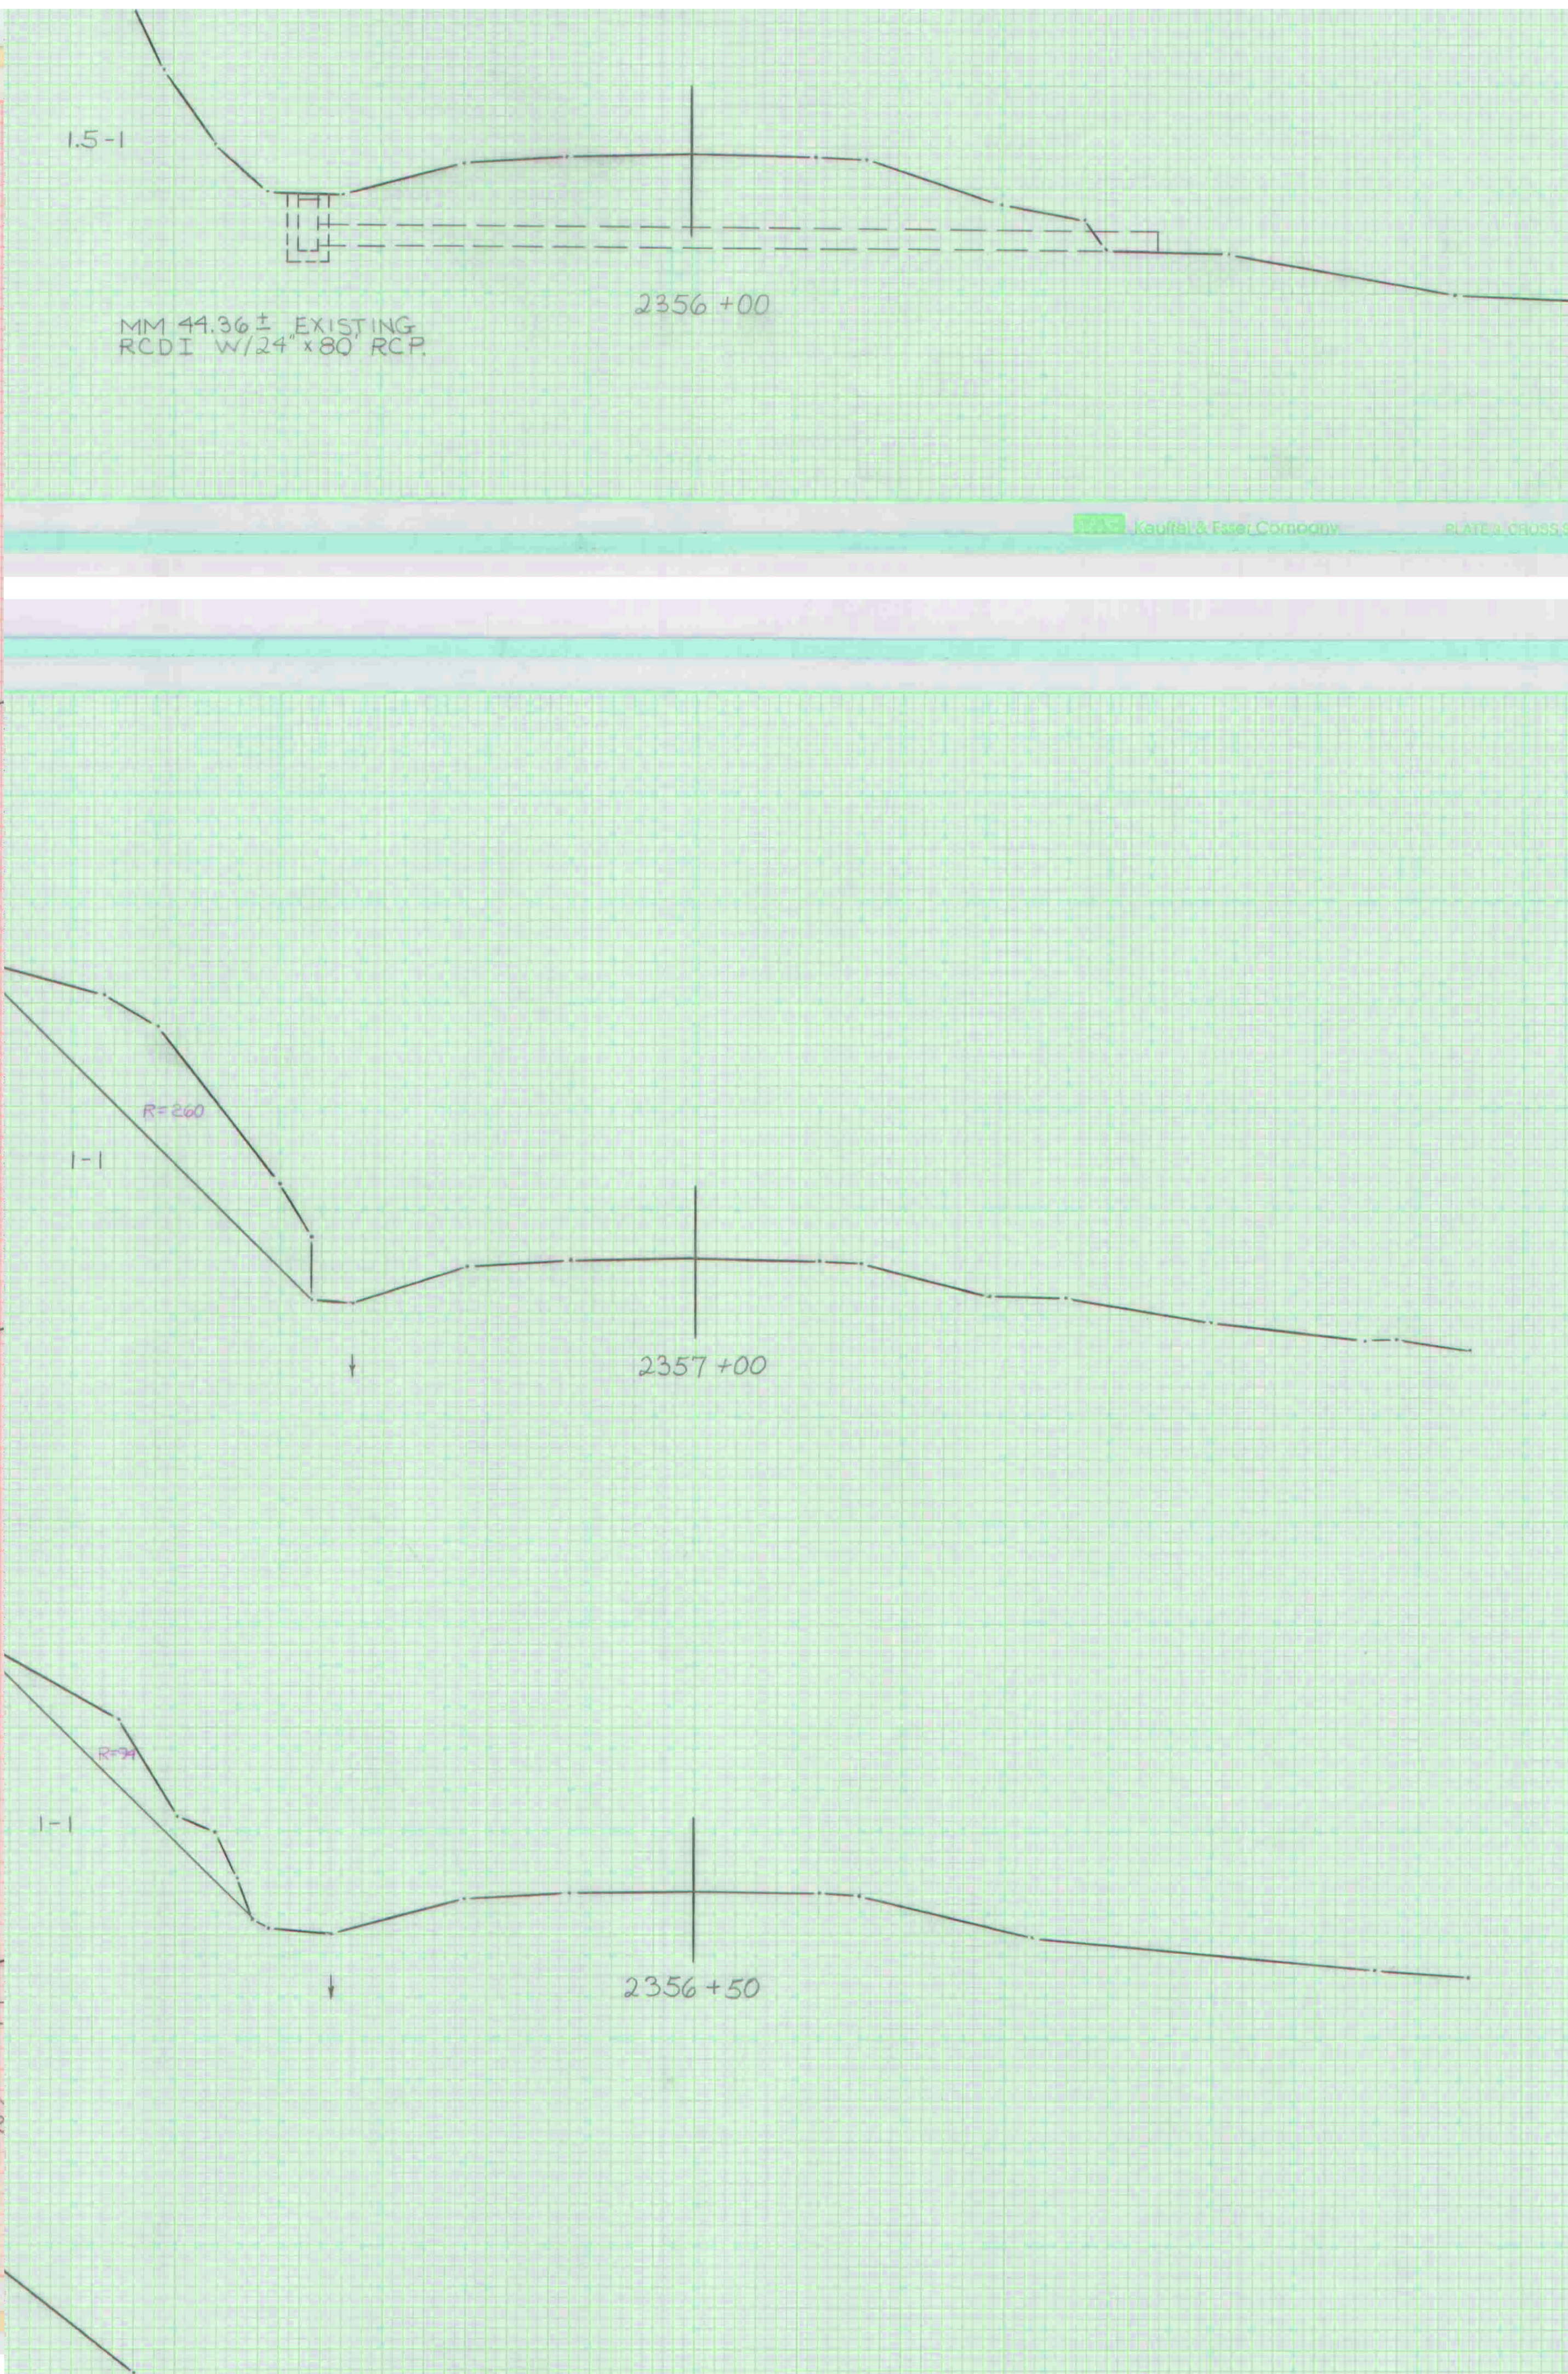

MM 44.36 ± EXISTING  
RCDI W/24" x 80" RCP

2356 +00

2357 +00

2356 +50

MM 44  
STA 235  
TOWN  
PROJECT  
HORIZ. &  
1"=10'  
DATE  
SHEET