


| DATE | BY | CHKD | APPD |
|------|----|------|------|
|      |    |      |      |
|      |    |      |      |
|      |    |      |      |
|      |    |      |      |

| DATE | BY | CHKD | APPD |
|------|----|------|------|
|      |    |      |      |
|      |    |      |      |
|      |    |      |      |
|      |    |      |      |

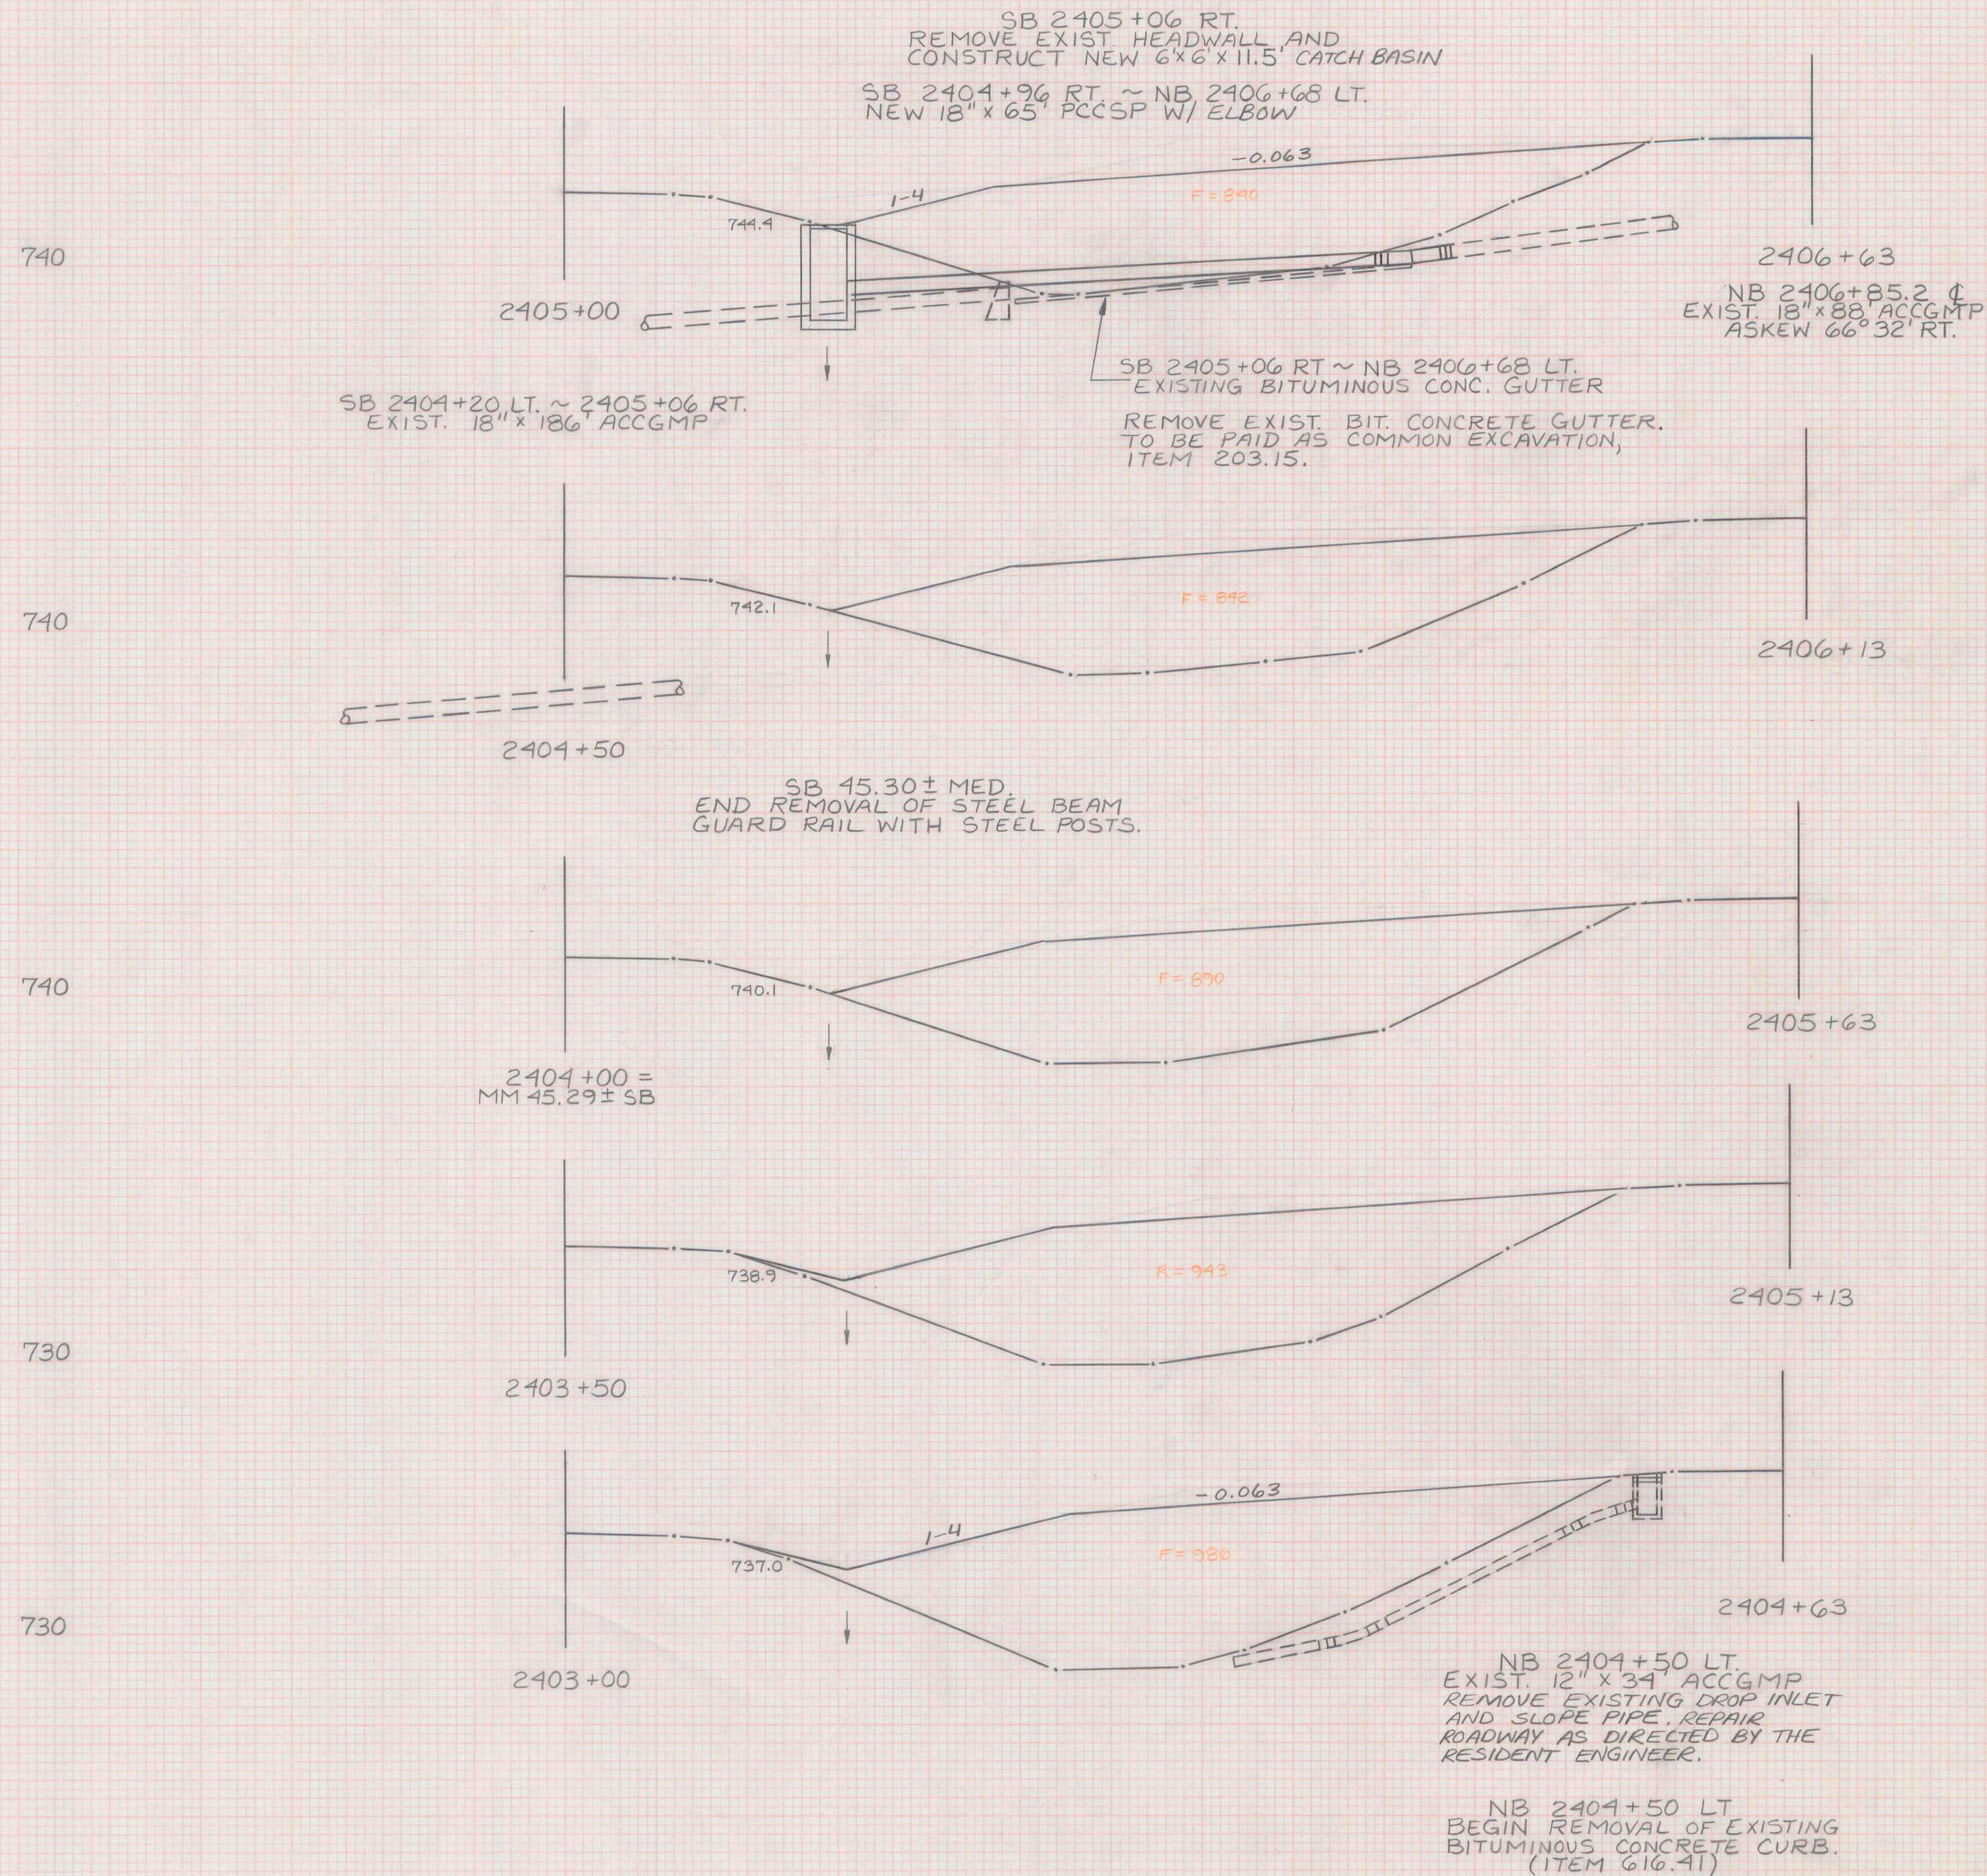

|                      |
|----------------------|
| ROCK DISPOSAL        |
| MM 45.00 MM          |
| STA 2403+0 ST        |
| TOWN SPRINGFIELD     |
| PROJECT IR 09        |
| HORIZ. & VERT. SCALE |
| 1"=10'               |
| DATE: OCT. 4, 1991   |
| SHEET 100 OF 100     |