


| DATE | BY | CHECKED | APPROVED |
|------|----|---------|----------|
|      |    |         |          |
|      |    |         |          |
|      |    |         |          |
|      |    |         |          |

| DATE | BY | CHECKED | APPROVED |
|------|----|---------|----------|
|      |    |         |          |
|      |    |         |          |
|      |    |         |          |
|      |    |         |          |

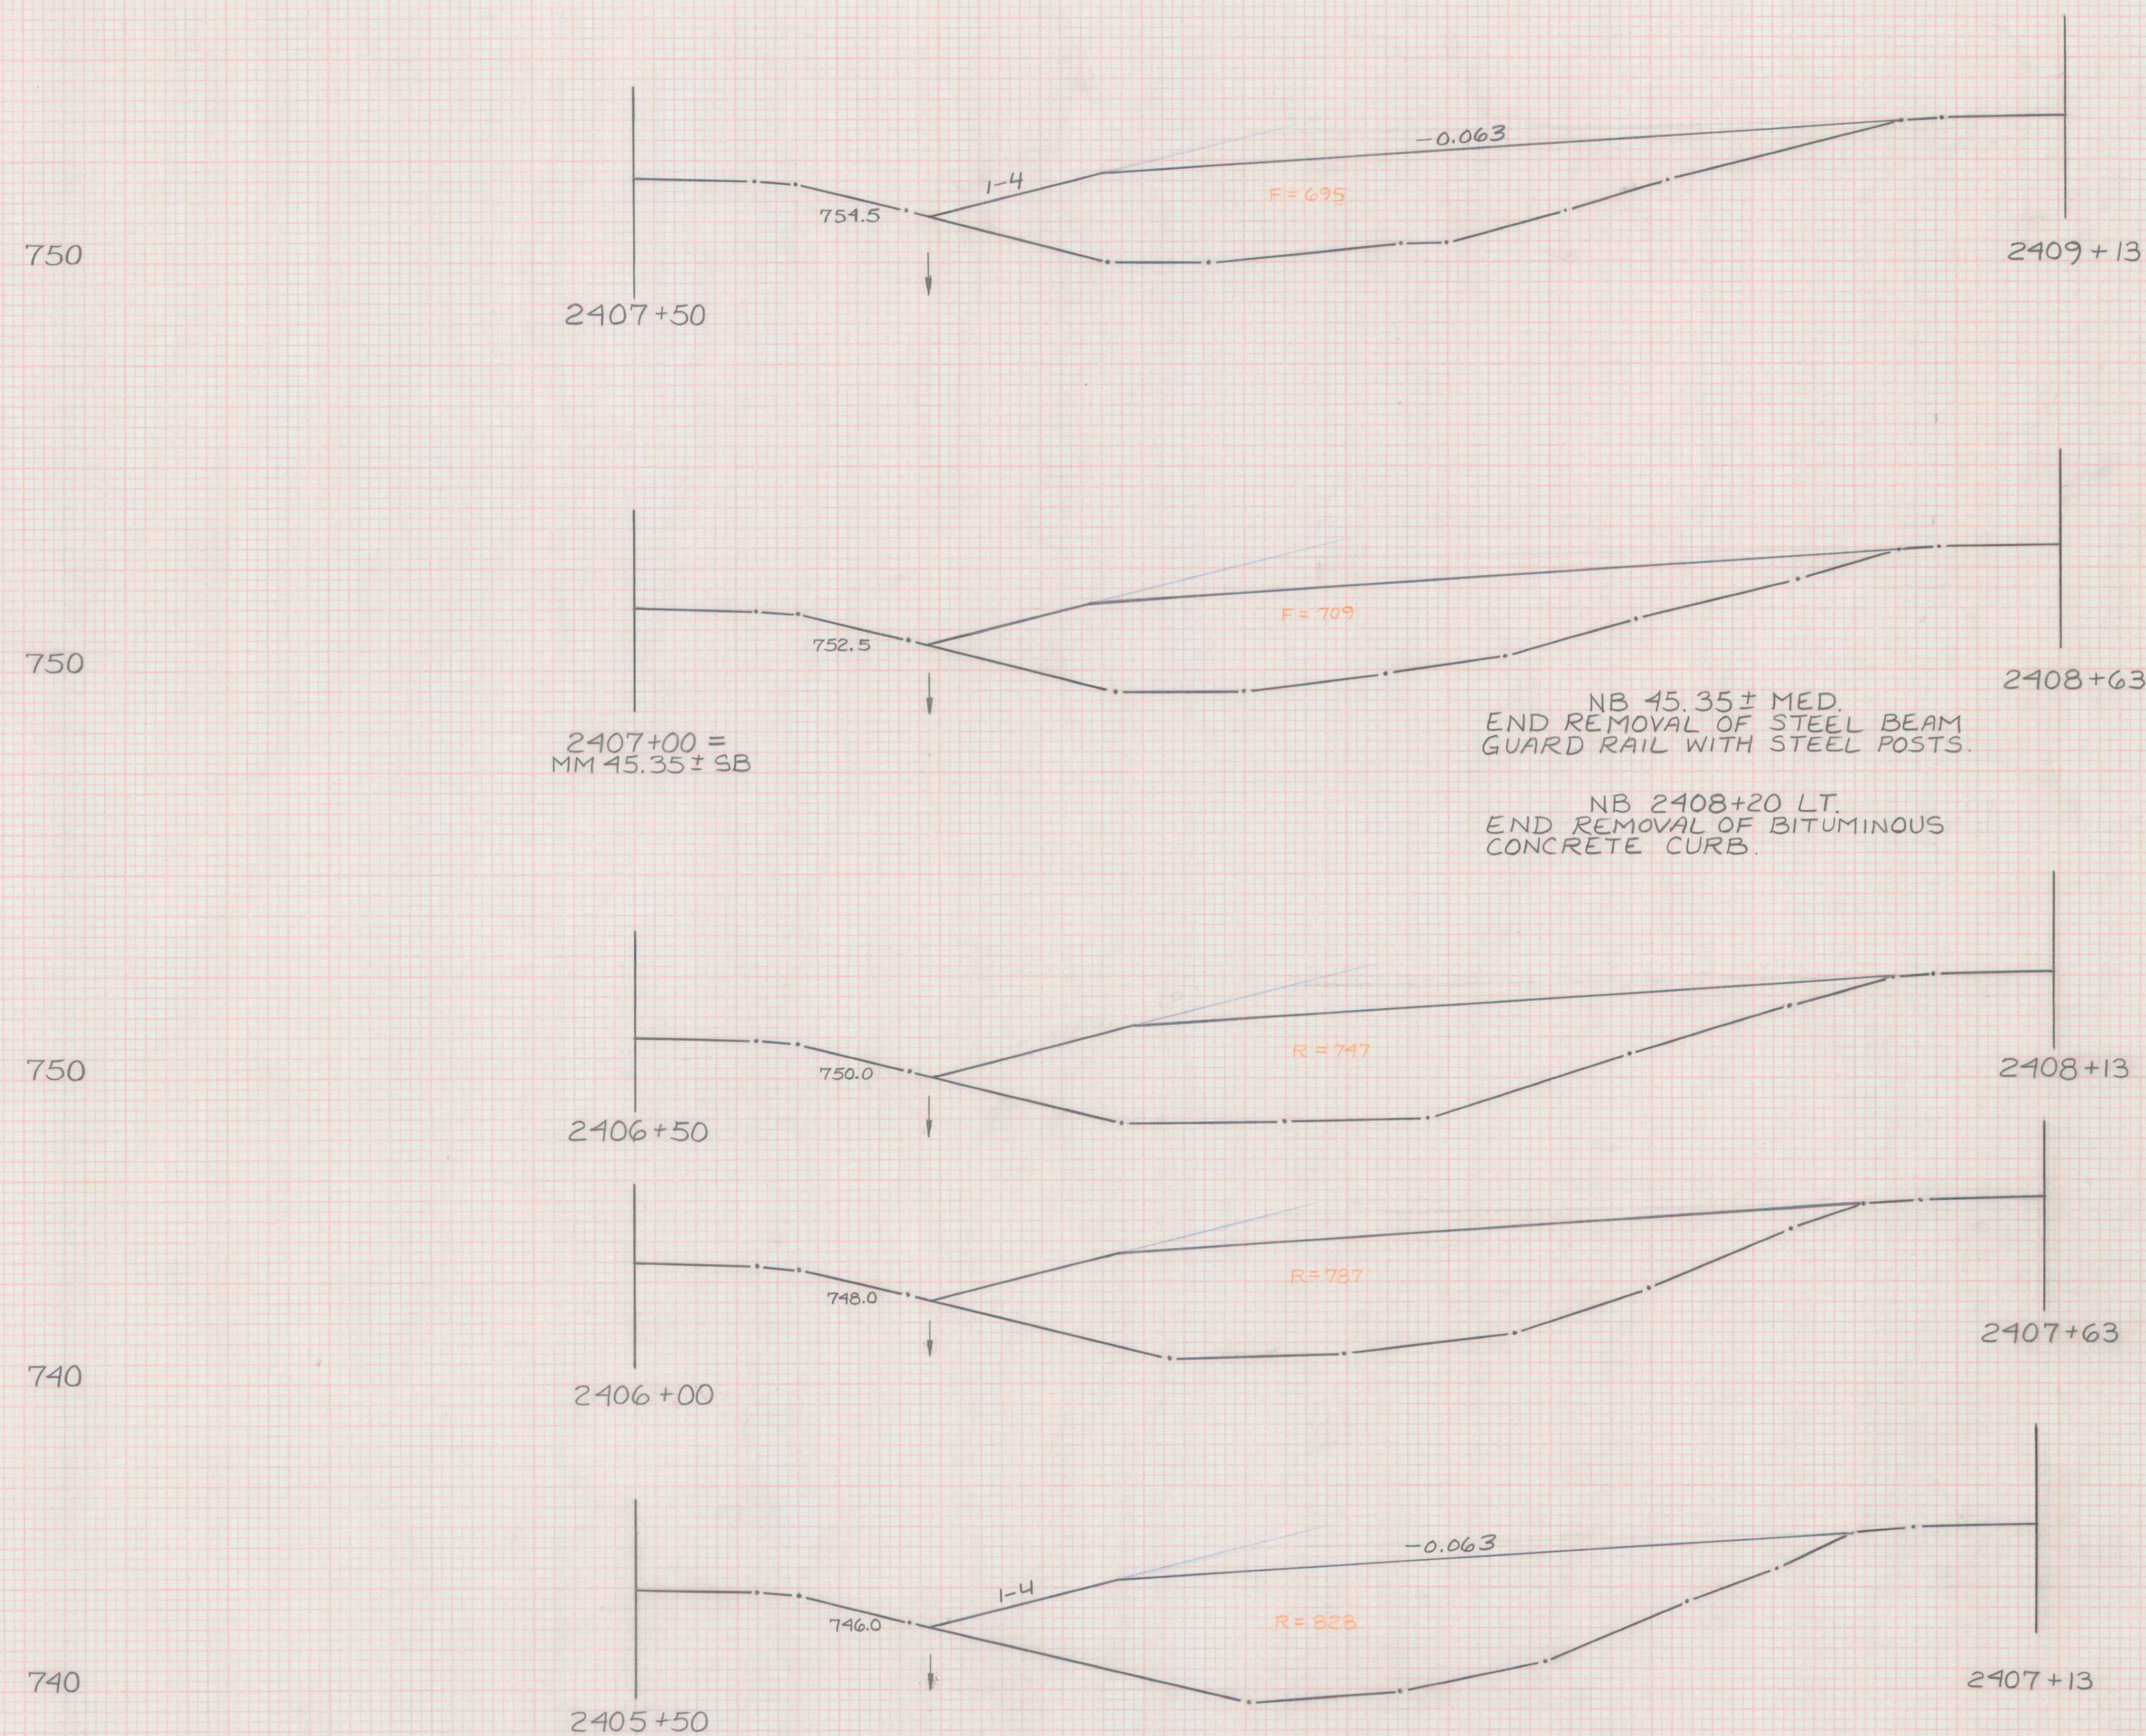

ROCK DISPOSAL AREA  
 MM 45.00 MM 45.38  
 STA 2405+50 STA 2407+50  
 TOWN SPRINGFIELD-HARTFORD  
 PROJECT IR 091-1(20)  
 HORIZ. & VERT. SCALES  
 1"=10'  
 DATE: OCT. 4, 1990  
 SHEET 101 OF 133 SHEETS