


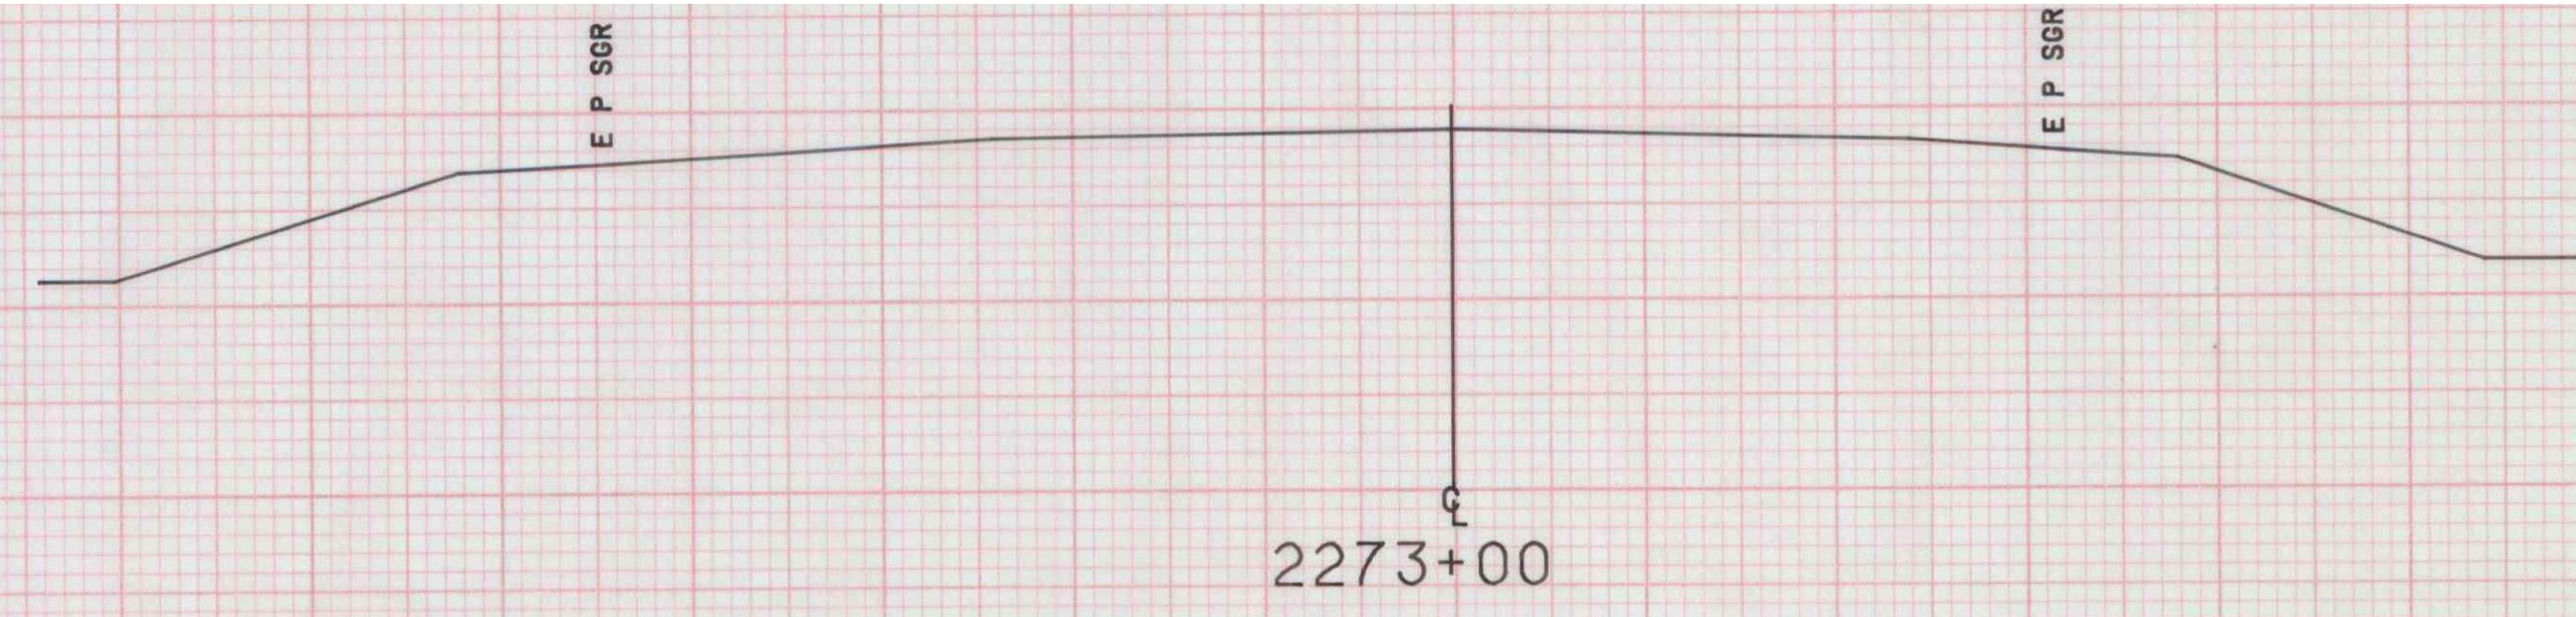

SCALE 5 FEET

SOUTHBOUND PEDESTAL
FROM STA. 2273+00 TO STA. 2273+00
PROJECT NAME SPRINGFIELD-HARTFORD
NO. IR091-1 (20)
SURVEYED BY J. SHERIDAN
SHEET 107 OF 133 SHEETS