


FINAL SURVEY NOTE BOOK	DATE	
	BY	
	REVISION	
	NO.	

ORIGINAL SURVEY NOTE BOOK	DATE	
	BY	
	REVISION	
	NO.	

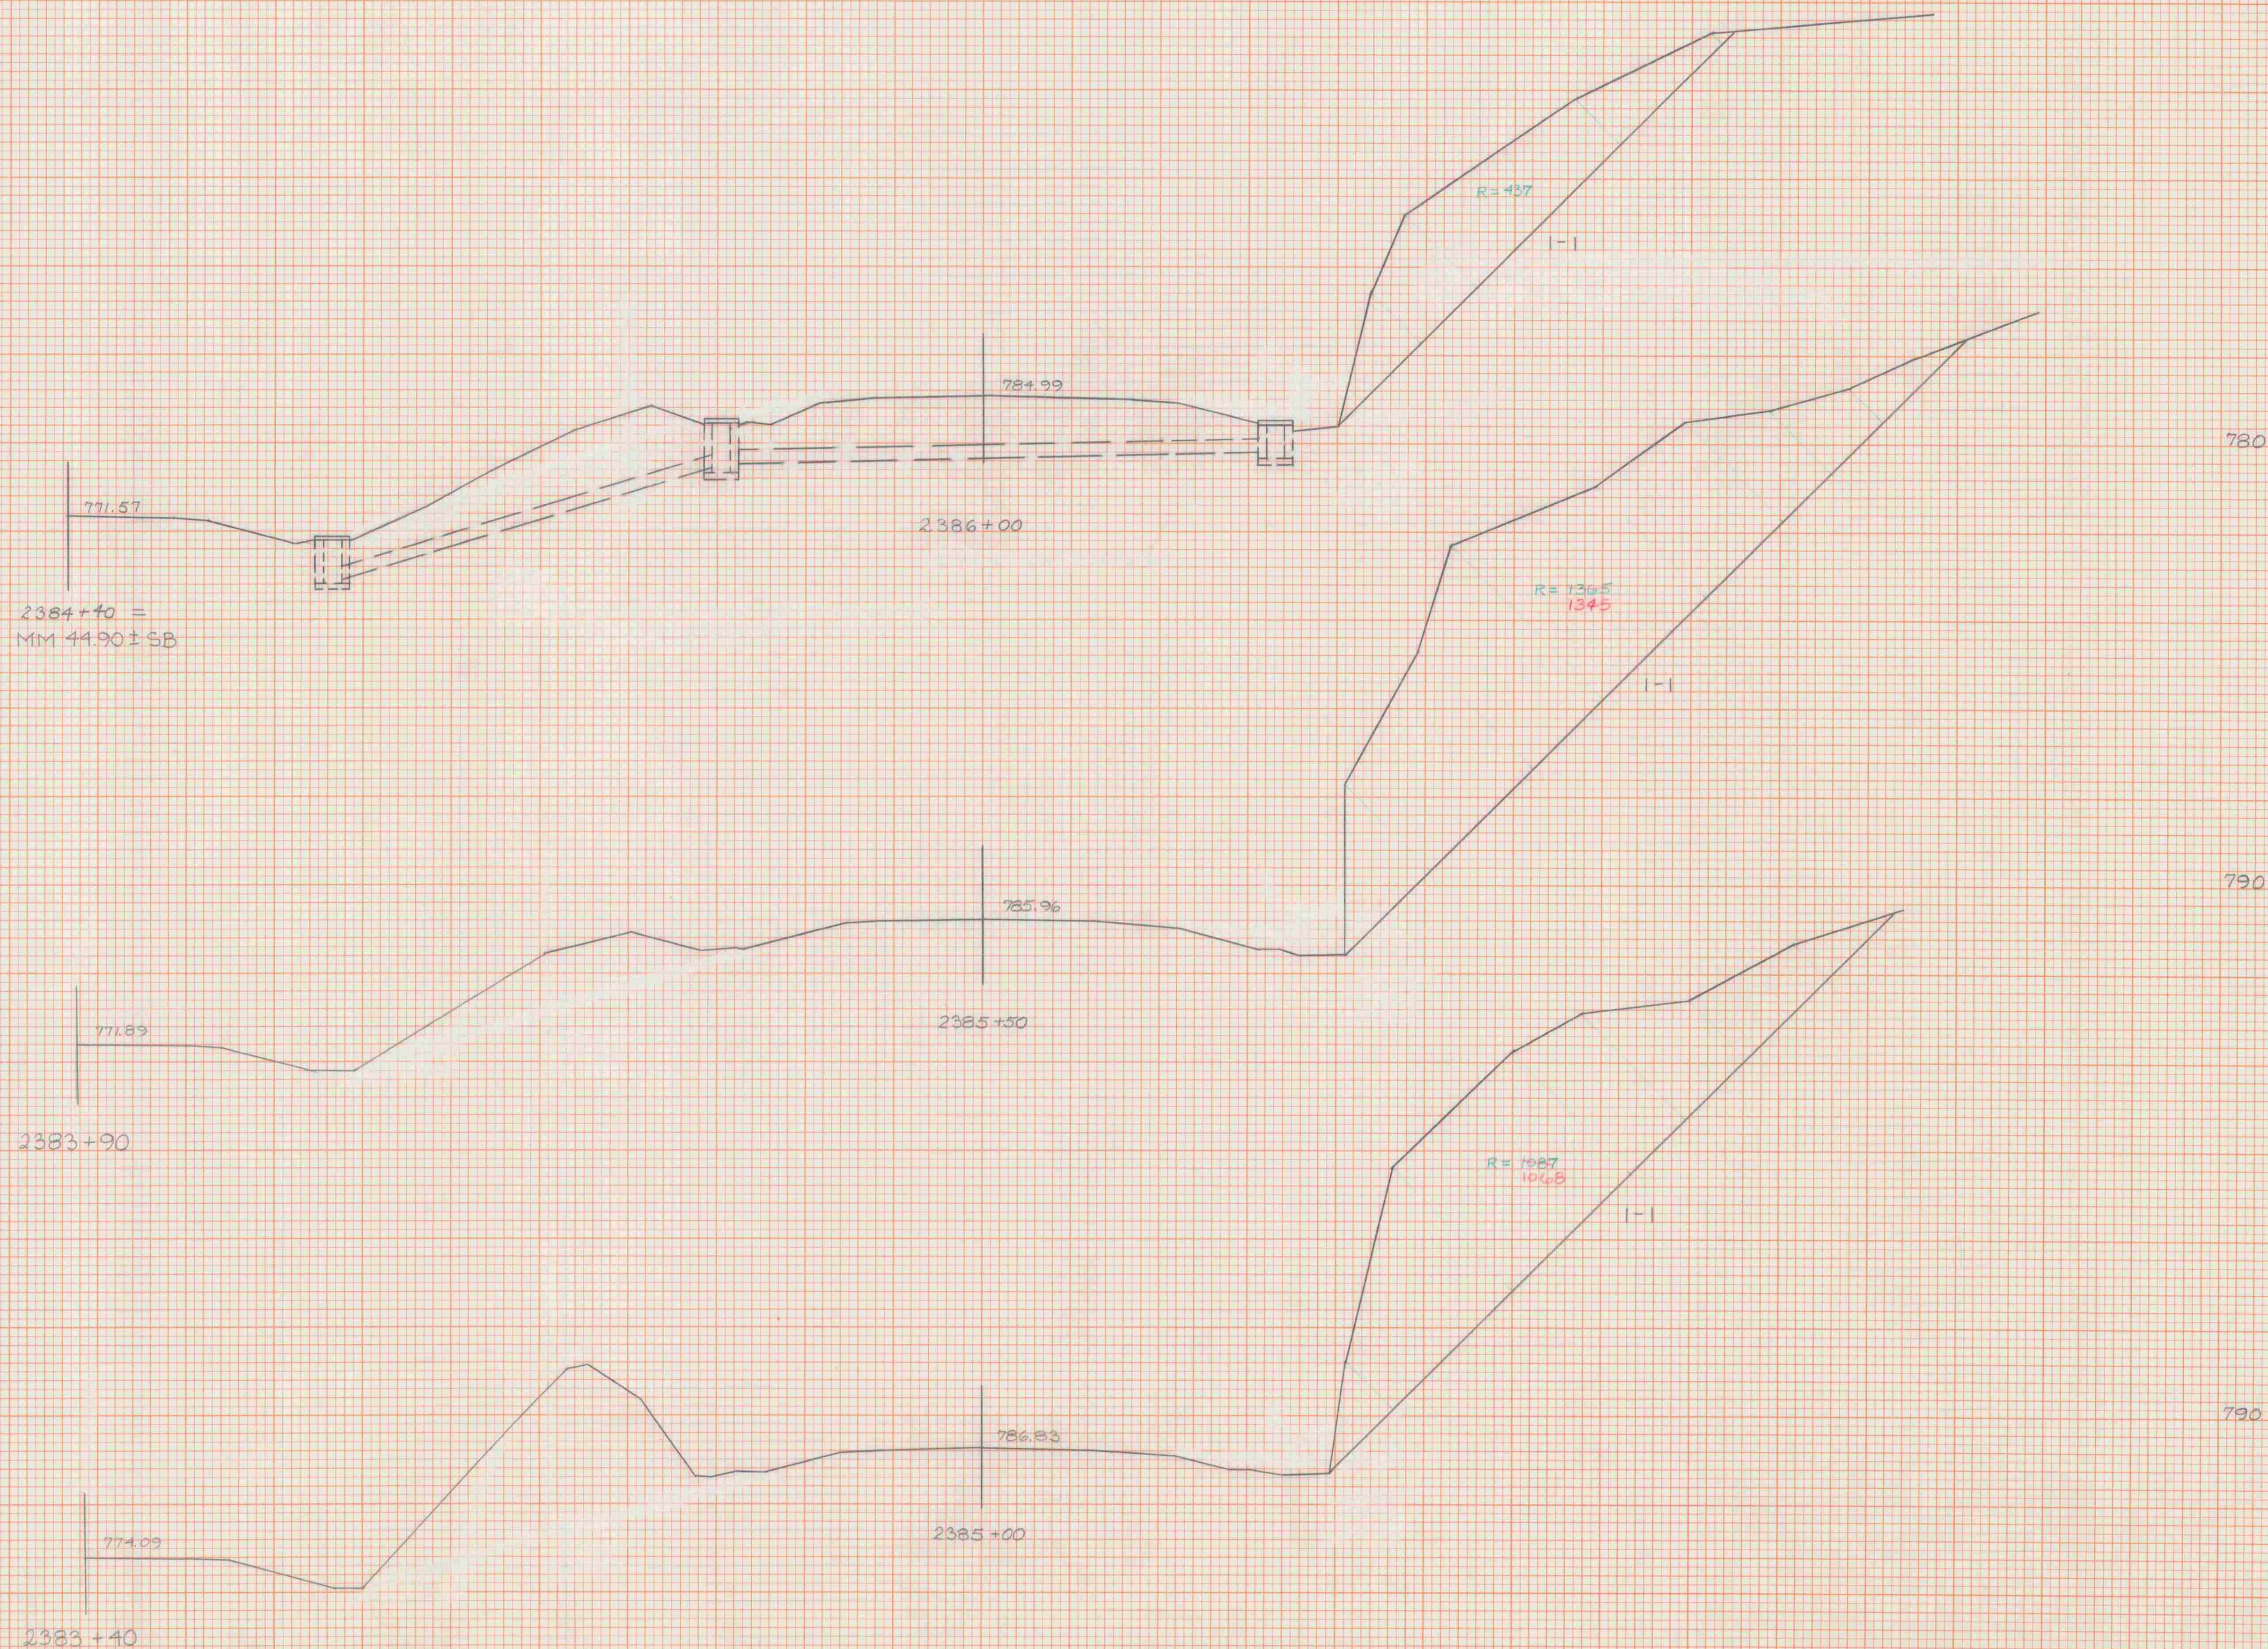

MM 44.84	MM 44.95
STA 2385+0	STA 2386+0
TOWN	SPRINGFIELD-HARTFORD
PRO. ECT	IF 091-112(1)
HOR. Z. & VERT. SCALES	1"=10'
DATE	JAN. '90
SHEET	120 OF 133 SHEETS