


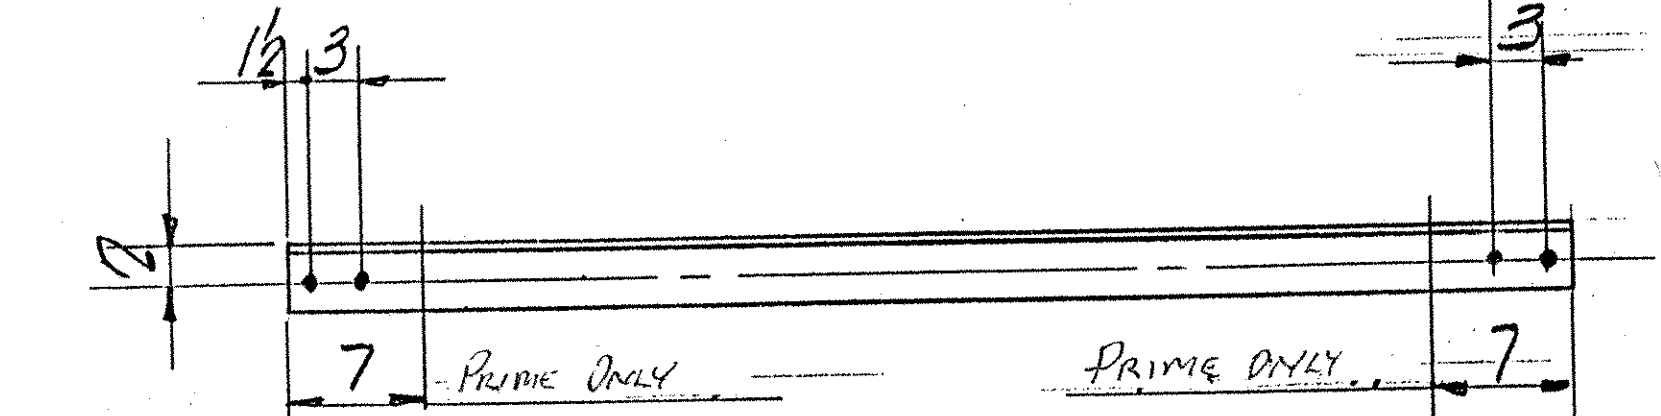

REPAIR ID# N2

REPAIR ID# S26

REPAIR ID# 54, 57, 58, 511, 514, 521

REPAIR ID# N13

22" x 36"

14 1/2" LEFT MARGIN.

 $\frac{1}{2}''$ T, R, & B

TYPICAL ALL DRUGS

VHLL

INCLUDE BOLT TYPE AND GRADE
WASHER & NUT TYPE & GRADE

MATERIAL: 4-22-20

MATERIAL: 4-22-86 ELECTRODES: HOLES: 1/16" Ø

MATERIAL A704-36

~~SURFACE PREP. & PAINT: SSPC-SP10, SHERWIN WILLIAMS~~

PRIMER: ZINC CLAD IV B69WB/B69VS

T-1000 Heavy Duty Paper B676.1301 / B60V3

FINISH: #17 SCHUBS POLYURETHANE B65W301/R60V30

DESCRIPTION: LATERAL BRACE

JOB: T-89 AIR & CR

101 1415 30 over

WHITE Room.

11/11/14

HAITFORD VI

CUSTOMER: Cheng Tai

WINDSEI INC
3400 RAY STREET STE

CASCO BAY STEEL STRUCTURES, INC.

5 INDUSTRY ROAD SOUTH PORTLAND, ME. 04106
PHONE (207) 772-2533 FAX (207) 772-0580

PHONE (207) 772-2555 FAX: (207) 772-3555

JOB NO.	DRG. NO.
---------	----------

048	5
-----	---

108	REV.	△
-----	------	---

$$j^* = 1 - \epsilon$$

Rec'd - 57099