

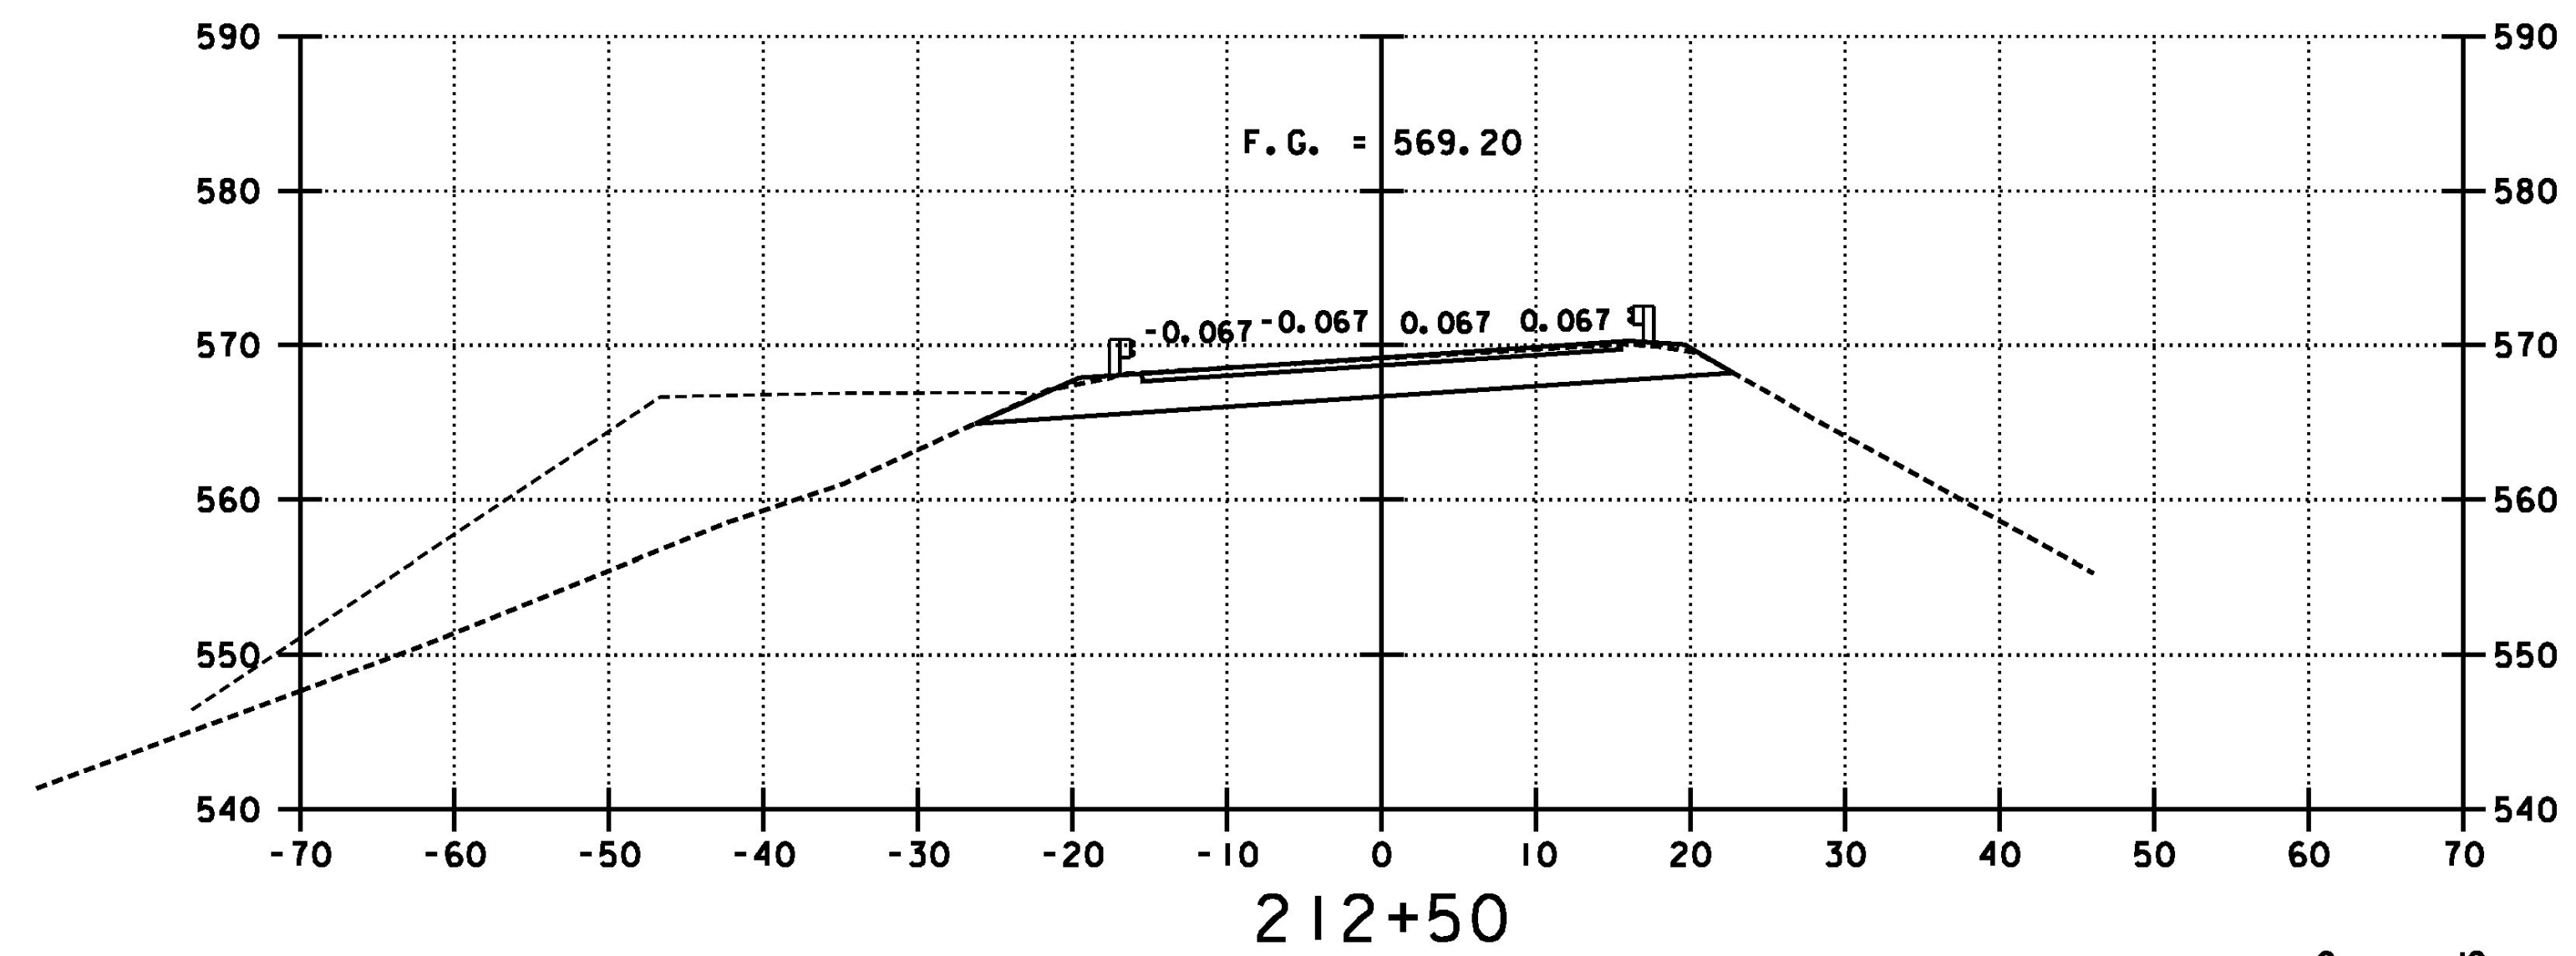


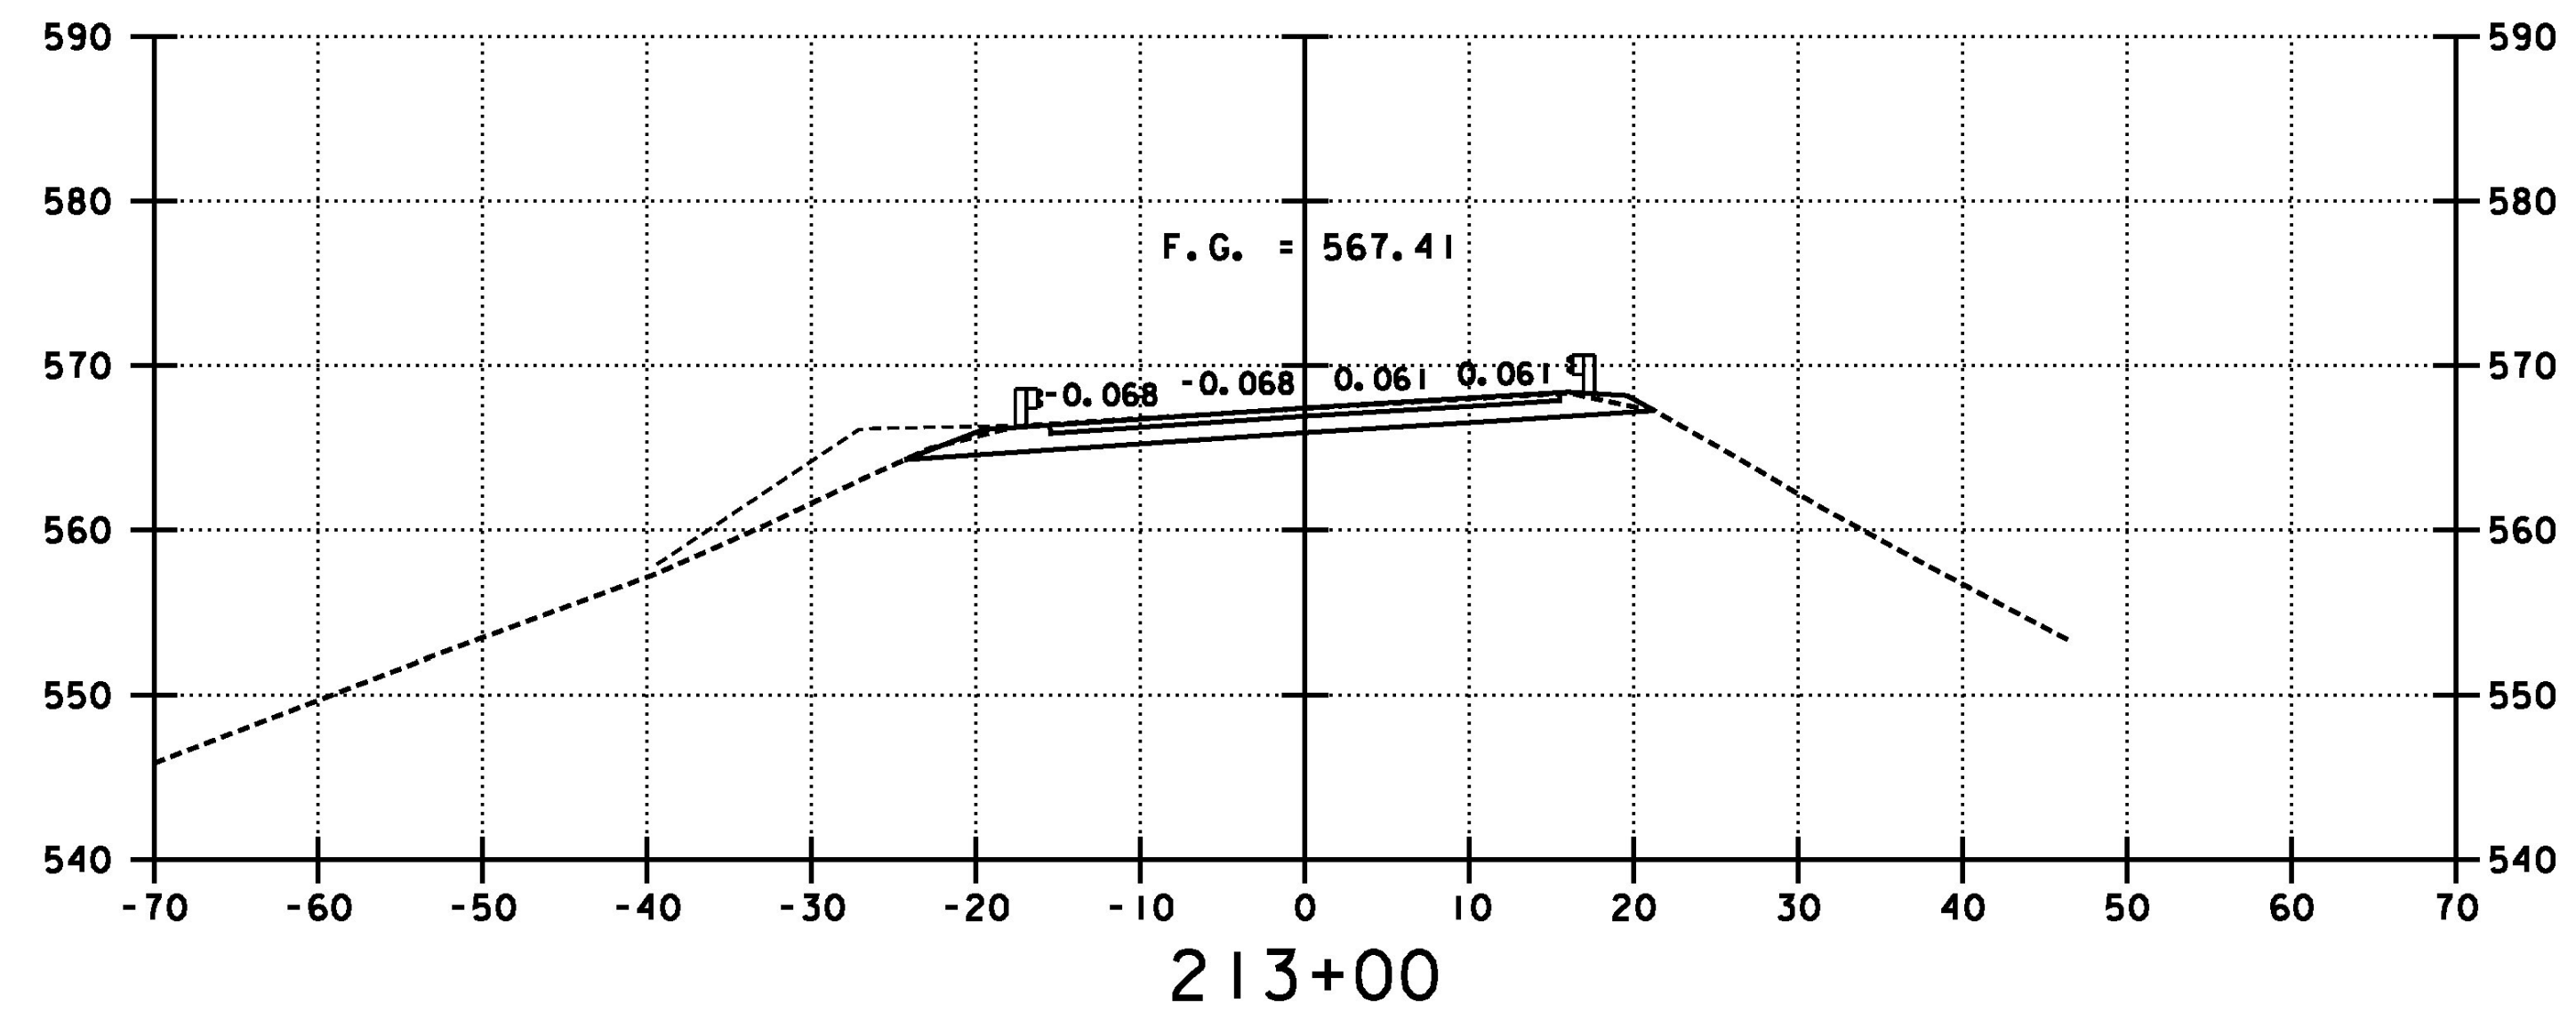

214+00
END COLD PLANING

0 10 20
SCALE

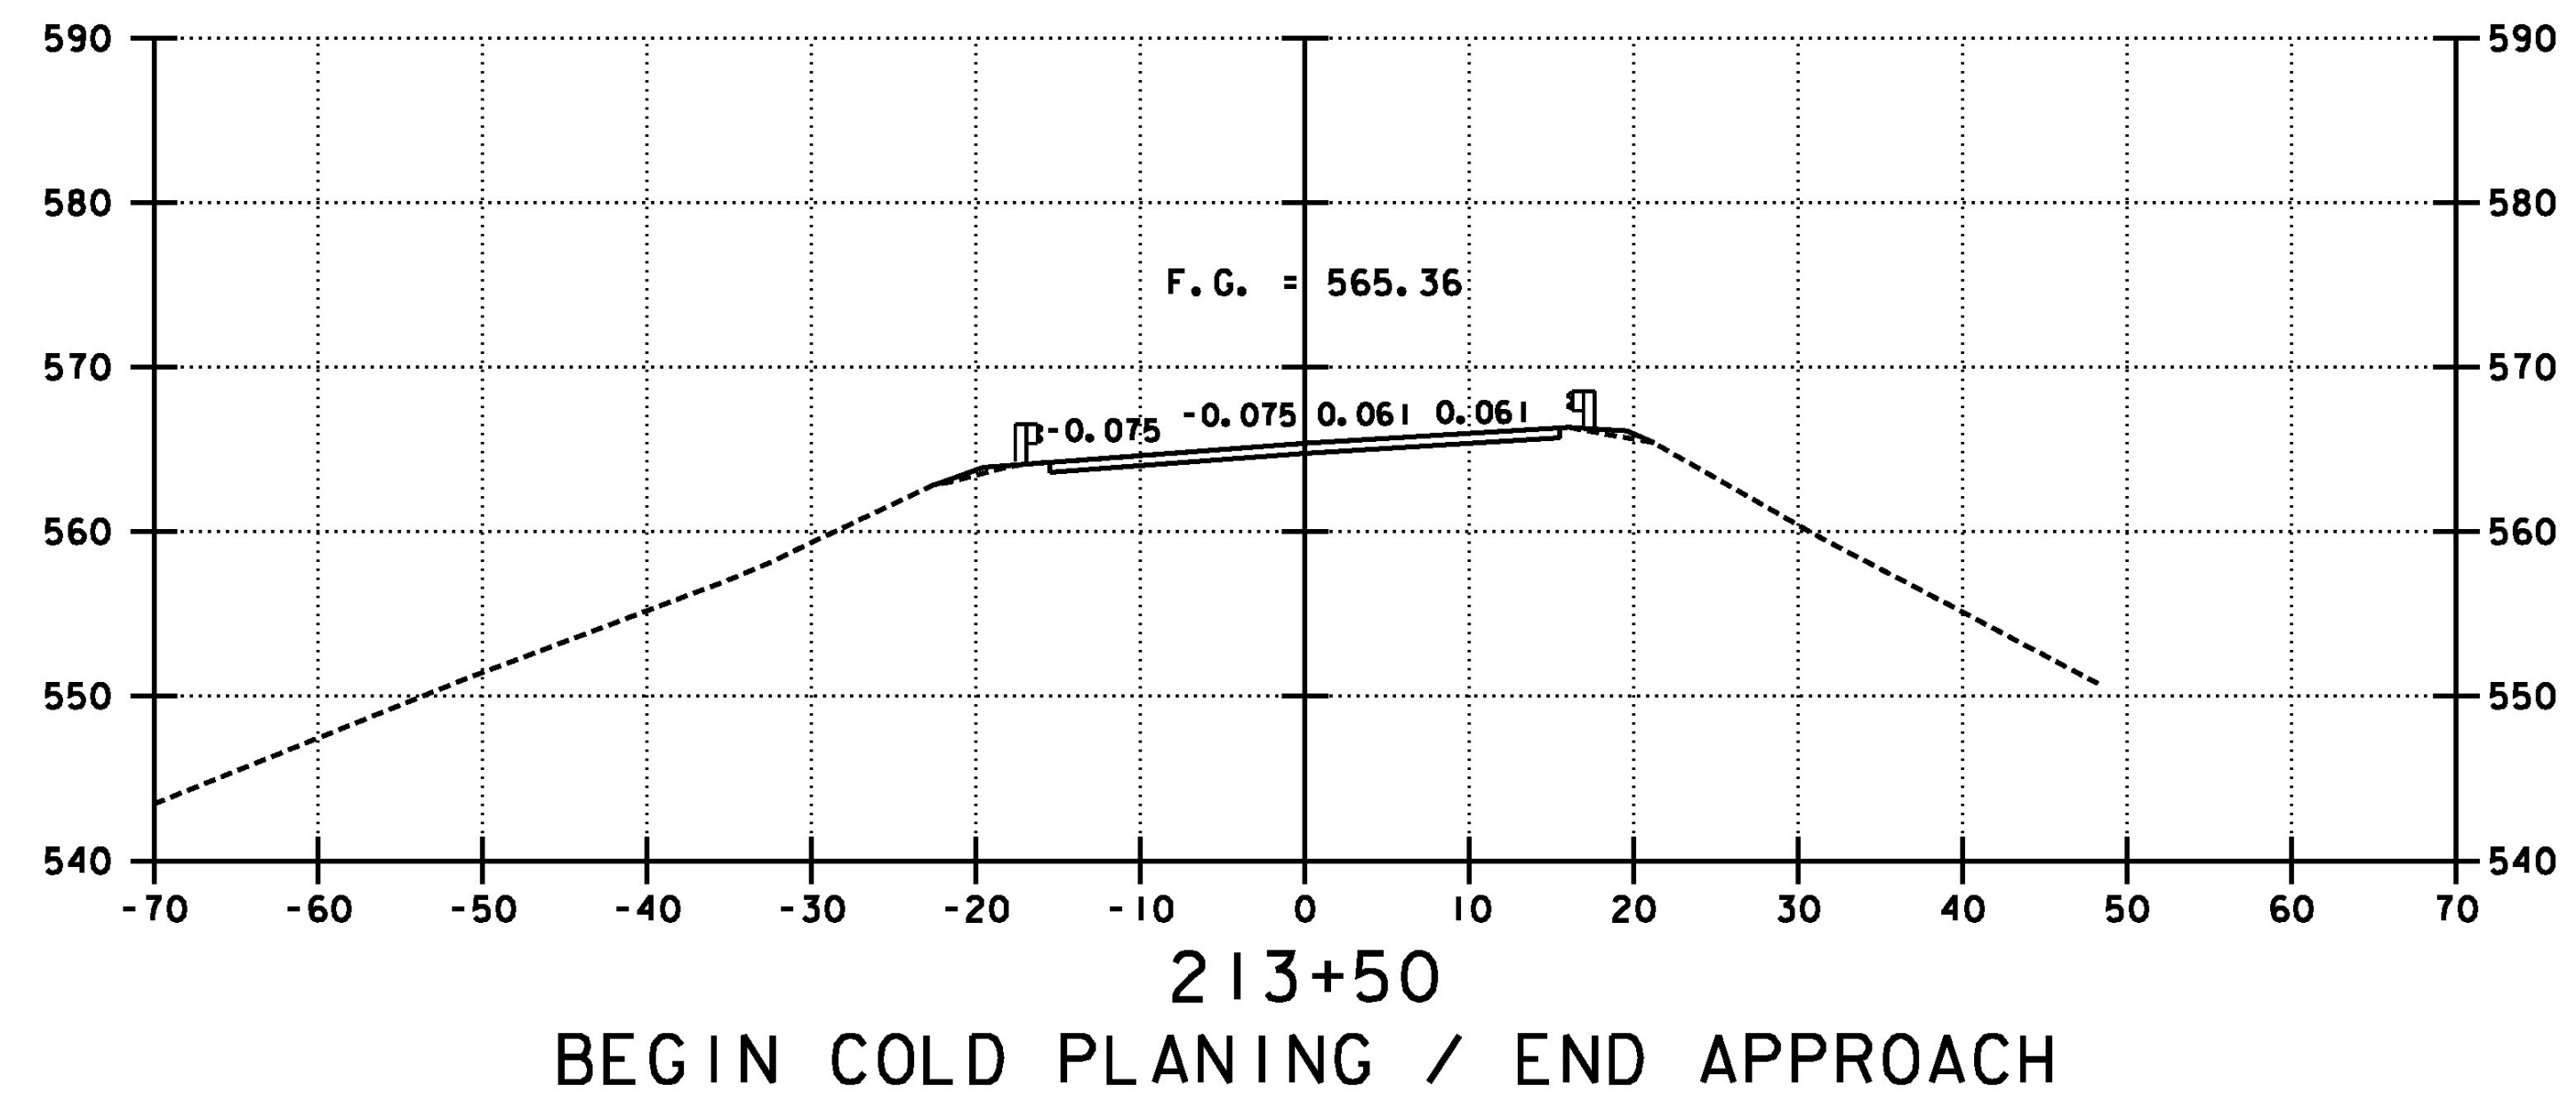

PROJECT NAME: PUTNEY	
PROJECT NUMBER: IM 091-1(31)	
FILE NAME: ...drawing\z93al48xs.dgn	PLOT DATE: 7/8/2009
PROJECT LEADER: G. BOGUE	DRAWN BY: E. ALLING
DESIGNED BY: E. ALLING	CHECKED BY: G. GOYETTE
MAINLINE SECTIONS	SHEET 57 OF 75