




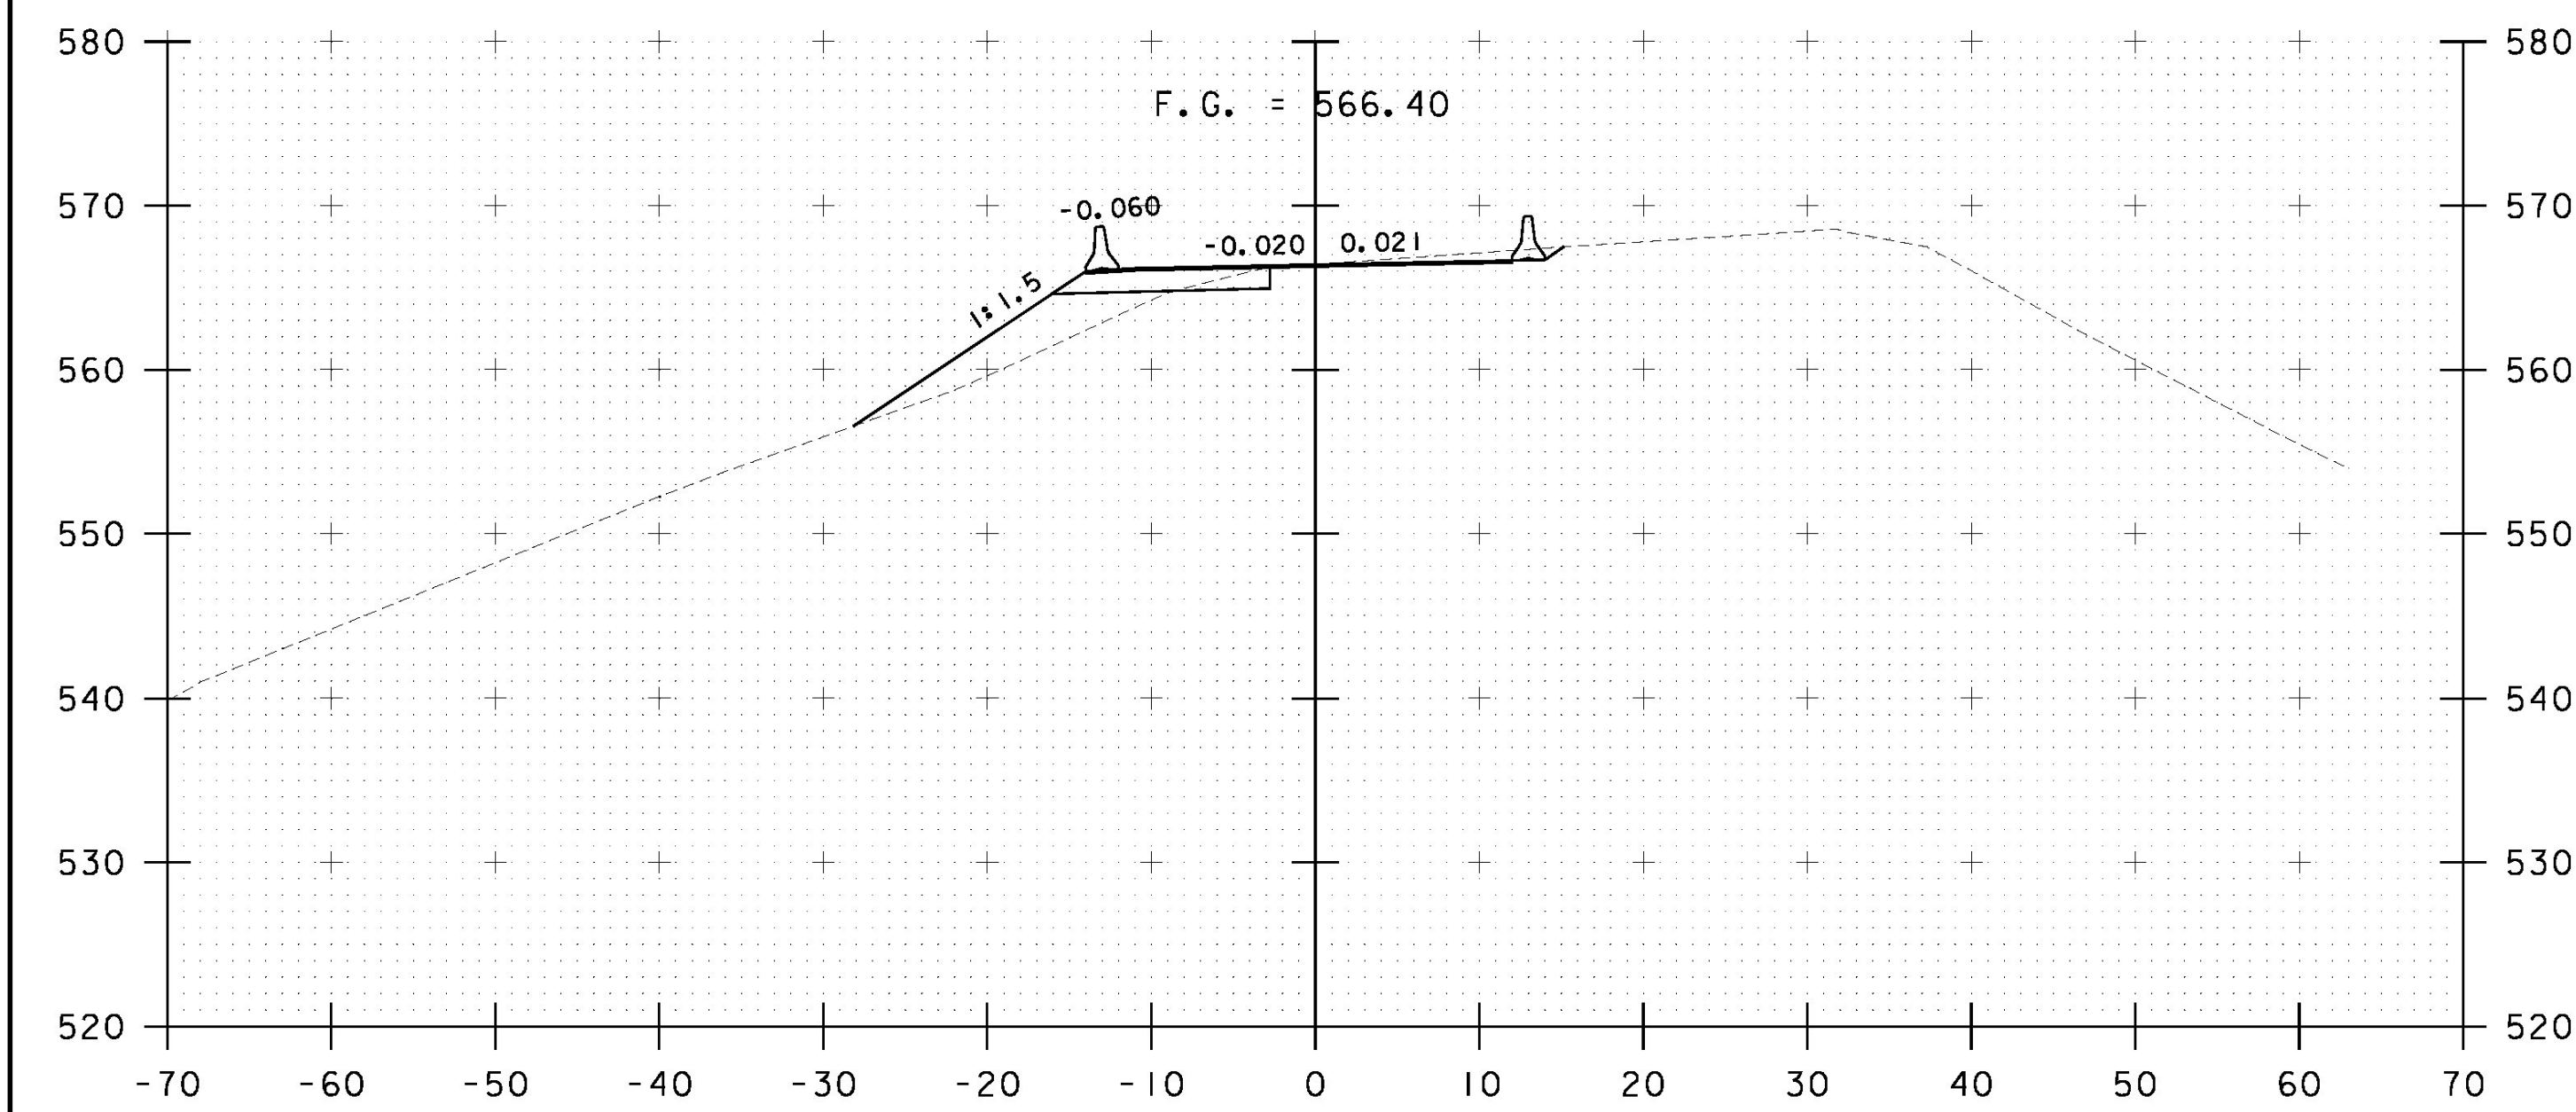


411+50

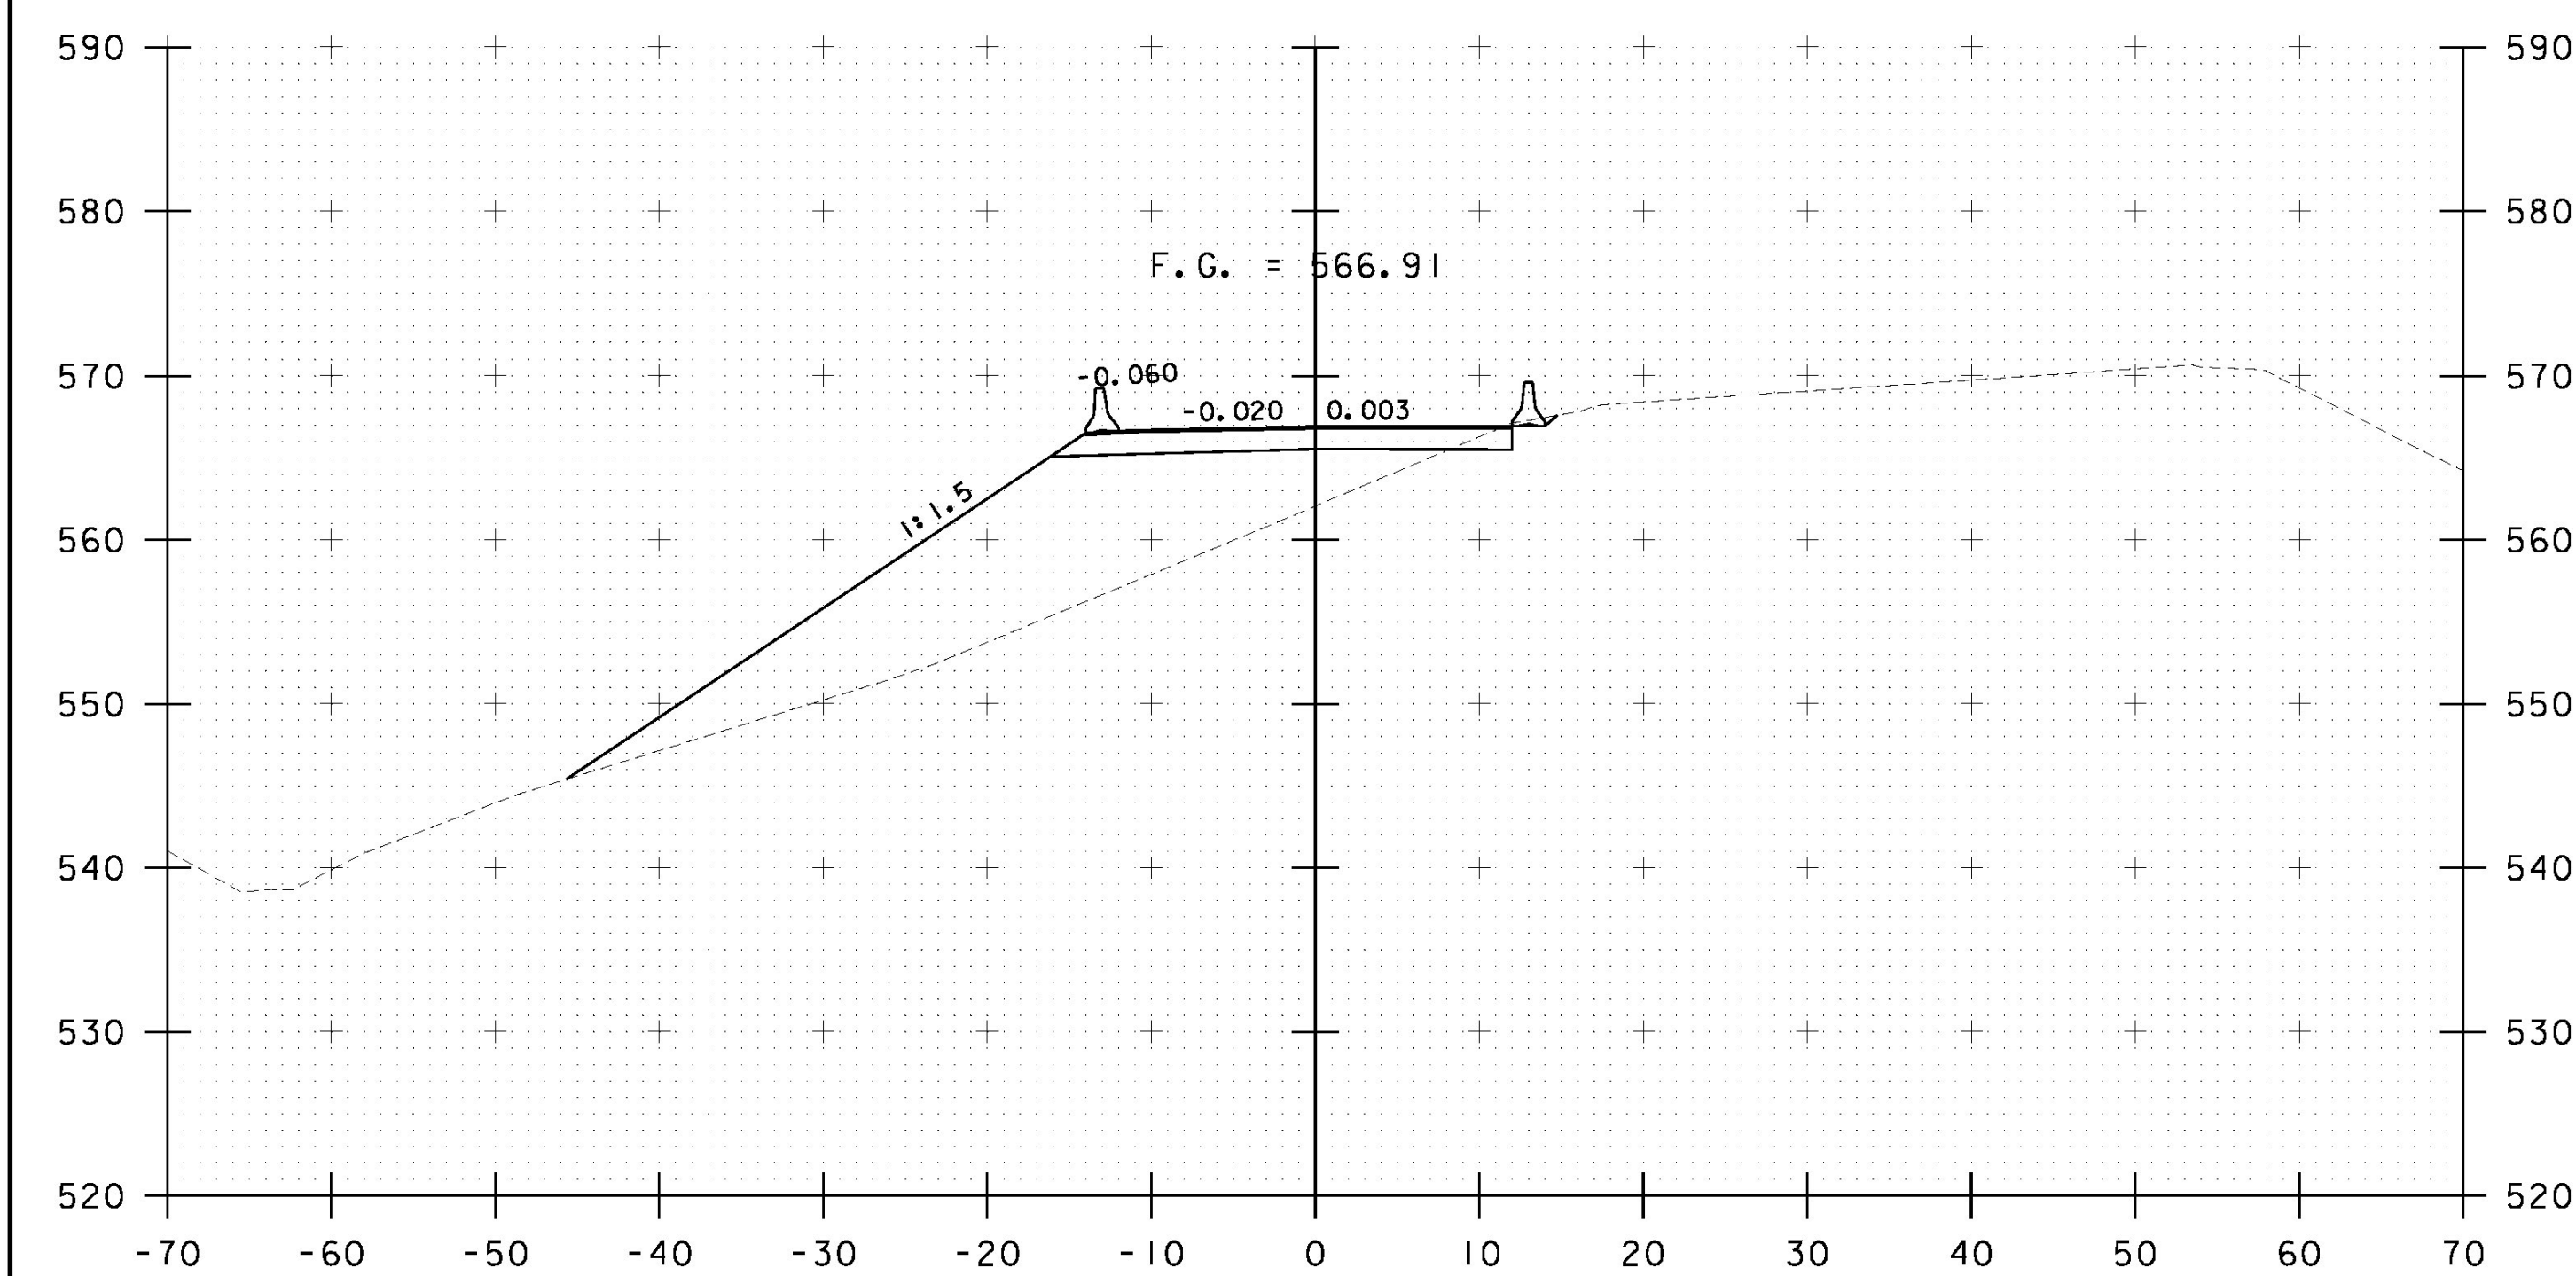

411+00

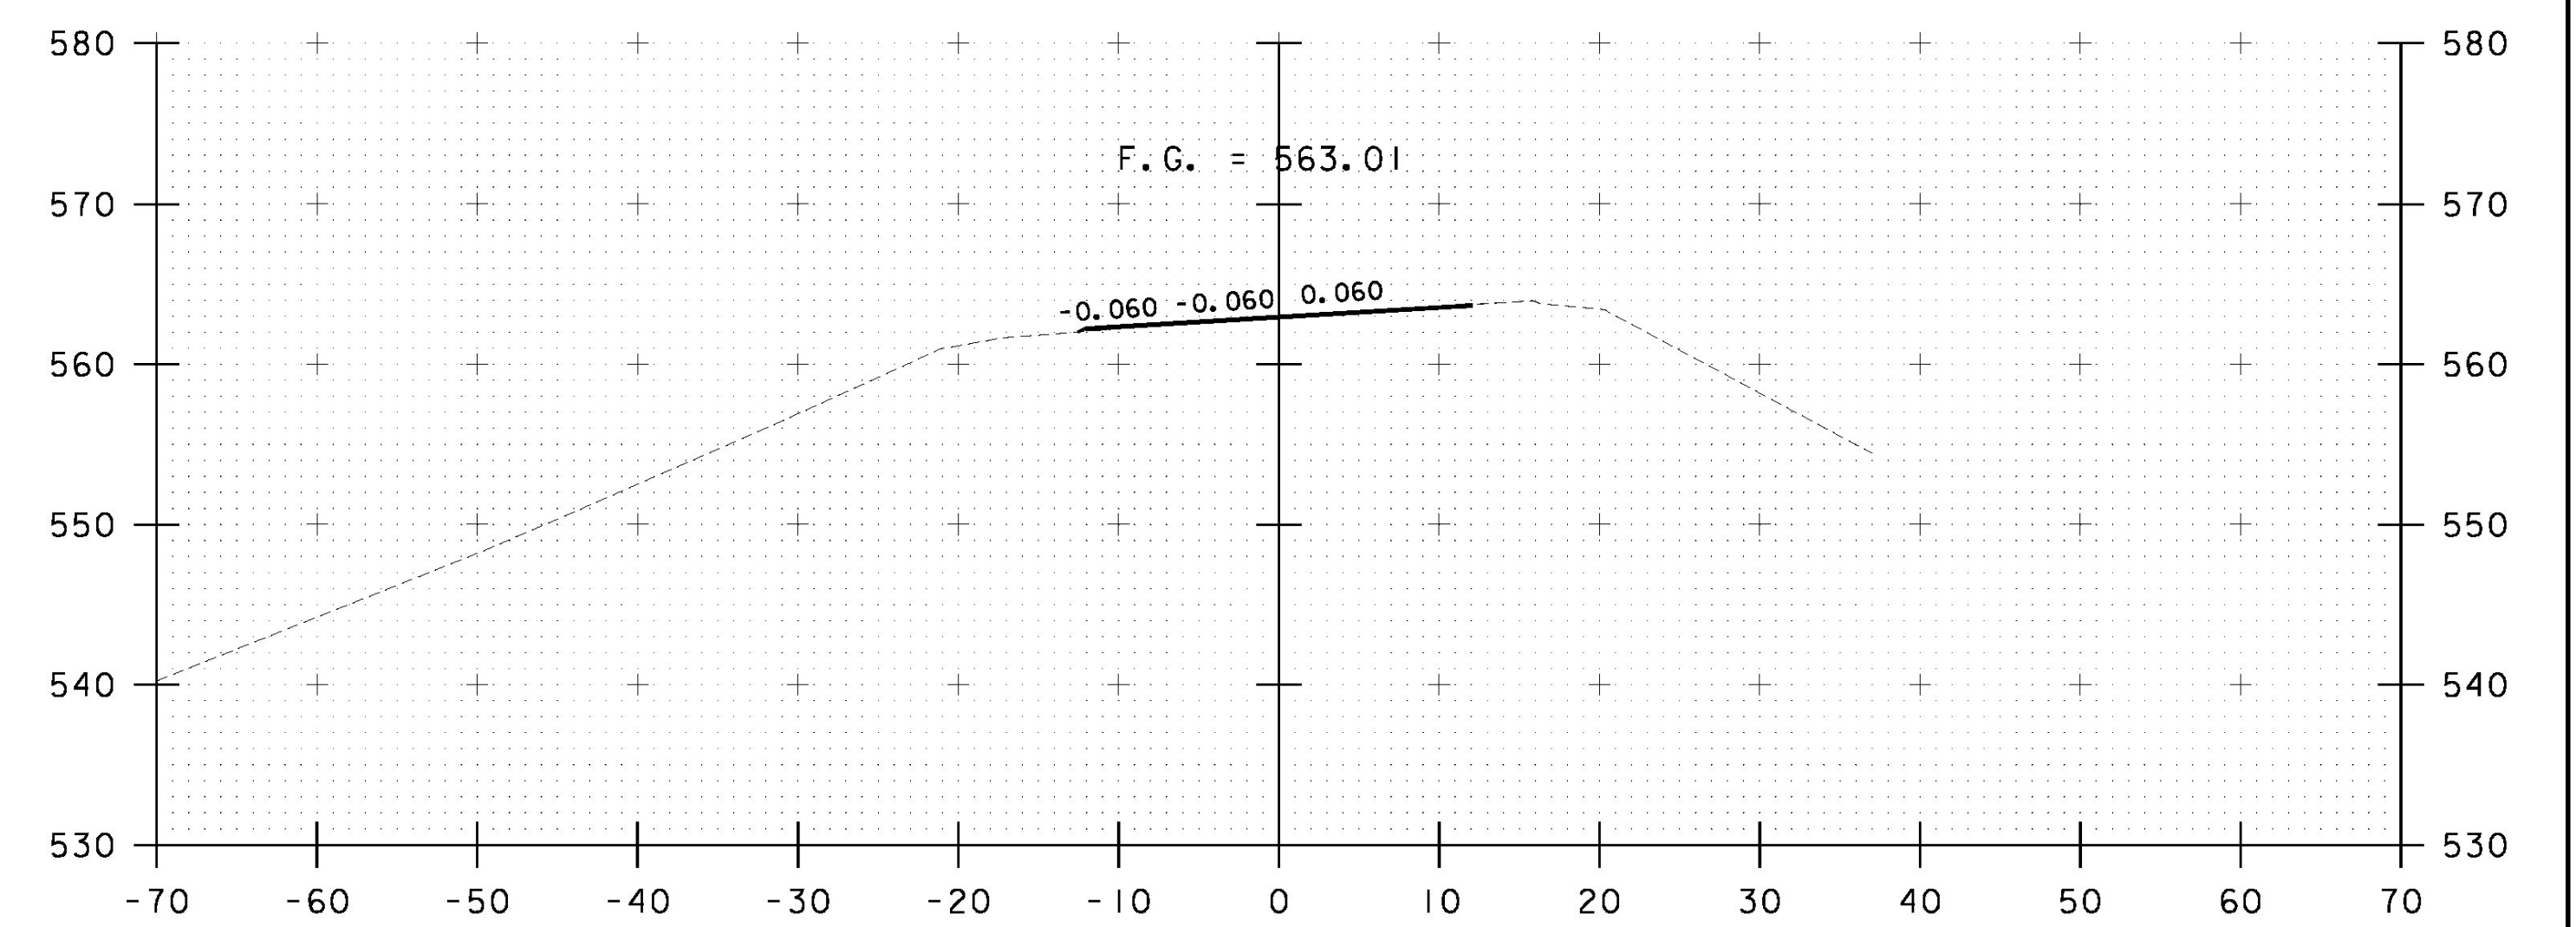


412+49

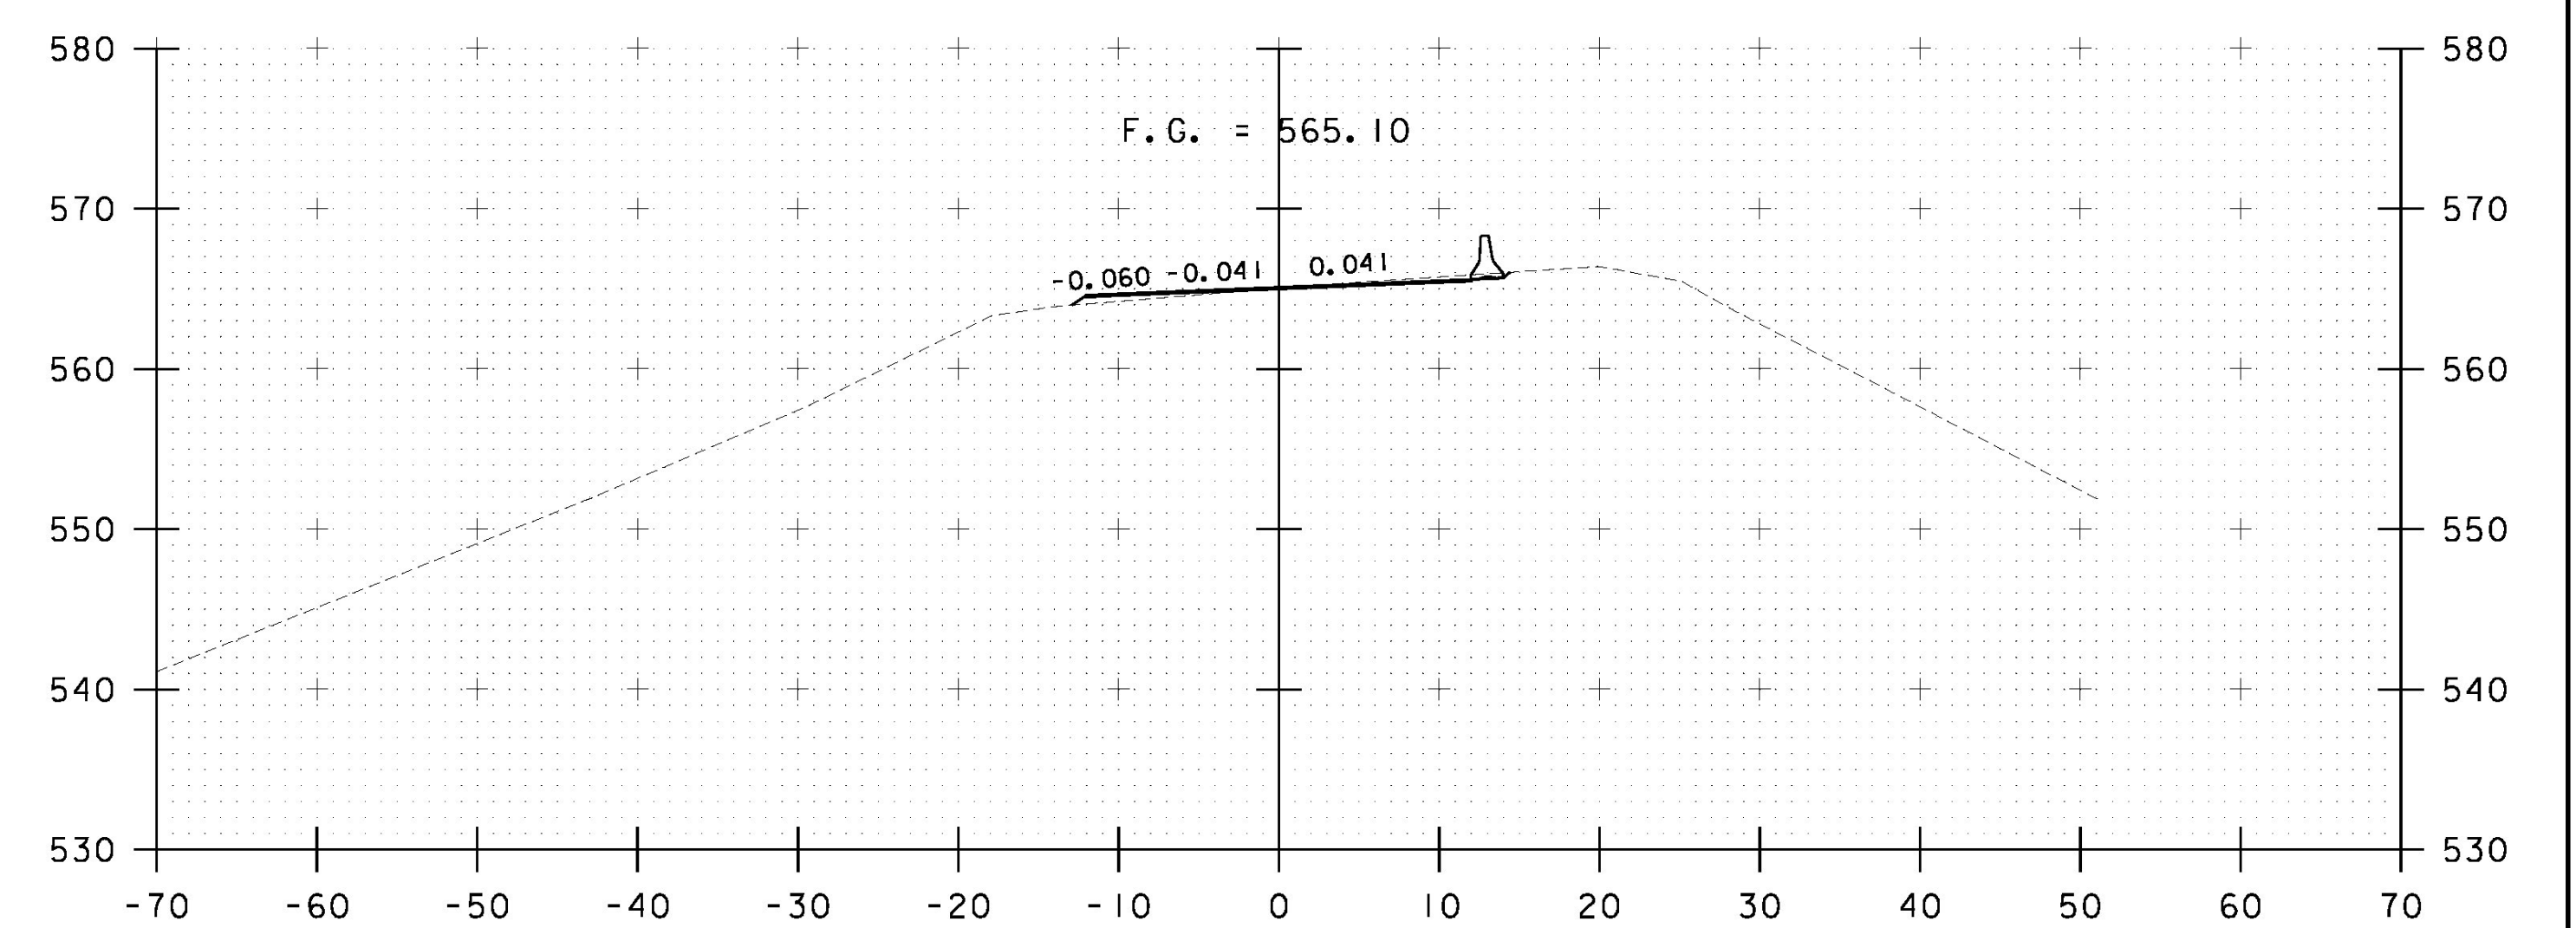

412+00

STA. 411+00 TO STA. 412+49

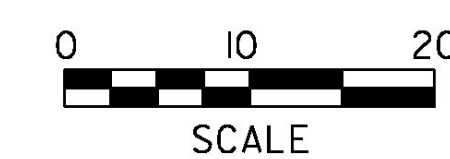

PROJECT NAME: PUTNEY	
PROJECT NUMBER: IM 091-1(31)	
FILE NAME: ...58-62 z93cl48tempdetourxxs.pdf	DATE: 7/8/2009
PROJECT LEADER: G. BOGUE	DRAWN BY: E. ALLING
DESIGNED BY: E. ALLING	CHECKED BY: G. GOYETTE
TEMPORARY DETOUR SECTIONS	SHEET 62 OF 75