
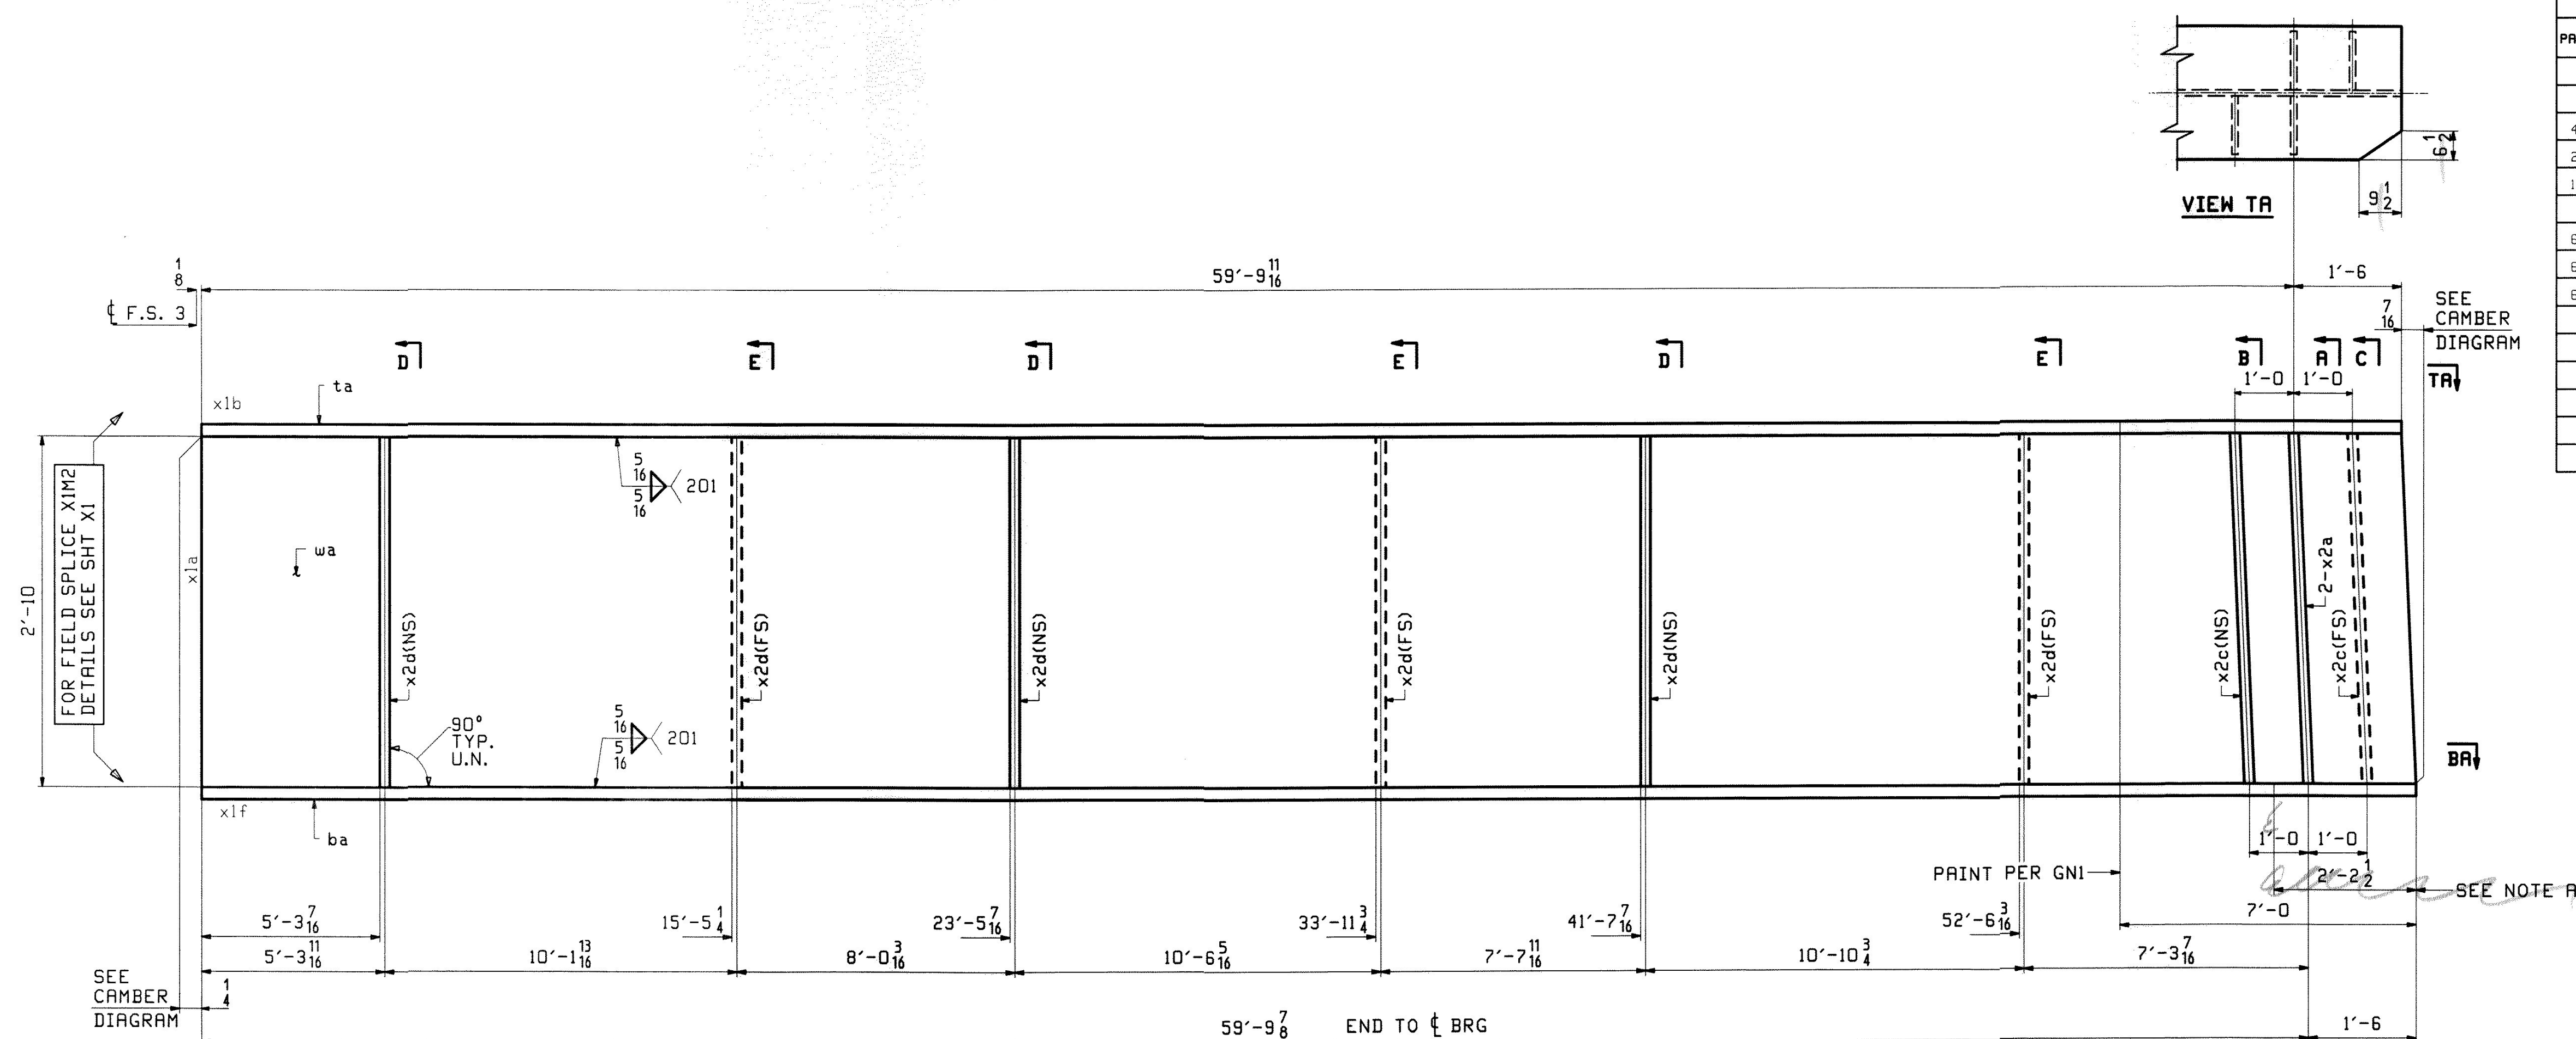



[illegible]

NOTE A:
NO PAINT BOTTOM AND EDGES OF BOTTOM FLANGE.

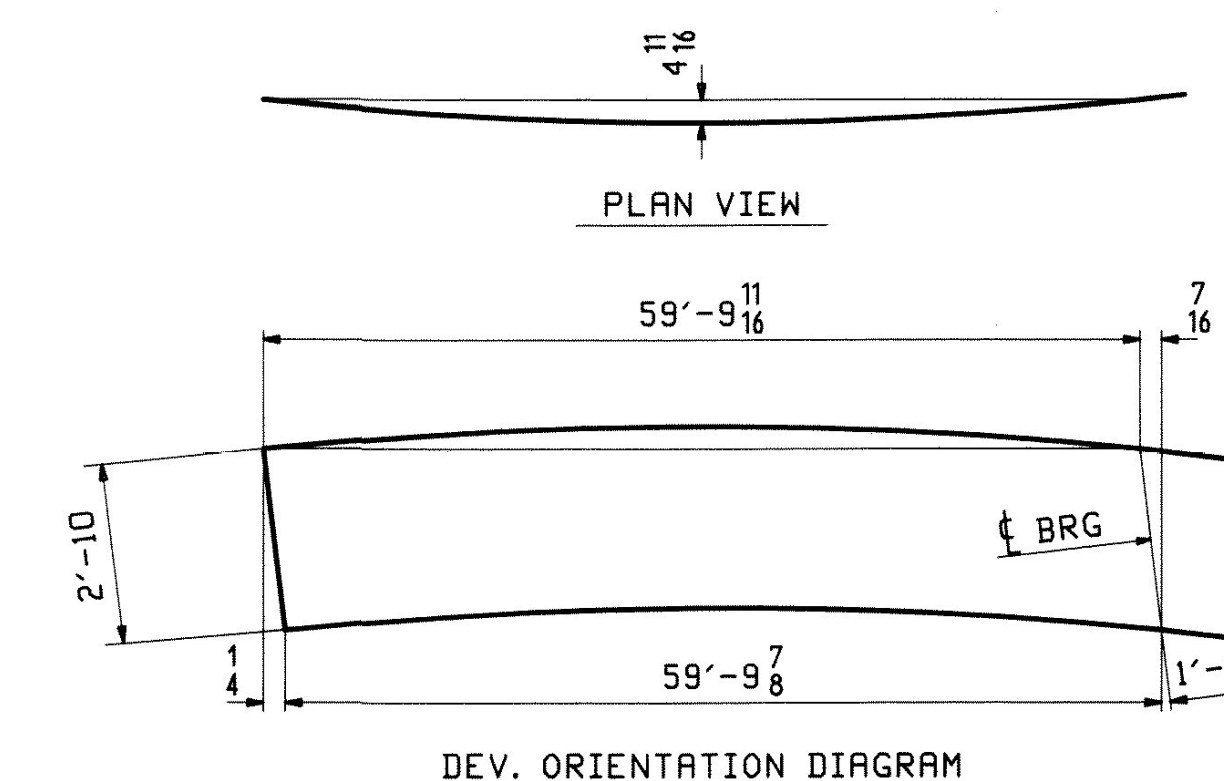

ONE - GIRDER - 17G2D (DEV)

FOR FIELD SPLICE & STANDARD DETAILS SEE X SHEETS
FOR CAMBER DIAGRAM SEE SHEET C2
FOR FLANGE DIAGRAM SEE SHEET F1
FOR GENERAL NOTES SEE SHEET GN1

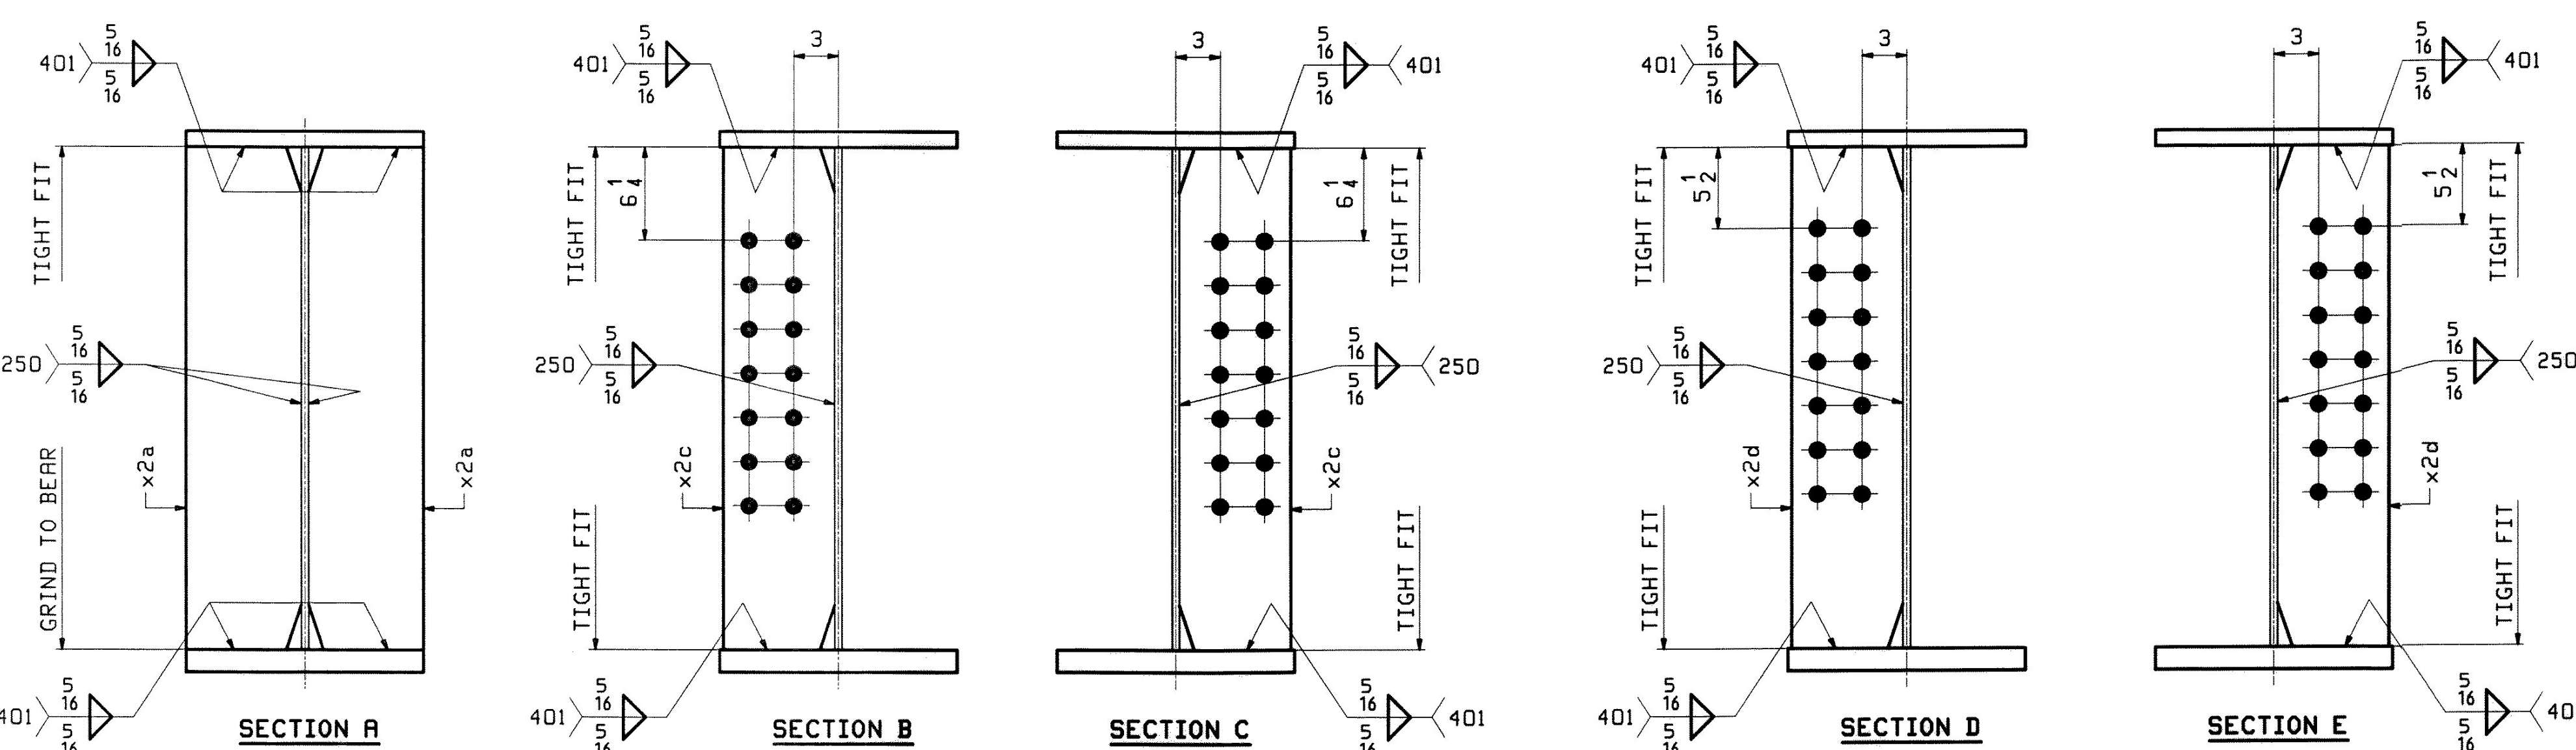

D					JAN 28 2019														
REV.	DATE	REMARKS	DWN	CHK	APVL	SHOP													
MATERIAL:	SURFACE PREP. & PAINT:		HOLES:		SHOP BOLTS:														
M270-50W (UN)	SEE GNI		$\frac{15}{16} \phi$ U.N.		NONE														
DESCRIPTION: GIRDER - I7G2D																			
CASCO BAY STEEL STRUCTURES, INC. 75 SPRING HILL ROAD SACO, MAINE D4072 PHONE (207) 282-7360 FAX. (207) 282-1179																			
STRUCTURE: U.S. 5 over I-91 Bridge No. 19A Putney County of Windham															DRAWN:		DATE:		
															WJF		OI/12		
															CHKD:		DATE:		
															DO		OI/14		
LOCATION: Putney															JOB NO.		DWG NO.		
PROJ NO. IM O9I-(31)																	17		
CUSTOMER: VT RAT															438		REV. /		