



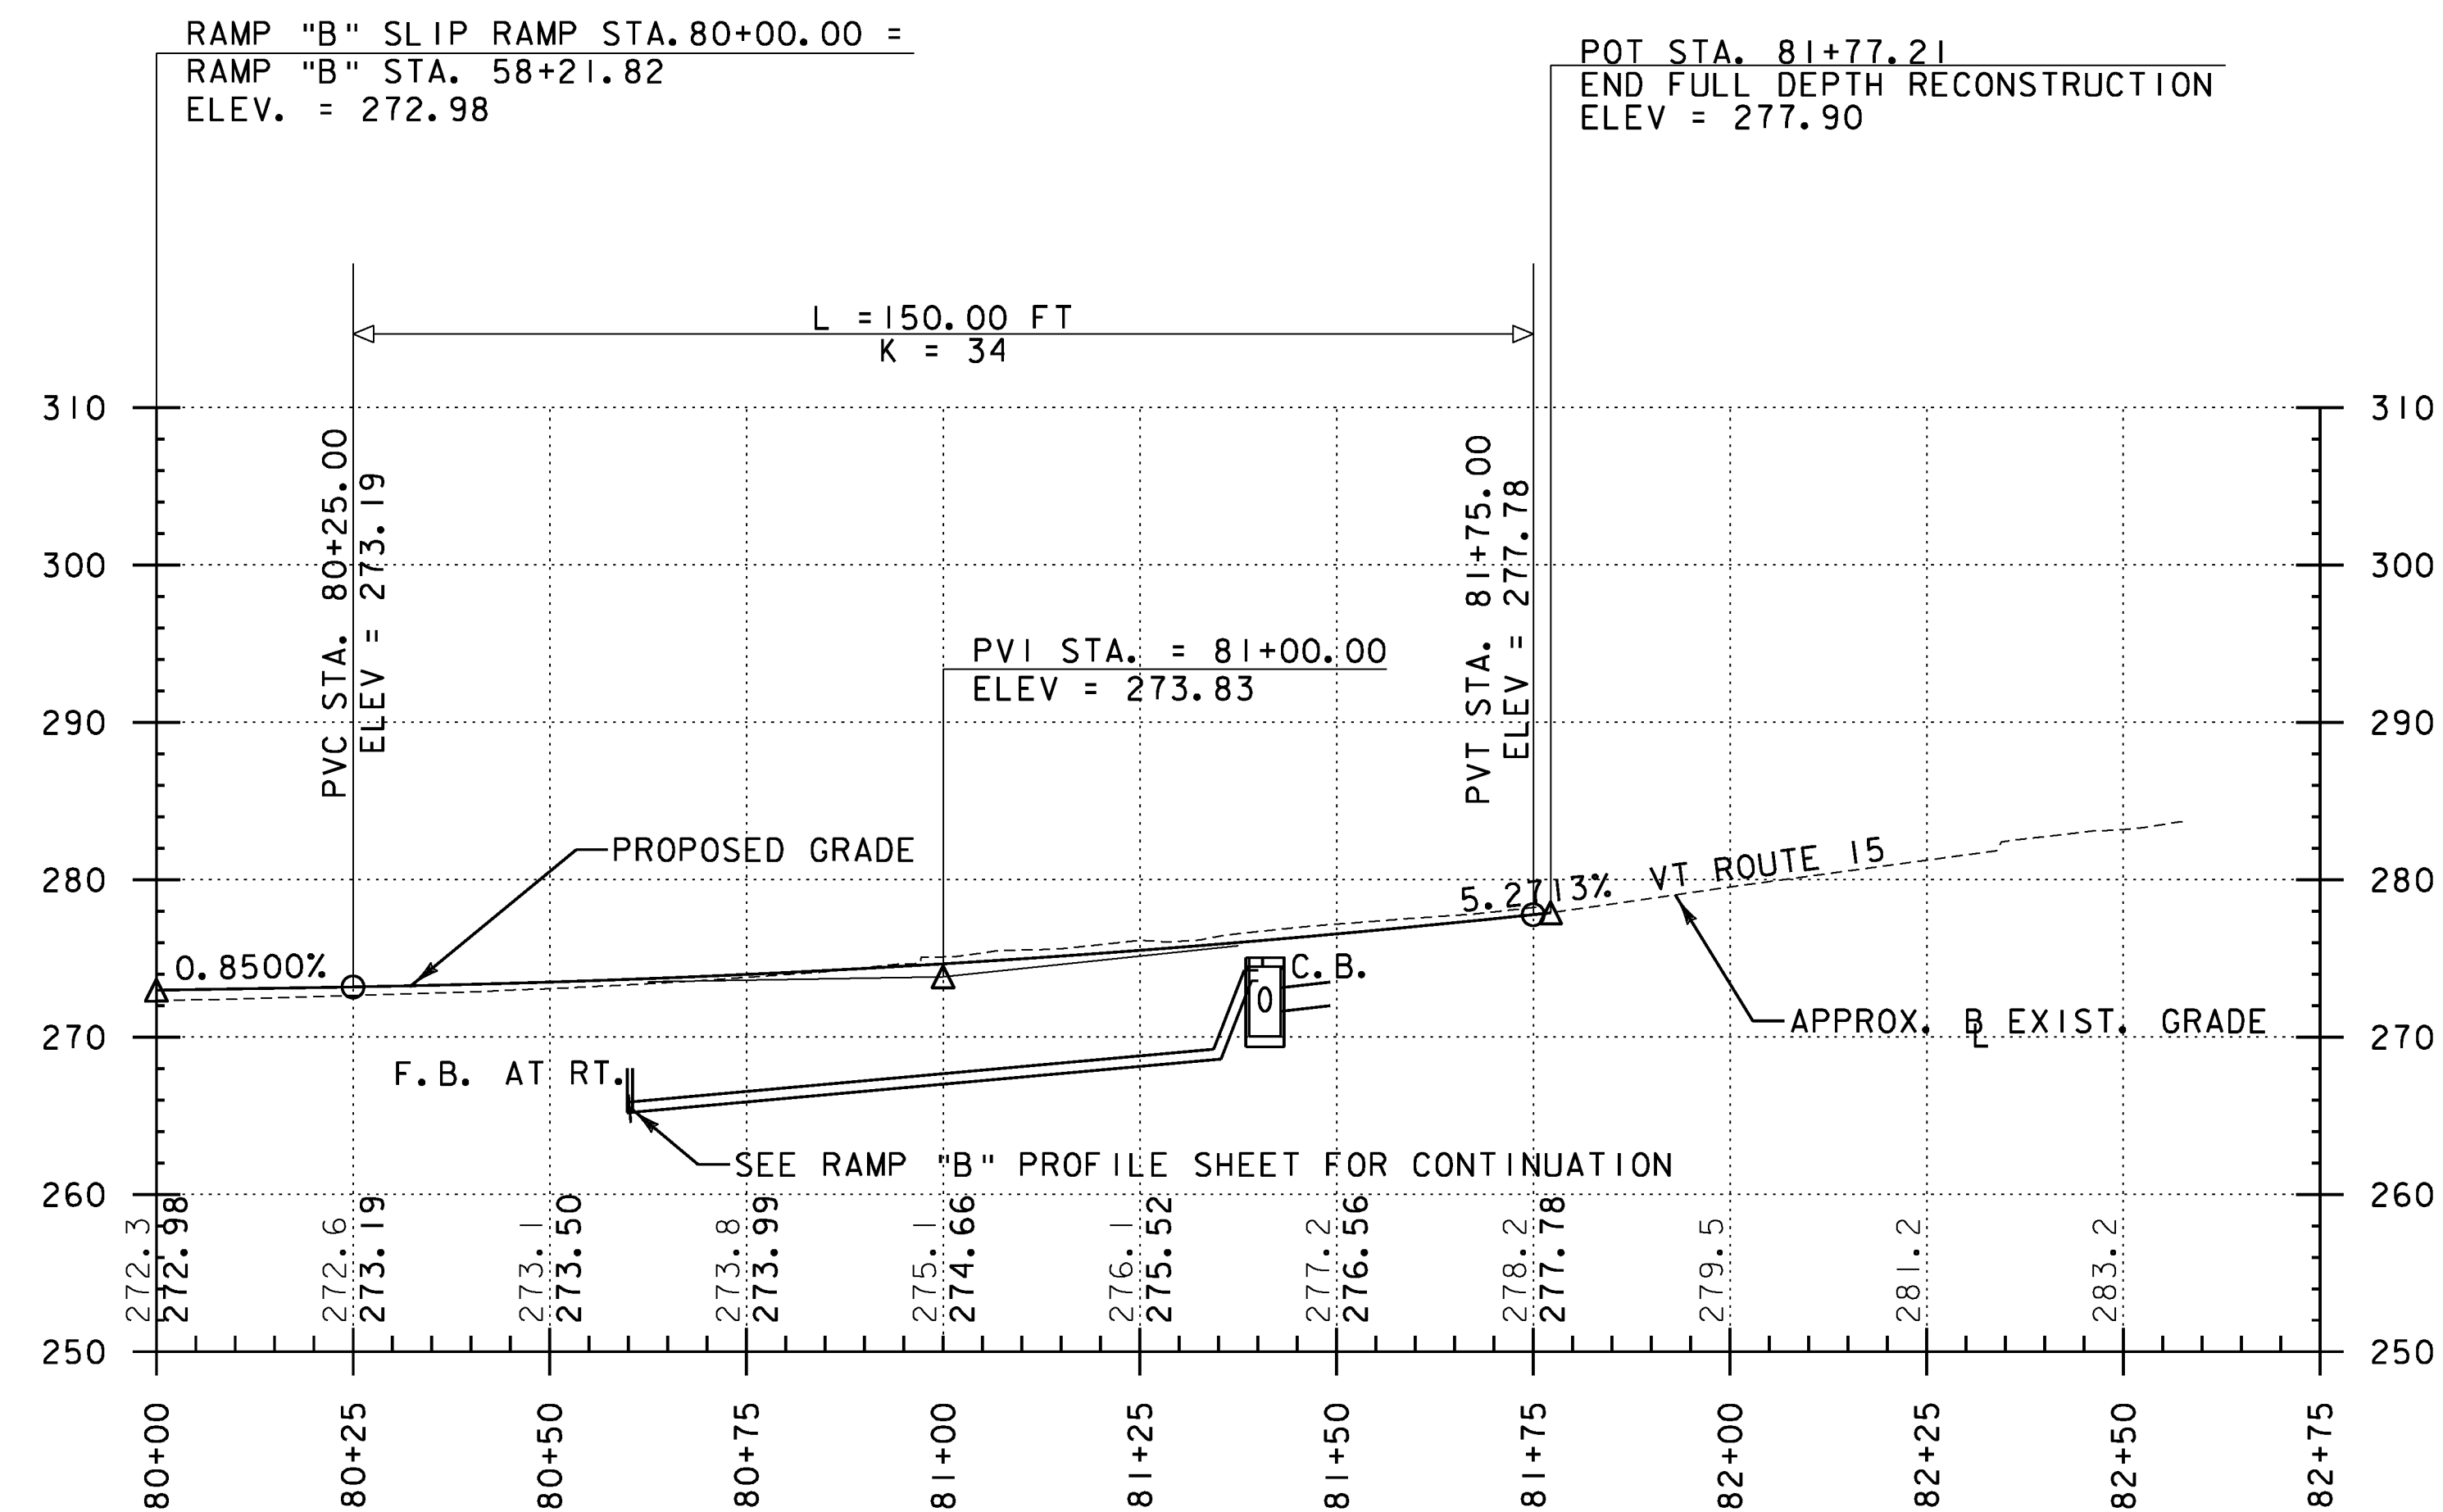

LEGEND	
=====	UNDERDRAIN ON RIGHT
=====	UNDERDRAIN ON LEFT
F.B.	FLUSHING BASIN
C.B.	CATCH BASIN
LT.	LEFT
RT.	RIGHT

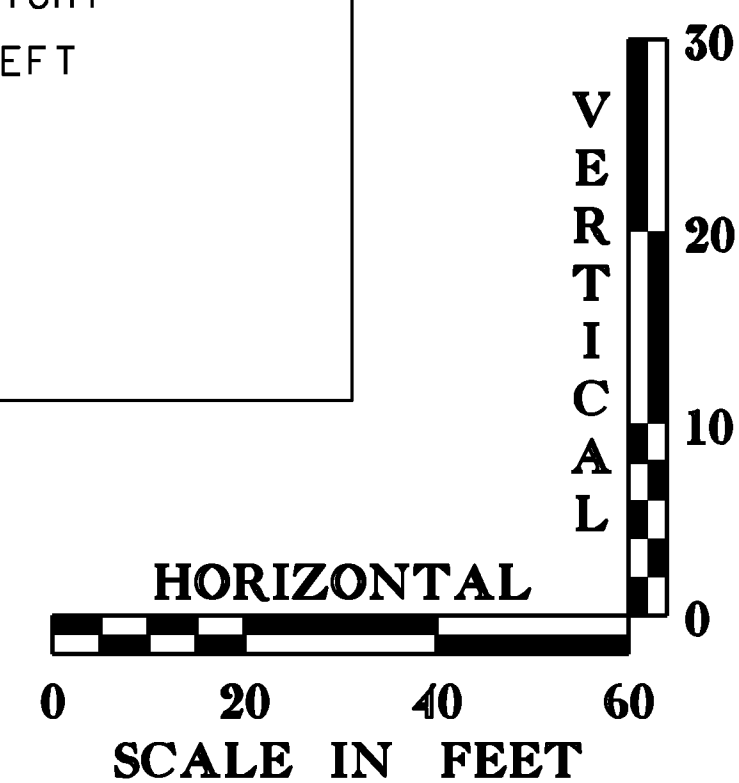

THE GRADES SHOWN TO THE NEAREST TENTH ARE THE ORIGINAL GROUND ELEVATIONS ALONG THE PROPOSED ALIGNMENT. THE GRADES SHOWN TO THE NEAREST HUNDREDTH ARE THE PROPOSED PROFILE GRADES FOR THE NEW ALIGNMENT.

PROJECT NAME: WINOOSKI	
PROJECT NUMBER: NH 089-3(65)	
FILE NAME: z94a198xsl.dgn	PLOT DATE: 2/22/2010
PROJECT LEADER: KEN UPMAL	DRAWN BY: A. ACHARYA
DESIGNED BY: A. ACHARYA	CHECKED BY: E. ATKINS
SLIP RAMP PROFILE SHEET	SHEET 22 OF 67