
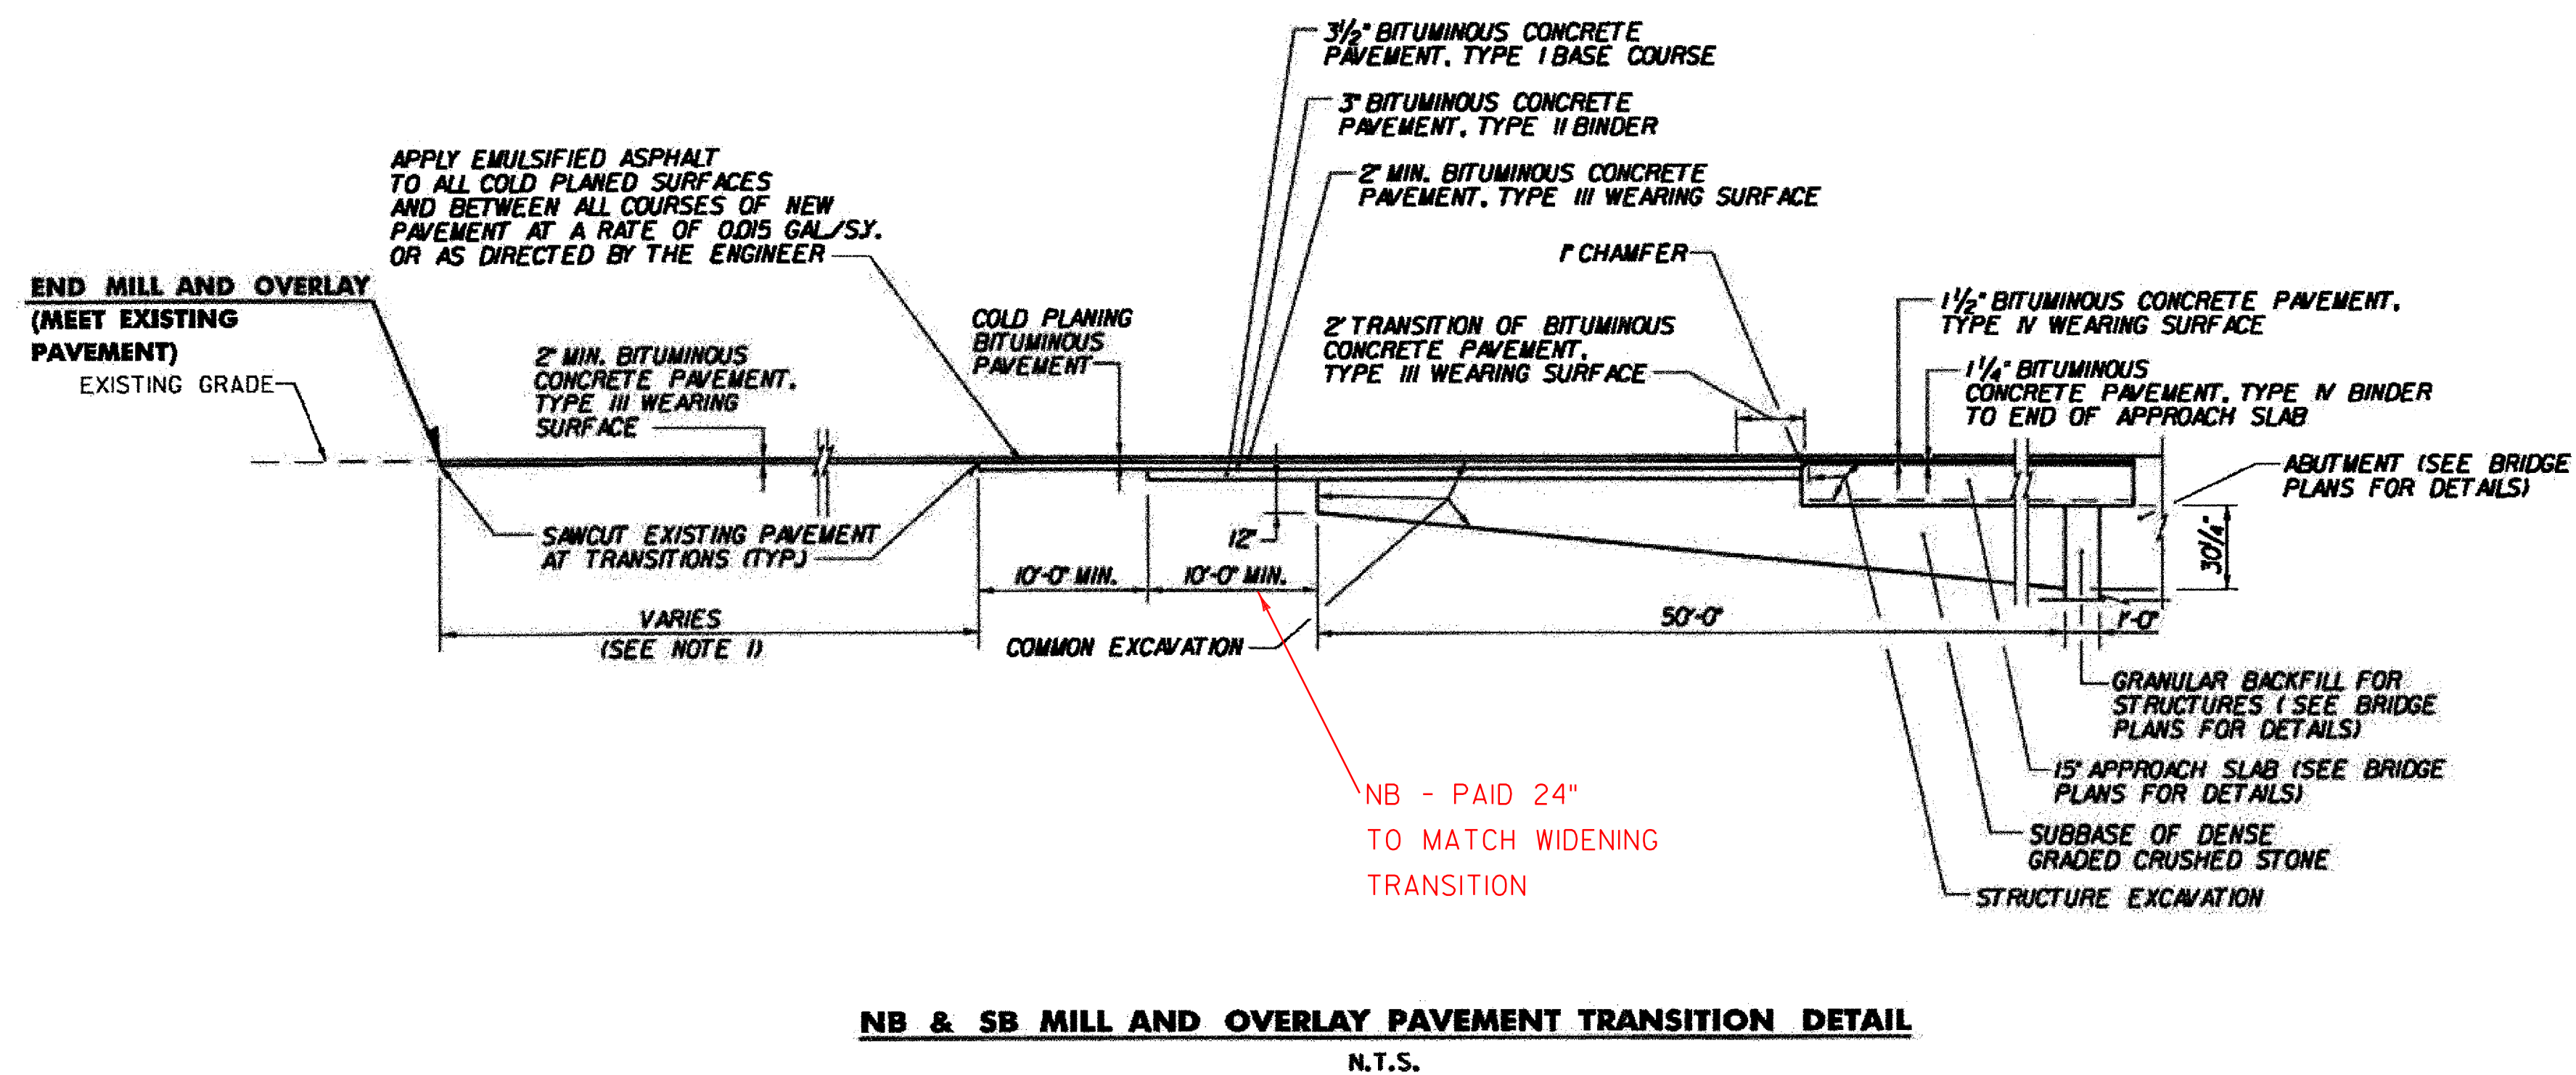


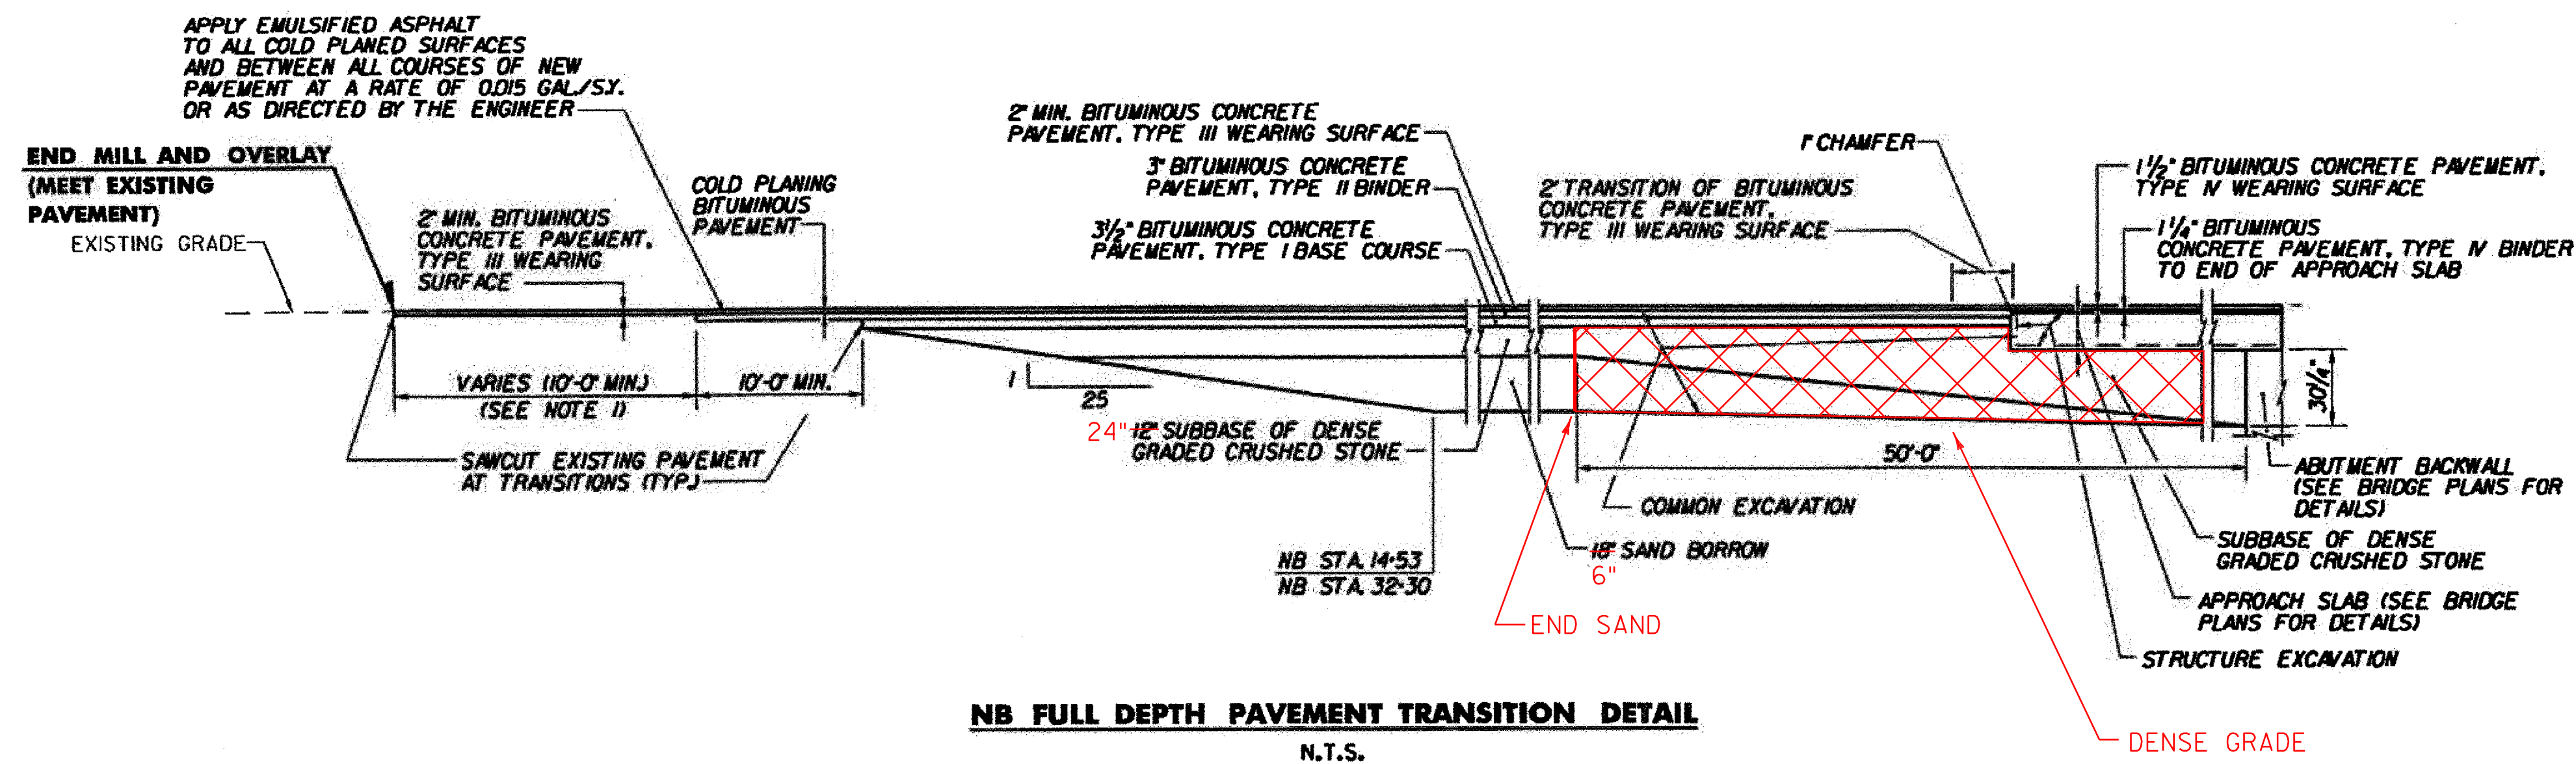

NOTES:

1. SEE ROADWAY PLAN (1 OF 2), SHEET 6, AND ROADWAY PLAN (2 OF 2), SHEET 1 FOR LIMITS OF MILL AND OVERLAY.

**STATE OF VERMONT
AGENCY OF TRANSPORTATION**

Town Of	GUILFORD	Bridge No.	3N&S
Highway No.	I-91	Log Sta.	
		Surv. Sta.	
I-91 OVER BROAD BROOK & BROAD BROOK ROAD			
ROADWAY TYPICAL SECTION DETAILS			
Designed By	T.C. GAWENUS	Drawn By	R.A. BOTZENHART
Checked By	Date	Bridge Design Supervisor	
P.W. SZUSTAK	01/03	J.P. HALSTEAD	Date 01/03
PROJECT	GUILFORD	PROJECT NO.	IM 091-K(33)
TVGA CAD Drawing No.	TS-2.dgn	Date	04/25/08
Bridge Sheet No.		Sheet	5A of 14