



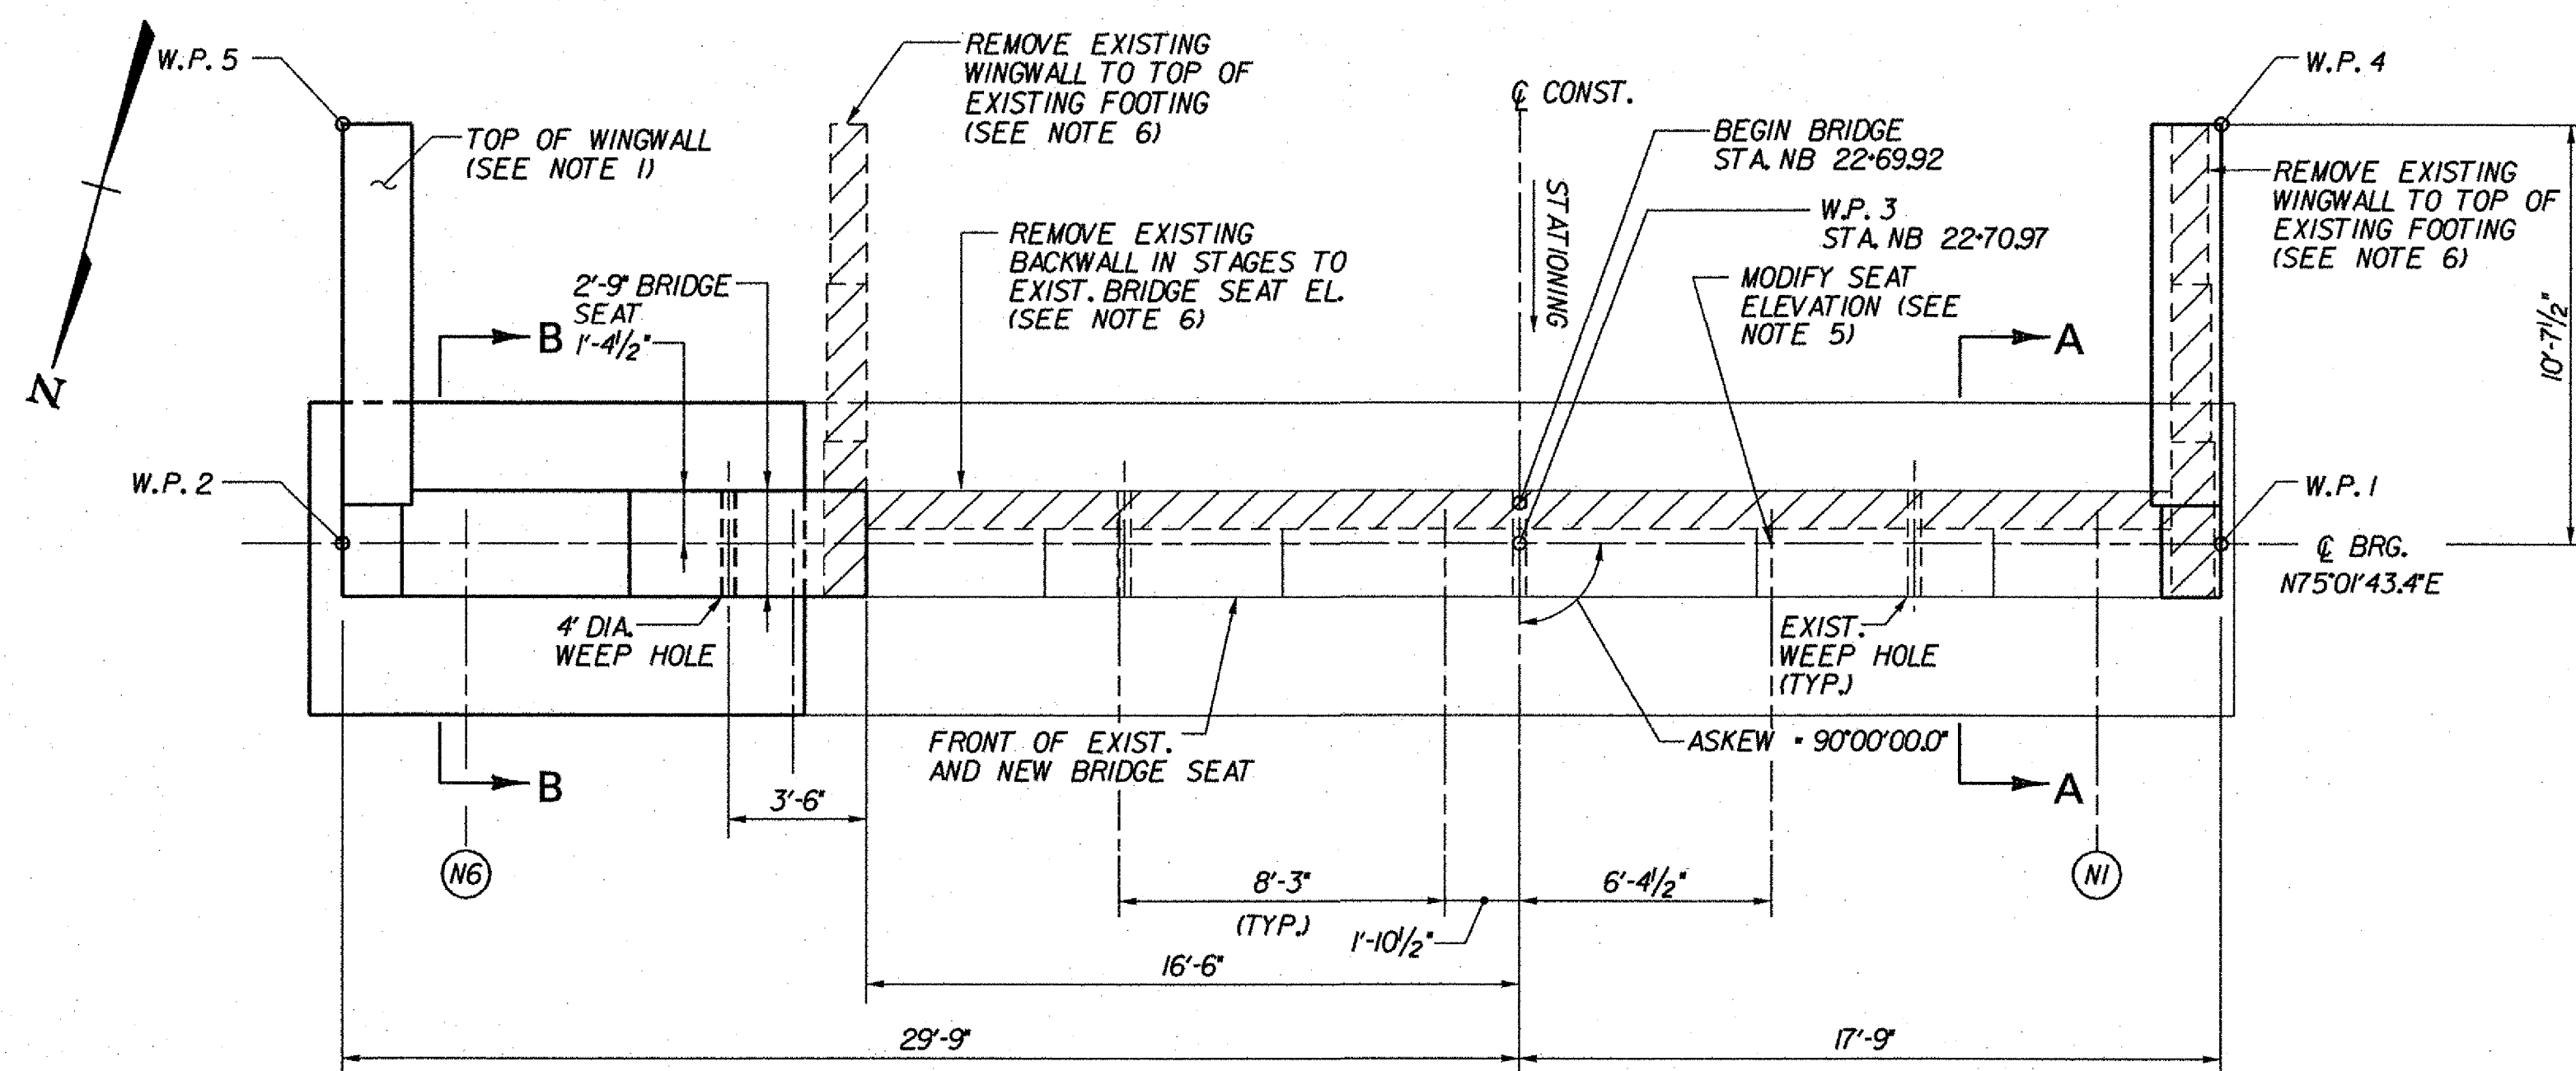

ABUTMENT 1 PLAN (FIXED) (3N)


SCALE: 1/4" = 1'-0"

• SEE SHEET 70AR

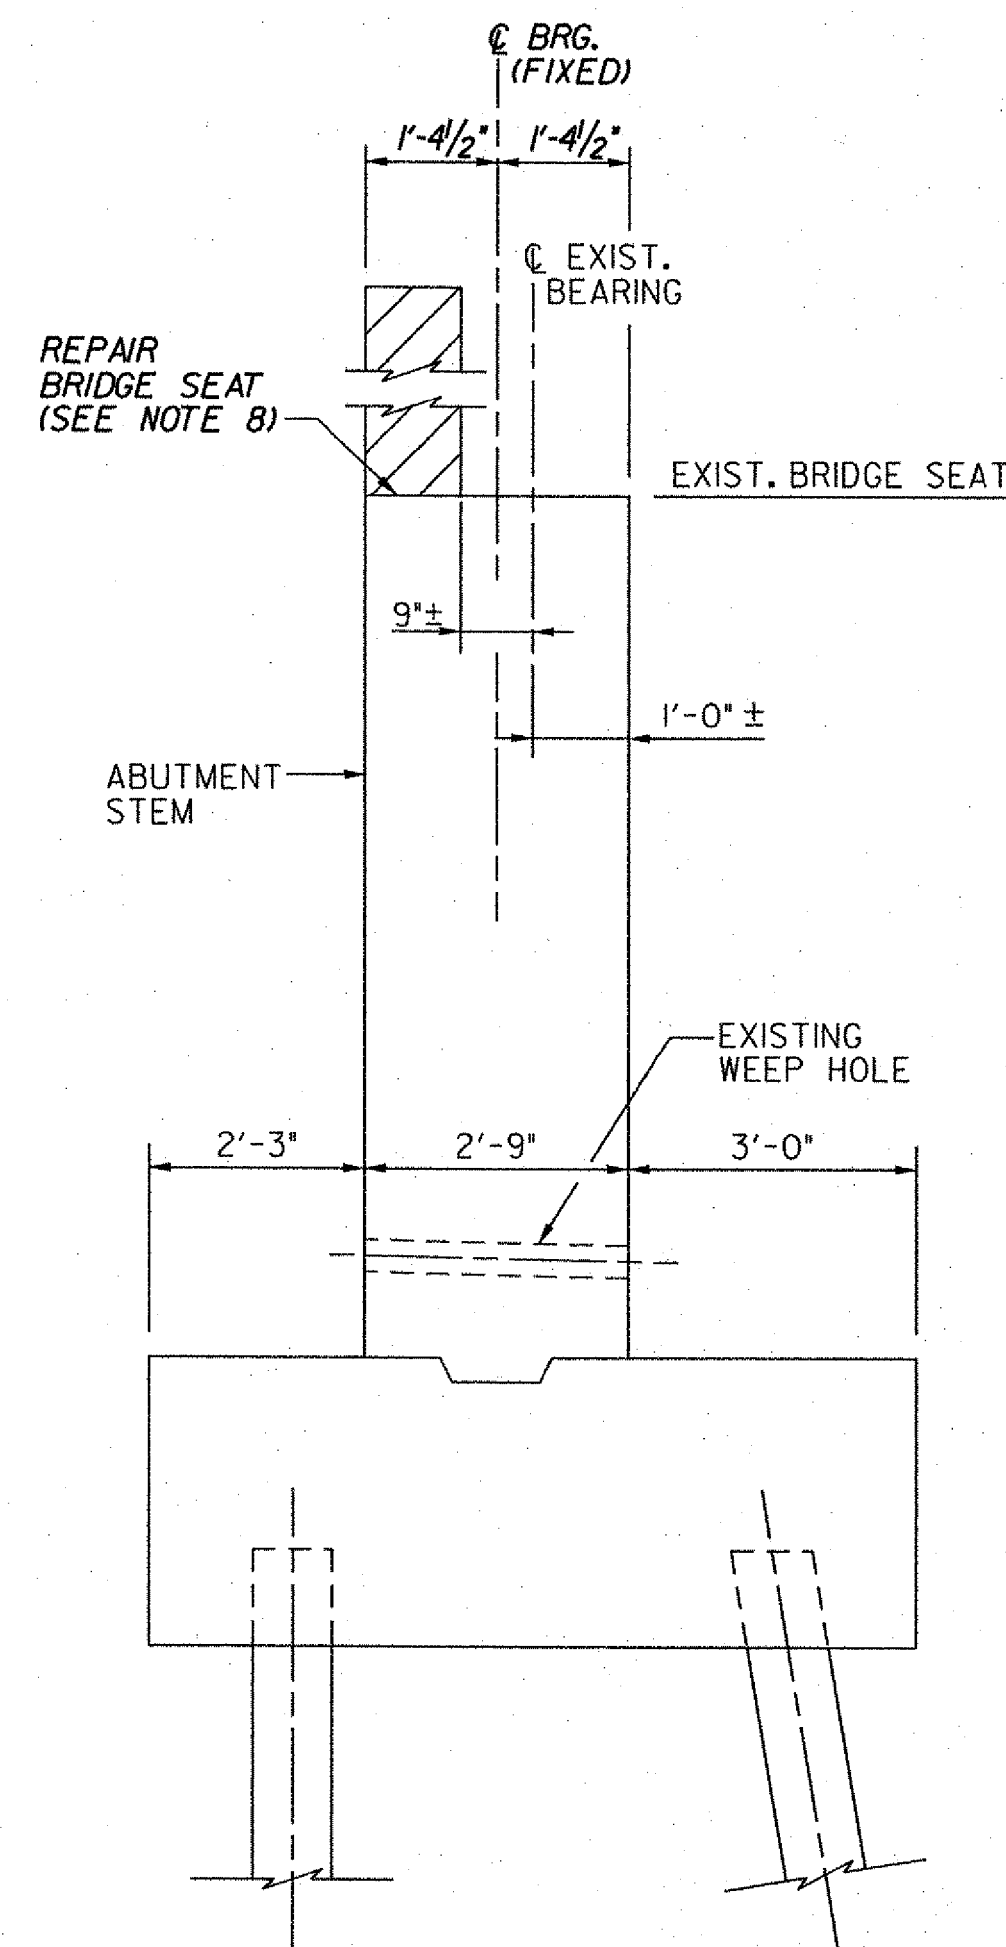

SECTION A-A

SCALE: 1/2" = 1'-0"

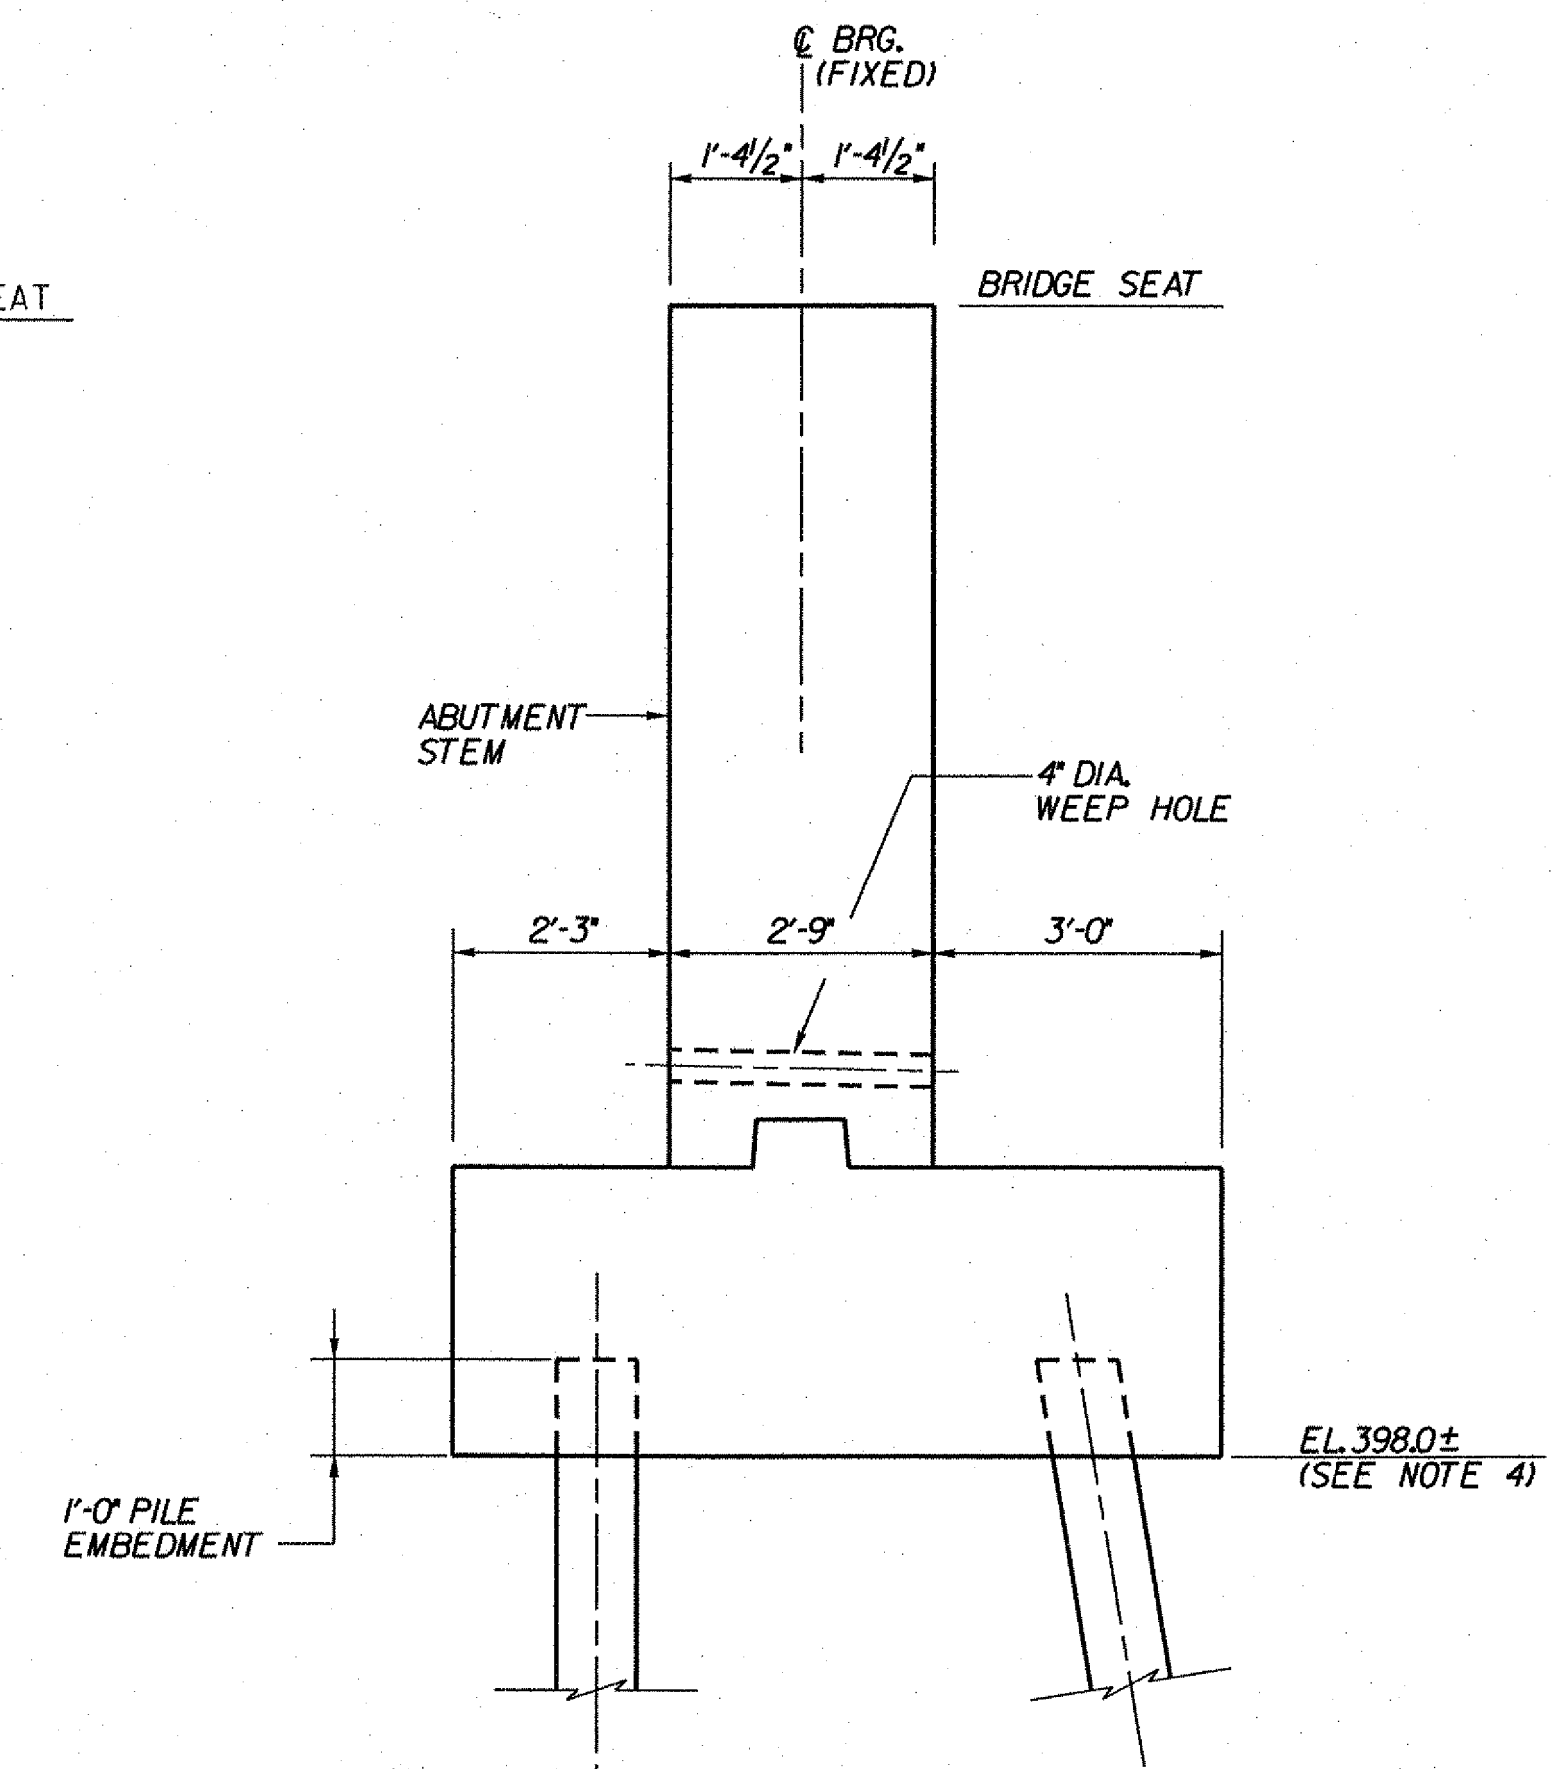

SECTION B-B

SCALE: 1/2" = 1'-0"

NOTES:

- FOR WINGWALL AND CHEEKWALL DIMENSIONS, DETAILS AND ELEVATIONS, SEE WINGWALL MASONRY & REINFORCEMENT BRIDGE SHEET BR138.
- FOR ABUTMENT REINFORCEMENT DETAILS, SEE ABUTMENT 1 REINFORCEMENT (3N) BRIDGE SHEET BR134.
- REPAIR ALL EXISTING SPALLED AND DELAMINATED AREAS ON ABUTMENT. SEE EXISTING SUBSTRUCTURE CONDITION (3N), BRIDGE SHEET BR160, FOR APPROXIMATE CONDITION OF EXISTING SUBSTRUCTURE. FOR CONCRETE REPAIR DETAILS, SEE SUBSTRUCTURE REPAIR DETAILS (3N&S), BRIDGE SHEET BR151.
- THE NEW BOTTOM OF FOOTING ELEVATION SHOWN IS APPROXIMATE AND SHALL BE CONSTRUCTED AT THE SAME ELEVATION AS THE EXISTING FOOTING. THE CONTRACTOR SHALL VERIFY THE EXISTING FOOTING LOCATION PRIOR TO ORDERING REINFORCING STEEL.
- DUE TO THE PROXIMITY OF THE GIRDER TO THE STEP IN THE EXISTING BRIDGE SEAT, REMOVE 4"± OF CONCRETE TO A MINIMUM OF 1" BELOW THE TOP MAT OF REINFORCING STEEL AND REPLACE WITH A LEVEL BED OF CONCRETE, CLASS AA TO THE HIGHER ELEVATION OF THE ADJACENT BRIDGE SEAT. LIMITS OF CONCRETE REMOVAL AND REPLACEMENT SHALL BE 18" EITHER SIDE OF C OF GIRDER. THIS WORK SHALL BE PAID FOR AS ITEM 580.14, "REPAIR OF CONCRETE SUBSTRUCTURE SURFACE, CLASS II".
- BRIDGE SEATS SHALL BE SLOPED 1/2" PER FOOT EXCEPT UNDER BEARING PLATES WHERE THE SURFACE SHALL BE LEVEL. THE RESIDENT ENGINEER SHALL DETERMINE IF THE EXISTING CONCRETE AT PROPOSED BEARING LOCATION REQUIRES REPAIR. ANY WORK REQUIRED TO PROVIDE A SOUND, LEVEL SURFACE SHALL BE PERFORMED UNDER ITEM 580.14, "REPAIR OF CONCRETE SUBSTRUCTURE SURFACE, CLASS II", EXCEPT THAT ONLY CONCRETE, CLASS AA SHALL BE ALLOWED UNDER BEARINGS. ALL WORK AND MATERIALS REQUIRED SHALL BE PAID UNDER ITEM 580.14.
- FOLLOWING REMOVAL OF EXISTING BACKWALL, THE CONTRACTOR SHALL GRIND AND/OR REPAIR THE CONCRETE, AS DIRECTED BY THE ENGINEER, TO PROVIDE A SMOOTH LEVEL SURFACE AT PROPOSED SEAT ELEVATION. ANY REPAIRS REQUIRED SHALL BE PERFORMED IN ACCORDANCE WITH SUBSTRUCTURE REPAIR DETAILS (3N&S), BRIDGE SHEET BR151. ALL COSTS FOR THIS WORK SHALL BE INCIDENTAL TO ITEM 529.20, "PARTIAL REMOVAL OF STRUCTURE (DECK & SUBSTRUCTURE)".


LEGEND:

LIMIT OF CONCRETE REMOVAL

**STATE OF VERMONT
AGENCY OF TRANSPORTATION**

Town Of	GUILFORD	Bridge No.	3N
Highway No.	I-91	Log Sta.	
		Surv. Sta.	
I-91NB OVER BROAD BROOK & BROAD BROOK ROAD			
ABUTMENT 1 MASONRY (3N)			
Designed By	M. J. MOZER	Drawn By	G.K. MORZE
Checked By	P.W. SZUSTAK	Bridge Design Supervisor	J.P. HALSTEAD
	01/03	Date	01/03
PROJECT	GUILFORD	PROJECT NO.	IM 091-(133)
TVGA CAD Drawing No. G NB ABUT1.dgn		Date	05/12/08
Bridge Sheet No.	BR133	Sheet	59 of 114

TVGA TVGA ENGINEERING,
SURVEYING, P.C.

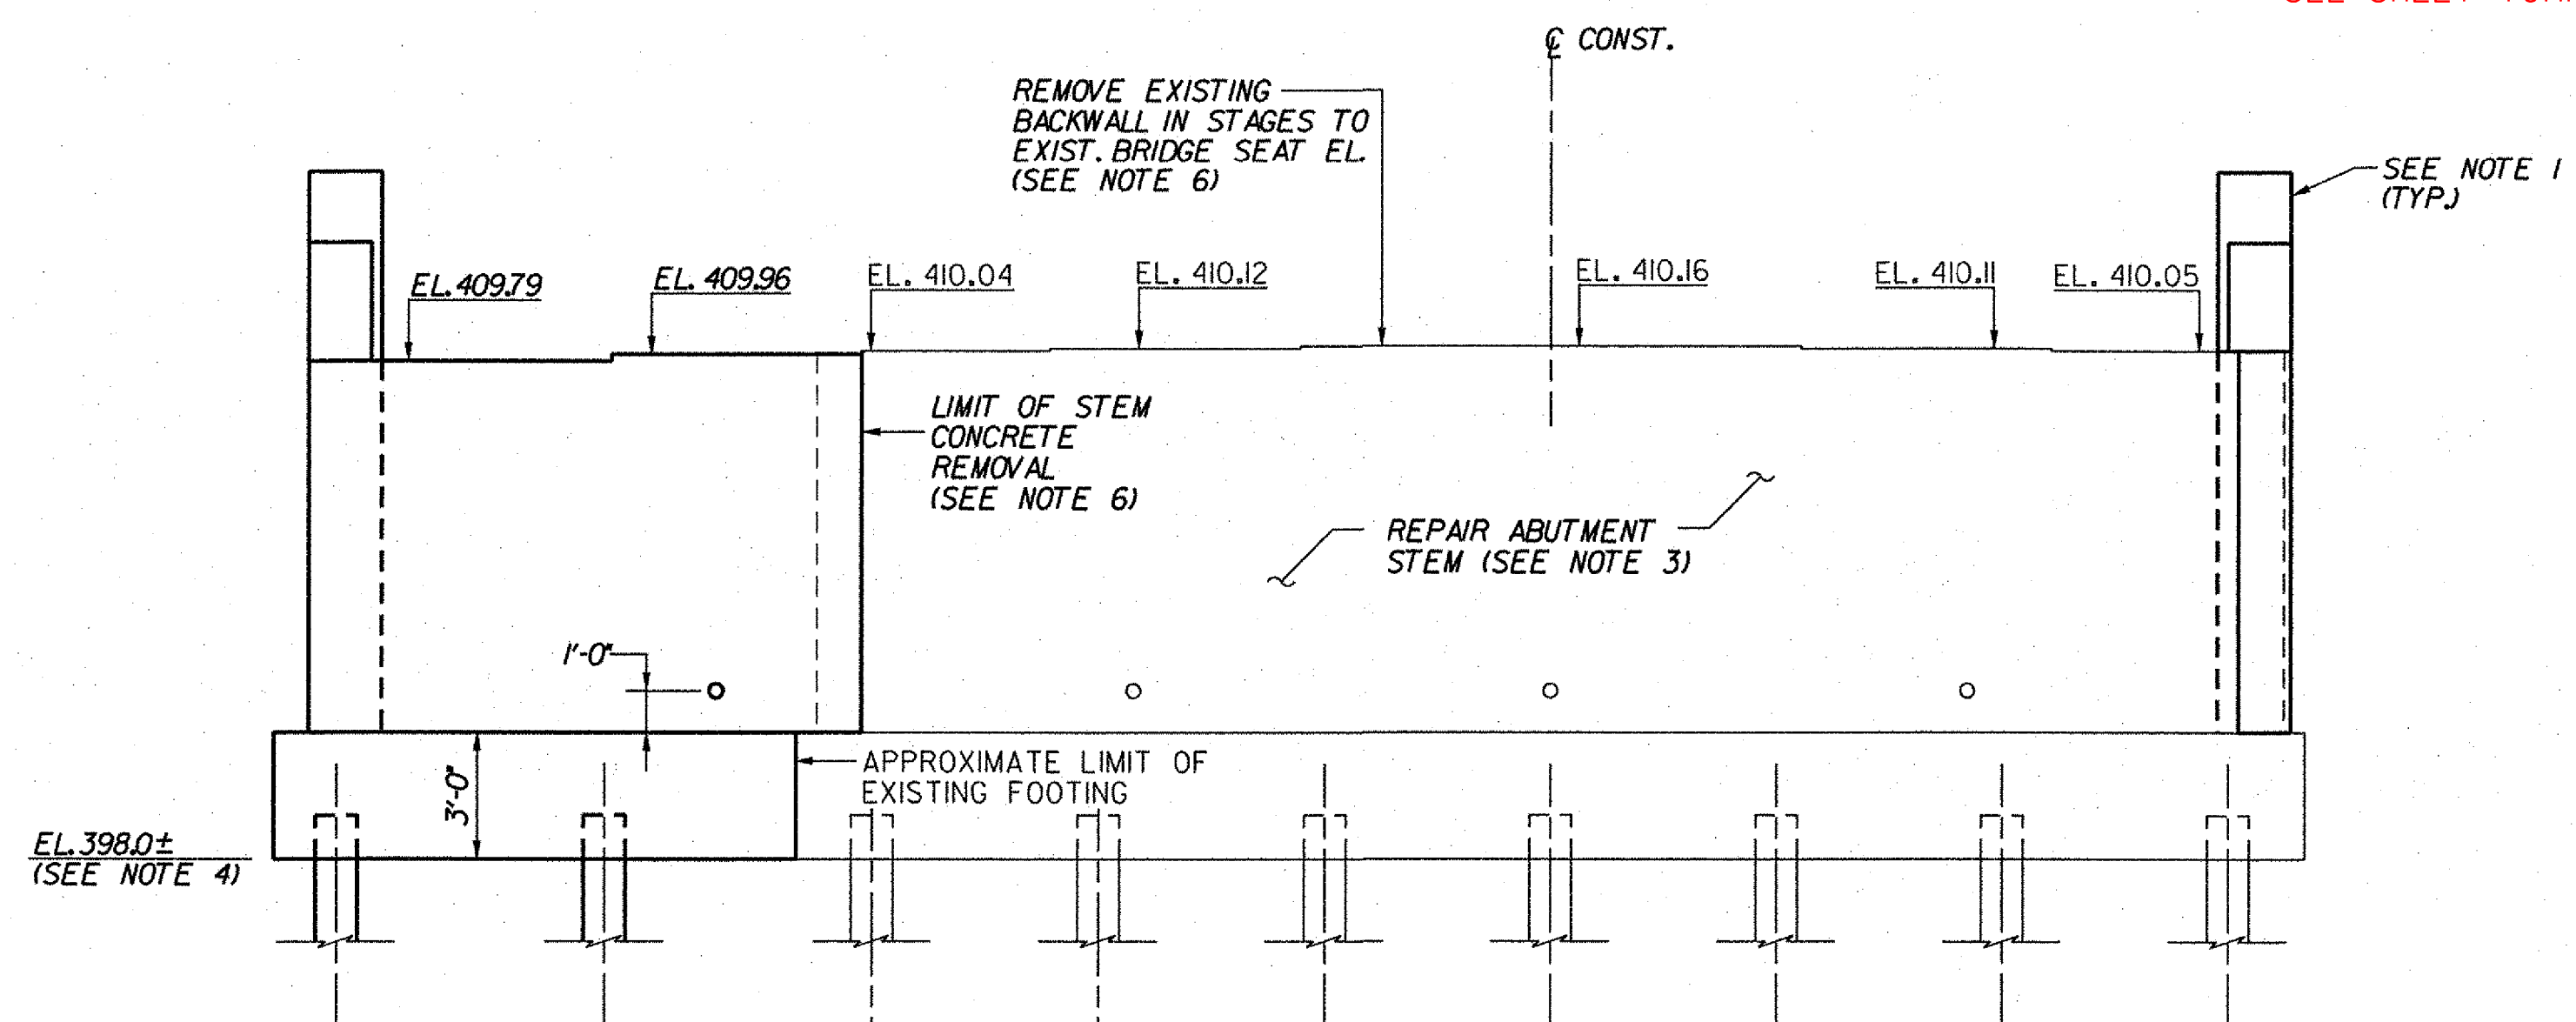


ABUTMENT 1 ELEVATION (3N)

(BACKWALL AND WINGWALL REMOVAL LIMITS NOT SHOWN FOR CLARITY)

SCALE: 1/4" = 1'-0"

KEY:

- EXISTING 12BP53 PILE
- HP 12X53 PILE
- INDICATES BATTERED PILE 1:6

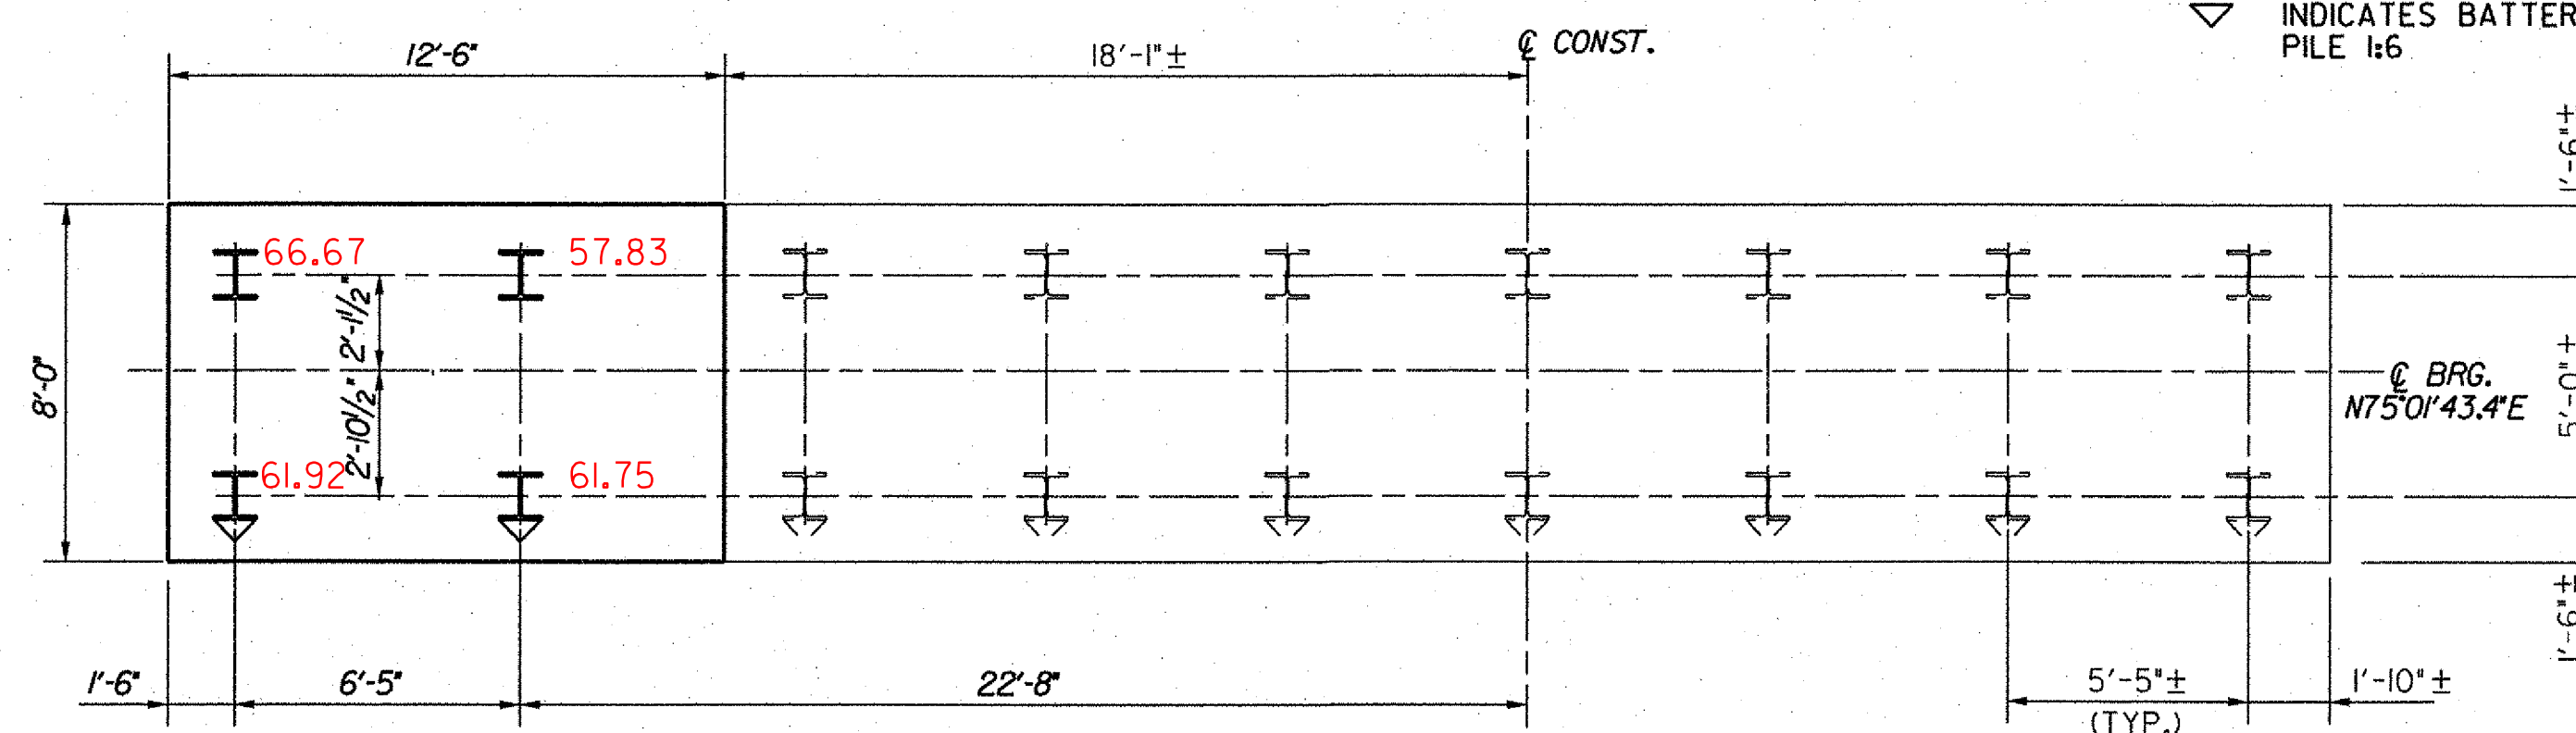

FOOTING PLAN (3N)

SCALE: 1/4" = 1'-0"