




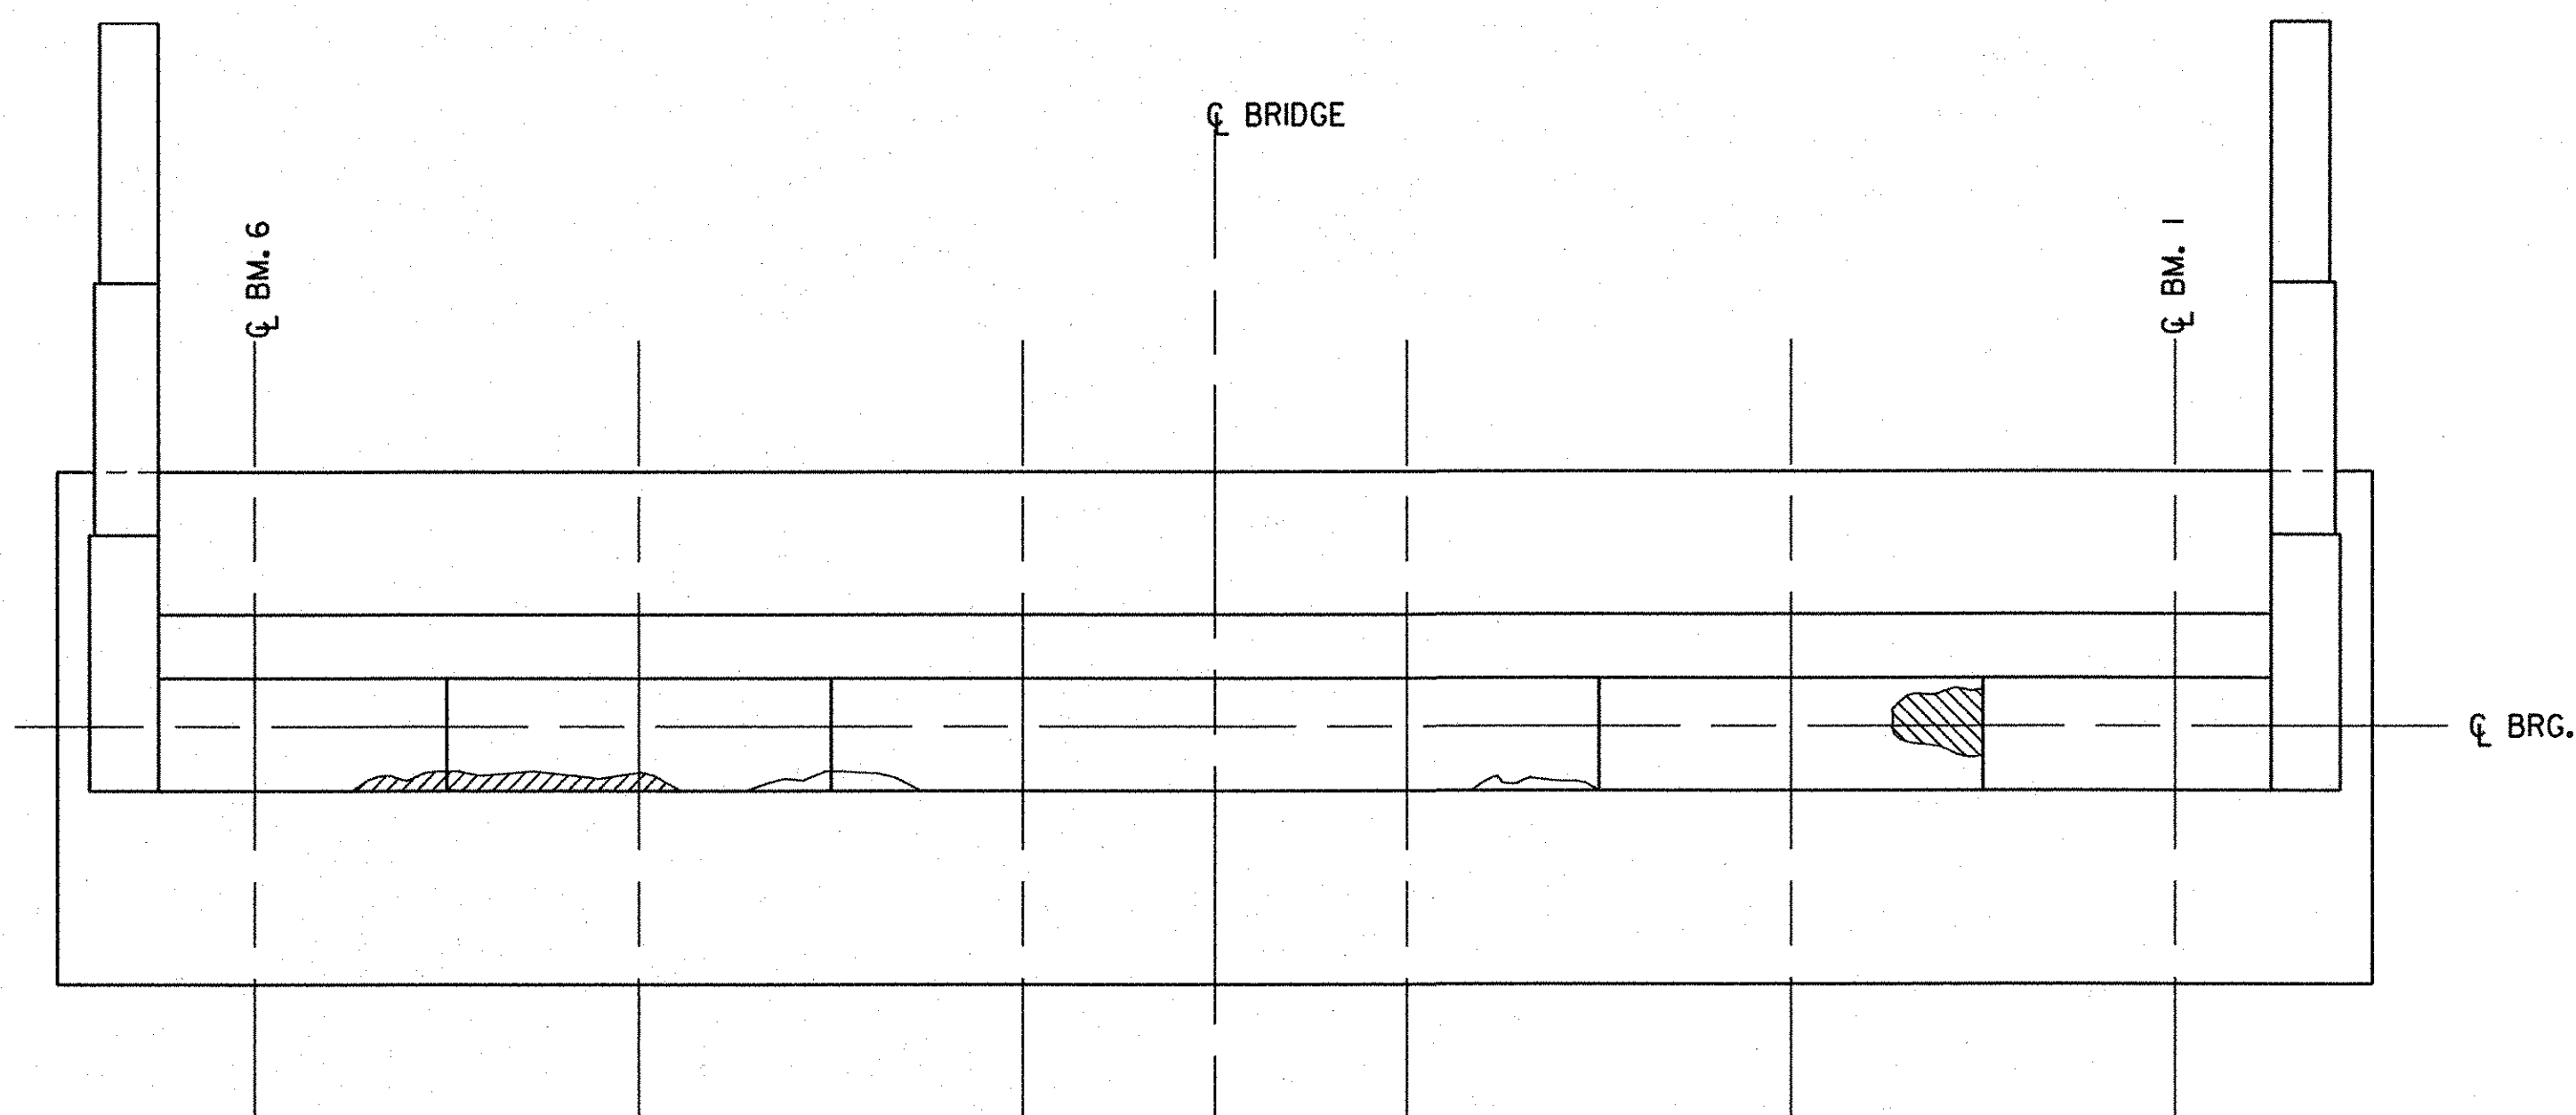


ABUTMENT 1 PLAN (3N)
SCALE: 3/8"=1'-0"

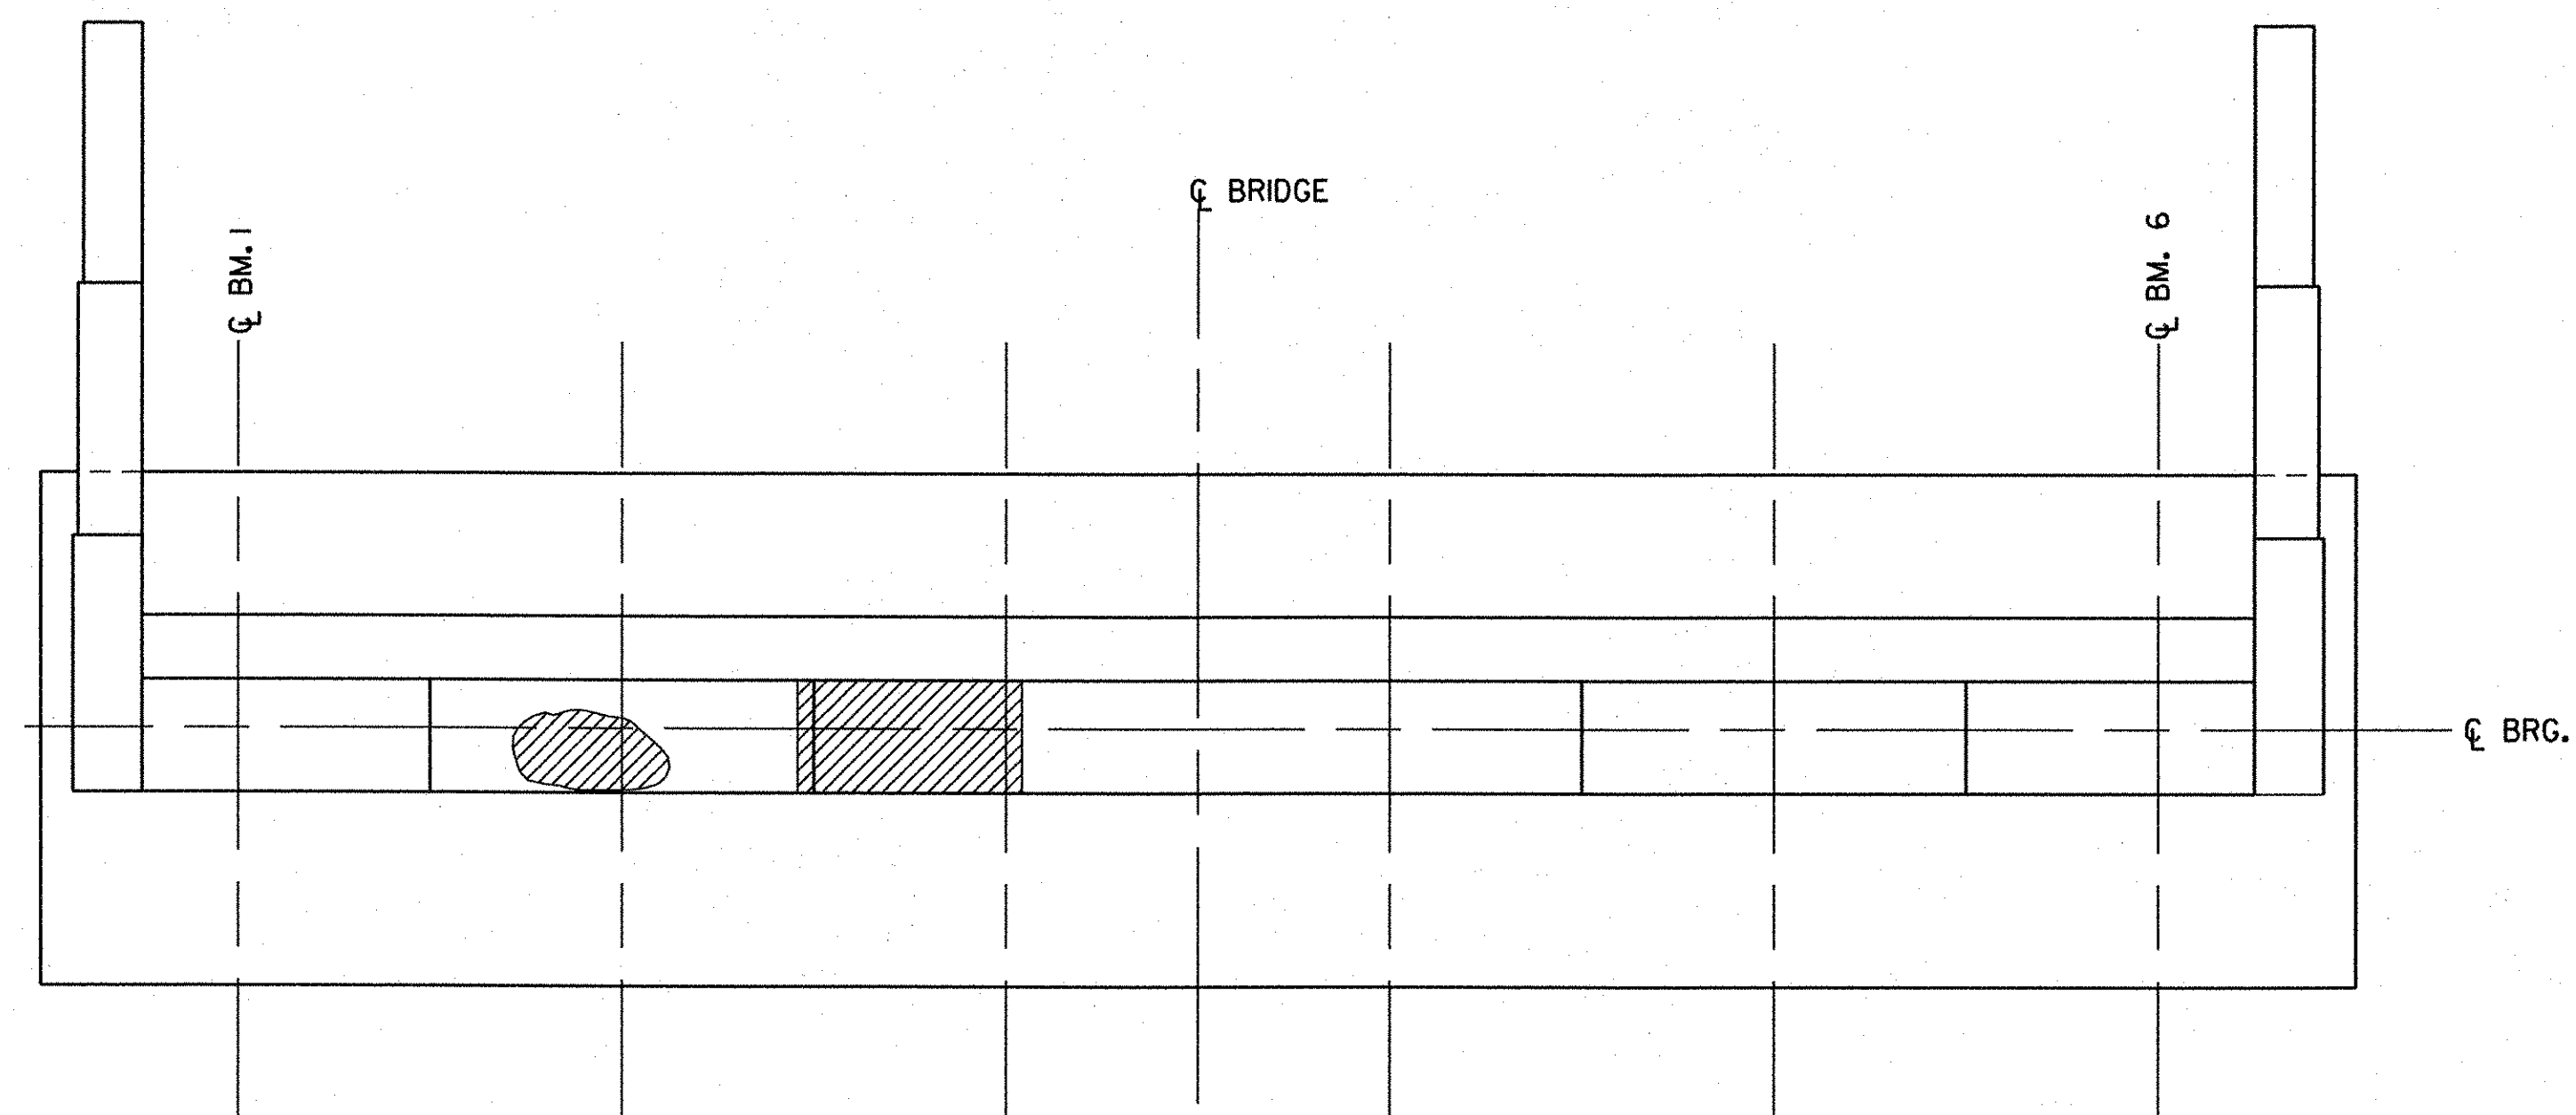

ABUTMENT 2 PLAN (3N)
SCALE: 3/8"=1'-0"

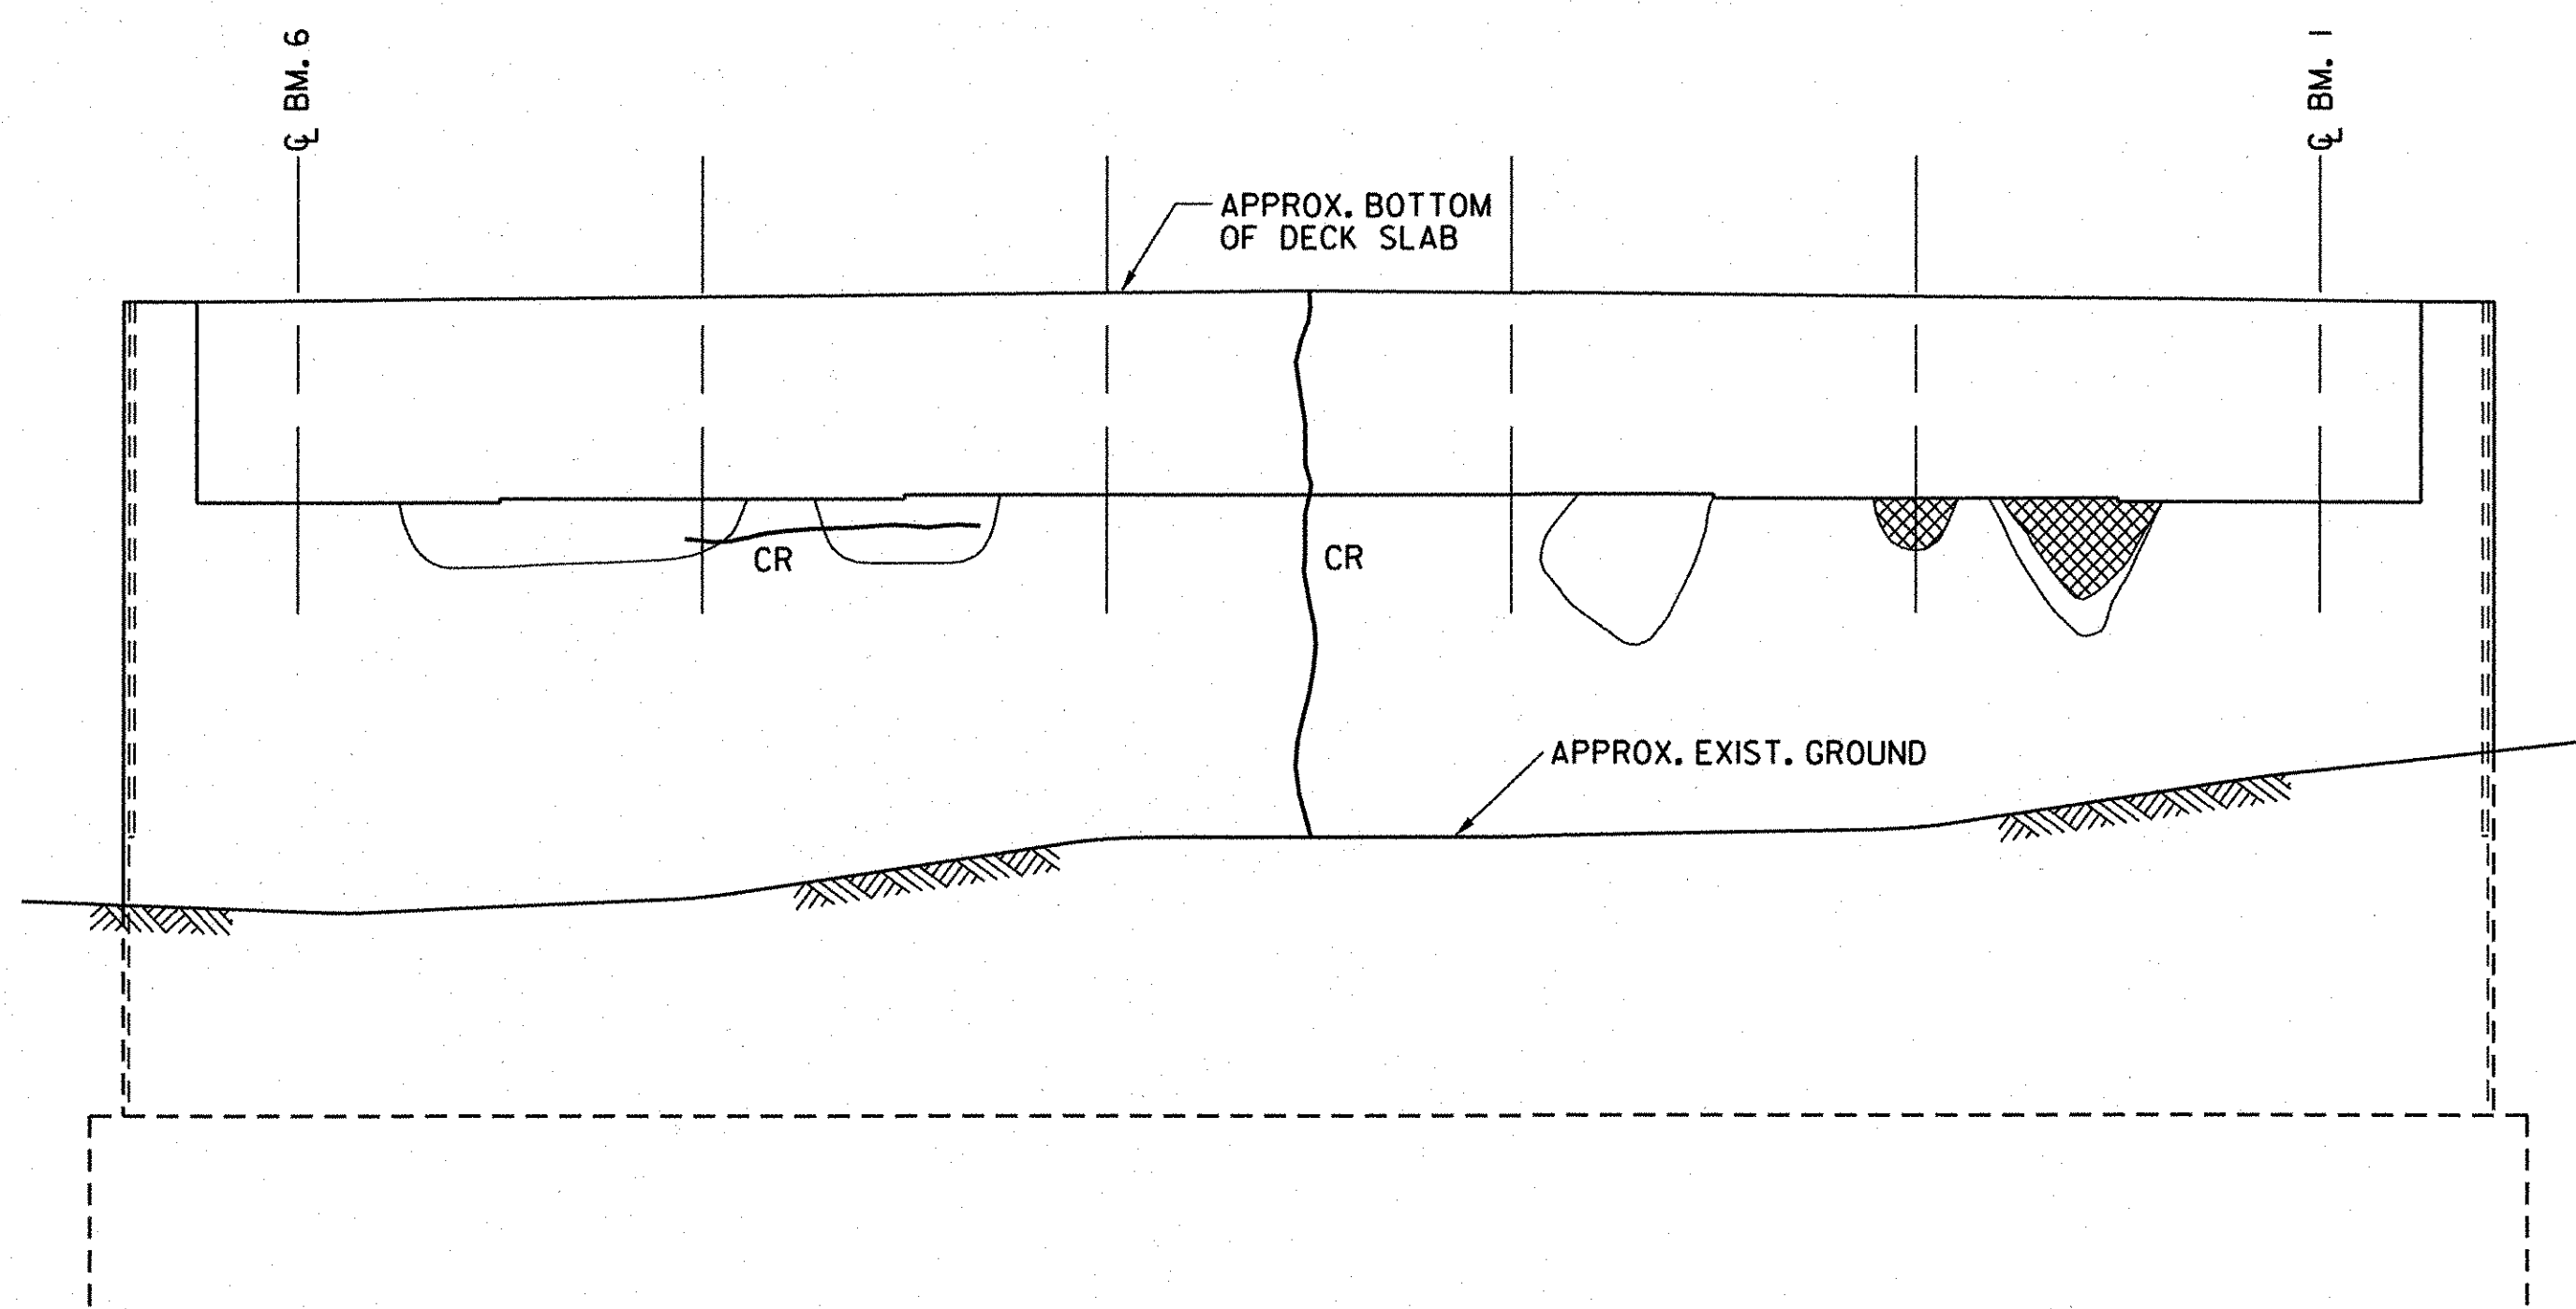

ABUTMENT 1 ELEVATION (3N)
SCALE: 3/8"=1'-0"

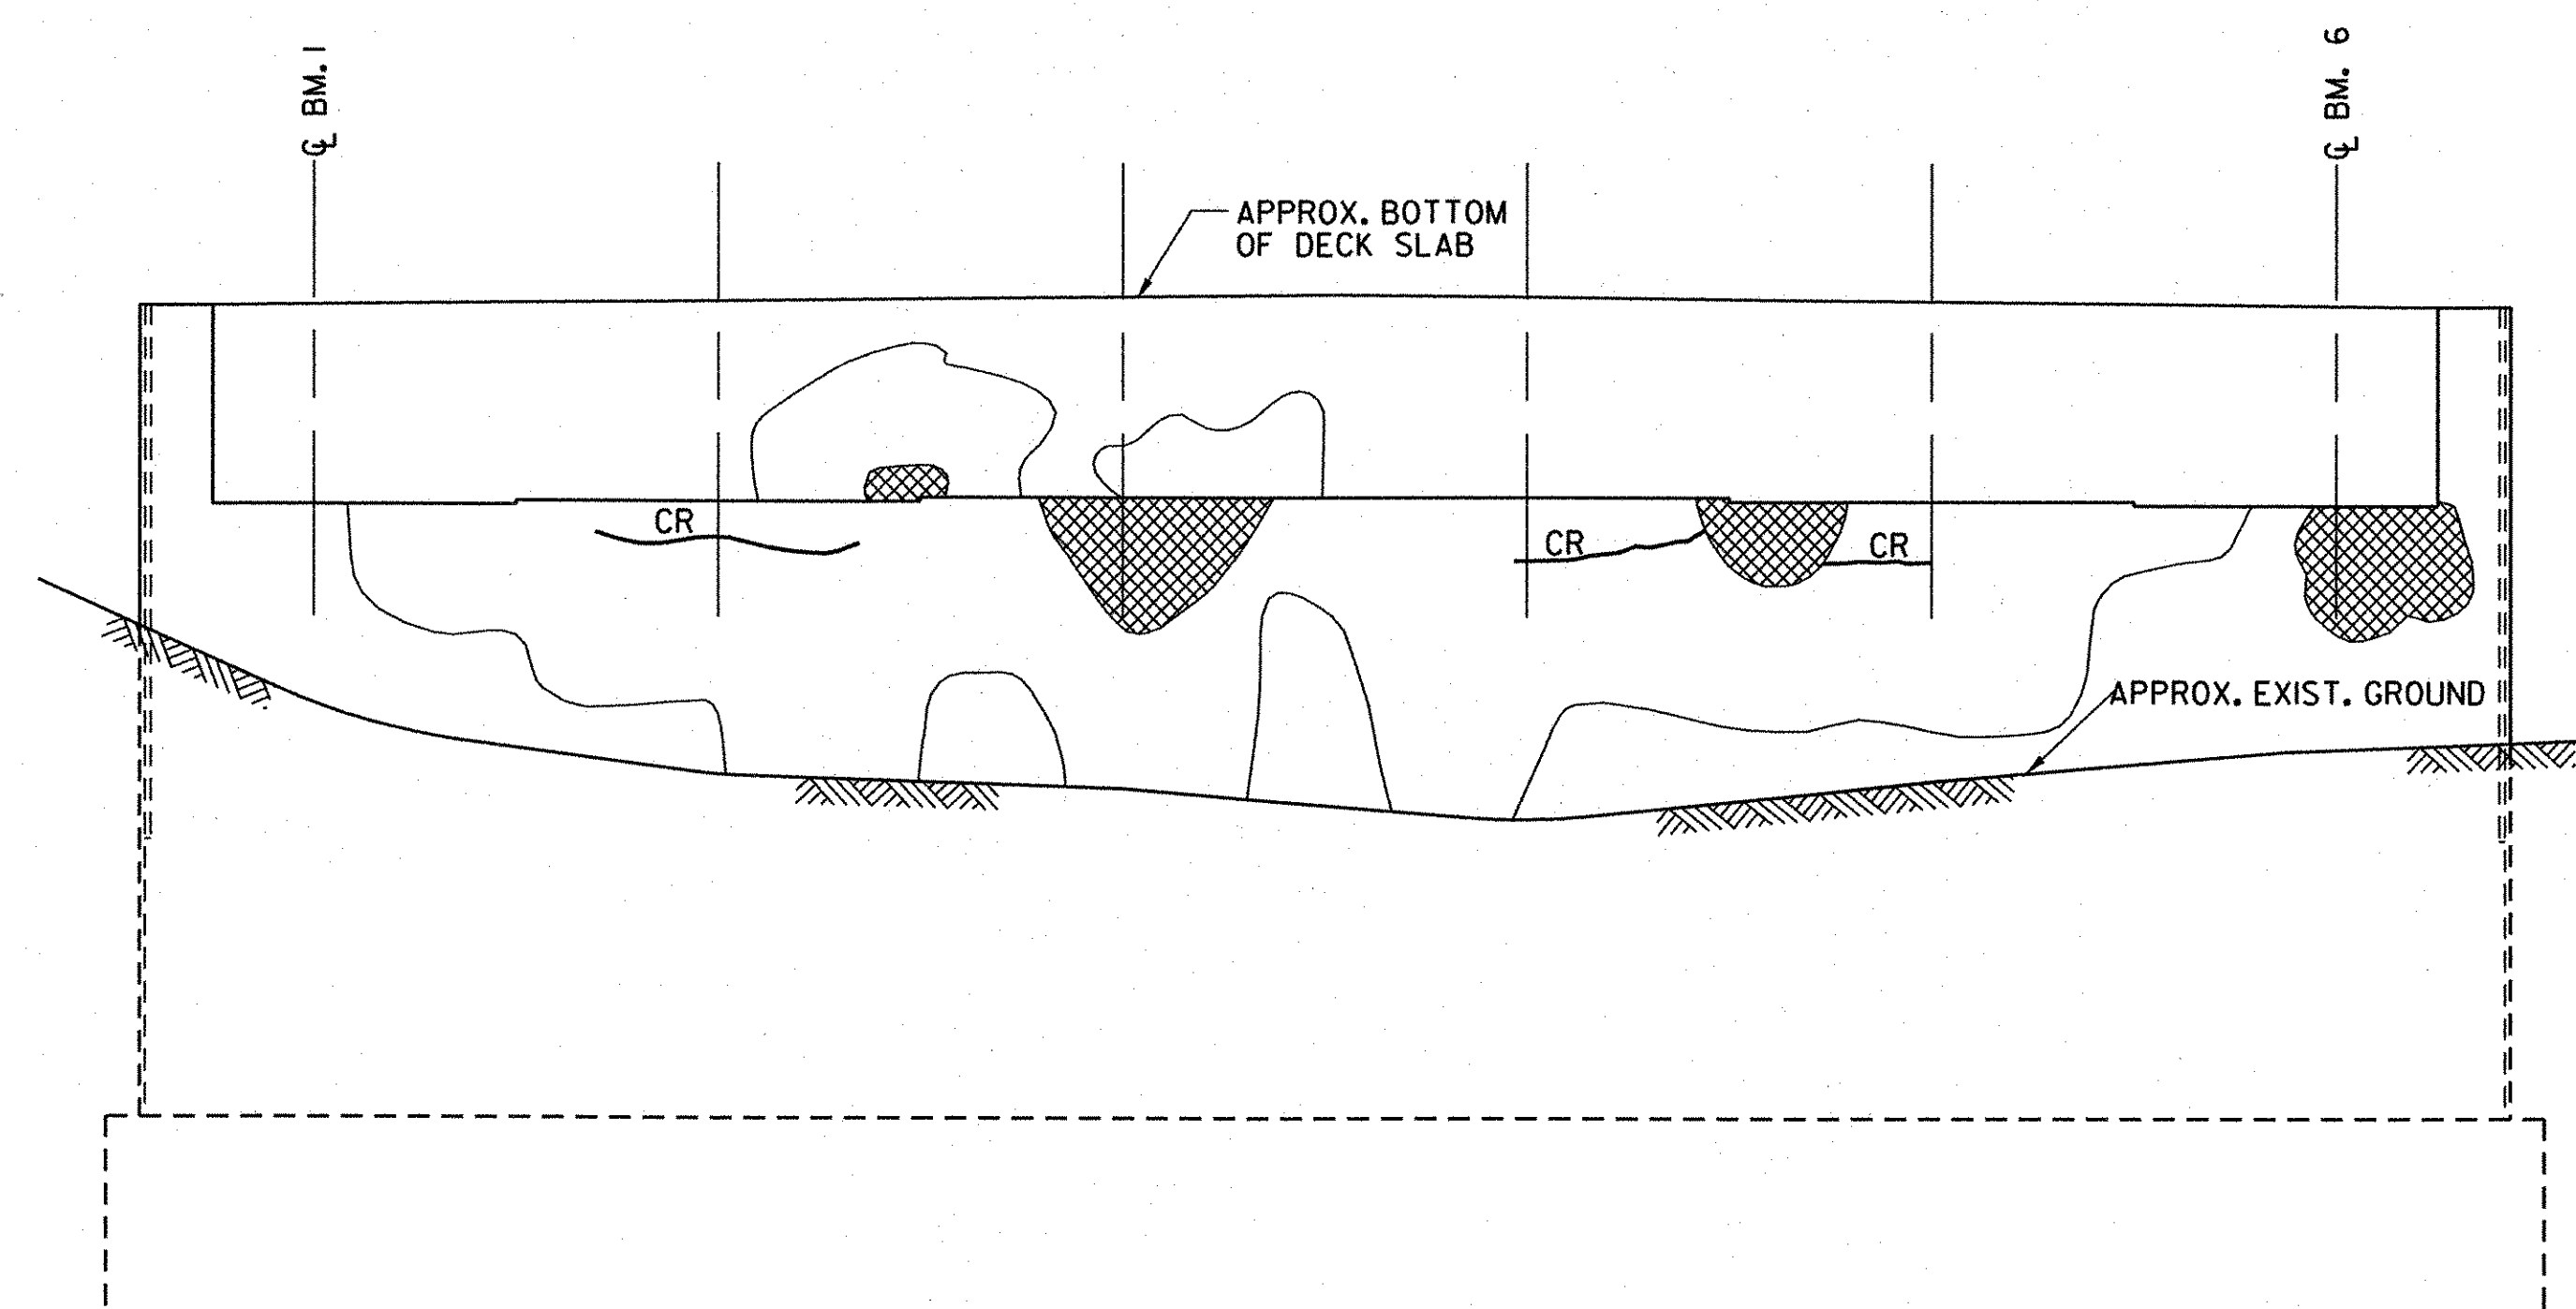

ABUTMENT 2 ELEVATION (3N)
SCALE: 3/8"=1'-0"

ABBREVIATIONS	
CR	CRACK
PA	PREVIOUSLY PATCHED AREA
LEGEND	
CRACK	
DELAMINATED AREA	
SPALLED AREA	
DEEPLY SPALLED WITH EXPOSED REBAR	
UNDERGROUND TELEPHONE	
EXISTING GROUND	

STATE OF VERMONT AGENCY OF TRANSPORTATION			
Town Of		Bridge No.	3N
Highway No.		Log Sta.	
1-91NB OVER BROAD BROOK & BROAD BROOK ROAD		Surv. Sta.	
EXIST. SUBSTRUCTURE CONDITION (3N) (3 OF 3)			
Designed By	M.J. MOZER	Drawn By	G. K. MORZE
Checked By	P.W. SZUSTAK	Bridge Design Supervisor	J.P. HALSTEAD
Date	01/03	Date	01/03
PROJECT		PROJECT NO.	
GUILFORD		IM 091-11331	
TVGA CAD Drawing No. G EXIS NB AB12.dgn		Date	
04/28/08		Bridge Sheet No. BR160	
		Sheet 86 of 114	