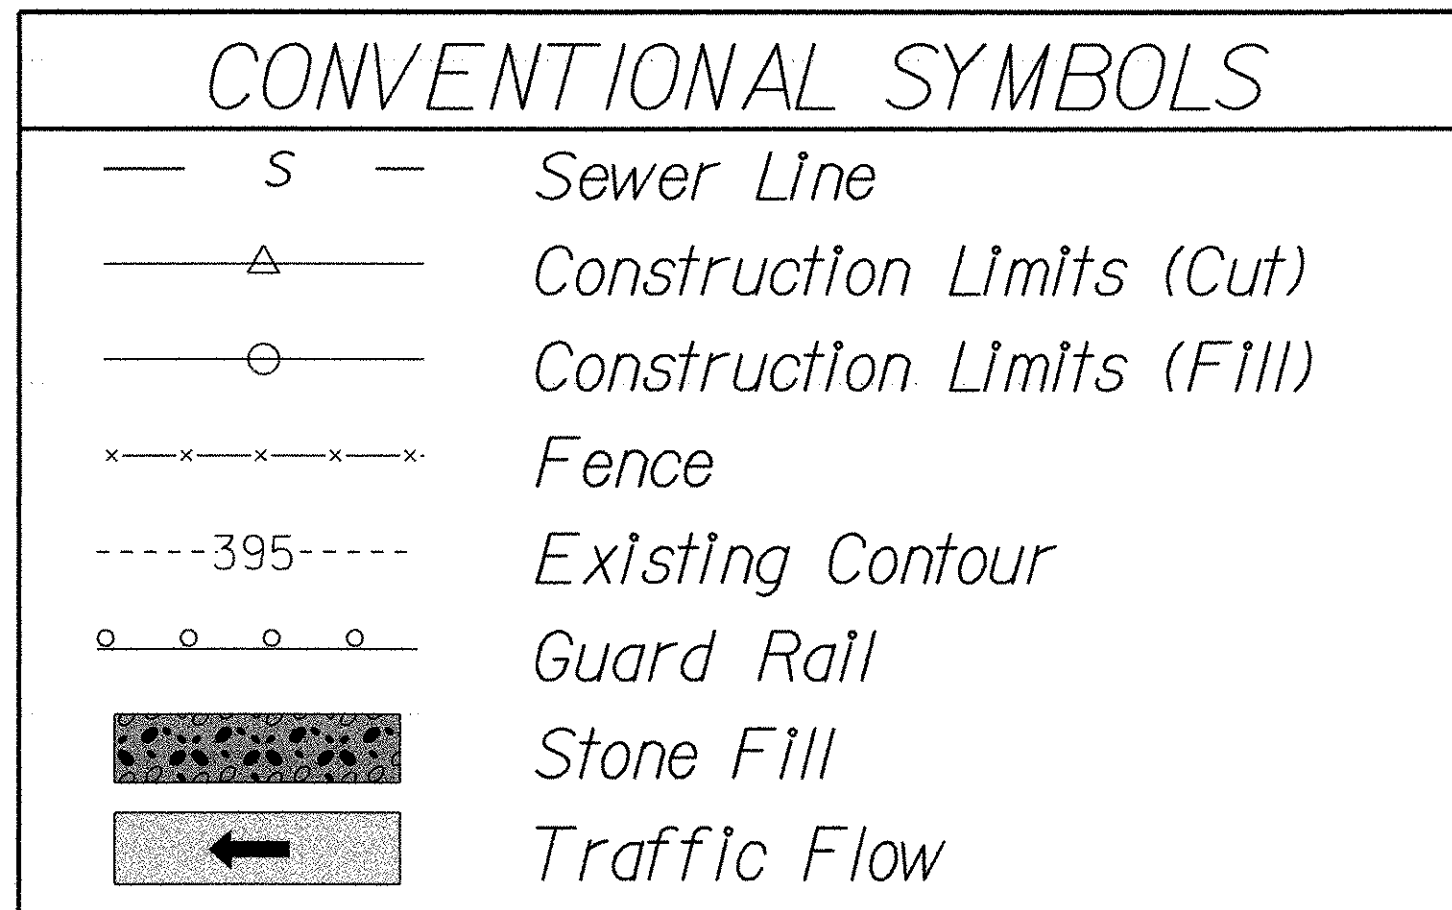
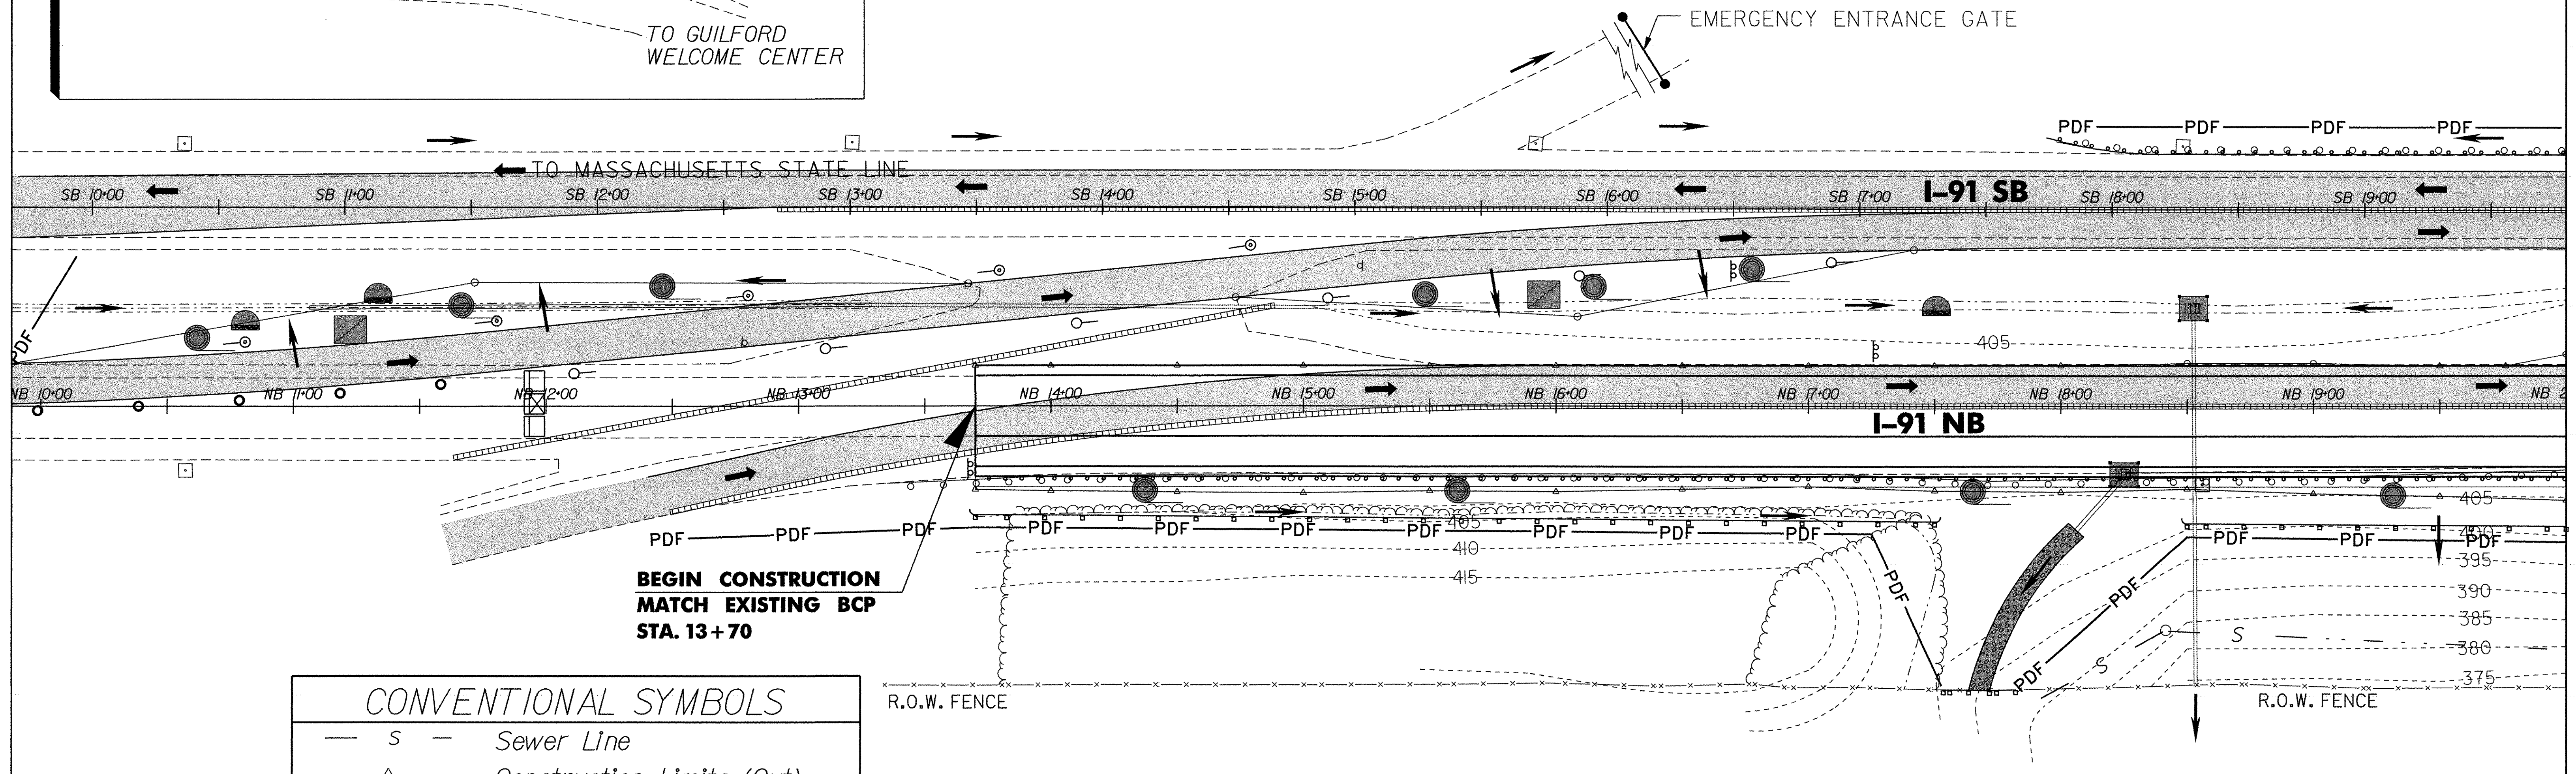
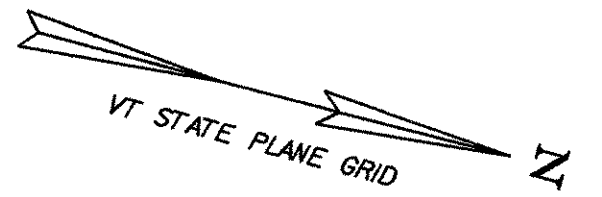
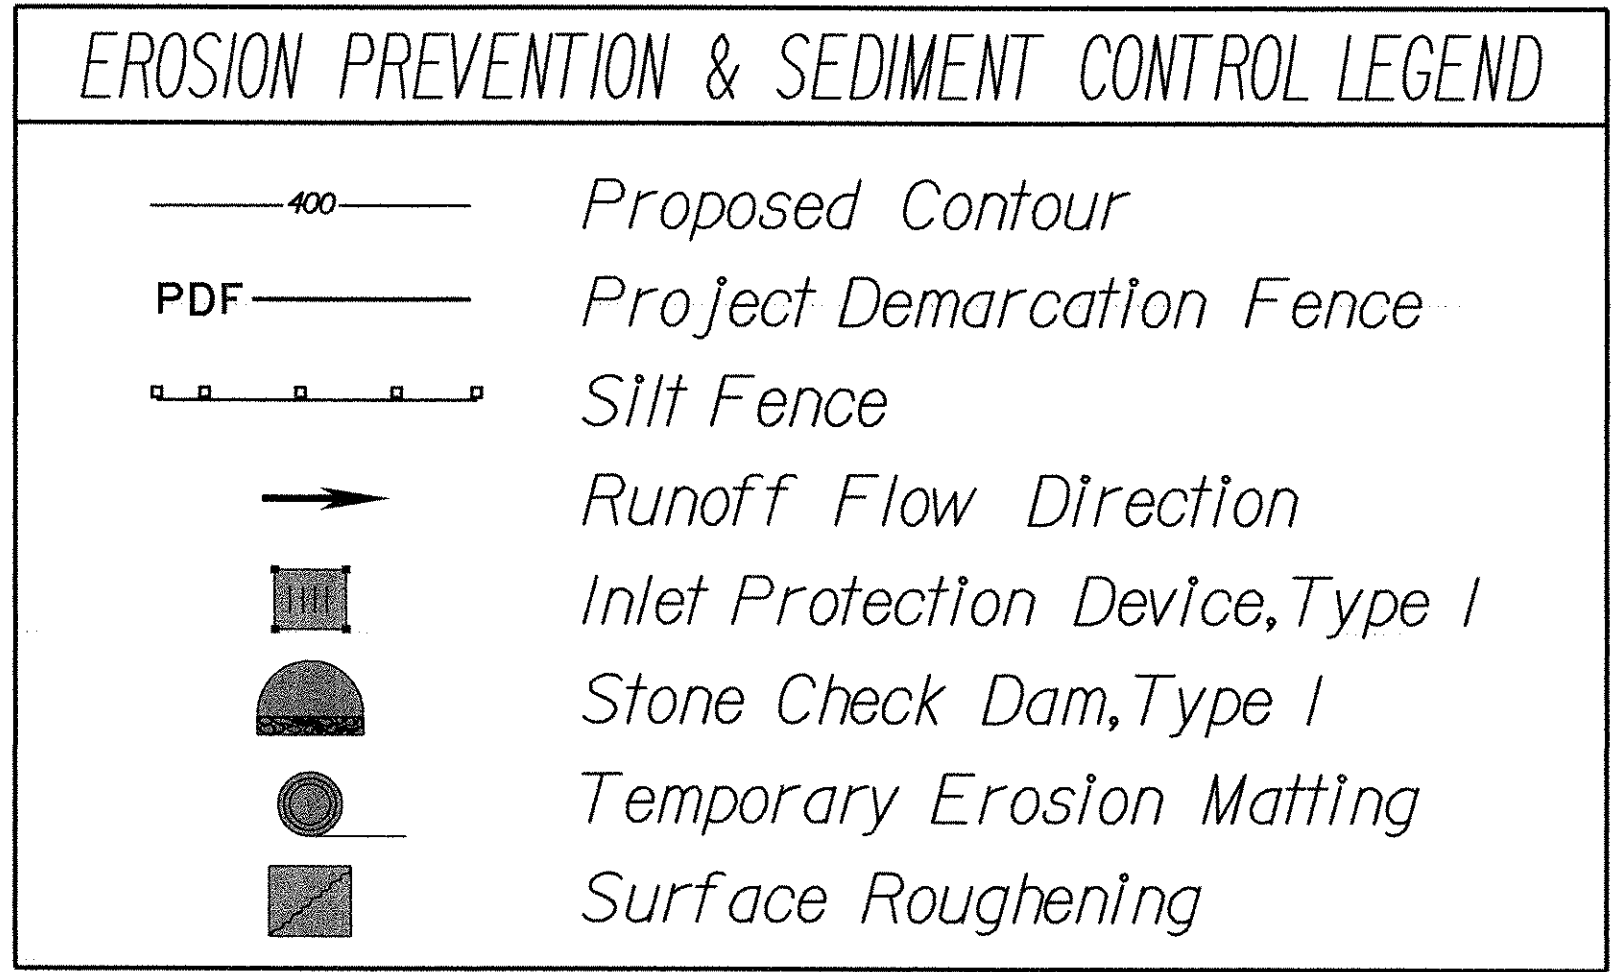
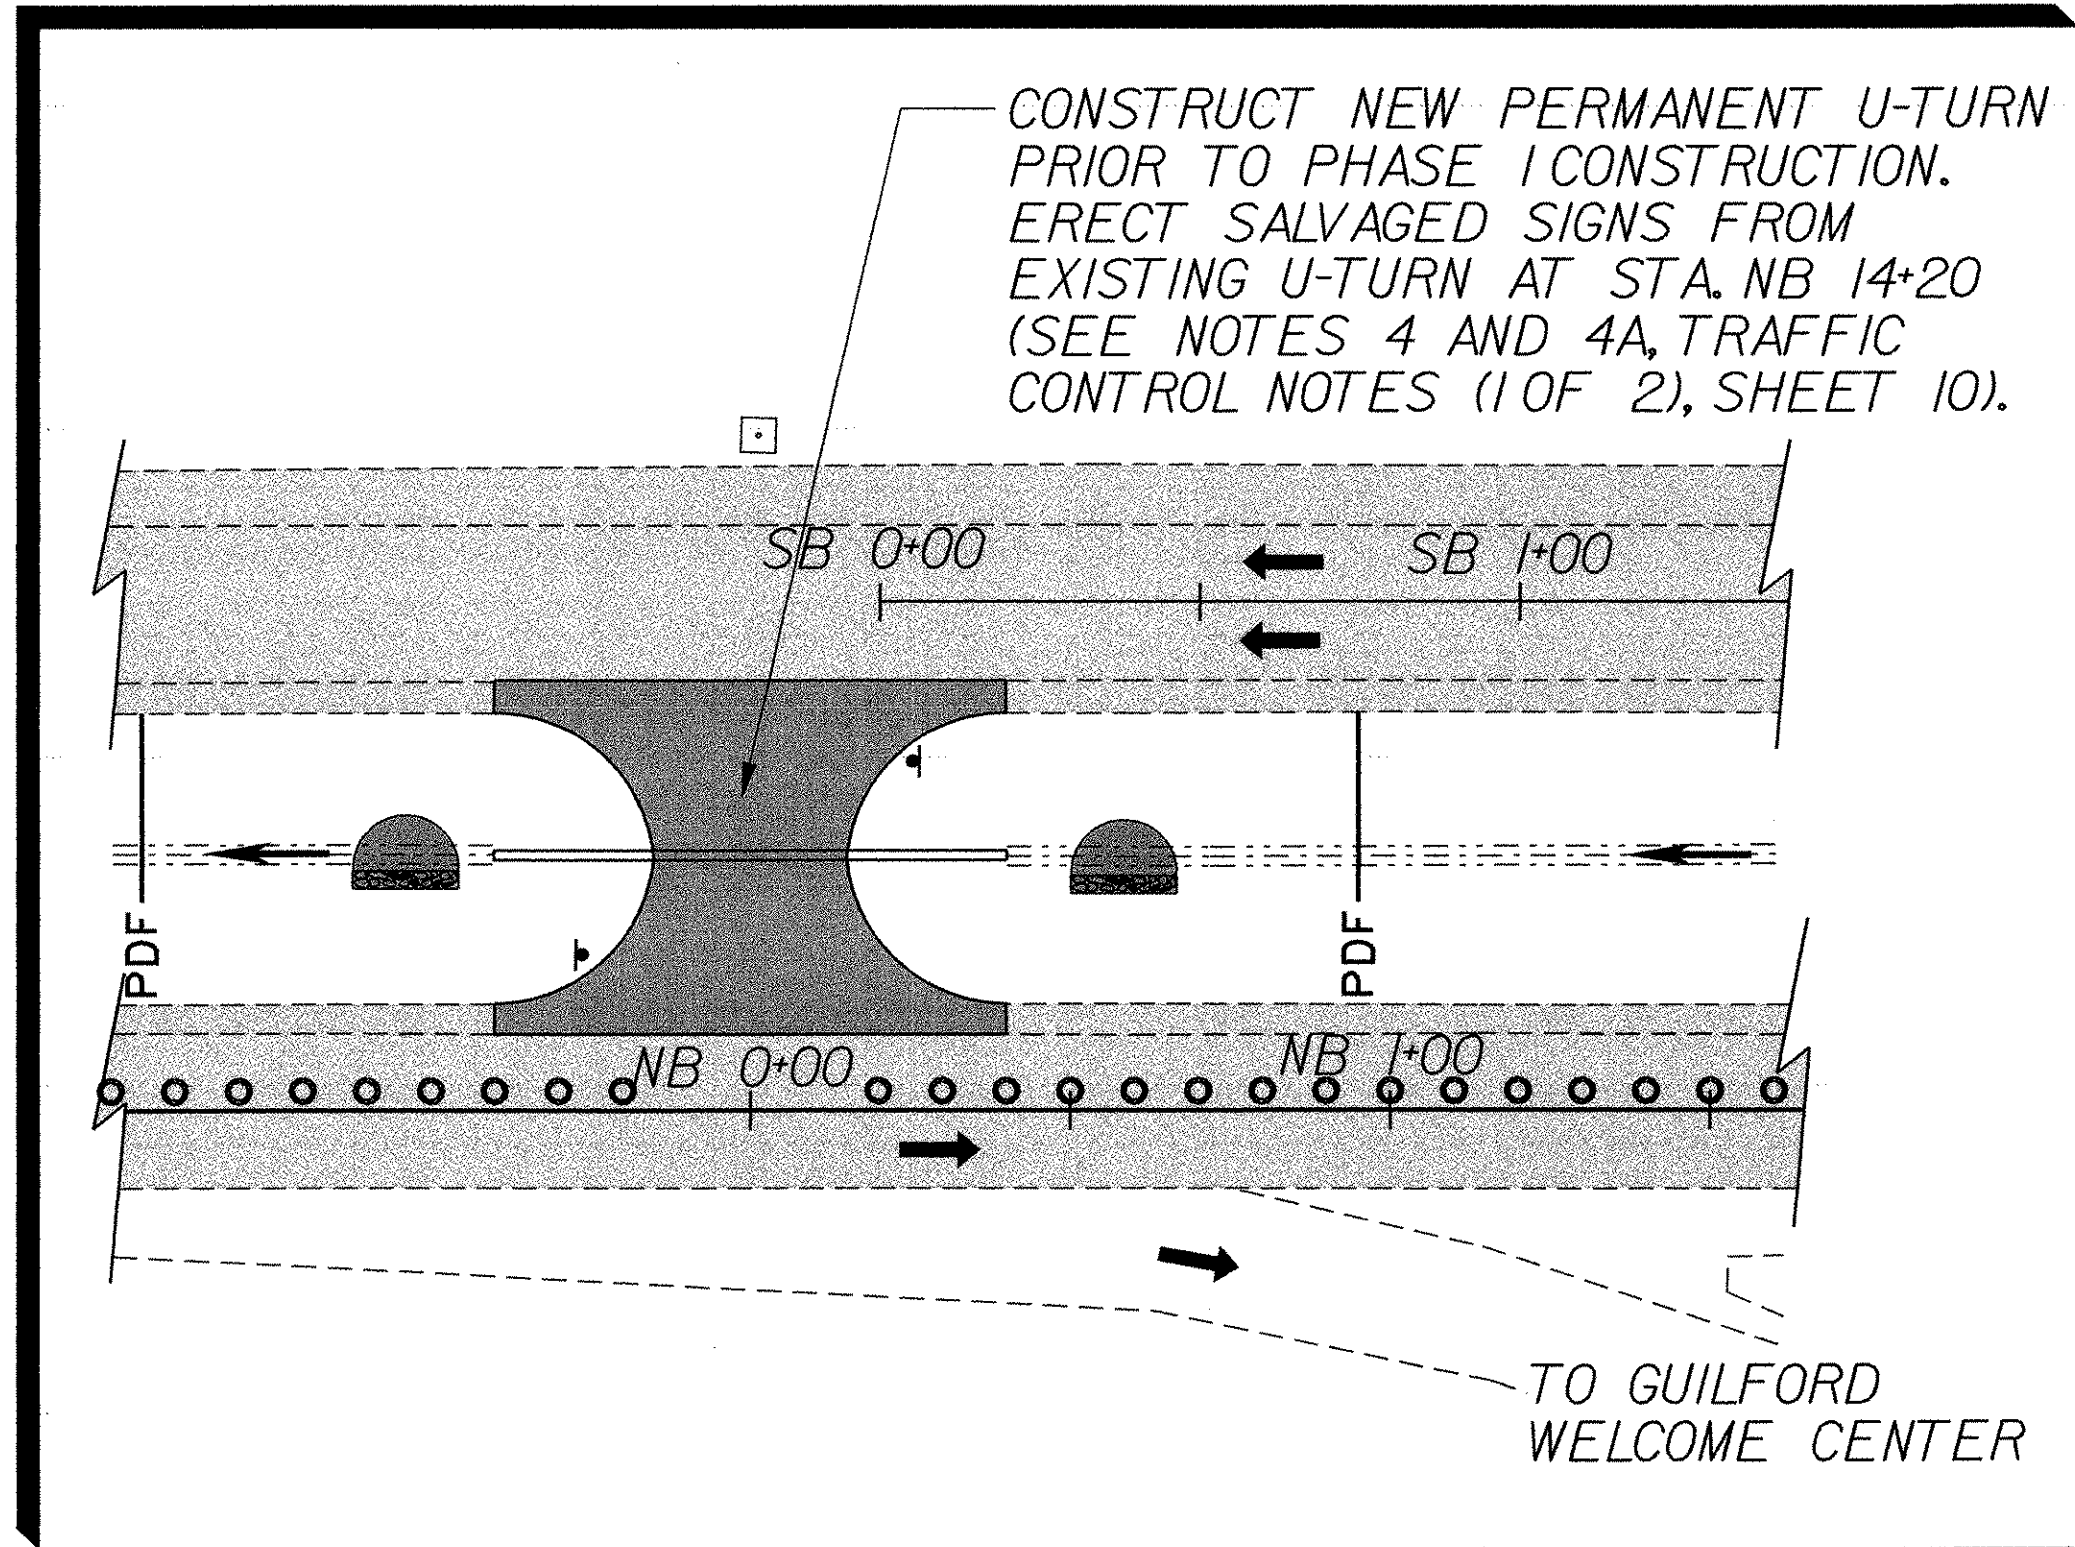


EPSC - PHASE 1 /STAGE A			
PROJECT NAME: GUILFORD		PLOT DATE: 11-JUN-2008	
PROJECT NUMBER: IM 091-I(33)		DRAWN BY: Weeber	
FILE NAME: 95al76\str\sdl76epsclA.dgn		DESIGNED BY: STRI	
PROJECT LEADER: Farnsworth		CHECKED BY: Farnsworth	
sdl76epsclALLI		SHEET 92A OF 114	