


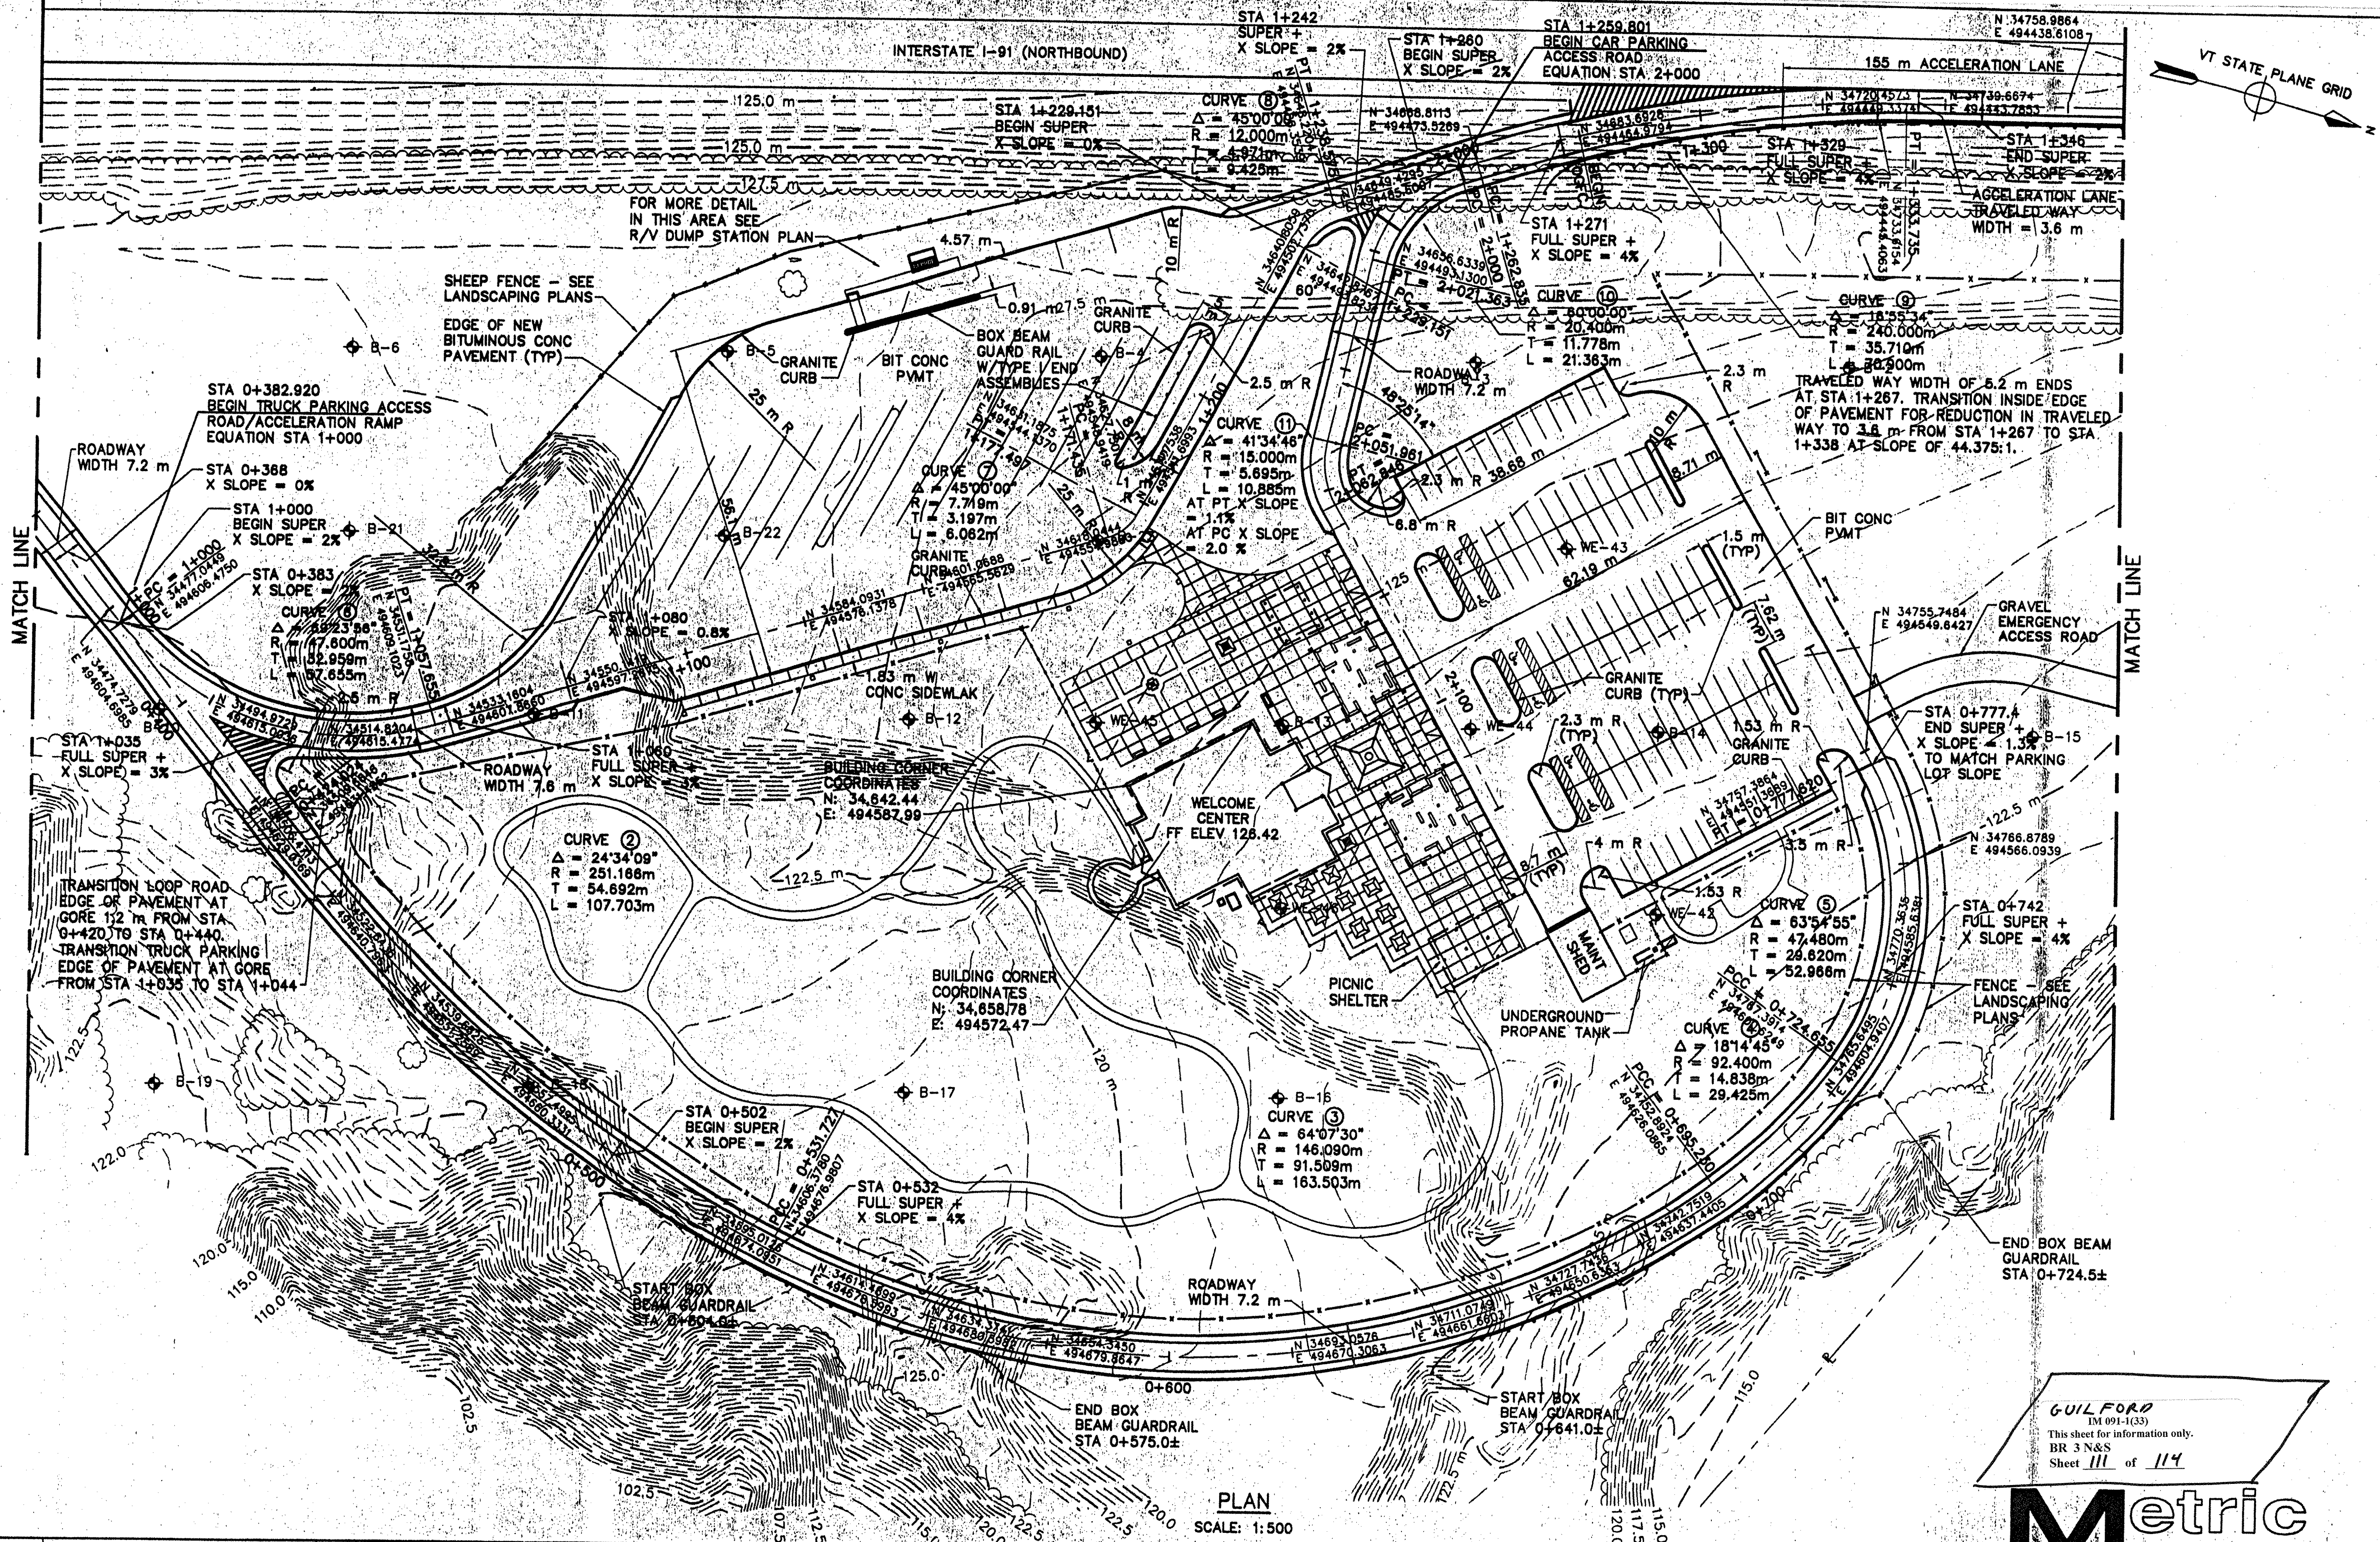

GUILFORD
IM 091-1(33)
This sheet for information only.
BR 3 N&S
Sheet III of 114

Metric

TIMOTHY D. SMITH & ASSOCIATES, PC ARCHITECTS OLD RAILROAD STATION NORTH BENNINGTON, VERMONT 06257 802-442-8184 FAX 802-442-5241				PROJECT NO. IM 091-1 (30) SOUTHEAST VERMONT WELCOME CENTER GUILFORD, VERMONT PRELIMINARY DRAWINGS				STATE OF VERMONT AGENCY OF ADMINISTRATION DEPARTMENT OF BUILDINGS & GENERAL SERVICES			
WRIGHT ENGINEERING, LTD. CIVIL ENGINEERS 188 MERCHANTS ROW - P.O. BOX 178 RUTLAND, VERMONT 05708-0178 802-770-8811 FAX 802-770-8818				ROBT W. HALL T.J. BOYLE AND ASSOCIATES CONSULTING ENGINEERS, INC. LANDSCAPE ARCHITECTS 640 MEADOW STREET EXTENSION, ETC. 4 AGAWAM, MASSACHUSETTS 01001-0005 415-769-0900 FAX 781-385-3853				DSGN BY: JAC DRWN BY: DSM CHKD BY: JAC CHKD BY: JCO			
NO. DATE REVISIONS				SHEET TITLE: ROAD PLAN				DATE: -13-98 SHEET NO. III OF 114 SHEETS			
2	5/6/98	ADDED COORDINATES									
1	2/18/98	REVISIONS PER BGS/FHWA REVIEW	DSM KAS								

C5