



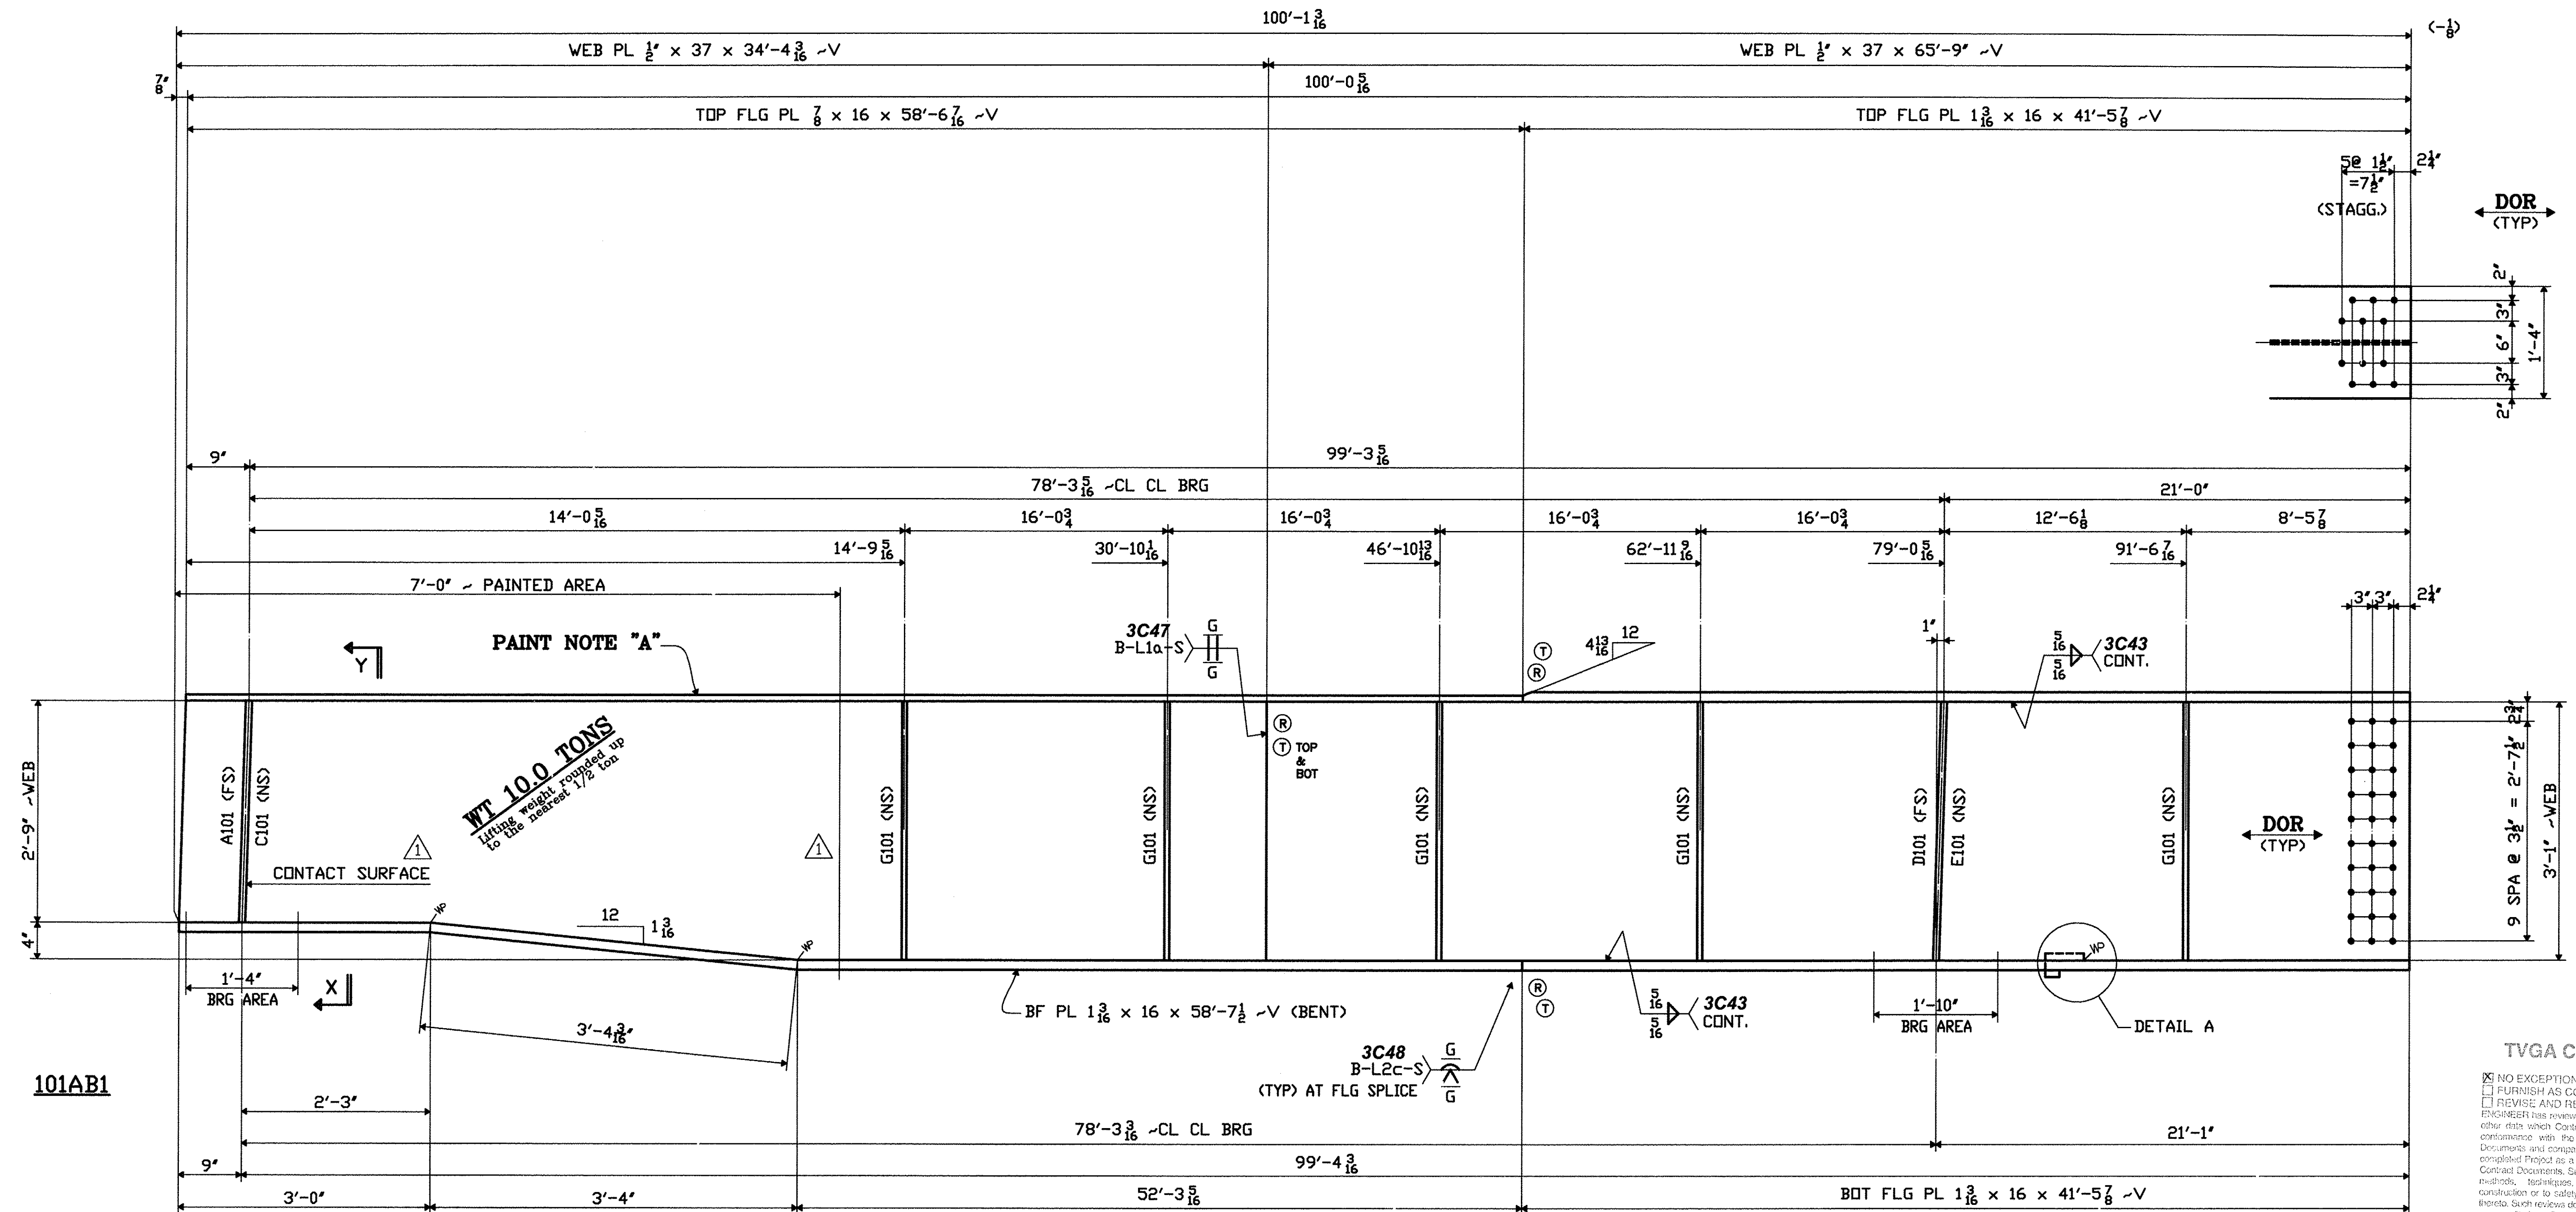

101AB1

PAINT NOTE "A"
(MIST COAT OF PRIMER
ONLY ~1.5 MILS DFT)

SECTION Y
AT 7'-0" PAINTED AREA

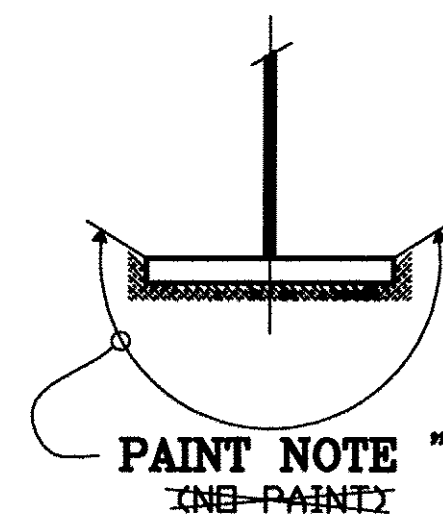

SECTION X
AT BRG AREA

DOR ~ DENOTES
DIRECTION OF ROLLING

TVGA CONSULTANTS

☒ NO EXCEPTIONS TAKEN ☐ REJECTED
☐ FURNISH AS CORRECTED
☐ REVISE AND RESUBMIT
ENGINEER has reviewed Shop Drawings and Samples and other data which Contractor is required to submit, only for conformance with the information given in the Contract Documents and compliance with the design concept of the completed Project as a functioning whole as indicated in the Contract Documents. Such review does not extend to means, methods, techniques, sequences or procedures of construction or to safety precautions and programs located thereto. Such review does not extend to any LEED certification or sustainability. Contractor is responsible for dimensions to be confirmed and correlated at the job site for information that pertains solely to the fabrication processes or to techniques of construction and for coordination of the work of all trades.

BY: *John T. [Signature]*
DATE: 7/23/2009

PROJECT No: ACIM 091-1(33)
STA. 22+47.71 TO STA. 25+05.93
BRIDGE No. 3S (SOUTHBOUND)
TOWN OF GUILFORD

ORDER NO. 08-18537H32
DETAILS OF PL GIRDER - SPAN AB
LINE 1
PROJECT I-91 OVER BROAD BROOK AND
BROAD BROOK ROAD
LOCATION WINDHAM COUNTY, VT
CUSTOMER MEC CONSTRUCTION
CAROLINA STEEL GROUP, LLC.

MADE BY GM
CHECKED BY PDC/SB
SOUND LEADER Precision Drilling Co. Inc.
DATE 09-08
SHEET HF101A

FABRICATED BY NASH
HOLES 13/16" SHOP FASTENERS
SHOP PAINT PARTIAL PAINT PER HN101 & AS NOTED
SHOP INSPECTION WORK THIS SHEET w/HF101B
GENERAL NOTES

DATE	NO.	BY	REVISIONS
07/06/09	R1	PDC/SB	REMOVED HATCHED AREA & ADDED NOTES

