

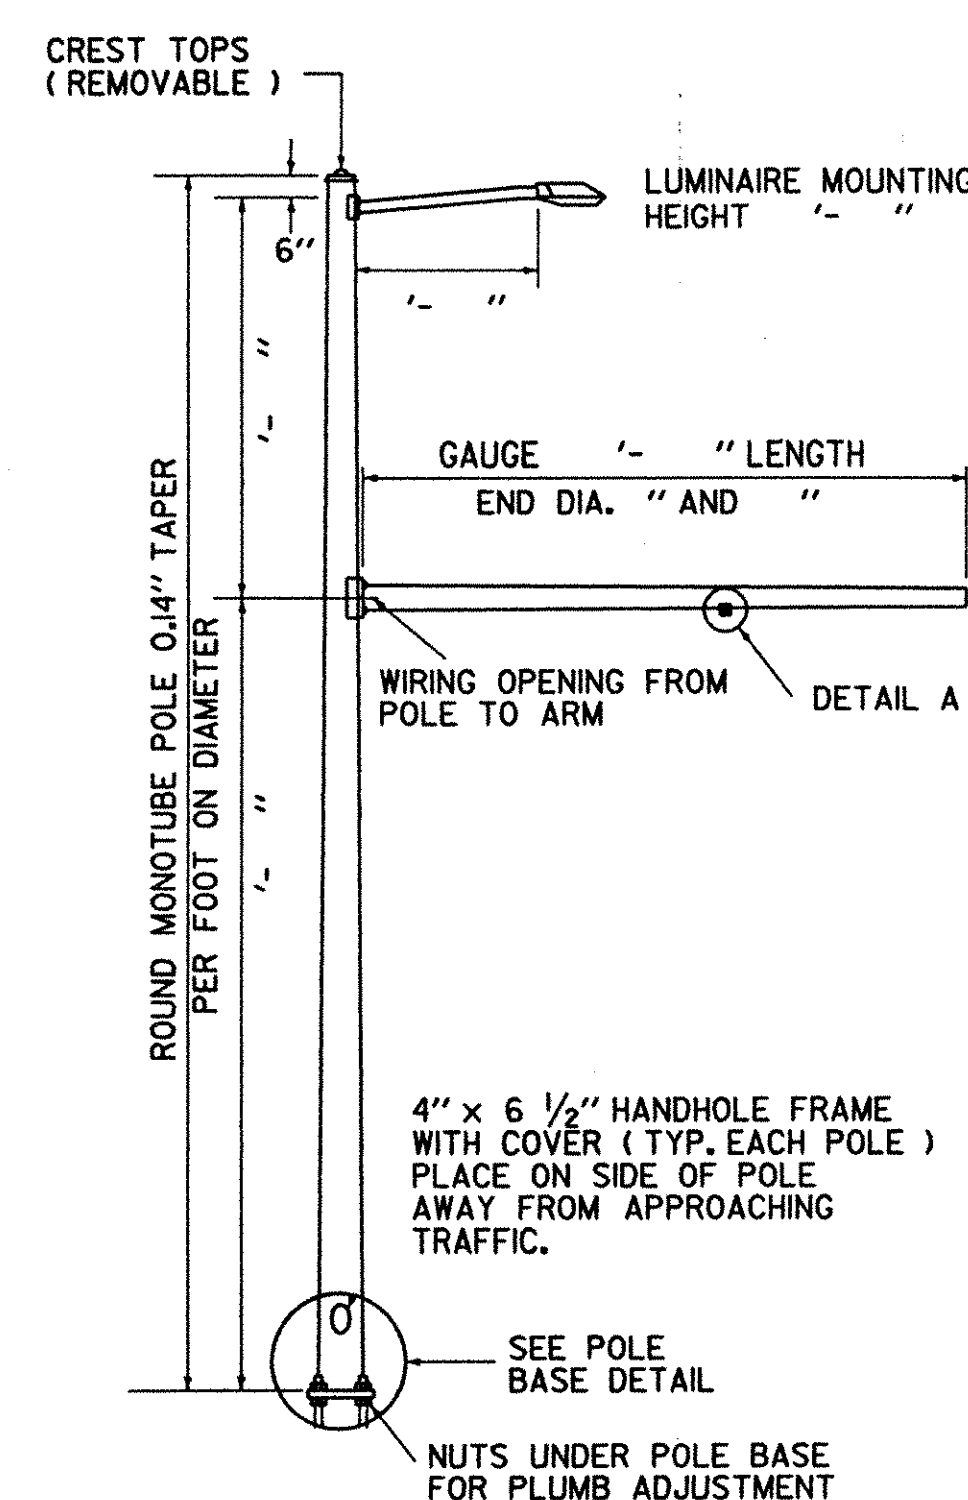


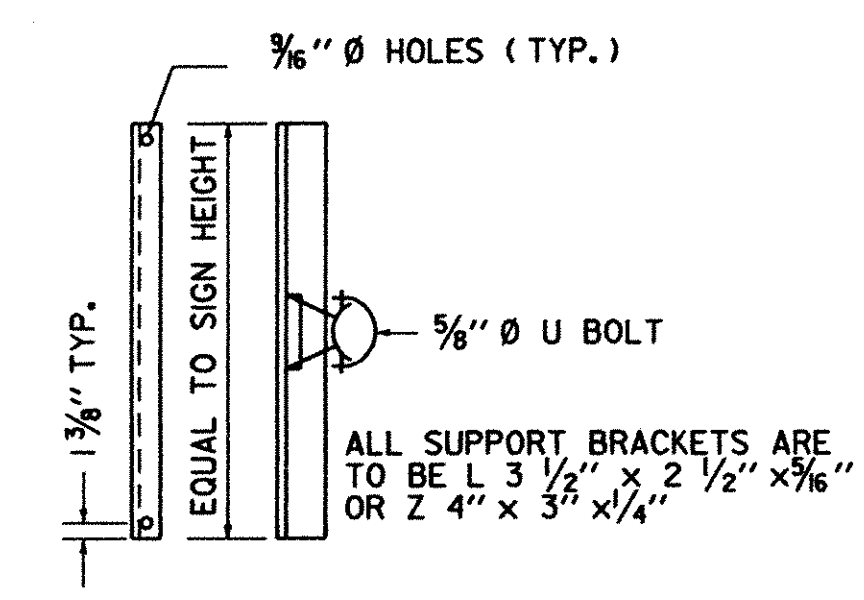


TYPE C
SINGLE MASTARM WITH LUMINAIRE

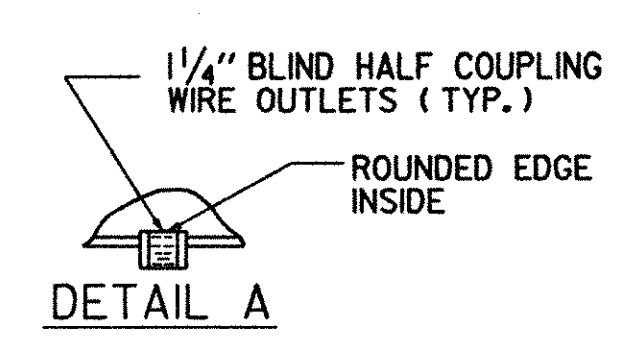



SIGN ON SINGLE MASTARM
SIGN BRACKET DETAILS

POLE DATA		POLE BASE DATA					
TYPE	GAGE AND POLE SIZE	BC	F	S	T	P	ANCHOR BOLT SIZE


GROUND WIRES SHALL BE ANCHORED TO THE STRUCTURE INSIDE THE MANHOLE ACCESS ASSEMBLY WITH A SUITABLE ANCHORING DEVICE HAVING A MINIMUM DIAMETER OF ONE-HALF (1/2) INCH.

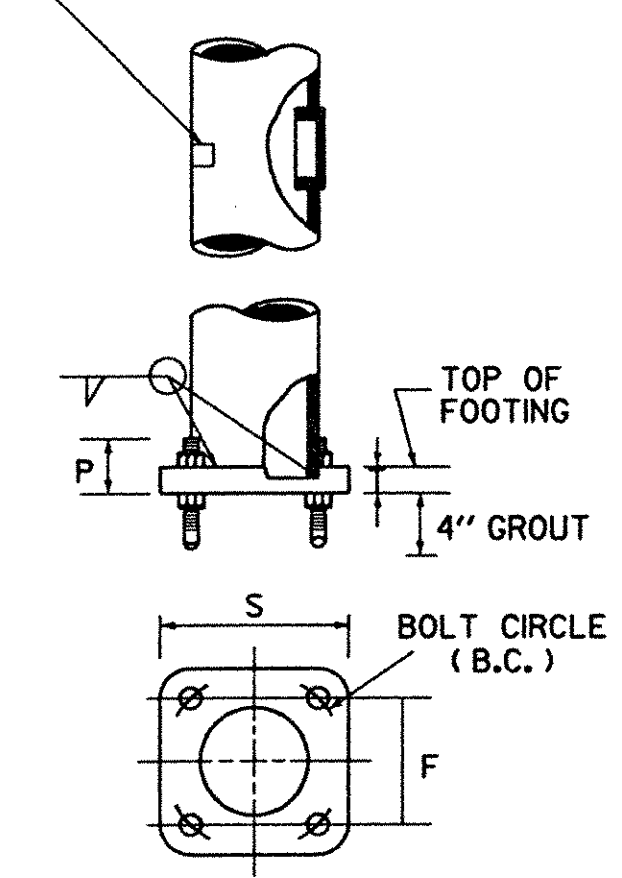


POLE BASE DETAIL

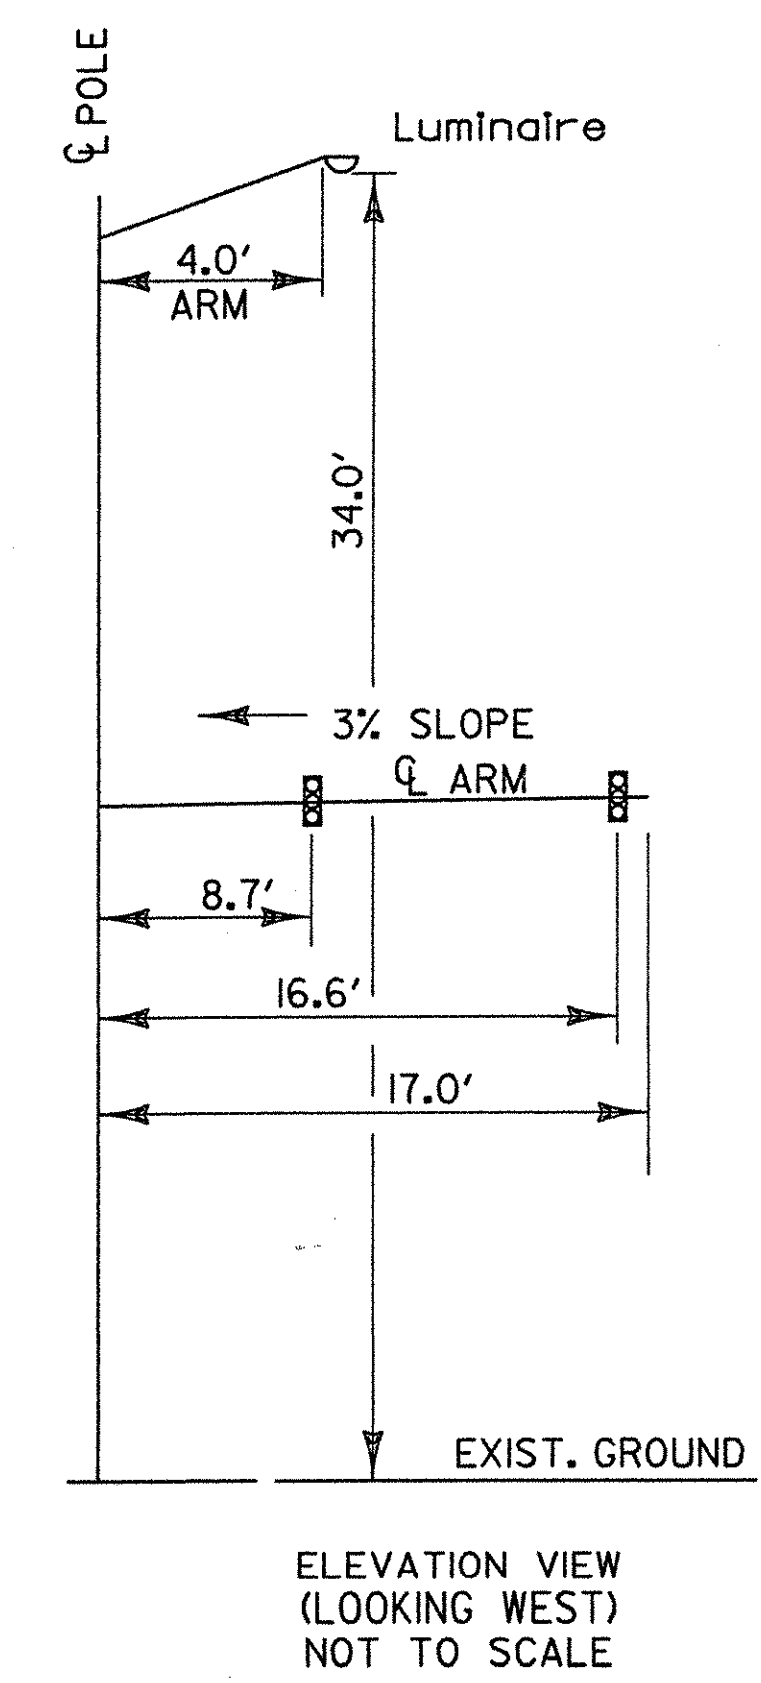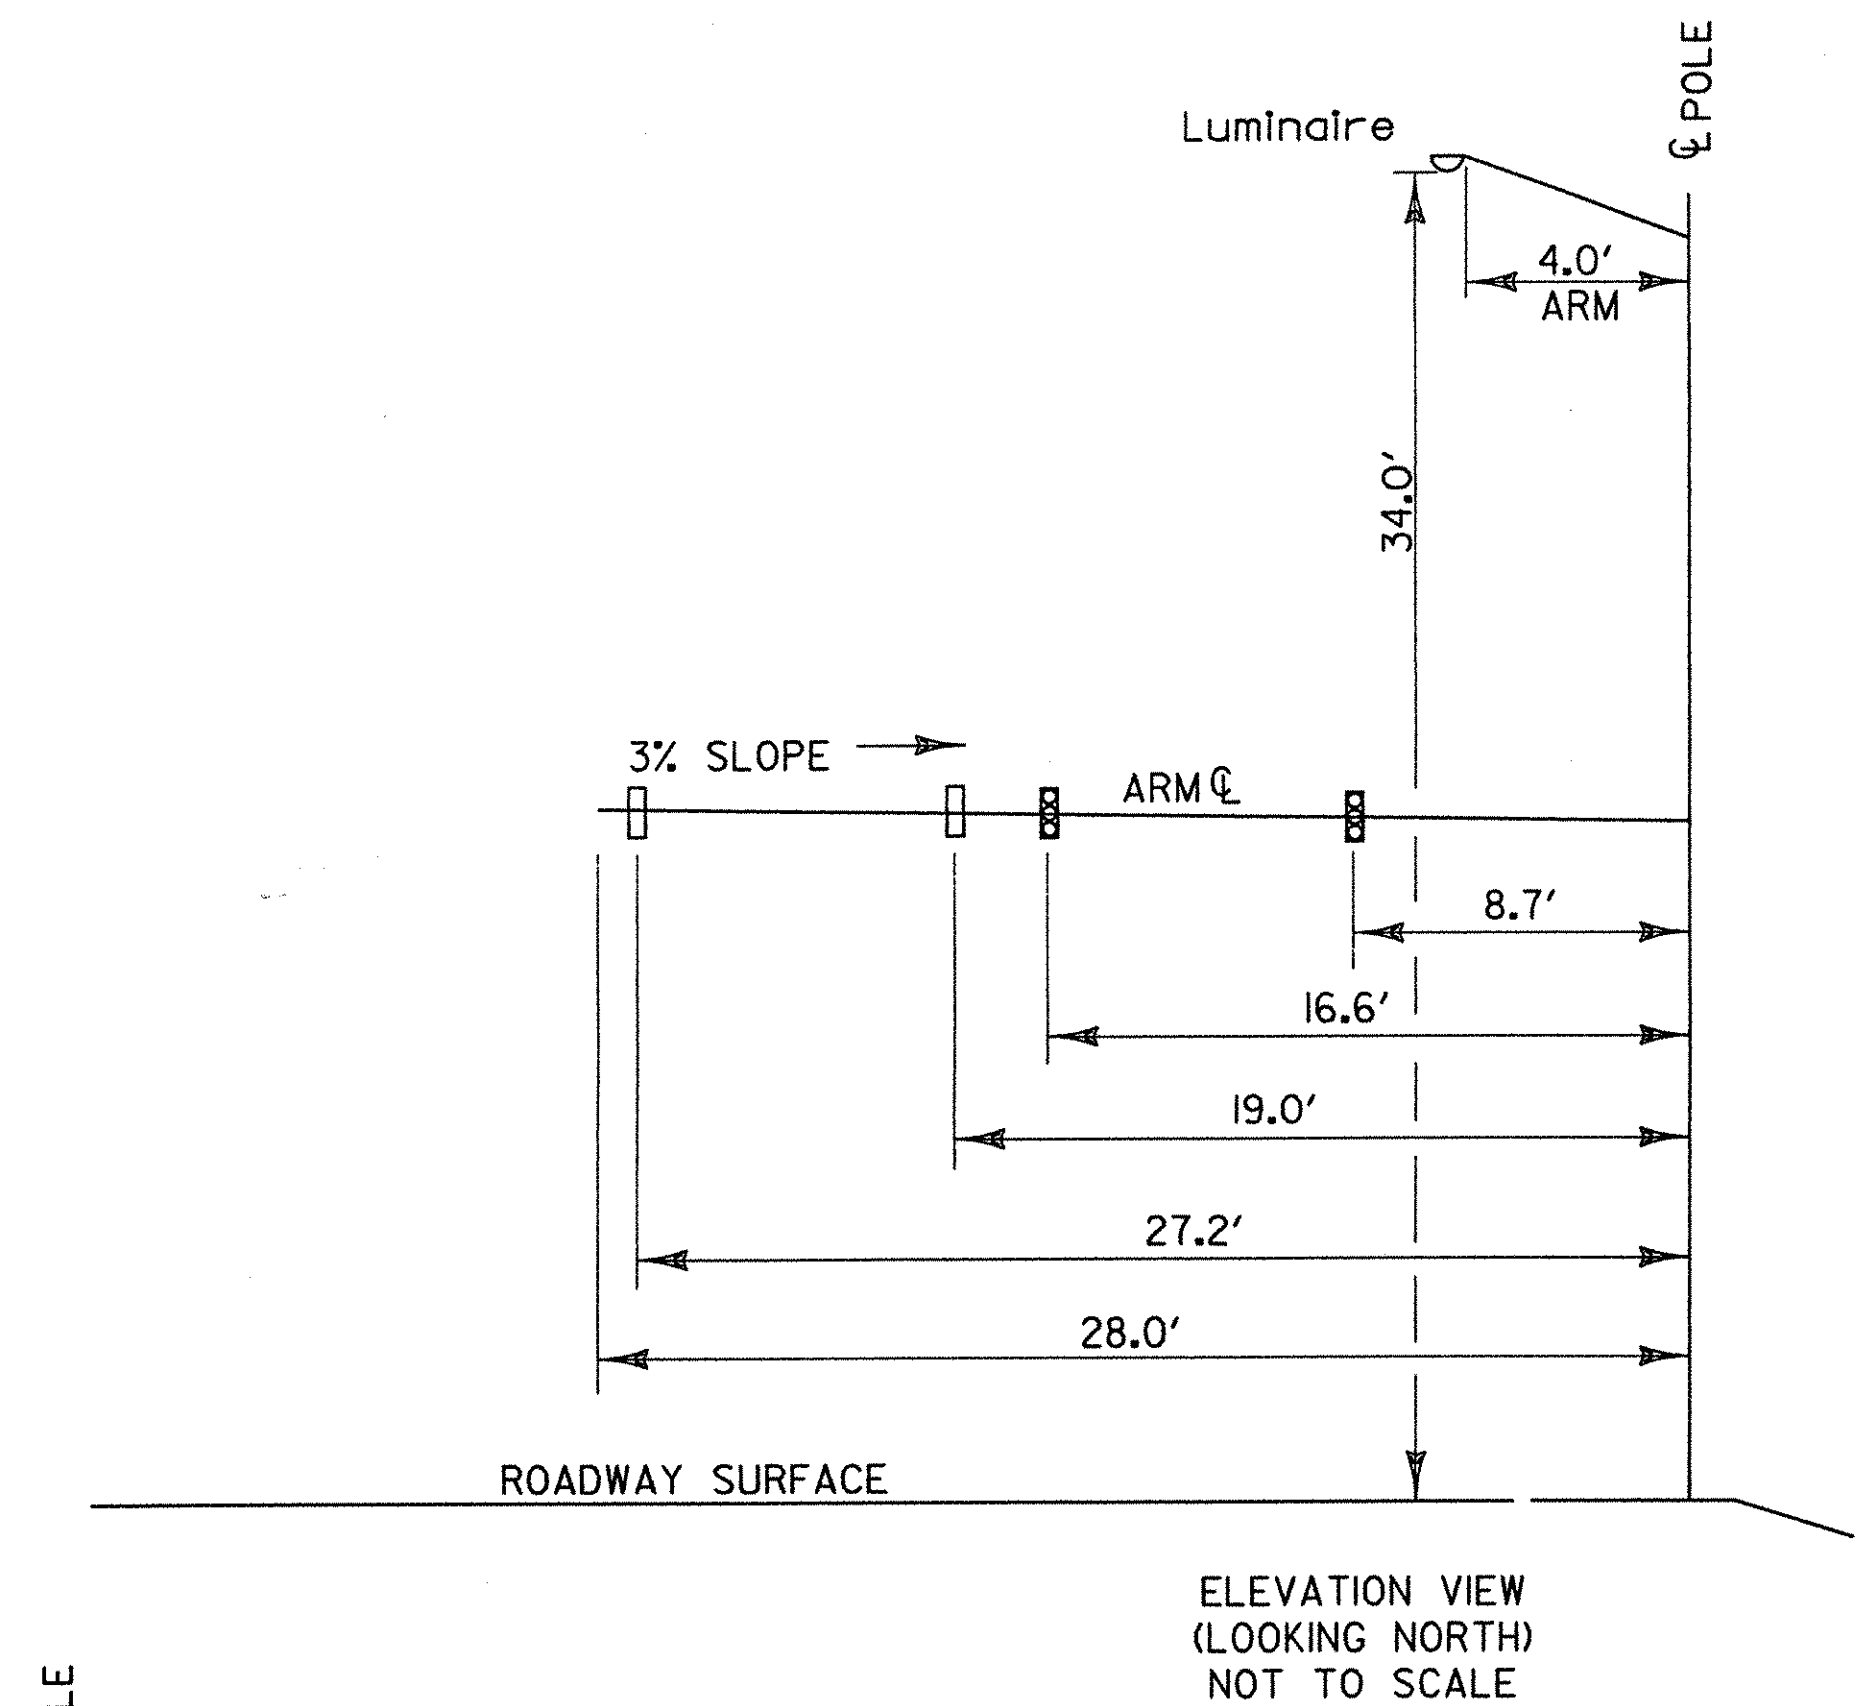

MAST ARM DETAILS

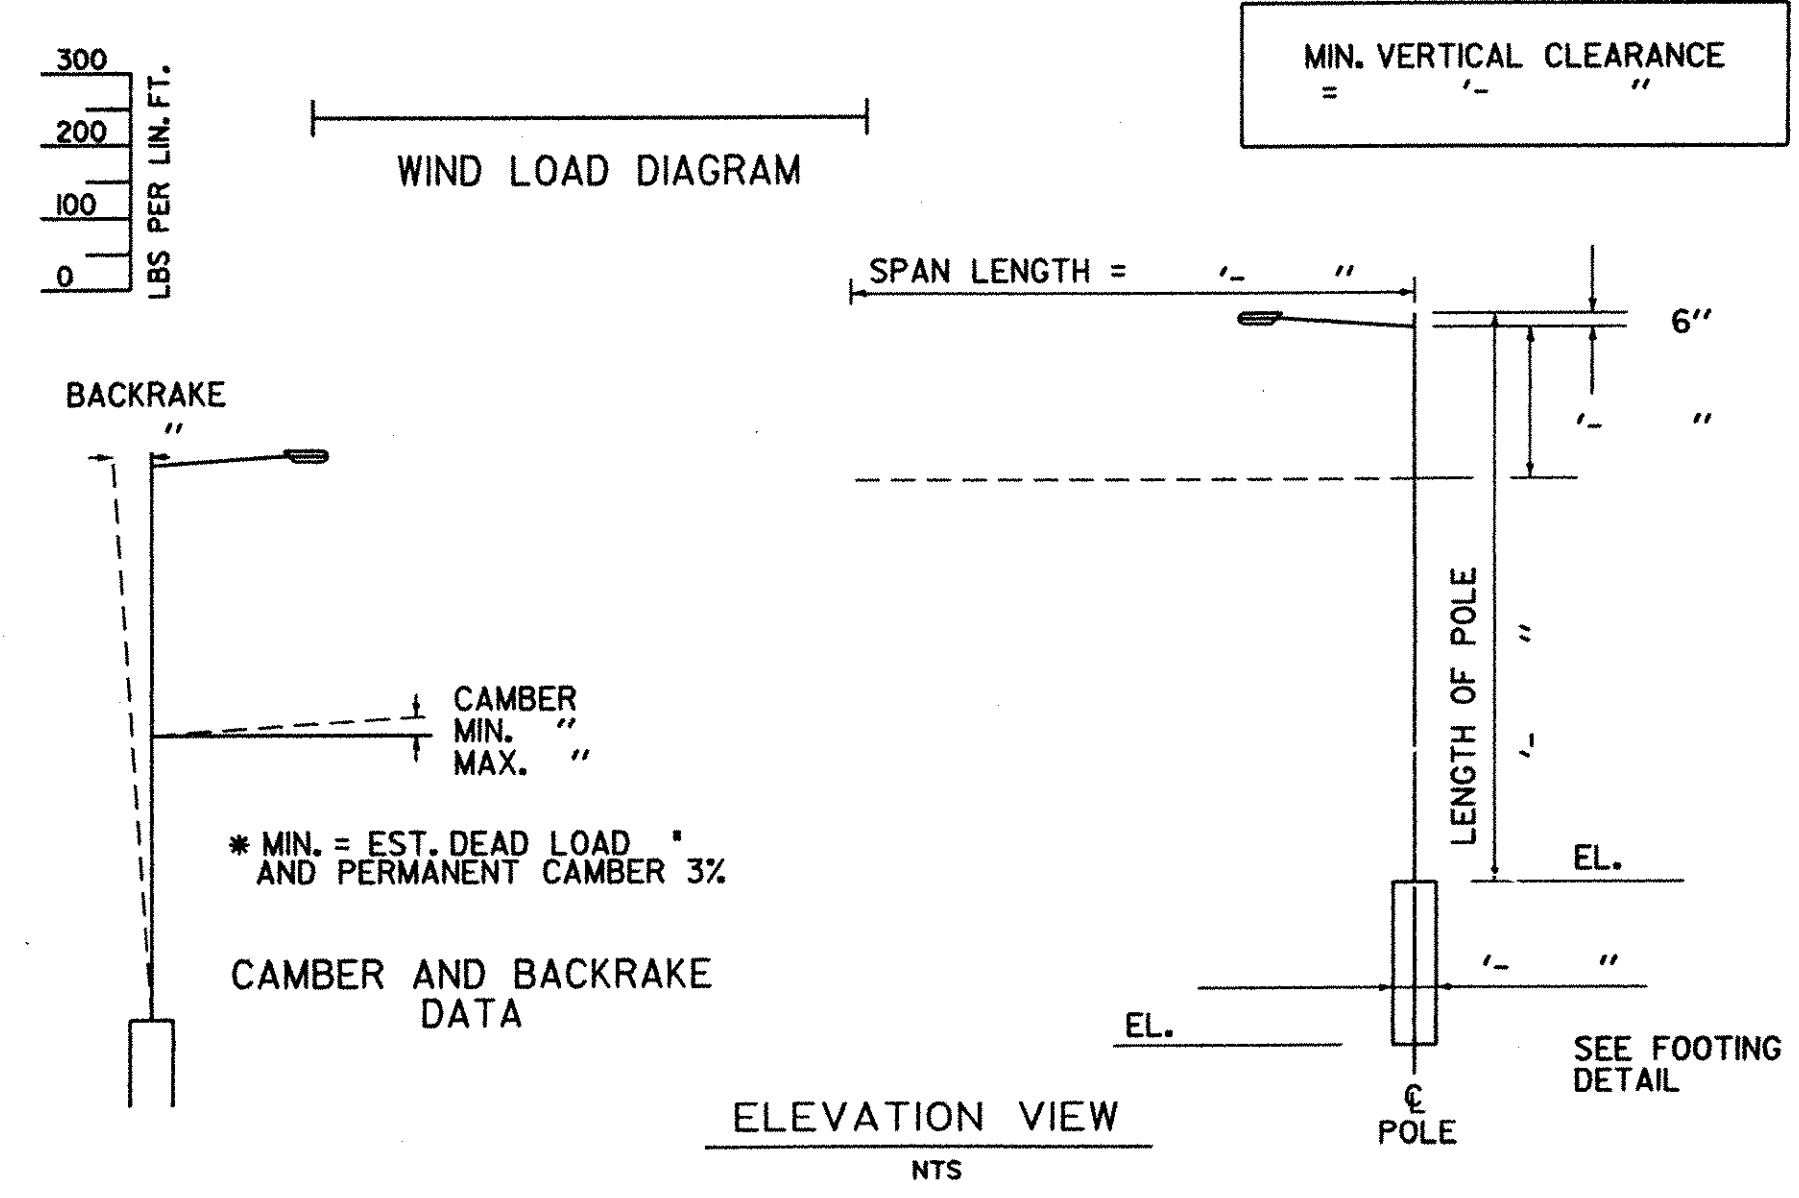

ELEVATION VIEW
NTS

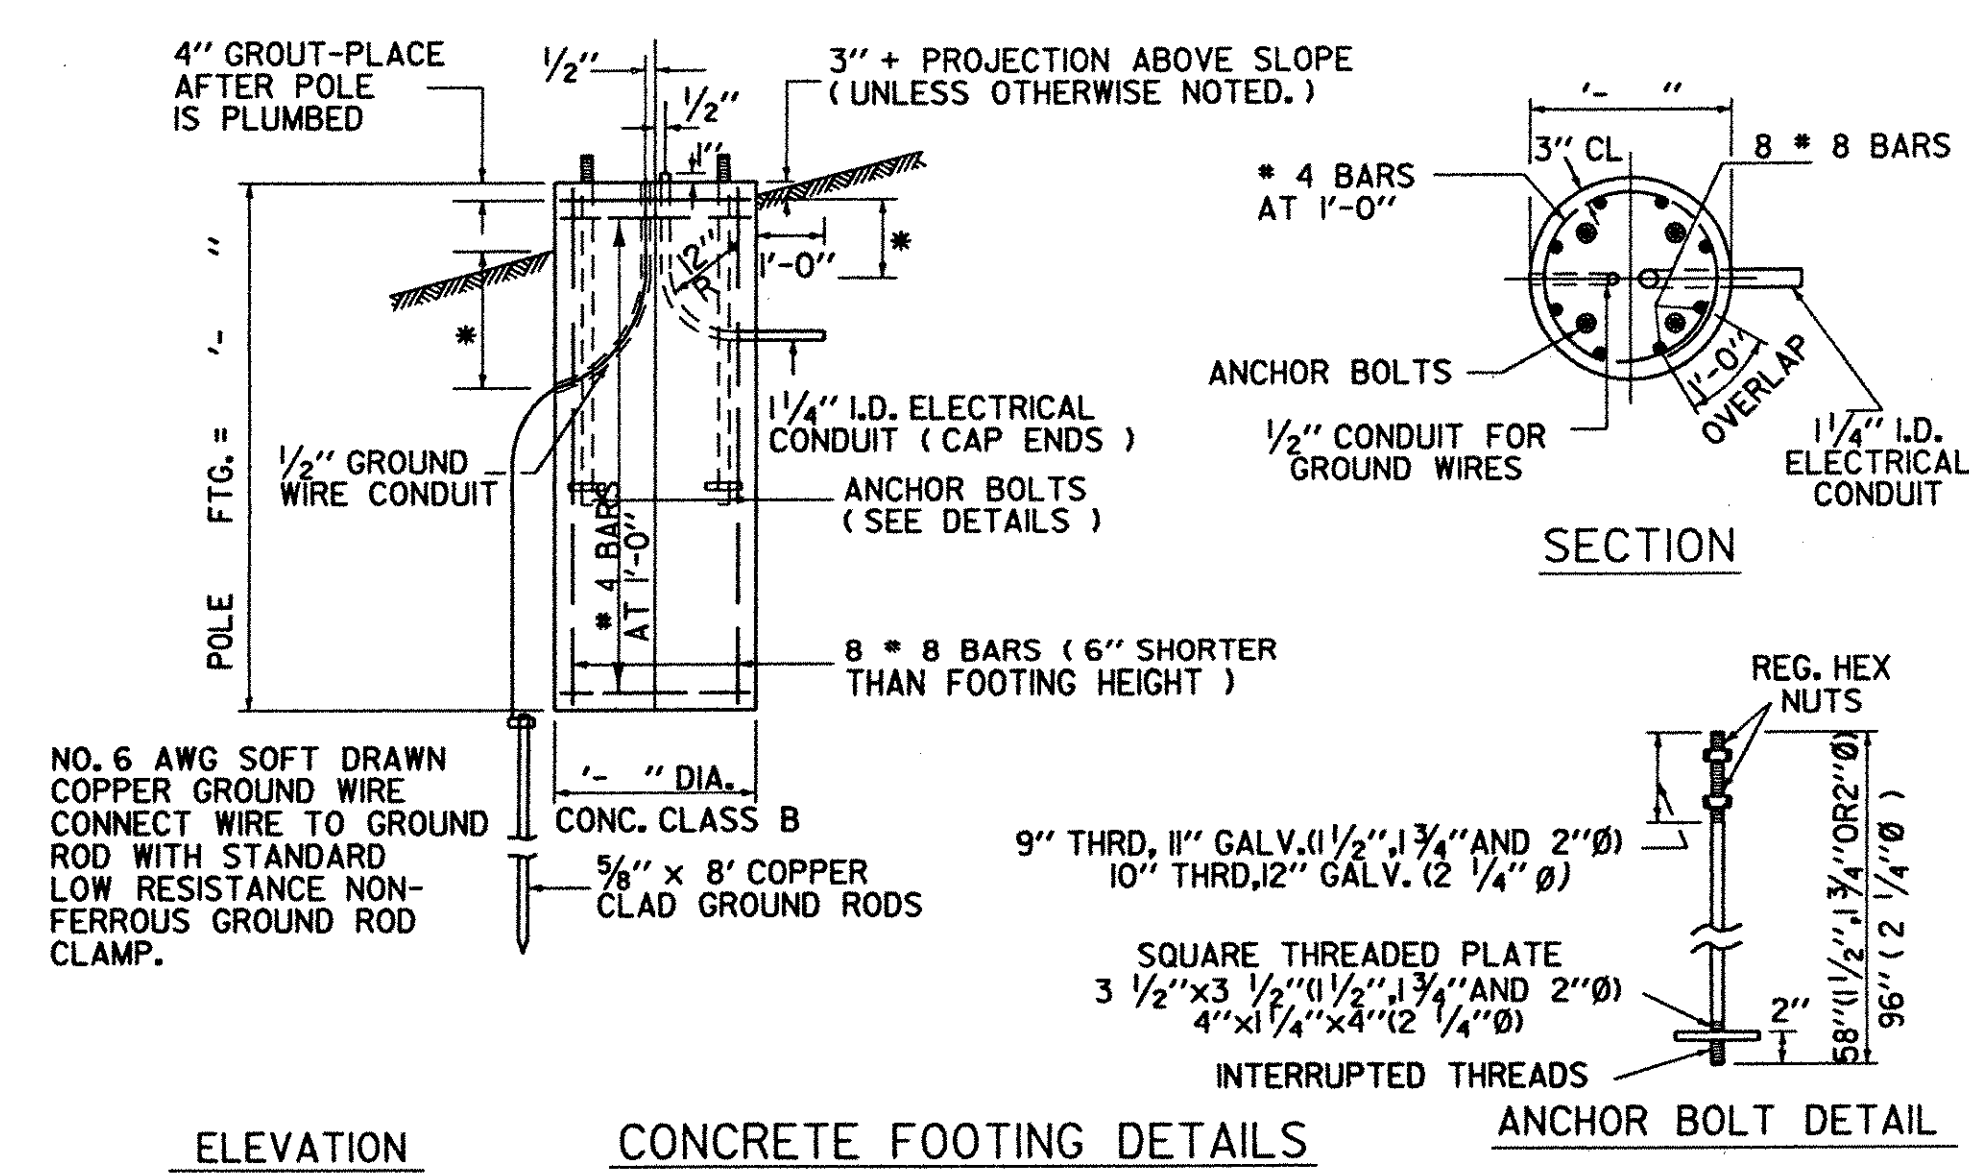

ELEVATION
CONCRETE FOOTING DETAILS
ANCHOR BOLT DETAIL