



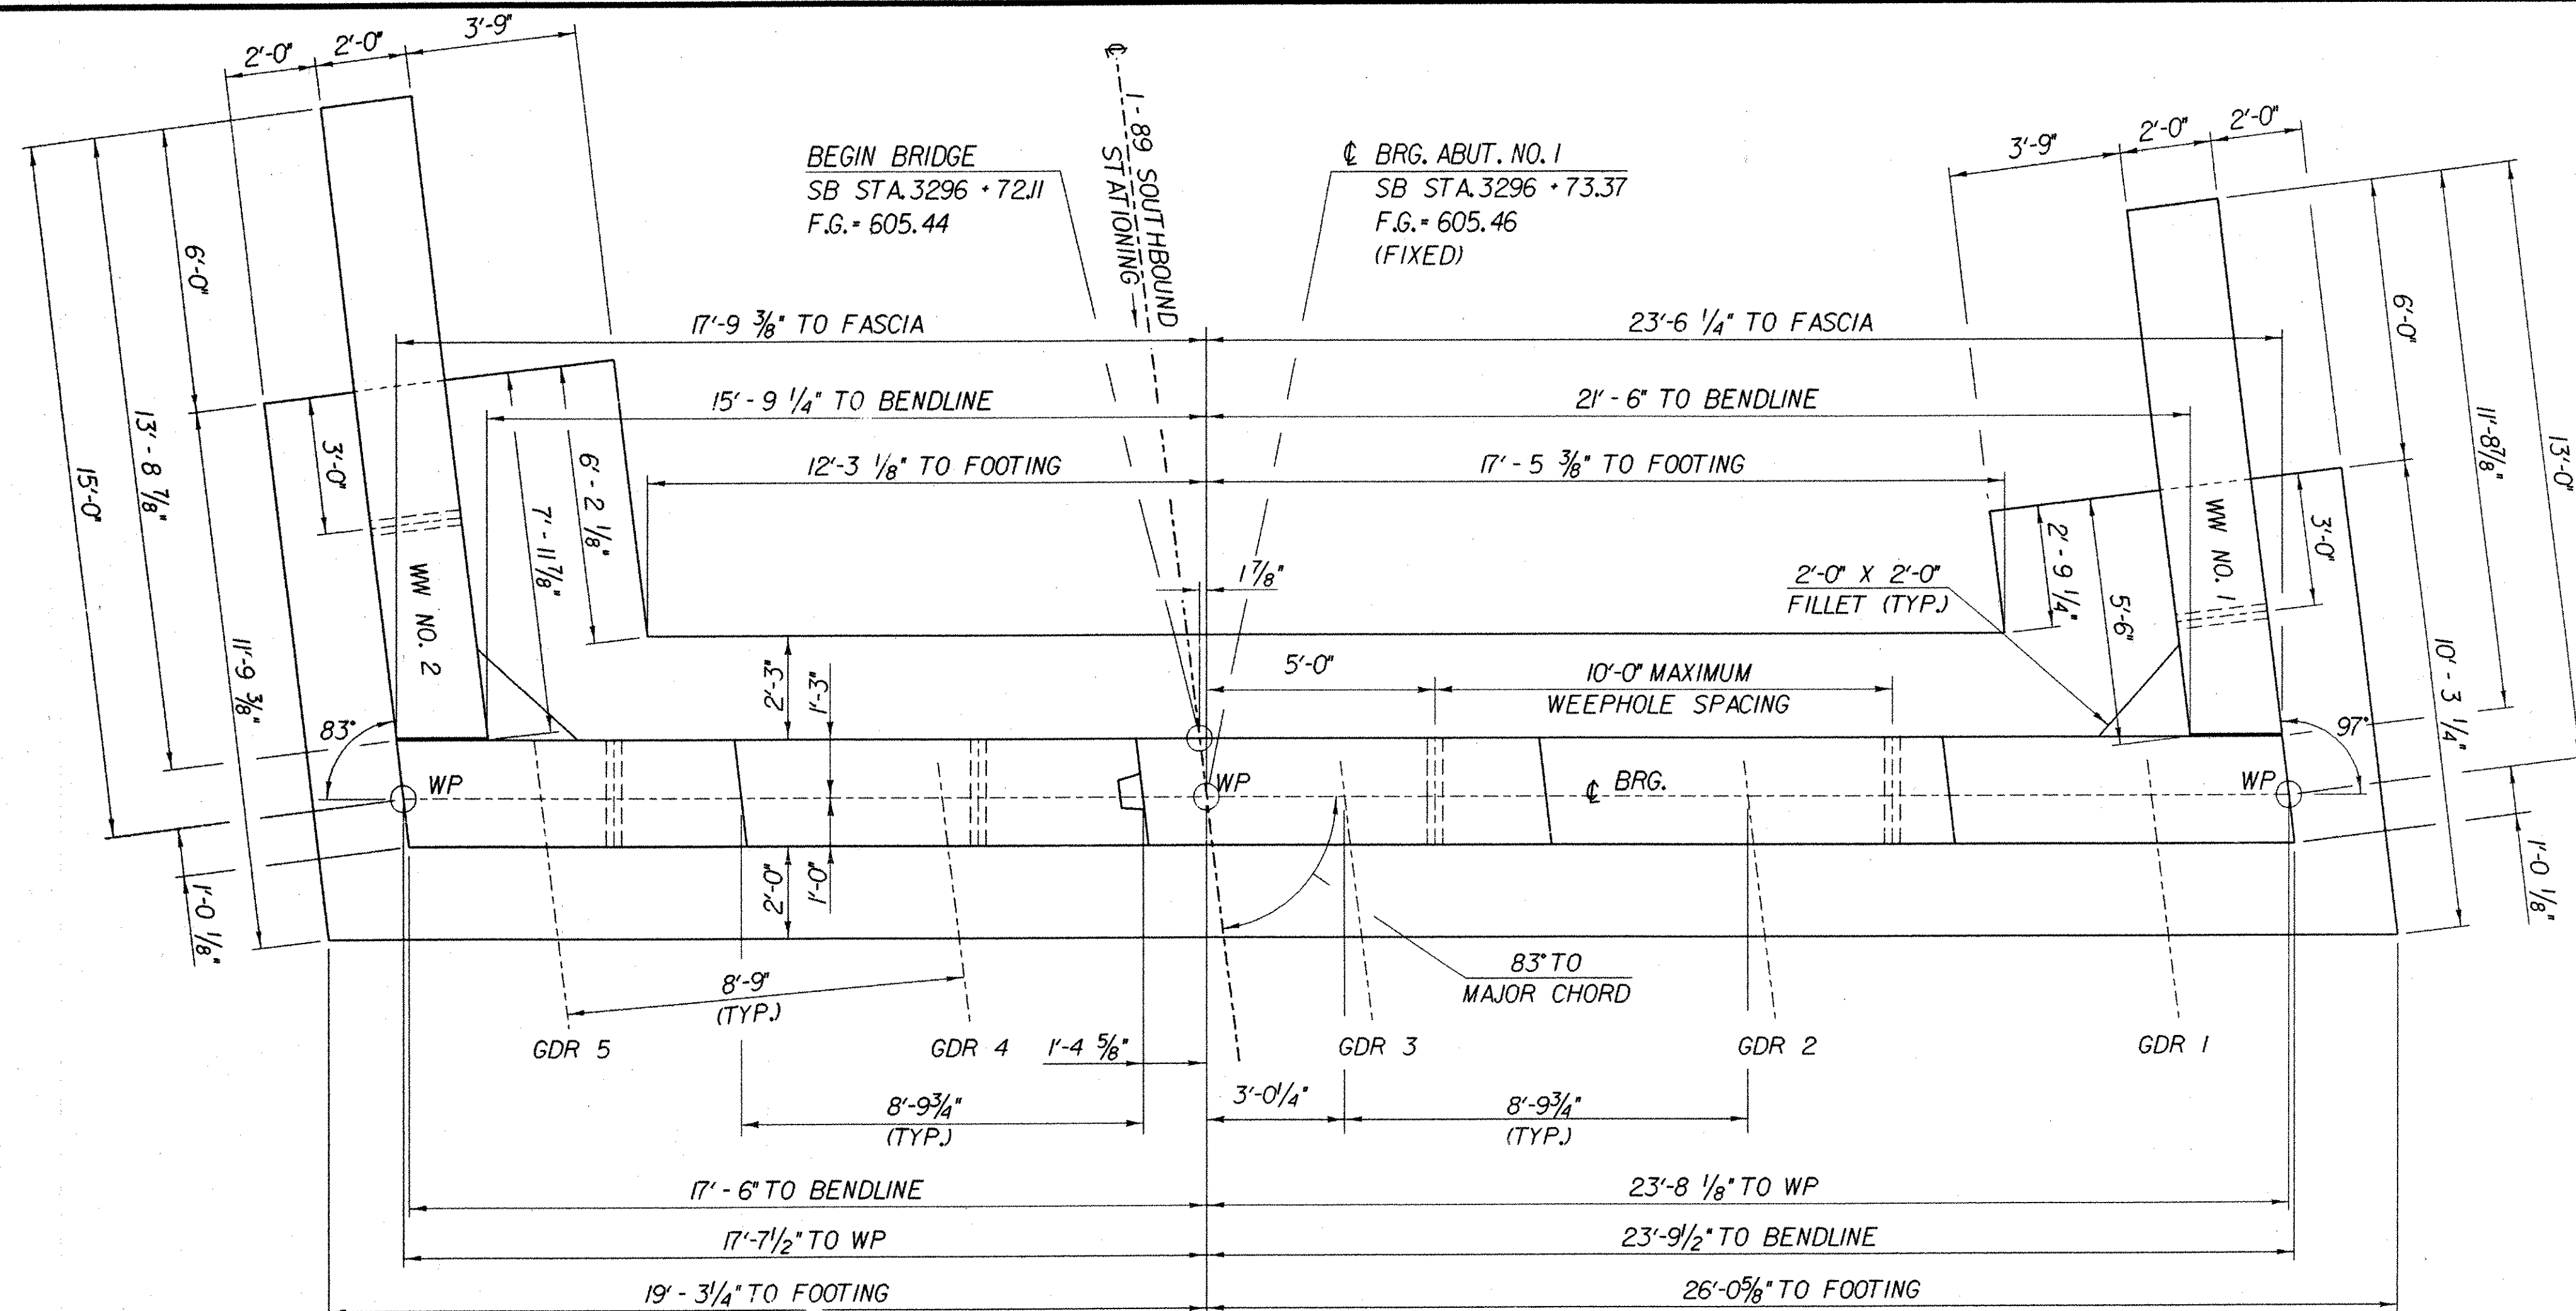


ABUTMENT NO. 1 PLAN

SCALE: $\frac{3}{8}$ " = 1'-0"

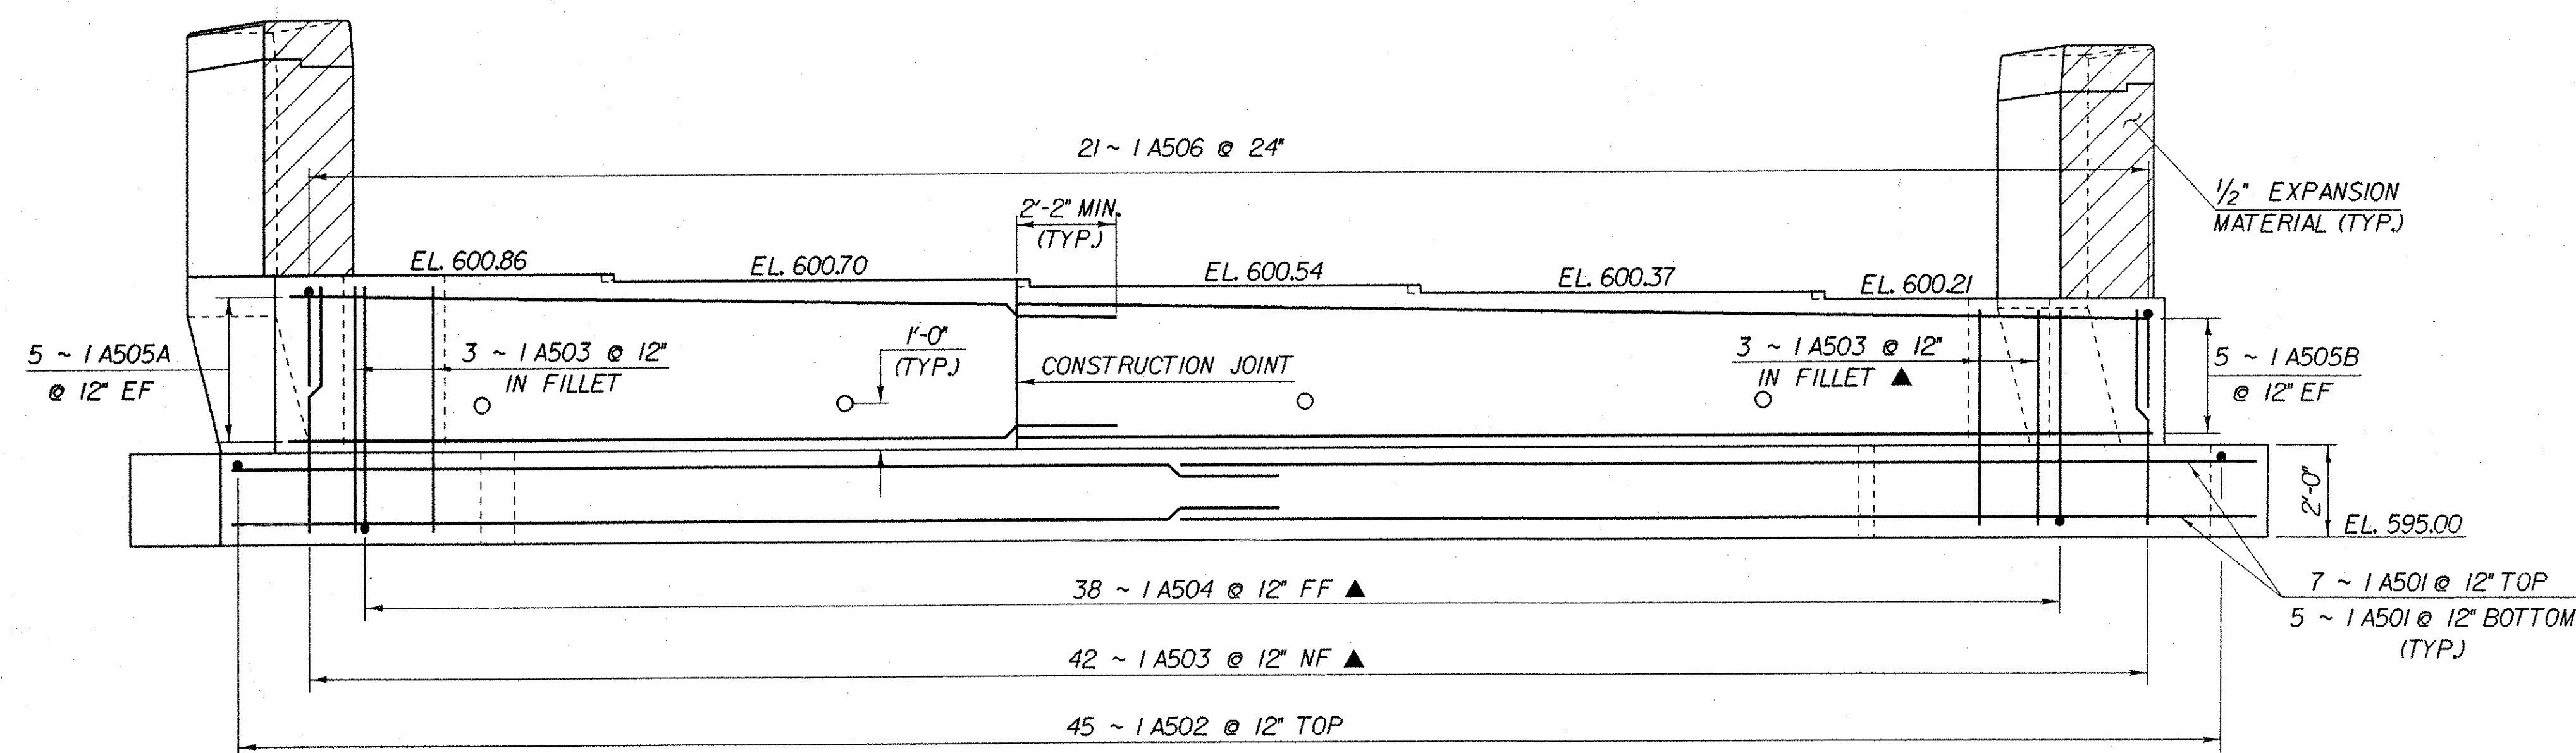

ABUTMENT NO. 1 ELEVATION

SCALE: $\frac{3}{8}$ " = 1'-0"

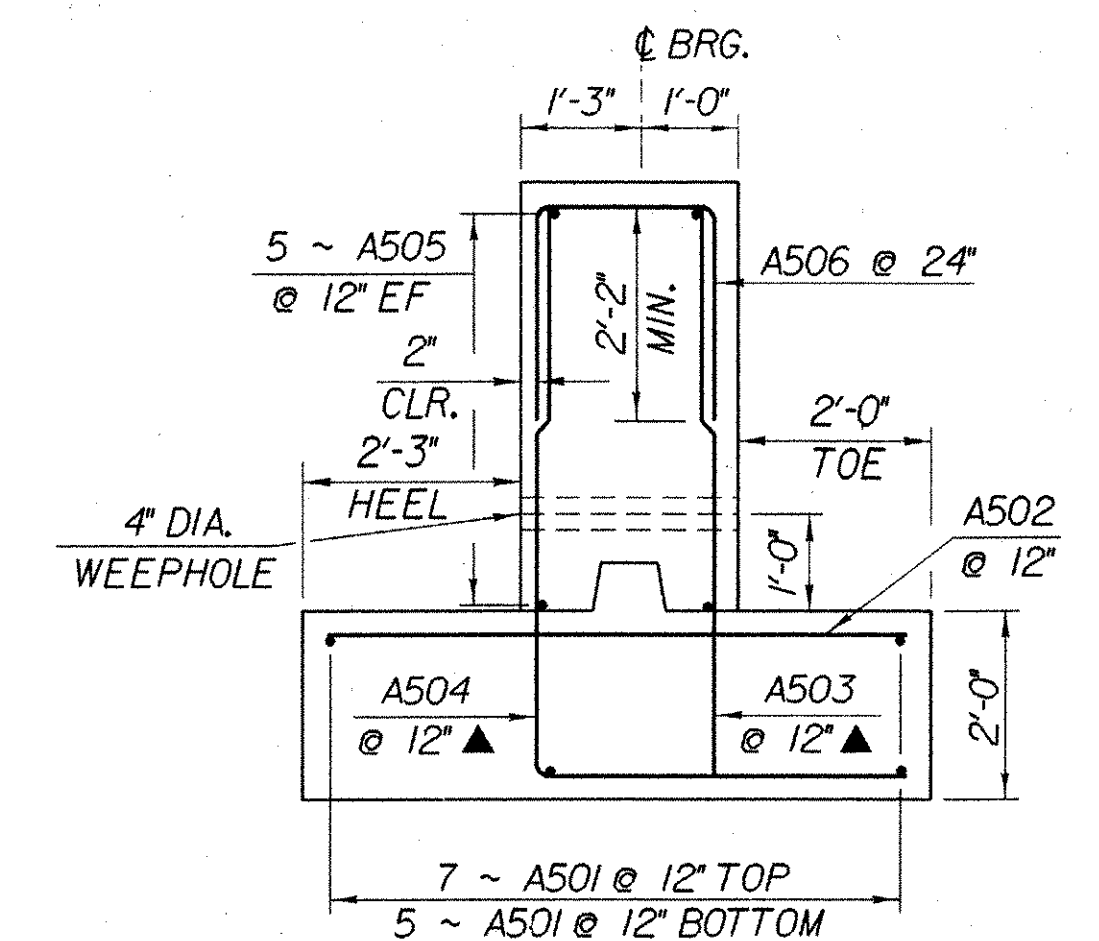

ABUTMENT TYPICAL

SCALE: $\frac{1}{2}$ " = 1'-0"

NOTE:

NF = NEAR FACE
FF = FAR FACE
EF = EACH FACE
▲ = CUT TO FIT IN FIELD
3" CLR. UNLESS OTHERWISE SPECIFIED ON THE PLANS.

STATE OF VERMONT AGENCY OF TRANSPORTATION			
Town Of FAIRFAX-FAIRFIELD-ST. ALBANS	Bridge No.	87S	
Highway No.	1-89	Log Sta.	
		Surv. Sta.	
1-89 OVER VT 104			
ABUTMENT NO. 1 DETAILS			
Designed By M. LOZIER	Date	Drawn By K. CHISHOLM	Date
Checked By GRY	10/99	Bridge Design Supervisor R.R. WHITCOMB	Date 11/99
PROJECT FAIRFAX-FAIRFIELD-ST. ALBANS		PROJECT NO. 1M 089 - 3 (27)	
I.G.C. Info. 94\106\Structures\106ab.dgn		so056ab1	
Bridge Sheet No. BR220		Sheet 98 of 370	

IMPORTANT NOTE: BRIDGE FINISHED GRADES ARE CENTERLINE GRADES.