




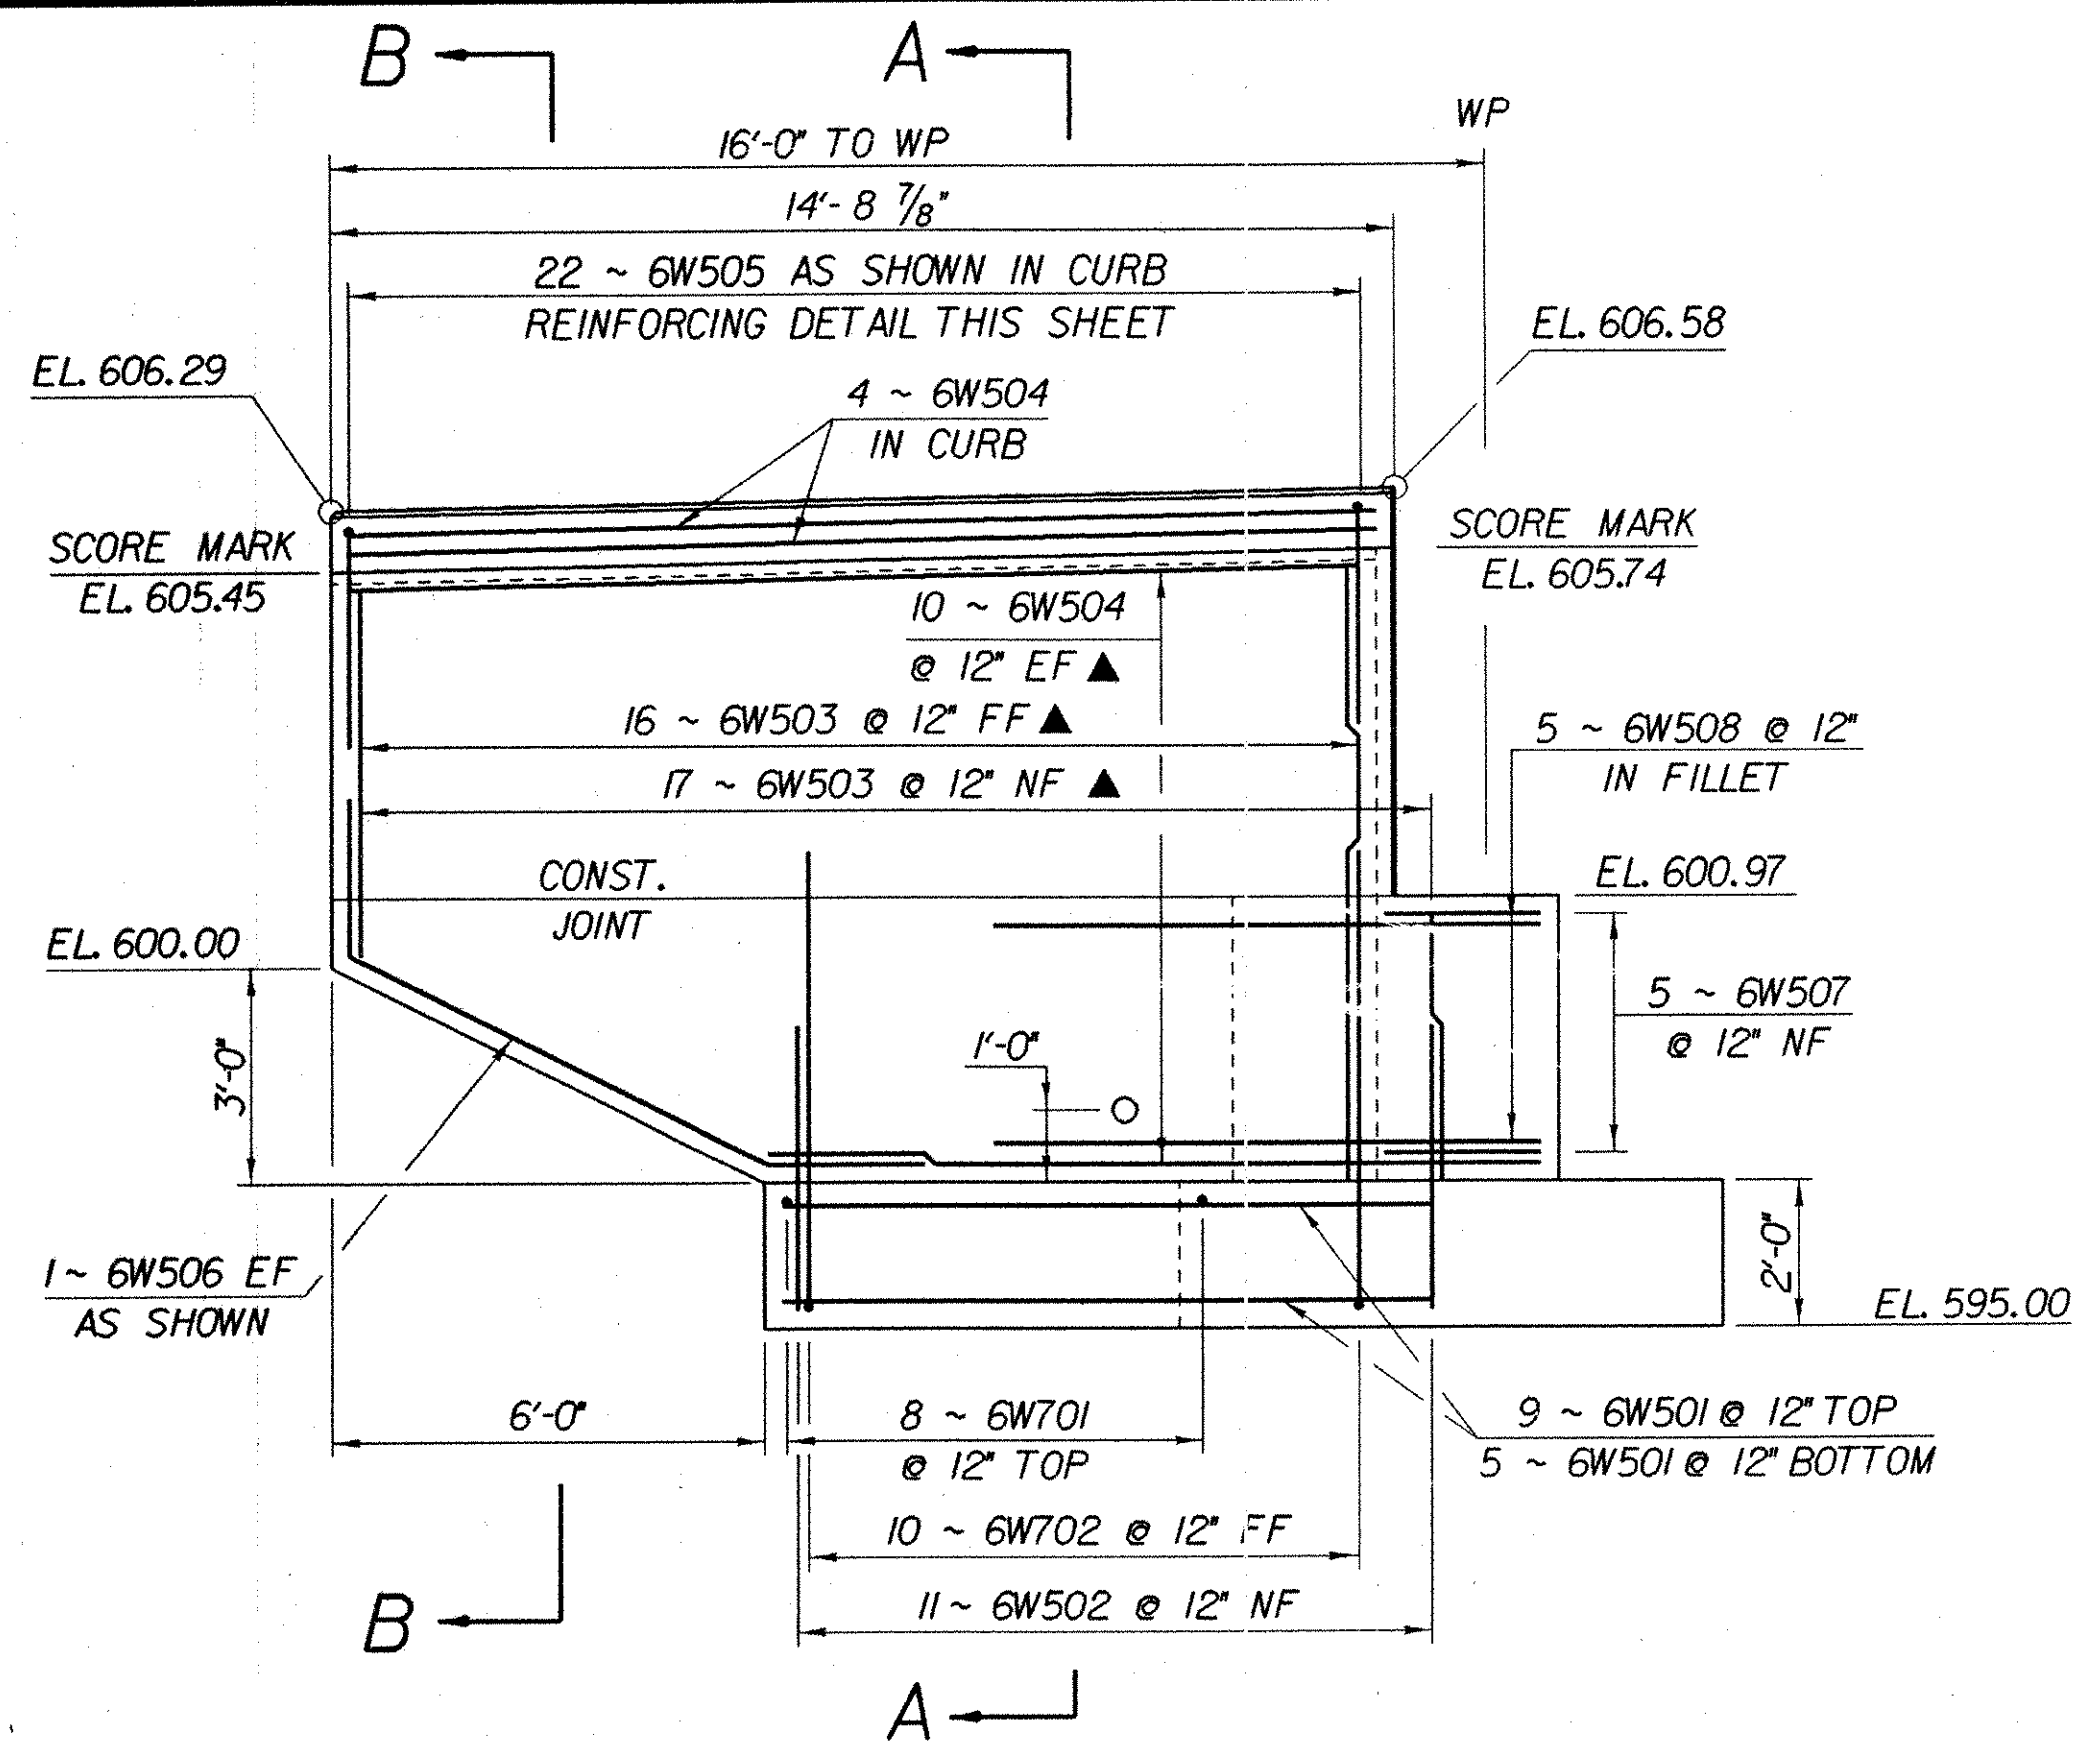


WINGWALL NO. 6
SCALE: 3/8" = 1'-0"

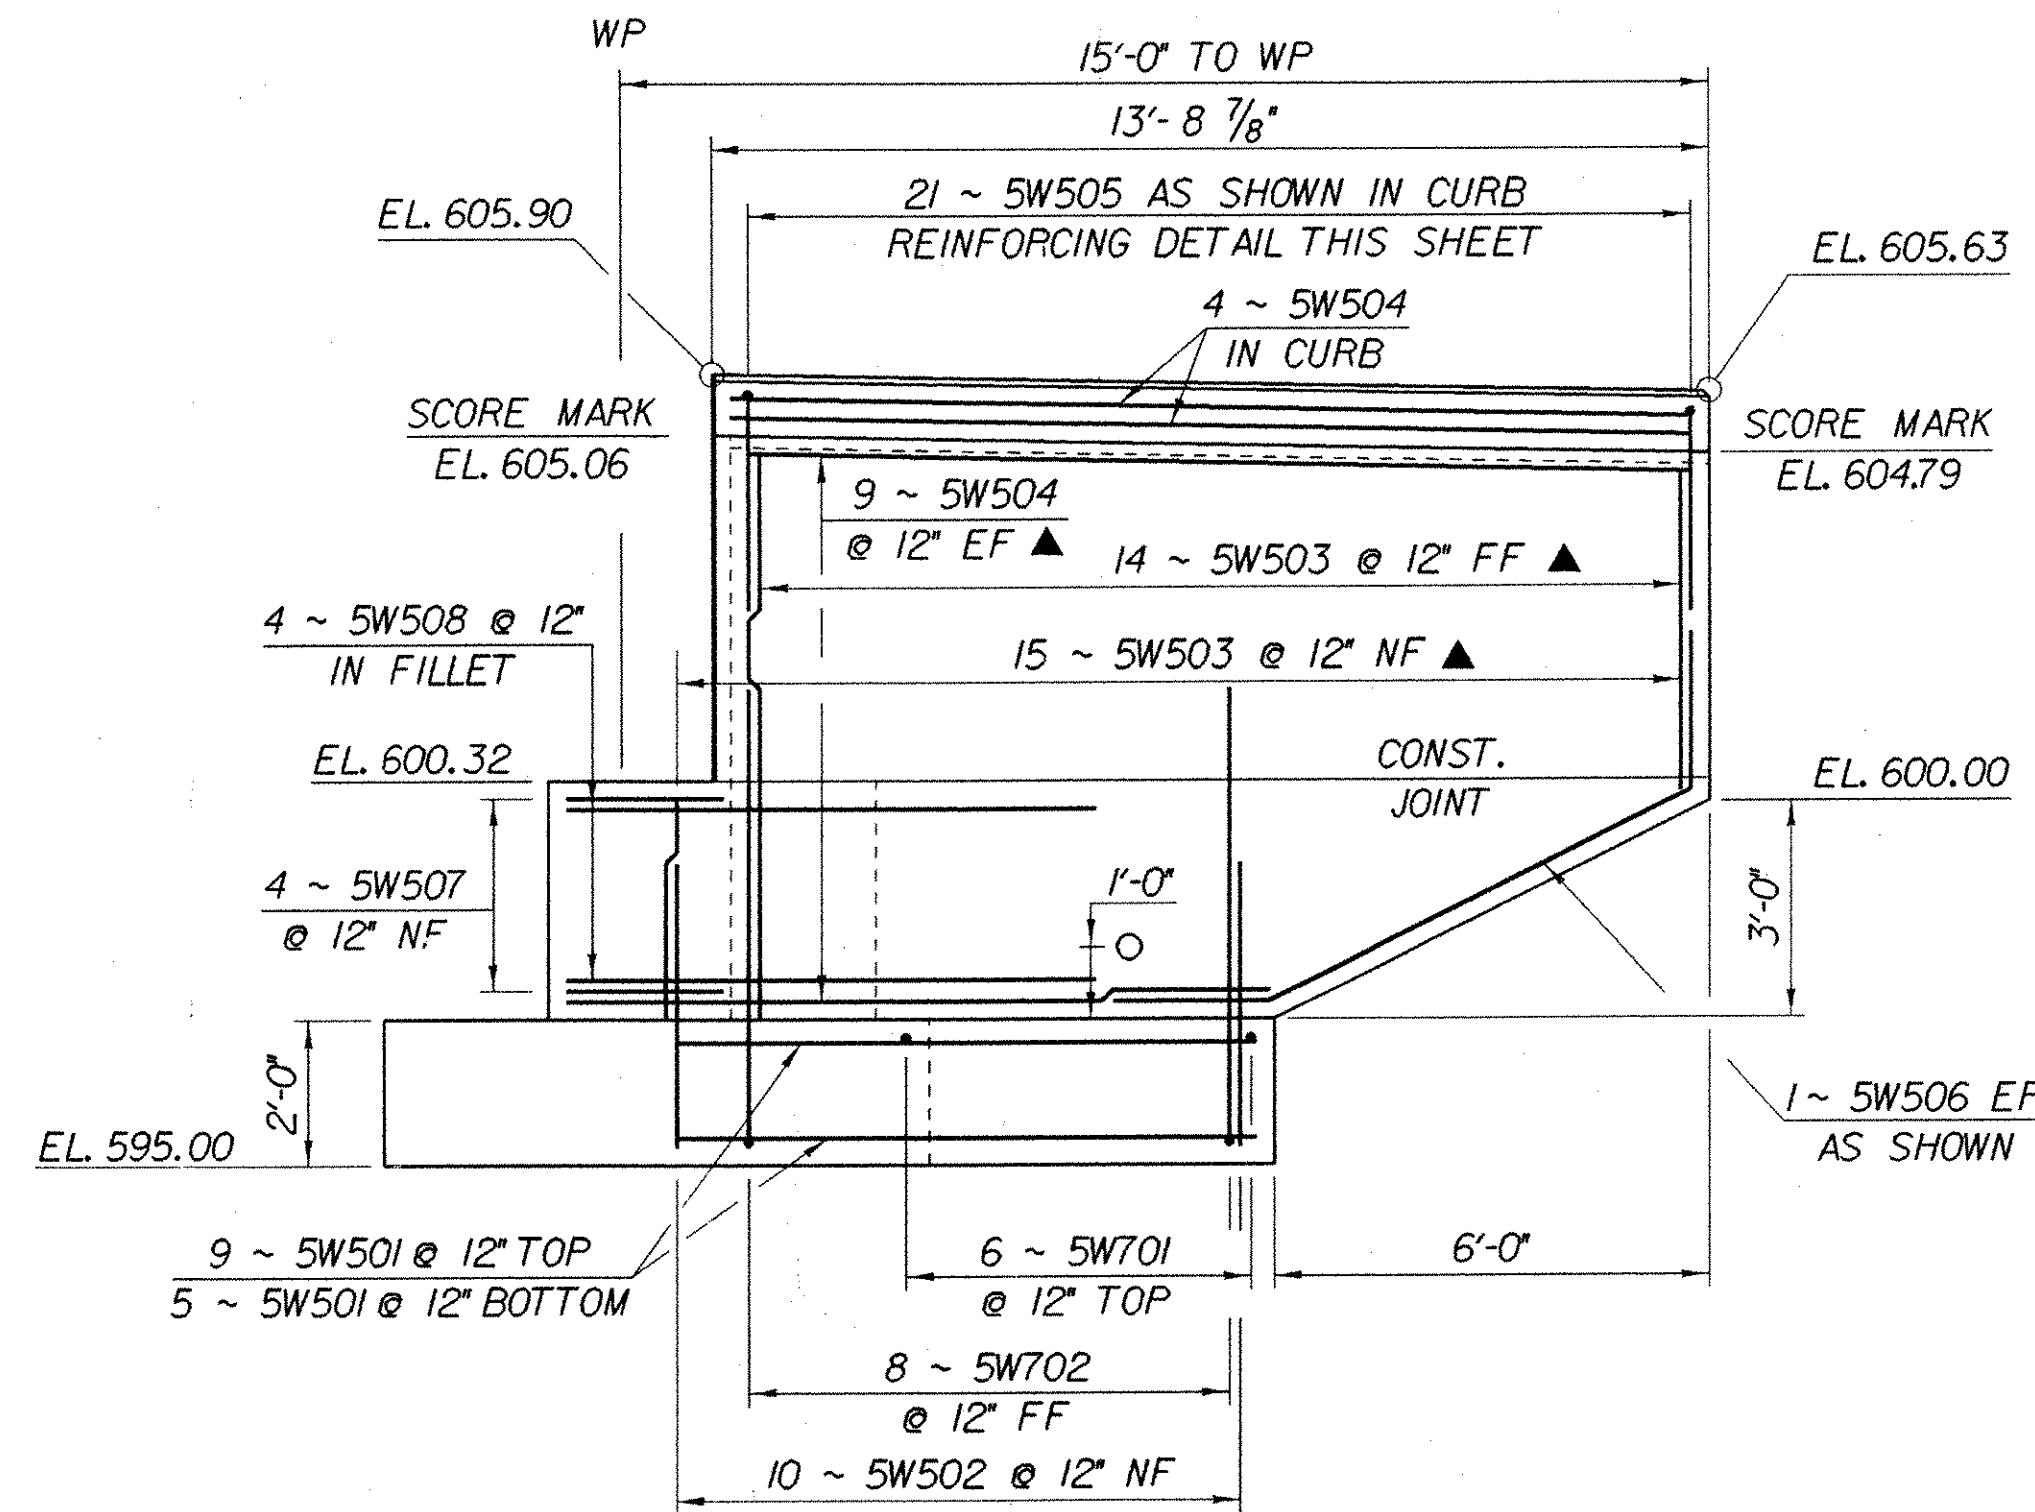

WINGWALL NO. 5
SCALE: 3/8" = 1'-0"

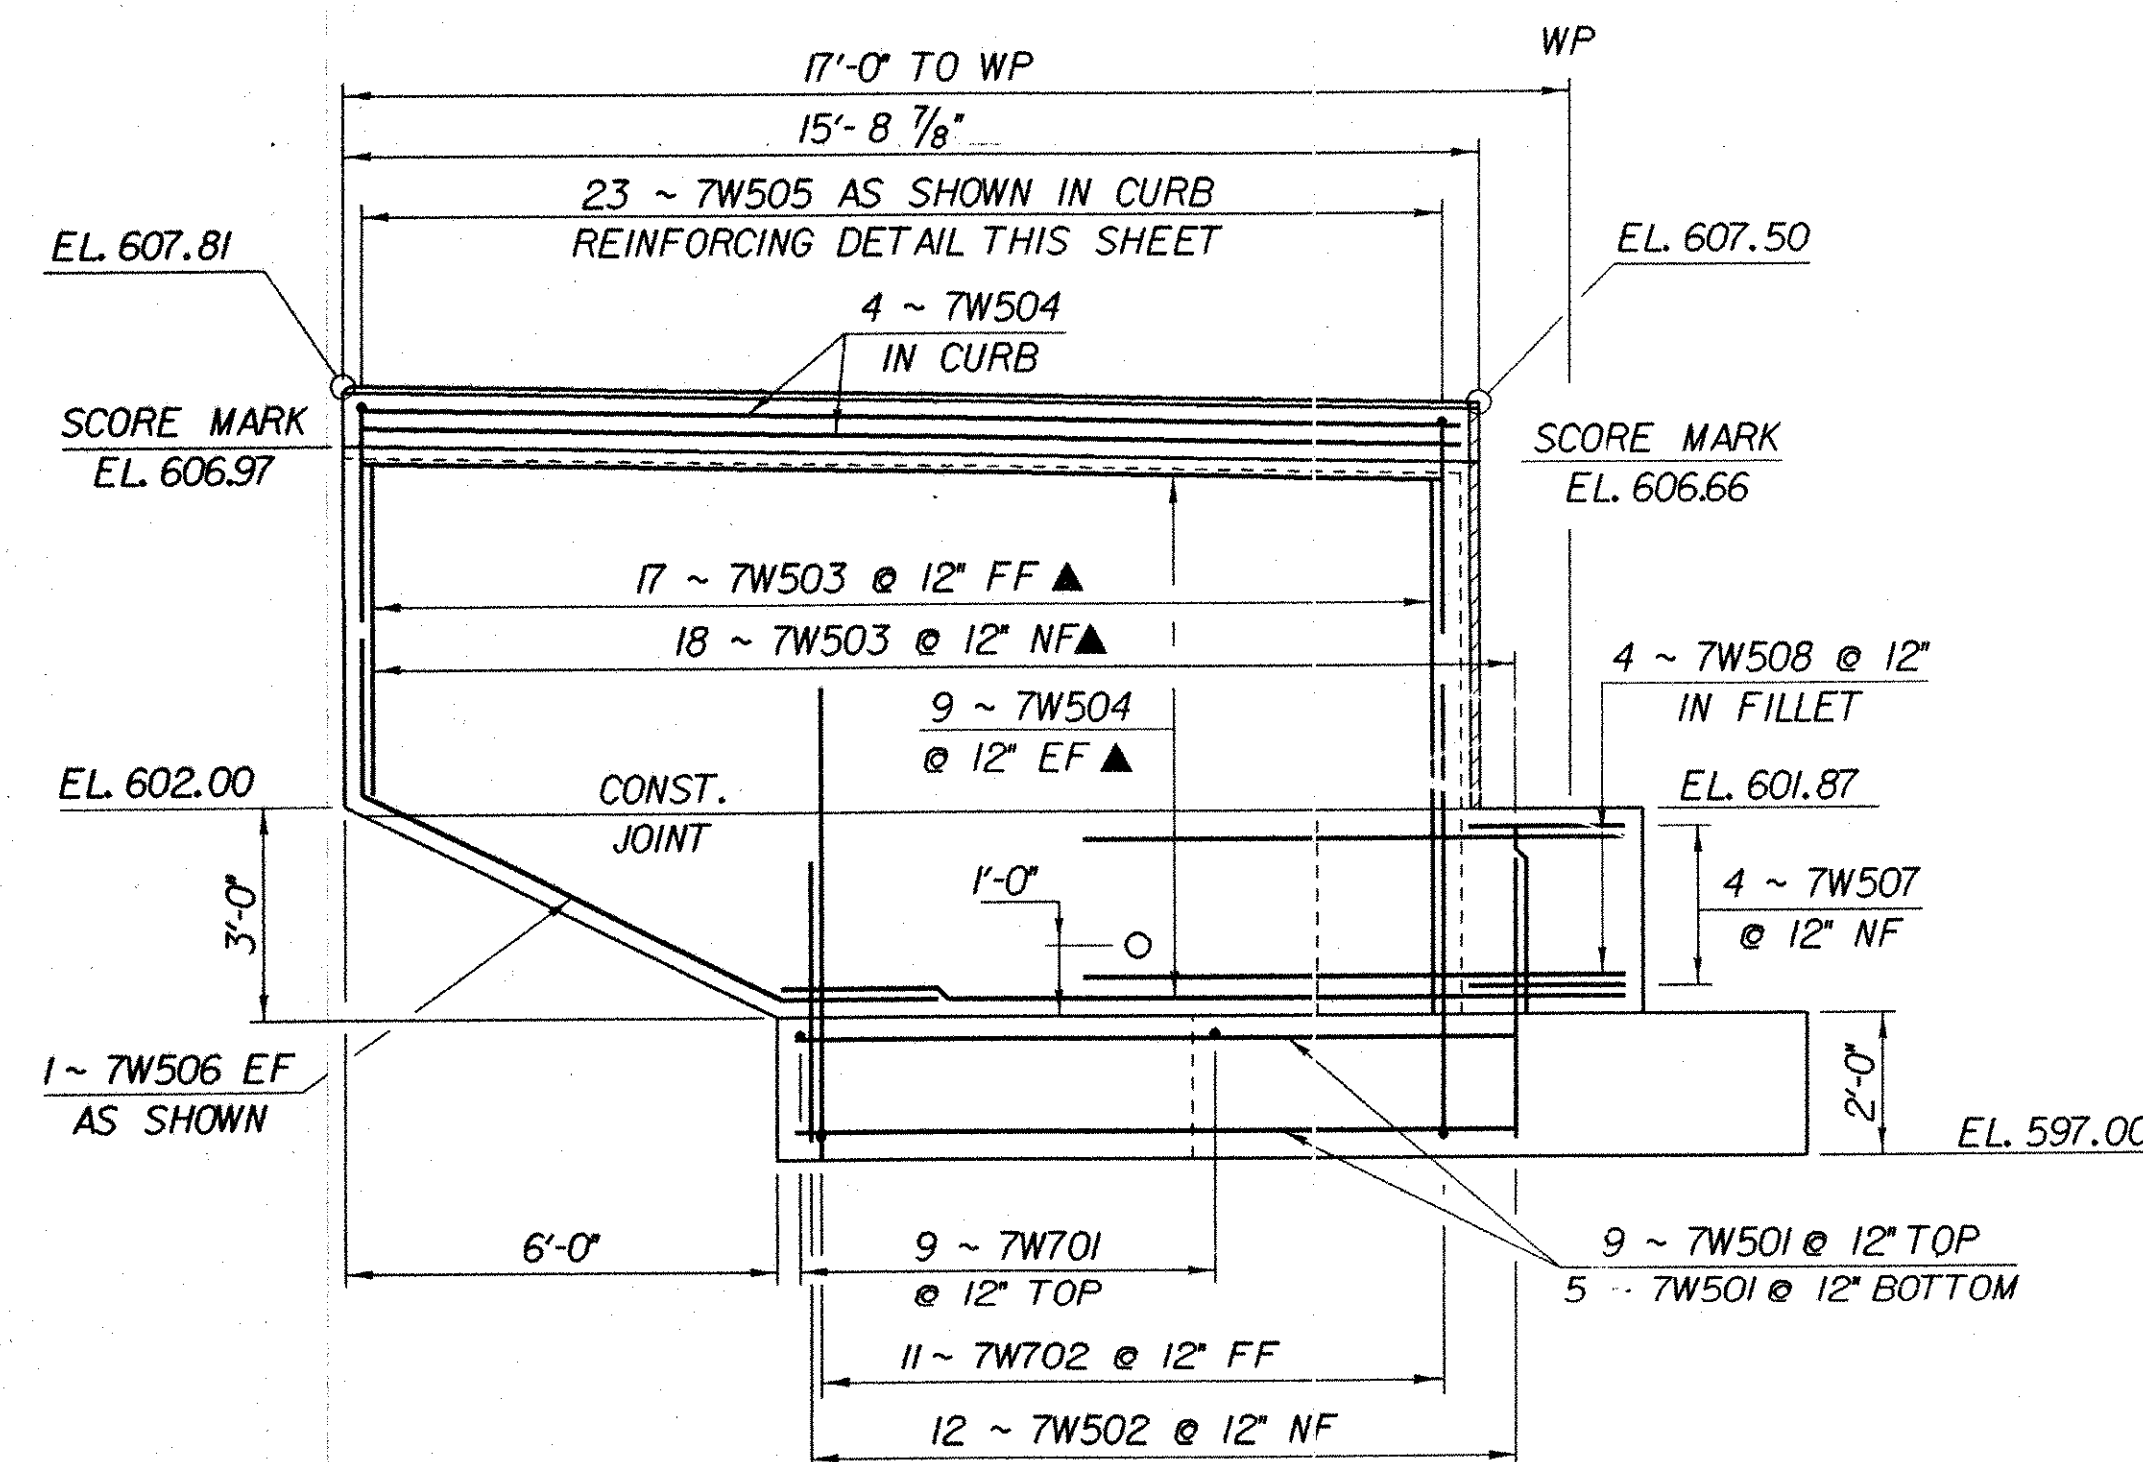


WINGWALL NO. 7
SCALE: 3/8" = 1'-0"

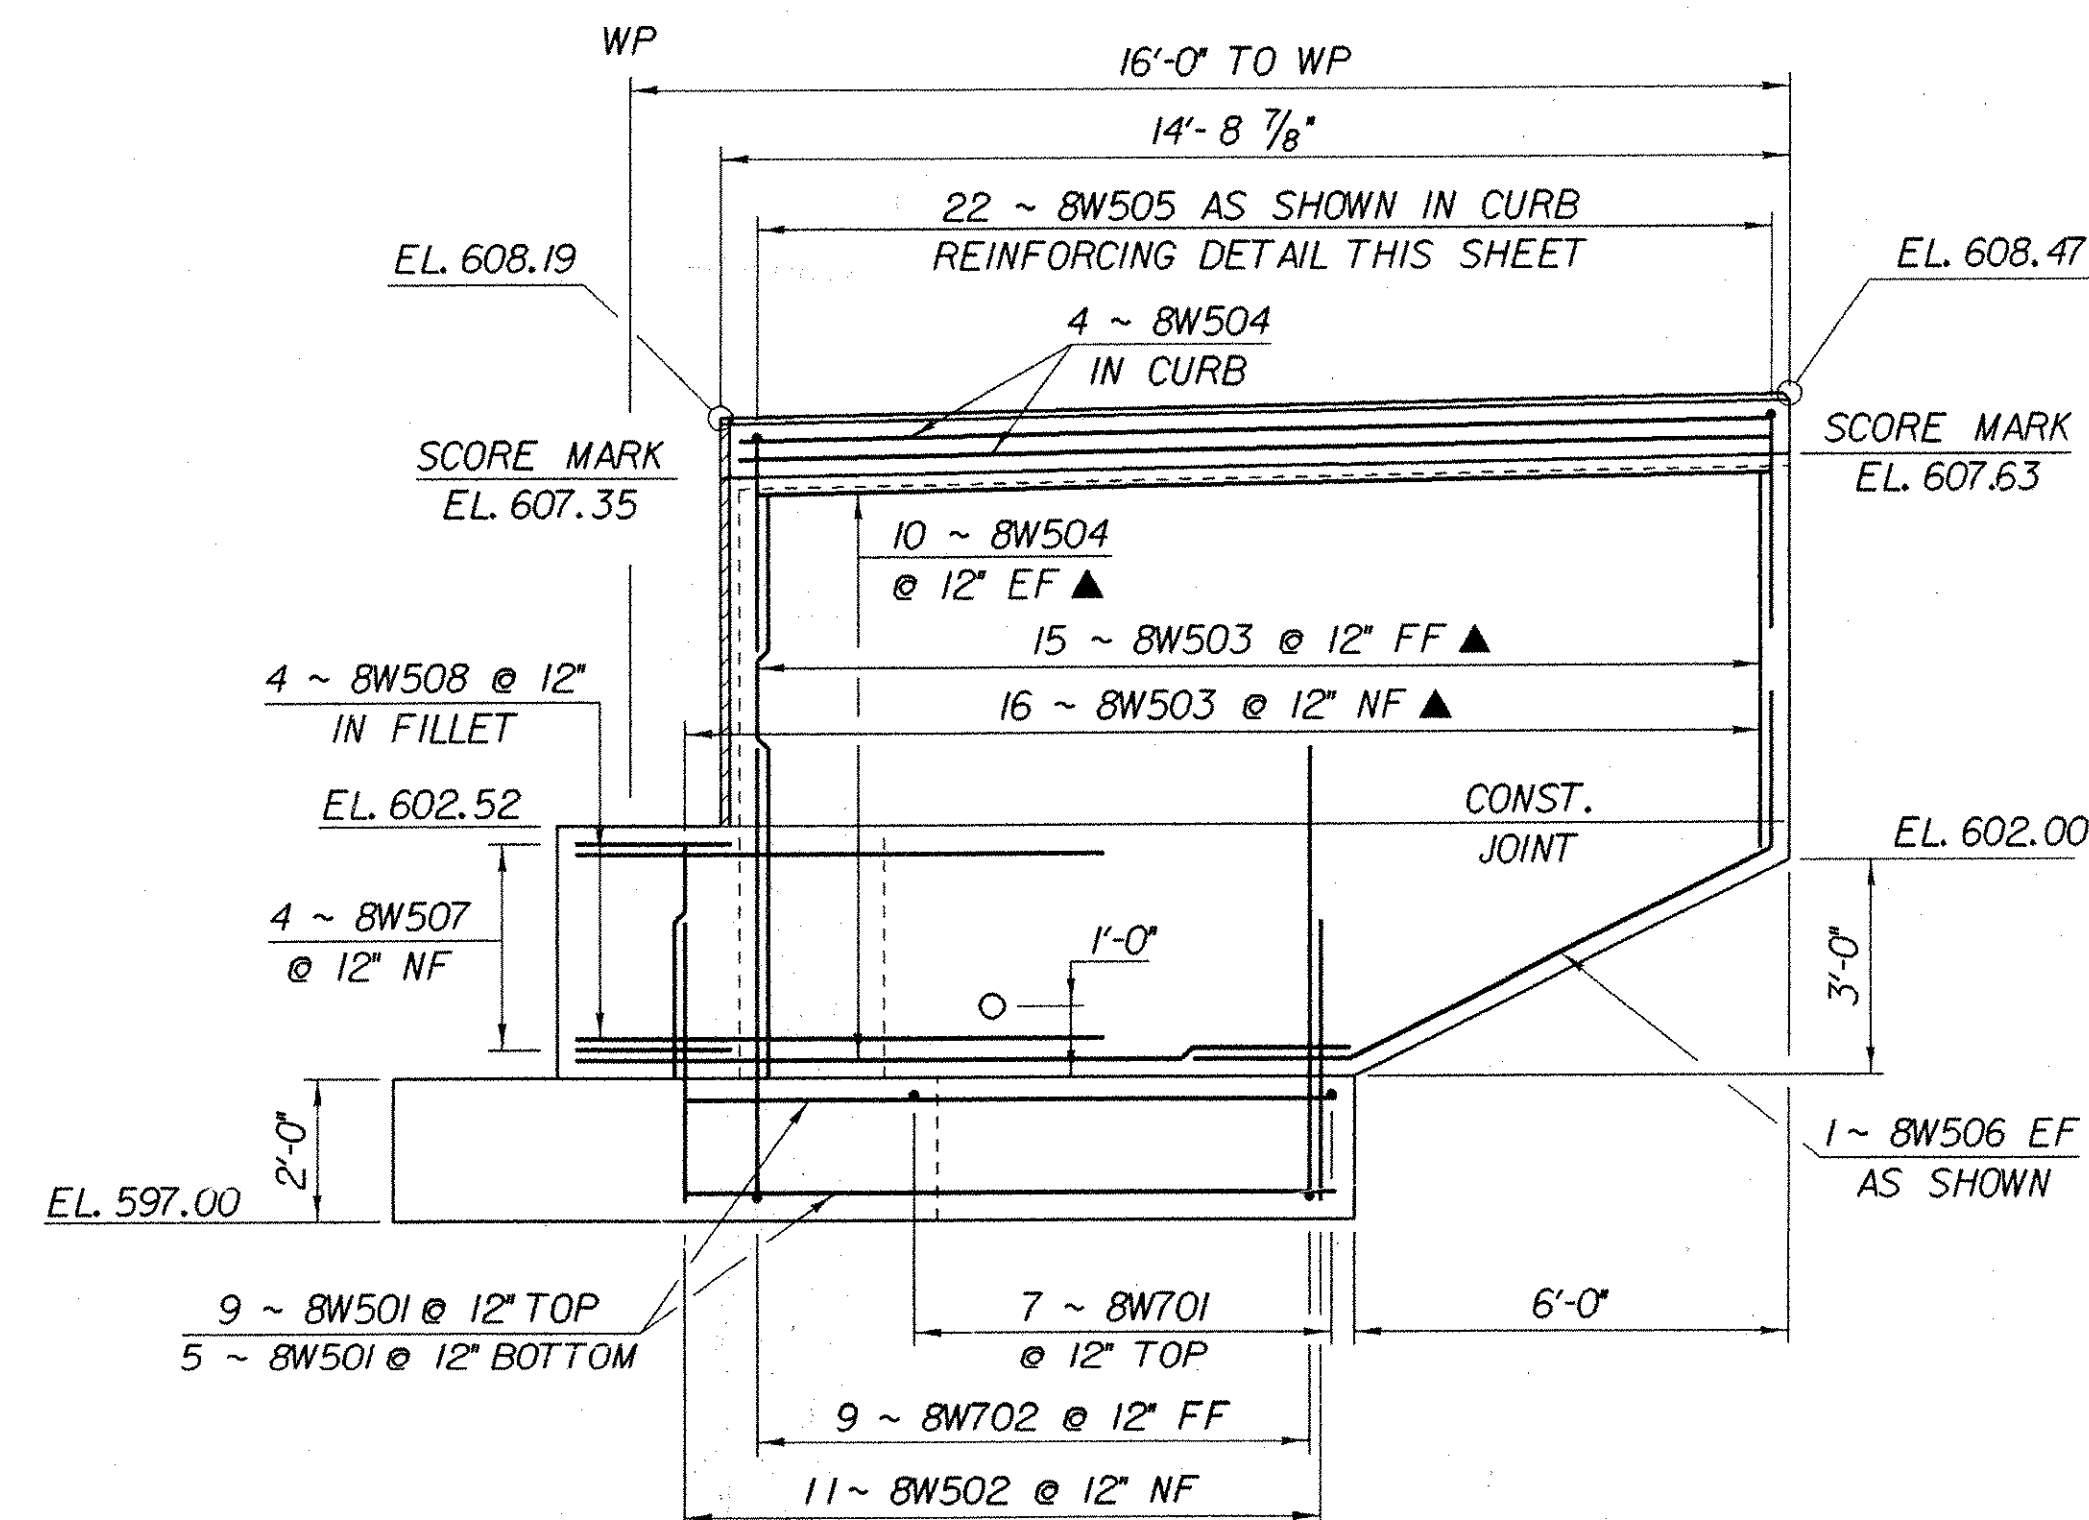


WINGWALL NO. 8
SCALE: 3/8" = 1'-0"


IMPORTANT NOTE: BRIDGE FINISHED GRADES ARE CENTERLINE GRADES.

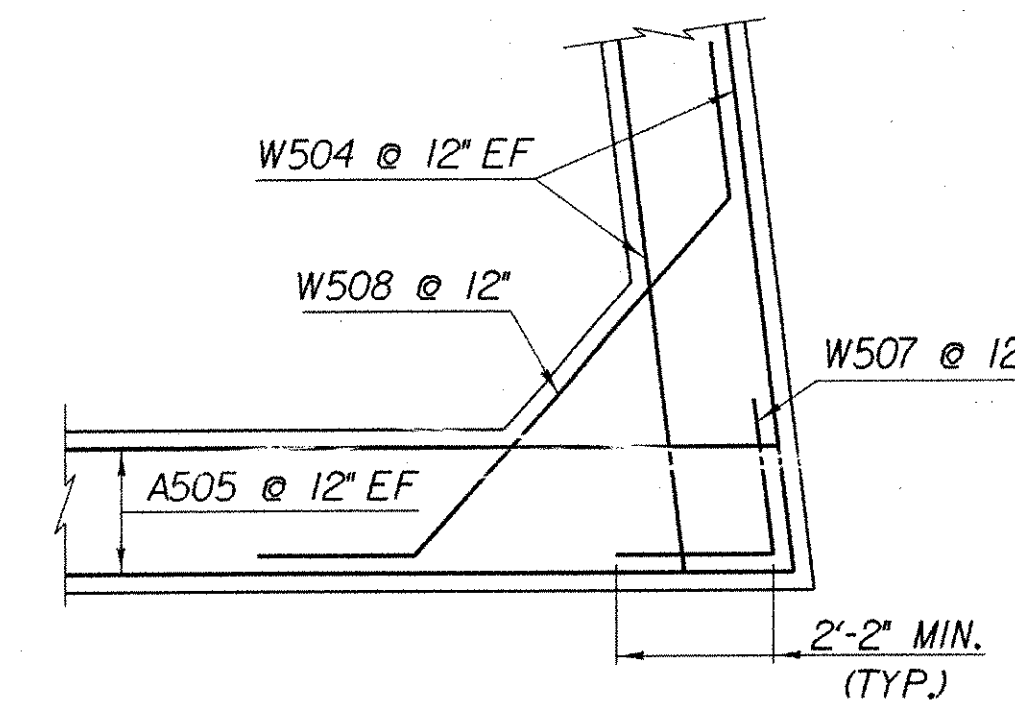


**WINGWALL CORNER DETAIL
BELOW BRIDGE SEAT**
SCALE: 3/8" = 1'-0"

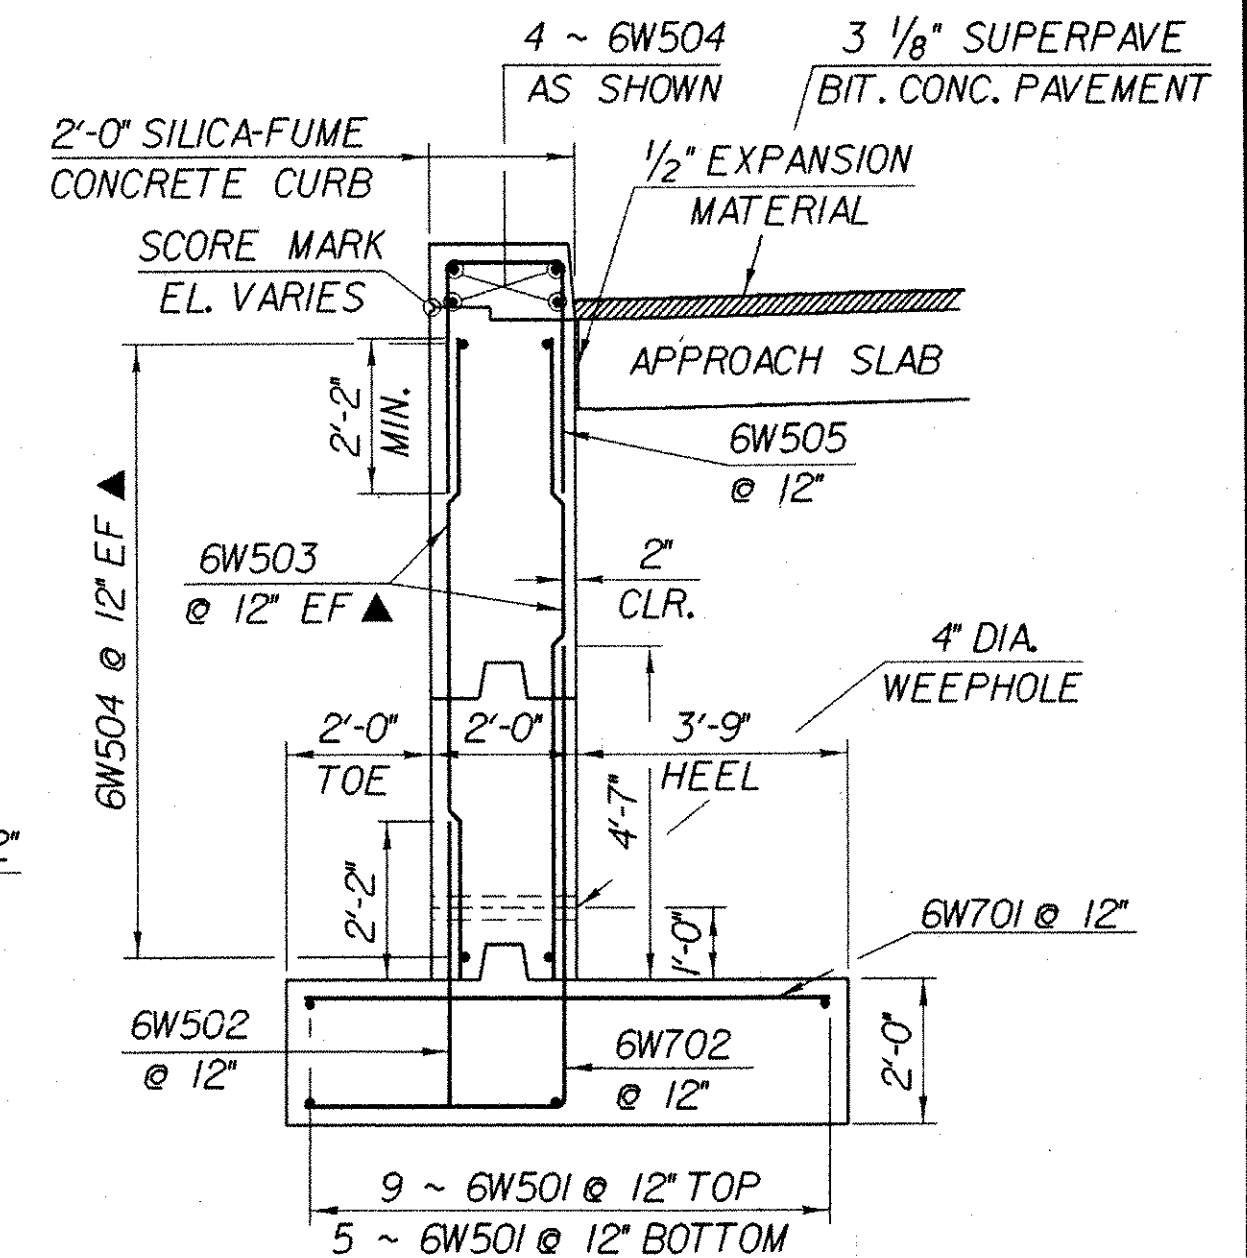

**WINGWALL NO. 6 TYPICAL
SECTION A-A**
SCALE: 3/8" = 1'-0"
(WINGWALLS 5, 7 & 8 SIMILAR)

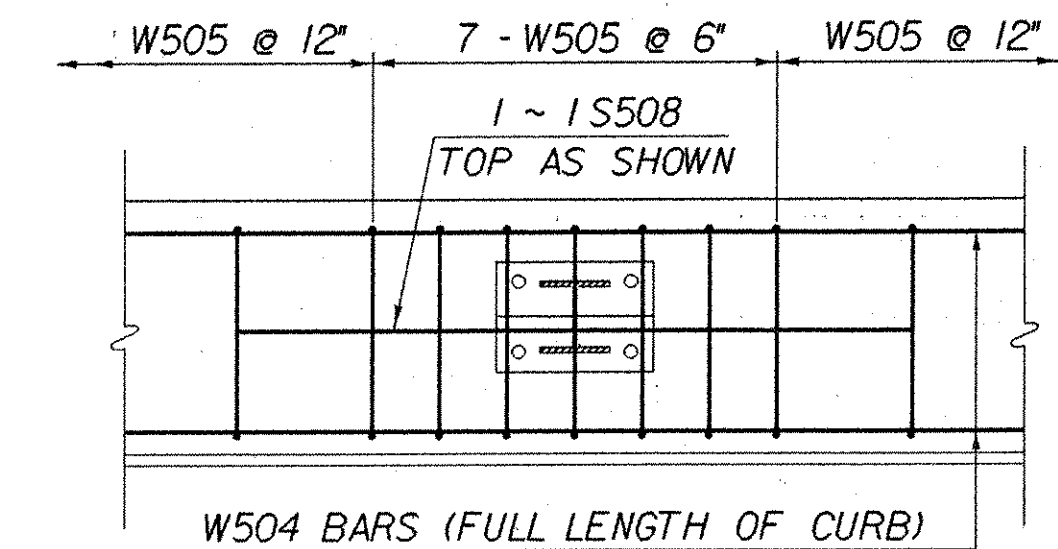

CURB REINFORCING DETAIL
NTS

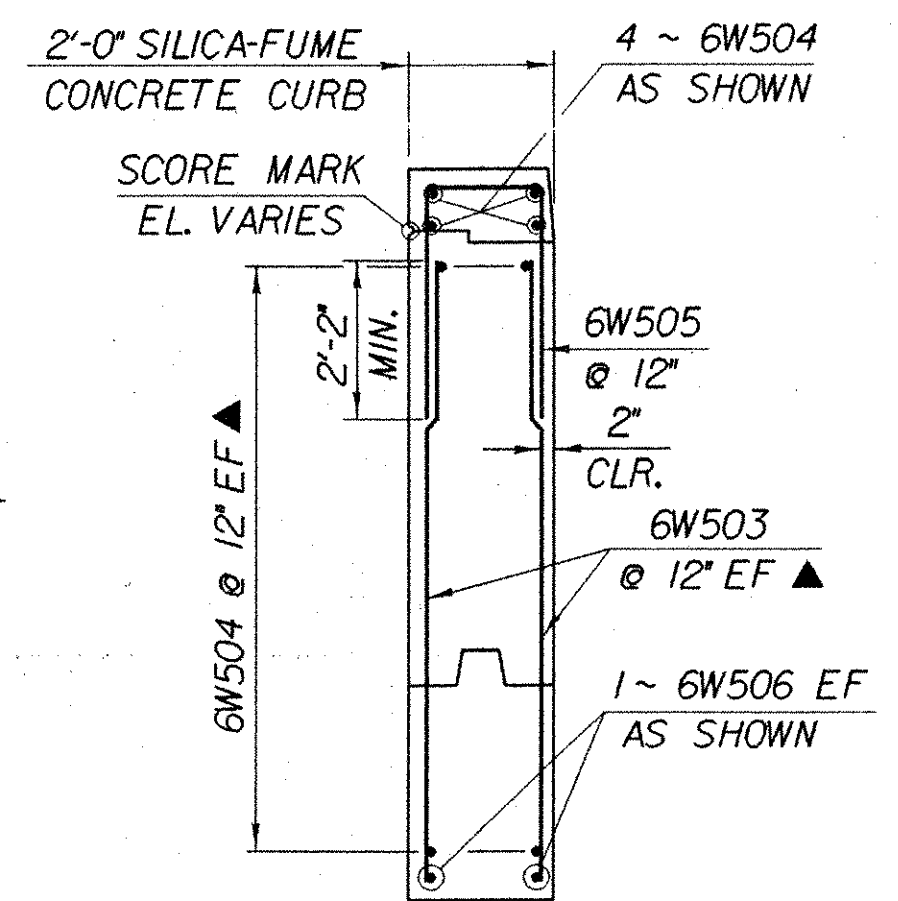

**WINGWALL NO. 6 TYPICAL
SECTION B-B**
SCALE: 3/8" = 1'-0"
(WINGWALLS 5, 7 & 8 SIMILAR)

NOTE:
NF = NEAR FACE
FF = FAR FACE
EF = EACH FACE
▲ = CUT TO FIT IN FIELD
3" CLR. UNLESS OTHERWISE SPECIFIED ON THE PLANS.

STATE OF VERMONT AGENCY OF TRANSPORTATION			
Town Of	FAIRFAX-FAIRFIELD-ST. ALBANS	Bridge No.	87N
Highway No.	1-89	Log Sta.	
		Surv. Sta.	
1-89 OVER VT 104			
WINGWALL NOS. 5 - 8 ELEVATIONS			
Designed By	M. LOZIER	Drawn By	K. CHISHOLM
Checked By		Bridge Design Supervisor	
GROY	10/99	R.R. WHITCOMB	Date 11/99
PROJECT	FAIRFAX-FAIRFIELD-ST. ALBANS	PROJECT NO.	1M 089 - 3 (27)
I.G.C. Info.	94/106Structures/106abdg	so056ww2j	
Bridge Sheet No.	BR227	Sheet	105 of 370