
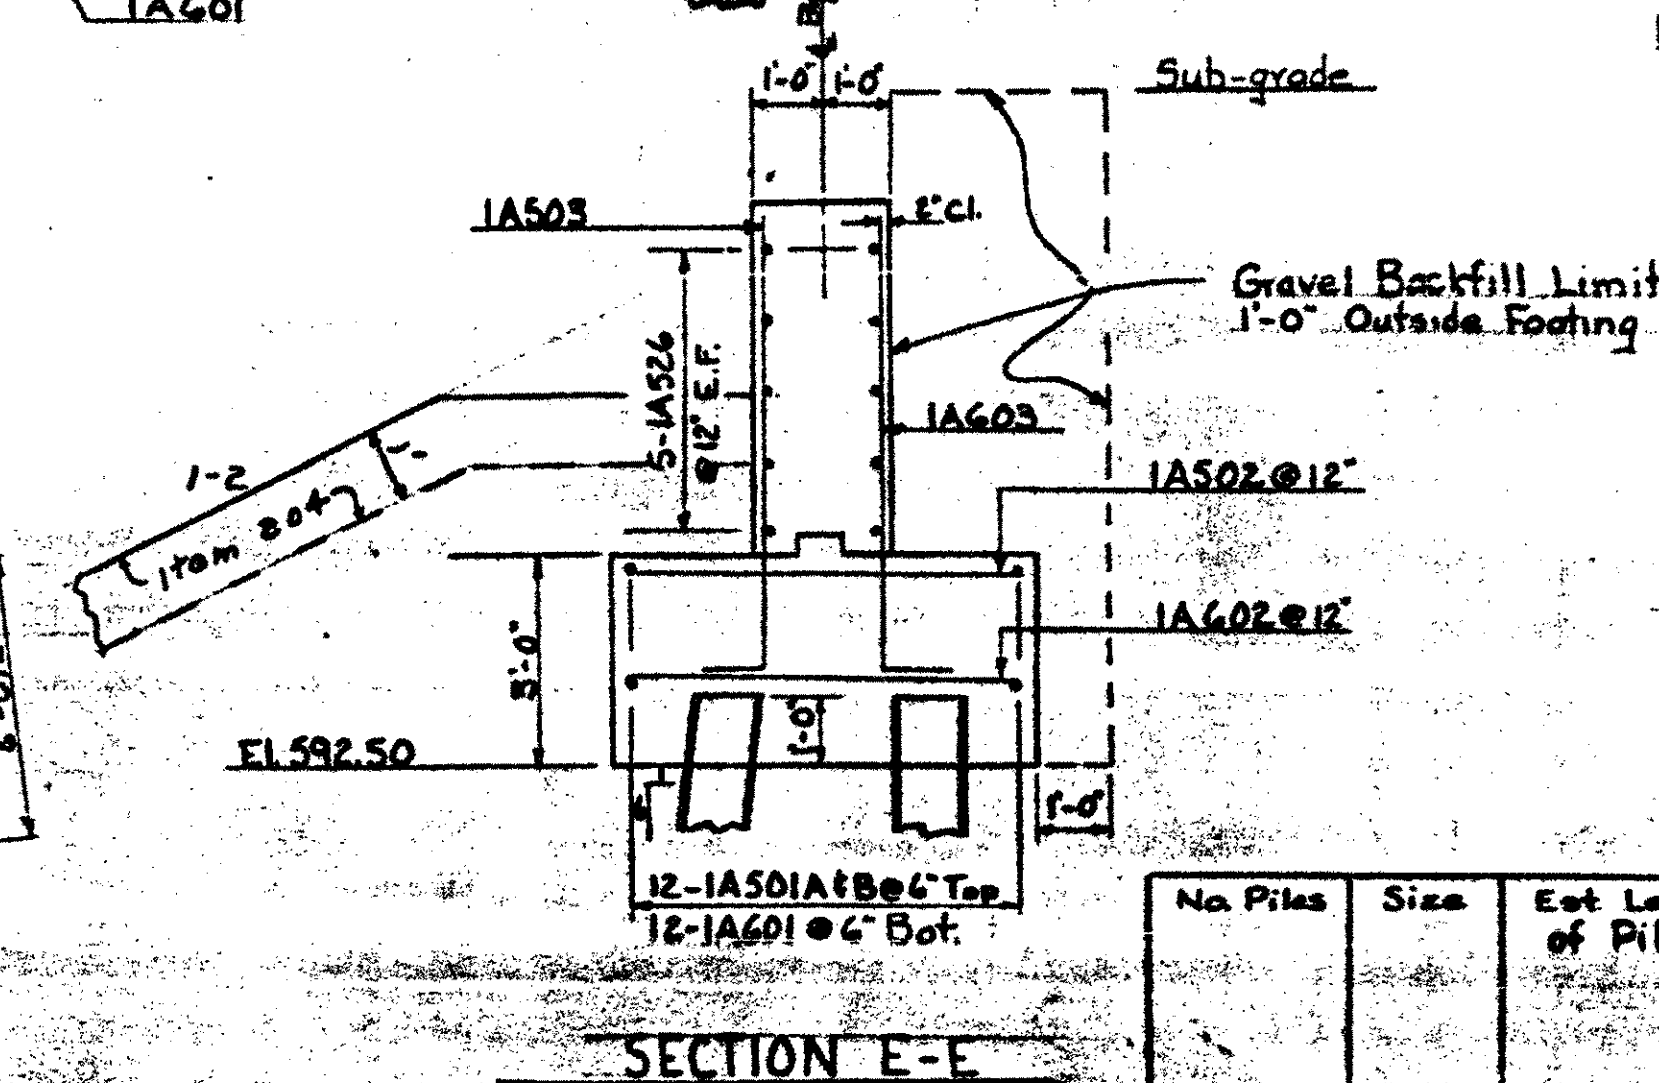


BRIDGE SHEET BR241
REFERENCE SHEET 3 OF 9
SHEET 119 OF 370

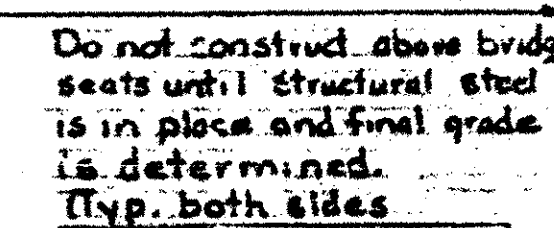

SECTION E-E

VIEW C-C

NOTES

1. For general notes see Sheet BR-100.
2. Fill to be made 6" above bottom of footing elevation before piles are driven.
3. All piles shall be driven to a minimum bearing capacity of 45 tons and to a minimum penetration of 10' into original ground.

No. Piles	Size	Est. Length of Piles	Splices Allowed for Piles not exceeding Plan Length (to be paid for only if used)	Splices Estimated for Piles exceeding Plan Length (to be paid for only if used)
10	12BP53	35	—	2

SECTION D-D CONTRACT 2

STATE OF VERMONT
DEPARTMENT OF HIGHWAYS

TOWN OF Georgia - Fairfax - Fairfield
- Albans -
ROUTE NO. I 89 LOG STA
Abutment # 1 S.B.
I 89 Over VT 104
Scale 3/8" = 1' - as Sh. Noted

SURVEYED BY
DRAWN BY RAC CHECKED BY WMS ET
PROJECT NO. I 89 - 31457 Cont. 2
SHEET 170 OF 167

BR 109

BR 875